



APPROACH AREA DETAIL - MAINLINE

FULL ROADWAY WIDTH
 FAIRFAX MM 6.883
 ST. ALBANS TOWN MM 2.300

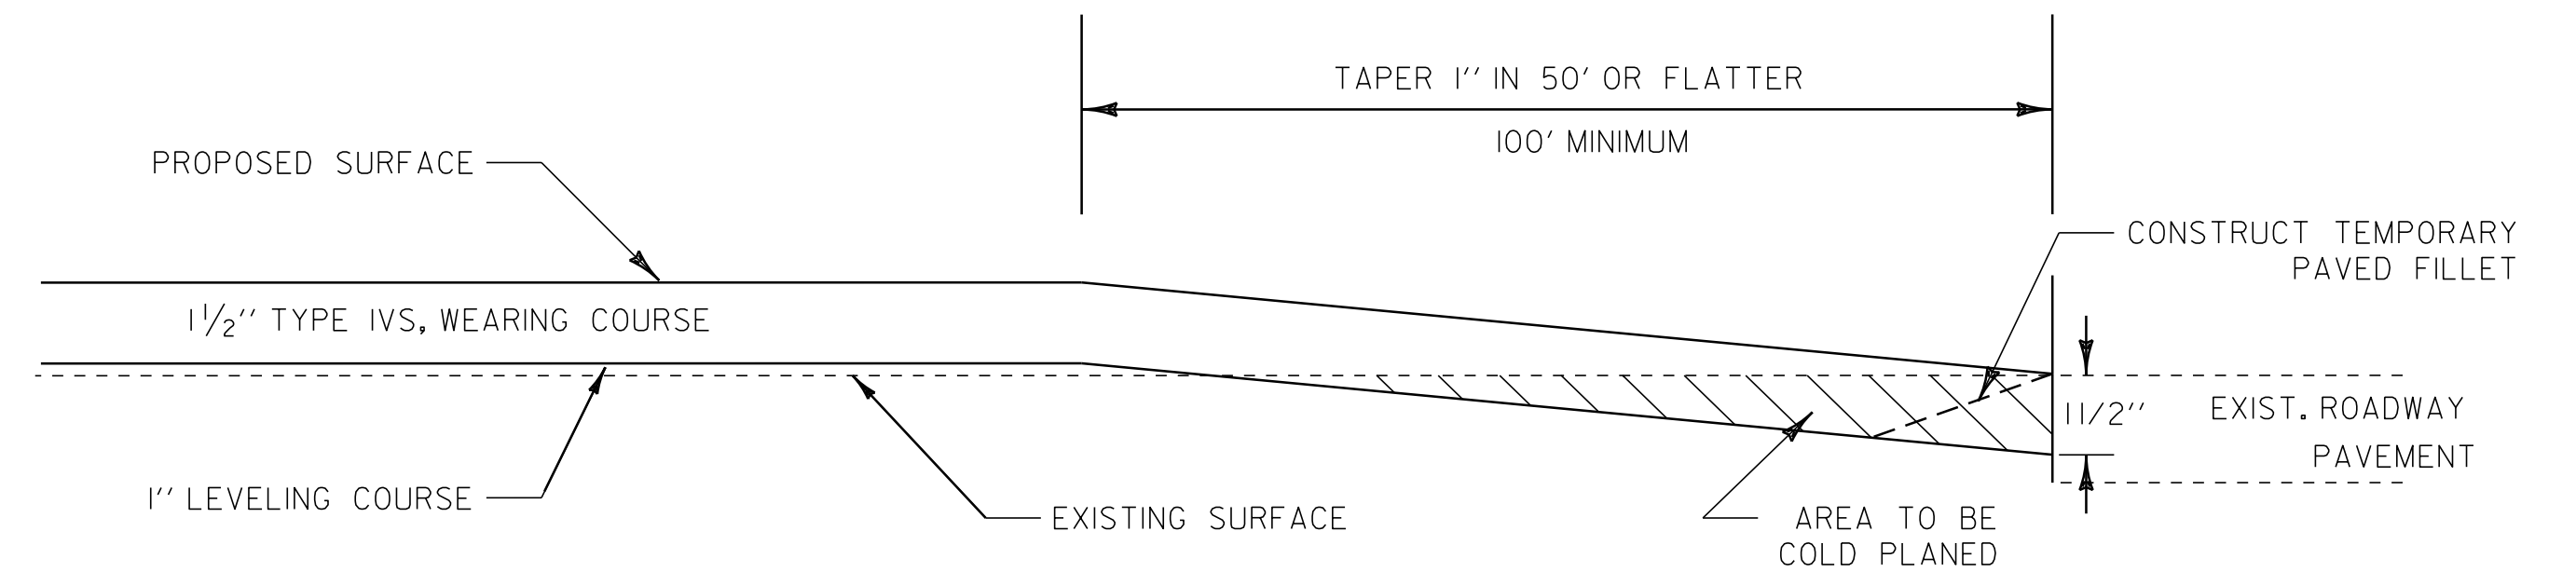


APPROACH AREA DETAIL - MAINLINE

FULL ROADWAY WIDTH
 ST. ALBANS TOWN MM 1.285
 ST. ALBANS TOWN MM 2.155
 ST. ALBANS TOWN MM 4.110

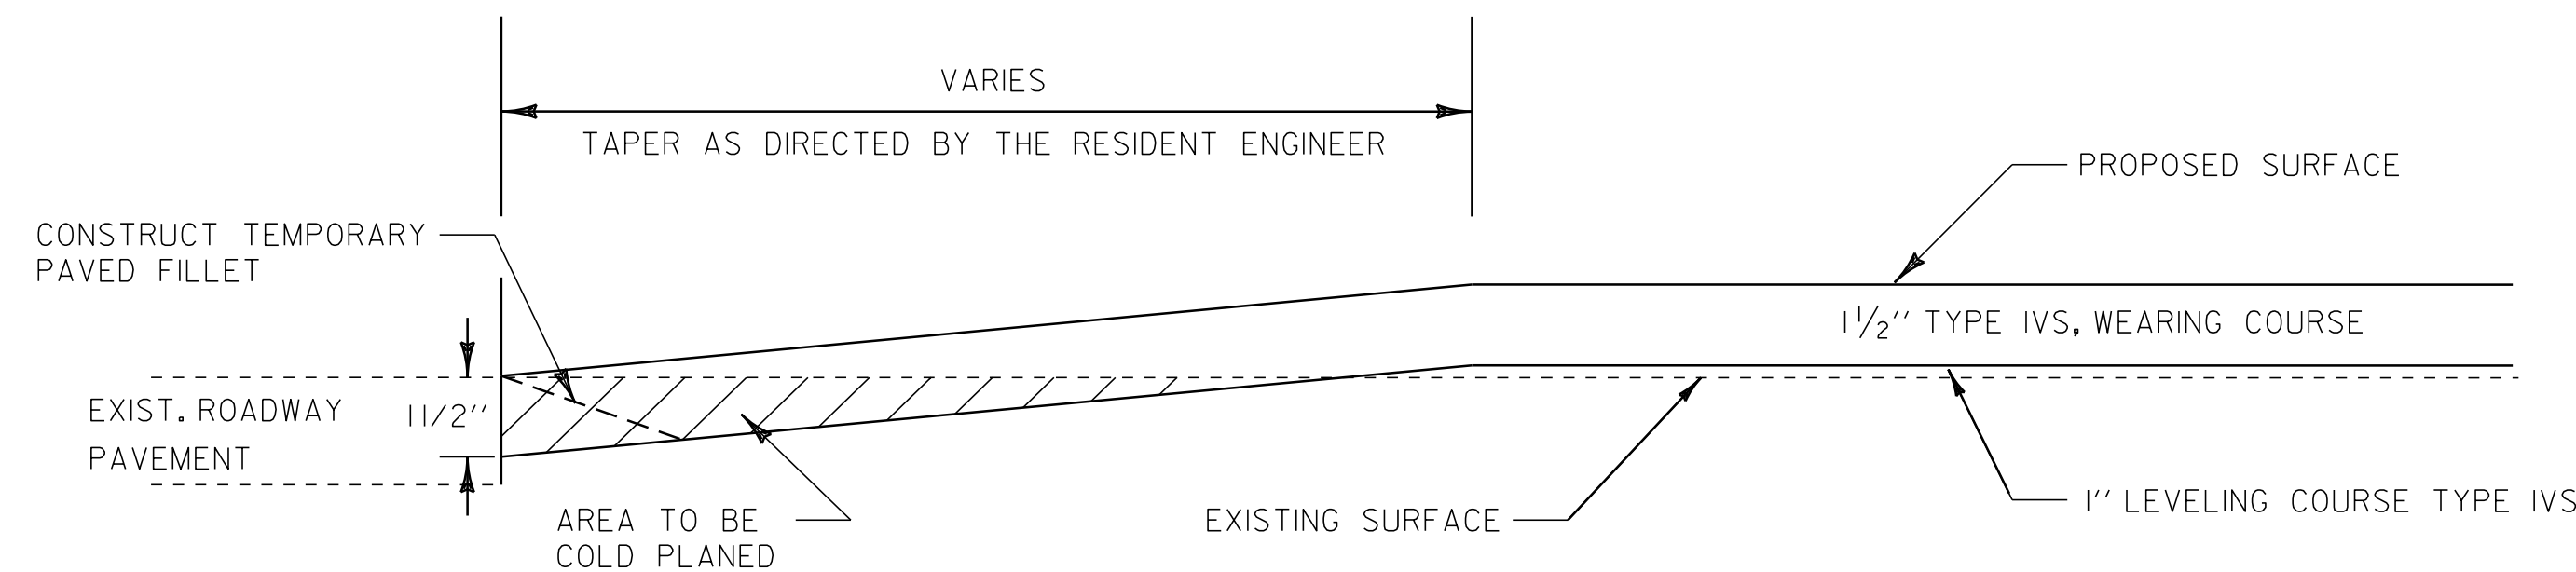

APPROACH AREA DETAIL - TOWN HIGHWAYS

FULL ROADWAY WIDTH

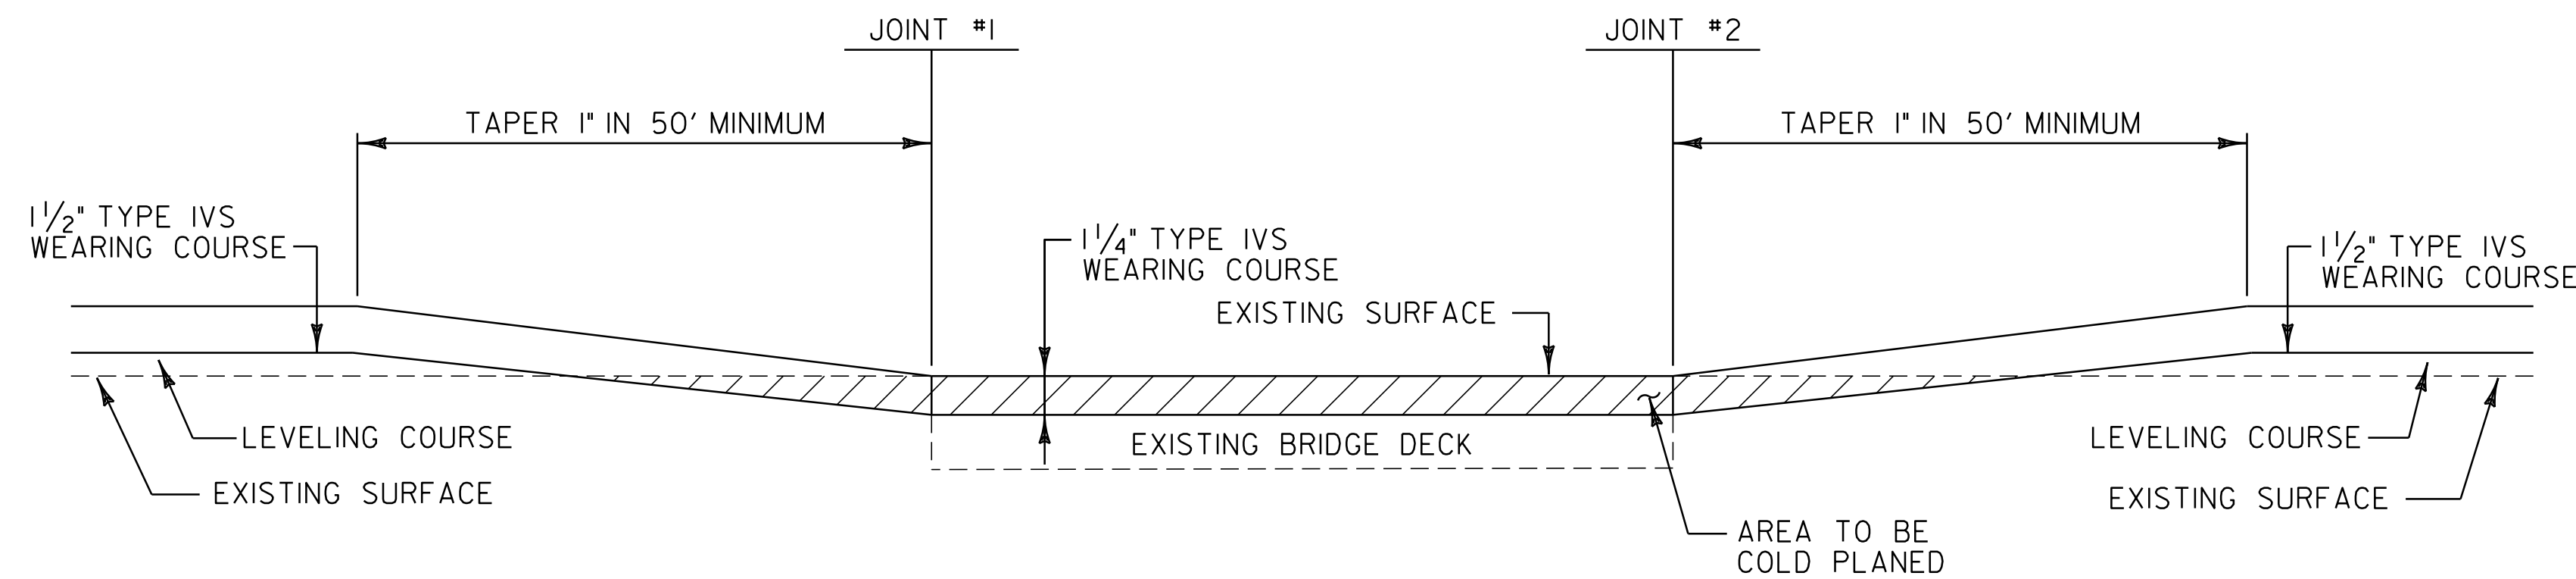

BRIDGE TRANSITION AREA DETAIL

BR 14 VT. ROUTE 104 FAIRFAX MM 9.781
 BR 20 VT. ROUTE 104 ST. ALBANS TOWN MM 2.865

620.75 SNOW BARRIER, GALVANIZED

BR 20 VT. ROUTE 104 ST. ALBANS TOWN MM 2.865 RT & LT (160 LF)
 FOR DETAILS SEE STD ESFM

NOT TO SCALE

PROJECT TYPICAL SHEET # 2	PROJECT NAME: FAIRFAX - ST. ALBANS TOWN	
	PROJECT NUMBER: STP 2217(1)	
	FILE NAME: p99cl86.dgn	PLOT DATE: 11-OCT-2011 11:48
	PROJECT LEADER: T. DOMEY	DRAWN BY: K. LOCKE
DESIGNED BY: K. LOCKE	CHECKED BY: PAVT MGMT	
IPARM FILE NAME: p99cl86+yp2.i	SHEET 3 OF 25	