



APPROACH AREA DETAIL
FULL ROADWAY WIDTH
 CAMBRIDGE STA. 3+513.198
 CAMBRIDGE STA. 12+200.000

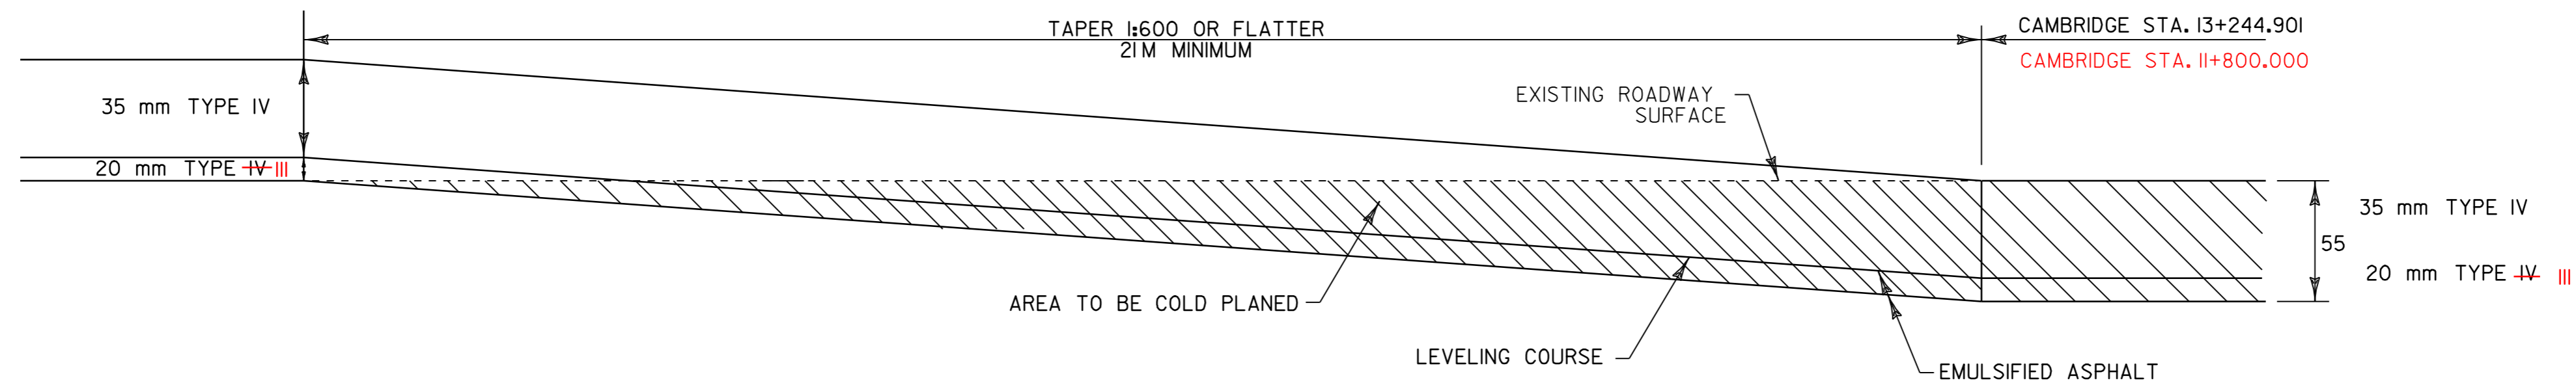

APPROACH AREA DETAIL
FULL ROADWAY WIDTH
 CAMBRIDGE STA. 13+244.901
 CAMBRIDGE STA. 11+800.000

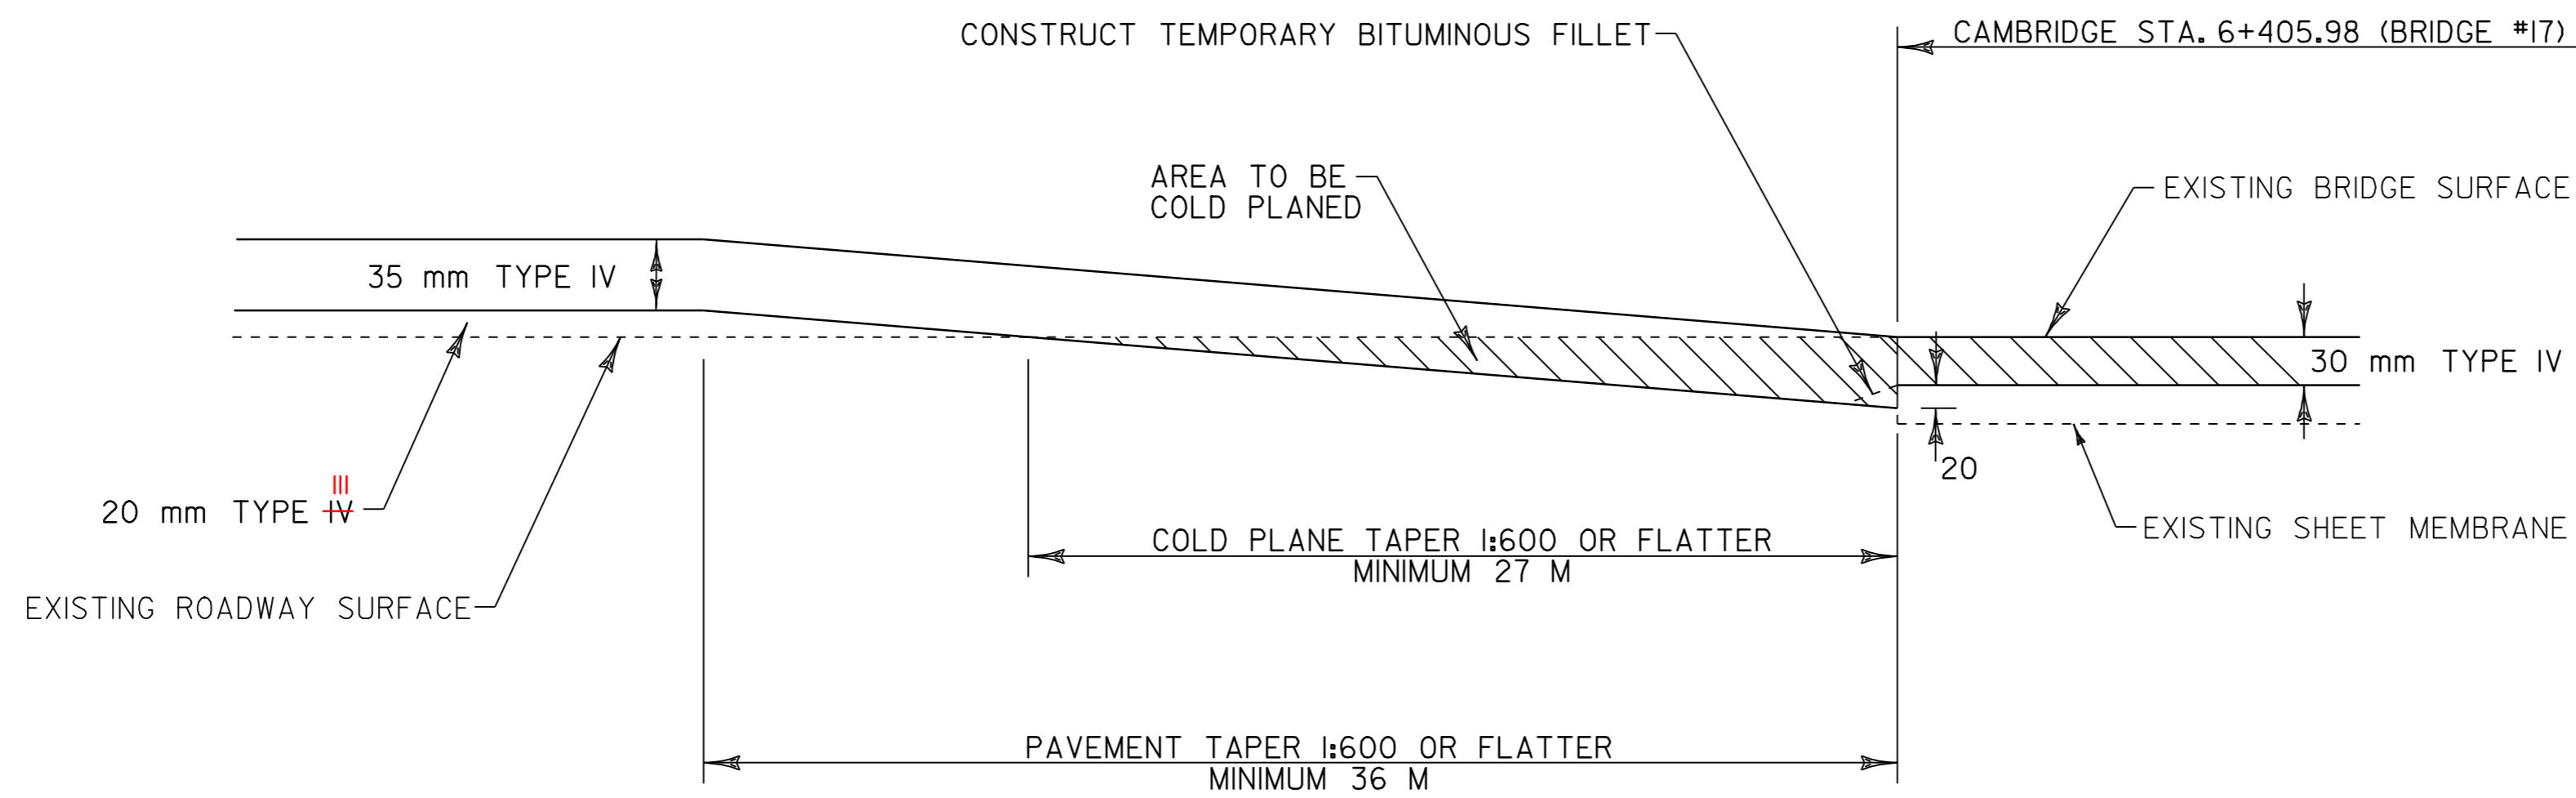

TRANSITION AREA DETAIL
(LEVELING AND OVERLAY TO COLD PLANING @ BRIDGE NO. 17)
FULL ROADWAY WIDTH
 CAMBRIDGE STA. 6+405.98 (BRIDGE #17)

DATUM	
VERTICAL	N/A
HORIZONTAL	N/A

PROJECT TYPICAL SHEET #2	SURVEYED BY	N/A	DATE	N/A
	DRAWN BY	LOCKE	DATE	JAN 04
	SQUAD LEADER	WOOLAVER		
	DESIGN FILE NO.	/pave/99cl88/99cl88.dgn		
	IPARM FILE		DATE PLOTTED	
PROJ. NAME	CAMBRIDGE			
PROJ. NO.	STP 2218(I)S			
SHEET	3 OF 28			