


TEMPORARY AND DURABLE 100 mm WHITE LINE
 STA. 8+000.00 - STA. 9+200.00 LT. & RT.
RELOCATE MAIL BOX, SINGLE SUPPORT
~~STA. 8+039.42 RT.~~
 STA. 8+698.08 RT.
 STA. 8+823.84 RT.
RELOCATE MAIL BOX, MULTIPLE SUPPORT
 STA. 8+620.54 RT.

TEMPORARY AND DURABLE 100 mm YELLOW LINE
 STA. 8+000.00 LT. - STA. 8+320.31 LT. (SOLID)
 STA. 8+000.00 RT. - STA. 8+111.09 RT. (SOLID)
 STA. 8+111.09 RT. - STA. 8+336.40 RT. (DASHED)
 STA. 8+320.31 LT. - STA. 8+545.62 LT. (DASHED)
 STA. 8+336.40 RT. - STA. 8+521.48 RT. (SOLID)
 STA. 8+545.62 LT. - STA. 8+738.74 LT. (SOLID)
 STA. 8+521.48 RT. - STA. 8+706.55 RT. (DASHED)
 STA. 8+706.55 RT. - STA. 8+996.23 RT. (SOLID)
 STA. 8+738.74 LT. - STA. 8+939.91 LT. (DASHED)
 STA. 8+939.91 LT. - STA. 9+200.00 LT. (SOLID)
 STA. 8+996.23 RT. - STA. 9+200.00 RT. (DASHED)

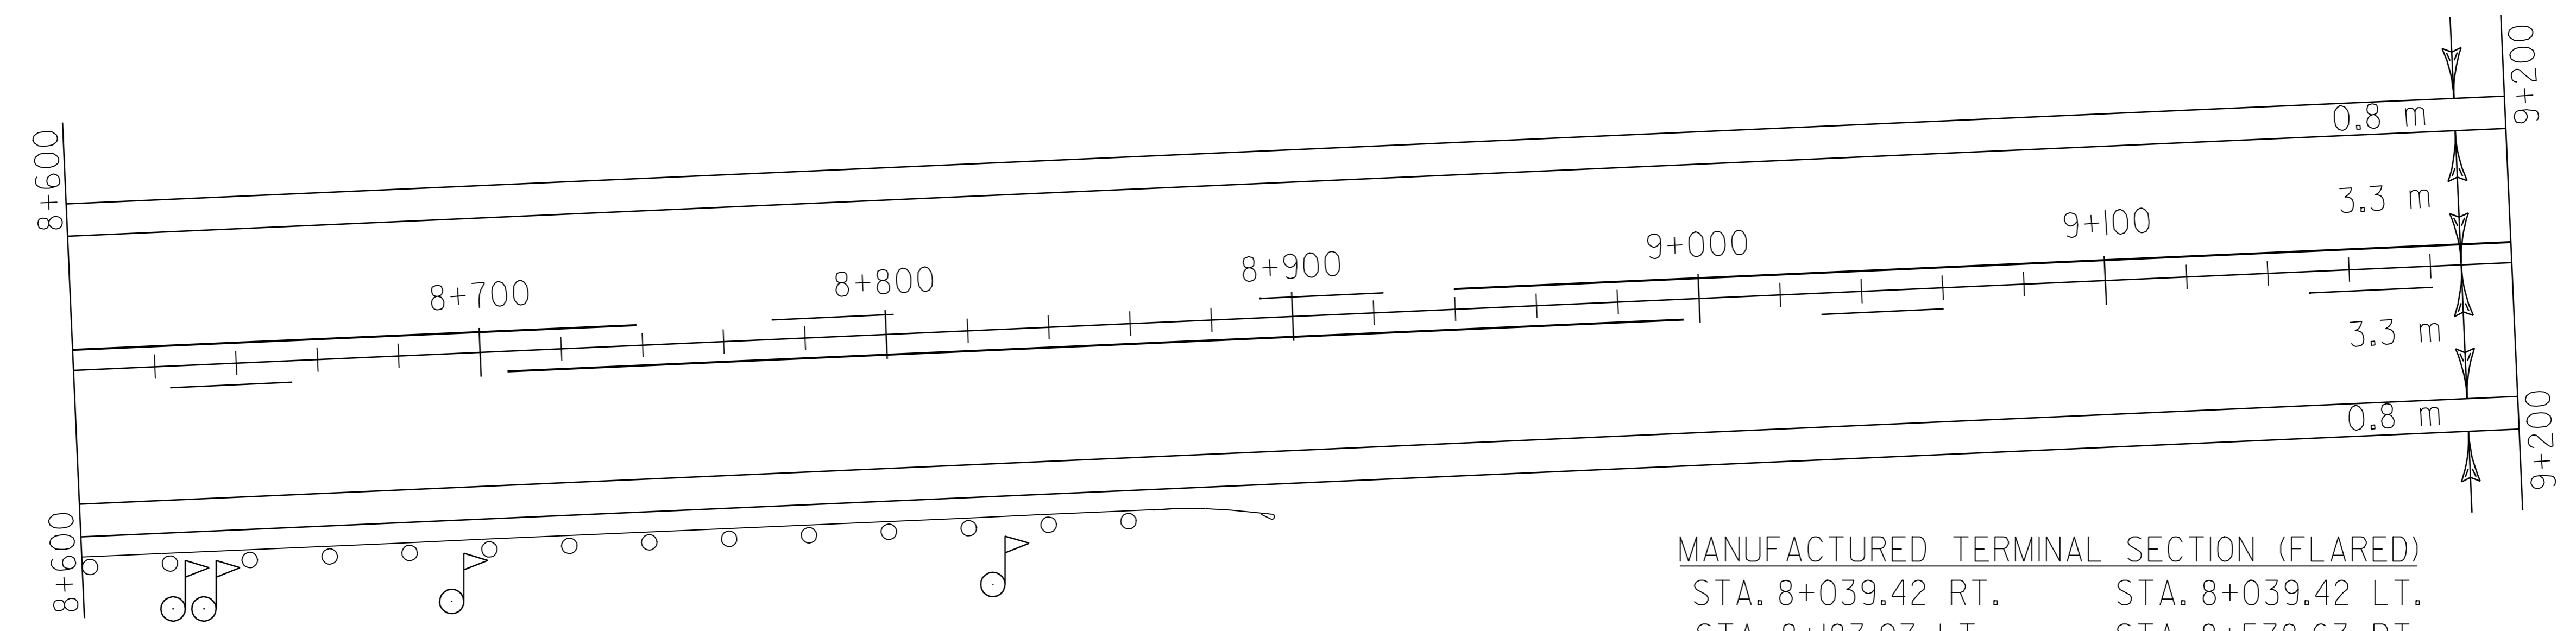

REMOVAL AND DISPOSAL OF GUARD RAIL
 STA. 8+000.00 RT. - STA. 8+039.42 RT.
 STA. 8+039.42 LT. - STA. 8+183.97 LT.
 STA. 8+578.63 RT. - STA. 8+896.23 RT.

STEEL BEAM GUARD RAIL
 STA. 8+000.00 RT. - STA. 8+028.02 RT.

MANUFACTURED TERMINAL SECTION (FLARED)
 STA. 8+039.42 RT. STA. 8+039.42 LT.
 STA. 8+183.97 LT. STA. 8+578.63 RT.
~~STA. 8+896.23 RT.~~ **USED G-ID WITH ANCHOR**

STEEL BEAM GUARD RAIL W/2.4 M POSTS
 STA. 8+050.82 LT. - STA. 8+172.57 LT.
 STA. 8+590.03 RT. - STA. 8+881.68 RT.

PAVING PROJECT LAYOUT #5	PROJECT NAME: CAMBRIDGE	FILE NAME: Z:\pave\299cl88\299cl88.dgn	PLOT DATE: 14-FEB-2006 16:4
	PROJECT NUMBER: SIP_2218(I)S	PROJECT LEADER: WQQLAYER	DRAWN BY: KML
	DESIGNED BY: KML	RECORDED BY: LOCKE	CHECKED BY: PAVI.MGMT.
			SHEET 12 OF 28