

TEMPORARY AND DURABLE 100 mm WHITE LINE
 STA. 14+200.00 - STA. 14+583.875 LT. & RT.
 STA. 14+303.458 RT (T-55) EDGE LINES
 STA. 14+303.458 RT (T-55) EDGE LINES (T-53)
 STA. 14+435.421 RT (T-73) EDGE LINES


TEMPORARY AND DURABLE 100 mm YELLOW LINE W/ CL BREAKS FOR TH'S
 STA. 14+200.00 - STA. 14+583.875 LT. & RT. (SOLID)
 STA. 14+303.458 RT (T-55) CL
 STA. 14+303.458 RT (T-55) CL
 STA. 14+435.421 RT (T-73) CL

REMOVING SIGNS
 15 ~~13~~ EACH

~~TEMPORARY AND DURABLE LETTERS OR SYMBOLS~~

STA. 14+303.458 LT (T-53) (STOP)
 STA. 14+303.458 LT (T-53) (STOP)
 STA. 14+435.421 RT (T-73) (STOP)
~~STA. 14+374.688 RT (STOP)~~ NOT WARRANTED
~~STA. 14+384.288 RT (AHEAD)~~ NOT WARRANTED
 STA. 14+580.275 RT (STOP)


~~TEMPORARY AND DURABLE CROSSWALK MARKINGS WITH DIAGONAL LINES~~
 STA. 14+210.119

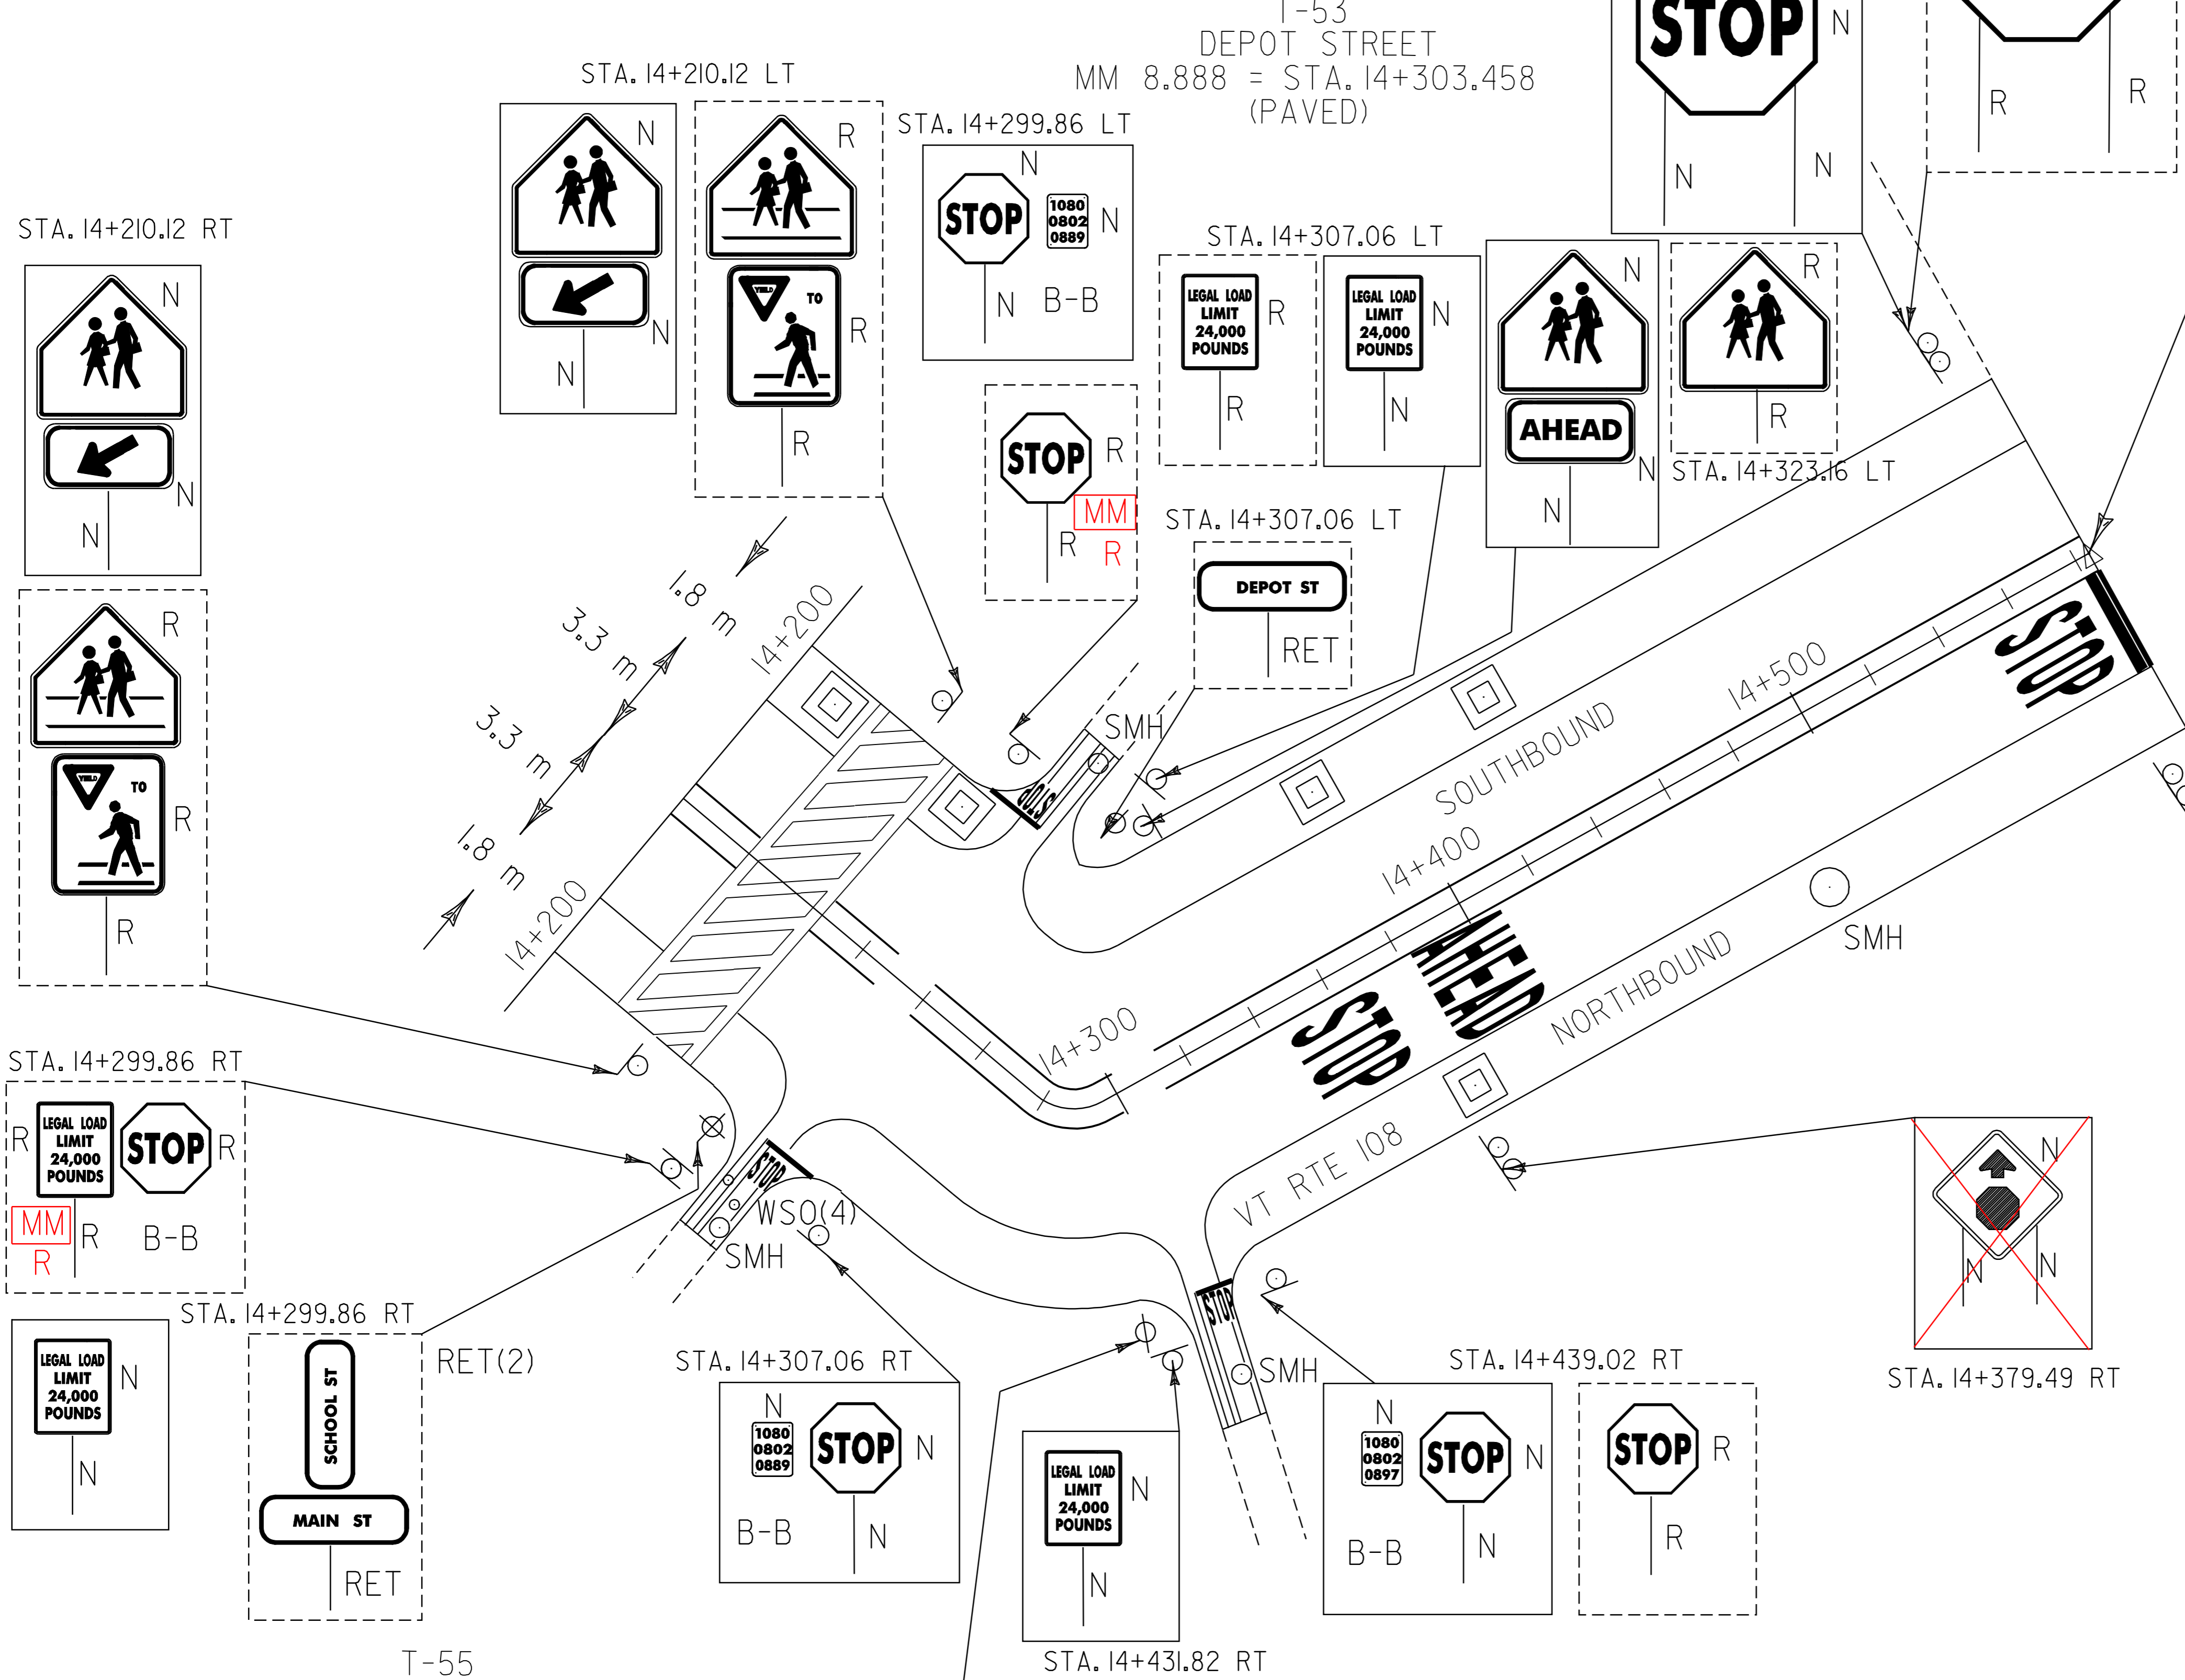

END PROJECT STP 2218(I)S
 STA. 14+583.875 = MM 9.062

~~TEMPORARY AND DURABLE 600 mm STOP BAR~~

STA. 14+303.458 LT (T-53)
 STA. 14+303.458 RT (T-55)
 STA. 14+435.421 RT (T-73)
 STA. 14+582.675 RT.

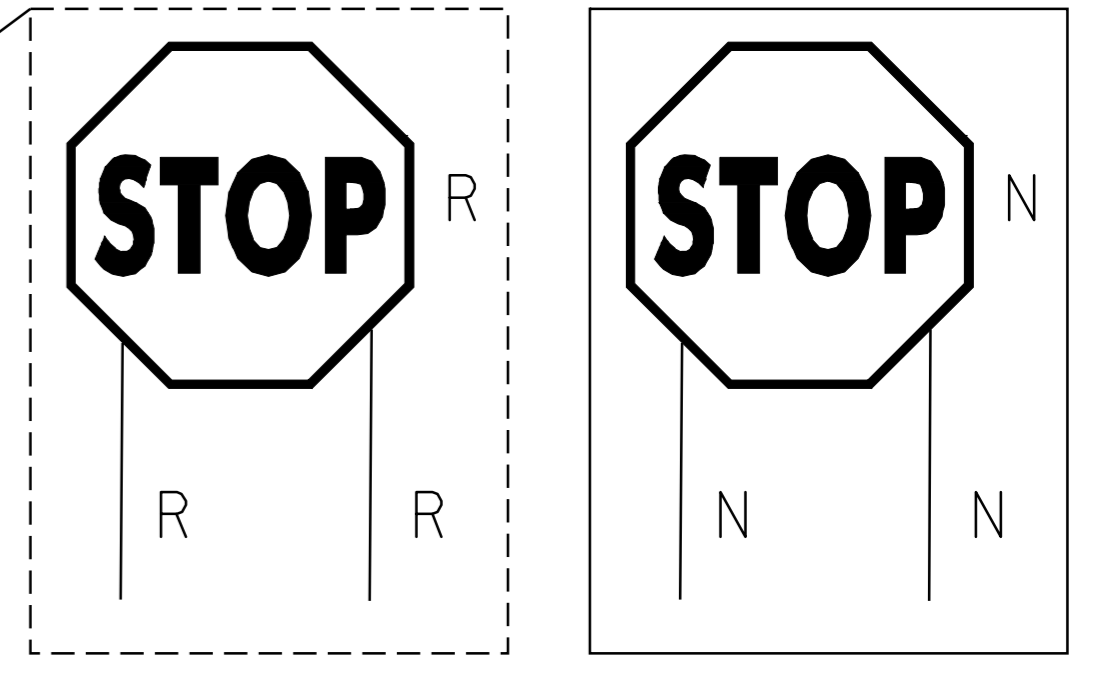

CHANGING ELEVATION OF SEWER MANHOLE

STA. 14+303.458 RT. (SCHOOL ST.)
 STA. 14+303.458 LT. (DEPOT ST.)
 STA. 14+435.421 RT. (OLD MAIN ST.)
 STA. 14+488.421 RT.

REHABILITATION OF DI, CB, OR MH, CLASS I

STA. 14+205.119 LT.
 STA. 14+297.458 LT.
~~STA. 14+385.421 LT.~~ OUTSIDE PAVING LIMIT
 STA. 14+385.421 RT.
 STA. 14+435.421 LT.

ADJUST ELEVATION OF VALVE BOX
 STA. 14+303.458 RT. (SCHOOL ST) (4 EA-WSO)
 3

PAVING PROJECT LAYOUT #11	PROJECT NAME: CAMBRIDGE	FILE NAME: Z:\pave\299cl88\299cl88.dgn	PLOT DATE: 14-FEB-2006 16:4
	PROJECT NUMBER: STP_2218(I)S	PROJECT LEADER: WOQLAYER	DRAWN BY: KML
	DESIGNED BY: KML	CHECKED BY: PAVI.MGMT.	SHEET 18 OF 28
	RECORDED BY: LOCKE		