

TEMPORARY AND DURABLE 100 mm WHITE LINE

STA. 0+000.00 - STA. 0+300.00 LT. & RT.

TEMPORARY AND DURABLE 100 mm YELLOW LINE

STA. 0+000.00 - STA. 0+300.00 LT. & RT. (SOLID)

~~TEMPORARY AND DURABLE LETTERS OR SYMBOLS~~

STA. 0+075.91 LT. (AHEAD)

STA. 0+085.51 LT. (STOP)

STA. 0+005.00 LT. (STOP)

~~TEMPORARY AND DURABLE 600 mm STOP BAR~~

STA. 0+006.00 LT

~~TEMPORARY AND DURABLE CROSSWALK MARKINGS WITH DIAGONAL LINES~~

STA. 0+274.34

REHABILITATION OF DI, CB, OR MH, CLASS I

STA. 0+269.34 LT. & RT.

STA. 0+222.34 ~~LT.~~ RT.

STA. 0+192.34 LT. & RT.

STA. 0+146.34 ~~RT.~~ LT.

STA. 0+139.34 ~~LT.~~ RT.

CHANGING ELEVATION OF SEWER MANHOLE


STA. 0+252.34 ~~RT.~~ LT.

STA. 0+222.34 ~~RT.~~ LT.

~~STA. 0+075.91 LT. (MOBIL ACCESS)~~

OUTSIDE COLD PLANE LIMIT

STA. 0+109.34 LT.

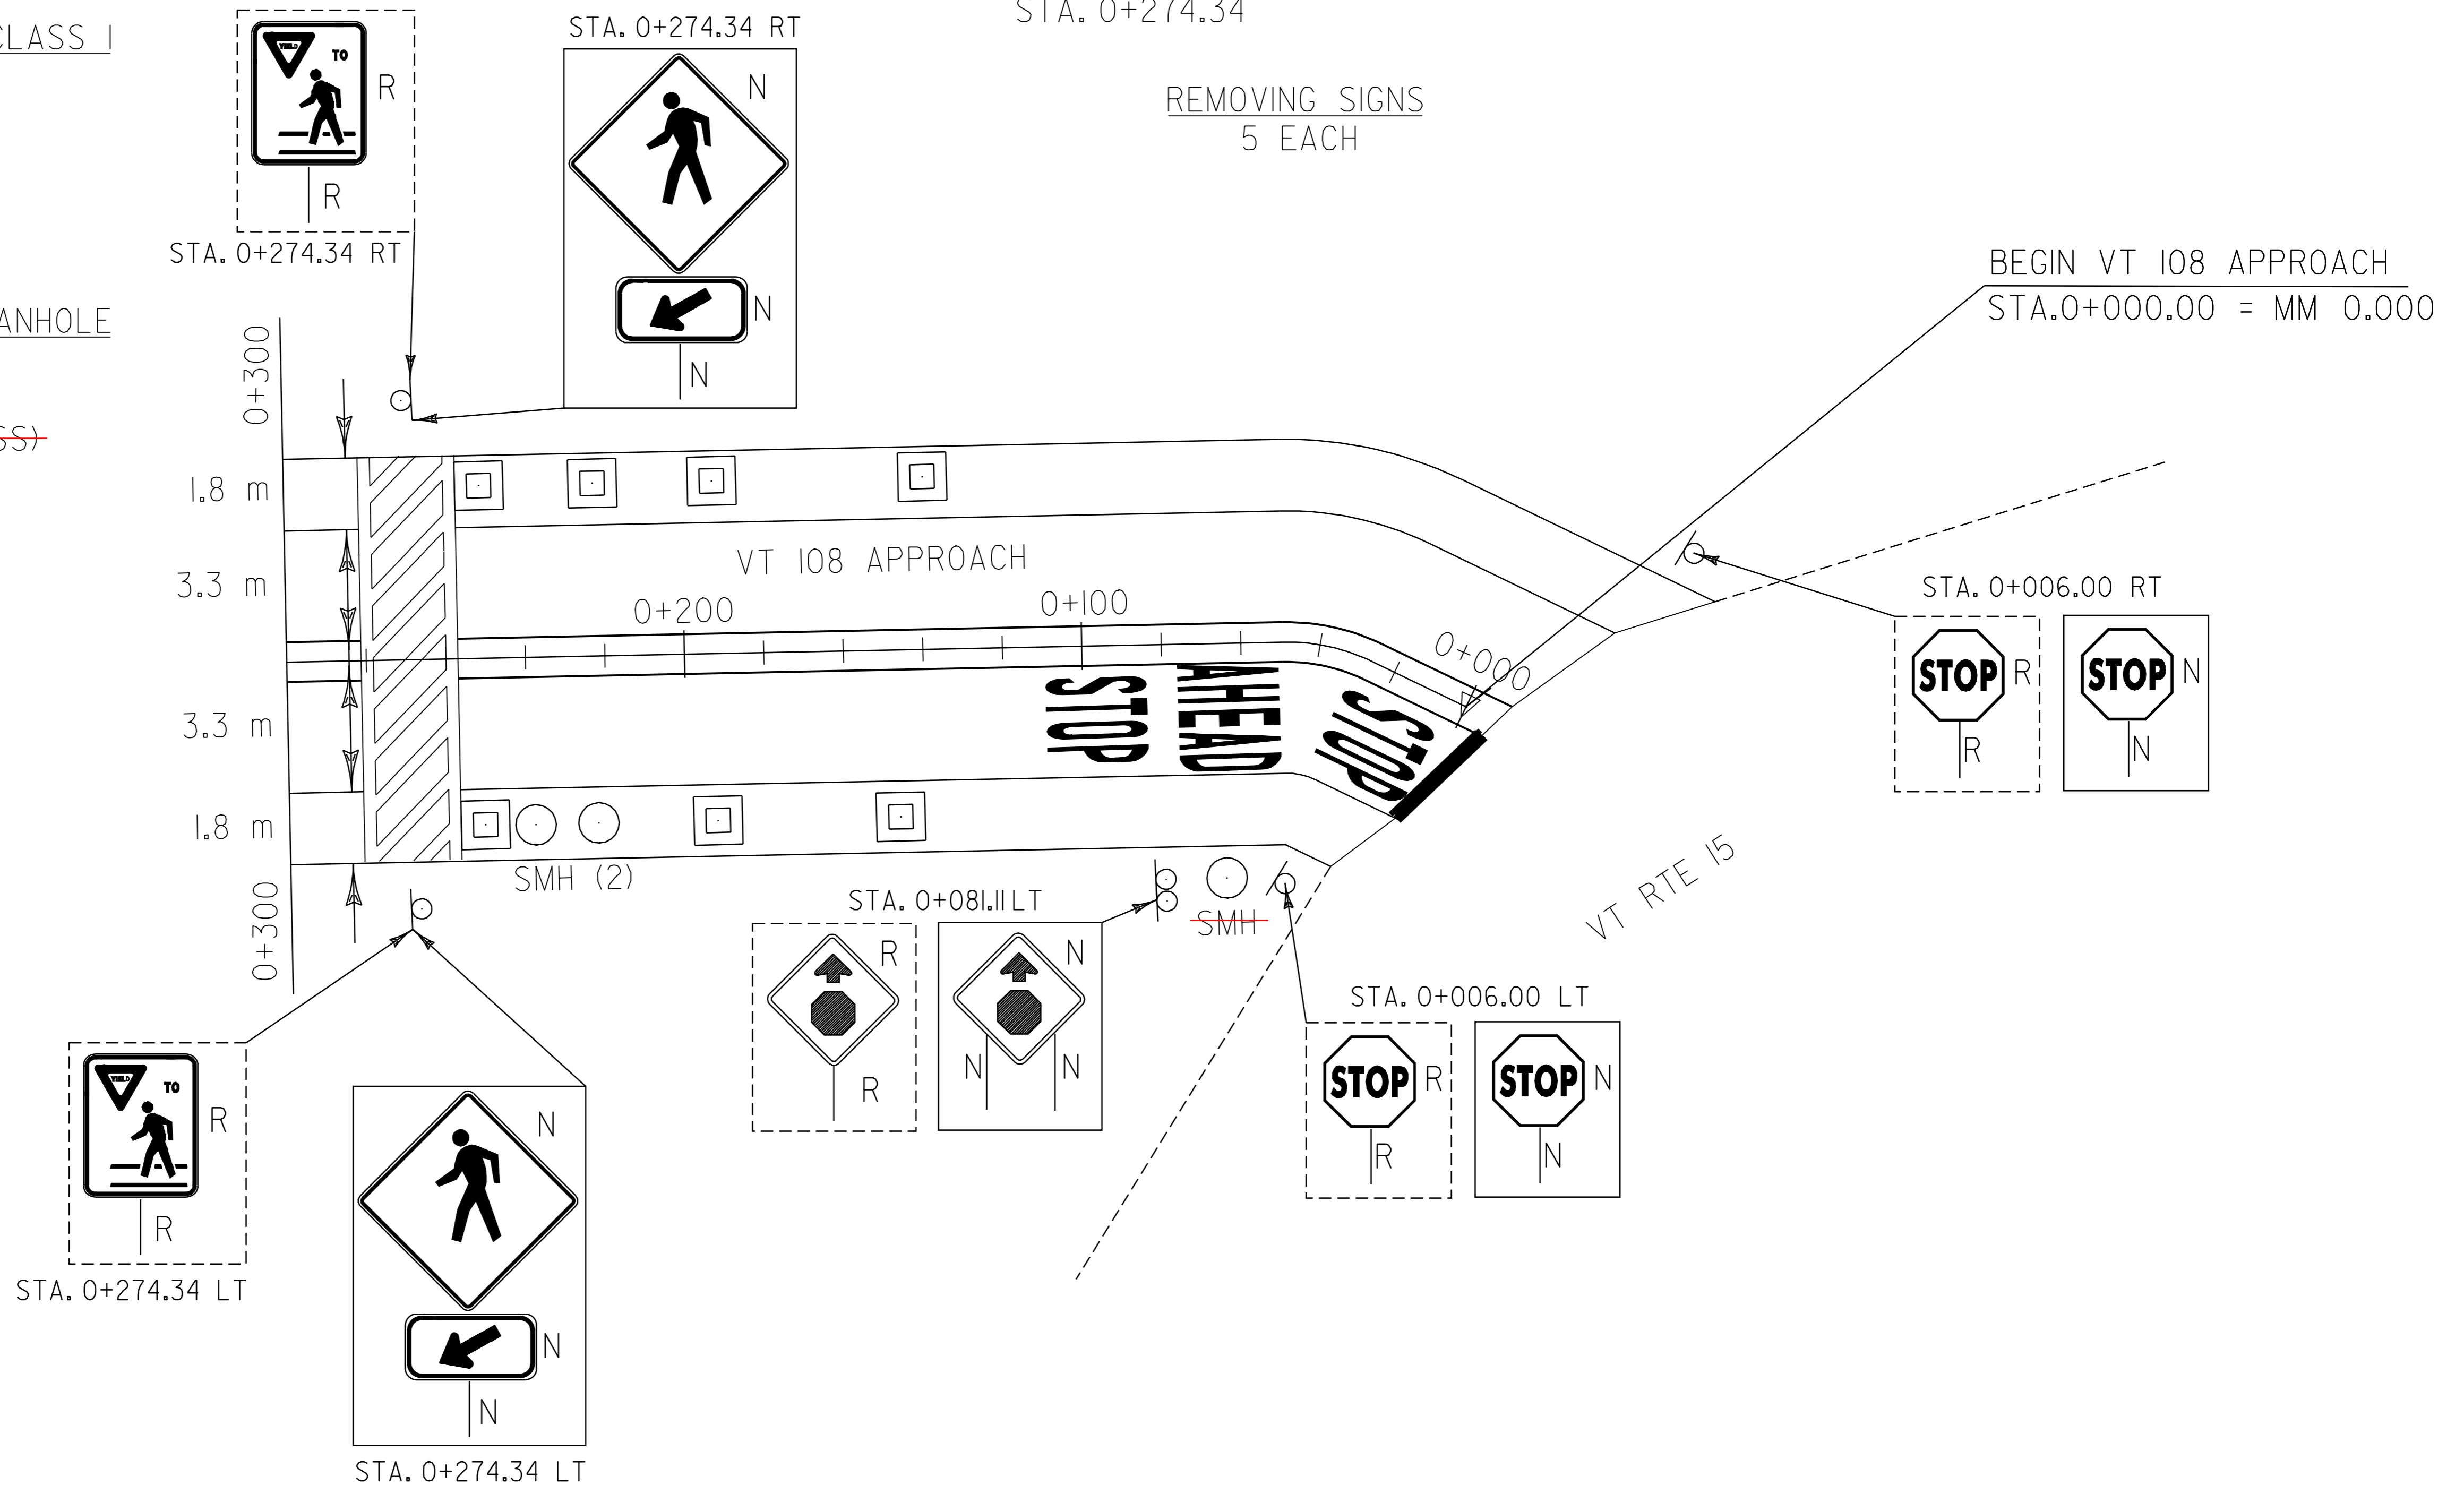

PAVING PROJECT LAYOUT #12	PROJECT NAME: CAMBRIDGE
	PROJECT NUMBER: STP_2218(1)S
	FILE NAME: Z:\pave\2218\2218.dgn
	PLOT DATE: 14-FEB-2006 16:4
PROJECT LEADER: WQQLAYER	DRAWN BY: KML
DESIGNED BY: KML	CHECKED BY: PAVI.MGMT.
RECORDED BY: LOCKE	SHEET 19 OF 28