


INDEX OF SHEETS

- 1. TITLE SHEET
- 2.-3. PROJECT TYPICAL SHEETS
- 4.-5. QUANTITY SHEETS
- 6. ITEM DETAIL SUMMARY SHEETS
- 7. DITCH CLEANING DETAIL SHEET
- 8.-19. LAYOUT SHEETS
- 20.-25. SIGN SUMMARY SHEETS
- 26. TERMINAL CONNECTOR DETAIL
- 27. REDUCED POST SPACING DETAIL
- 28. CONSTRUCTION APPROACH SIGNING SHEET

# STATE OF VERMONT AGENCY OF TRANSPORTATION

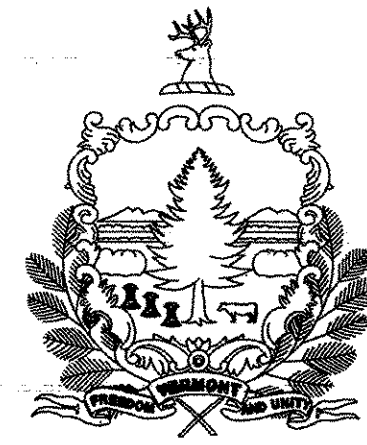

## PROPOSED IMPROVEMENT TOWN OF CAMBRIDGE COUNTY OF LAMOILLE VT ROUTE 108


BEGINNING AT STATION 3+513.198 (MM 2.183) IN THE TOWN OF CAMBRIDGE, AND EXTENDING NORTHERLY ALONG VT RTE 108 FOR A DISTANCE OF 11,070.677 METERS (6.879 MILES) TO STATION 14+583.875 (MM 9.062). ALSO INCLUDED IS ALL OF THE VT 108 APPROACH FROM STATION 0+000.000 (MM 0.000) TO STATION 0+439.351 (MM 0.273).

LENGTH OF ROADWAY 11,510.028 m (7.152 MILES)  
LENGTH OF PROJECT 11,510.028 m (7.152 MILES)

WORK TO BE PERFORMED ON THIS PROJECT INCLUDES RESURFACING WITH A SHIM/LEVELING COURSE AND WEARING COURSE, COLD PLANING, NEW PAVEMENT MARKINGS, DRAINAGE IMPROVEMENTS, GUARDRAIL IMPROVEMENTS AND INCIDENTAL ITEMS.

VAOT STANDARDS

C-1M	TREATED TIMBER CURB	01-03-00
E-100AM	SIDE ROAD CONSTRUCTION APPROACH SIGNS	03-01-04
E-100M	CONSTRUCTION APPROACH SIGNS	03-01-04
E-101M	CONSTRUCTION SIGN DETAILS	05-30-03
E-102AM	CONSTRUCTION SIGN DETAILS	06-13-97
E-102M	CONSTRUCTION SIGN DETAILS	06-30-03
E-106M	TRAFFIC CONTROL-MISCELLANEOUS DETAILS	03-01-04
E-108M	CONSTRUCTION ZONE LONGITUDINAL DROP OFFS	06-13-97
E-121M	STANDARD SIGN PLACEMENT CONVENTIONAL ROAD	06-13-97
E-138M	REFERENCE PLAQUE DETAILS STATE AND TOWN HIGHWAYS	05-30-03
E-141M	REGULATORY SIGN DETAILS	06-13-97
E-143M	REGULATORY SIGN DETAILS	06-13-97
E-150M	WARNING SIGN DETAILS	06-13-97
E-152M	WARNING SIGN DETAILS	06-13-97
E-153M	WARNING SIGN DETAILS	06-13-97
E-160M	FLANGED CHANNEL SIGN POST	06-13-97
E-164M	SQUARE STEEL SIGN POST	06-13-97
E-191M	PAVEMENT MARKING DETAILS	02-01-99
E-193M	PAVEMENT MARKING DETAILS	06-13-97
G-1DM	STEEL BEAM GUARD RAIL (40 MPH & LESS)	01-03-00
G-1M	STEEL BEAM GUARD RAIL (50 MPH & OVER)	01-03-00
G-4M	YIELDING MARKER POSTS	06-13-97
G-19M	GENERIC GRADING PLANS FOR GUARD RAIL END TERMINALS	11-15-02
SB-R6-82M	BRIDGE RAILING - HEAVY DUTY STEEL BEAM	07-10-97

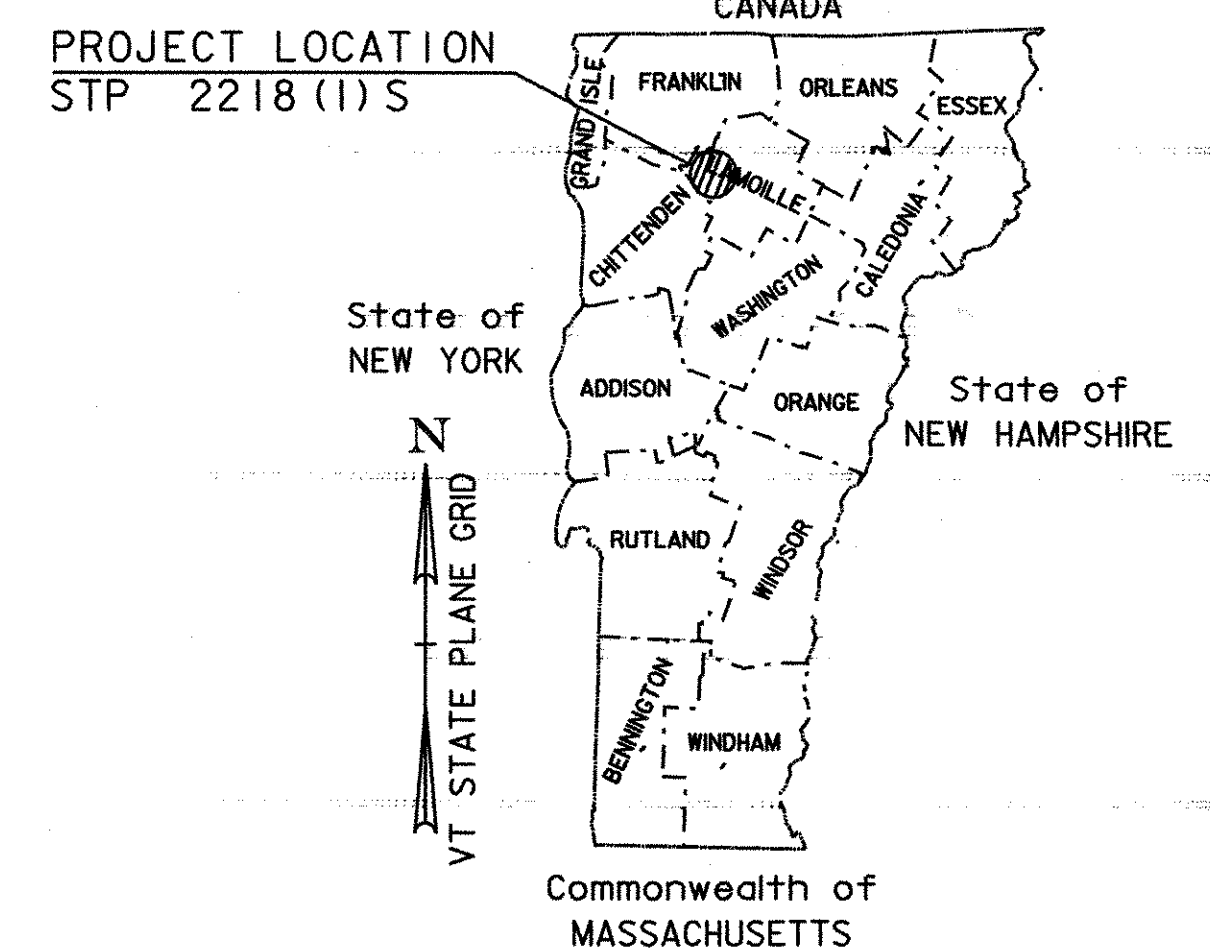


TRAFFIC DATA

VT. ROUTE 108 (MM 2.183 TO MM 5.840)	2005 ADT = 3,500
	2005 DHV = 1,000
	2015 ADT = 4,000
	2015 DHV = 1,200
2005 ~ 2015 CUM. ESALS = 478,000	
2005 ~ 2025 CUM. ESALS = 1,147,000	
VT. ROUTE 108 (MM 5.840 TO MM 8.740)	2005 ADT = 4,600
	2005 DHV = 1,400
	2015 ADT = 5,300
	2015 DHV = 1,600
2005 ~ 2015 CUM. ESALS = 406,000	
2005 ~ 2025 CUM. ESALS = 1,003,000	
VT. ROUTE 108 APPROACH (MM 0.000 TO END OF PROJECT)	2005 ADT = 2,200
	2005 DHV = 410
	2015 ADT = 2,500
	2015 DHV = 450
2005 ~ 2015 CUM. ESALS = 224,000	
2005 ~ 2025 CUM. ESALS = 542,000	

UNLESS OTHERWISE NOTED, ALL DRAWINGS AND DETAILS OF THE PROJECT PLANS ARE NOT TO SCALE.

RIGHT OF WAY LIMITS, IF APPLICABLE, ARE PROVIDED SOLELY FOR THE CONVENIENCE OF THE STATE AND ITS CONTRACTOR DURING THE COURSE OF THIS PAVING PROJECT. ANY REFERENCES TO OFFSETS ON THESE PLANS ARE APPROXIMATE AND SHOULD NOT BE RELIED UPON FOR ANY OTHER PURPOSES.

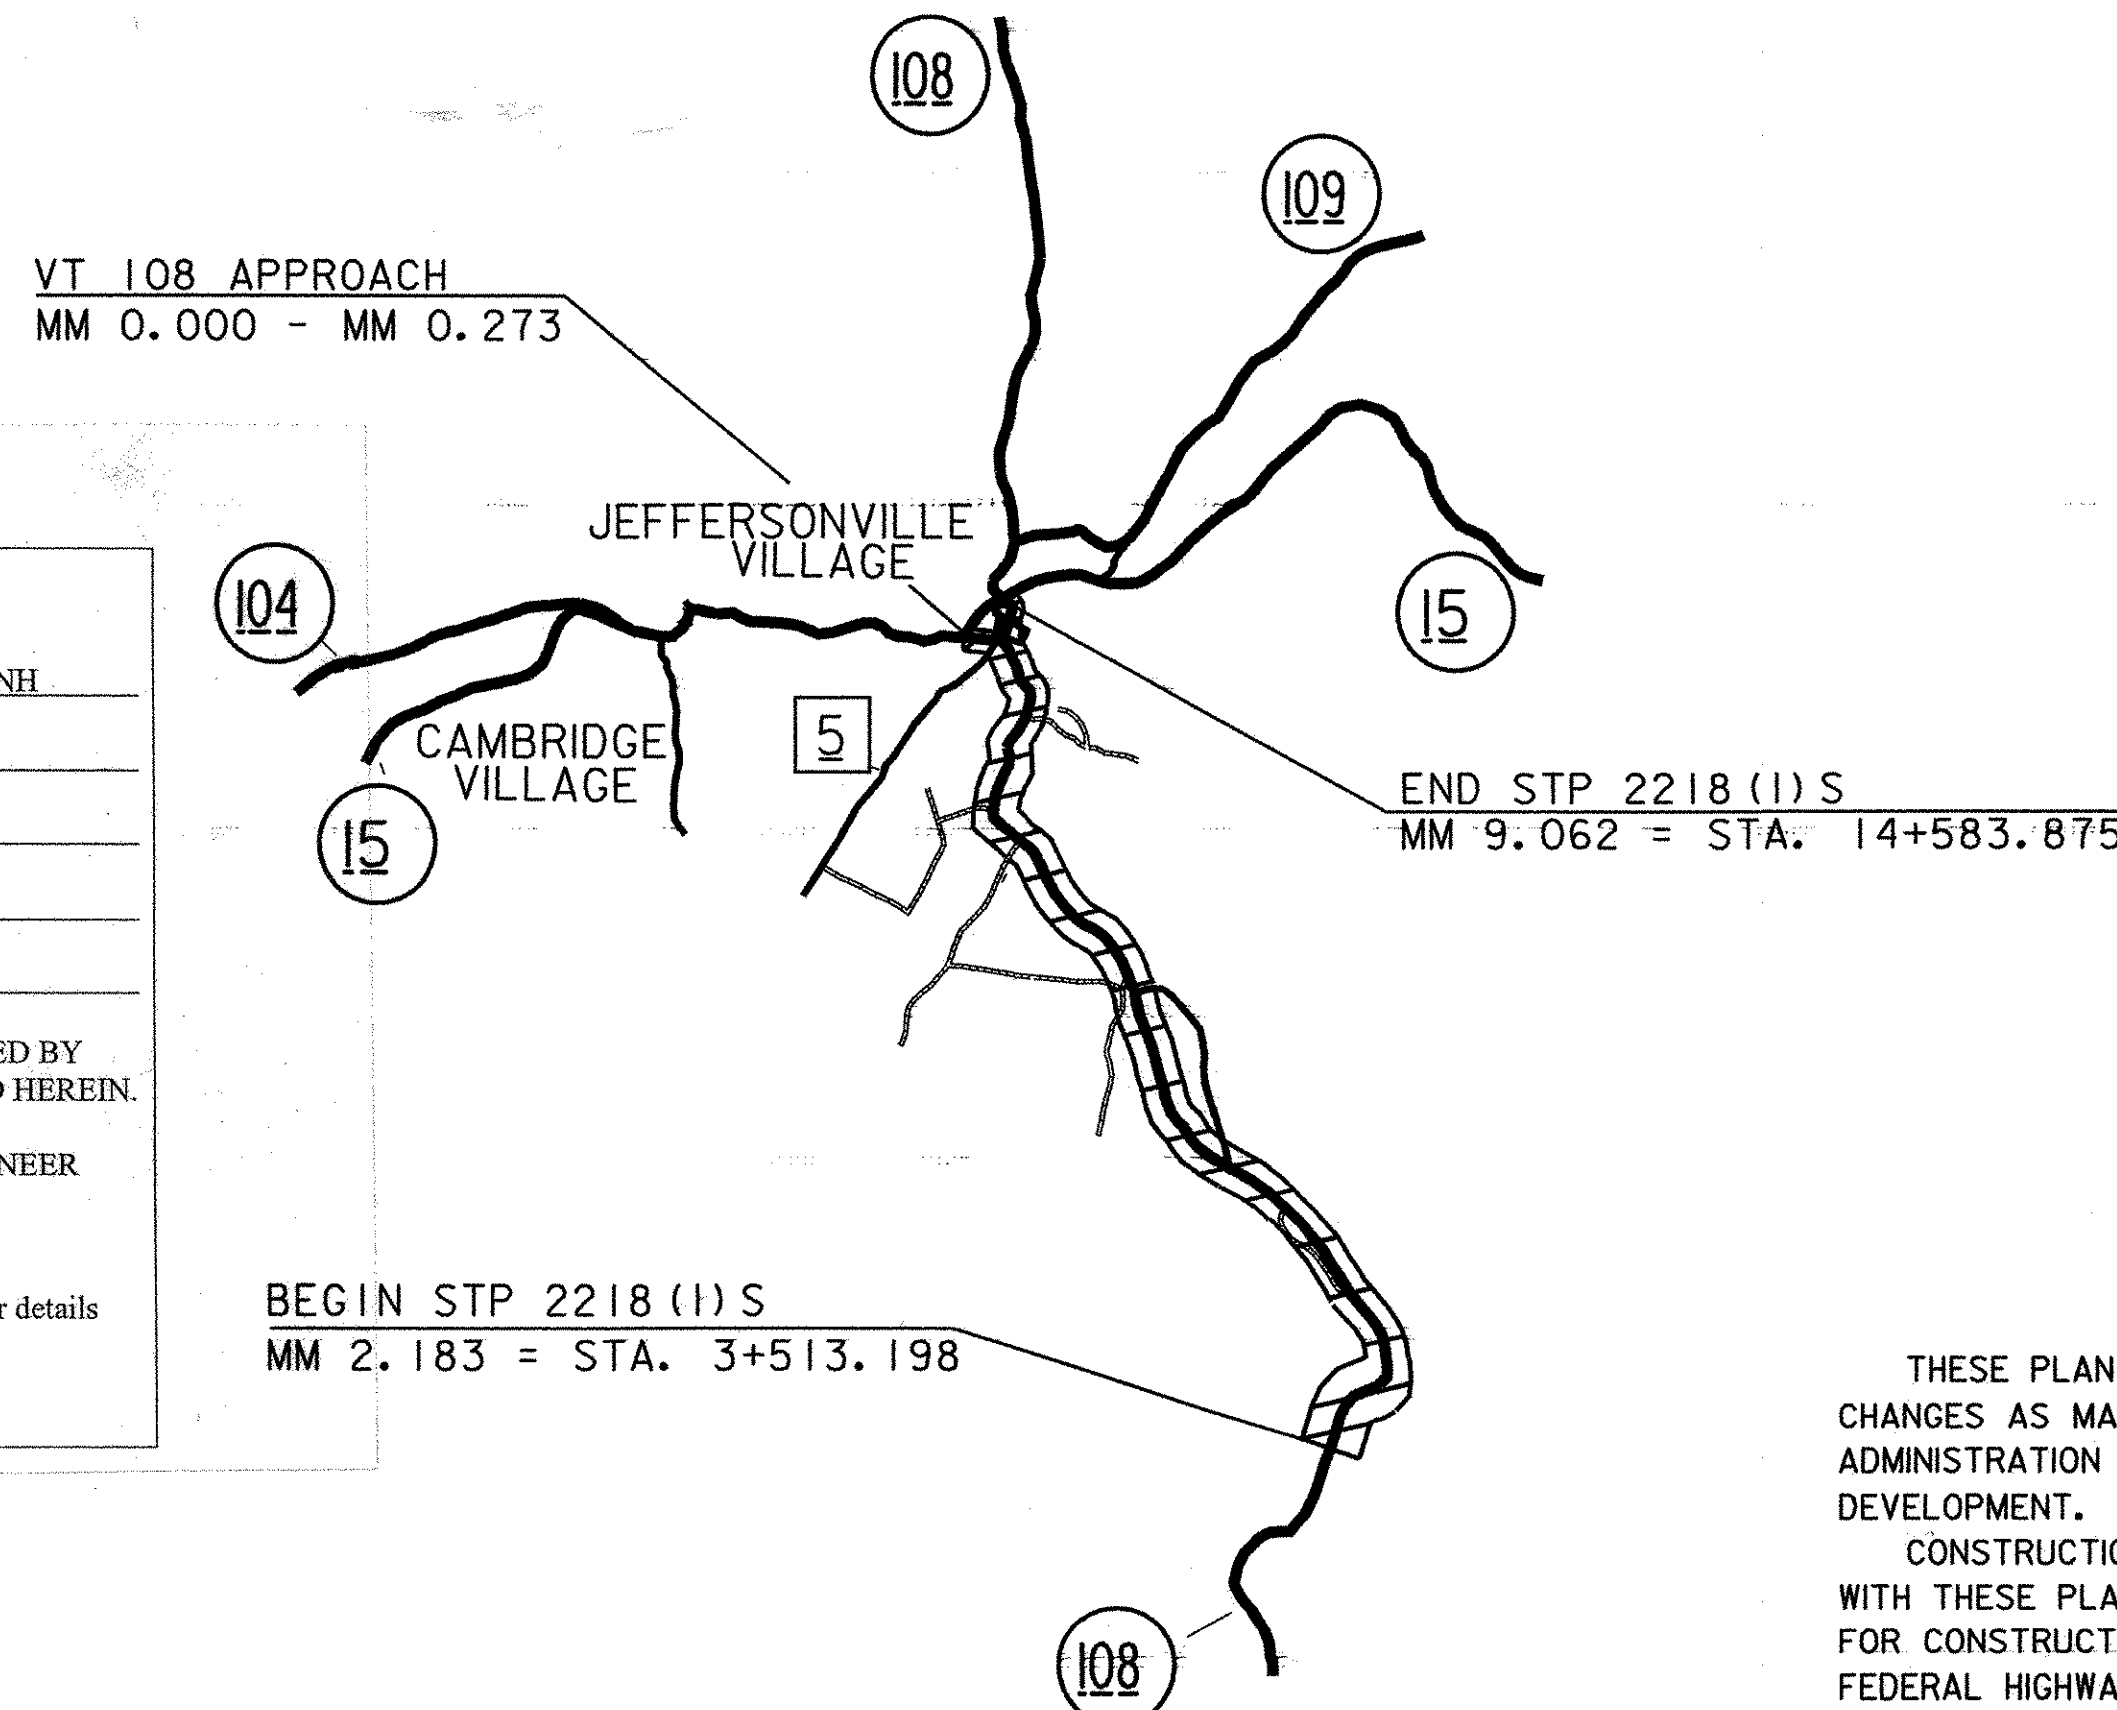

**RECORD PLANS**

CONTRACTOR: WHITCOMB CONSTRUCTION CORP. - WALPOLE, NH

RESIDENT ENGINEER: JEFF COTA

CONSTRUCTION BEGAN: AUGUST 17, 2004

CONSTRUCTION COMPLETE: OCTOBER 29, 2004

RECORD PLANS BY: K. LOCKE & E. FOSTER

I HEREBY CERTIFY THAT ALL THE CONSTRUCTION REQUIRED BY THIS SET OF DRAWINGS HAS BEEN ACCOMPLISHED AS INDICATED HEREIN.

BY: *[Signature]* RESIDENT ENGINEER

DATE: Jan 17, 06

NOTE: Any further information concerning final quantities, amounts or other details relative to this project may be found at Central Files in the electronic archives.

**CONVENTIONAL SYMBOLS**

COUNTY LINE	
TOWN LINE	
LIMITS OF ACCESS	
POINT OF ACCESS	
FENCE LINE	
STONE WALL	
TRAVELED WAY	
GUARD RAIL	
RAILROAD	
SURVEY LINE	
CULVERT	
POWER POLE	
TELEPHONE POLE	
TREES	
CONTROL OF ACCESS	
PROPERTY LINE	
R.O.W. TAKING LINE	
SLOPE RIGHTS	
TOP OF CUT	
TOE OF SLOPE	

SURVEYED BY :

SURVEYED DATE :

DATUM

VERTICAL N/A

HORIZONTAL N/A

THESE PLANS ARE SUBJECT TO SUCH ENGINEERING CHANGES AS MAY BE REQUIRED BY THE FEDERAL HIGHWAY ADMINISTRATION OR THE DIRECTOR OF PROGRAM DEVELOPMENT.

CONSTRUCTION IS TO BE CARRIED ON IN ACCORDANCE WITH THESE PLANS AND THE STANDARD SPECIFICATIONS FOR CONSTRUCTION DATED 2001, AS APPROVED BY THE FEDERAL HIGHWAY ADMINISTRATION ON JANUARY 4, 2001 FOR USE ON THIS PROJECT, INCLUDING ALL SUBSEQUENT REVISIONS AND SUCH REVISED SPECIFICATIONS AND SPECIAL PROVISIONS AS ARE INCORPORATED IN THESE PLANS.


**Metric**

UNLESS NOTED OTHERWISE  
STATIONS ARE IN KILOMETERS  
ELEVATIONS ARE IN METERS  
DIMENSIONS ARE IN MILLIMETERS

DEPARTMENT OF TRANSPORTATION FEDERAL HIGHWAY ADMINISTRATOR
APPROVED _____ DATE _____
DIRECTOR OF PROGRAM DEVELOPMENT
APPROVED <i>[Signature]</i> DATE 5/11/04
PROJECT MANAGER : WOOLAVER
PROJECT NAME : CAMBRIDGE
PROJECT NUMBER: C-STP 2218 (1) S
SHEET 1 OF 28 SHEETS


### NOTES

1. THE WEARING COURSE SHALL BE TYPE IV MEDIUM DUTY BITUMINOUS CONCRETE PAVEMENT. THE LEVELING COURSE SHALL BE TYPE ~~III~~ UNLESS OTHERWISE DIRECTED BY THE RESIDENT ENGINEER. ALL ASPHALT CEMENT USED IN THE MEDIUM DUTY BITUMINOUS CONCRETE PAVEMENT SHALL BE PG 58-34.
2. EMULSIFIED ASPHALT SHALL BE APPLIED ON ALL EXISTING PAVEMENT SURFACES, ON ALL COLD PLANED SURFACES AND BETWEEN ALL COURSES OF PAVEMENT AT THE RATE OF 0.12 L/m<sup>2</sup> OR AS DIRECTED BY THE RESIDENT ENGINEER.
3. MEDIUM DUTY BITUMINOUS CONCRETE PAVEMENT TOLERANCE = 5 mm (TOTAL PAVEMENT THICKNESS EXCLUDING LEVELING).
4. ALL DRIVEWAYS, MAILBOX TURNOUTS AND GRAVEL PULLOUTS SHALL RECEIVE A PAVED APRON AS DIRECTED BY THE RESIDENT ENGINEER. ALL MAILBOX TURNOUTS SHALL HAVE THE EXISTING EDGE OF PAVEMENT BACKED-UP WITH COLD PLANE GRINDINGS PRIOR TO THE PLACEMENT OF THE PAVED APRON. ALL GRAVEL PULLOUTS SHALL HAVE 100 mm OF COLD PLANE GRINDINGS PLACED ON THE EXISTING SURFACE AND COMPACTED. THE CONTRACTOR SHALL COMPLETE THIS WORK USING COLD PLANE GRINDINGS PRODUCED DURING THE CONSTRUCTION OF THIS PROJECT. COMPENSATION FOR THIS WORK SHALL BE MADE UNDER THE APPROPRIATE EQUIPMENT RENTAL ITEM(S).
5. EARTH BORROW SHALL BE USED FOR THE PROVISION OF CONSTRUCTING END SECTION FLARES WHICH SHALL BE CAPPED WITH AN ESTIMATED 75 mm DEPTH OF AGGREGATE SHOULDER MATERIAL UNLESS OTHERWISE DIRECTED BY THE RESIDENT ENGINEER. THE QUANTITIES INCLUDED REFLECT 20 m<sup>3</sup> OF EARTH BORROW AND 5 TONS OF AGGREGATE SHOULDER MATERIAL FOR EACH GUARDRAIL TERMINAL.
6. GRASS GROWING ADJACENT TO PAVEMENT OR THROUGH CRACKS IN THE PAVEMENT WHICH MAY HAMPER THE PLACEMENT OF NEW BITUMINOUS CONCRETE SHALL BE REMOVED BY THE CONTRACTOR AS DIRECTED BY THE RESIDENT ENGINEER. PAYMENT FOR THIS WORK WILL NOT BE MADE DIRECTLY BUT WILL BE CONSIDERED INCIDENTAL TO ITEM 406.27 MEDIUM DUTY BITUMINOUS CONCRETE PAVEMENT (PG 58-34).
7. THE PROPOSED GUARDRAIL SHALL BE INSTALLED IN A LOCATION THAT MAXIMIZES THE DISTANCE FROM THE CENTER OF THE ROAD TO THE FACE OF GUARDRAIL. 1.0 m OF BACKING IS REQUIRED BEHIND THE FACE OF GUARDRAIL WITH 1.8 m POSTS. IF THIS CANNOT BE OBTAINED, THEN 2.4 m POSTS SHALL BE USED.
8. FIFTY (50) SERVICABLE AND UNDAMAGED 3.8 M STEEL BEAM GUARD RAIL PANELS THAT ARE REMOVED FROM THE PROJECT SHALL REMAIN THE PROPERTY OF THE STATE OF VERMONT. THE CONTRACTOR SHALL LOAD THESE PANELS ONTO SUITABLE TRANSPORT AND DELIVER THEM TO THE STATE OF VERMONT MAINTENANCE FACILITY ON VT RTE 15 IN CAMBRIDGE. THE CONTRACTOR SHALL CONTACT MARK LEHOULLIER AT (802) 644 2023 AT LEAST TWO WEEKS PRIOR TO DELIVERY TO COORDINATE ACCESS ETC. THE STATE OF VERMONT WILL PROVIDE THE LOCATION, EQUIPMENT, AND PERSONNEL TO STOCKPILE THESE MATERIALS. ALL COSTS WILL NOT BE PAID DIRECTLY BUT WILL BE CONSIDERED INCIDENTAL TO THE ITEM UNDER WHICH THEY WERE REMOVED.
9. THE PAVING/COLD PLANE LIMIT FOR ALL INTERSECTING TOWN HIGHWAYS THAT ARE PAVED SHALL BE 8 METERS FROM THE OUTSIDE EDGE OF THE HIGHWAY SHOULDER OR AS DIRECTED BY THE ENGINEER.

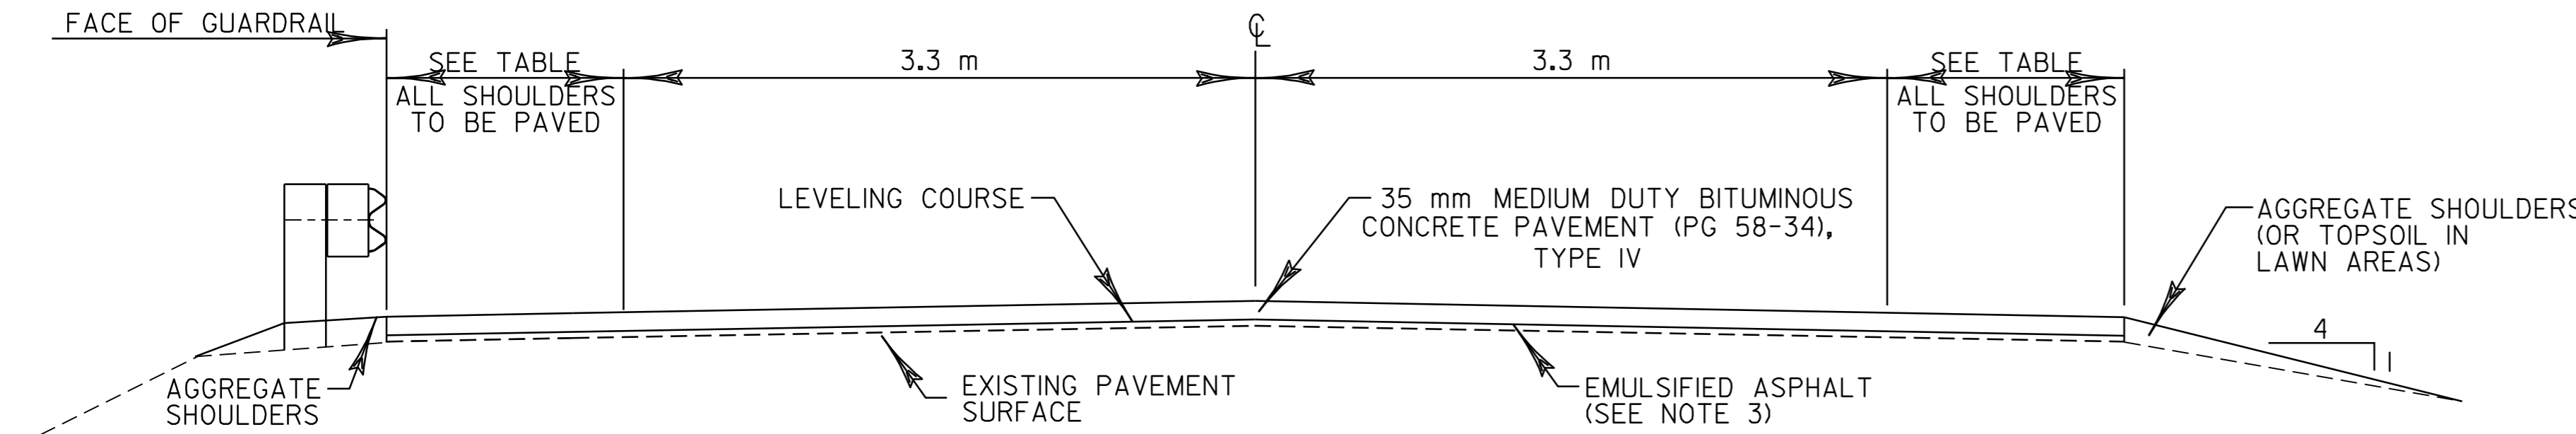


### OVERLAY TYPICAL SECTION

VT ROUTE 108 STA. 3+513.198 TO STA. 13+244.901 ~~11+800.000~~  
 VT ROUTE 108 STA. 12+200.000 TO STA. 13+244.901

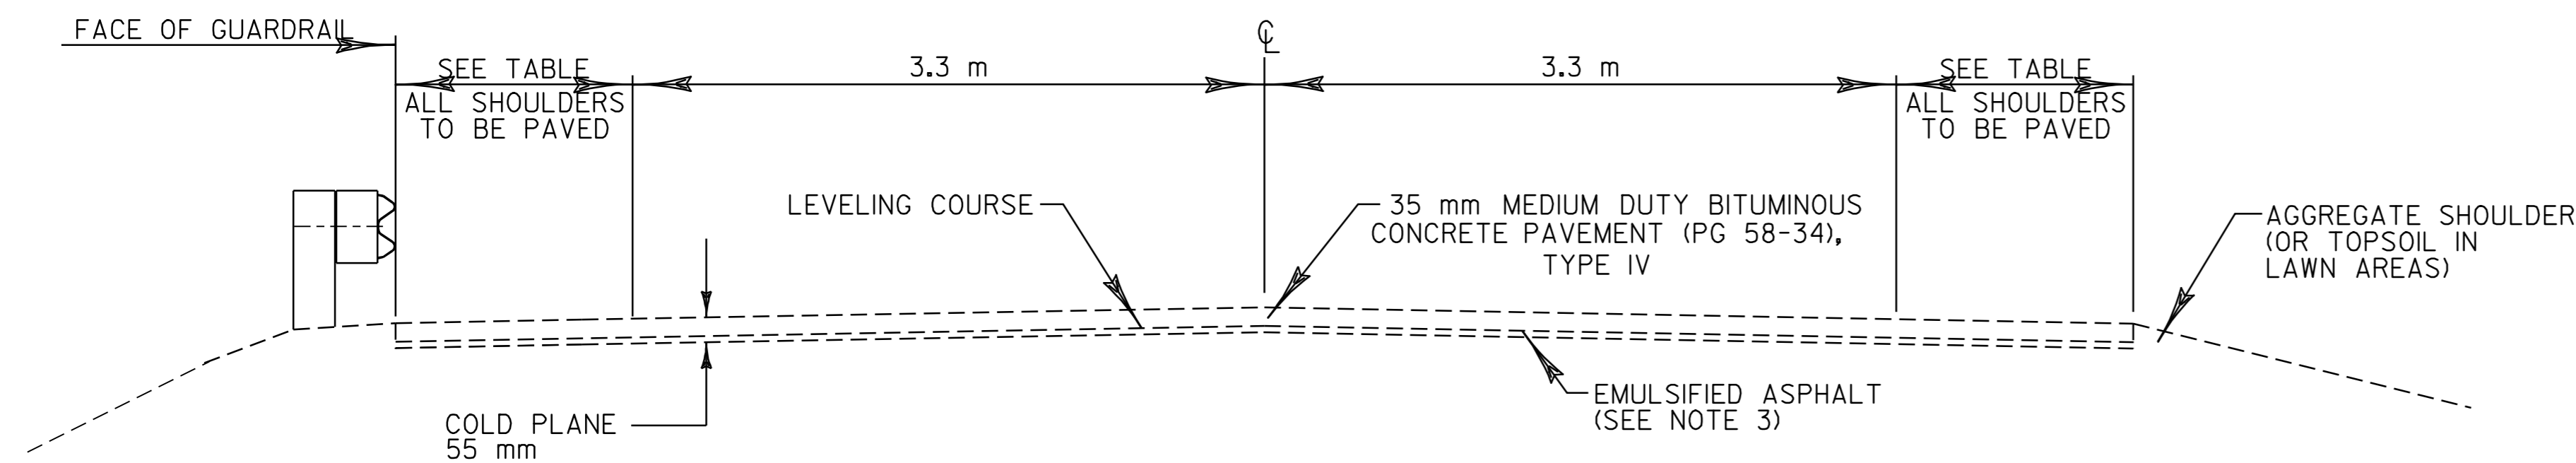


### COLD PLANE TYPICAL SECTION

VT ROUTE 108 STA. 13+244.901 TO STA. 14+583.875  
 VT ROUTE 108 APPROACH STA. 0+000.000 TO STA. 0+439.351  
 VT ROUTE 108 STA. 11+800.000 TO STA. 12+200.000

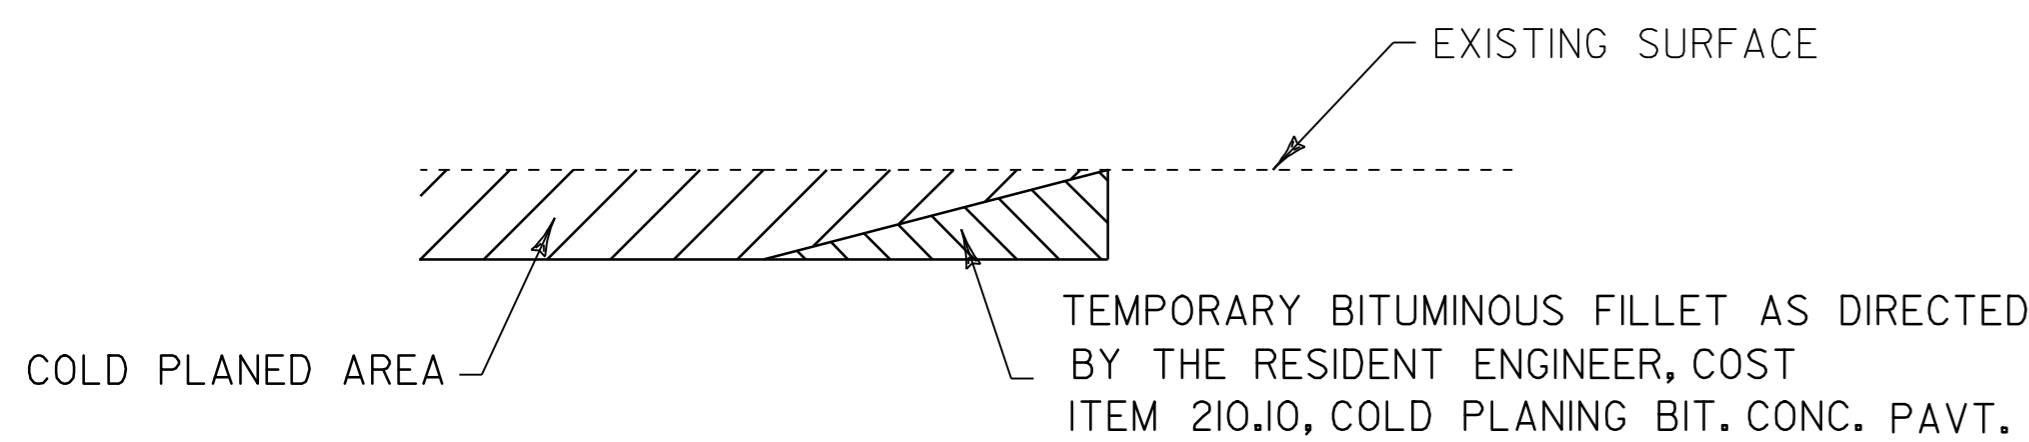

### DETAIL AT VERTICAL COLD PLANE JOINTS

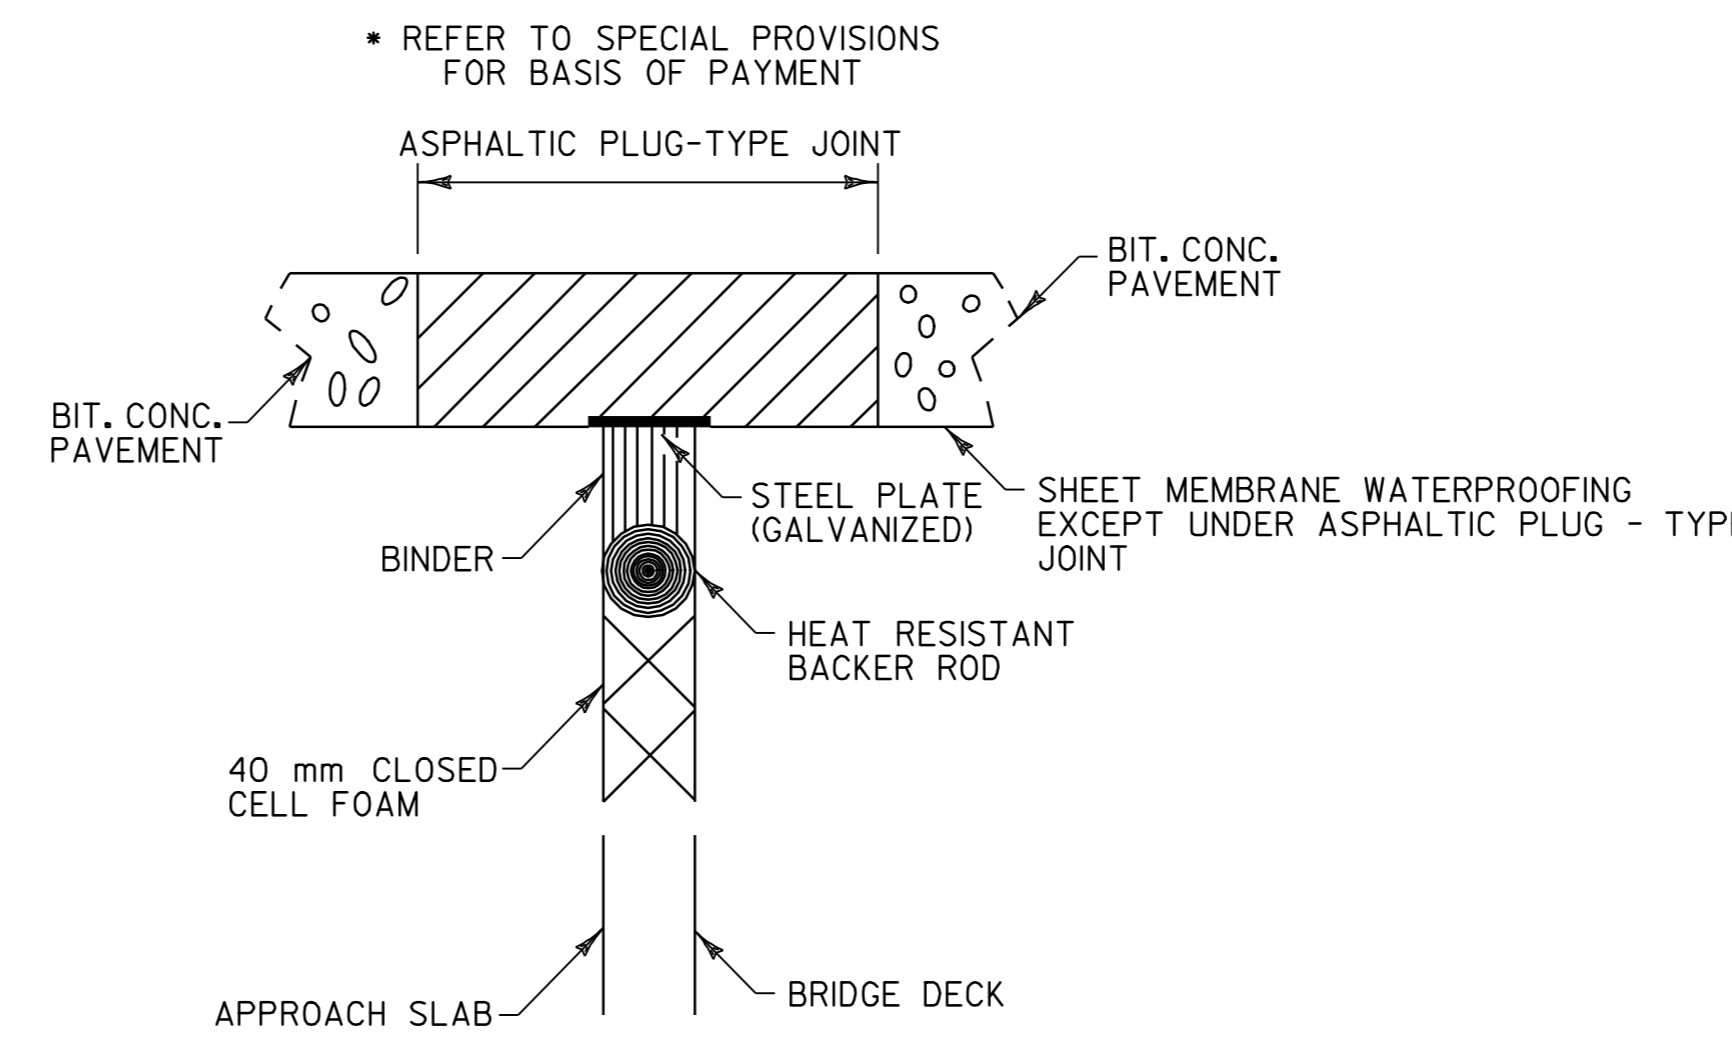

### ASPHALTIC PLUG JOINT DETAIL

BRIDGE 17 CAMBRIDGE STA. 6+405.98 - ONE AT SOUTHERN ABUTMENT

### CONSERVATION SEED MIX

		RURAL AREA - SEED MIXTURE		
% WT.	kg/ha.	NAME	PUR. %	GERM. %
37.14	26.0	CREEPING RED FESCUE	98	85
37.14	26.0	TALL FESCUE	95	90
5.71	4.0	RED TOP	95	90
14.30	10.0	BIRDSFOOT TREFOL	98	85
5.71	4.0	ANNUAL RYEGRASS	95	85
100.0	70.0			

SEED MIXTURE:  
 SHALL NOT HAVE A WEED CONTENT EXCEEDING 0.40% BY WEIGHT AND SHALL BE FREE OF ALL NOXIOUS WEED SEED.

SEED:  
 TO BE APPLIED PER SEEDING FORMULA DIRECTED BY THE RESIDENT ENGINEER

FERTILIZER:  
 FORMULA 10-20-10 TO BE USED WITH SEED, APPLIED AT THE RATE OF 560 kg/ha (HYDRO SEEDERS MAY USE 19-19-19 FORMULA)

AGRICULTURAL LIMESTONE:  
 TO BE APPLIED AT THE RATE OF 4.5 tons/ha OR AS DIRECTED BY THE RESIDENT ENGINEER.

HAY MULCH:  
 TO BE APPLIED ON EARTH SLOPES AT THE RATE OF 4.5 tons/ha, OR AS DIRECTED BY THE RESIDENT ENGINEER.

TOPSOIL:  
 TO BE USED WITH SEED AS INDICATED ON THE PLANS OR AS DIRECTED BY THE RESIDENT ENGINEER.


### PROJECT PAVING LIMITS

TOWN & ROUTE	BEGIN STATION	END STATION	LANE TYPICAL	WEARING DEPTH	LEVELING †	NOTES
CAMBRIDGE VT. RTE 108 APPR.	0+000.000	0+439.351	1.8 m - 3.3 m - 3.3 m - 1.8 m	35 mm	272	COLD PLANE 55 mm, LEVEL WITH 20 mm TYPE <del>IV</del> & PAVE WITH 35 mm TYPE IV
CAMBRIDGE VT. RTE 108	3+513.198	13+244.901	0.8 m - 3.3 m - 3.3 m - 0.8 m	35 mm	4597	LEVEL WITH 20 mm TYPE <del>IV</del> & PAVE WITH 35 mm TYPE IV
CAMBRIDGE VT. RTE 108	13+244.901	14+001.292	0.8 m - 3.3 m - 3.3 m - 0.8 m	35 mm	358	COLD PLANE 55 mm, LEVEL WITH 20 mm TYPE <del>IV</del> & PAVE WITH 35 mm TYPE IV
CAMBRIDGE VT. RTE 108	14+001.292	14+583.875	1.8 m - 3.3 m - 3.3 m - 1.8 m	35 mm	342	COLD PLANE 55 mm, LEVEL WITH 20 mm TYPE <del>IV</del> & PAVE WITH 35 mm TYPE IV


### PROJECT TYPICAL SHEET #1

SURVEYED BY	N/A	DATE	N/A
DRAWN BY	LOCKE	DATE	JAN 04
SQUAD LEADER	WOOLAYER		
DESIGN FILE NO.	/pave/99cl88/99cl88.dgn		
IPARM FILE		DATE PLOTTED	
PROJ. NAME	CAMBRIDGE		
PROJ. NO.	STP 2218(1)S		
SHEET	2	OF	28


DATUM	
VERTICAL	N/A
HORIZONTAL	N/A

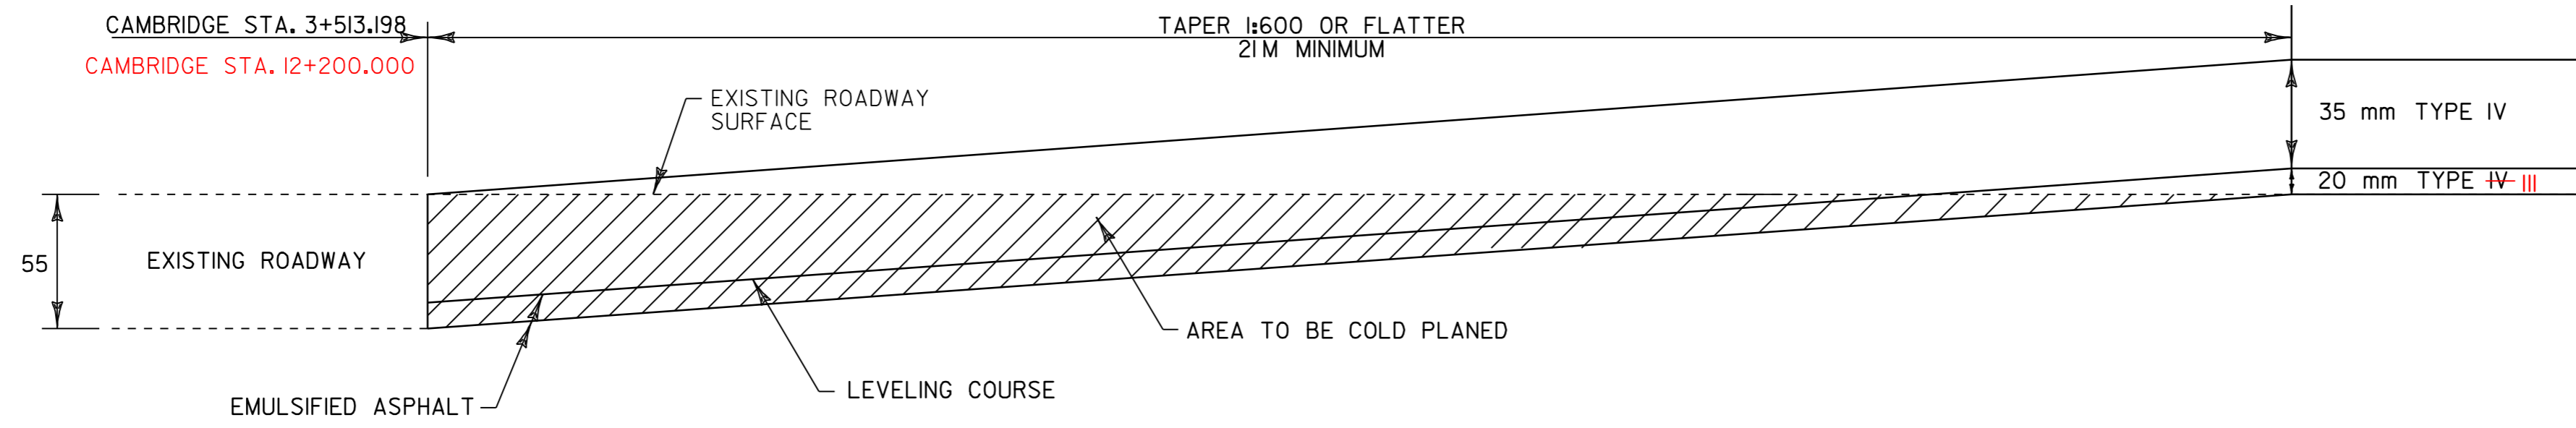

**APPROACH AREA DETAIL**  
**FULL ROADWAY WIDTH**  
 CAMBRIDGE STA. 3+513.198  
 CAMBRIDGE STA. 12+200.000

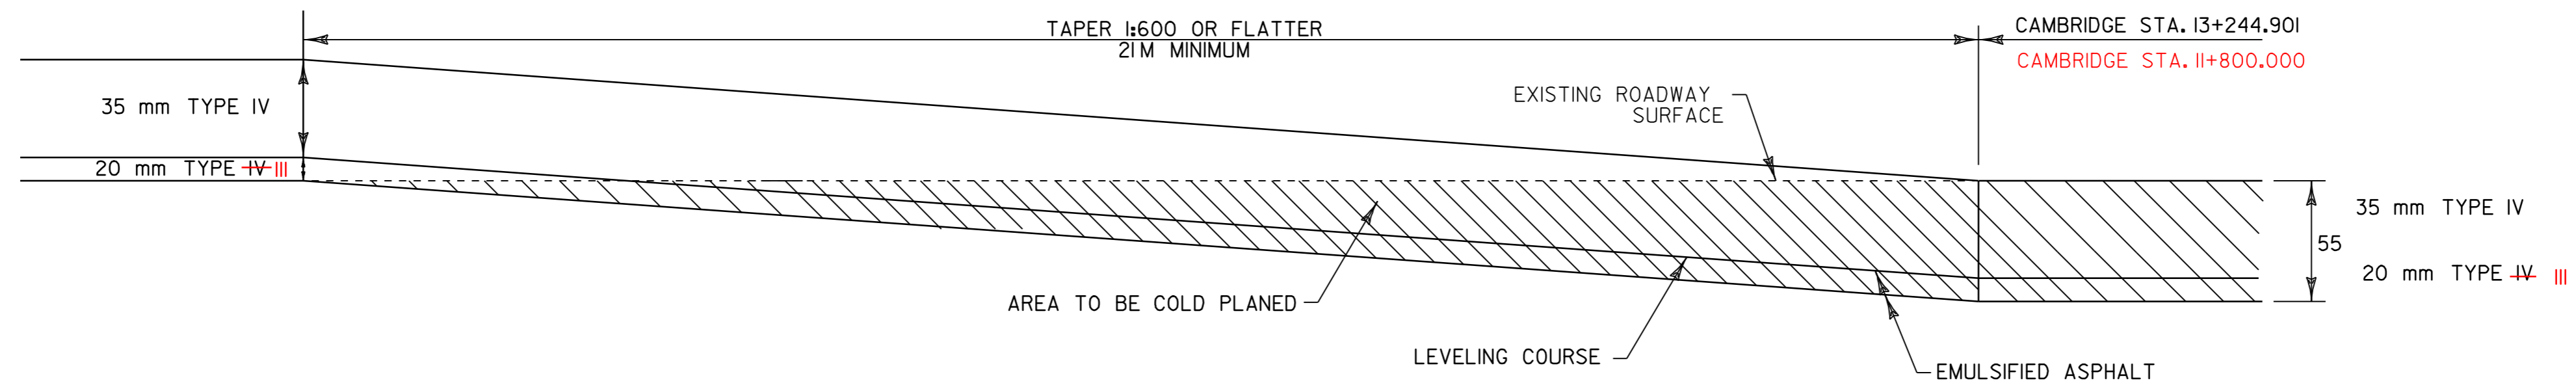

**APPROACH AREA DETAIL**  
**FULL ROADWAY WIDTH**  
 CAMBRIDGE STA. 13+244.901  
 CAMBRIDGE STA. 11+800.000

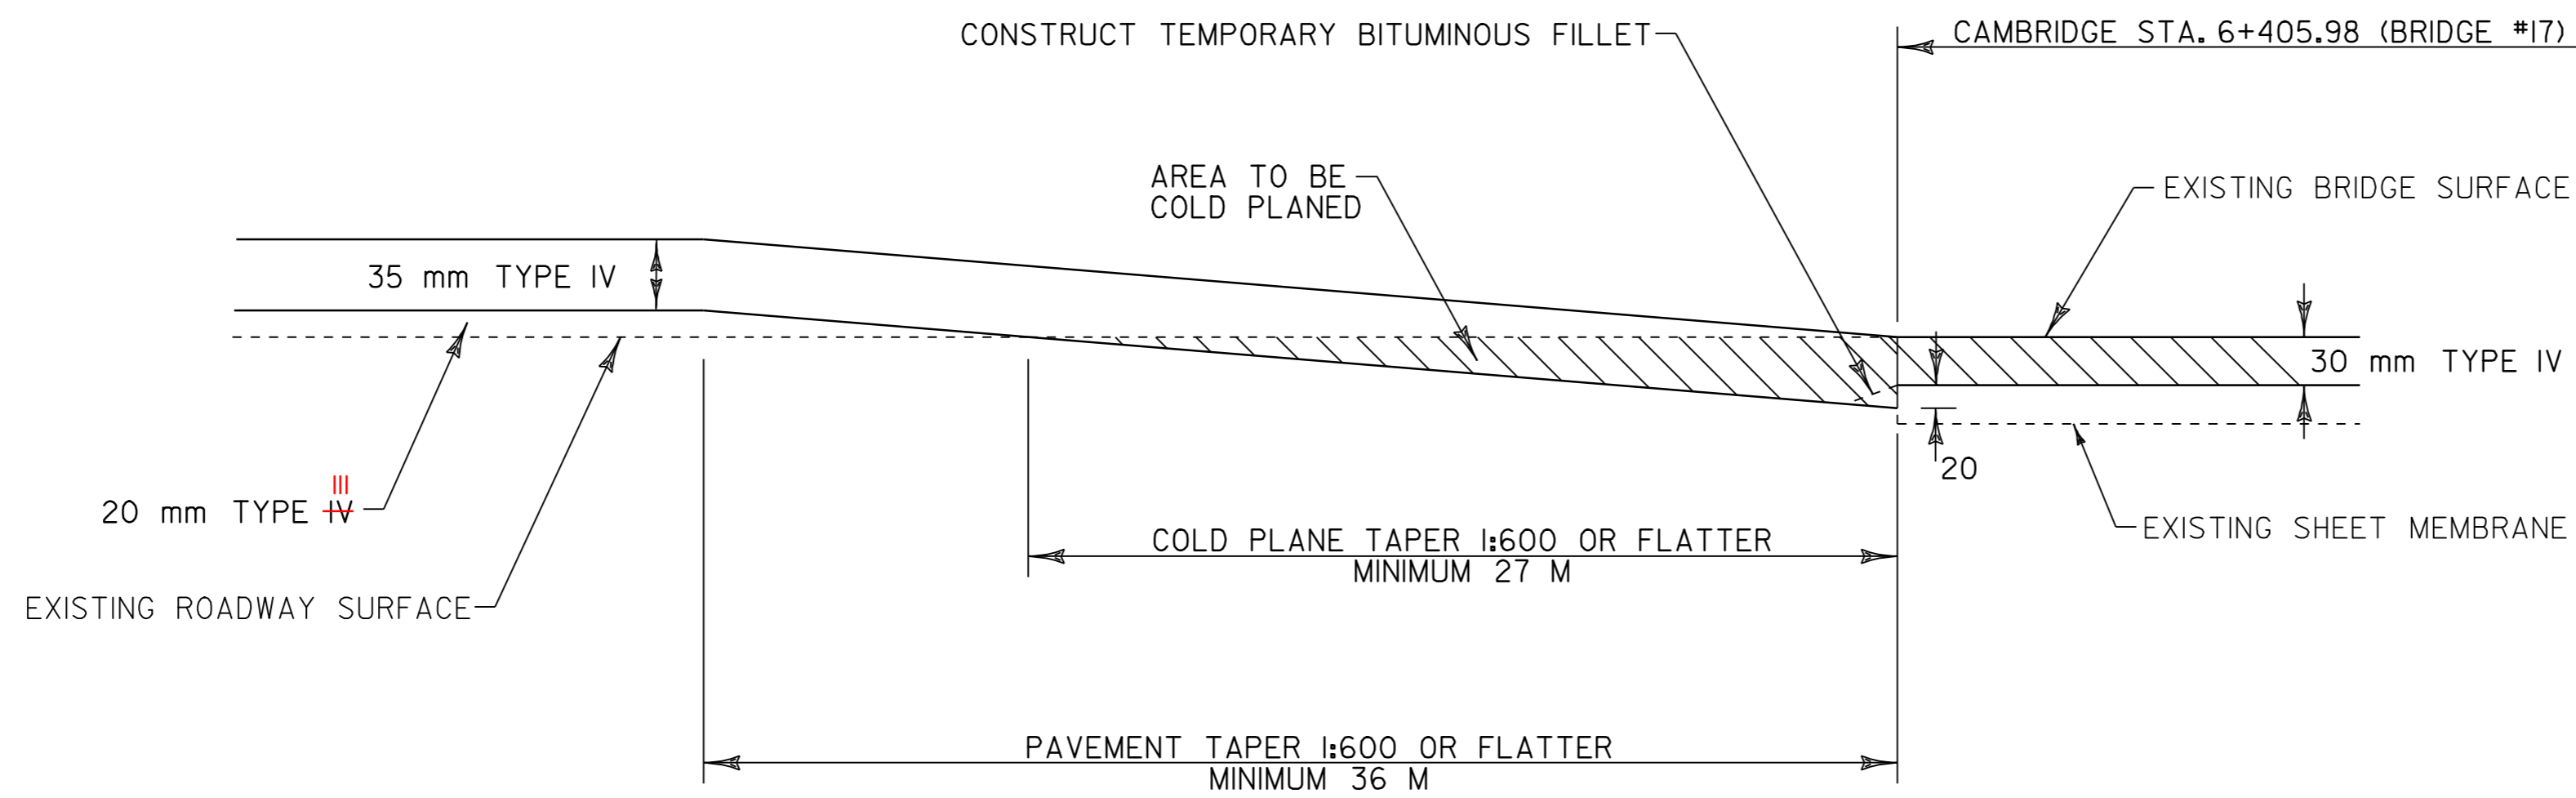

**TRANSITION AREA DETAIL**  
**(LEVELING AND OVERLAY TO COLD PLANING @ BRIDGE NO. 17)**  
**FULL ROADWAY WIDTH**  
 CAMBRIDGE STA. 6+405.98 (BRIDGE #17)

DATUM	
VERTICAL	N/A
HORIZONTAL	N/A

<b>PROJECT TYPICAL SHEET #2</b>	SURVEYED BY <u>N/A</u> DATE <u>N/A</u>
	DRAWN BY <u>LOCKE</u> DATE <u>JAN 04</u>
	SQUAD LEADER <u>WOOLAVER</u>
	DESIGN FILE NO. <u>/pave/99cl88/99cl88.dgn</u>
	IPARM _____ DATE PLOTTED _____
PROJ. NAME <u>CAMBRIDGE</u>	
PROJ. NO. <u>STP 2218(I)S</u>	
SHEET <u>3</u> OF <u>28</u>	

### SUMMARY OF ESTIMATED QUANTITIES

				NON GOVT PARTICIPATING	BRIDGE	ROADWAY	QUANTITIES GRAND TOTAL	UNIT	ITEMS	ITEM NUMBER	RND
						1080	1080	CM	EARTH BORROW	203.30	
						I	I	CM	TRENCH EXCAVATION OF EARTH (MOD. - EXPLORATORY) (N.A.B.I.)	204.20	
						19,618.5	19,618.5				
						16,650	16,650	SM	COLD PLANING - BITUMINOUS PAVEMENT	210.10	-9-
						985	985	T	AGGREGATE SHOULDERS	402.12	
						2195	2195	T	AGGREGATE SHOULDERS (MOD.)	402.12	
						22,932	22,932	KG	EMULSIFIED ASPHALT	404.65	
						14,000	14,000	T	MEDIUM DUTY BITUMINOUS CONCRETE PAVEMENT (PG 58-34)	406.27	
						I	I	LU	PRICE ADJUSTMENT ASPHALT CEMENT (N.A.B.I.)	406.50	
					10		-10- II	M	BRIDGE EXPANSION JOINT (ASPHALTIC PLUG TYPE)	516.10	1.8
					35		35	M	BRIDGE RAIL - H.D. STEEL BEAM/FASCIA MOUNTED (MOD. I)	525.41	
						-22- 23	-22- 23	EA	REHABING D.I., C.B., OR M.H., CLASS I	604.412	
				20		20	20	EA	CHANGING ELEVATION OF SEWER MANHOLE	604.42	EST
						175	175	HR	POWER GRADER RENTAL	608.15	EST
						175	175	HR	ALL PURPOSE EXCAVATOR RENTAL, TYPE I	608.25	EST
						115	115	HR	POWER BROOM RENTAL	608.30	EST
						175	175	HR	POWER BROOM RENTAL, TYPE II	608.31	EST
						175	175	HR	TRUCK RENTAL	608.37	EST
						175	175	HR	LOADER RENTAL, TYPE I	608.40	EST
						18,975.0	18,975.0	CM	DUST CONTROL W/WATER	609.10	
						2403.1	2403.1				
						1750-	1750-	CM	STONE FILL, TYPE I	613.10	
						100- 14	100- 14	CM	STONE FILL, TYPE II	613.11	EST
						285-130	285-130	M	TREATED TIMBER CURB	616.35	2
						3- 2	3- 2	EA	RELOCATE MAIL BOX, SINGLE SUPPORT	617.10	
						3- 2	3- 2	EA	RELOCATE MAIL BOX, MULTIPLE SUPPORT	617.12	
				2407.8	2407.8	2340-	2340-	M	STEEL BEAM GUARD RAIL	621.20	4
				2787.4	2787.4	2630-	2630-	M	STEEL BEAM GUARD RAIL (MOD. - W/2.4 M POSTS)	621.20	3
						53- 33	53- 33	EA	MANUFACTURED TERMINAL SECTION (FLARED)	621.505	
						4	4	EA	TERMINAL CONNECTOR FOR STEEL BEAM GUARD RAIL	621.53	
						-11- 29	-11- 29	EA	ANCHOR FOR STEEL BEAM GUARD RAIL	621.60	
						5670	5670				
						5505-	5505-	M	REMOVAL AND DISPOSAL OF GUARD RAIL	621.80	1
				-11- 9		-11- 9	-11- 9	EA	ADJUST ELEVATION OF VALVE BOX	629.20	EST
						690- 0	690- 0	HR	UNIFORMED TRAFFIC OFFICERS	630.10	
						1500	1500	HR	FLAGGERS	630.15	
						I	I	LS	TESTING EQUIPMENT - BITUMINOUS (MOD.)	631.17	
						I	I	LS	MOBILIZATION	635.10	
						I	I	LS	TRAFFIC CONTROL	641.10	

### DETAILED SUMMARY OF QUANTITIES

QUANTITIES	UNIT	ITEMS
		MEDIUM DUTY BITUMINOUS CONCRETE PAVEMENT (PG 58-34)
5563	T	LEVELING COURSE TYPE III
8053	T	WEARING COURSE TYPE IV
384	T	ROUNDING
14,000	T	TOTAL

### DETAILED SUMMARY OF QUANTITIES

QUANTITIES	UNIT	ITEMS
------------	------	-------

PROJECT NAME: CAMBRIDGE  
 PROJECT NUMBER: STP 2218 (1) S  
 FILE NAME: \_/pave/99cl88/99cl88.dgn PLOT DATE: 14-FEB-2006 16:4  
 PROJECT LEADER: WOOLAYER DRAWN BY: LOCKE  
 DESIGNED BY: LOCKE CHECKED BY: PAVT MGMT  
 RECORDED BY: LOCKE SHEET 4 OF 28




# ITEM DETAIL SUMMARY SHEET



STATION		POS.	203.15	203.16	203.30	301.28	402.12 (MOD.)	NEW PIPE			GRATE TYPE	604.40	604.412	616.35	525.41	616.47	501.25	507.15	621.20	621.20	621.505	621.60	621.53	621.80	REMARKS	
BEGIN	END		COMMON EXCAV. m³	SOLID ROCK EXCAV. m³	EARTH BORROW m³	SUBBASE OF CR. GRAVEL T	AGGREGATE SHOULDERS T	D	L	TH/CL		EA	EA	REHAB DI CLASS I EA	TREATED TIMBER CURB M	BRIDGE RAIL-H.D. STEEL BEAM FASCIA MTD (MOD. I) EA	BIT. CONC. GUTTERS & TRAFFIC ISLANDS T	CONC. CLASS B m³	REINF. STEEL KG	STEEL BEAM G.R. M	STEEL BEAM G.R. (MOD) M	MANUFACT. TERMINAL SECTION EA	ANCHOR FOR STEEL BEAM RAIL EA	TERMINAL CONNECTOR FOR STEEL BEAM GUARD RAIL EA		REMOVAL AND DISPOSAL OF G.R. M
3+476.18	3+871.05	LT			40-		10												372-416.5		2	2		395-418	REMOVE AND DISPOSE EXISTING GUARD RAIL, INSTALL NEW STEEL BEAM GUARD RAIL, INSTALL NEW MTS(FLARED) AT STA. 3+476.18 LT & STA. 3+871.05 LT. USED GI-d & ANCHOR	
3+911.85	4+056.01	LT			40-		10												143-146		2	2		145-148	REMOVE AND DISPOSE EXISTING GUARD RAIL, INSTALL NEW STEEL BEAM GUARD RAIL, INSTALL NEW MTS(FLARED) AT STA. 3+911.85 LT & STA. 4+056.01 LT. USED GI-d & ANCHOR	
4+200.88	4+353.36	LT			40-		10						130-153						130-129.5		2			153-155	REMOVE AND DISPOSE EXISTING GUARD RAIL, INSTALL NEW STEEL BEAM GUARD RAIL, INSTALL NEW MTS(FLARED) AT STA. 4+200.88 LT & STA. 4+353.36 LT.	
4+208.82	4+298.00	RT			20-		5												76-92		1	2		89-107	REMOVE AND DISPOSE EXISTING GUARD RAIL, INSTALL NEW STEEL BEAM GUARD RAIL, INSTALL NEW MTS(FLARED) AT STA. 4+208.82 RT, (2) 4.8 m RADIUS PANELS & (2) ANCHORS @ STA. 4+298 RT	
4+692.22	4+845.63	LT			40-		10												131-129.5		2			154-156	REMOVE AND DISPOSE EXISTING GUARD RAIL, INSTALL NEW STEEL BEAM GUARD RAIL, INSTALL NEW MTS(FLARED) AT STA. 4+692.22 LT & STA. 4+845.63 LT.	
4+740.57	4+788.72	RT			40-		10												25-22.9		2			48-47	REMOVE AND DISPOSE EXISTING GUARD RAIL, INSTALL NEW STEEL BEAM GUARD RAIL, INSTALL NEW MTS(FLARED) AT STA. 4+740.57 RT & STA. 4+788.72 RT.	
5+014.18	5+093.66	LT			40-		10												57-57.2		2			80-85	REMOVE AND DISPOSE EXISTING GUARD RAIL, INSTALL NEW STEEL BEAM GUARD RAIL, INSTALL NEW MTS(FLARED) AT STA. 5+014.18 LT & STA. 5+093.66 LT.	
5+730.82	6+157.35	RT			40-		10														2	2		427-428	REMOVE AND DISPOSE EXISTING GUARD RAIL, INSTALL NEW STEEL BEAM GUARD RAIL, INSTALL NEW MTS(FLARED) AT STA. 5+730.82 RT & STA. 6+157.35 RT. USED GI-d & ANCHOR	
6+220.86	6+308.84	RT			40-		10												42-62	23	2	2		88-86	REMOVE AND DISPOSE EXISTING GUARD RAIL, INSTALL NEW STEEL BEAM GUARD RAIL, INSTALL NEW MTS(FLARED) AT STA. 6+220.86 RT & STA. 6+308.84 RT. USED GI-d & ANCHOR	
6+228.99	6+316.98	LT			40-		10																	88-82	REMOVE AND DISPOSE EXISTING GUARD RAIL, INSTALL NEW STEEL BEAM GUARD RAIL, INSTALL NEW MTS(FLARED) AT STA. 6+228.99 LT & STA. 6+316.98 LT. USED GI-d & ANCHOR	
6+333.29	6+382.20	LT			20-		5												42-42.5		+	1	1		49-55	REMOVE AND DISPOSE EXISTING GUARD RAIL, INSTALL NEW STEEL BEAM GUARD RAIL, INSTALL NEW MTS(FLARED) AT STA. 6+333.29 LT. USED GI-d & ANCHOR
6+349.58	6+390.38	RT			20-		5												33-34.9		+	1	1		4-48	REMOVE AND DISPOSE EXISTING GUARD RAIL, INSTALL NEW STEEL BEAM GUARD RAIL, INSTALL NEW MTS(FLARED) AT STA. 6+349.58 RT. USED GI-d & ANCHOR
6+414.74	6+422.89	LT			20-		5												# 15.8			2	1		12-17	REMOVE AND DISPOSE EXISTING GUARD RAIL, INSTALL NEW STEEL BEAM GUARD RAIL, INSTALL (2) 4.8 M RADIUS PANELS & (2) ANCHORS AT STA. 6+422.89 LT
6+422.89	6+453.73	RT			20-		5												24-27.3		+	1	1		31-40	REMOVE AND DISPOSE EXISTING GUARD RAIL, INSTALL NEW STEEL BEAM GUARD RAIL, INSTALL NEW MTS(FLARED) AT STA. 6+453.73 RT. USED GI-d & ANCHOR
6+888.32	7+081.91	RT			40-		10												17-175.3		2			194-201	REMOVE AND DISPOSE EXISTING GUARD RAIL, INSTALL NEW STEEL BEAM GUARD RAIL, INSTALL NEW MTS(FLARED) AT STA. 6+888.32 RT & STA. 7+081.91 RT.	
7+226.91	7+838.04	RT			20-		5												264.8-247	353	1	2		61-638	REMOVE AND DISPOSE EXISTING GUARD RAIL, INSTALL NEW STEEL BEAM GUARD RAIL, INSTALL NEW MTS(FLARED) AT STA. 7+838.04 RT, (2) 4.8 m RADIUS PANELS & (2) ANCHORS @ STA. 7+226.91 RT	
7+853.60	8+039.42	RT			40-		10												163-167.6		2			186-194	REMOVE AND DISPOSE EXISTING GUARD RAIL, INSTALL NEW STEEL BEAM GUARD RAIL, INSTALL NEW MTS(FLARED) AT STA. 7+853.60 RT & STA. 8+039.42 RT.	
8+039.42	8+183.97	LT			40-		10														2			146-150	REMOVE AND DISPOSE EXISTING GUARD RAIL, INSTALL NEW STEEL BEAM GUARD RAIL, INSTALL NEW MTS(FLARED) AT STA. 8+039.42 LT & STA. 8+183.97 LT.	
8+578.63	8+896.23	RT			40-		10															1		318-328	REMOVE AND DISPOSE EXISTING GUARD RAIL, INSTALL NEW STEEL BEAM GUARD RAIL, INSTALL NEW MTS(FLARED) AT STA. 8+578.63 RT & STA. 8+896.23 RT. (1) ANCHOR AT 8+896.23 RT	
9+329.02	9+527.72	RT			20-		5												199-161.2		+	2-3		199-163	REMOVE AND DISPOSE EXISTING GUARD RAIL, INSTALL NEW STEEL BEAM GUARD RAIL & NEW MTS(FLARED) AT STA. 9+527.72 RT, (2) 4.8 m RADIUS PANELS & (2) ANCHORS @ STA. 9+329.02 RT	
9+552.70	9+712.95	RT			40-		10												122-110	27	2			160-162	REMOVE AND DISPOSE EXISTING GUARD RAIL, INSTALL NEW STEEL BEAM GUARD RAIL, INSTALL NEW MTS(FLARED) AT STA. 9+552.70 RT & STA. 9+712.95 RT.	
9+945.98	10+324.81	RT			40-		10												48-					379-385	REMOVE AND DISPOSE EXISTING GUARD RAIL, INSTALL NEW STEEL BEAM GUARD RAIL, INSTALL NEW MTS(FLARED) AT STA. 9+945.98 RT & STA. 10+324.81 RT.	
10+509.37	10+695.51	RT			40-		10												82-					186-	REMOVE AND DISPOSE EXISTING GUARD RAIL, INSTALL NEW STEEL BEAM GUARD RAIL, INSTALL NEW MTS(FLARED) AT STA. 10+509.37 RT & STA. 10+695.51 RT.	
10+742.59	11+032.41	RT			20-		5														1	1		290-316	REMOVE AND DISPOSE EXISTING GUARD RAIL, INSTALL NEW STEEL BEAM GUARD RAIL, INSTALL NEW MTS(FLARED) AT STA. 10+742.59 RT. NEW ANCHOR AT STA. 11+032.41 RT	
11+048.30	11+112.81	RT			40-		10												27-31	15-16	2			65-71	REMOVE AND DISPOSE EXISTING GUARD RAIL, INSTALL NEW STEEL BEAM GUARD RAIL, INSTALL NEW MTS(FLARED) AT STA. 11+048.30 RT & STA. 11+112.81 RT. MTS (TANGENT) @ 11+112.81 RT	
11+161.42	11+258.58	RT			40-		10																	97-102	REMOVE AND DISPOSE EXISTING GUARD RAIL, INSTALL NEW STEEL BEAM GUARD RAIL, INSTALL NEW MTS(FLARED) AT STA. 11+161.42 RT & STA. 11+258.58 RT.	
11+941.49	11+974.10	RT			40-		10												33-11.4		2			33-36	REMOVE AND DISPOSE EXISTING GUARD RAIL, INSTALL NEW STEEL BEAM GUARD RAIL NEW MTS(FLARED) AT STA. 11+941.49 RT & STA. 11+974.10 RT.	
11+941.49	11+982.89	LT			40-		10												41-19		2			41-48	REMOVE AND DISPOSE EXISTING GUARD RAIL, INSTALL NEW STEEL BEAM GUARD RAIL NEW MTS(FLARED) AT STA. 11+941.49 LT & STA. 11+982.89 LT.	
12+343.70	12+481.74	RT			40-		10							35					84-91.4		-2	1		138-140	REMOVE AND DISPOSE EXISTING GUARD RAIL, INSTALL NEW STEEL BEAM GUARD RAIL, INSTALL NEW MTS(FLARED) AT STA. 12+343.70 RT & (STA. 12+481.74 RT. G-ID & ANCHOR)	
12+618.32	13+213.20	RT			40-		10																	595-604	REMOVE AND DISPOSE EXISTING GUARD RAIL, INSTALL NEW STEEL BEAM GUARD RAIL, INSTALL NEW MTS(FLARED) AT STA. 12+618.32 RT & (STA. 13+213.20 RT. G-ID & ANCHOR)	
13+325.62	13+342.87	RT																						17-20	REMOVE AND DISPOSE EXISTING GUARD RAIL, INSTALL NEW STEEL BEAM GUARD RAIL, INSTALL (2) ANCHORS AT STA. 13+325.62 RT & STA. 13+342.87 RT.	
13+373.85	13+423.01	RT			40-		10																	49-54	REMOVE AND DISPOSE EXISTING GUARD RAIL, INSTALL NEW STEEL BEAM GUARD RAIL, INSTALL NEW MTS(FLARED) AT STA. 13+373.85 RT & STA. 13+423.01 RT.	
																			40	72			2			INSTALL NEW STEEL BEAM GUARD RAIL, INSTALL ANCHOR AT STA. 13+325.62 RT NEW G-ID AT STA. 13+423.01 RT, INSTALL ANCHOR AT STA. 13+423.01 RT
			TOTALS		1080-		270												130-283	35					5504-5670	THESE RUNS WERE CONNECTED
																			2336-2407.8	2627-2787.4	53-33	# 29	4			(1) ANCHOR AT 9+527.72

LOCATION				METERS OF DITCHING			MISC. ITEMS			REMARKS	LOCATION				METERS OF DITCHING			MISC. ITEMS			REMARKS												
SITE	STATION	STATION	POS.	PERCENT GRADE			EROS. MATT.	STONE FILL TYP. I	GEOT. UNDER STONE FILL		SITE	STATION	STATION	POS.	PERCENT GRADE			EROS. MATT.	STONE FILL TYP. I	GEOT. UNDER STONE FILL													
				0-2.5	> 2.5										0-2.5	> 2.5						0-2.5	> 2.5										
VT ROUTE 108 DISTRICT #8							m2	m3	m2								m2	m3	m2														
1	3+513.19	3+598.49	RT.	85			85			38	13+774.38	13+792.08	LT.	20			20			66	13+593	13+641	LT	48						24.5	96		
2	3+715.98	3+912.32	RT.		196			60	196	39	13+993.25	14+001.29	LT.	8			8			67	13+672	13+707	LT	35			73.7						
3	3+923.58	4+053.94	RT.	130			130			40	14+001.29	14+059.23	LT.	58			58			68	13+716	13+731	LT	15			73.7						
4	4+063.59	4+078.08	RT.		15			5	15	41	14+511.45		LT.	23			23			69	13+737	13+769	LT	32			73.7						
5	4+200.39	4+361.32	RT.		161			48	161	* AS BUILT IN THE FIELD *											70	13+784	13+821	LT	37			147					
6	4+370.98	4+552.83	RT.		182			55	182	1	3+582	3+652	RT	79				52.1	173.8	71	13+828	13+858	LT	30			147						
7	4+604.33	5+156.34	RT.		552			166	552	2	3+790	3+847	RT	57				37.6	125.4	72	13+877	13+886	LT	11			106.3						
8	5+130.59	5+165.99	LT.		35			11	35	3	3+850	3+962	RT	112				73.9	246.4	73	13+890	13+899	LT	9			106.3						
9	5+265.77	5+402.57	LT.		137			41	137	4	4+034	4+086	RT	52				34.3	114.4	74	13+969	13+974	LT	5			106.3						
10	5+471.77	5+719.61	RT.		248			74	248	5	4+089	4+162	RT	73				48.2	160.6	75	14+511		LT	4				4.8	16				
11	5+563.50	5+779.15	LT.		216			65	216	6	4+178	4+235	RT	57				37.6	125.4	76	14+525		RT	2.6				4.4	14.6				
12	5+685.81		LT.	15			15			7	4+346	4+372	RT	30				19.8	66	77	14+525		LT				106.3						
13	6+208.85	6+249.08	LT.		40			12	40	8	4+425	4+477	RT	52				37.4	124.8	SUB TOTAL				940.3	33.7	126.6							
14	6+488.88	6+773.73	LT.		285			86	285	9	4+535	4+555	RT	26				21.8	57.2	GRAND TOTAL				2230.9	2360.4	7761.6							
15	6+493.70	6+587.04	RT.	93			93			10	4+571	4+772	RT	201				132.7	442.2														
16	6+920.18	6+945.93	LT.		26			8	26	11	4+822	4+852	RT	30				19.8	60														
17	6+945.93	8+115.92	LT.		1170			350	1170	12	4+870	4+981	RT	111				76.6	222														
18	8+920.59	9+377.65	LT.		457			137	457	13	4+984	5+106	RT	122				73.2	244														
19	9+377.65	9+559.50	LT.		182			55	182	14	5+109	5+238	RT	129				77.4	258														
20	9+527.32	9+784.81	LT.		258			77	258	15	5+183	5+228	LT	45				33.8	90														
21	9+759.06	9+789.63	RT.	31			31			16	5+235	5+330	LT	95				77	190														
22	9+842.75	9+905.51	RT.	63			63			17	5+238	5+321	RT	83				49.8	166														
23	9+857.23	10+143.70	LT.		287			86	287	18	5+324	5+400	RT	76				43.3	152														
24	10+253.13	10+462.35	LT.	209			209			19	5+517	5+627	RT	110				66	220														
25	10+344.86	10+436.60	RT.	92			92			20	5+611	5+638	LT	27				21.9	54														
26	10+492.92		RT.	15			15			21	5+631	5+746	RT	115				79.4	230														
27	10+790.65	10+943.54	LT.		153			46	153	22	6+257	6+261	LT	4				2.4	8														
28	11+104.47	11+107.69	LT.	8			8			23	6+614	6+702	LT	88				52.8	176														
29	11+151.14	11+270.24	LT.	120			120			24	6+739	6+839	LT	100				60	200														
30	11+270.24	11+595.32	LT.	325			325			25	6+920	6+978	LT	58				34.8	116														
31	11+683.84	12+540.01	LT.	850			850			26	7+081	7+098	LT	17				10.2	34														
32	11+788.44	11+942.94	RT.	155			155			27	7+187	7+246	LT	59				35.4	118														
33	12+021.80	12+025.02	RT.	3			3			28	7+259	7+296	LT	37				22.2	74														
34	12+203.66	12+382.29	LT.		180			54	180	29	7+355	7+434	LT	79				47.4	158														
35	12+401.60	12+615.65	LT.	214			214			30	7+440	7+550	LT	110				66	220														
36	12+634.96	13+679.42	LT.		1045			314	1045	31	7+833	7+996	LT	163				97.8	326														
37	13+681.03	13+772.77	LT.	92			92			32	7+996	8+040	LT	44				26.4	88														
										33	8+889	9+095	LT	206				123.6	412														
										34	9+385	9+451	LT	66				39.6	132														
										35	9+656	9+675	LT	19				11.4	38														
										36	9+827	9+882	LT	55				33	110														
										37	9+895	9+911	LT	16				9.6	32														
										38	9+911	9+940	LT	29		57.4																	
										39	9+940	9+946	LT	6				3.6	12														
										40	9+971	9+983	LT	12		23.8																	
										41	9+998	10+000	LT	2				1.2	4														
										42	10+000	10+117	LT	117		388.1																	
										43	10+264	10+284	LT	20		79.2																	
										44	10+356	10+369	LT	13		51.5																	
										45	10+850	10+894	LT	44		159.3																	
										46	10+894	10+907	LT	13				7.8	26														
										47	11+600		LT			79.7																	
										48	11+899	11+954	LT	55				32.2	110														
										49	12+065	12+256	LT	191		239																	
										50	12+200	12+210	RT	10				4.8	20														
										51	12+256		LT	6.2				5.6	18.6														
										52	12+395	12+468	LT	73				50.4	146														
										53	12+509		LT	6				3.2	10.8														
										54	12+524		LT	8				4.3	14.4														
										55	12+646	12+858	LT	212				108	424														
										56	12+869	13+006	LT	137				72	274														
										57	13+000	13+013	LT	19				10.3	38														
										58	13+017	13+172	LT	155				93	310														
										59	13+176	13+269	LT	93				62.8	186														

BEGIN PROJECT STP 2218(I)S  
 STA. 3+513.198 = MM 2.183

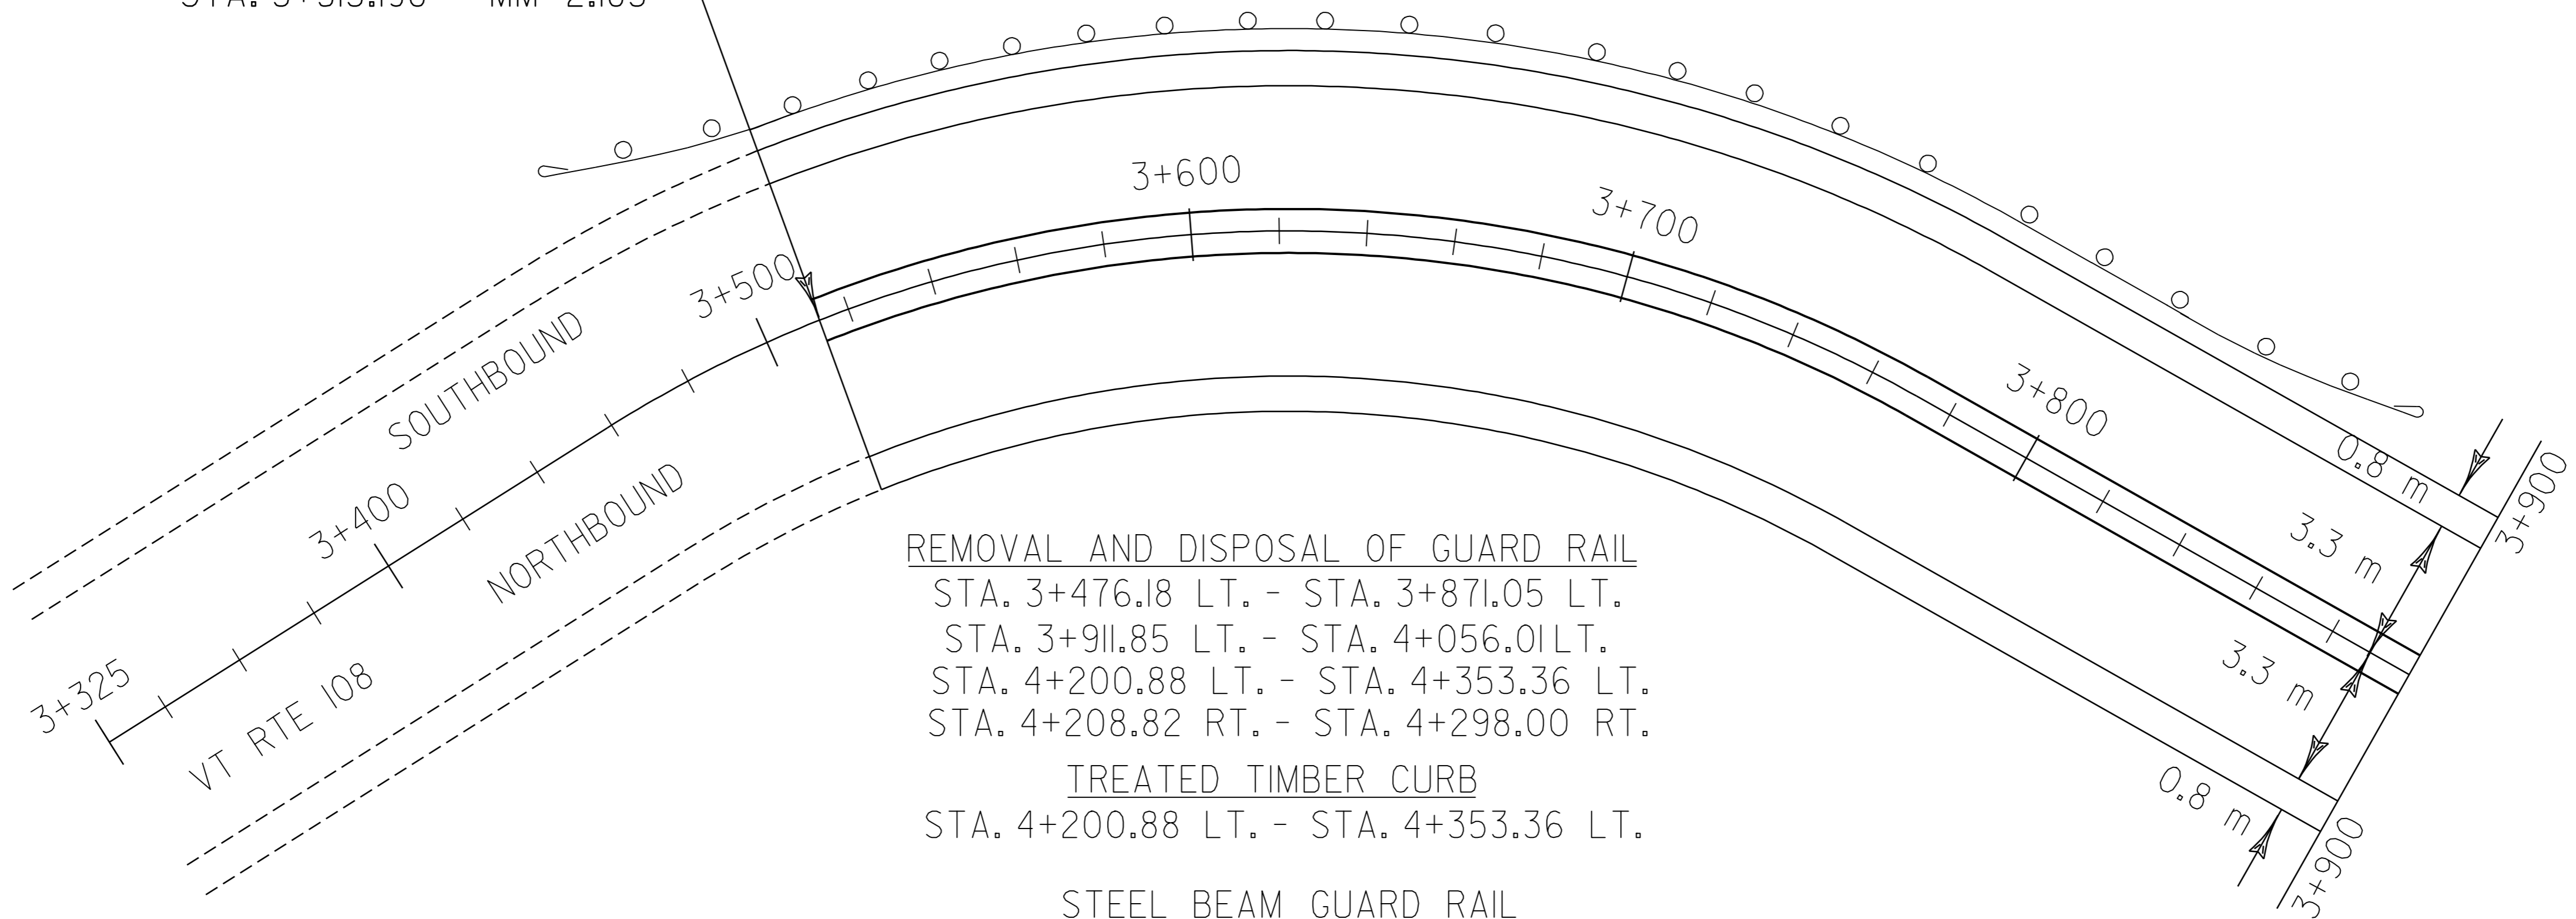

REMOVAL AND DISPOSAL OF GUARD RAIL  
 STA. 3+476.18 LT. - STA. 3+871.05 LT.  
 STA. 3+911.85 LT. - STA. 4+056.01 LT.  
 STA. 4+200.88 LT. - STA. 4+353.36 LT.  
 STA. 4+208.82 RT. - STA. 4+298.00 RT.

TREATED TIMBER CURB  
 STA. 4+200.88 LT. - STA. 4+353.36 LT.

STEEL BEAM GUARD RAIL  
~~STA. 3+476.18~~ ~~STA. 3+487.61~~ LT. - ~~STA. 3+859.62~~ LT. ~~STA. 3+871.05~~  
~~STA. 3+911.85~~ ~~STA. 3+923.28~~ LT. - ~~STA. 4+044.58~~ LT. ~~STA. 4+056.01~~  
 STA. 4+212.31 LT. - STA. 4+341.93 LT.  
 STA. 4+220.25 RT. - STA. 4+298.00 RT.


ANCHOR FOR STEEL BEAM GUARD RAIL  
 STA. 4+298.00 RT. (2)  
~~STA. 3+476.18~~ LT  
~~STA. 3+871.05~~ LT  
~~STA. 3+911.85~~ LT  
~~STA. 4+056.01~~ LT

TEMPORARY AND DURABLE 100 mm WHITE LINE  
 STA. 3+513.198 - STA. 4+400.00 LT. & RT.

TEMPORARY AND DURABLE 100 mm YELLOW LINE  
 STA. 3+513.198 - STA. 4+400.00 LT. & RT. (SOLID)

REHABILITATION OF DI, CB, OR MH CLASS I  
 STA. 4+370.00 RT

~~REDUCED POST SPACING~~  
~~STA. 3+984.11 LT.~~  
~~SEE DETAIL ON SHEET 27~~  
 NOT NEEDED

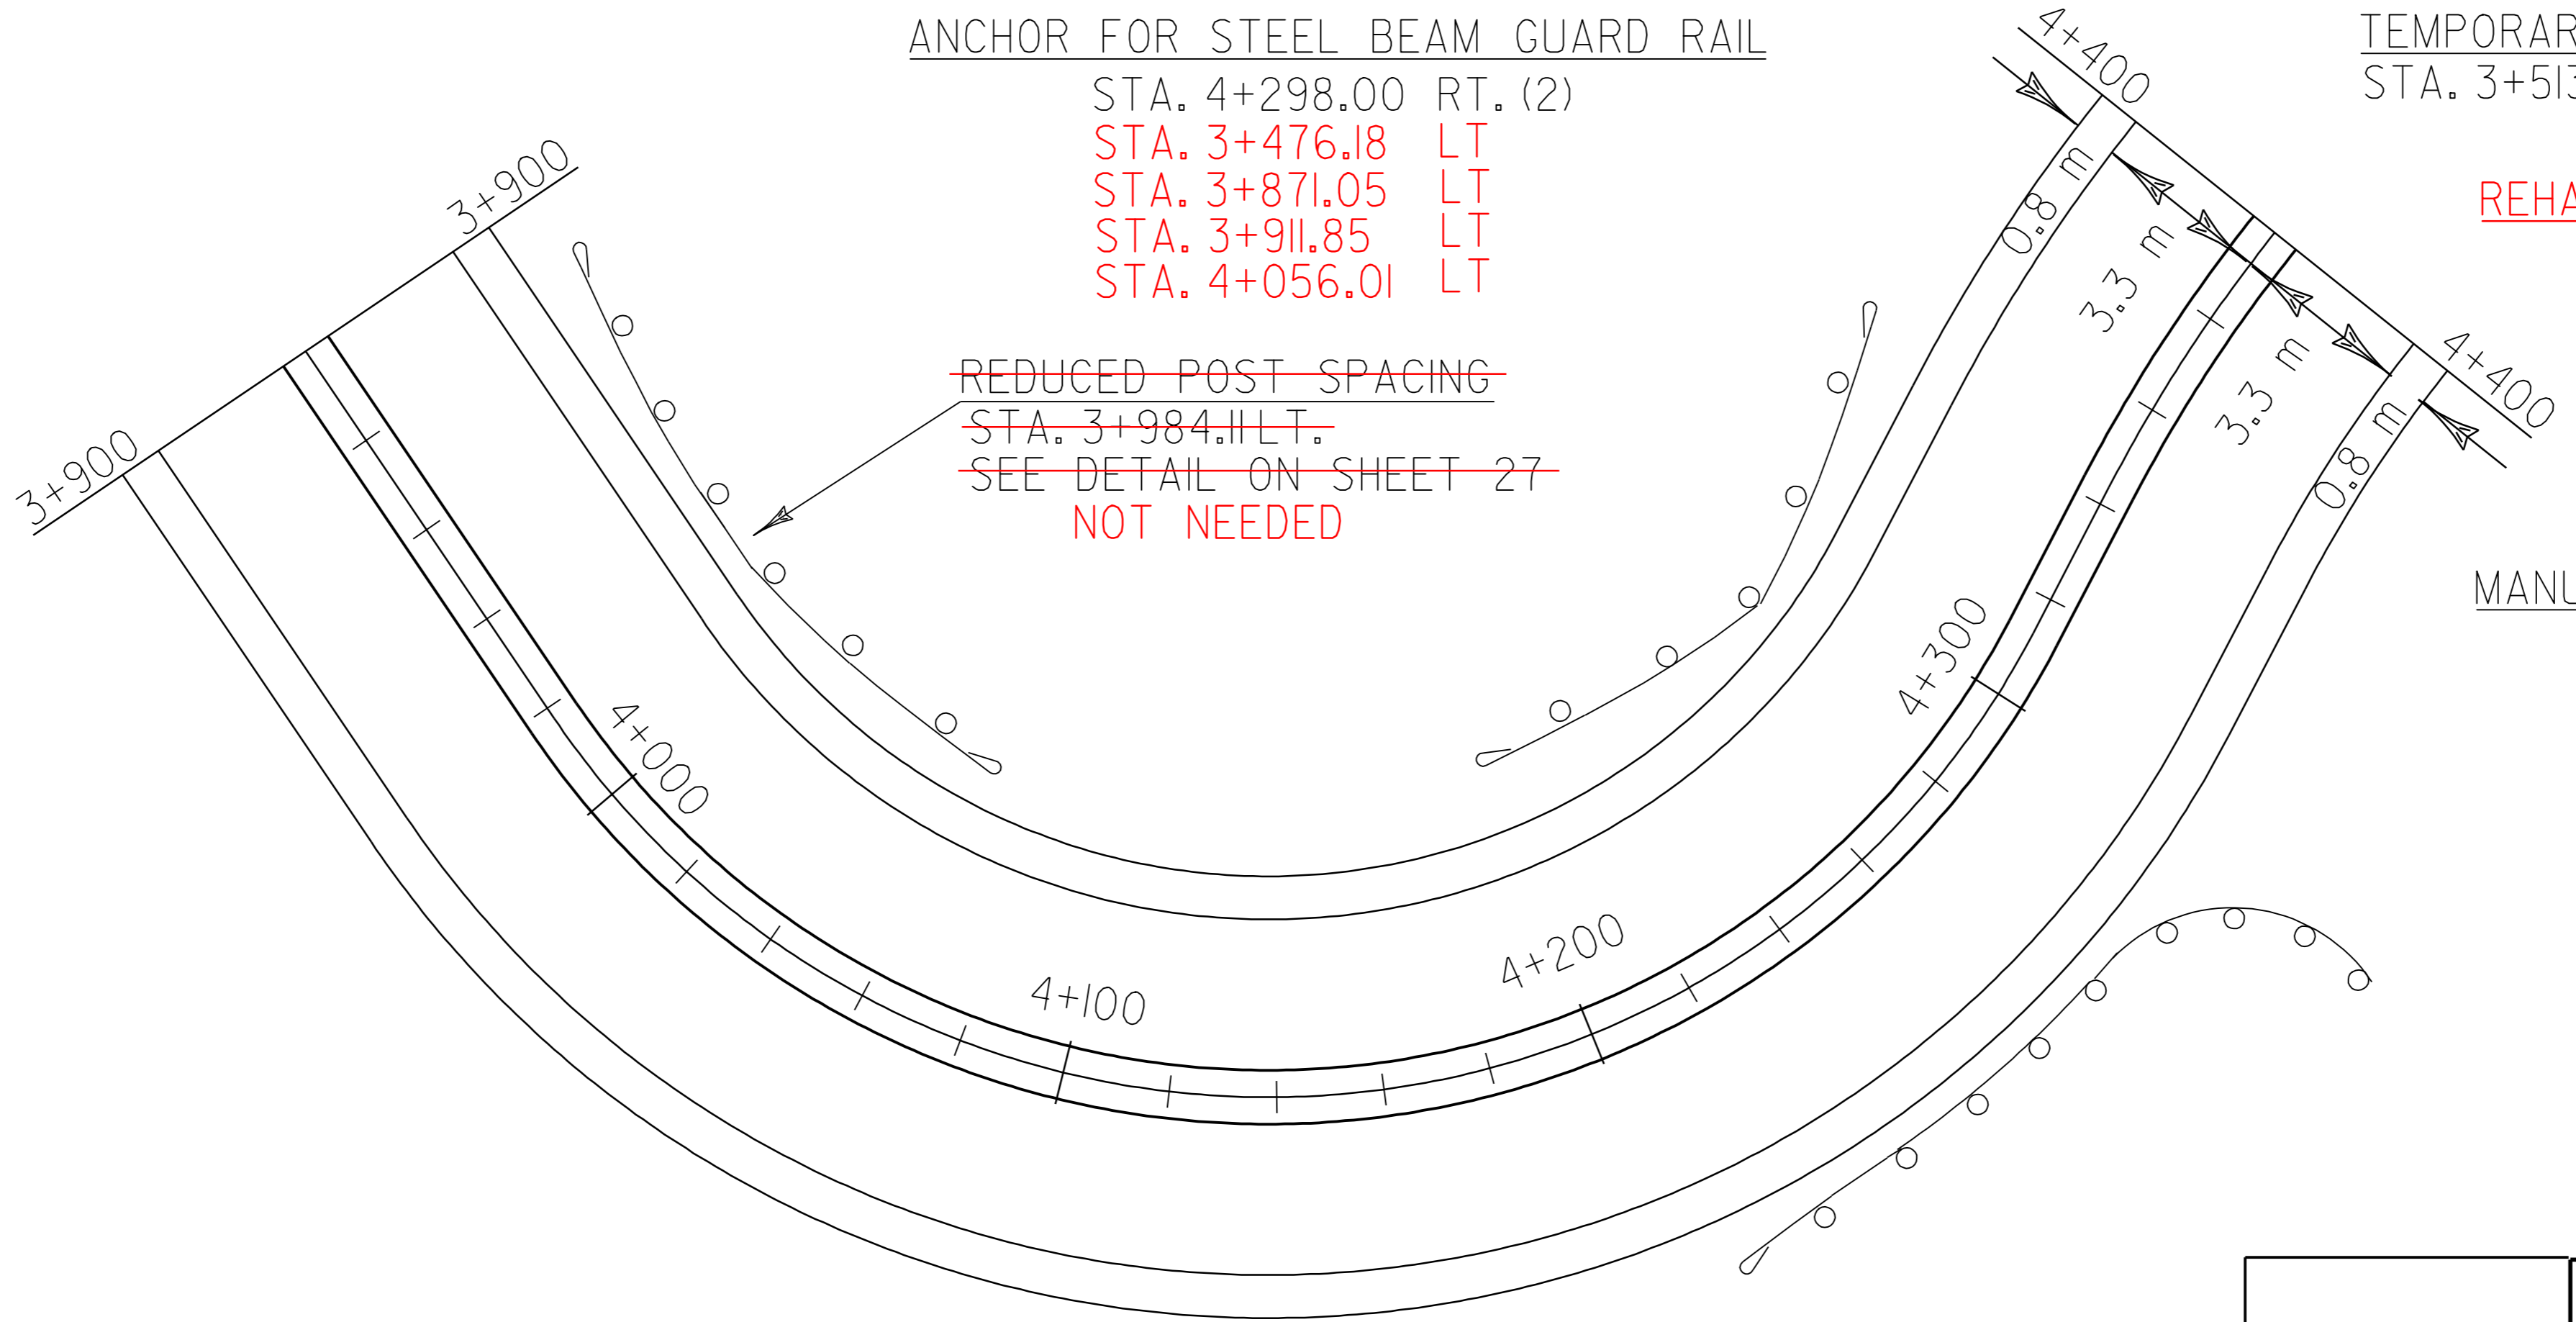

MANUFACTURED TERMINAL SECTION (FLARED)  
~~STA. 3+476.18~~ LT.  
~~STA. 3+871.05~~ LT. USED GI-d's  
~~STA. 3+911.85~~ LT.  
~~STA. 4+056.01~~ LT.  
 STA. 4+200.88 LT.  
 STA. 4+208.82 RT.  
 STA. 4+353.36 LT.


<b>PAVING PROJECT LAYOUT #1</b>	PROJECT NAME: CAMBRIDGE	FILE NAME: pave\99c188\99c188.dgn	PLOT DATE: 14-FEB-2006 16:4
	PROJECT NUMBER: STP_2218(I)S	PROJECT LEADER: WQQLAYER	DRAWN BY: KML
	DESIGNED BY: KML	CHECKED BY: PAVI_MGM	
	RECORDED BY: LOCKE		SHEET 8 OF 28

**REMOVAL AND DISPOSAL OF GUARD RAIL**


STA. 4+692.22 LT. - STA. 4+845.63 LT.  
 STA. 4+740.57 RT. - STA. 4+788.72 RT.  
 STA. 5+014.18 LT. - STA. 5+093.66 LT.

**STEEL BEAM GUARD RAIL**

STA. 4+703.65 LT. - STA. 4+834.20 LT.  
 STA. 4+751.99 RT. - STA. 4+777.29 RT.  
 STA. 5+025.61 LT. - STA. 5+082.23 LT.


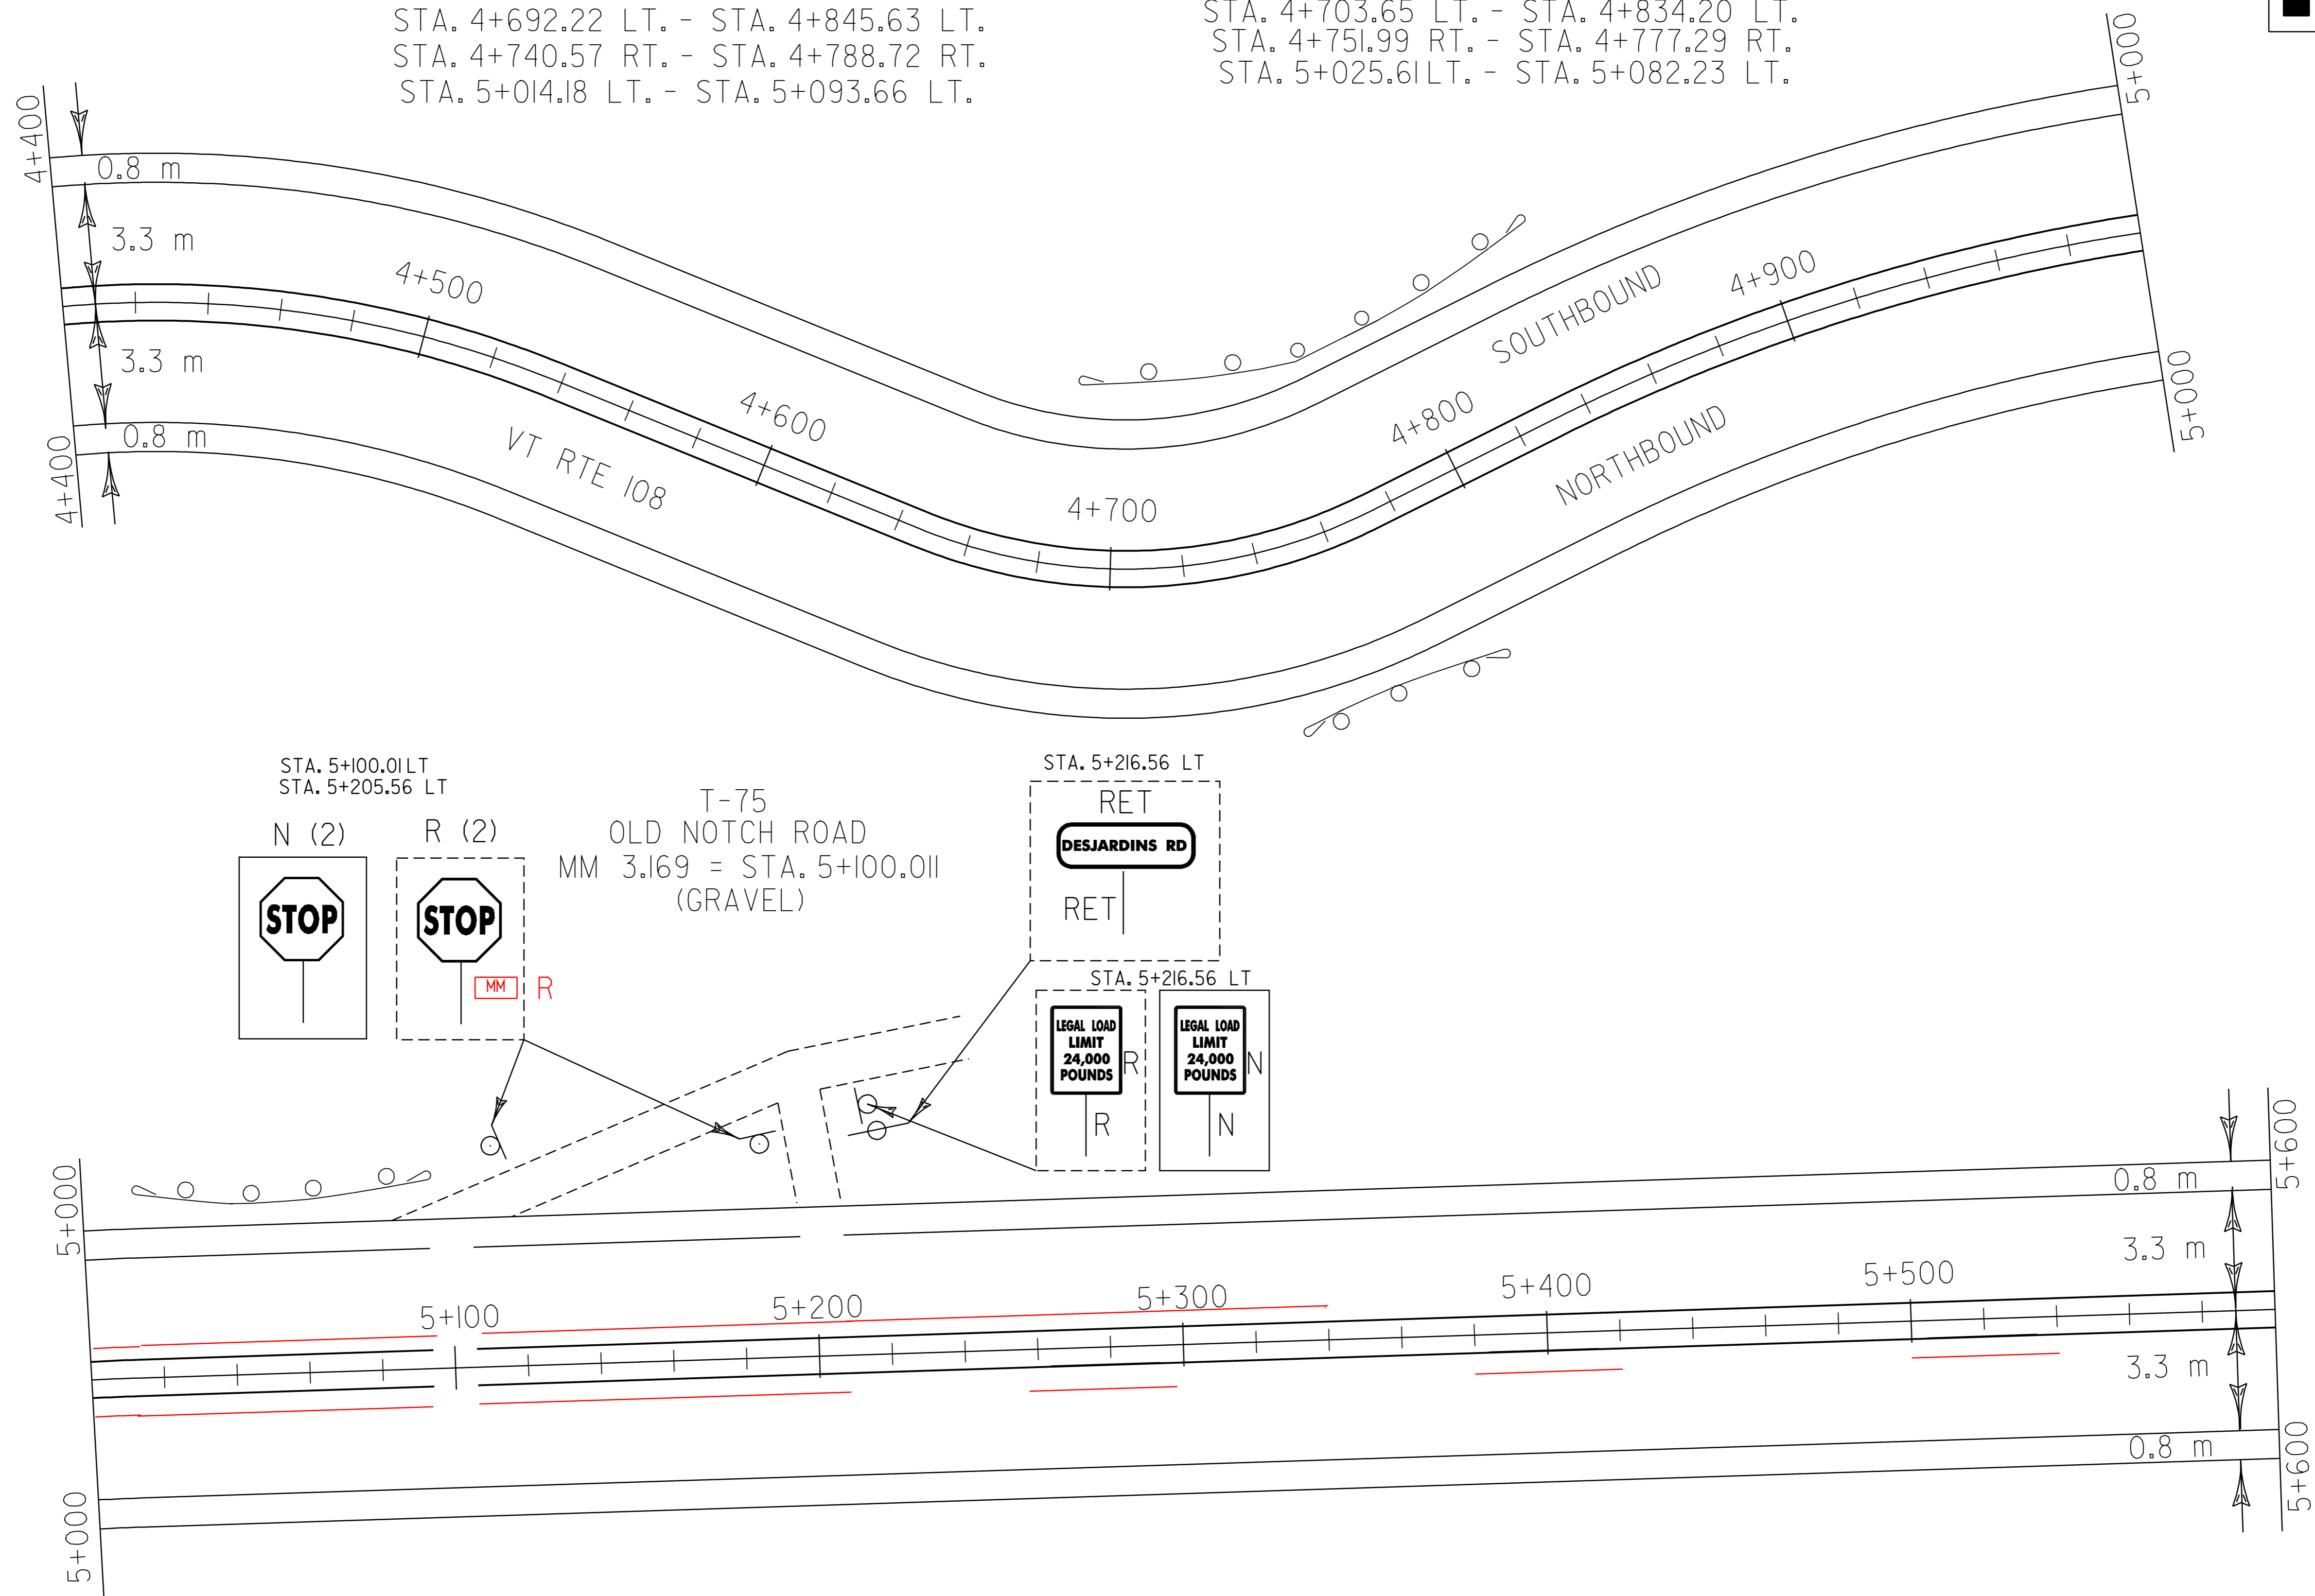


STA. 5+100.01 LT  
 STA. 5+205.56 LT

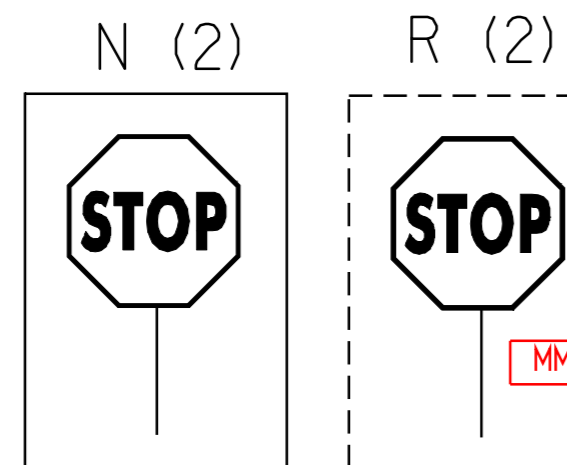

T-75  
 OLD NOTCH ROAD  
 MM 3.169 = STA. 5+100.01  
 (GRAVEL)

STA. 5+216.56 LT

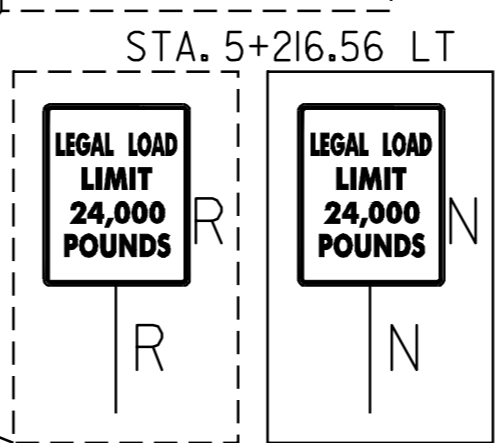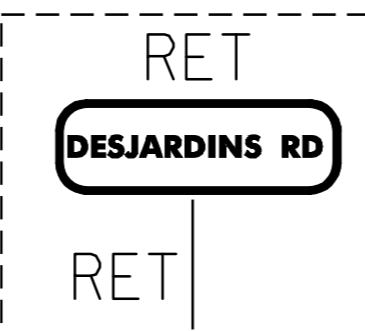

MANUFACTURED TERMINAL SECTION (FLARED)

STA. 4+692.22 LT.  
 STA. 4+740.57 RT.  
 STA. 4+788.72 RT.  
 STA. 4+845.63 LT.  
 STA. 5+014.18 LT.  
 STA. 5+093.66 LT.

REMOVING SIGNS  
 4 - 3 EA

TEMPORARY AND DURABLE 100 mm WHITE LINE W/ EL BREAKS FOR TH'S  
 STA. 4+400.00 - STA. 5+600.00 LT. & RT.

TEMPORARY AND DURABLE 100 mm YELLOW LINE W/ CL BREAKS FOR TH'S

~~STA. 4+400.00 - STA. 5+600.00 LT. & RT. (SOLID)~~  
 STA. 4+400.00 - STA. 5+222.32 LT & RT (SOLID)  
 STA. 5+222.32 - STA. 5+343.02 LT (SOLID)  
 STA. 5+222.32 - STA. 5+600.00 RT (DASHED)

**PAVING PROJECT**  
**LAYOUT**  
**#2**

PROJECT NAME: CAMBRIDGE	FILE NAME: Z:\pave\299cl88\299cl88.dgn	PLOT DATE: 14-FEB-2006 16:4
PROJECT NUMBER: SIP_2218(I)S	PROJECT LEADER: WQQLAYER	DRAWN BY: KML
DESIGNED BY: KML	RECORDED BY: LOCKE	CHECKED BY: PAVI_MGMT
		SHEET 9 OF 28

TEMPORARY AND DURABLE 100 mm WHITE LINE W/EL BREAKS FOR TH'S  
STA. 5+600.00 - STA. 6+800.00 RT. & LT.

TEMPORARY AND DURABLE 100 mm YELLOW LINE W/ CL BREAKS FOR TH'S  
STA. 5+600.00 - STA. 6+800.00 LT. & RT. (SOLID)

~~TEMPORARY AND DURABLE LETTERS OR SYMBOLS~~

~~STA. 5+600.00 - STA. 6+800.00 LT. & RT. (SOLID)~~

STA. 5+600.00 RT - STA. 5+793.64 RT (DASHED)  
STA. 5+793.64 RT - STA. 5+986.75 RT (SOLID)  
STA. 5+793.64 LT - STA. 5+986.75 LT (DASHED)  
STA. 5+986.75 - STA. 6+800.00 LT&RT (SOLID)


STA. 6+353.516 RT. (STOP)  
STA. 6+438.724 LT. (STOP)

STA. 6+438.724 LT. CL T-75  
STA. 6+353.516 RT. CL

~~TEMPORARY AND DURABLE 600 mm STOP BAR~~

REMOVING SIGNS  
86 EACH

STA. 6+353.516 RT.  
STA. 6+438.724 LT.

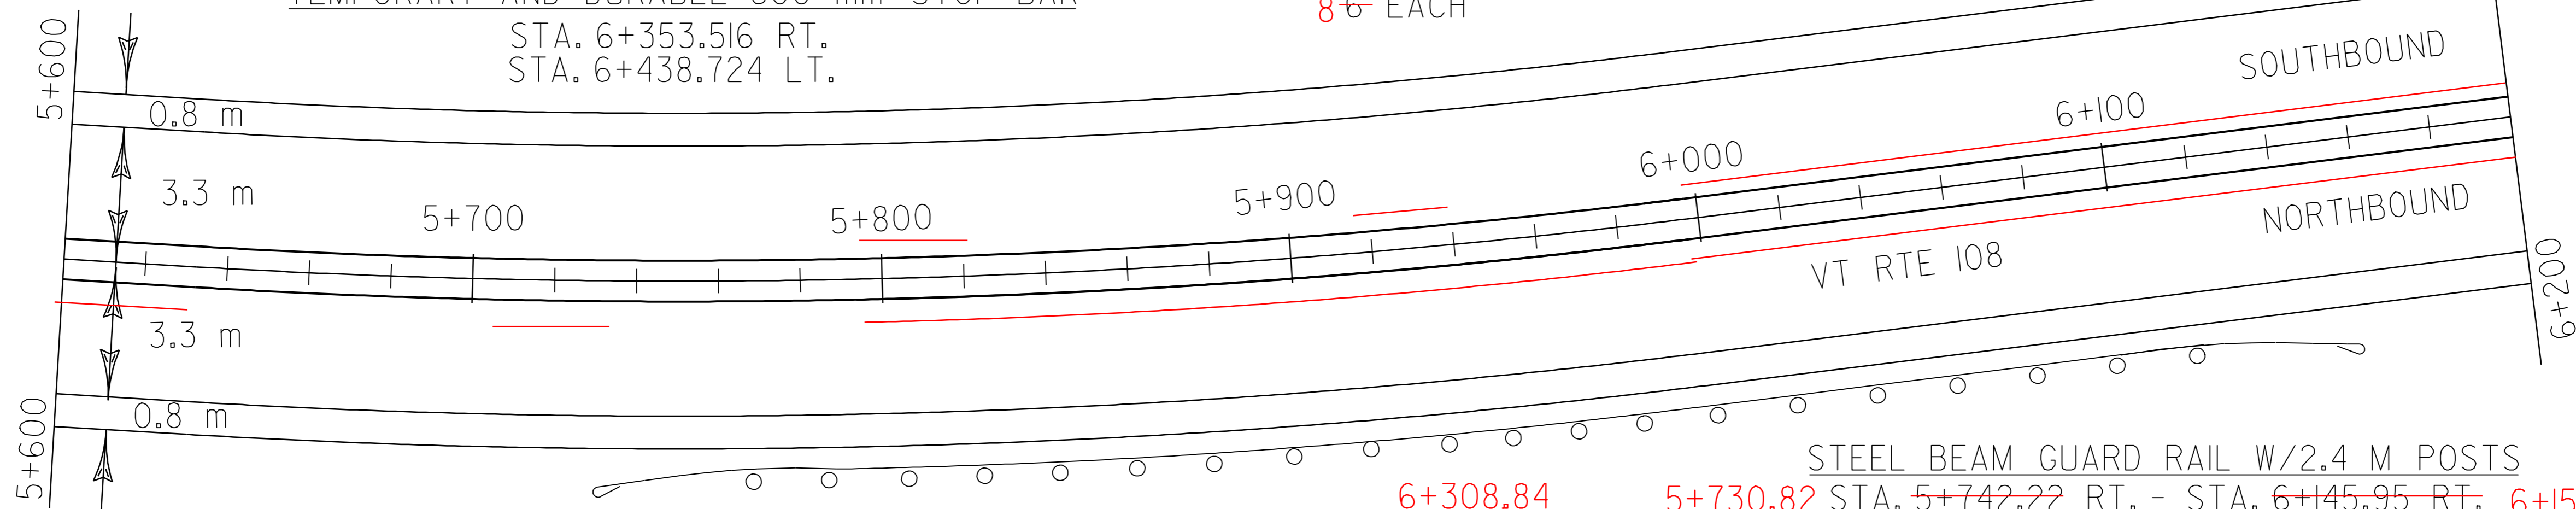

REMOVAL AND DISPOSAL OF GUARD RAIL

STEEL BEAM GUARD RAIL

STEEL BEAM GUARD RAIL W/2.4 M POSTS

STA. 5+730.82 RT. - STA. 6+157.35 RT.  
STA. 6+220.86 RT. - STA. 6+308.84 RT.  
STA. 6+228.99 LT. - STA. 6+316.98 LT.  
STA. 6+333.29 LT. - STA. 6+382.20 LT.  
STA. 6+349.58 RT. - STA. 6+390.38 RT.  
STA. 6+414.74 LT. - STA. 6+422.89 LT.  
STA. 6+422.89 RT. - STA. 6+453.73 RT.

STA. 6+255.50 RT. - STA. 6+297.44 RT.  
STA. 6+344.69 LT. - STA. 6+374.60 LT.  
STA. 6+360.98 RT. - STA. 6+382.78 RT.  
STA. 6+422.34 LT. - STA. 6+422.89 LT.  
STA. 6+430.49 RT. - STA. 6+442.33 RT.

6+308.84 STA. 5+730.82 RT. - STA. 6+145.95 RT. 6+157.35 RT  
6+228.99 STA. 6+240.39 LT. - STA. 6+305.58 LT. 6+316.98 LT  
6+220.86 STA. 6+232.26 RT. - STA. 6+255.50 RT.


~~MANUFACTURED TERMINAL SECTION (FLARED)~~

STA. 5+730.82 RT. USED G-ID'S  
STA. 6+157.35 RT.  
STA. 6+220.86 RT.  
STA. 6+228.99 LT.  
STA. 6+308.84 RT.  
STA. 6+316.98 LT.  
STA. 6+333.29 LT.  
STA. 6+349.58 RT.  
STA. 6+453.73 RT.



ANCHOR FOR STEEL BEAM GUARD RAIL

TERMINAL CONNECTOR FOR STEEL BEAM GUARD RAIL

RELOCATE MAILBOX, MULTIPLE SUPPORT  
STA. 6+316.98 LT.

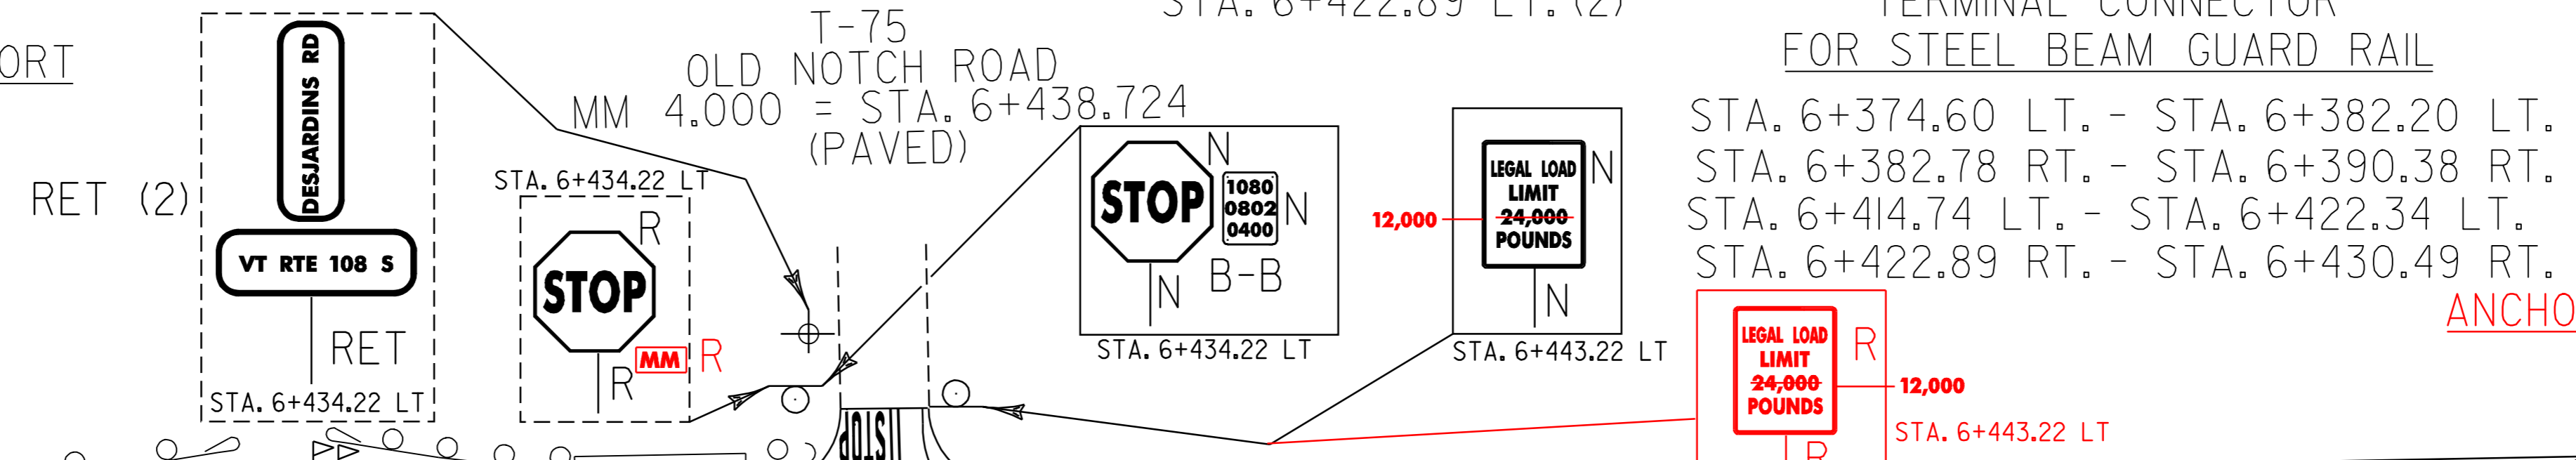

ANCHOR FOR STEEL BEAM GUARD RAIL  
STA. 5+730.82 RT.  
STA. 6+157.35 RT.  
STA. 6+220.86 RT.  
STA. 6+308.84 RT.  
STA. 6+228.99 LT.  
STA. 6+316.98 LT.  
STA. 6+333.29 LT.  
STA. 6+349.58 RT.  
STA. 6+453.73 RT.

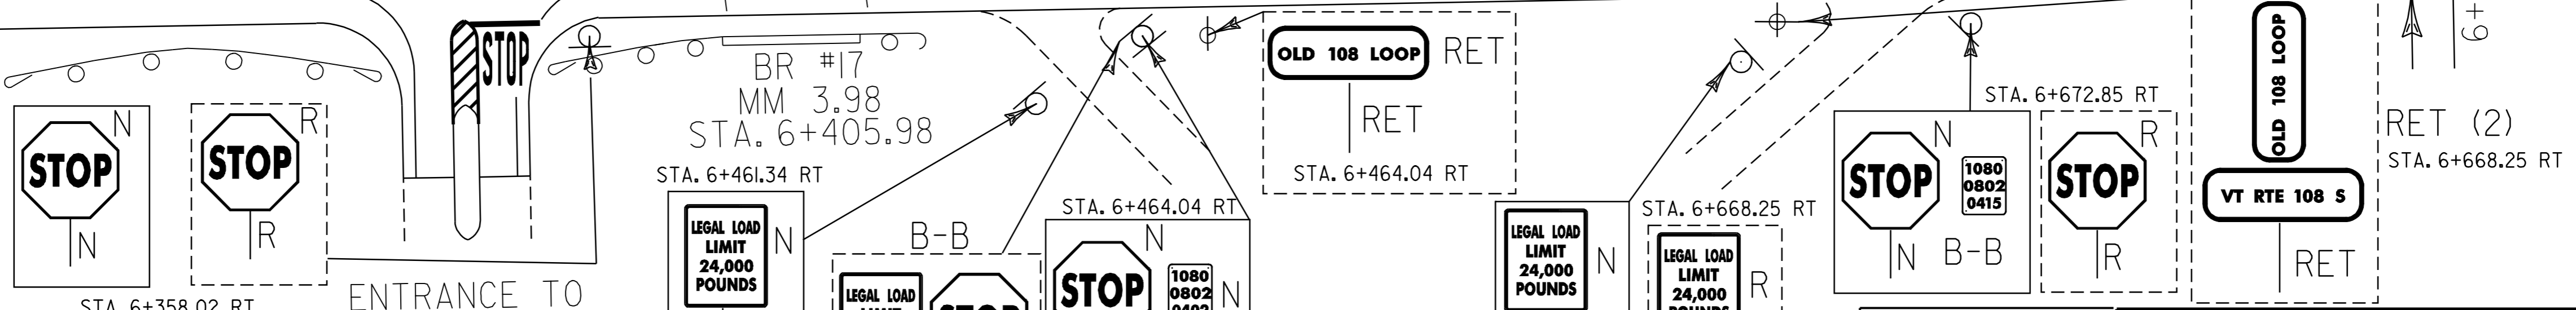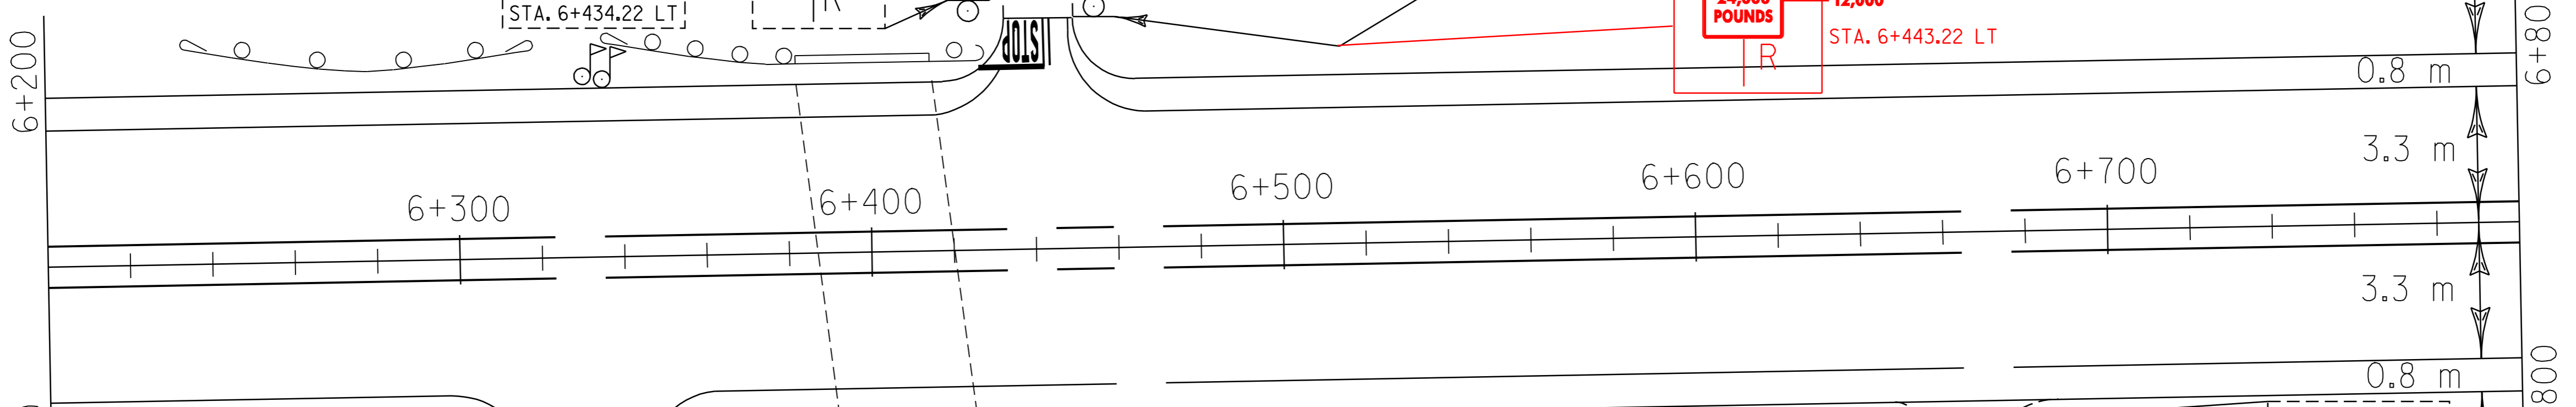

ENTRANCE TO SMUGGLER'S NOTCH SKIAREA  
MM 3.948 = STA. 6+353.516 (PAVED)

BR #17 MM 3.98 STA. 6+405.98  
STA. 6+461.34 RT  
LEGAL LOAD LIMIT 24,000 POUNDS  
B-B  
STOP 1080 0802 0402  
T-76  
OLD 108 LOOP  
MM 4.015 = STA. 6+461.340  
MM 4.145 = STA. 6+670.549 (GRAVEL)

PAVING PROJECT LAYOUT #3

PROJECT NAME: CAMBRIDGE  
PROJECT NUMBER: SIP\_2218(I)S  
FILE NAME: Z:\pave\299cl88\299cl88.dgn  
PROJECT LEADER: WOQLAYER  
DESIGNED BY: KML  
RECORDED BY: LOCKE  
PLOT DATE: 14-FEB-2006 16:4  
DRAWN BY: KML  
CHECKED BY: PAVI.MGMT  
SHEET 10 OF

REMOVING SIGNS  
3+EACH

REMOVAL AND DISPOSAL OF GUARD RAIL  
STA. 6+888.32 RT. - STA. 7+081.91 RT.  
STA. 7+226.91 RT. - STA. 7+838.04 RT.  
STA. 7+853.60 RT. - STA. 8+000.00 RT.


STEEL BEAM GUARD RAIL  
STA. 6+899.72 RT. - STA. 7+070.51 RT.  
STA. 7+226.91 RT. - STA. 7+340.00 RT.  
STA. 7+693.26 RT. - STA. 7+826.64 RT.  
STA. 7+865.00 RT. - STA. 8+000.00 RT.

MANUFACTURED TERMINAL SECTION (FLARED)  
STA. 6+888.32 RT. STA. 7+838.04 RT.  
STA. 7+081.91 RT. STA. 7+853.60 RT.



ANCHOR FOR STEEL BEAM GUARD RAIL  
STA. 7+226.91 RT. (2)

STEEL BEAM GUARD RAIL W/2.4 M POSTS (MOD.)  
STA. 7+340.00 RT. - STA. 7+693.26 RT

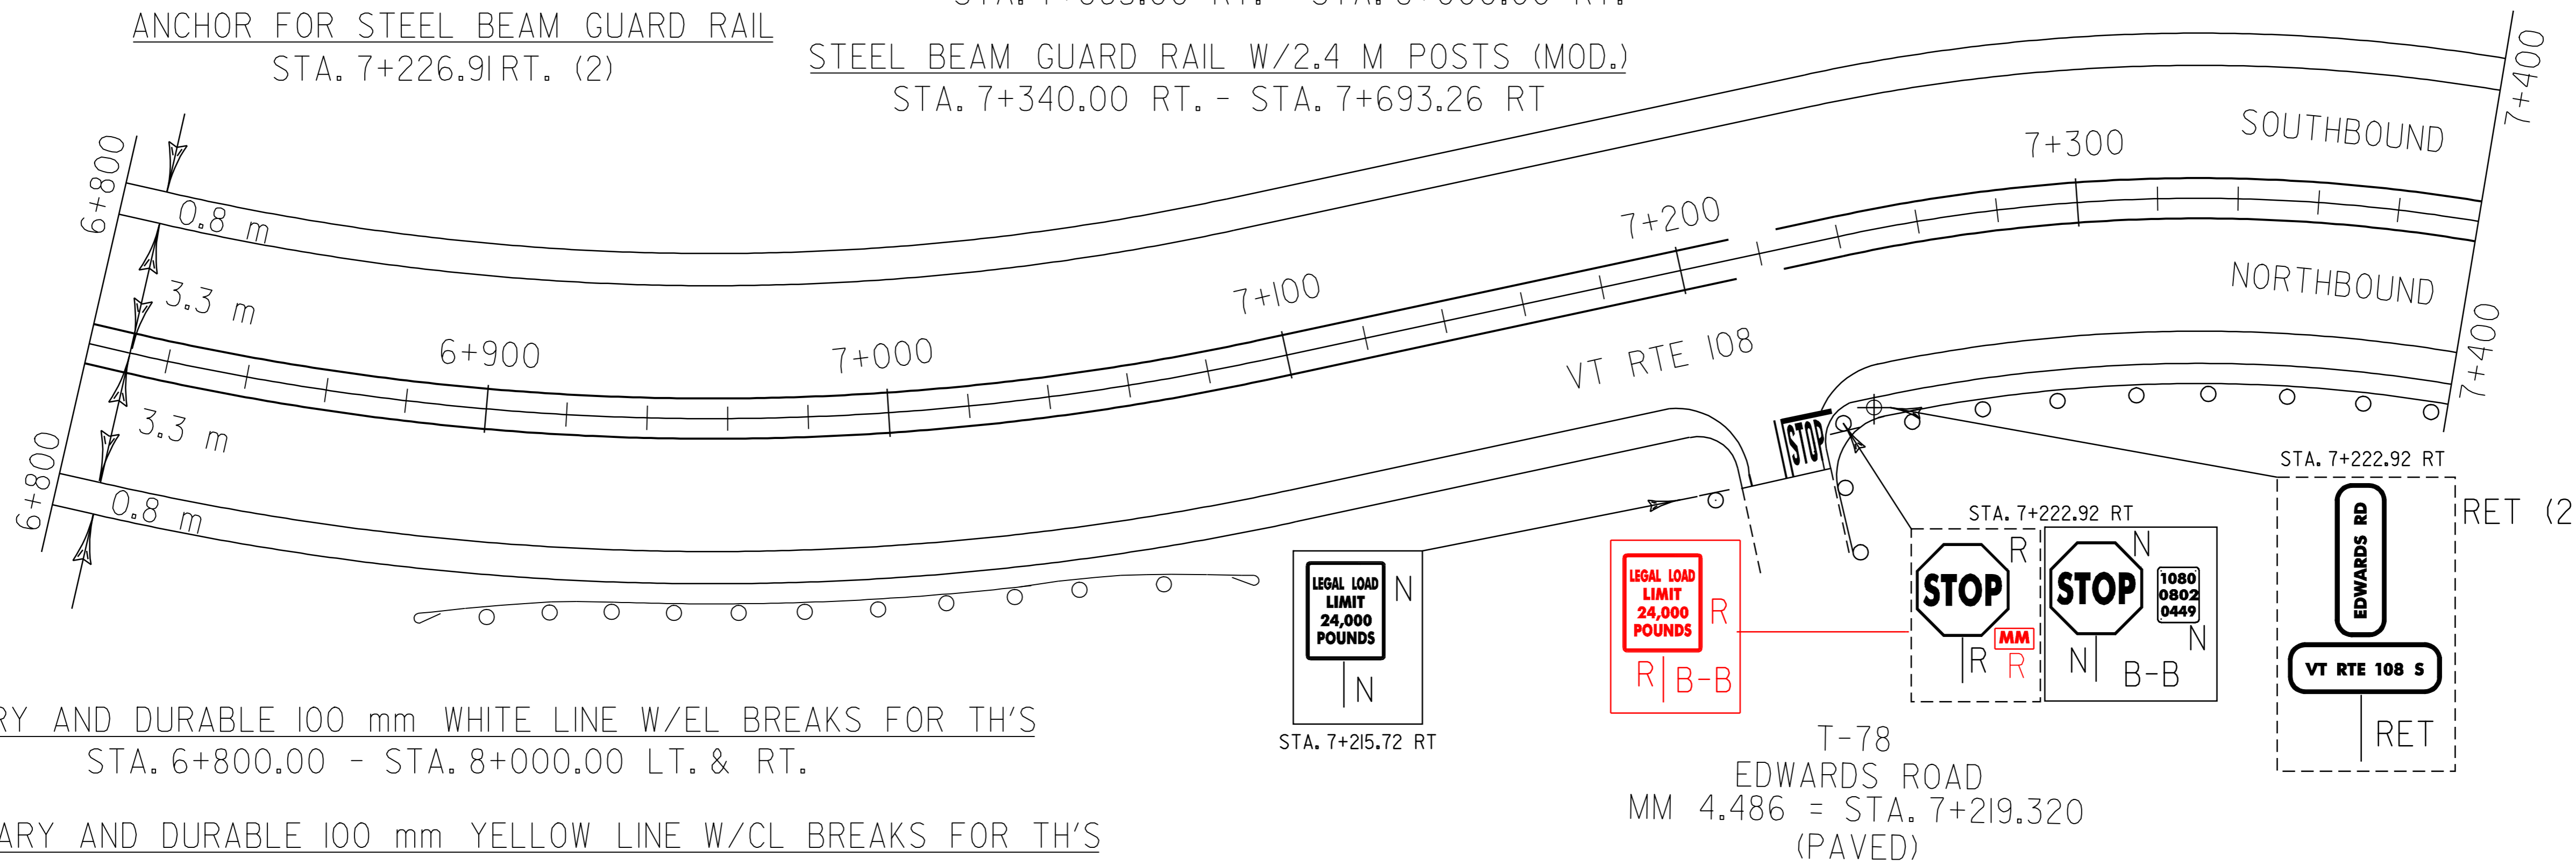


TEMPORARY AND DURABLE 100 mm WHITE LINE W/EL BREAKS FOR TH'S  
STA. 6+800.00 - STA. 8+000.00 LT. & RT.

TEMPORARY AND DURABLE 100 mm YELLOW LINE W/CL BREAKS FOR TH'S  
STA. 6+800.00 - STA. 8+000.00 LT. & RT. (SOLID)


~~TEMPORARY AND DURABLE 600 mm STOP BAR~~  
STA. 7+219.320 RT. (T-78)

~~TEMPORARY AND DURABLE LETTERS OR SYMBOLS~~  
STA. 7+219.320 RT. (STOP)

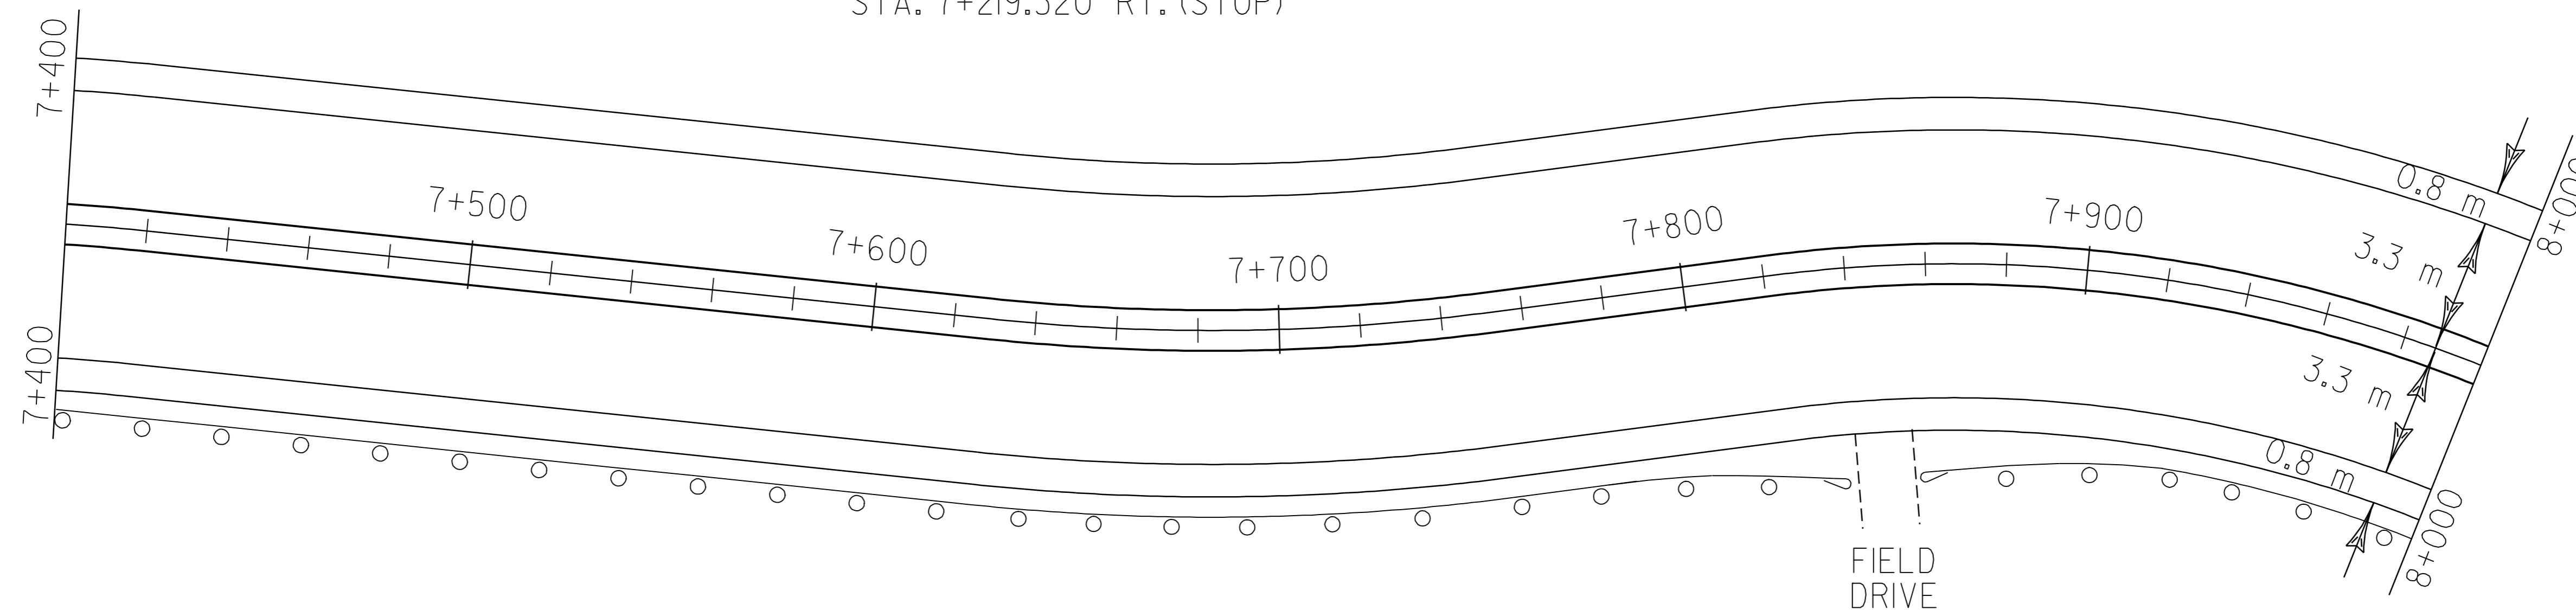


PAVING PROJECT  
LAYOUT  
#4

PROJECT NAME: CAMBRIDGE  
PROJECT NUMBER: SIP\_2218(I)S  
FILE NAME: Z:\pave\299cl88\299cl88.dgn  
PROJECT LEADER: WOQLAYER  
DESIGNED BY: KML  
RECORDED BY: LOCKE  
PLOT DATE: 14-FEB-2006 16:4  
DRAWN BY: KML  
CHECKED BY: PAVI.MGMI.  
SHEET 11 OF 28

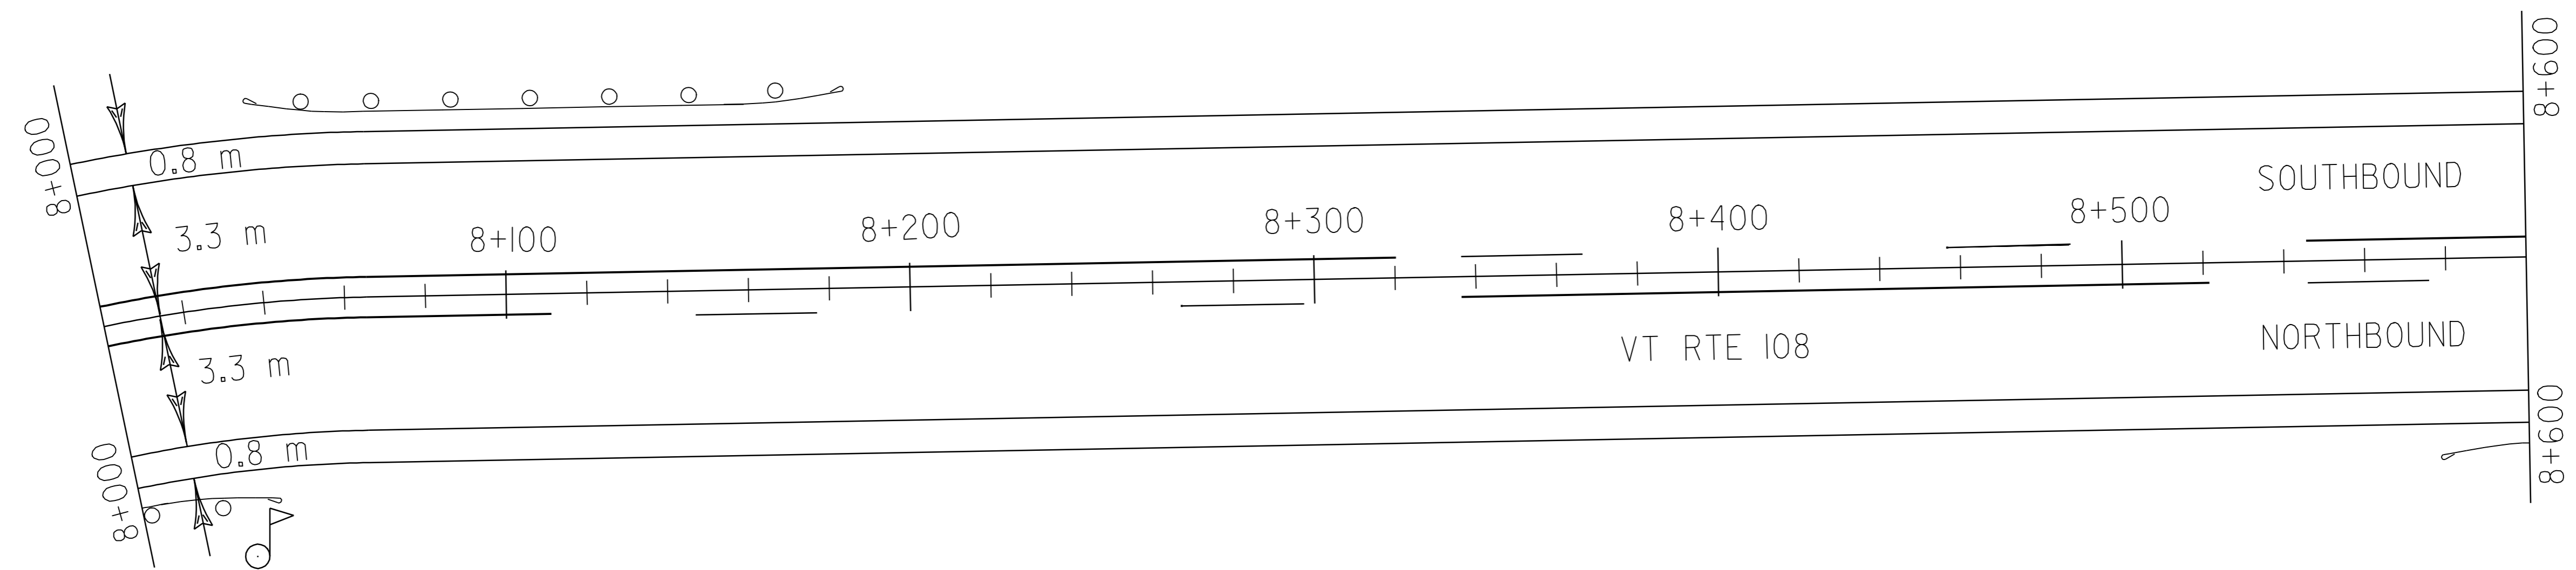

TEMPORARY AND DURABLE 100 mm WHITE LINE  
 STA. 8+000.00 - STA. 9+200.00 LT. & RT.  
 RELOCATE MAIL BOX, SINGLE SUPPORT  
~~STA. 8+039.42 RT.~~  
 STA. 8+698.08 RT.  
 STA. 8+823.84 RT.  
 RELOCATE MAIL BOX, MULTIPLE SUPPORT  
 STA. 8+620.54 RT.

TEMPORARY AND DURABLE 100 mm YELLOW LINE  
 STA. 8+000.00 LT. - STA. 8+320.31 LT. (SOLID)  
 STA. 8+000.00 RT. - STA. 8+111.09 RT. (SOLID)  
 STA. 8+111.09 RT. - STA. 8+336.40 RT. (DASHED)  
 STA. 8+320.31 LT. - STA. 8+545.62 LT. (DASHED)  
 STA. 8+336.40 RT. - STA. 8+521.48 RT. (SOLID)  
 STA. 8+545.62 LT. - STA. 8+738.74 LT. (SOLID)  
 STA. 8+521.48 RT. - STA. 8+706.55 RT. (DASHED)  
 STA. 8+706.55 RT. - STA. 8+996.23 RT. (SOLID)  
 STA. 8+738.74 LT. - STA. 8+939.91 LT. (DASHED)  
 STA. 8+939.91 LT. - STA. 9+200.00 LT. (SOLID)  
 STA. 8+996.23 RT. - STA. 9+200.00 RT. (DASHED)

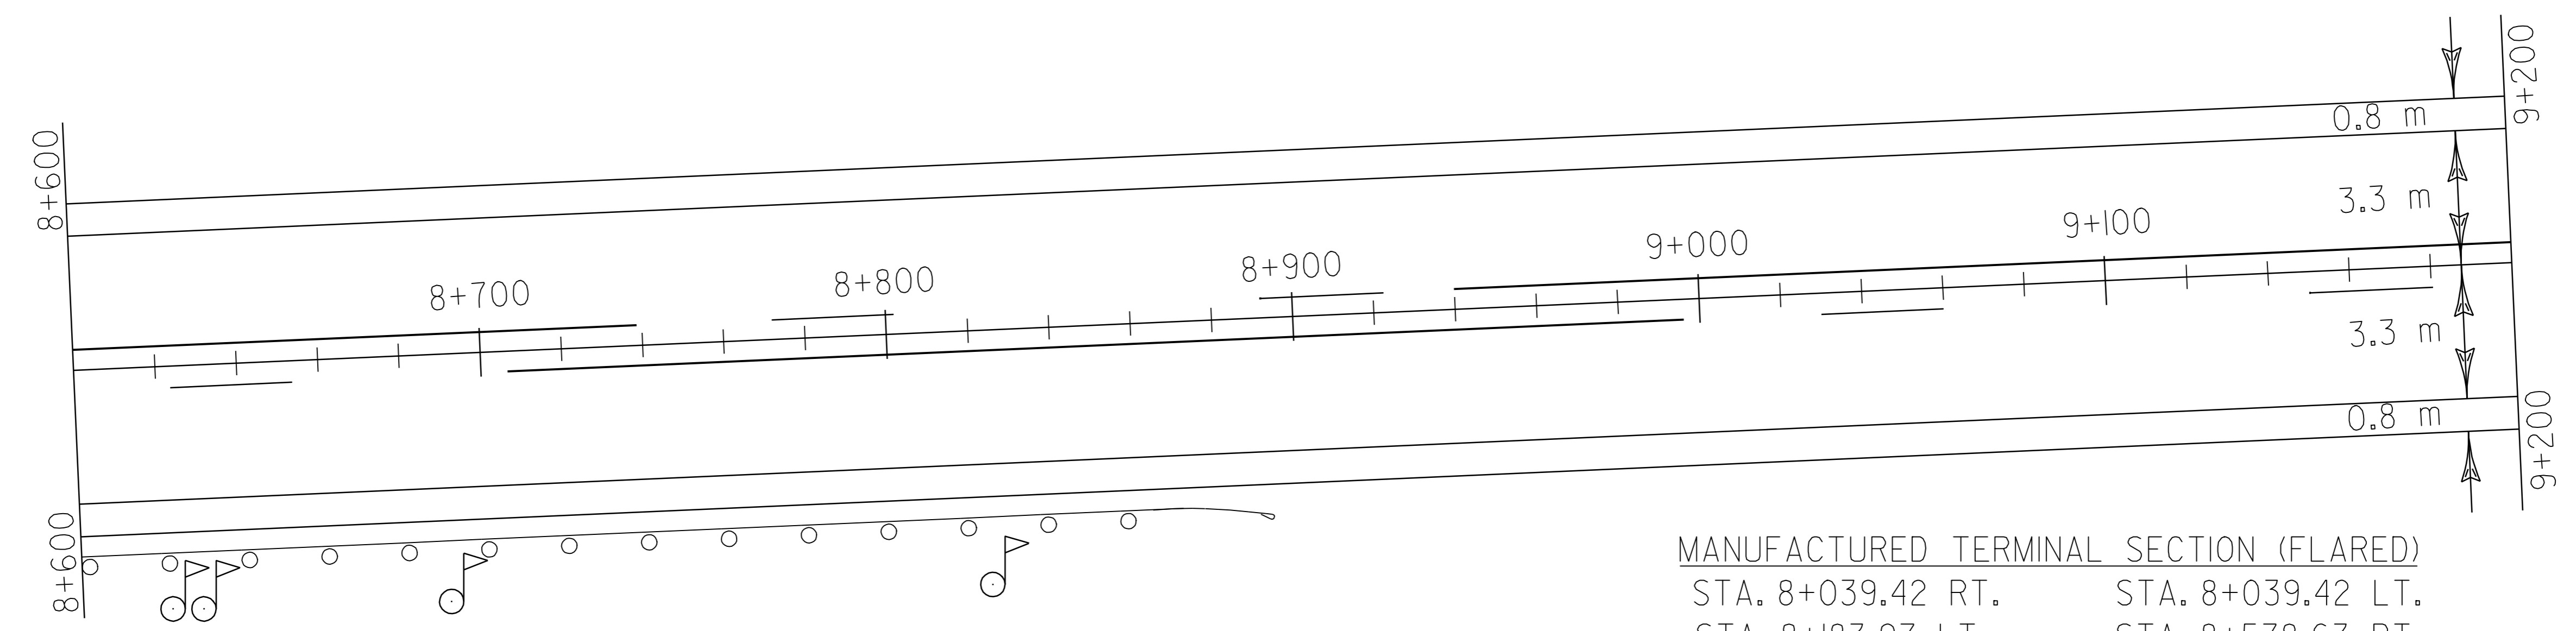

REMOVAL AND DISPOSAL OF GUARD RAIL  
 STA. 8+000.00 RT. - STA. 8+039.42 RT.  
 STA. 8+039.42 LT. - STA. 8+183.97 LT.  
 STA. 8+578.63 RT. - STA. 8+896.23 RT.

STEEL BEAM GUARD RAIL  
 STA. 8+000.00 RT. - STA. 8+028.02 RT.

MANUFACTURED TERMINAL SECTION (FLARED)  
 STA. 8+039.42 RT. STA. 8+039.42 LT.  
 STA. 8+183.97 LT. STA. 8+578.63 RT.  
~~STA. 8+896.23 RT.~~ **USED G-ID WITH ANCHOR**


STEEL BEAM GUARD RAIL W/2.4 M POSTS  
 STA. 8+050.82 LT. - STA. 8+172.57 LT.  
 STA. 8+590.03 RT. - STA. 8+881.68 RT.

<b>PAVING PROJECT</b>  <b>LAYOUT</b>  <b>#5</b>	PROJECT NAME: CAMBRIDGE	FILE NAME: Z:\pave\299cl88\299cl88.dgn	PLOT DATE: 14-FEB-2006 16:4
	PROJECT NUMBER: SIP_2218(I)S	PROJECT LEADER: WQQLAYER	DRAWN BY: KML
	DESIGNED BY: KML	RECORDED BY: LOCKE	CHECKED BY: PAVI.MGMT.
			SHEET 12 OF 28

STEEL BEAM GUARD RAIL  
 STA. 9+392.02 RT. - STA. 9+516.32 RT.  
 STA. 9+564.10 RT. - STA. 9+632.71 RT.  
 STA. 9+659.38 RT. - STA. 9+701.55 RT.

ANCHOR FOR STEEL BEAM GUARD RAIL  
 STA. 9+392.02 RT. (2)  
 STA. 9+392.02 RT. (1)

T-50 BURNOR ROAD  
 MM 5.986 = STA. 9+633.270  
 (PAVED)

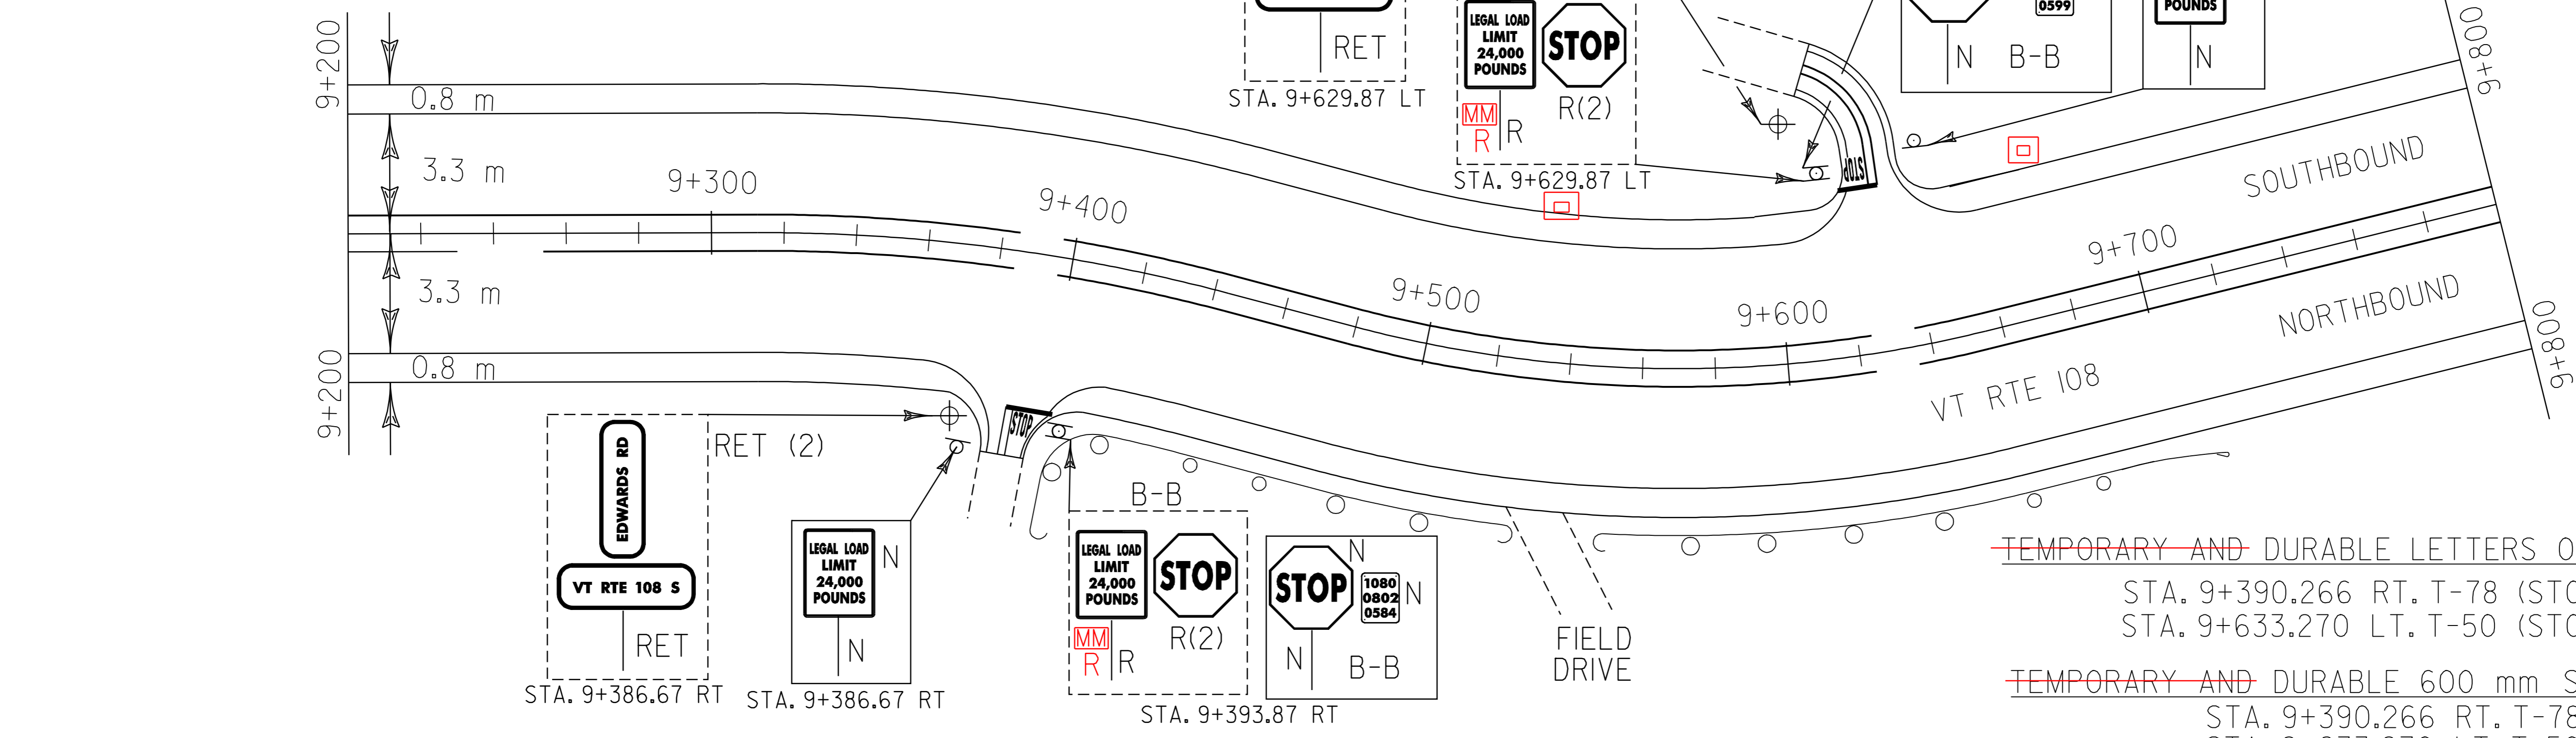


~~TEMPORARY AND DURABLE LETTERS OR SYMBOLS~~  
 STA. 9+390.266 RT. T-78 (STOP)  
 STA. 9+633.270 LT. T-50 (STOP)  
~~TEMPORARY AND DURABLE 600 mm STOP BAR~~  
 STA. 9+390.266 RT. T-78  
 STA. 9+633.270 LT. T-50

T-78 EDWARDS ROAD  
 MM 5.835 = STA. 9+390.266  
 (PAVED)

STEEL BEAM GUARD RAIL W/2.4 M POSTS  
 STA. 9+632.71 RT. - STA. 9+659.38 RT.  
 STA. 9+957.38 RT. - STA. 10+313.41 RT.

REMOVING SIGNS  
 6 EA

REHABILITATION OF DI, CB, OR MH CLASS I  
 STA. 9+531.00 LT  
 STA. 9+670.00 LT

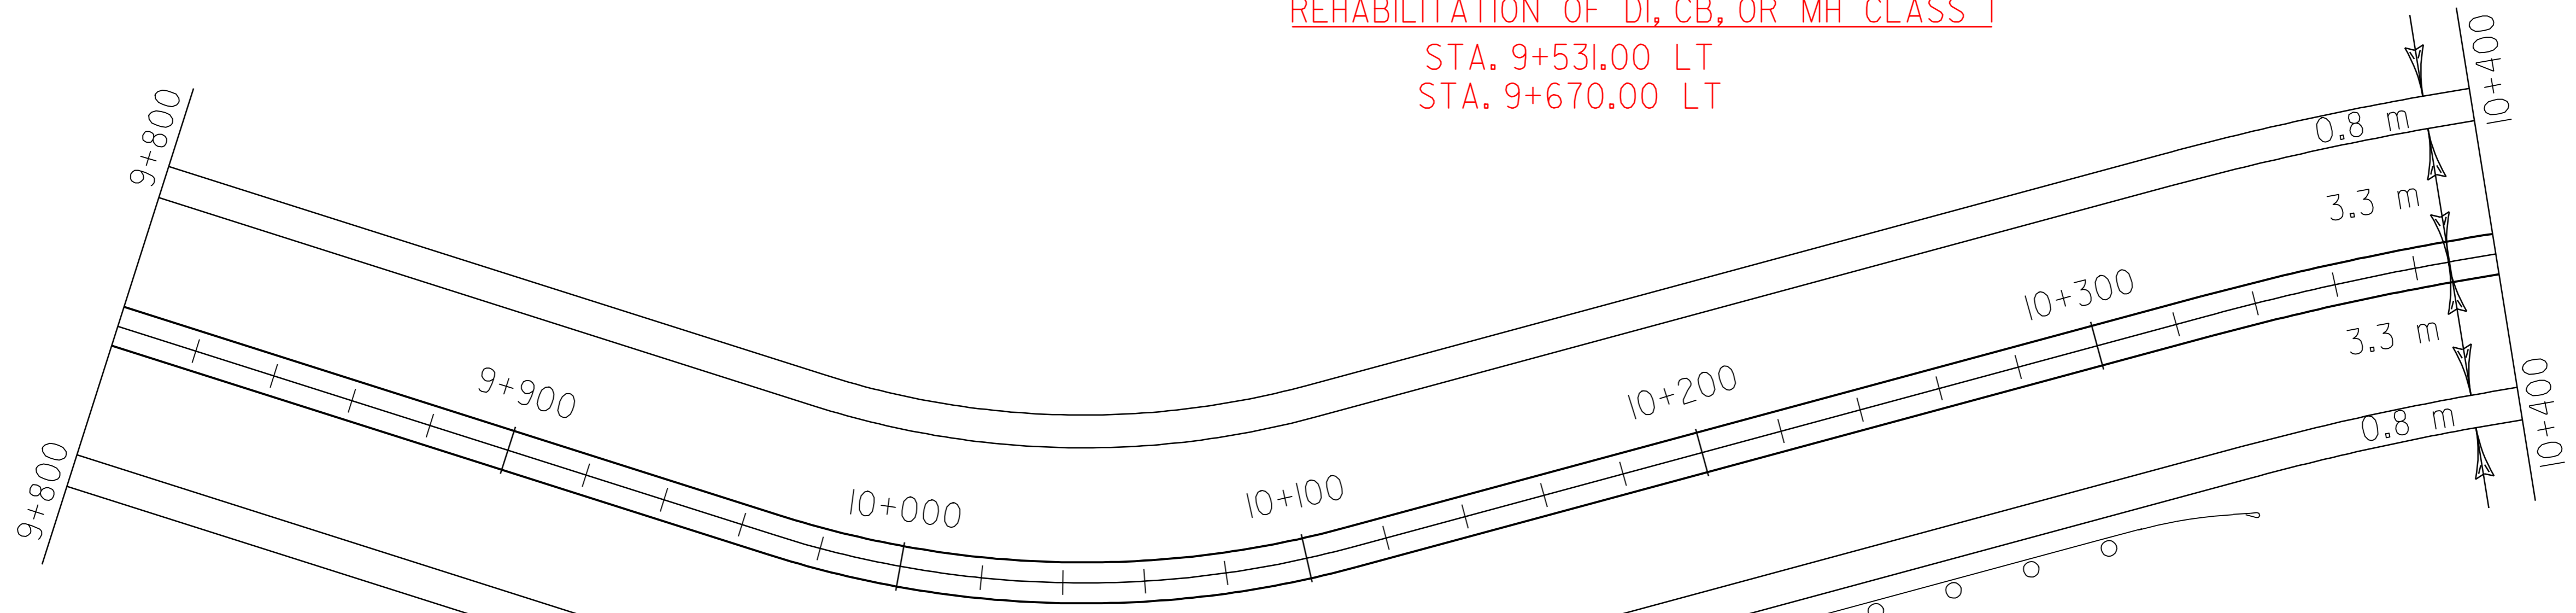

REMOVAL AND DISPOSAL OF GUARD RAIL  
 STA. 9+392.02 RT. - STA. 9+527.72 RT.  
 STA. 9+552.70 RT. - STA. 9+712.95 RT.  
 STA. 9+945.98 RT. - STA. 10+324.81 RT.

MANUFACTURED TERMINAL SECTION (FLARED)  
 USED G-ID ~~STA. 9+527.72 RT.~~ STA. 9+552.70 RT.  
 STA. 9+712.95 RT. STA. 9+945.98 RT.  
 STA. 10+324.81 RT.

TEMPORARY AND DURABLE 100 mm YELLOW LINE W/CL BREAKS FOR TH'S  
 STA. 9+200.00 RT. - STA. 9+253.73 RT. (DASHED)  
 STA. 9+200.00 LT. - STA. 9+253.73 LT. (SOLID)  
 STA. 9+253.73 - STA. 10+400.00 LT. & RT. (SOLID)  
 STA. 9+390.27 RT. T-78 (SOLID)  
 STA. 9+633.27 LT. T-50 (SOLID)

TEMPORARY AND DURABLE 100 mm WHITE LINE  
 STA. 9+200.00 - STA. 10+400.00 RT. & LT.  
~~TREATED TIMBER CURB~~  
~~STA. 9+945.98 RT. STA. 9+994.28 RT.~~

<b>PAVING PROJECT LAYOUT #6</b>	PROJECT NAME: CAMBRIDGE	PLOT DATE: 14-FEB-2006 16:4
	PROJECT NUMBER: SIP_2218(1)S	DRAWN BY: KML
	FILE NAME: Z:\pave\299ci88\299ci88.dgn	CHECKED BY: PAVI.MGMT.
	DESIGNED BY: KML	RECORDED BY: LOCKE
		SHEET 13 OF 28

TEMPORARY AND DURABLE 100 mm WHITE LINE  
 STA. 10+400.00 - STA. 11+600.00 LT. & RT.

REMOVAL AND DISPOSAL OF GUARD RAIL  
 STA. 10+509.37 RT. - STA. 10+695.51 RT.  
 STA. 10+742.59 RT. - STA. 11+032.41 RT.  
 STA. 11+048.30 RT. - STA. 11+112.81 RT.  
 STA. 11+161.42 RT. - STA. 11+258.58 RT.


STEEL BEAM GUARD RAIL  
 STA. 10+520.77 RT. - STA. 10+684.11 RT.  
 STA. 11+074.97 RT. - STA. 11+101.41 RT.

STEEL BEAM GUARD RAIL W/2.4 M POSTS  
 STA. 10+753.99 RT. - STA. 11+032.41 RT.  
 STA. 11+059.70 RT. - STA. 11+074.97 RT.  
 STA. 11+172.82 RT. - STA. 11+247.18 RT.

TEMPORARY AND DURABLE 100 mm YELLOW LINE W/CL BREAKS FOR TH'S  
 STA. 10+400.00 - STA. 11+600 LT. & RT. (SOLID)

~~TREATED TIMBER CURB~~  
~~STA. 10+541.20 RT. - STA. 10+622.84 RT.~~



REMOVING SIGNS  
 3-2 EACH

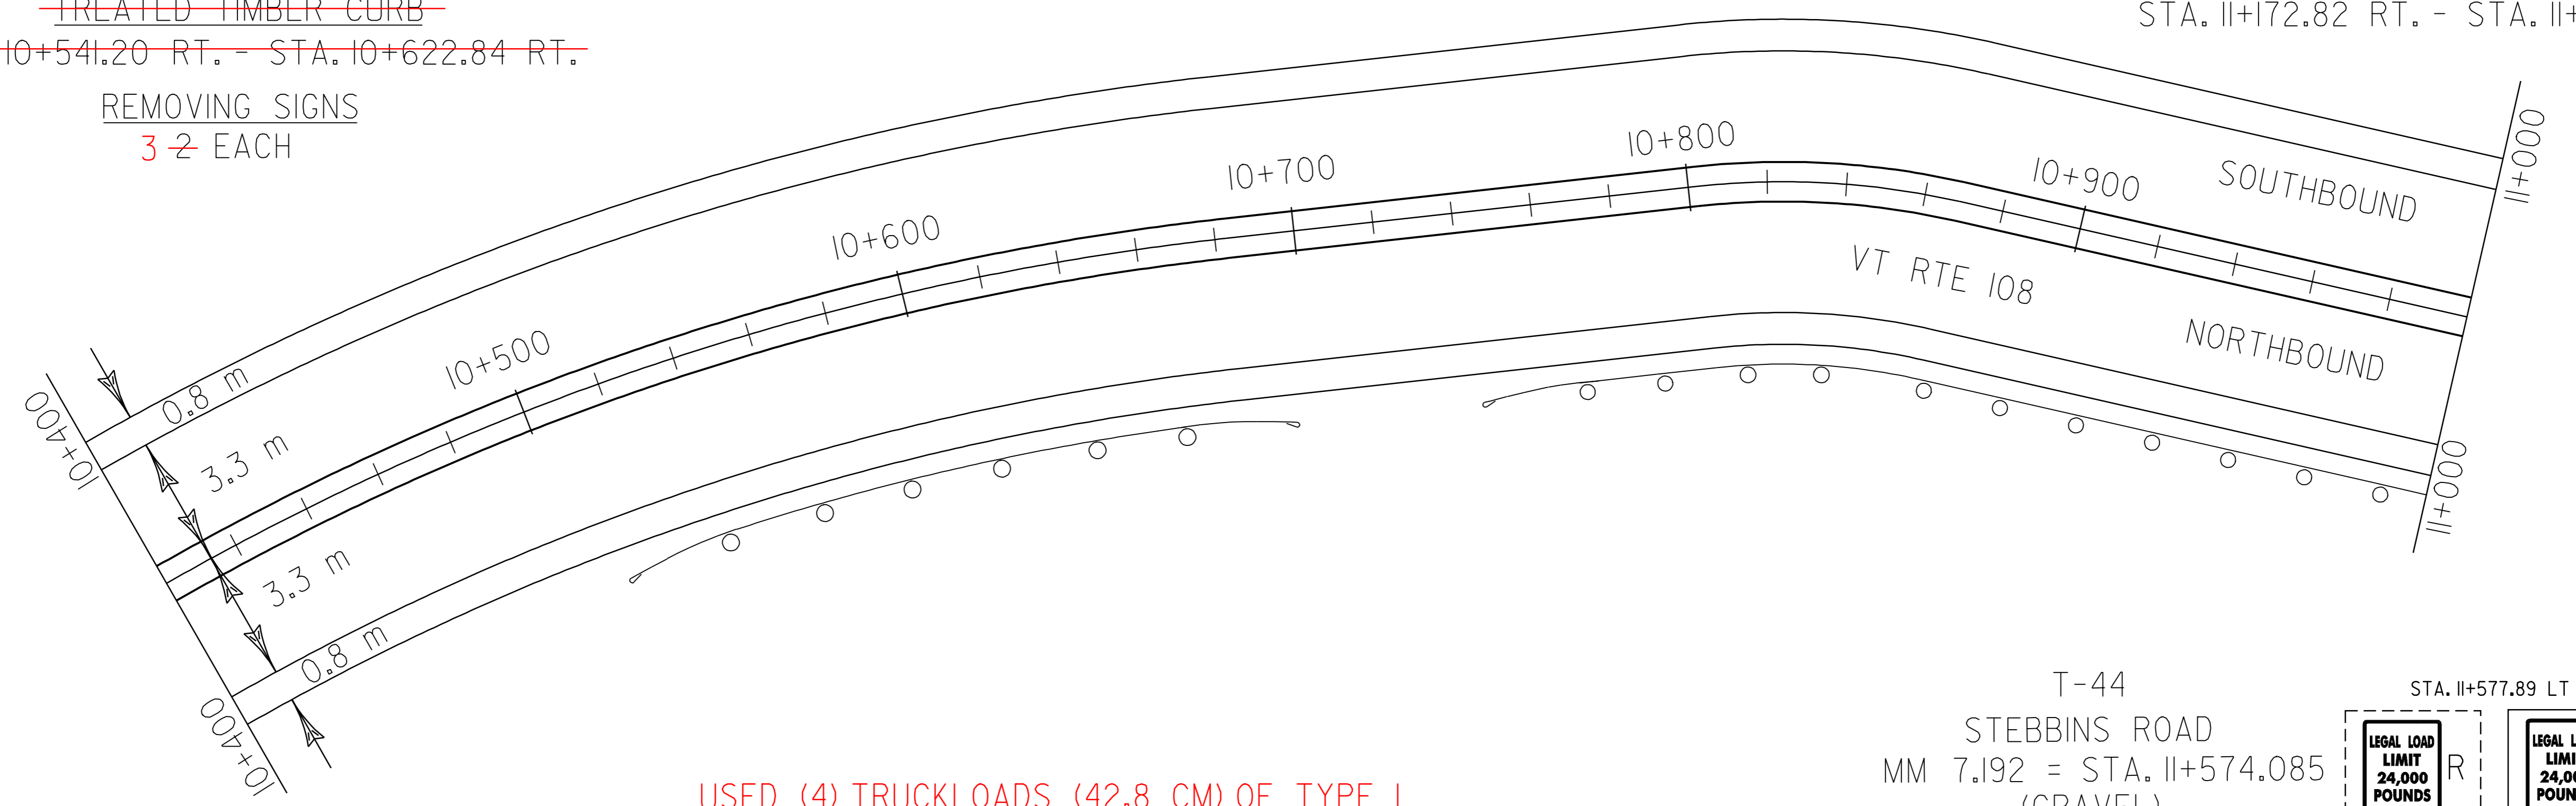

USED (4) TRUCKLOADS (42.8 CM) OF TYPE I  
 STONE FILL, TYPE I# FOR SLOPE STABILIZATION  
 STA. 10+600.00 RT.

MANUFACTURED TERMINAL SECTION (FLARED)  
 STA. 10+509.37 RT. STA. 10+695.51 RT.  
 STA. 10+742.59 RT. STA. 11+048.30 RT.  
 STA. 11+112.81 RT. (TANGENT) STA. 11+161.42 RT.  
 STA. 11+258.58 RT.

ANCHOR FOR STEEL BEAM GUARD RAIL  
 STA. 11+032.41 RT.

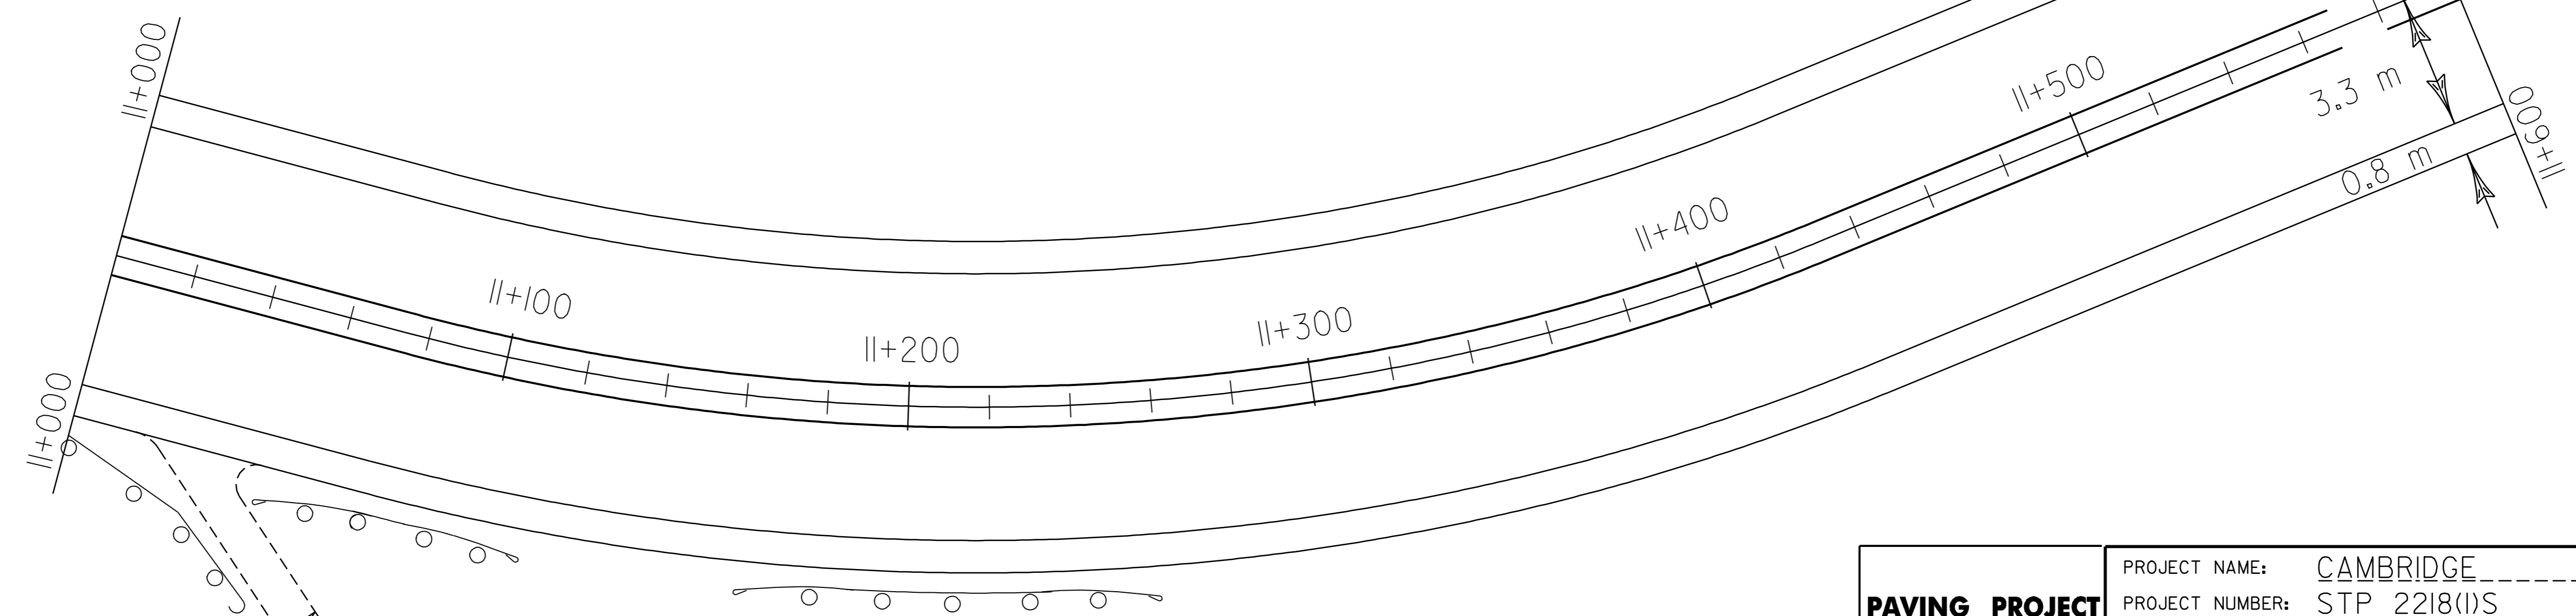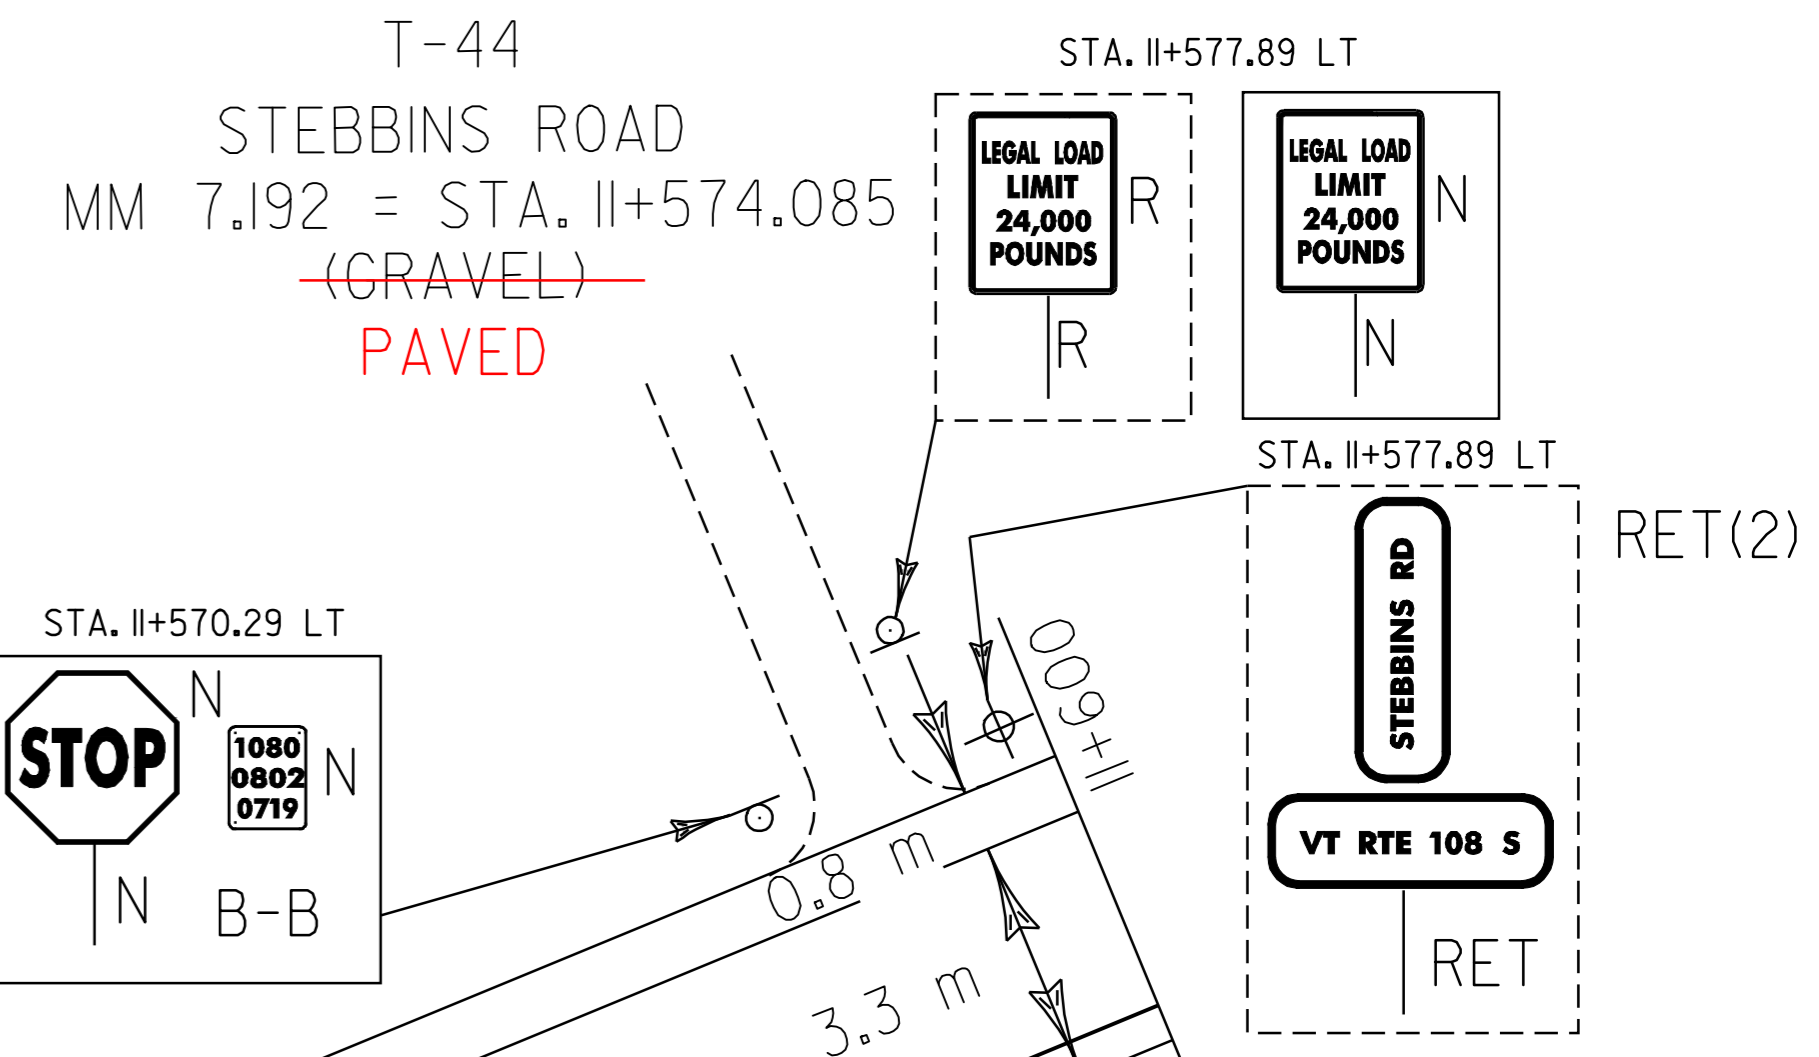

<b>PAVING PROJECT</b>  <b>LAYOUT</b>  <b>#7</b>	PROJECT NAME: CAMBRIDGE
	PROJECT NUMBER: SIP_2218(1)S
	FILE NAME: Z:\pave\299ci88\299ci88.dgn
	DESIGNED BY: KML
RECORDED BY: LOCKE	PLOT DATE: 14-FEB-2006 16:4 DRAWN BY: KML CHECKED BY: PAVI.MGMT. SHEET 14 OF 28



TEMPORARY AND DURABLE 100 mm WHITE LINE  
 STA. 11+600.00 - STA. 12+800.00 RT. & LT.

TEMPORARY AND DURABLE 100 mm YELLOW LINE W/CL BREAKS FOR TH'S  
 STA. 11+600.00 - STA. 12+800.00 RT. & LT. (SOLID)

REMOVING SIGNS  
 2 + EACH



T-42  
 PRATT ROAD  
 MM 7.462 = STA. 12+008.596  
 (GRAVEL) PAVED

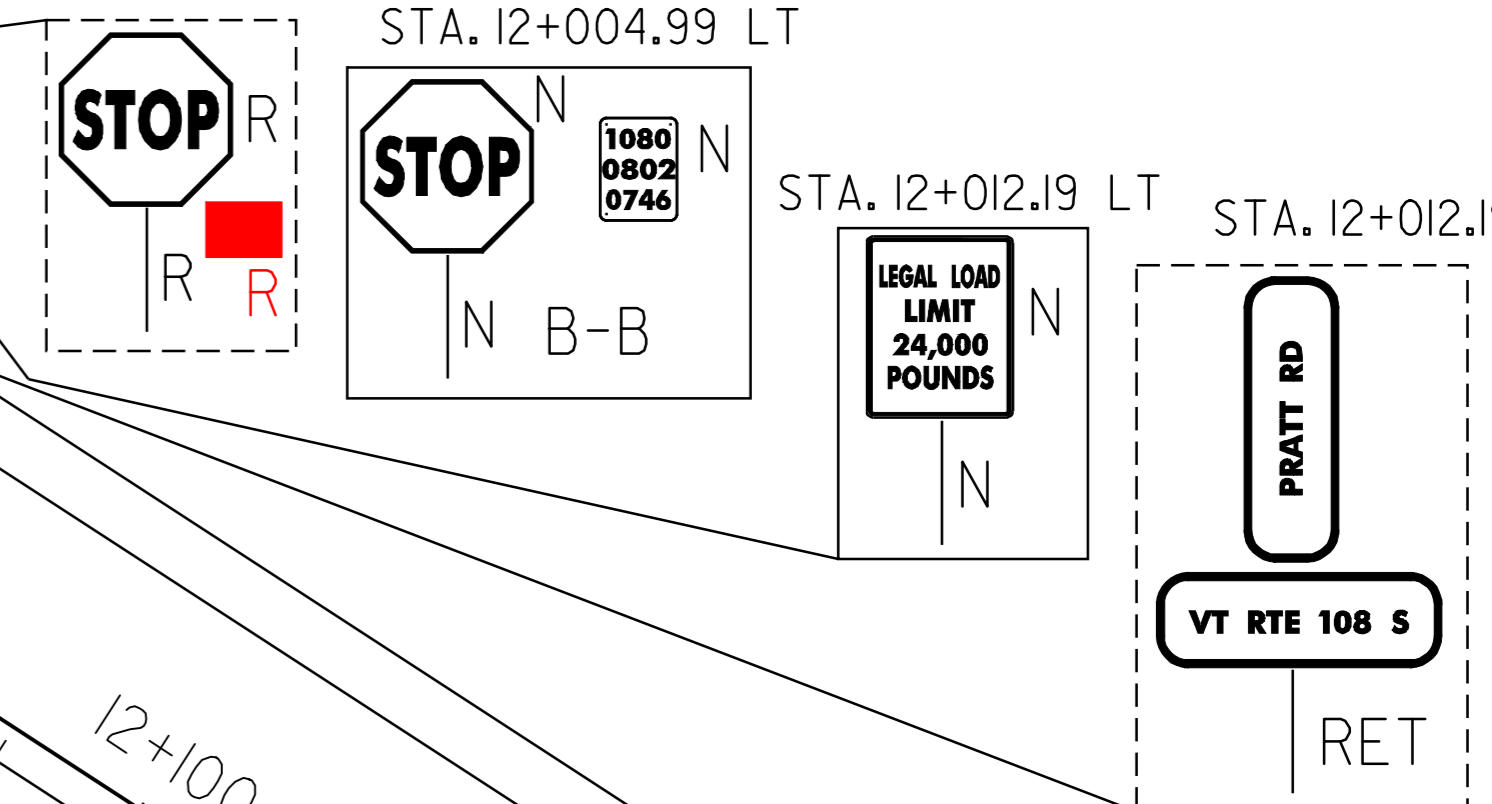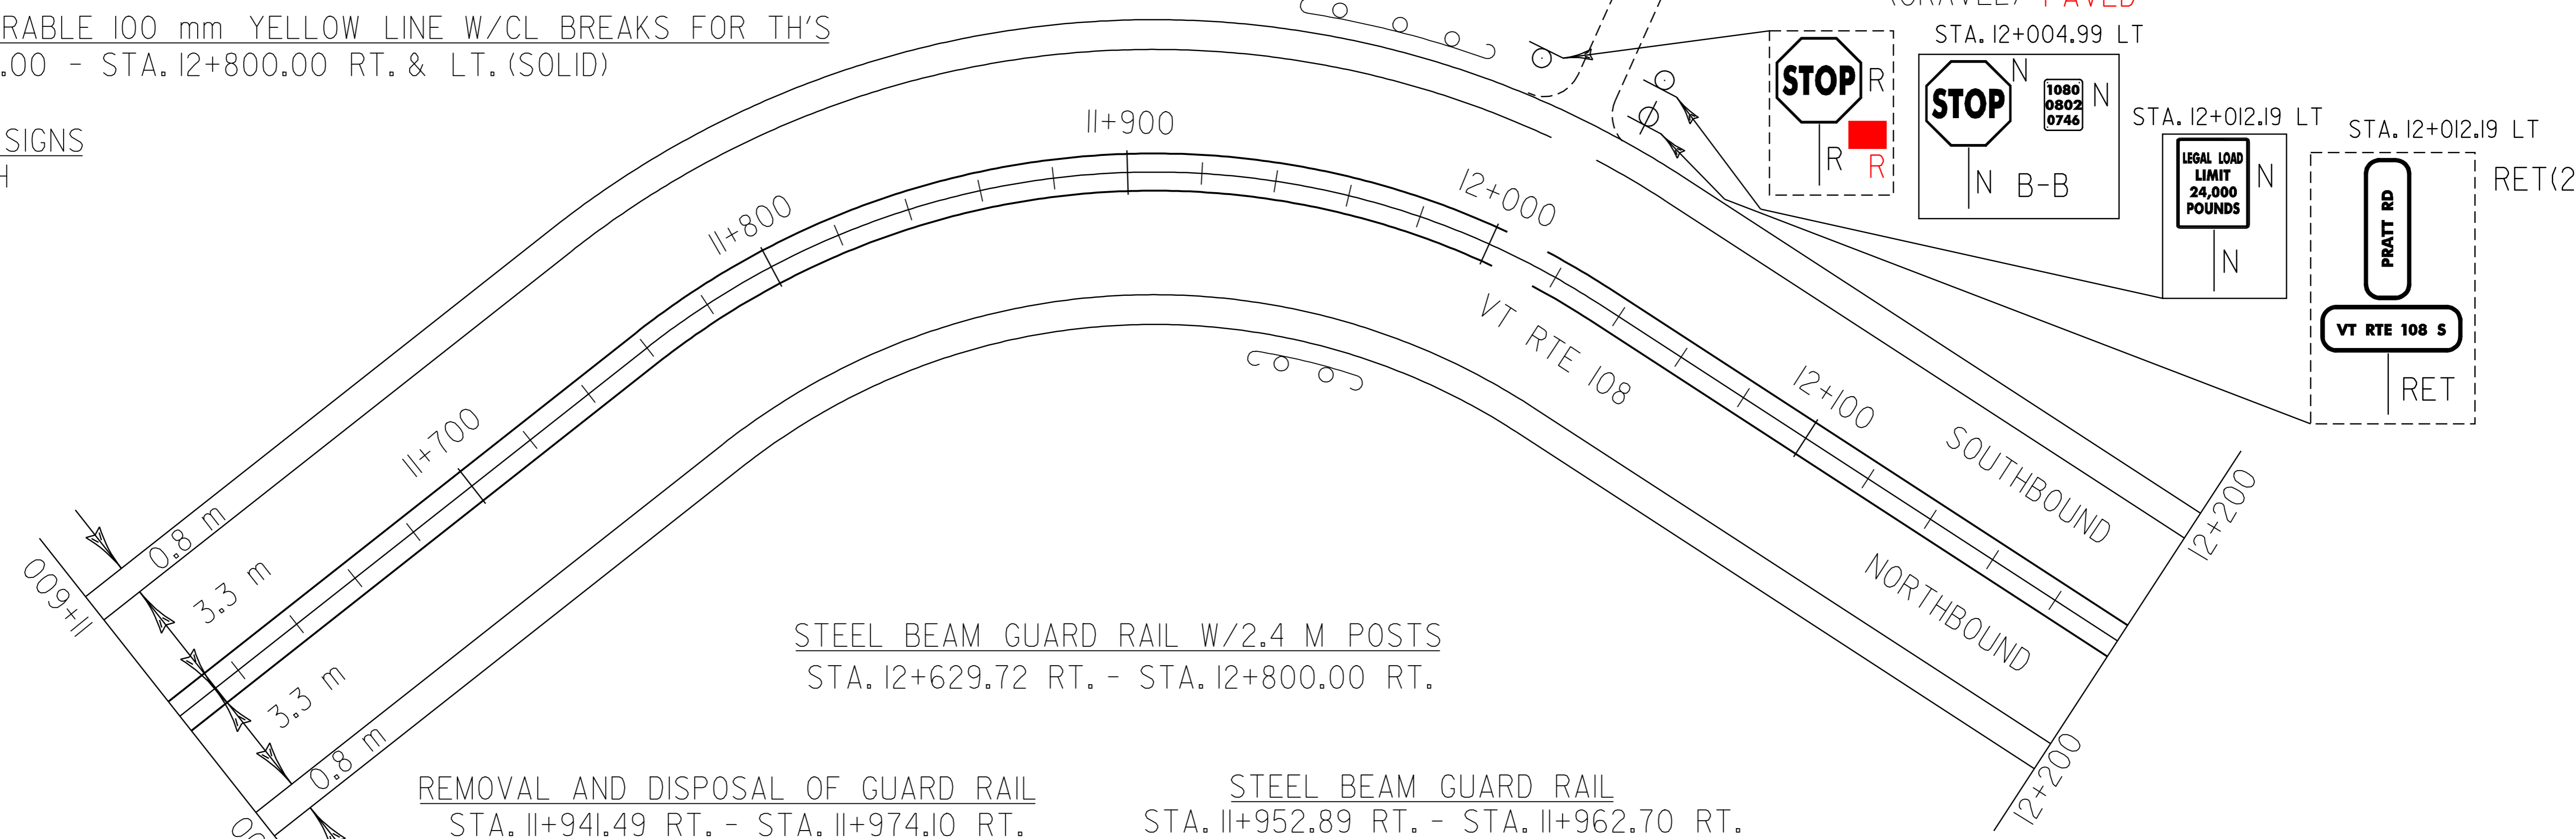

STEEL BEAM GUARD RAIL W/2.4 M POSTS  
 STA. 12+629.72 RT. - STA. 12+800.00 RT.


REMOVAL AND DISPOSAL OF GUARD RAIL  
 STA. 11+941.49 RT. - STA. 11+974.10 RT.  
 STA. 11+941.49 LT. - STA. 11+982.89 LT.  
 STA. 12+343.70 RT. - STA. 12+481.74 RT.  
 STA. 12+618.32 RT. - STA. 12+800.00 RT.

STEEL BEAM GUARD RAIL  
 STA. 11+952.89 RT. - STA. 11+962.70 RT.  
 STA. 11+952.89 LT. - STA. 11+971.49 LT.  
 STA. 12+355.10 RT. - STA. 12+431.30 RT.  
 STA. 12+465.59 RT. - STA. 12+470.34 RT.

MANUFACTURED TERMINAL SECTION (FLARED)  
 STA. 11+941.49 RT. STA. 11+941.49 LT.  
 STA. 11+974.10 RT. STA. 11+982.89 LT.  
 STA. 12+343.70 RT. STA. 12+481.74 RT.  
 STA. 12+618.32 RT. USED GI-D'S

BRIDGE RAIL - H.D. STEEL BEAM FASCIA MOUNTED (MOD. I)  
 STA. 12+431.30 RT. - STA. 12+465.59 RT.

ANCHOR FOR STEEL BEAM GUARD RAIL  
 STA. 12+618.32 RT  
 STA. 12+481.74 RT

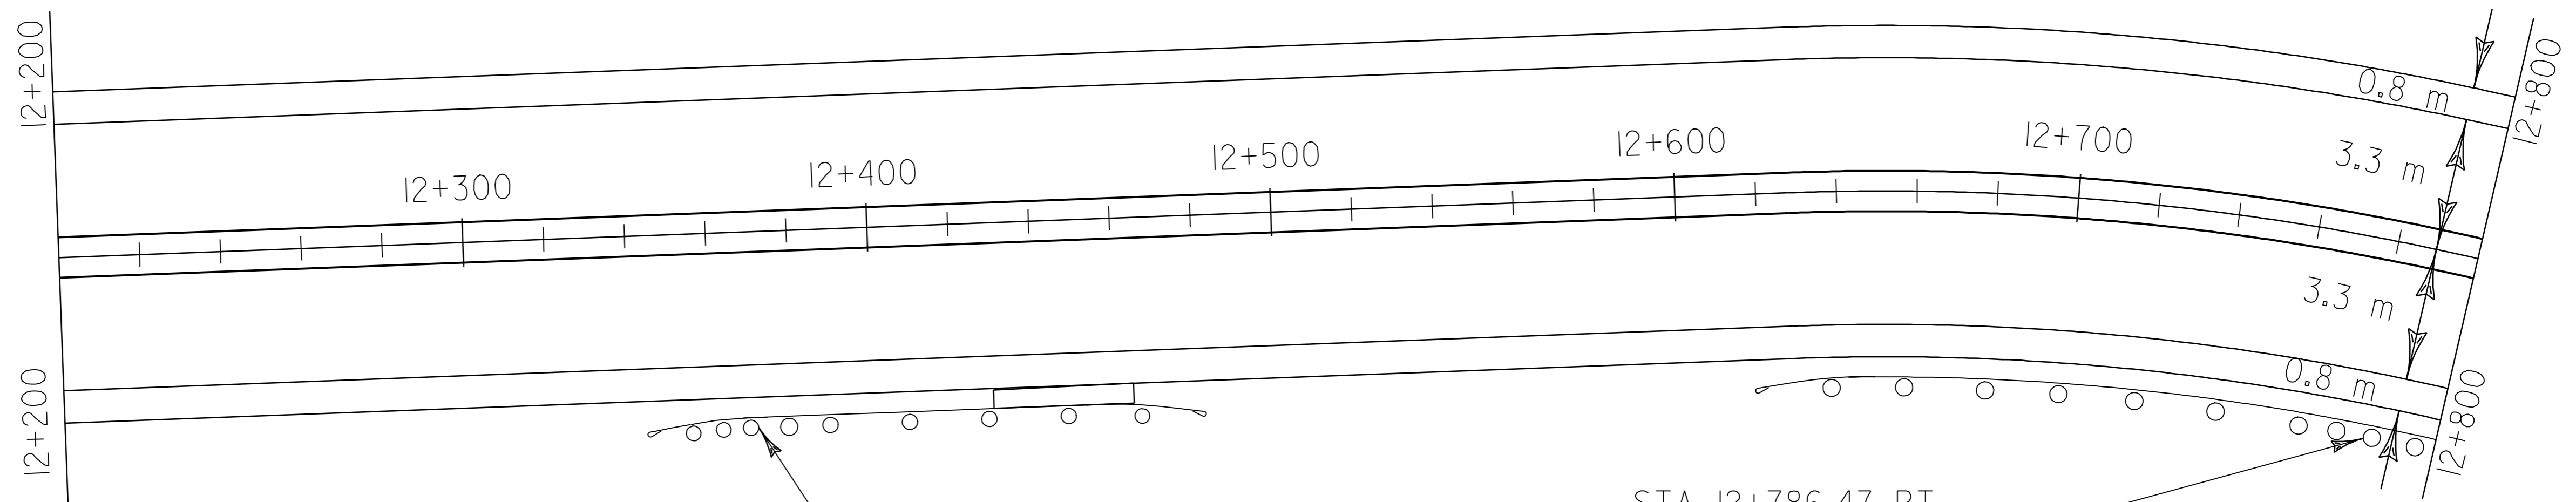

~~STA. 12+359.86 RT.~~  
~~REDUCED POST SPACING~~  
~~SEE DETAIL ON SHEET 27~~  
 NOT NEEDED

STA. 12+786.47 RT.  
 REDUCED POST SPACING  
 SEE DETAIL ON SHEET 27

<b>PAVING PROJECT LAYOUT #8</b>	PROJECT NAME: CAMBRIDGE	PLOT DATE: 14-FEB-2006 16:4
	PROJECT NUMBER: STP_2218(I)S	DRAWN BY: KML
	FILE NAME: Z:\pave\299ci88\299ci88.dgn	CHECKED BY: PAVI.MGMI.
	DESIGNED BY: KML	RECORDED BY: LOCKE
		SHEET 15 OF 28

TEMPORARY AND DURABLE 100 mm WHITE LINE  
STA. 12+800.00 - STA. 13+800.00 LT. & RT.

TEMPORARY AND DURABLE 100 mm YELLOW LINE W/CL BREAKS FOR TH'S  
STA. 12+800.00 - STA. 13+800.00 LT. & RT. (SOLID)

REMOVAL AND DISPOSAL OF GUARD RAIL  
STA. 12+800.00 RT. - STA. 13+213.20 RT.  
~~STA. 13+325.62 RT. - STA. 13+342.87 RT.~~  
~~STA. 13+373.85 RT. - STA. 13+423.01 RT.~~

STEEL BEAM GUARD RAIL W/2.4 M POSTS  
STA. 12+800.00 RT. - STA. 13+201.80 RT. STA. 13+359.91 RT. -  
~~STA. 13+325.62 RT. - STA. 13+342.87 RT. STA. 13+423.01 RT.~~  
~~STA. 13+385.25 RT. - STA. 13+411.61 RT.~~


STEEL BEAM GUARD RAIL  
STA. 13+325.62 RT - STA. 13+359.91 RT

STA. 13+398.31 RT.  
REDUCED POST SPACING  
SEE DETAIL ON SHEET 27

~~MANUFACTURED TERMINAL SECTION (FLARED)~~  
~~STA. 13+213.20 RT. - STA. 13+373.85 RT.~~

~~STA. 13+423.01 RT.~~  
USED GI-D'S


STA. 13+244.901  
END OVERLAY/BEGIN COLD PLANE

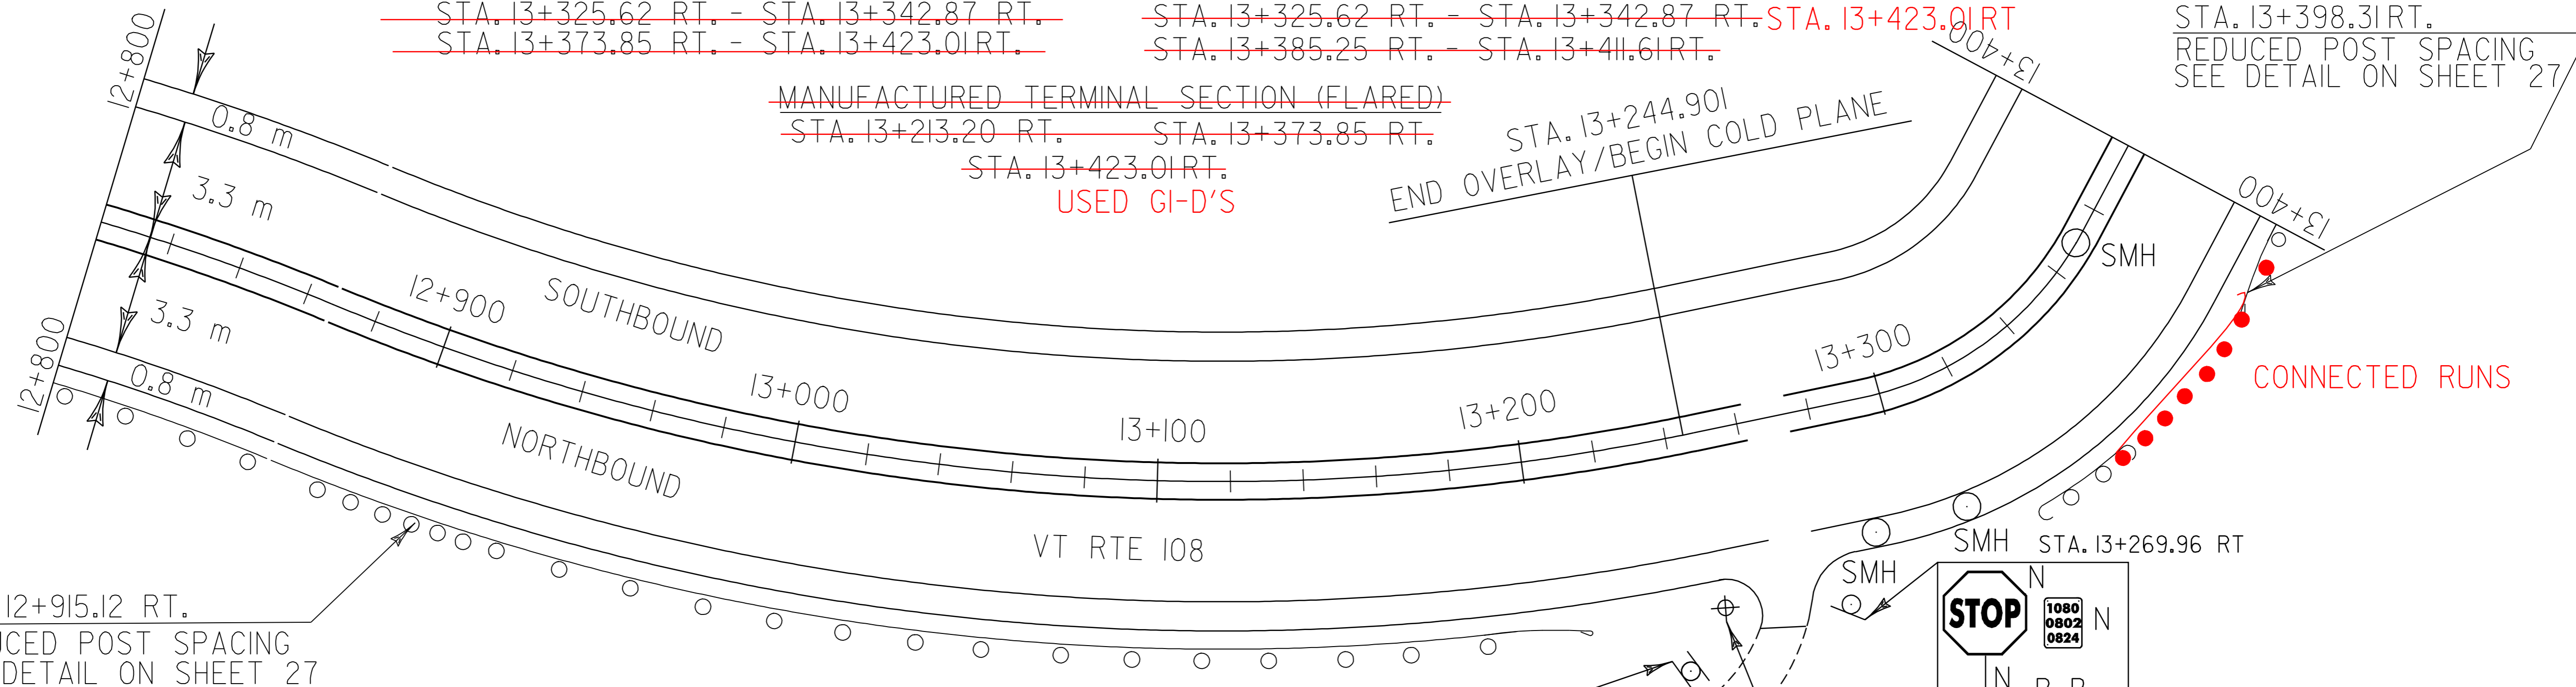

STA. 12+915.12 RT.  
REDUCED POST SPACING  
SEE DETAIL ON SHEET 27



ANCHOR FOR STEEL BEAM GUARD RAIL  
STA. 13+325.62 RT. (1 EACH)  
~~STA. 13+342.87 RT. (1 EACH)~~  
STA. 13+213.20 RT (1 EACH)  
STA. 13+423.01 RT (1 EACH)

ADJUST ELEVATION OF VALVE BOX  
STA. 13+607.00 LT. (WSO)

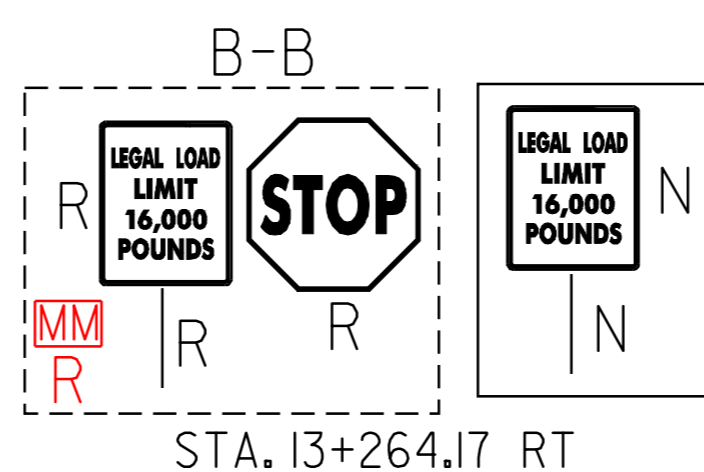

STA. 13+264.17 RT


T-31  
CANYON ROAD  
MM 8.244 = STA. 13+267.069  
(PAVED)

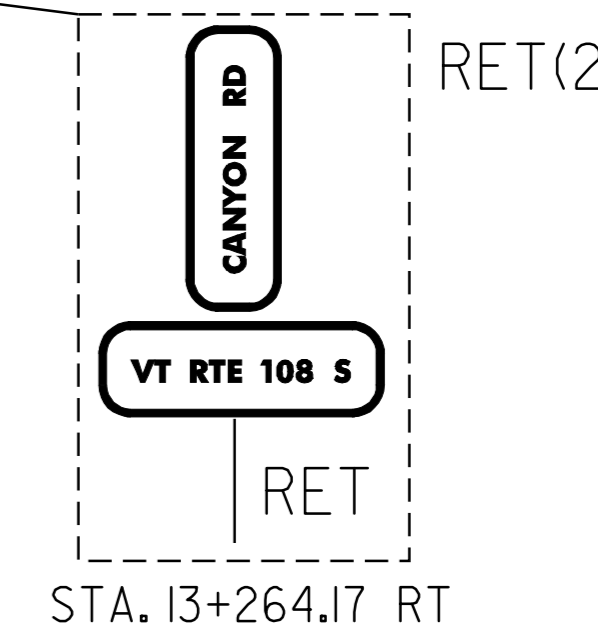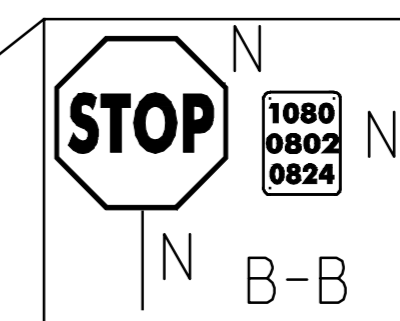

STA. 13+264.17 RT

CHANGE ELEVATION OF SEWER MH

STA. 13+290.00 RT.  
STA. 13+310.00 RT.  
~~STA. 13+370.00 CL. NOT FOUND~~  
STA. 13+430.00 RT.  
STA. 13+520.00 RT.  
STA. 13+580.00 RT.  
STA. 13+660.00 RT.  
STA. 13+660.00 LT.  
STA. 13+740.00 LT.

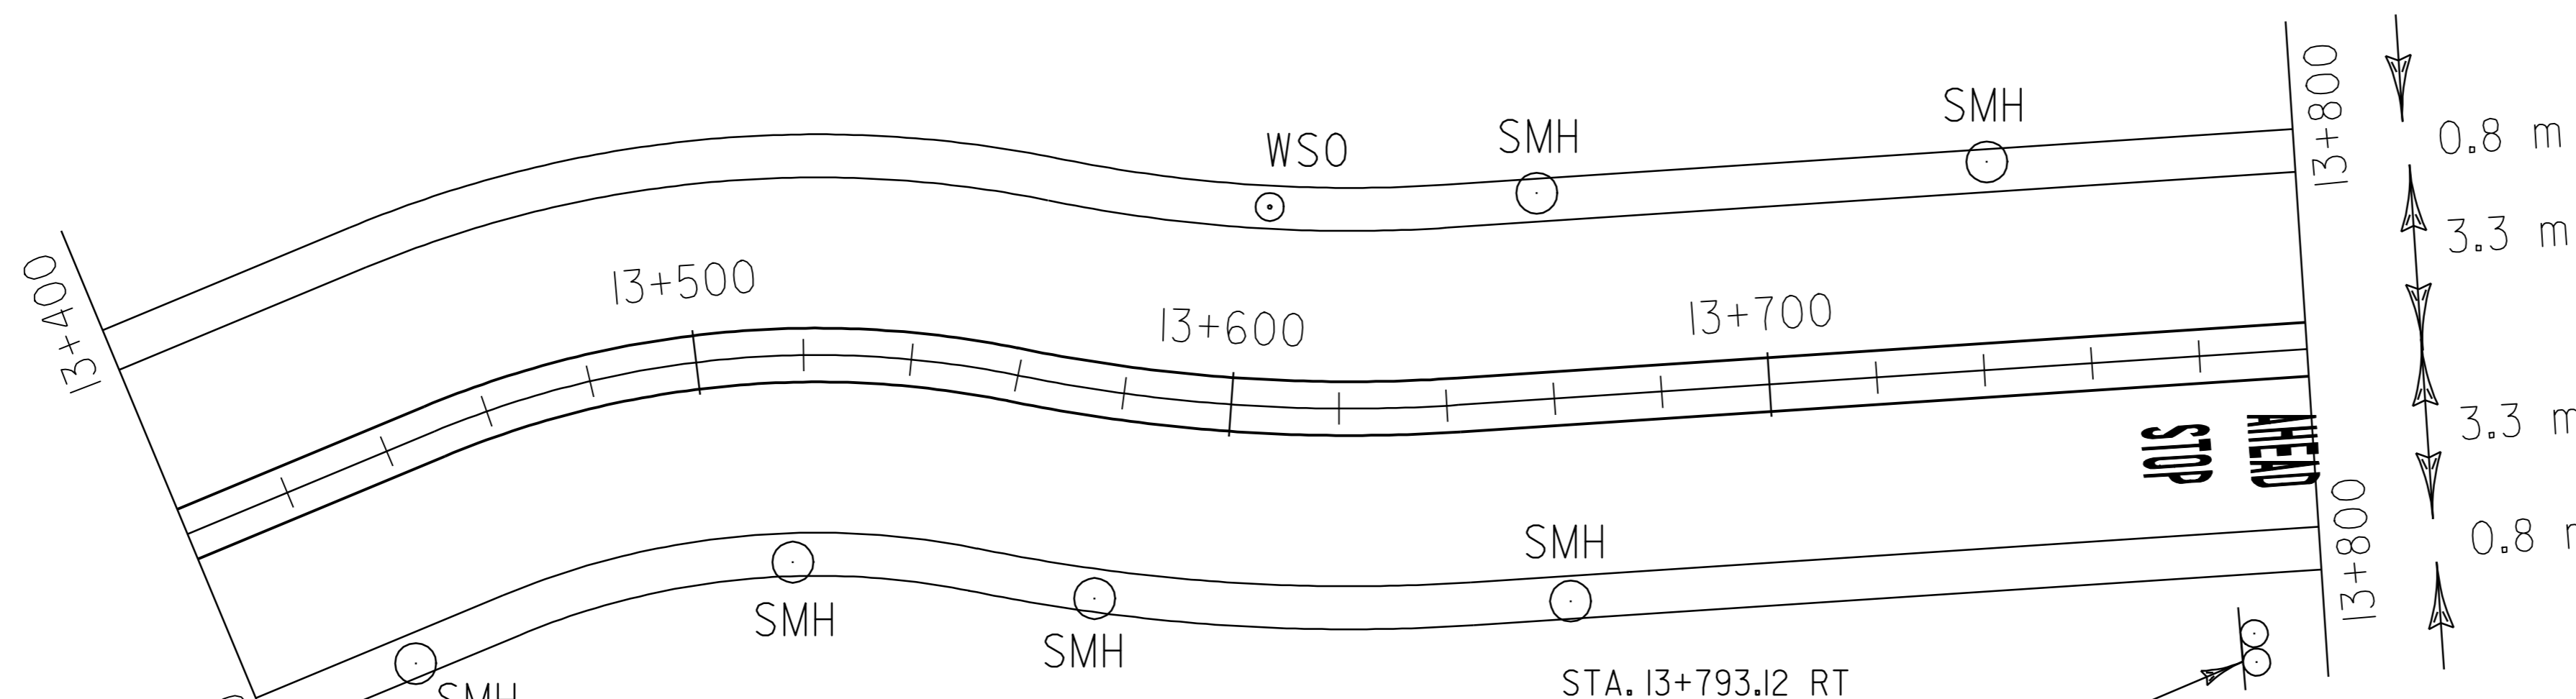


REHABILITATION OF DI, CB, OR MH CLASS I  
STA. 13+640.00 LT.


REMOVING SIGNS  
4 3 EACH

RELOCATE MAIL BOX, MULTIPLE SUPPORT  
~~STA. 13+423.01 RT.~~

~~TEMPORARY AND DURABLE LETTERS OR SYMBOLS~~  
STA. 13+788.32 RT. (STOP)  
STA. 13+797.92 RT. (AHEAD)

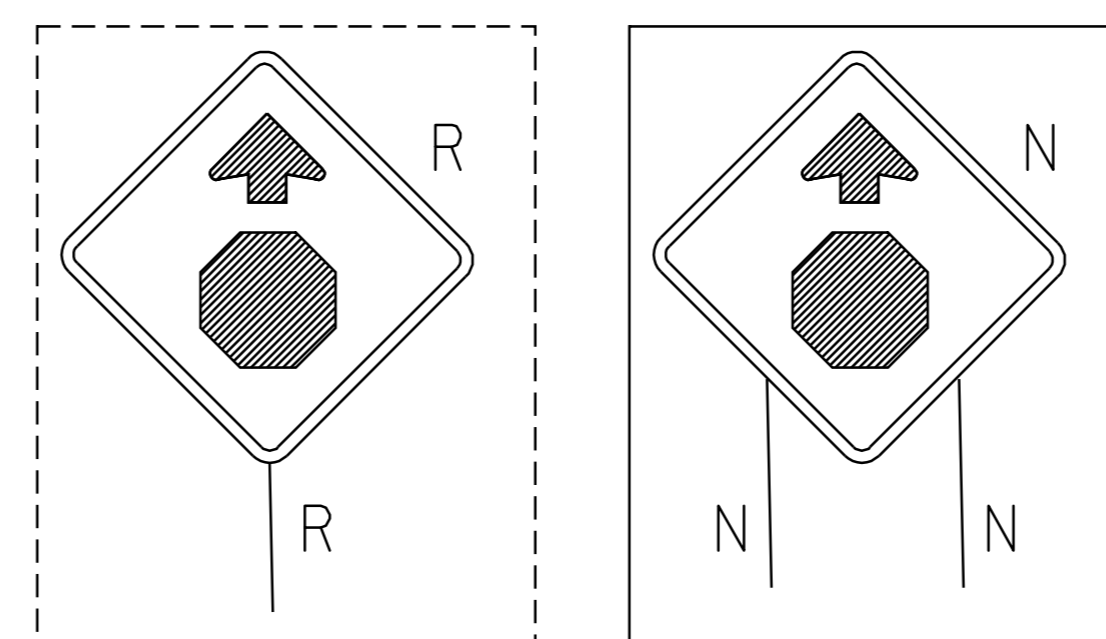

<b>PAVING PROJECT LAYOUT #9</b>	PROJECT NAME: CAMBRIDGE	PLOT DATE: 14-FEB-2006 16:4
	PROJECT NUMBER: SIP_2218(1)S	DRAWN BY: KML
	FILE NAME: Z:\pave\299cl88\299cl88.dgn	CHECKED BY: PAVI.MGMT.
	DESIGNED BY: KML	RECORDED BY: LOCKE
		SHEET 16 OF 28

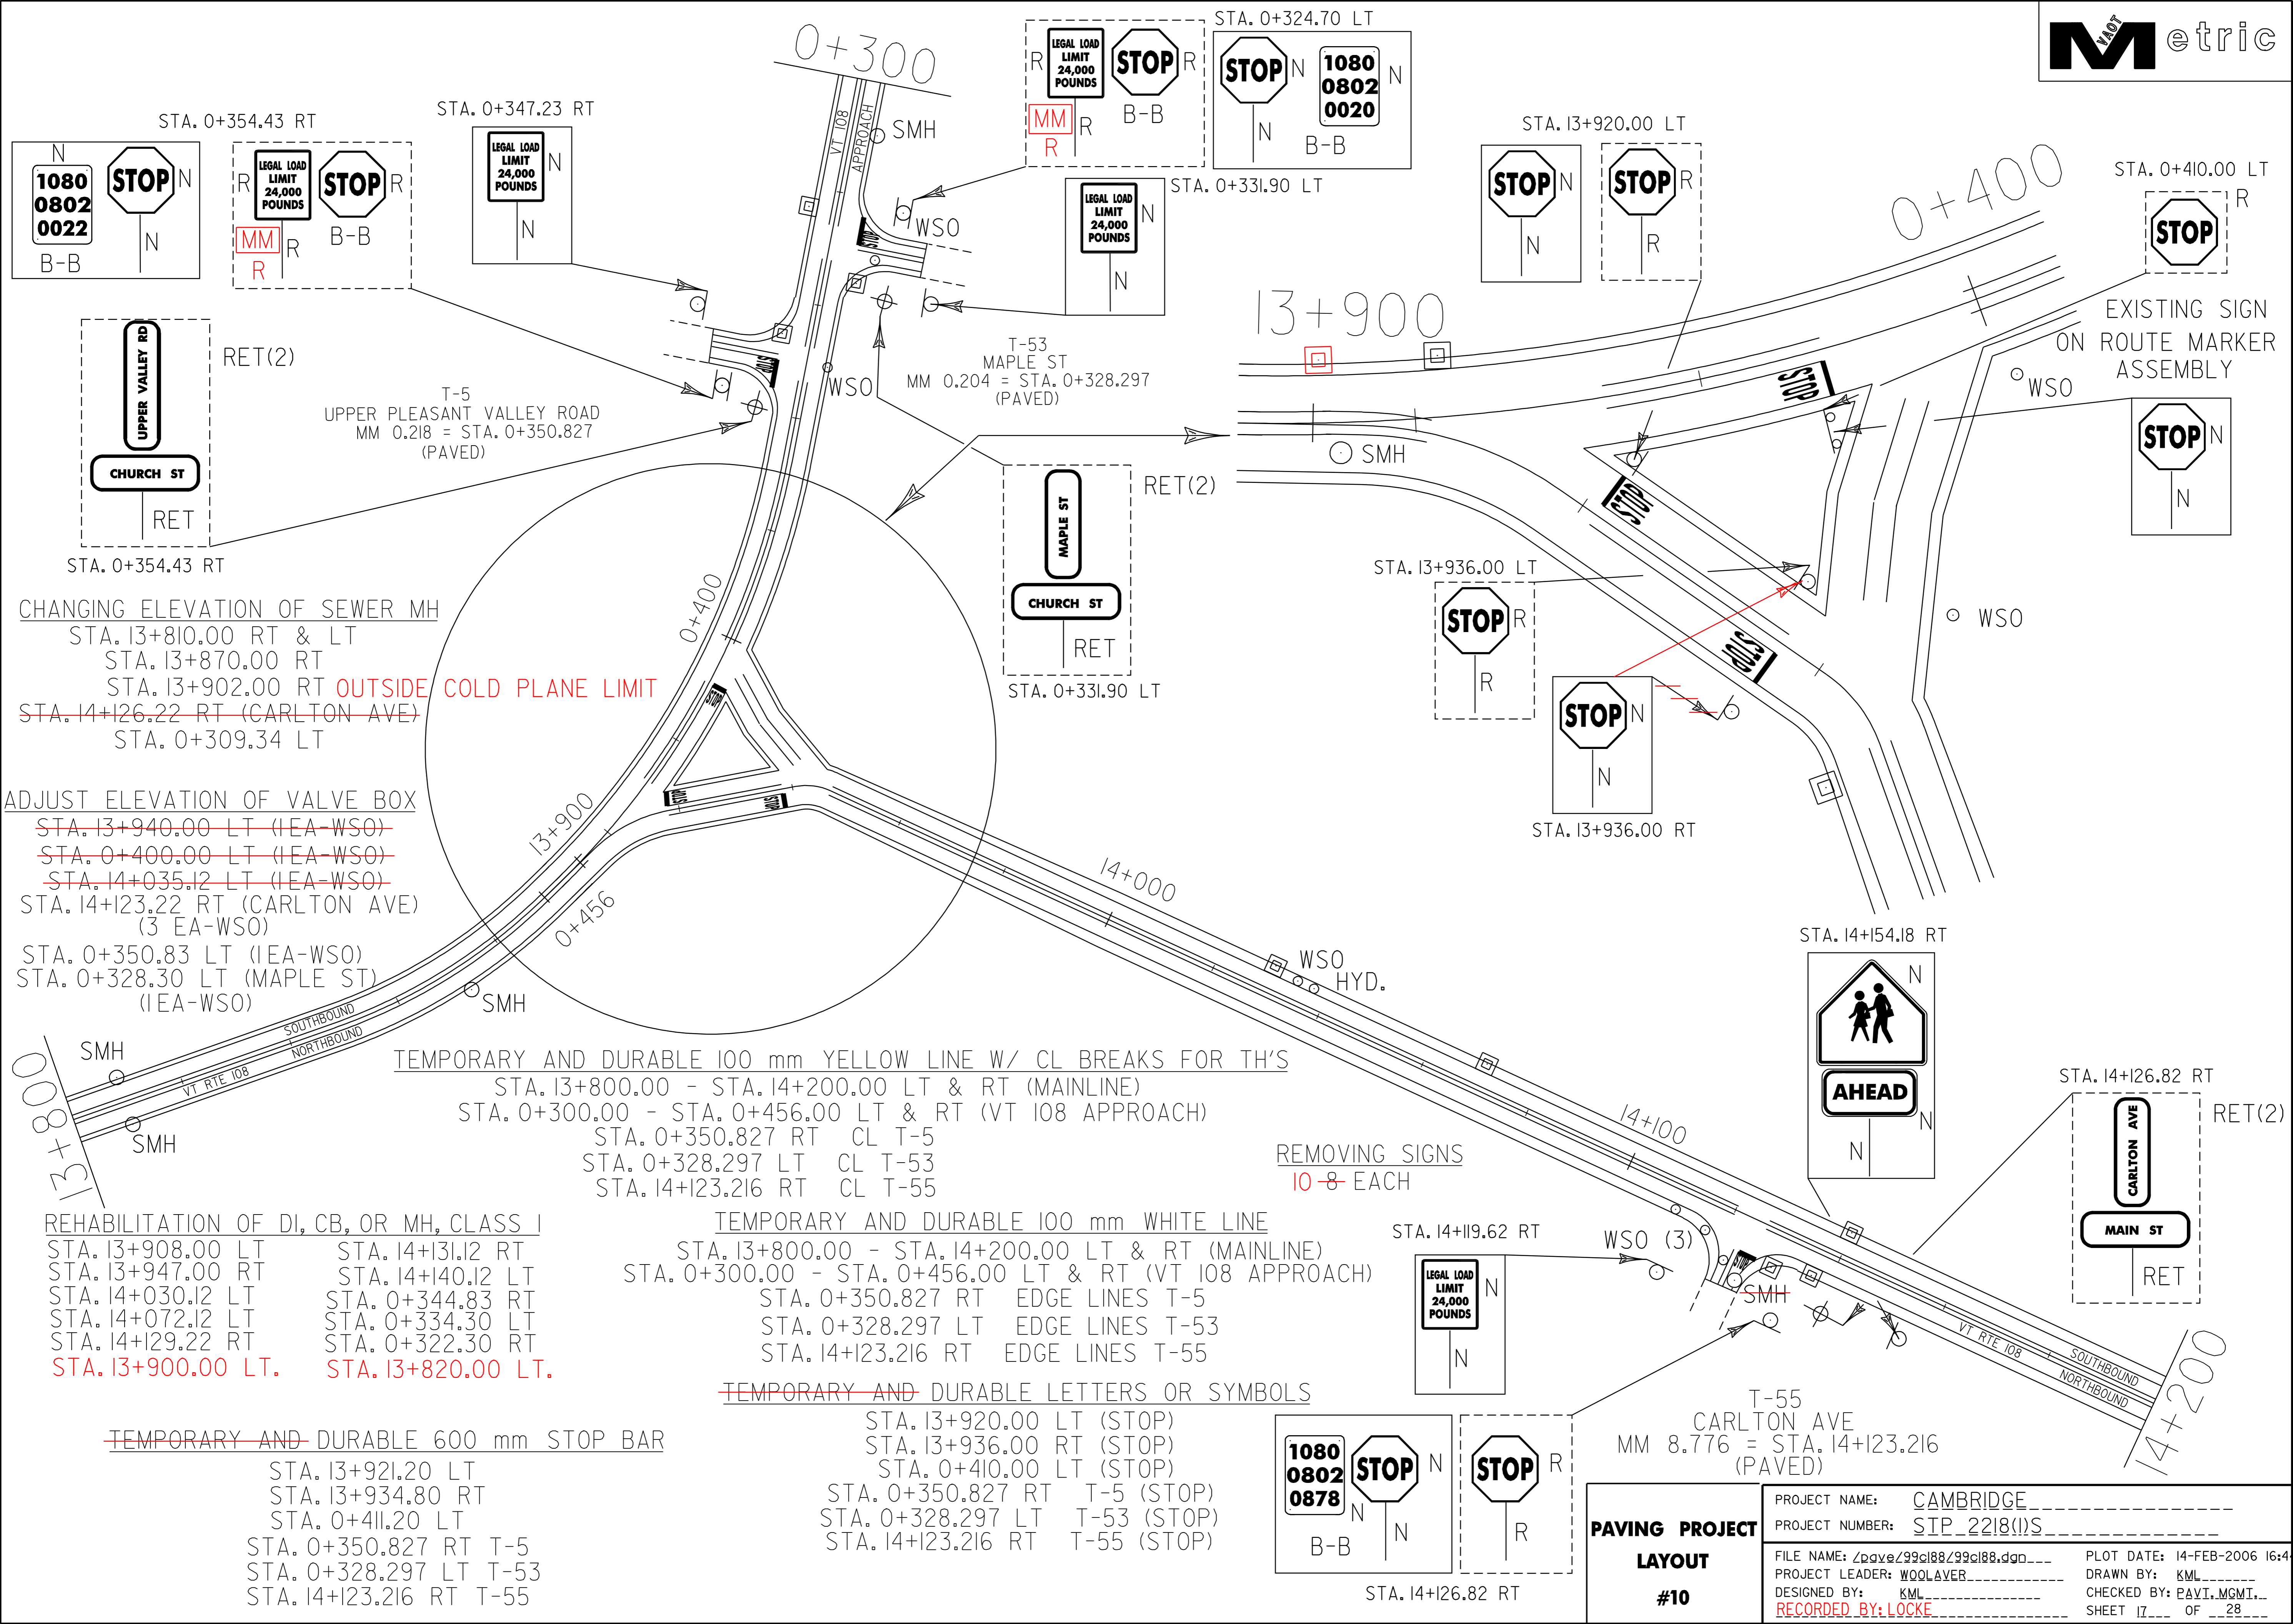

STA. 0+354.43 RT

STA. 0+347.23 RT

STA. 0+324.70 LT

STA. 13+920.00 LT

STA. 0+410.00 LT

STA. 0+331.90 LT

13+900

0+400

T-5  
UPPER PLEASANT VALLEY ROAD  
MM 0.218 = STA. 0+350.827  
(PAVED)

T-53  
MAPLE ST  
MM 0.204 = STA. 0+328.297  
(PAVED)

EXISTING SIGN  
ON ROUTE MARKER  
ASSEMBLY

CHANGING ELEVATION OF SEWER MH  
STA. 13+810.00 RT & LT  
STA. 13+870.00 RT  
STA. 13+902.00 RT  
~~STA. 14+126.22 RT (CARLTON AVE)~~  
STA. 0+309.34 LT

**COLD PLANE LIMIT**

ADJUST ELEVATION OF VALVE BOX  
~~STA. 13+940.00 LT (IEA-WSO)~~  
~~STA. 0+400.00 LT (IEA-WSO)~~  
~~STA. 14+035.12 LT (IEA-WSO)~~  
STA. 14+123.22 RT (CARLTON AVE)  
(3 EA-WSO)  
STA. 0+350.83 LT (IEA-WSO)  
STA. 0+328.30 LT (MAPLE ST)  
(IEA-WSO)

TEMPORARY AND DURABLE 100 mm YELLOW LINE W/ CL BREAKS FOR TH'S  
STA. 13+800.00 - STA. 14+200.00 LT & RT (MAINLINE)  
STA. 0+300.00 - STA. 0+456.00 LT & RT (VT 108 APPROACH)  
STA. 0+350.827 RT CL T-5  
STA. 0+328.297 LT CL T-53  
STA. 14+123.216 RT CL T-55

REMOVING SIGNS  
~~10~~ EACH

REHABILITATION OF DI, CB, OR MH, CLASS I  
STA. 13+908.00 LT  
STA. 13+947.00 RT  
STA. 14+030.12 LT  
STA. 14+072.12 LT  
STA. 14+129.22 RT  
**STA. 13+900.00 LT.**  
STA. 14+131.12 RT  
STA. 14+140.12 RT  
STA. 0+344.83 RT  
STA. 0+334.30 LT  
STA. 0+322.30 RT  
**STA. 13+820.00 LT.**

TEMPORARY AND DURABLE 100 mm WHITE LINE  
STA. 13+800.00 - STA. 14+200.00 LT & RT (MAINLINE)  
STA. 0+300.00 - STA. 0+456.00 LT & RT (VT 108 APPROACH)  
STA. 0+350.827 RT EDGE LINES T-5  
STA. 0+328.297 LT EDGE LINES T-53  
STA. 14+123.216 RT EDGE LINES T-55

~~TEMPORARY AND DURABLE LETTERS OR SYMBOLS~~  
STA. 13+920.00 LT (STOP)  
STA. 13+936.00 RT (STOP)  
STA. 0+410.00 LT (STOP)  
STA. 0+350.827 RT T-5 (STOP)  
STA. 0+328.297 LT T-53 (STOP)  
STA. 14+123.216 RT T-55 (STOP)

~~TEMPORARY AND DURABLE 600 mm STOP BAR~~  
STA. 13+921.20 LT  
STA. 13+934.80 RT  
STA. 0+411.20 LT  
STA. 0+350.827 RT T-5  
STA. 0+328.297 LT T-53  
STA. 14+123.216 RT T-55

**PAVING PROJECT  
LAYOUT  
#10**

PROJECT NAME: CAMBRIDGE  
PROJECT NUMBER: SIP\_2218(1)S  
FILE NAME: Z:\pave\299cl88\299cl88.dgn  
PROJECT LEADER: WOOLAYER  
DESIGNED BY: KML  
RECORDED BY: LOCKE  
PLOT DATE: 14-FEB-2006 16:4  
DRAWN BY: KML  
CHECKED BY: PAVI.MGMT.  
SHEET 17 OF 28

TEMPORARY AND DURABLE 100 mm WHITE LINE  
 STA. 14+200.00 - STA. 14+583.875 LT. & RT.  
 STA. 14+303.458 RT (T-55) EDGE LINES  
 STA. 14+303.458 RT (T-55) EDGE LINES (T-53)  
 STA. 14+435.421 RT (T-73) EDGE LINES


TEMPORARY AND DURABLE 100 mm YELLOW LINE W/ CL BREAKS FOR TH'S  
 STA. 14+200.00 - STA. 14+583.875 LT. & RT. (SOLID)  
 STA. 14+303.458 RT (T-55) CL  
 STA. 14+303.458 RT (T-55) CL  
 STA. 14+435.421 RT (T-73) CL

REMOVING SIGNS  
 15 ~~13~~ EACH

~~TEMPORARY AND DURABLE LETTERS OR SYMBOLS~~

STA. 14+303.458 LT (T-53) (STOP)  
 STA. 14+303.458 LT (T-53) (STOP)  
 STA. 14+435.421 RT (T-73) (STOP)  
~~STA. 14+374.688 RT (STOP)~~ NOT WARRANTED  
~~STA. 14+384.288 RT (AHEAD)~~ NOT WARRANTED  
 STA. 14+580.275 RT (STOP)


~~TEMPORARY AND DURABLE CROSSWALK MARKINGS WITH DIAGONAL LINES~~  
 STA. 14+210.119

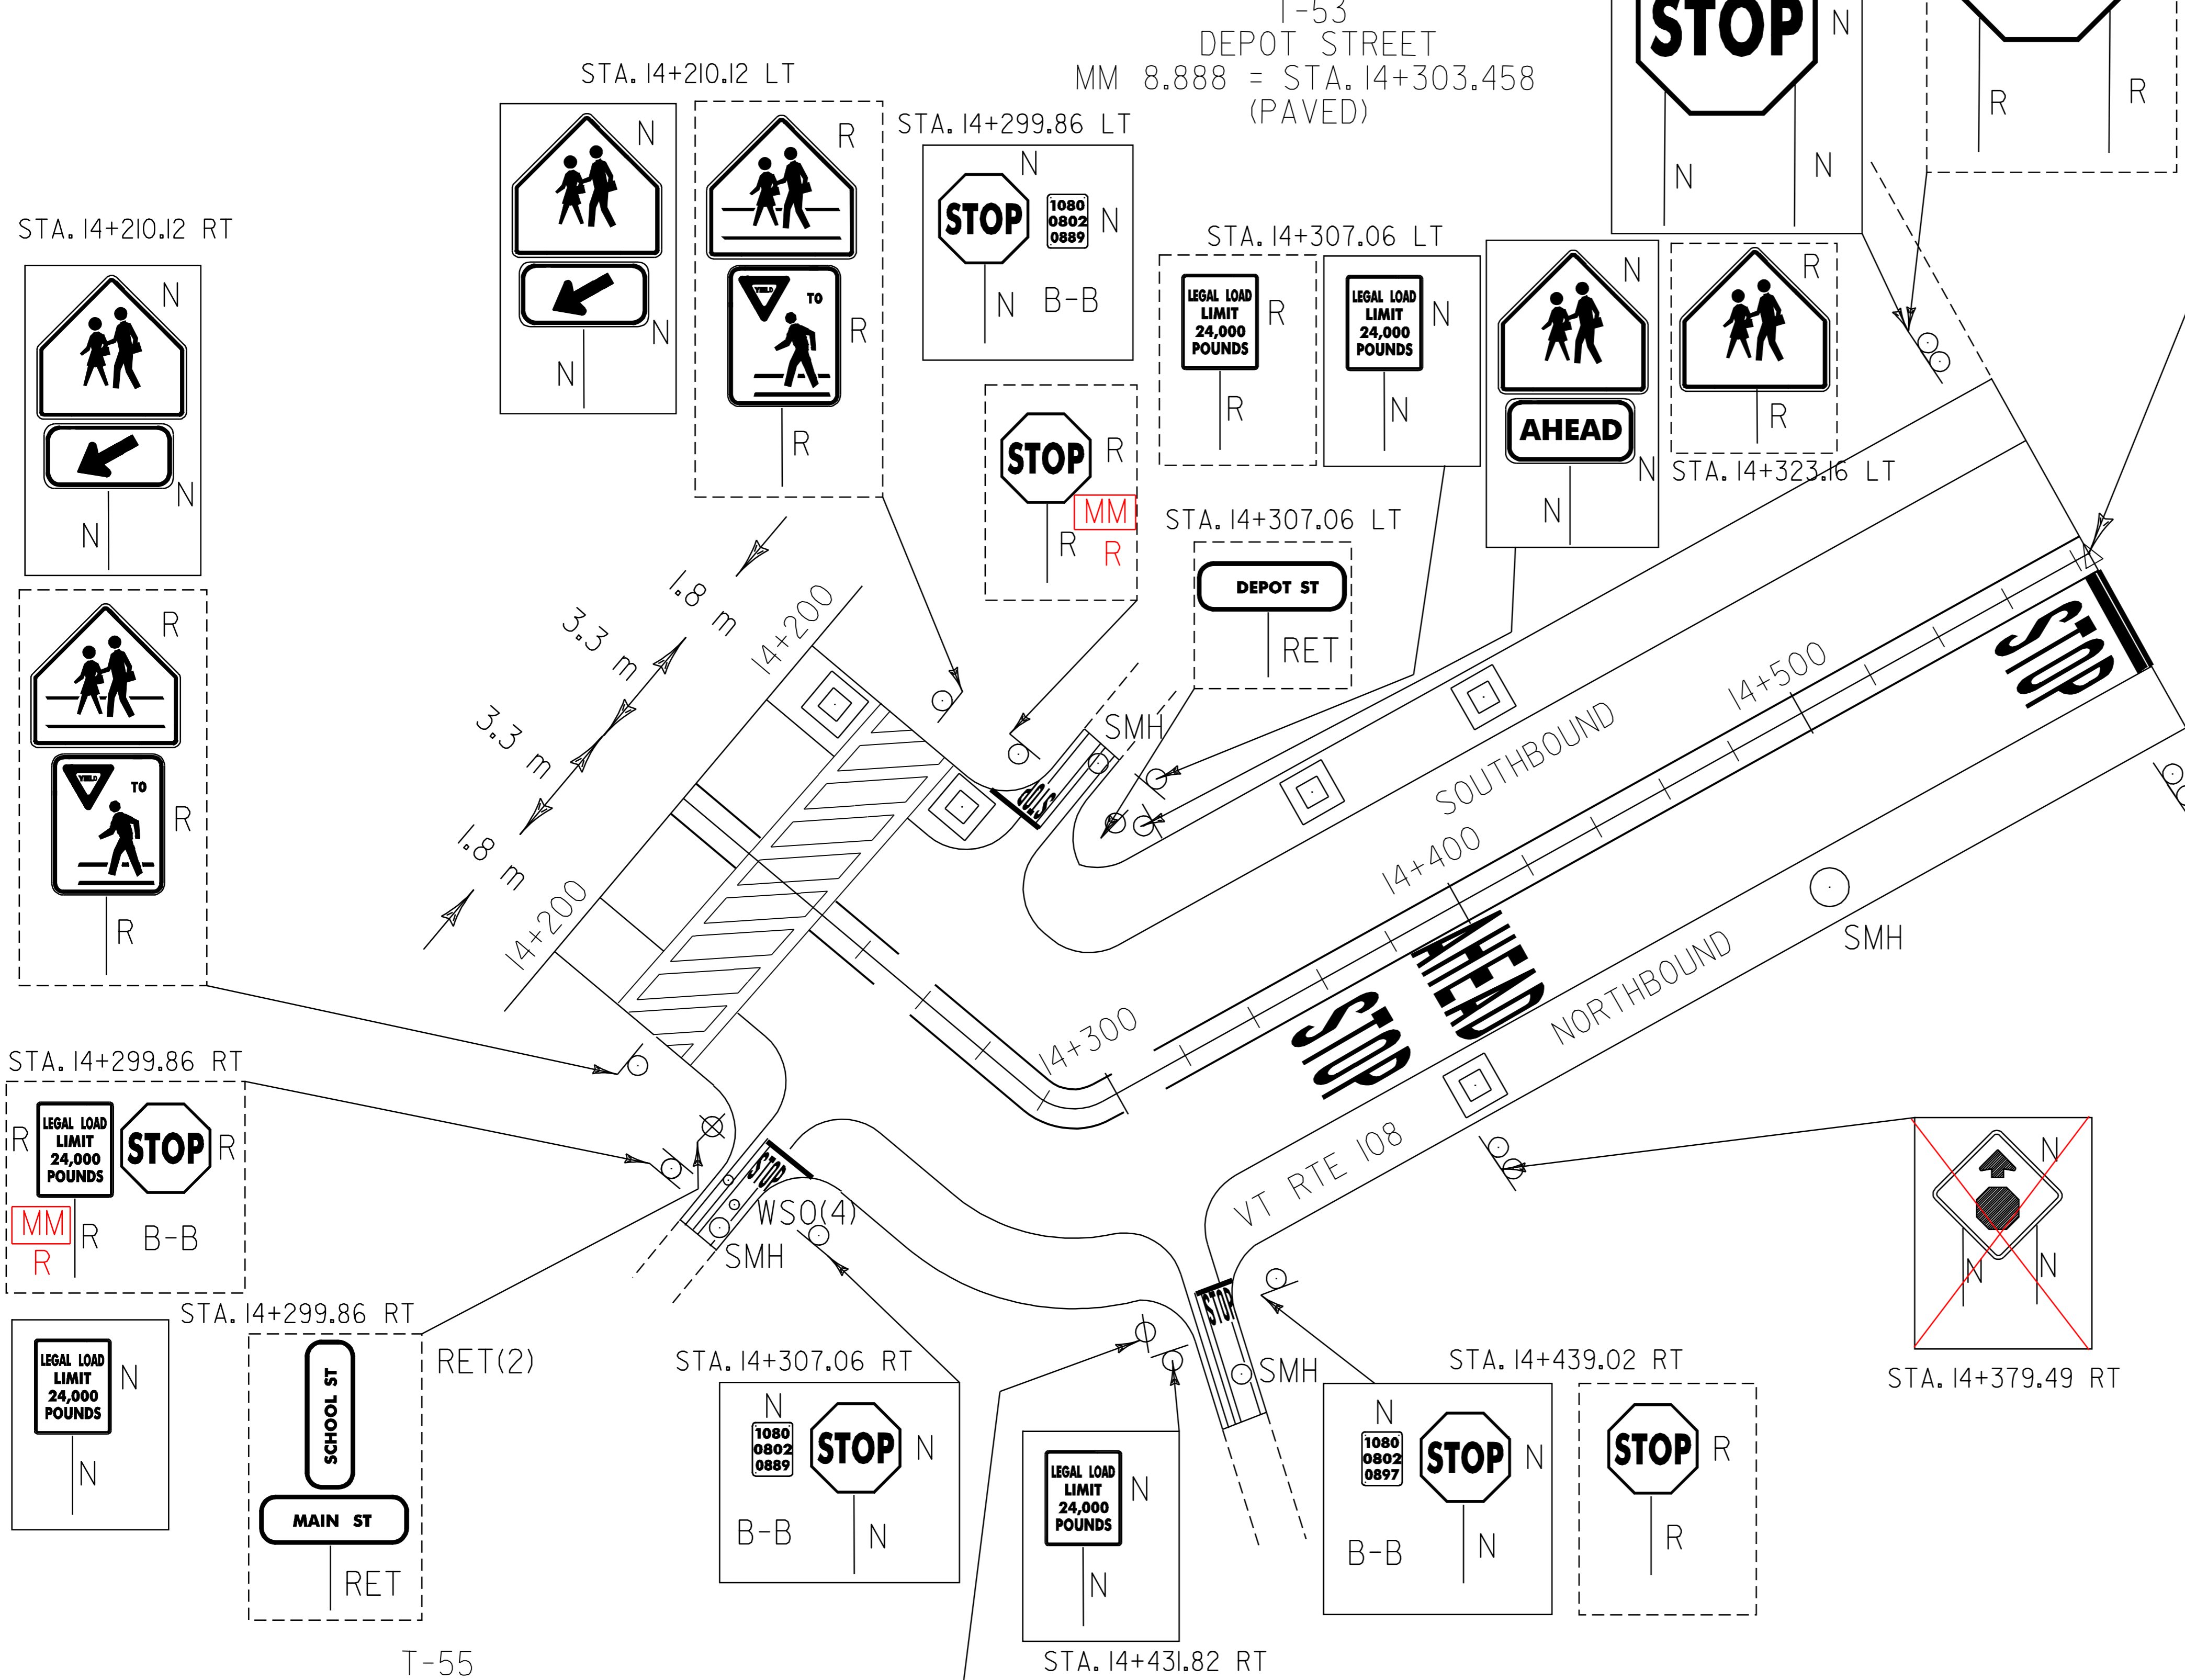

END PROJECT STP 2218(I)S  
 STA. 14+583.875 = MM 9.062

~~TEMPORARY AND DURABLE 600 mm STOP BAR~~

STA. 14+303.458 LT (T-53)  
 STA. 14+303.458 RT (T-55)  
 STA. 14+435.421 RT (T-73)  
 STA. 14+582.675 RT.

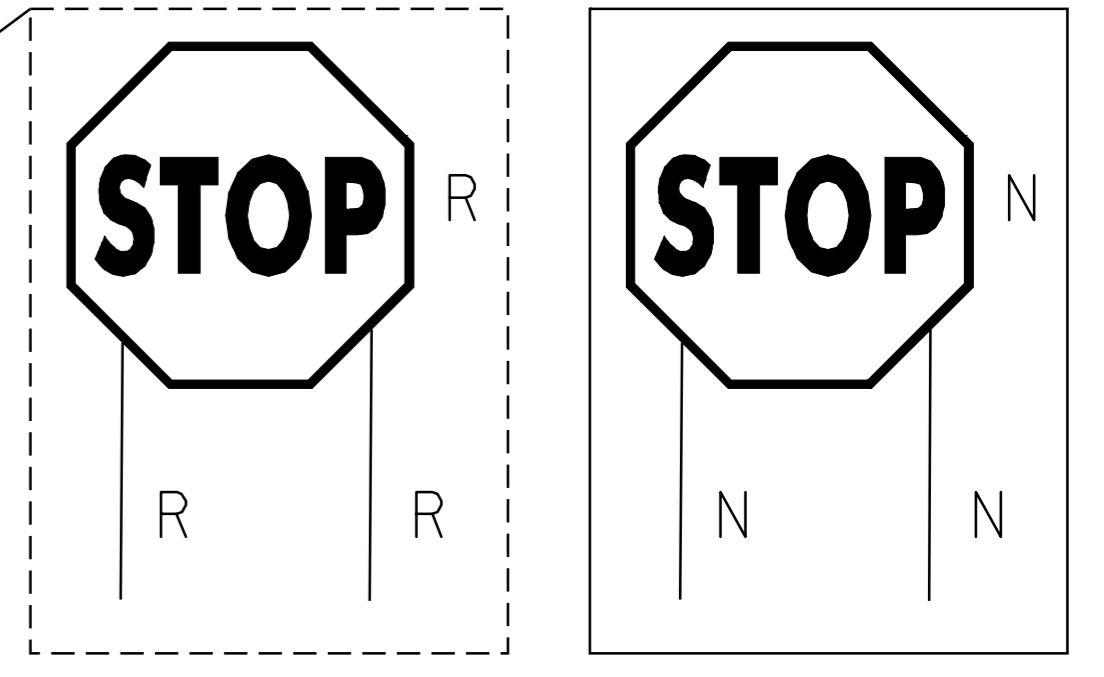

CHANGING ELEVATION OF SEWER MANHOLE

STA. 14+303.458 RT. (SCHOOL ST.)  
 STA. 14+303.458 LT. (DEPOT ST.)  
 STA. 14+435.421 RT. (OLD MAIN ST.)  
 STA. 14+488.421 RT.

REHABILITATION OF DI, CB, OR MH, CLASS I

STA. 14+205.119 LT.  
 STA. 14+297.458 LT.  
~~STA. 14+385.421 LT.~~ OUTSIDE PAVING LIMIT  
 STA. 14+385.421 RT.  
 STA. 14+435.421 LT.

ADJUST ELEVATION OF VALVE BOX  
 STA. 14+303.458 RT. (SCHOOL ST) (4 EA-WSO)  
 3

**PAVING PROJECT LAYOUT #11**

PROJECT NAME:	CAMBRIDGE		
PROJECT NUMBER:	STP_2218(I)S		
FILE NAME:	Z:\pave\299cl88\299cl88.dgn	PLOT DATE:	14-FEB-2006 16:4
PROJECT LEADER:	WQCLAYER	DRAWN BY:	KML
DESIGNED BY:	KML	CHECKED BY:	PAVI.MGMT.
RECORDED BY:	LOCKE	SHEET	18 OF 28

TEMPORARY AND DURABLE 100 mm WHITE LINE

STA. 0+000.00 - STA. 0+300.00 LT. & RT.

TEMPORARY AND DURABLE 100 mm YELLOW LINE

STA. 0+000.00 - STA. 0+300.00 LT. & RT. (SOLID)

~~TEMPORARY AND DURABLE LETTERS OR SYMBOLS~~

STA. 0+075.91 LT. (AHEAD)

STA. 0+085.51 LT. (STOP)

STA. 0+005.00 LT. (STOP)

~~TEMPORARY AND DURABLE 600 mm STOP BAR~~

STA. 0+006.00 LT

~~TEMPORARY AND DURABLE CROSSWALK MARKINGS WITH DIAGONAL LINES~~

STA. 0+274.34

REHABILITATION OF DI, CB, OR MH, CLASS I

STA. 0+269.34 LT. & RT.

STA. 0+222.34 ~~LT. RT.~~

STA. 0+192.34 LT. & RT.

STA. 0+146.34 ~~RT. LT.~~

STA. 0+139.34 ~~LT. RT.~~

CHANGING ELEVATION OF SEWER MANHOLE


STA. 0+252.34 ~~RT. LT.~~

STA. 0+222.34 ~~RT. LT.~~

~~STA. 0+075.91 LT. (MOBIL ACCESS)~~

OUTSIDE COLD PLANE LIMIT

STA. 0+109.34 LT.

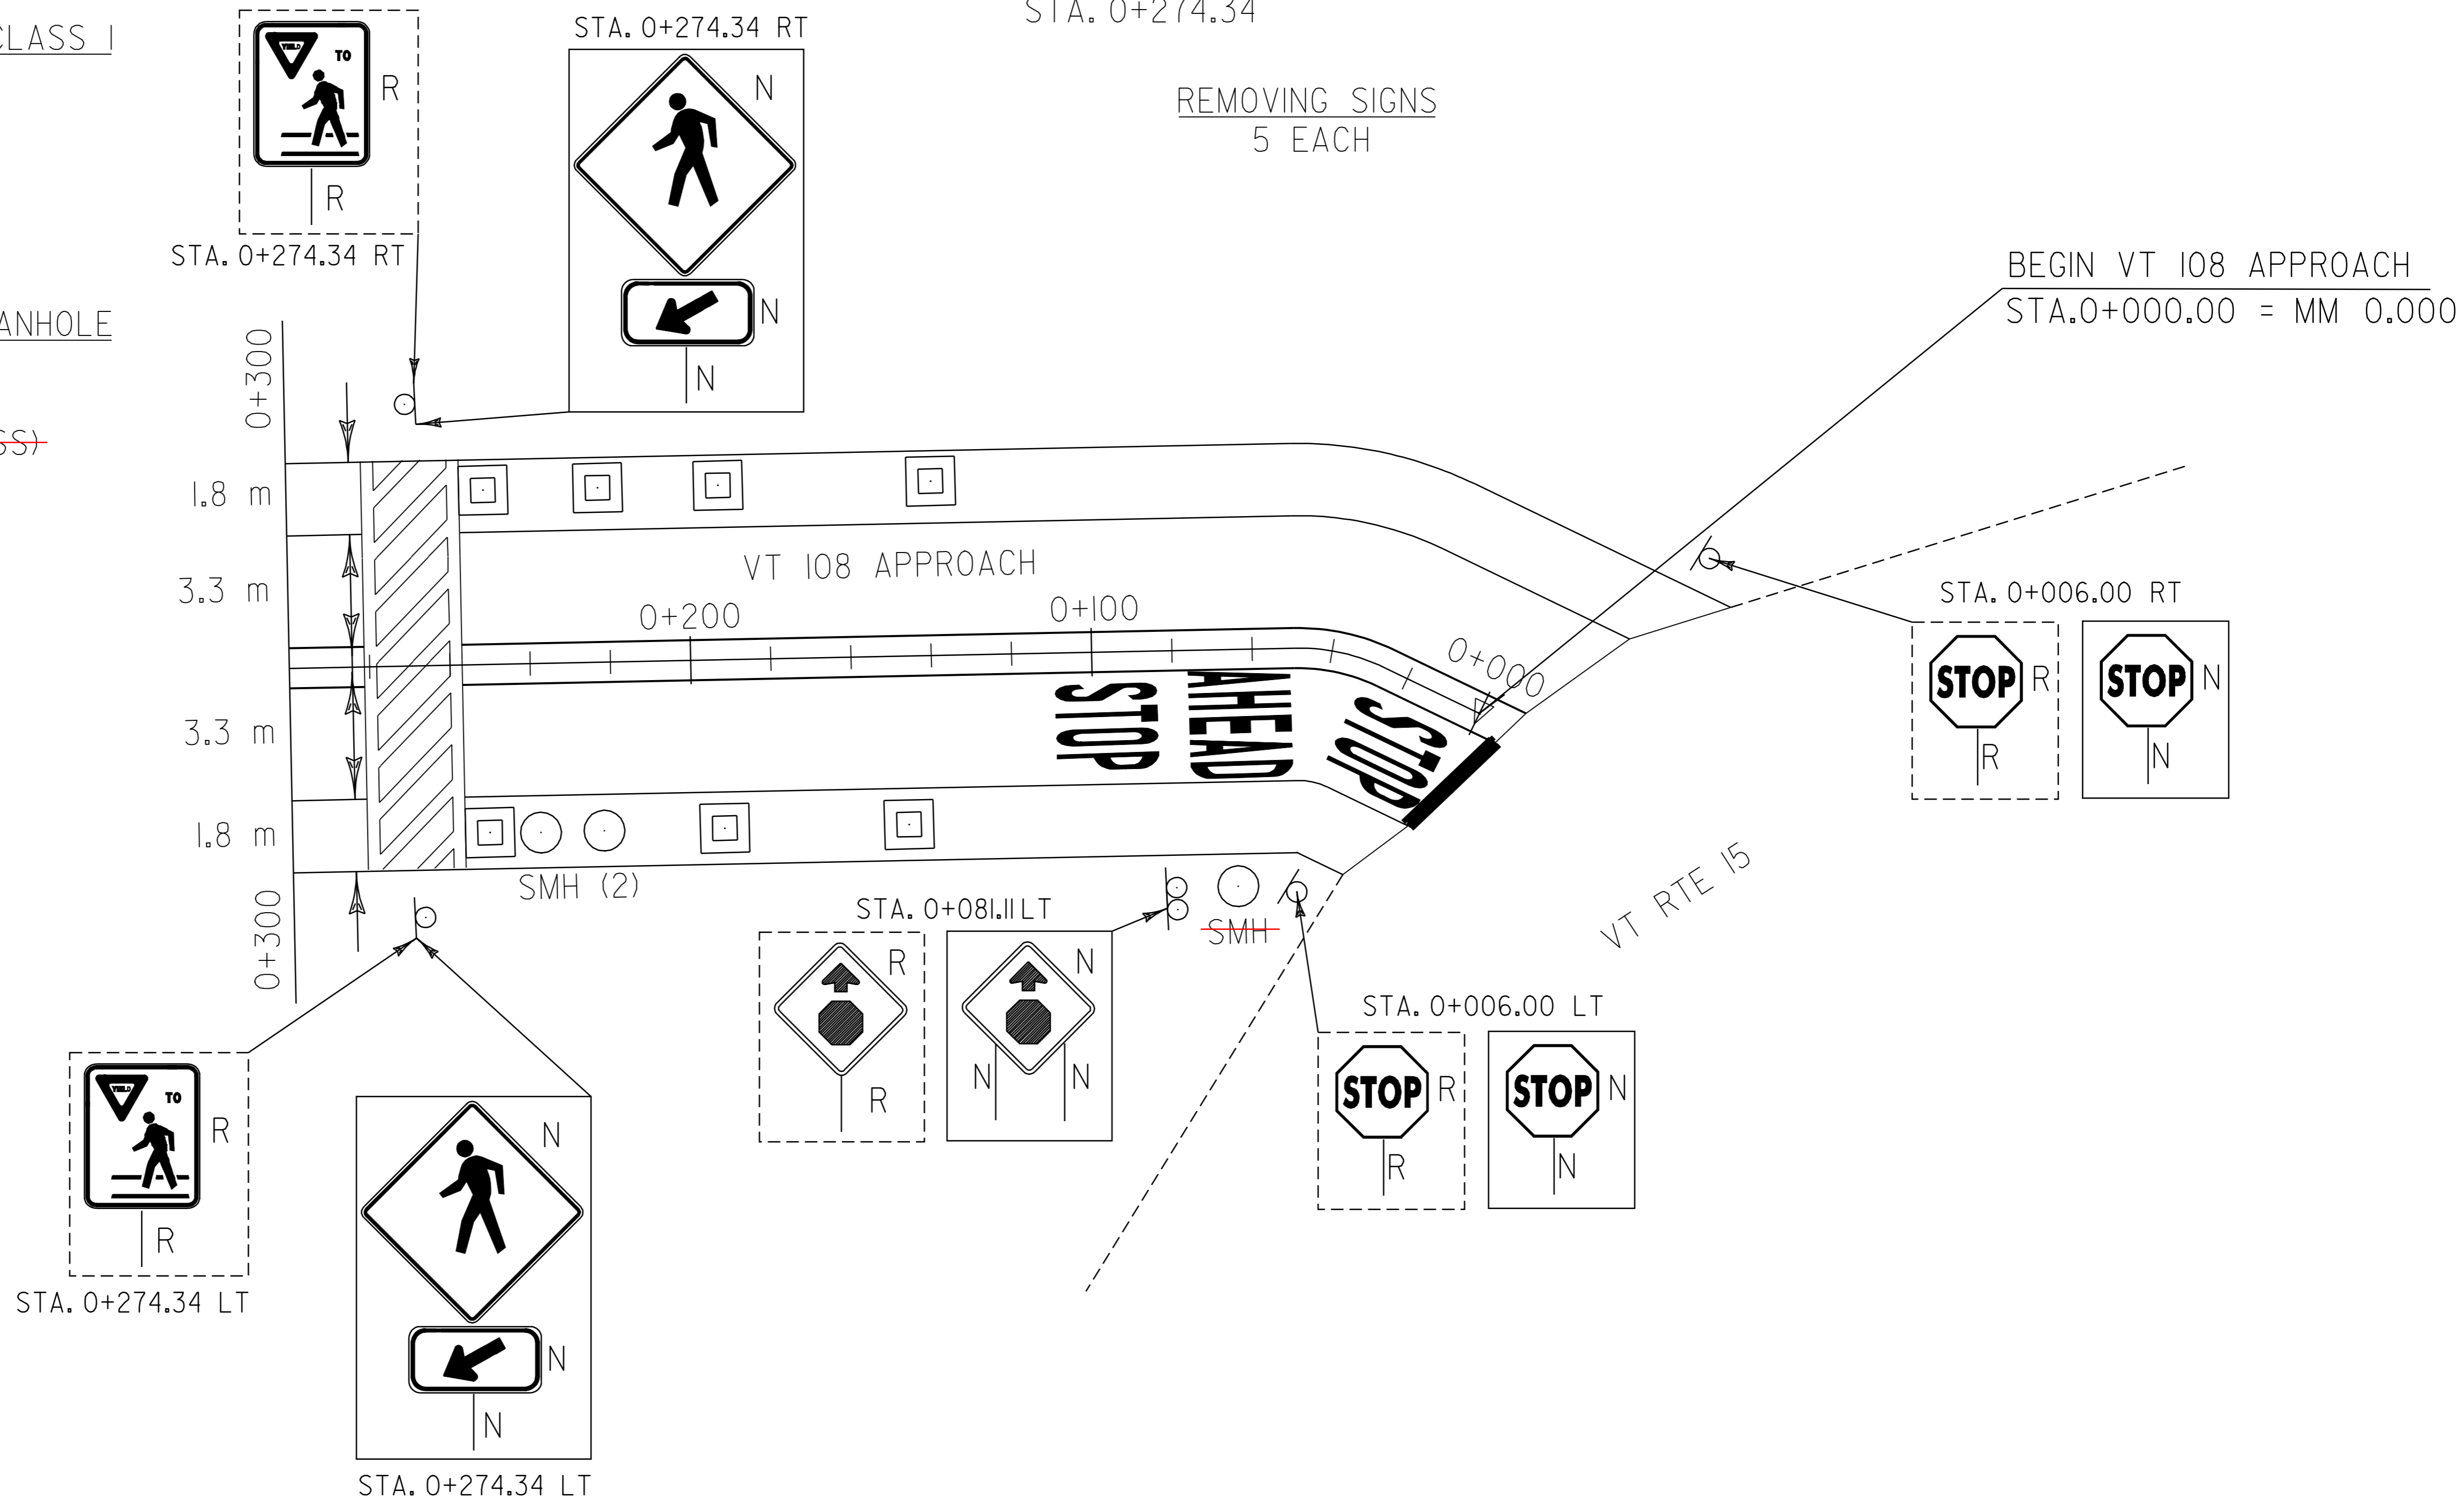

**PAVING PROJECT**  
**LAYOUT**  
**#12**

PROJECT NAME: CAMBRIDGE  
PROJECT NUMBER: STP\_2218(I)S

FILE NAME: Z:\pave\2218\2218.dwg PLOT DATE: 14-FEB-2006 16:4  
PROJECT LEADER: WQQLAYER DRAWN BY: KML  
DESIGNED BY: KML CHECKED BY: PAVI.MGMT.  
RECORDED BY: LOCKE SHEET 19 OF 28

KILOMETER MARKER, STATION, OR SIGN NUMBER	SIGN LEGEND	SIGN DIMENSIONS		NEW & SALVAGED SIGNS				EXIST POST RETAIN	SALVAGE	NO. OF POSTS	NEW SIGN POSTS														REMARKS	SIGN DETAIL								
		EA	WIDTH (mm)	HEIGHT (mm)	"A"	"B"	SALV SIGN				SALV TIS	FLANGED CHANNEL		SQUARE STEEL (mm)			TUBULAR ALUMINUM Ø (mm)			TUBULAR STEEL Ø (mm)				W-SHAPE STEEL		FRAMING SIGN	REQUIRED	DETAIL ON SHEET NUMBER	STD. SHEET NUMBER					
												1.7	3.0	4.5	44	50	63	75	100	100 MOD	FOUND-ATION	75	89	100						125	FTG. SIZE		WEIGHT	POST SIZE
																															kg/m	kg/m		
VT 108											OPTION ITEMS																							
5+100.01 LT			750	750	0.56							X	X																E-143M					
5+205.56 LT			750	750	0.56							X	X																E-143M					
5+216.56 LT	12,000		600	750	0.45							X	X																E-141M					
6+358.02 RT			750	750	0.56							X	X																E-143M					
6+434.22 LT			750	750	0.56							X	X														BACK TO BACK	E-143M E-138M						
6+443.22 LT			600	750	0.45							X	X																E-141M					
6+461.34 RT			600	750	0.45							X	X																E-141M					
6+464.04 RT			750	750	0.56							X	X														BACK TO BACK	E-143M E-138M						
6+668.25 RT			600	750	0.45							X	X																E-141M					
6+672.85 RT			750	750	0.56							X	X														BACK TO BACK	E-143M E-138M						
7+215.72 RT			600	750	0.45							X	X																E-141M					
7+222.92 RT			750	750	0.56							X	X														BACK TO BACK	E-143M E-138M						

FINAL POST LENGTHS ARE TO BE DETERMINED IN THE FIELD. POST SIZES ARE COMPUTED BASED ON INFORMATION FURNISHED ON THE STANDARD SHEETS AND THE TRAFFIC & SAFETY DIVISION'S "SIGN POST DESIGN GUIDELINE."

<b>TOTALS</b>	m <sup>2</sup>	m <sup>2</sup>	EA.	m <sup>2</sup>		m	m	m	EA	kg	kg	kg	kg	kg	kg	EA.	EA.	kg
	6.29					46.8	46.8											
						46.8	52.2											

PROJECT: CAMBRIDGE PROJECT NO.: STP 2218(1)S  
 DESIGN FILE NAME: IP\_PWP:dms02398\99cl88.dgn PLOT DATE: 14-FEB-2006 16  
 IPARM FILE NAME: p99cl88tssl.dgn SURVEY DATE: MAR\_04  
 SURVEYED BY: LOCKE SQUAD LEADER: WQQLAYER DRAWN BY: LOCKE  
 RECORDED BY: LOCKE SHEET: 20 OF 28















**NOTES**


1. This guardrail transition is for connection to a vertical concrete bridge rail and should not be connected directly to a concrete safety shape.
2. Bottom beam blocks are offset drilled to sit squarely on the post flange. Blocks are attached with 15mm carriage bolts.
3. The rubrail may be shop bent in the last 3 feet to facilitate installation.
4. Posts 1,2,3,4 and 6 require an additional hole to attach lower blocks and or lower beam.
5. At post 7, back-up plate bolted to block only.
6. Posts will be either 1.8m or 2.4m steel posts, as directed by the Engineer.

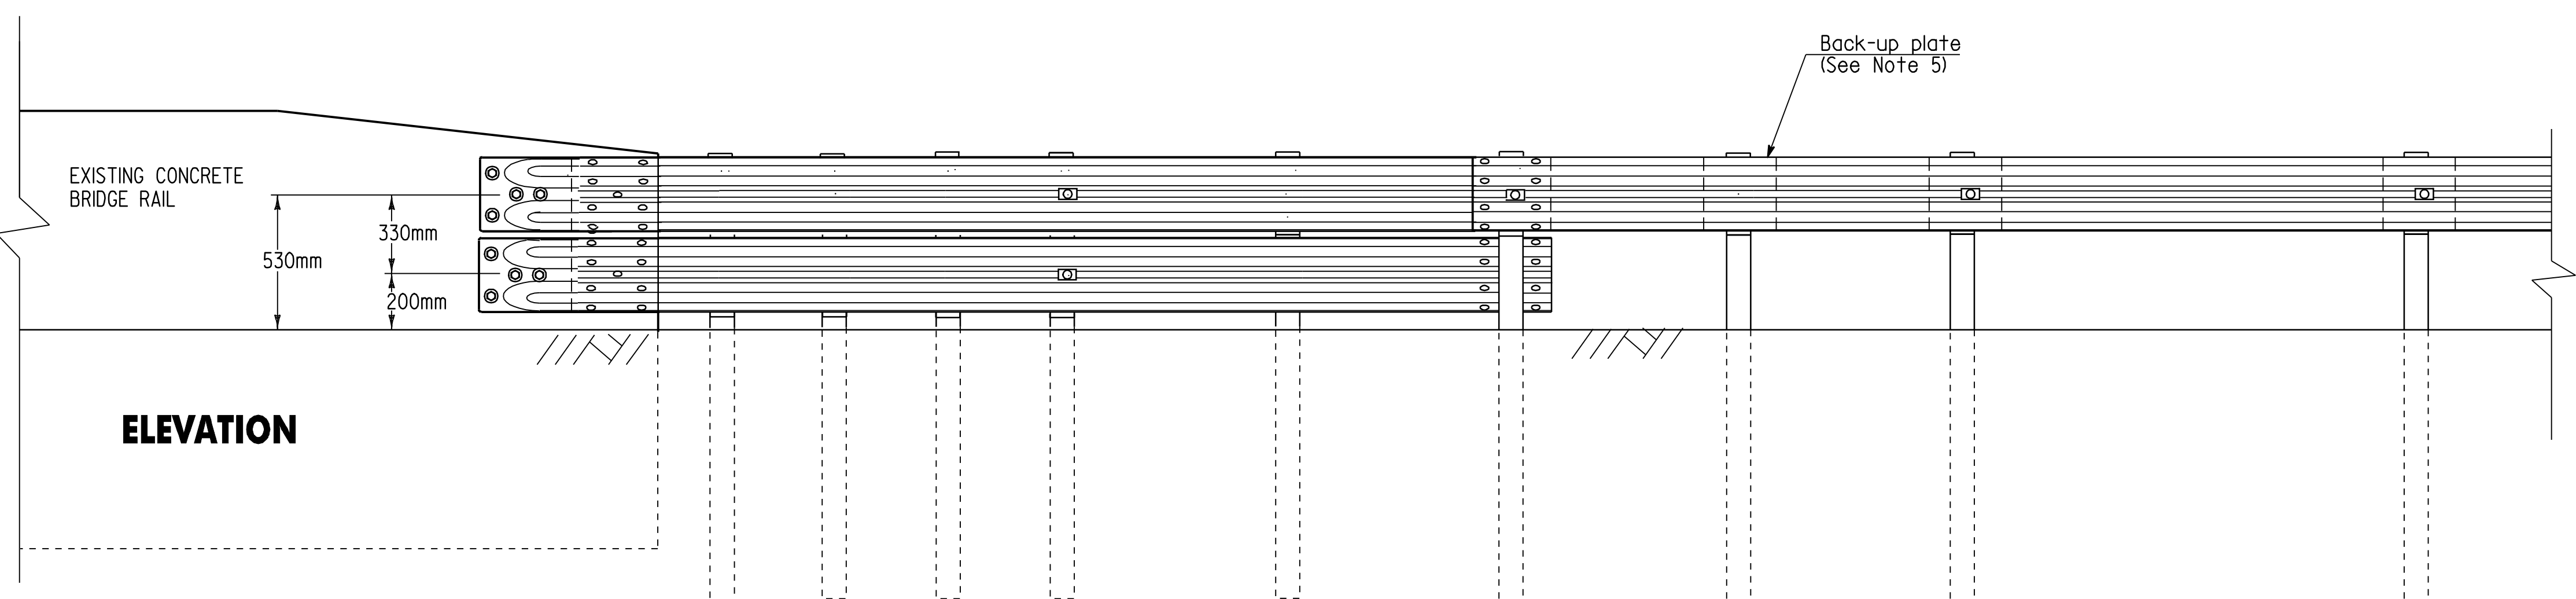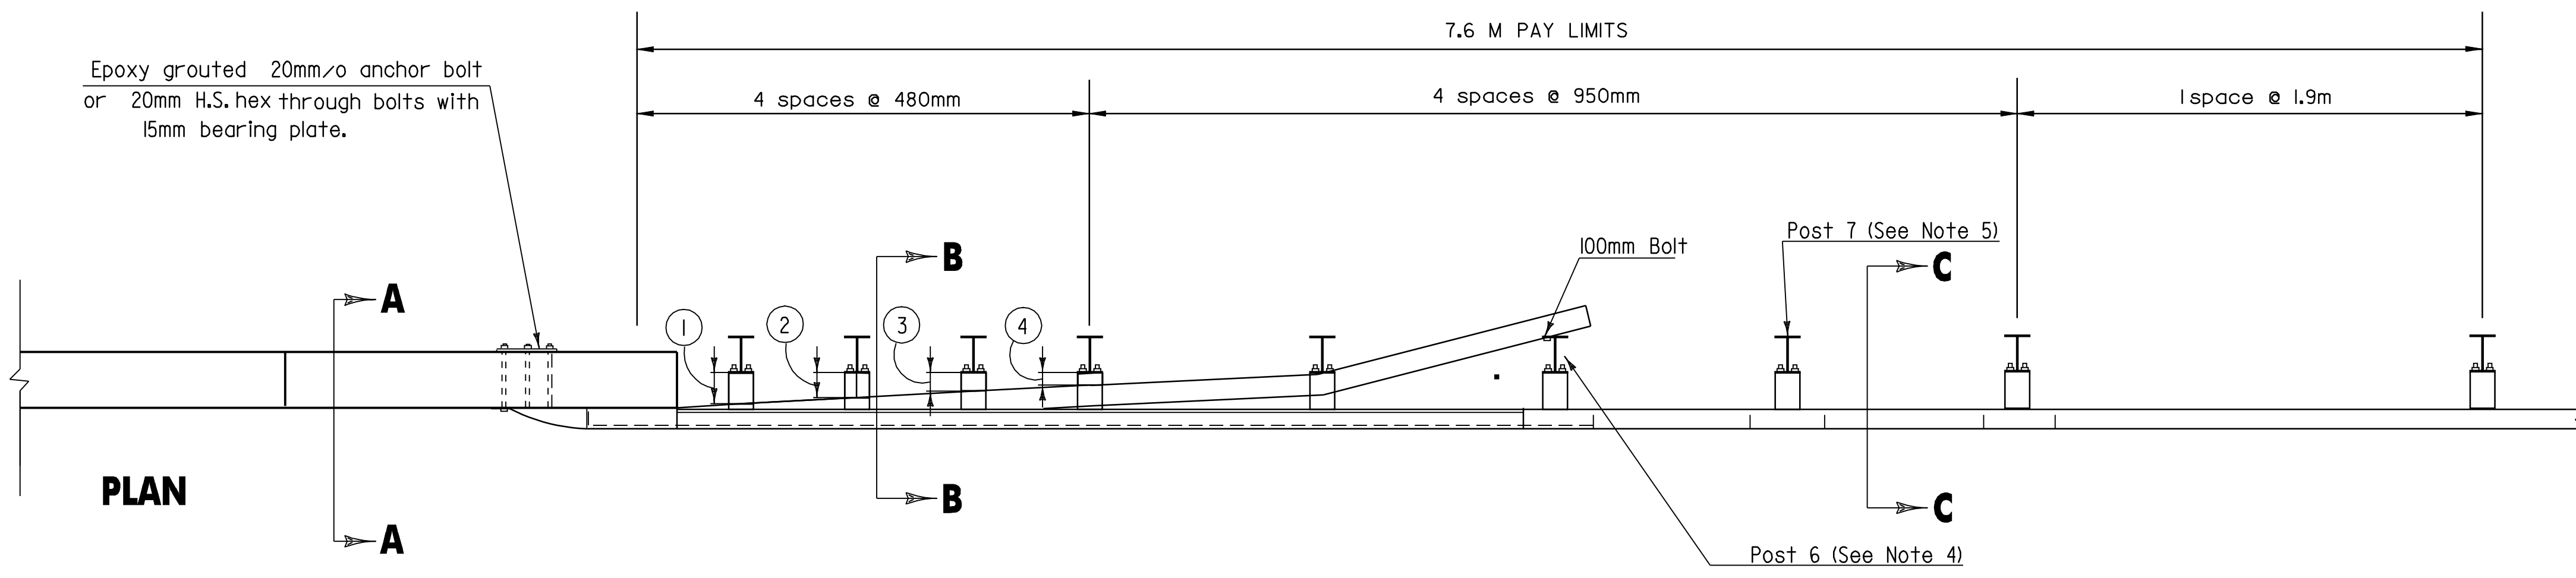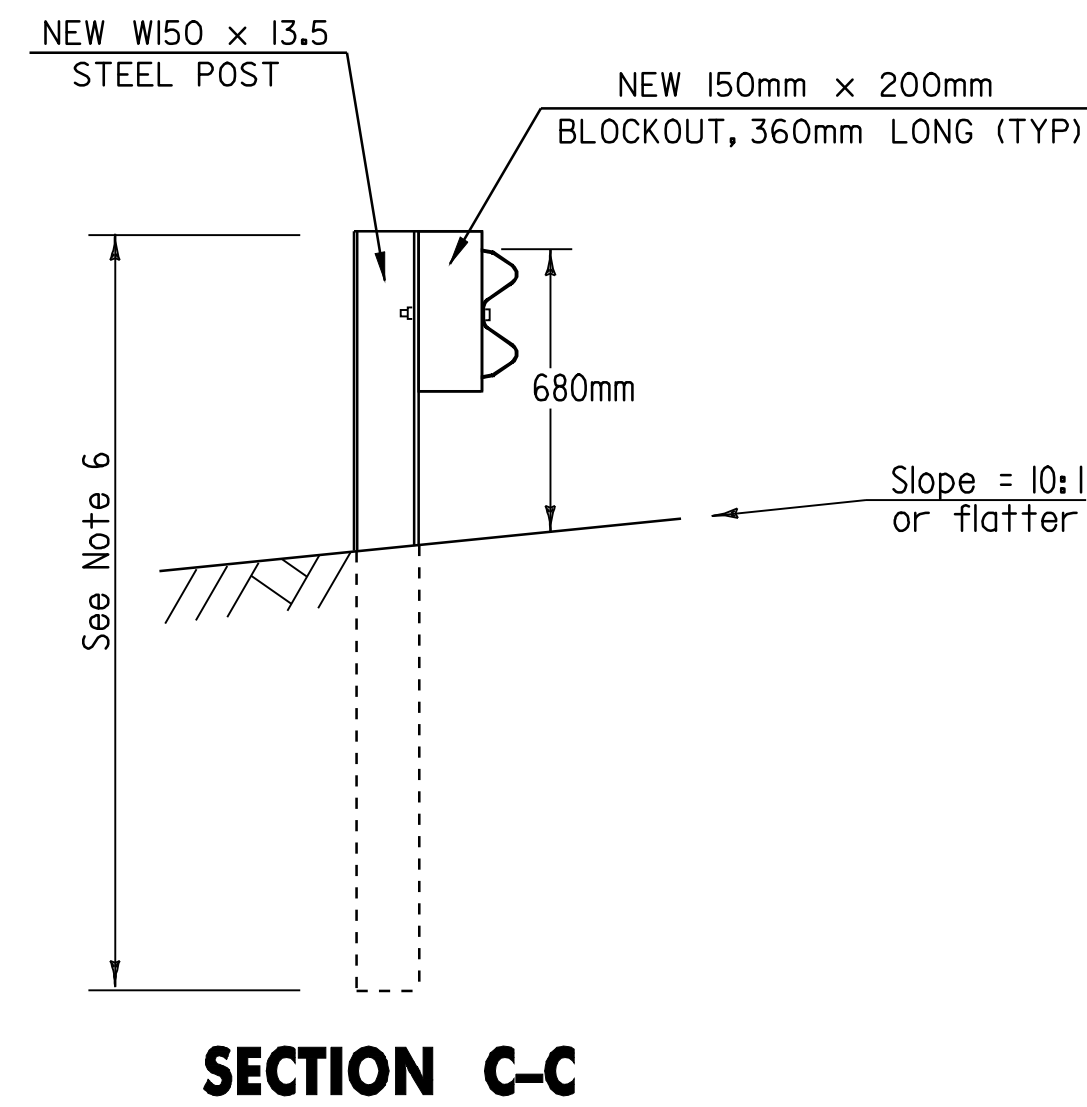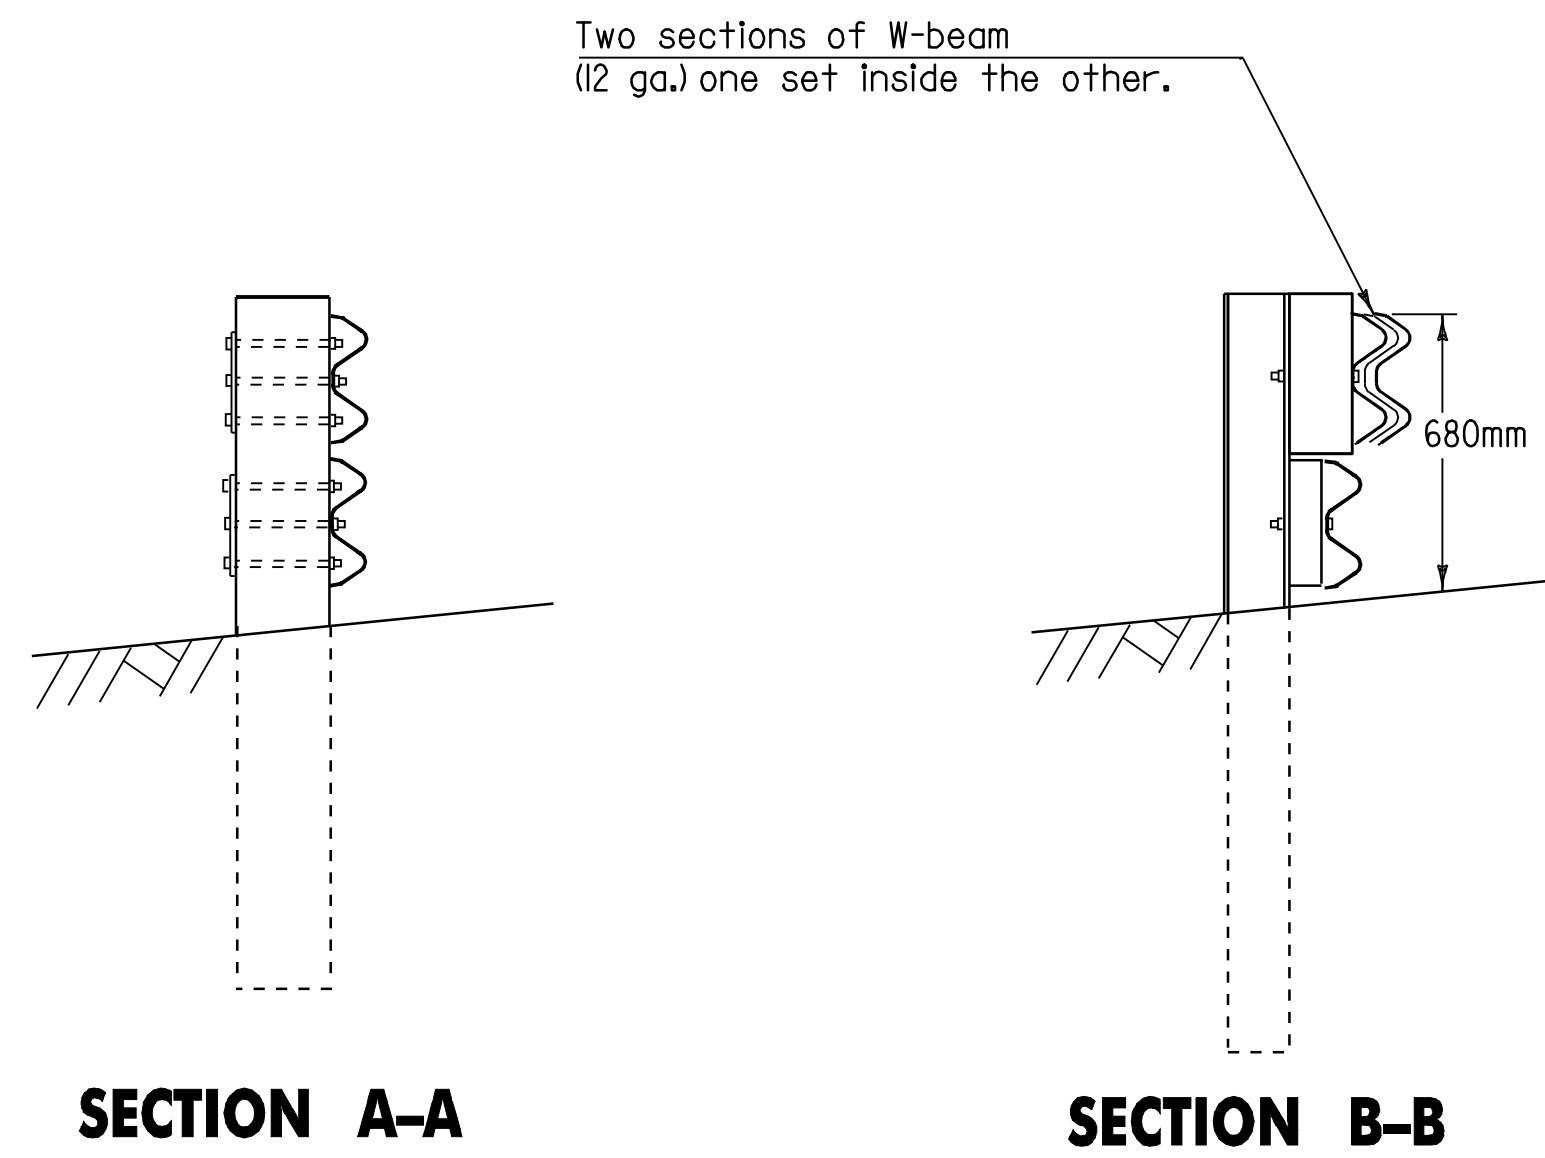

No Scale




<p><b>TERMINAL CONNECTOR FOR STEEL BEAM GUARD RAIL W/STEEL POSTS BRIDGE NO. 17</b></p>	DESIGNED BY	KML	DATE	01-04
	DRAWN BY	KML	DATE	01-04
	DESIGN FILE NO.	pave/99cl88/99cl88.dgn		
	PROJ. NAME	CAMBRIDGE		
	PROJ. NO.	STP 2218(1)S		
SHEET 26	OF	28	SHEETS	

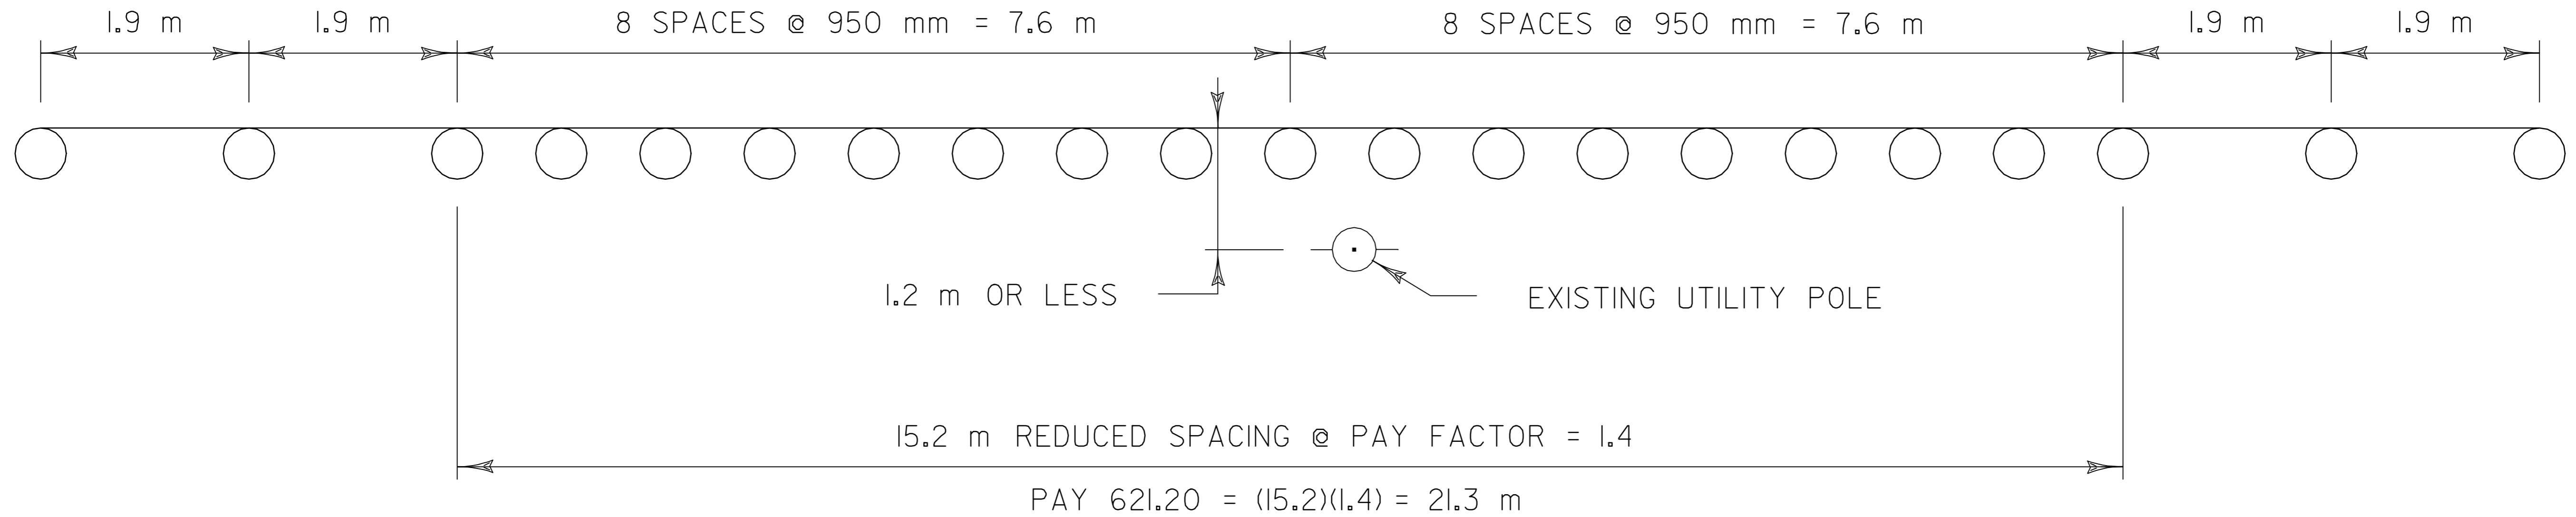

**REDUCED STEEL BEAM GUARDRAIL POST SPACING DETAIL**


**CAMBRIDGE STA. 3+984.11 LT**  
**CAMBRIDGE STA. 12+359.86 RT**  
**CAMBRIDGE STA. 12+786.47 RT**  
**CAMBRIDGE STA. 12+915.12 RT**

NOT TO SCALE

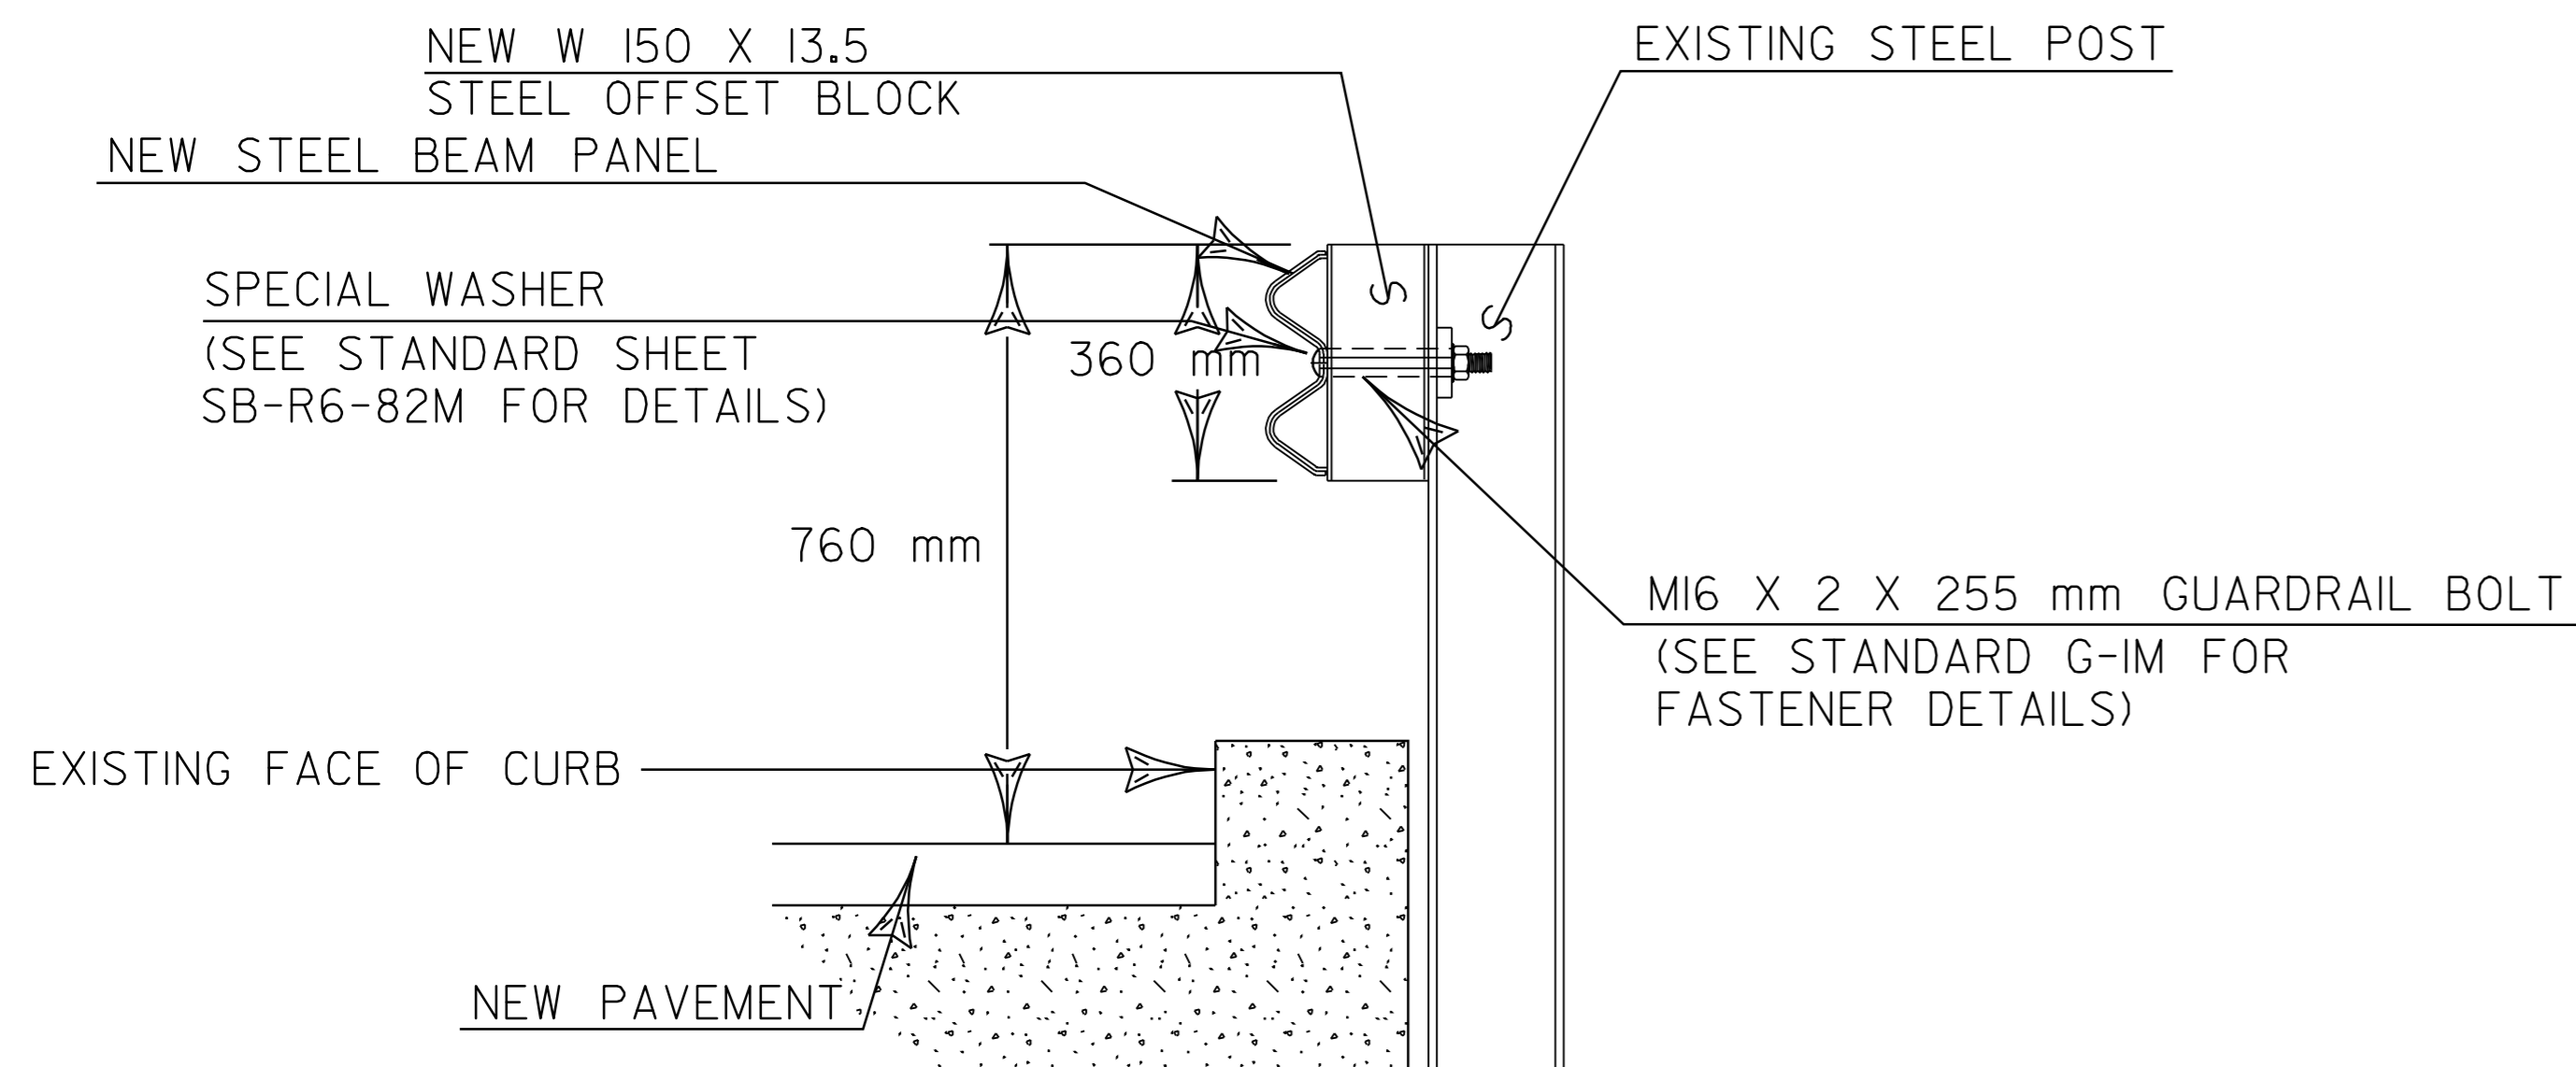

**H.D. STEEL BEAM FASCIAMOUNTED DETAIL (MOD. 1)**


NOT TO SCALE

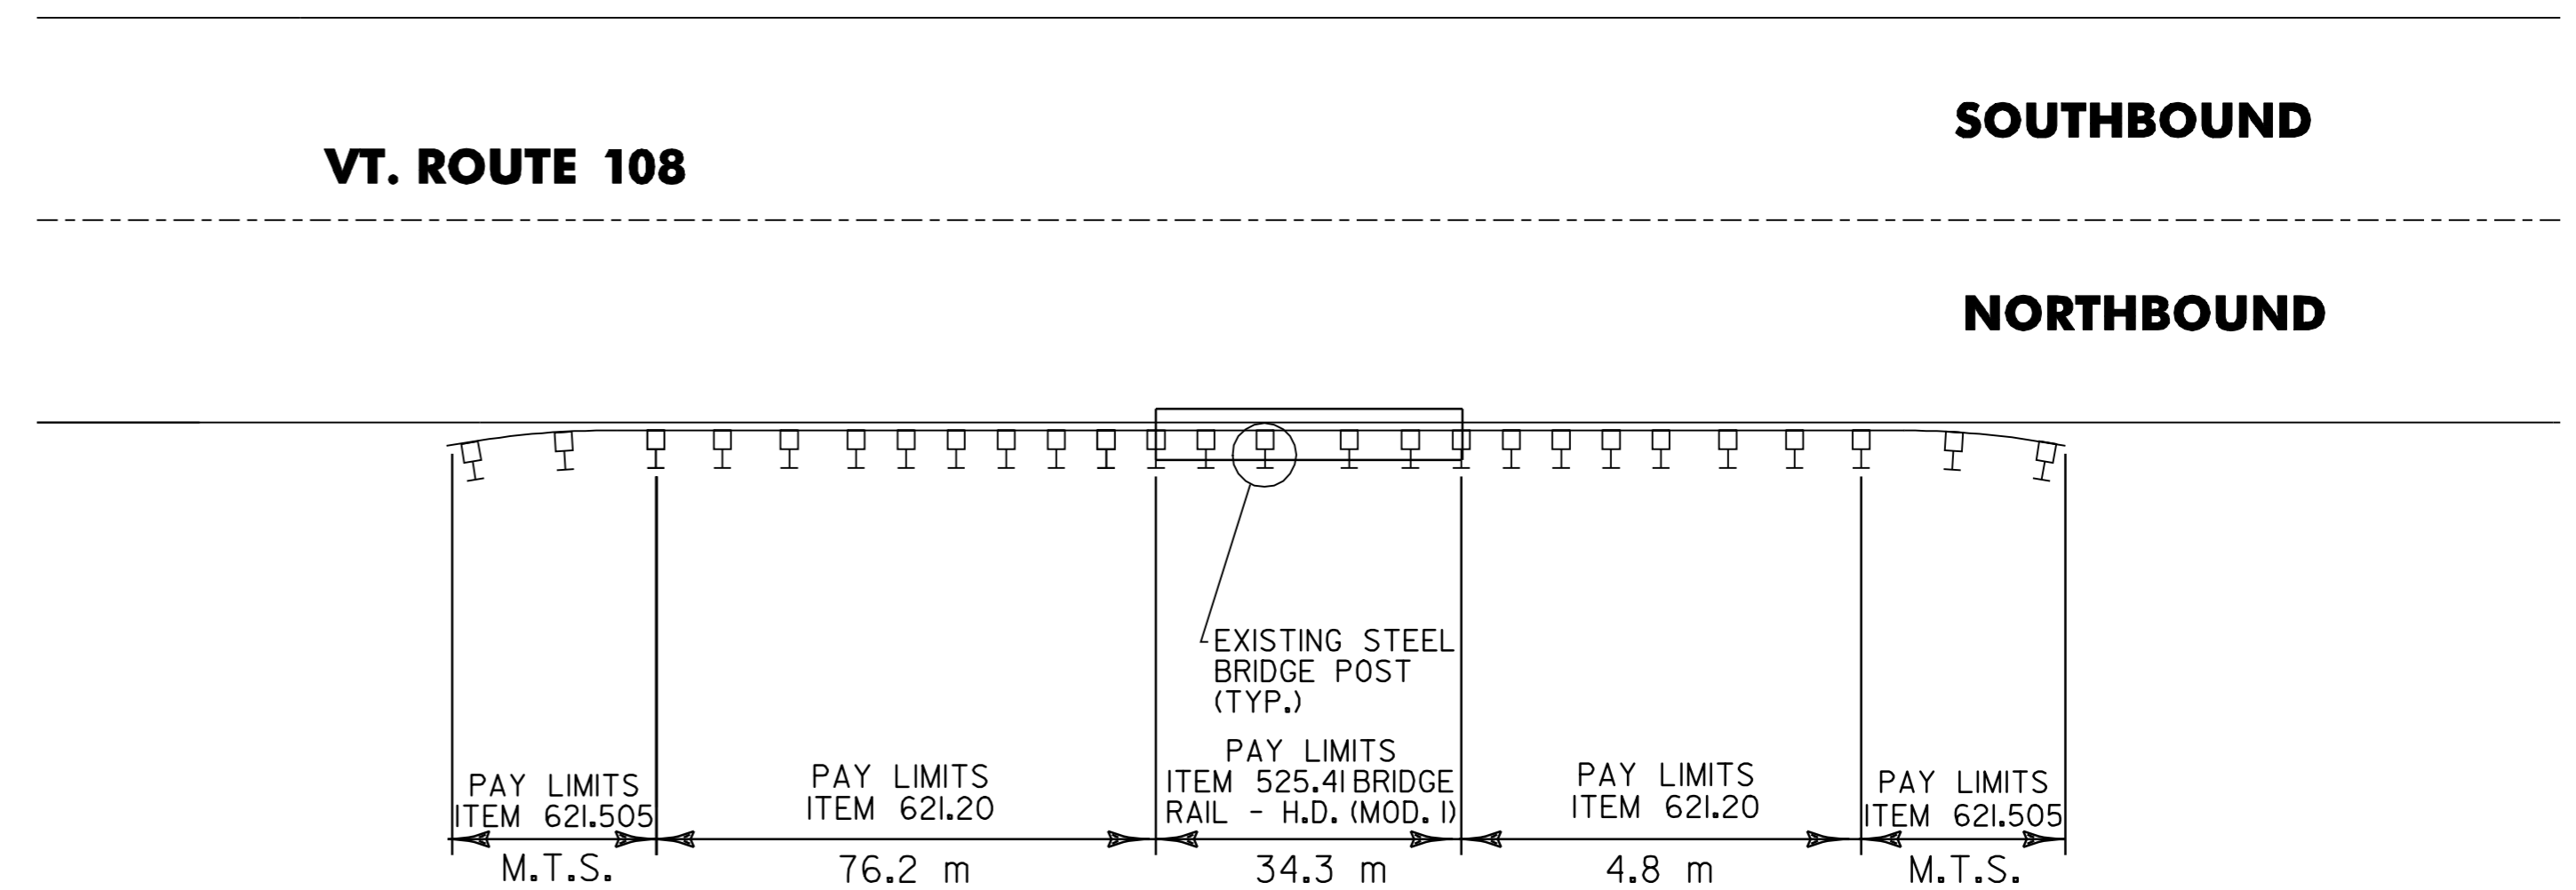

DATUM	
VERTICAL	N/A
HORIZONTAL	N/A

**REDUCED POST SPACING DETAIL**

SURVEYED BY	N/A	DATE	N/A
DRAWN BY	LOCKE	DATE	JAN 04
SQUAD LEADER	WOOLAVER		
DESIGN FILE NO.	/pave/99cl88/99cl88.dgn		
IPARM FILE		DATE PLOTTED	\$DATE\$
PROJ. NAME	CAMBRIDGE		
PROJ. NO.	STP 2218(1)S		
SHEET	27 OF 28		

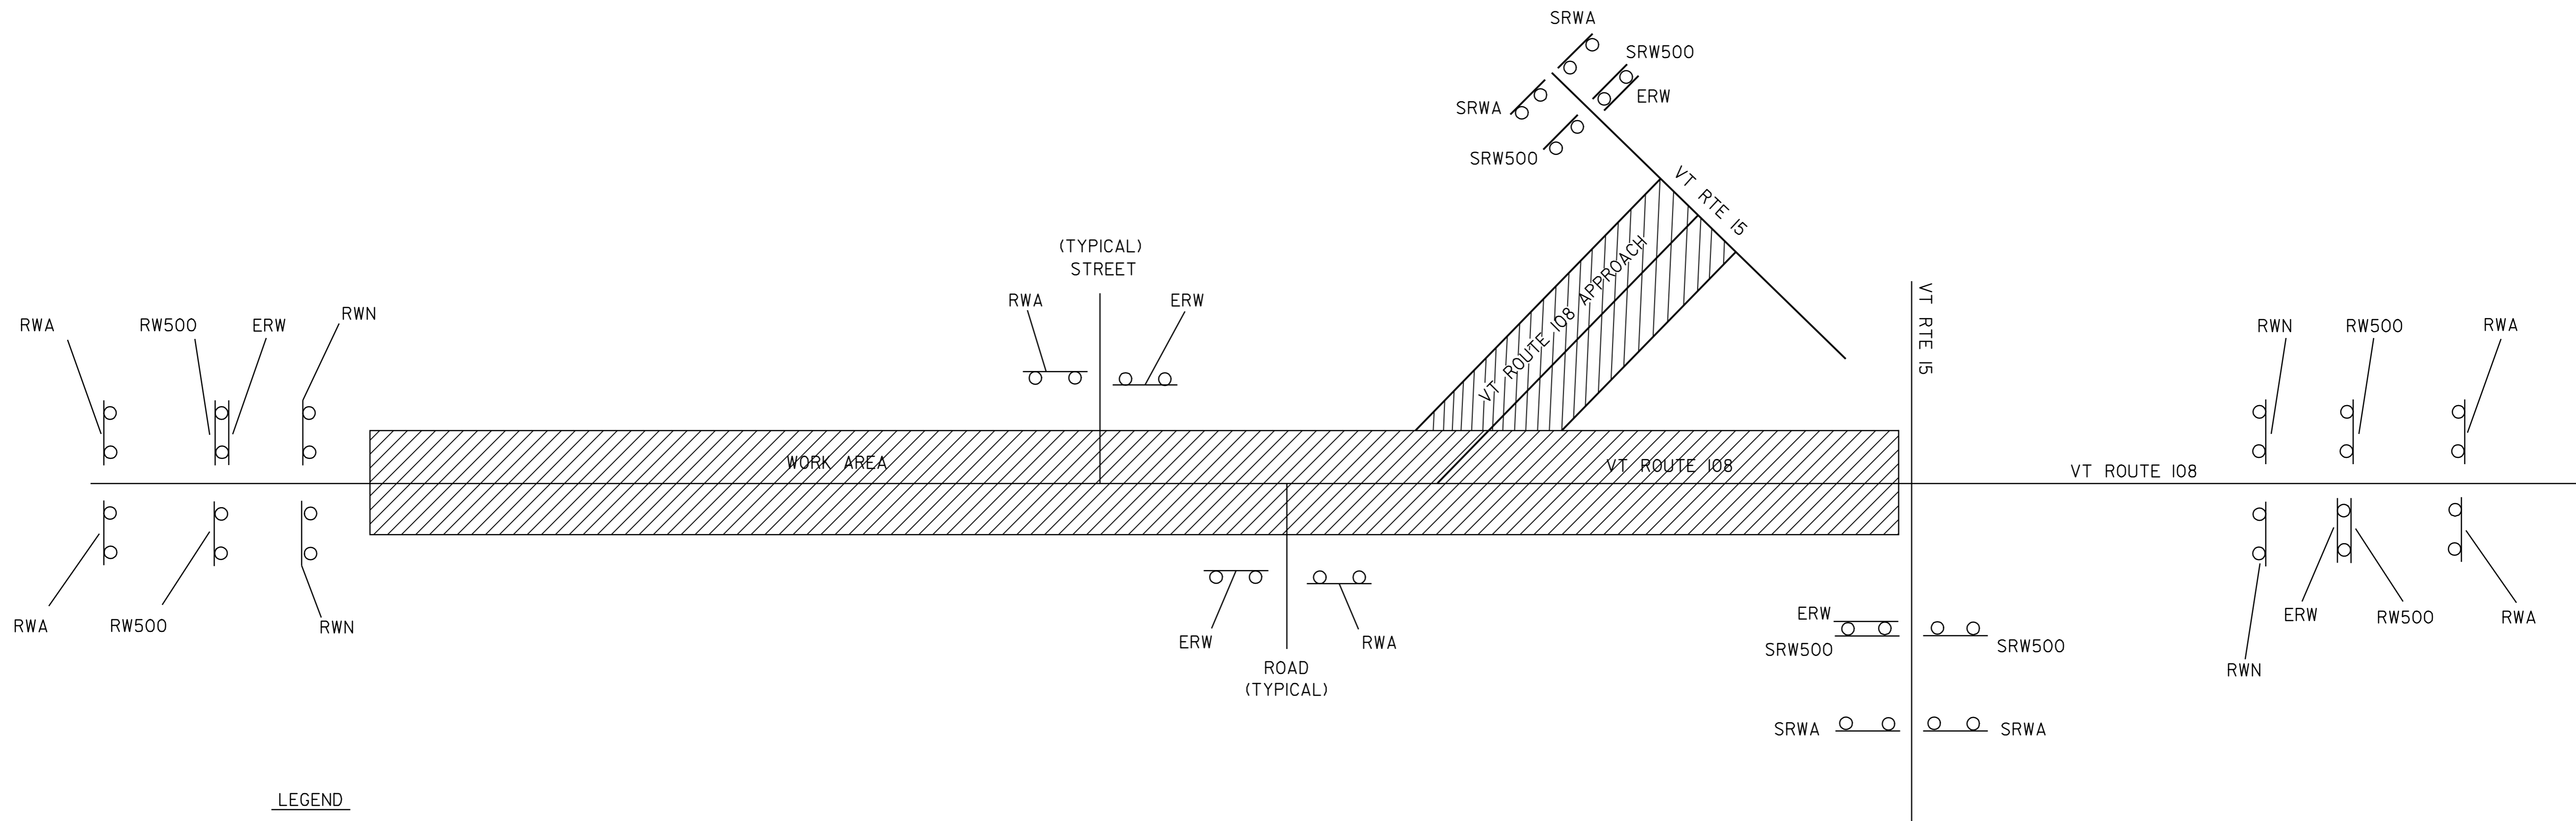


**LEGEND**

- RWA = ROAD WORK AHEAD
- RW500 = ROAD WORK 500 FEET
- ERW = END ROAD WORK
- RWN = ROAD WORK NEXT 5 MILES
- SRWA = SIDE ROAD WORK AHEAD
- SRW500 = SIDE ROAD WORK 500 FEET

**CONSTRUCTION APPROACH SIGNING**


SEE STD. E-100M & E-100AM FOR SIGN PLACEMENT

RESIDENT ENGINEER, AT HIS OR HER DISCRETION, MAY ELIMINATE CONSTRUCTION APPROACH SIGNING AT DEAD END LOCATIONS

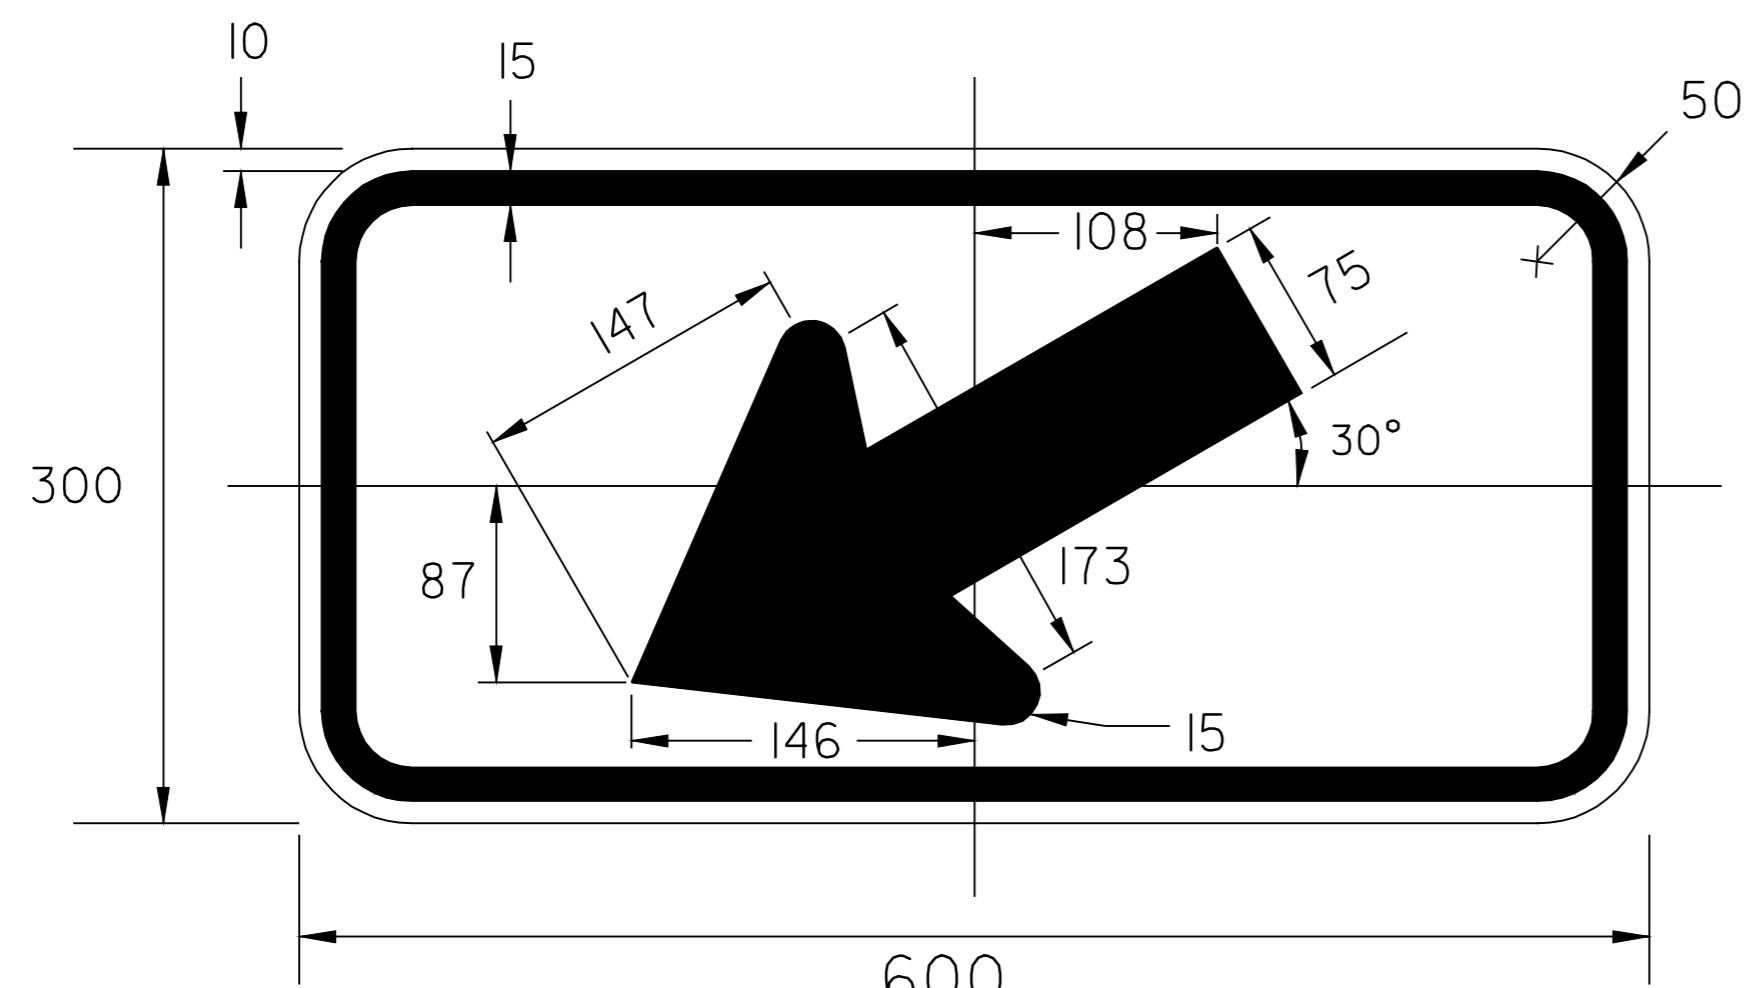

**W16-7P**

COLOR: FLOURESCENT YELLOW-GREEN SHEETING WITH BLACK BORDER AND ARROW  
MATERIAL: PER VOAT STANDARD E-151M

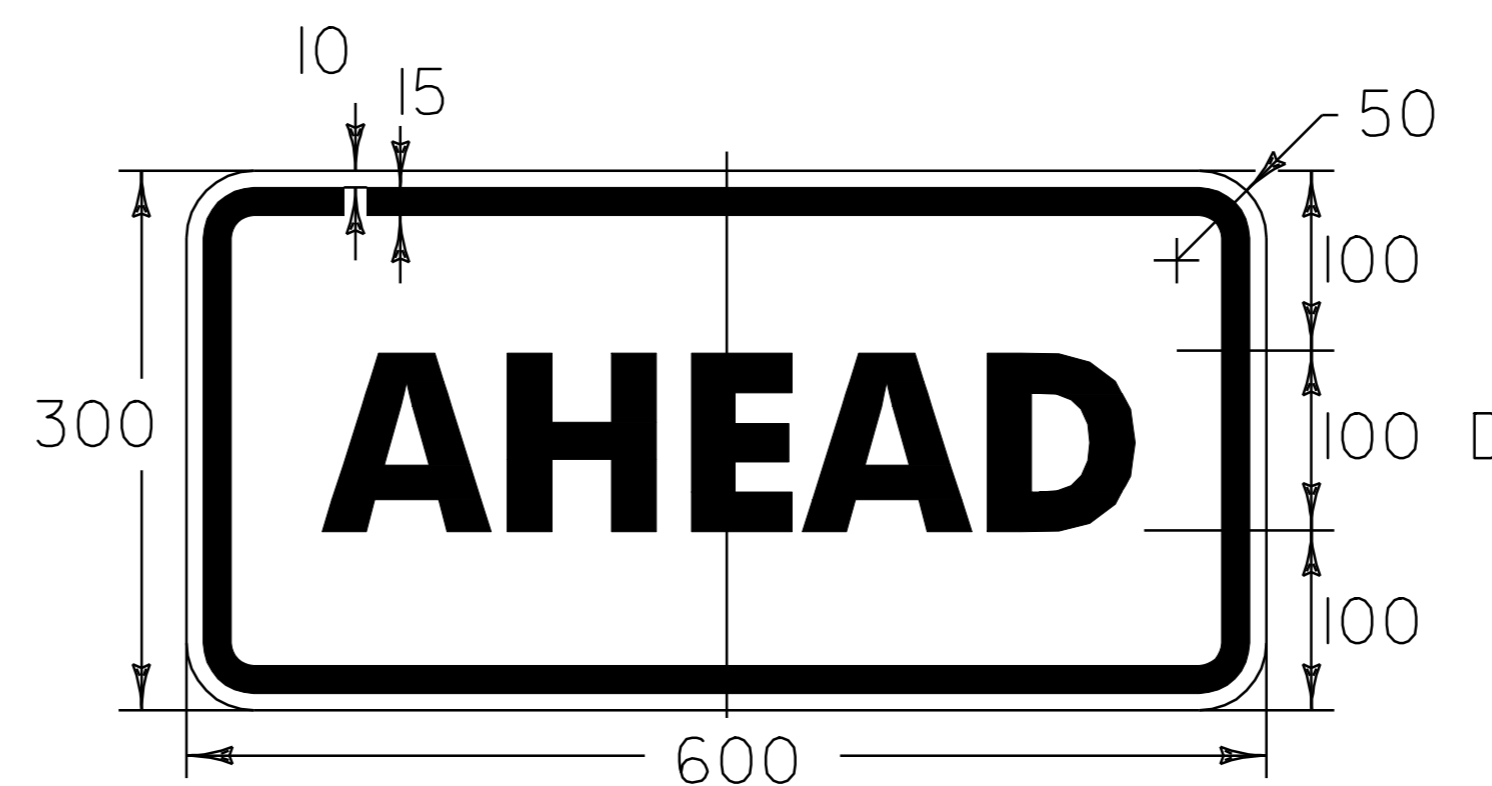

**W16-9p**

COLOR: FLOURESCENT YELLOW-GREEN SHEETING WITH BLACK BORDER AND TEXT  
MATERIAL: PER VOAT STANDARD E-151M

DATUM	
VERTICAL	N/A
HORIZONTAL	N/A

**CONSTRUCTION APPROACH SIGNING SHEET**

SURVEYED BY	N/A	DATE	N/A
DRAWN BY	LOCKE	DATE	JAN 04
SQUAD LEADER	WOOLLAVER		
DESIGN FILE NO.	/pave/99cl88/99cl88.dgn		
IPARM FILE		DATE PLOTTED	\$DATE\$
PROJ. NAME	CAMBRIDGE		
PROJ. NO.	STP 2218(1)S		
SHEET	28 OF 28		