

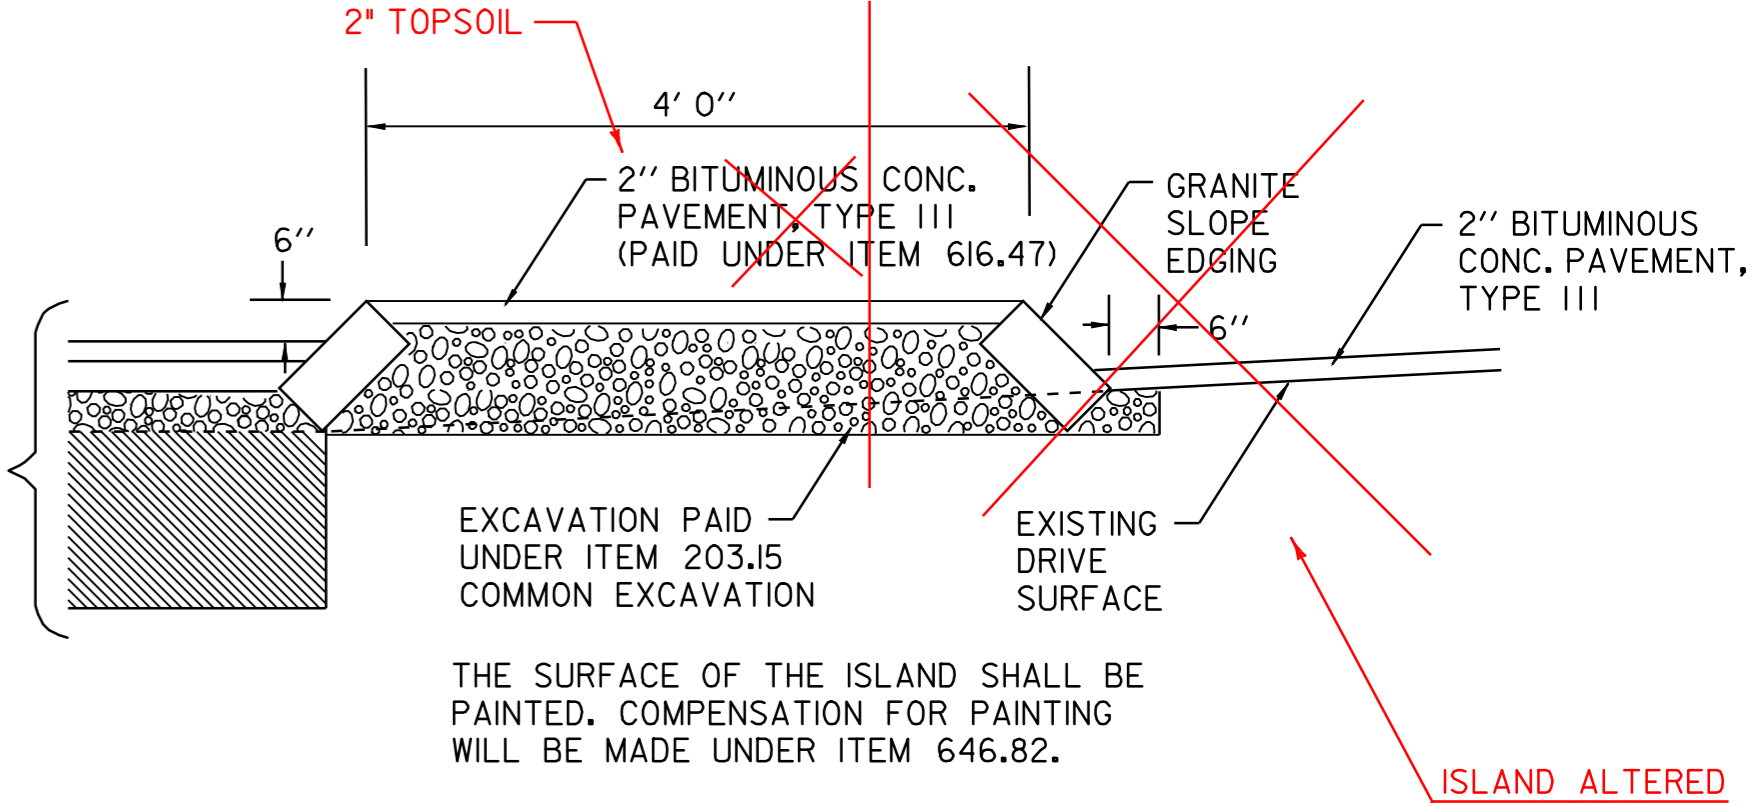


**-RECLAIMING/OVERLAY DETAIL @ BRIDGES-**

BRIDGE # 5 - STA 159+73 (MM 3.025)  
(FIELD MEASURED STA. 159+65)

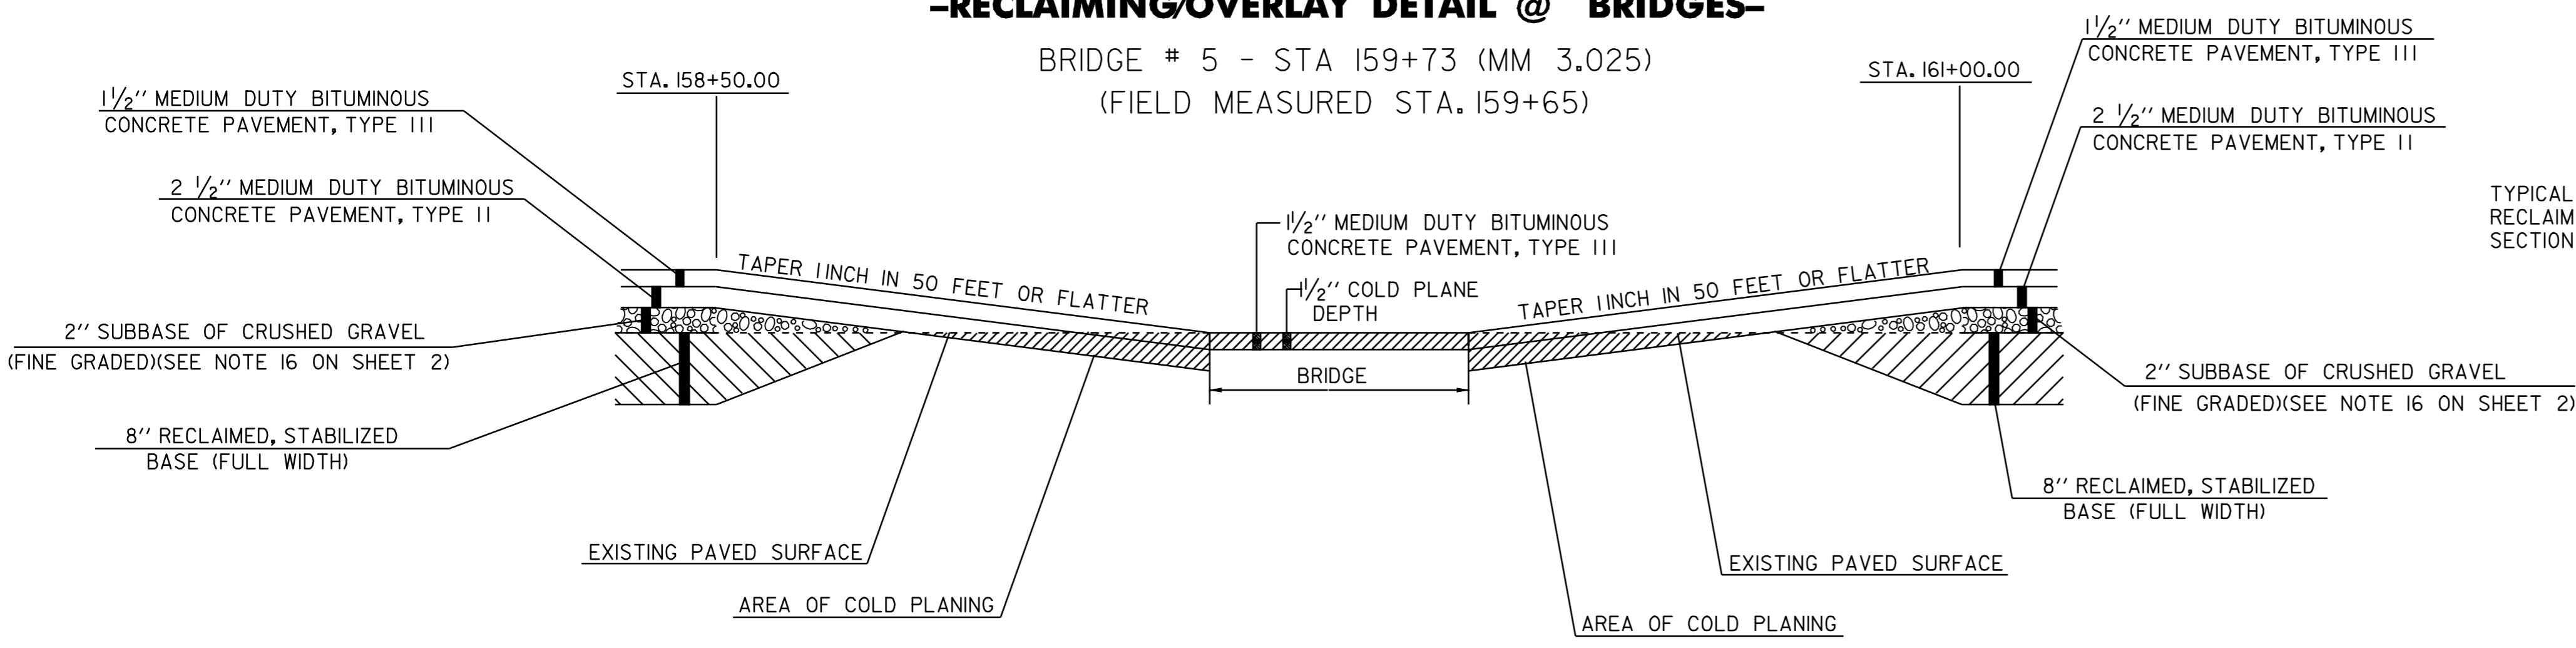


**RAISED ISLAND DETAIL  
TH#3 INTERSECTION  
STA. 148+22 RT.**

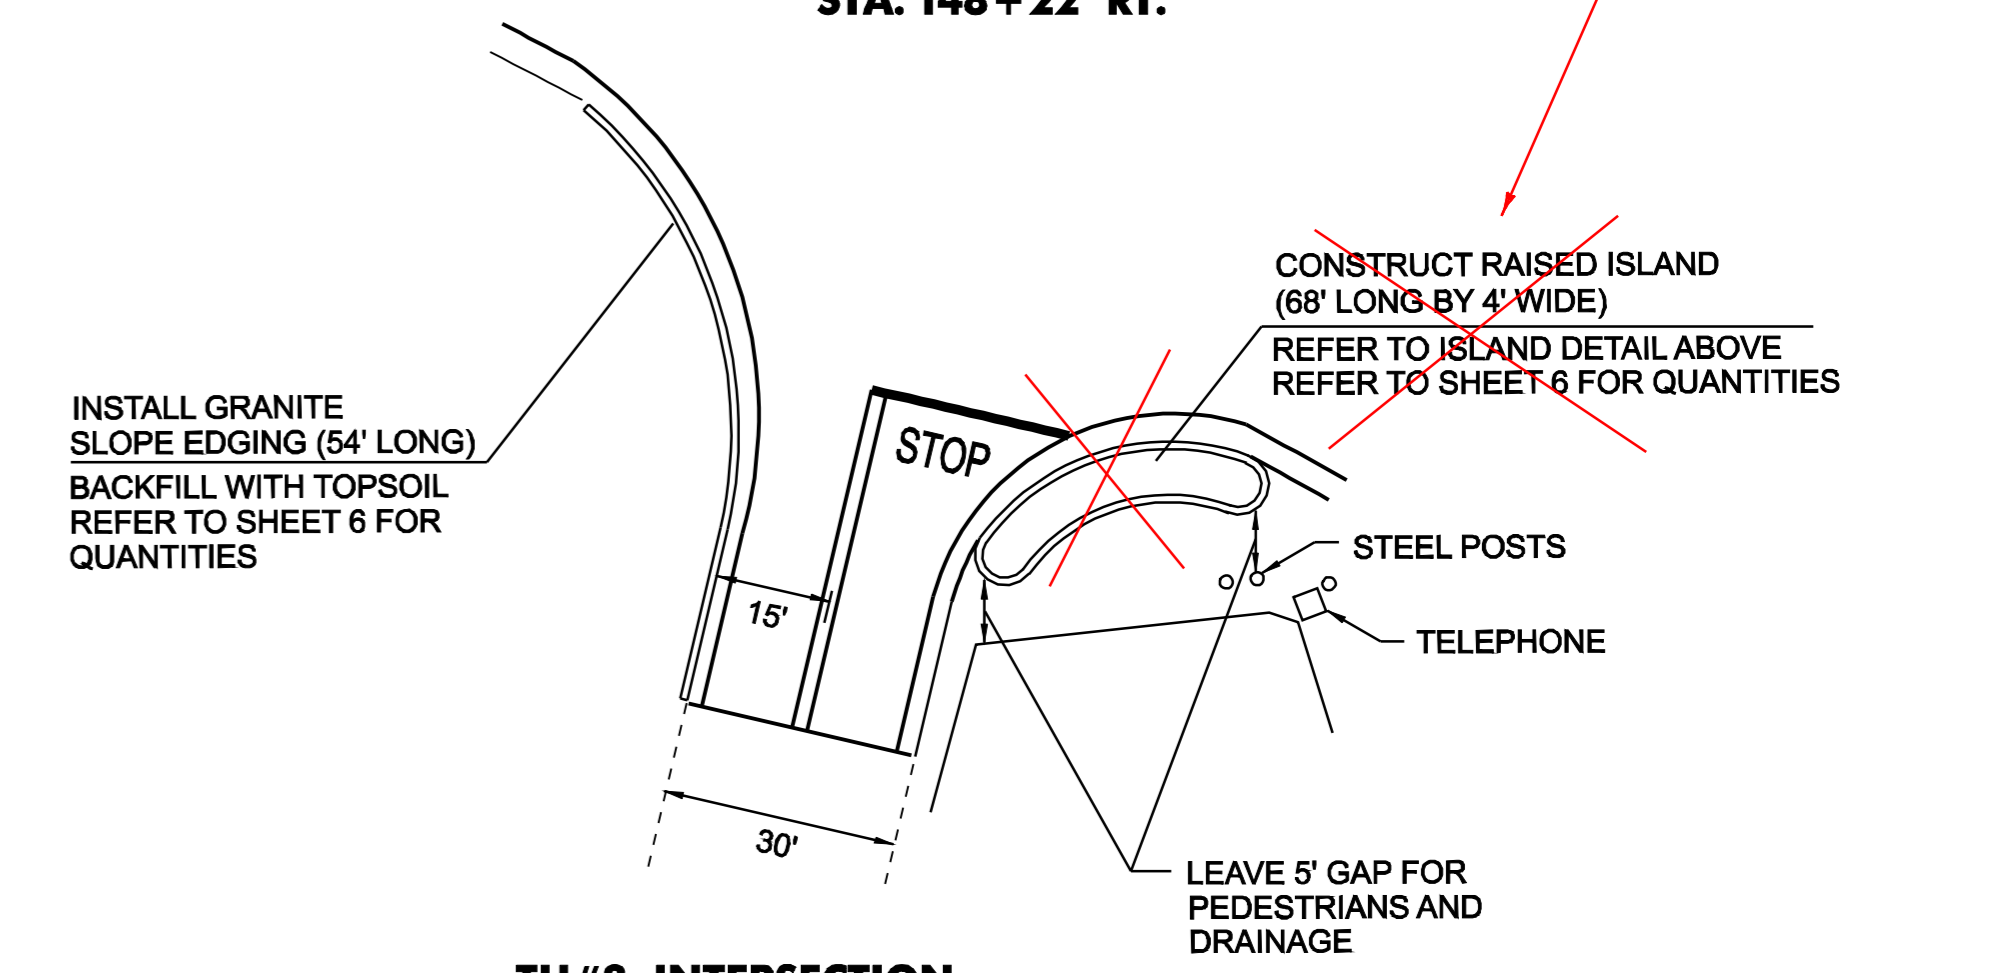

**TH#3 INTERSECTION  
STA. 148+22 RT.**

**-RECLAIMING/OVERLAY DETAIL @ BRIDGES-**

BRIDGE # 8 - STA 251+46 (MM 4.763)  
(FIELD MEASURED STA. 251+15)

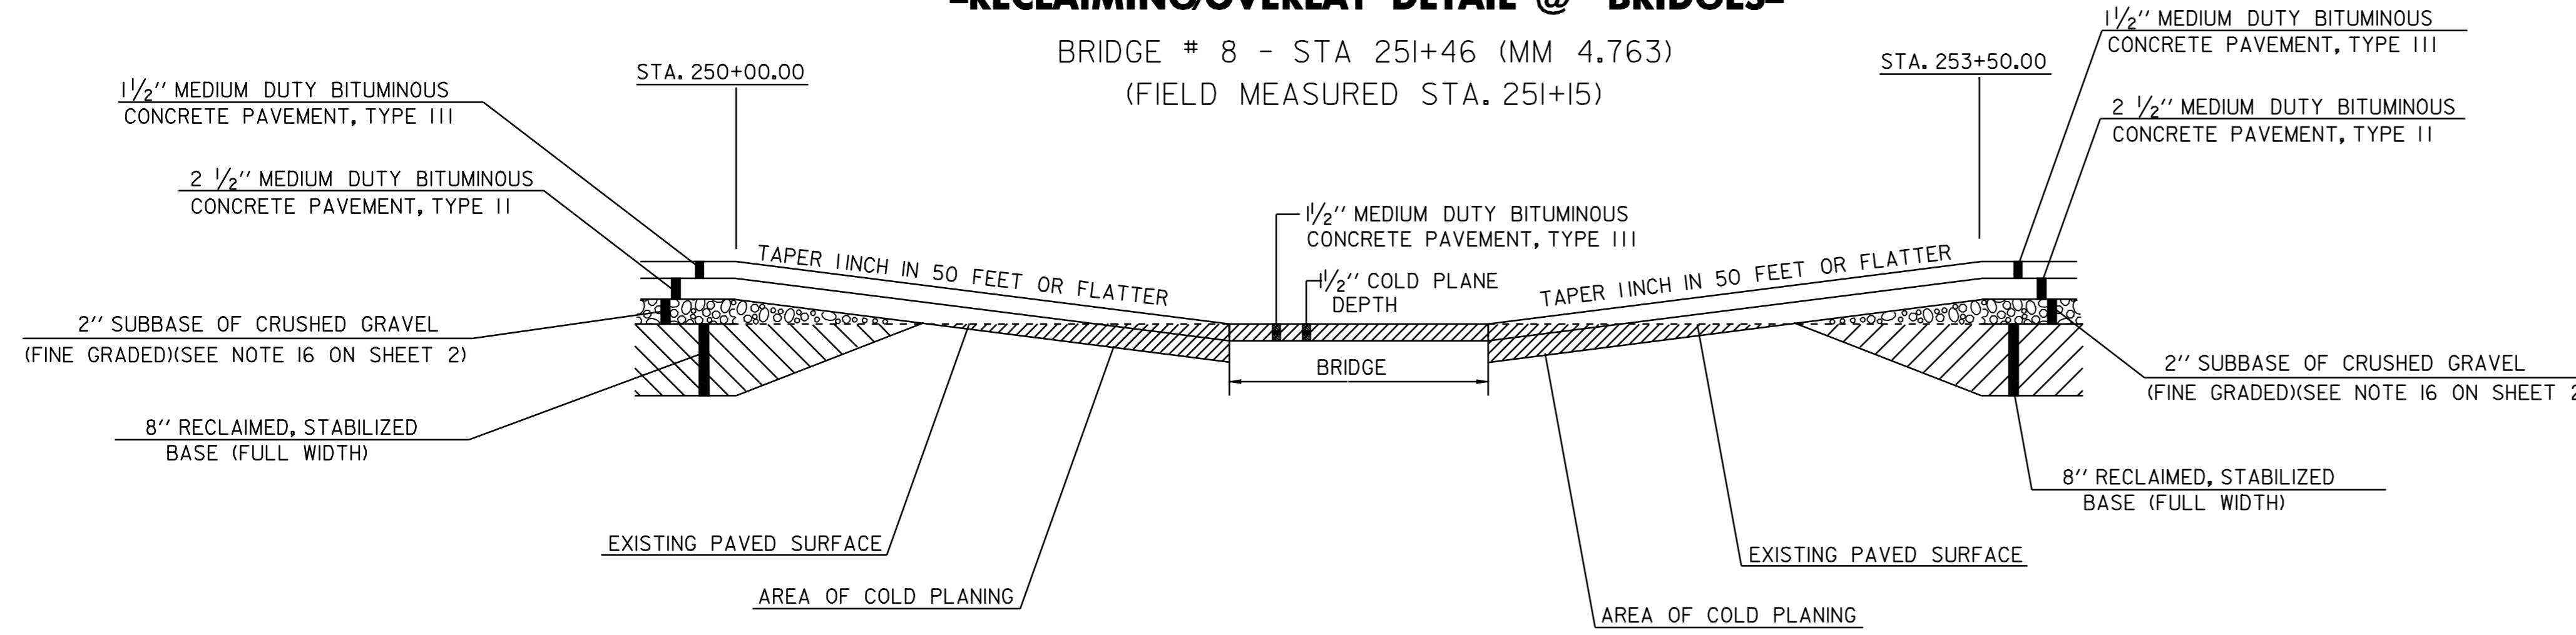

**CONSERVATION SEED MIX  
RURAL AREA - SEED MIXTURE**

% WT.	LBS/ACRE	NAME	PUR%	GERM%
38.0	26	CREeping RED FESCUE	98	85
38.0	26	TALL FESCUE	95	90
4.5	4	RED TOP	95	90
15.0	10	BIRDSFOOT TREFoil	98	85
4.5	4	ANNUAL RYEGrASS	95	85
100.0	70			

**SEED MIXTURE:**  
SHALL NOT HAVE A WEED CONTENT EXCEEDING 0.40% BY WEIGHT AND SHALL BE FREE OF ALL NOXIOUS SEED.

**SEED:**  
TO BE APPLIED PER SEEDING FORMULAS OR AS DIRECTED BY THE ENGINEER.

**FERTILIZER:**  
FORMULA 10-20-10, TO BE USED WITH SEED, APPLIED AT THE RATE OF 500 LBS./ACRE (HYDRO SEEDERS MAY USE 19-19-19 FORMULA).

**AGRICULTURAL LIMESTONE:**  
TO BE APPLIED AT THE RATE OF 2 TONS/ACRE, OR AS DIRECTED BY THE ENGINEER.


**HAY MULCH:**  
TO BE PLACED ON EARTH SLOPES AT THE RATE OF 2 TONS/ACRE, OR AS DIRECTED BY THE ENGINEER.

**TOPSOIL:**  
TO BE USED AS INDICATED ON THE PLANS, OR AS DIRECTED BY THE ENGINEER.


**MARKER POSTS:**  
TO BE PLACED AS INDICATED OR AS DIRECTED BY THE ENGINEER.

**DRIVEWAY TRANSITION DETAIL  
@ RECLAIMED STABILIZED BASE AREAS**

**TOWN HIGHWAY TRANSITION DETAIL  
@ RECLAIMED STABILIZED BASE AREAS**

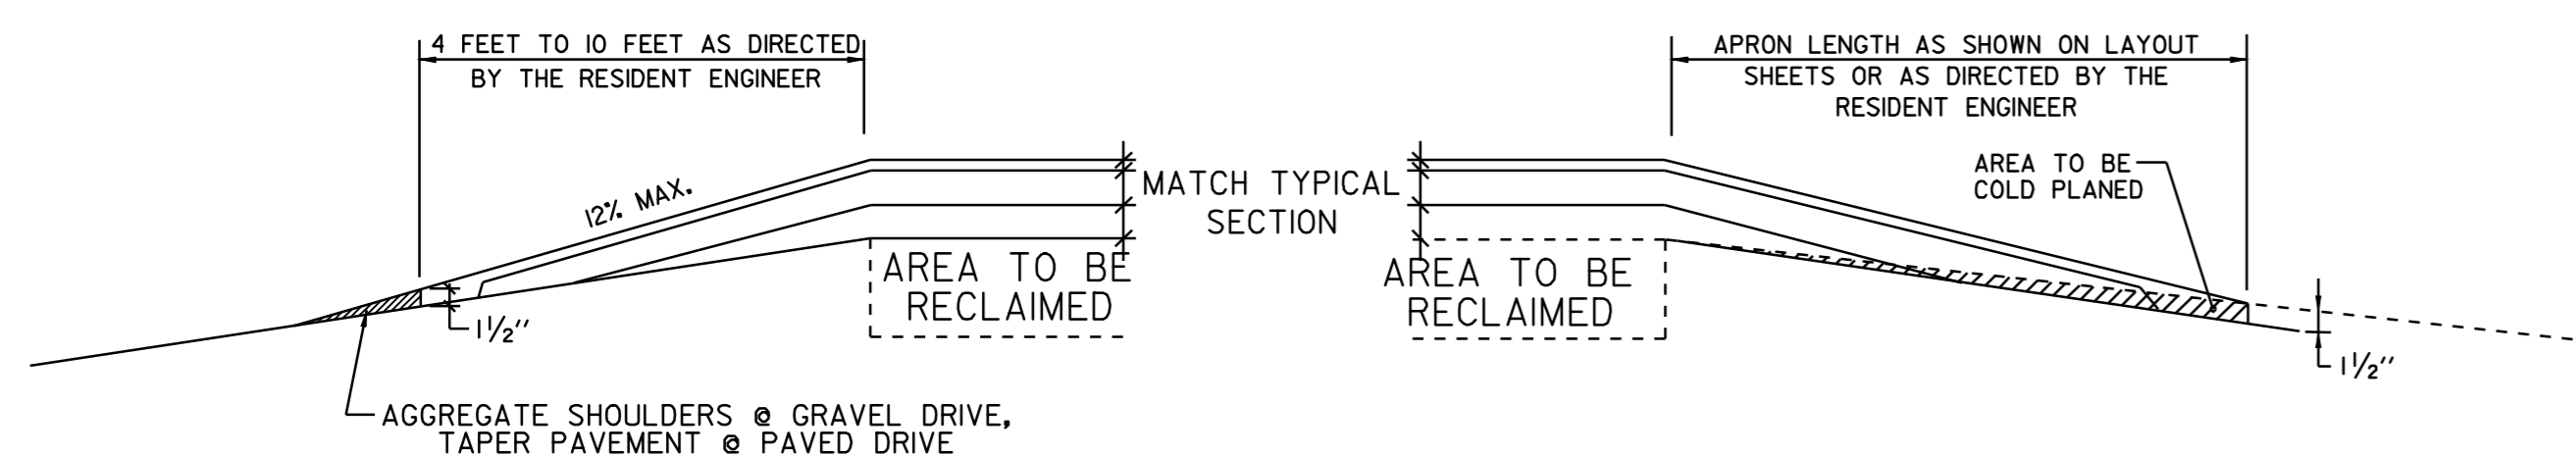

**- TYPICAL SECTION AT GUARD RAIL -  
RECLAIMING SECTION**

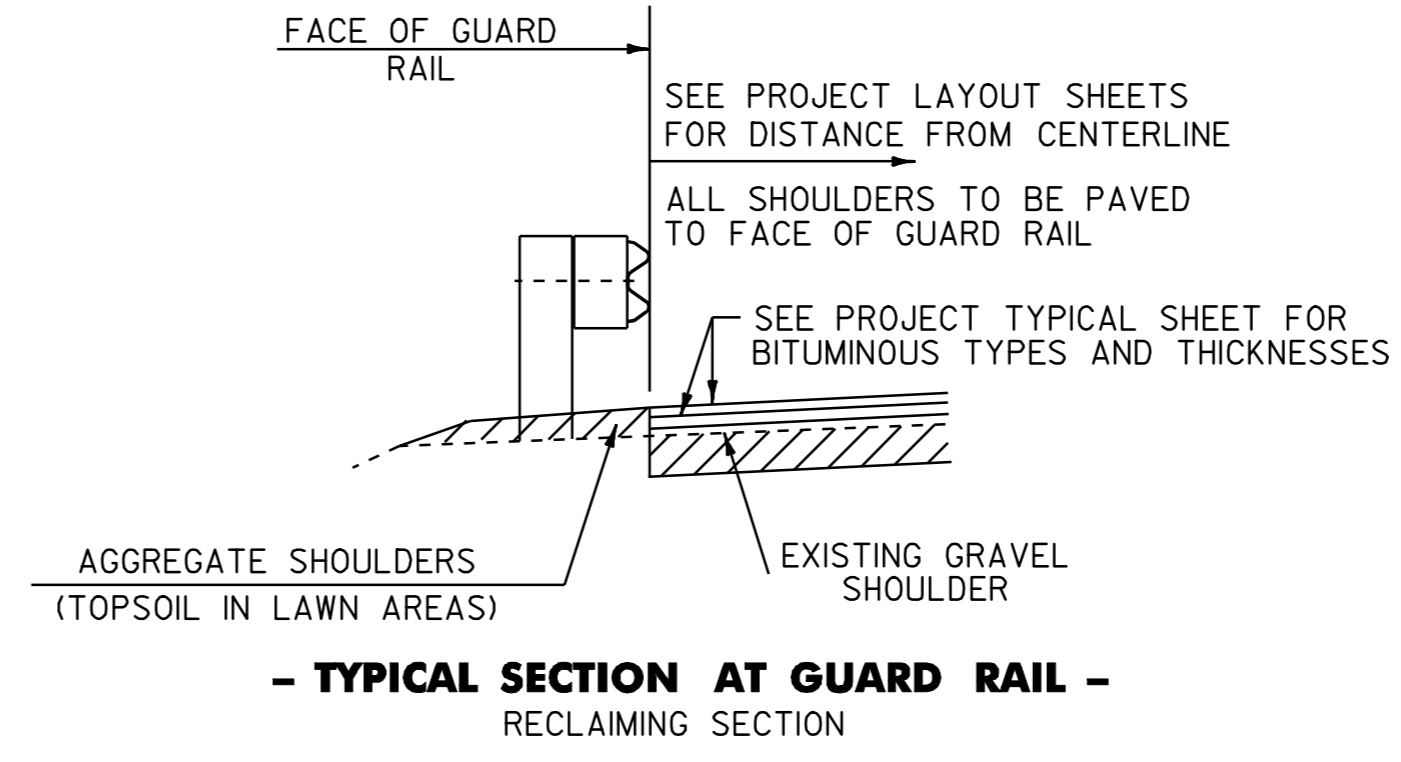

**PROJECT TYPICAL SHEET #2**

DESIGNED BY LFW DATE 6/04  
 DRAWN BY LFW DATE 6/04  
 DESIGN FILE NO. pave/99c192/99c192.dgn  
 PRF FILE 99c192+y2.1 DATE 12-MAR-2007  
 PROJ. NAME **MORGAN**  
 PROJ. NO. **AC STP 2220(1)S**  
 SHEET **3** OF **61** SHEETS