


TEMPORARY AND DURABLE 4" WHITE LINE
 STA 57+00 TO 64+00 SOLID RT AND LT

TEMPORARY AND DURABLE 4" YELLOW LINE
 STA 57+00 TO 64+00 SOLID RT SOLID LT

DITCHING LOCATIONS (REFER TO SHEET 7 FOR DETAILS)
 STA 57+00 TO 64+00 LT
 STA 62+05 RT (CULVERT OUTLET)

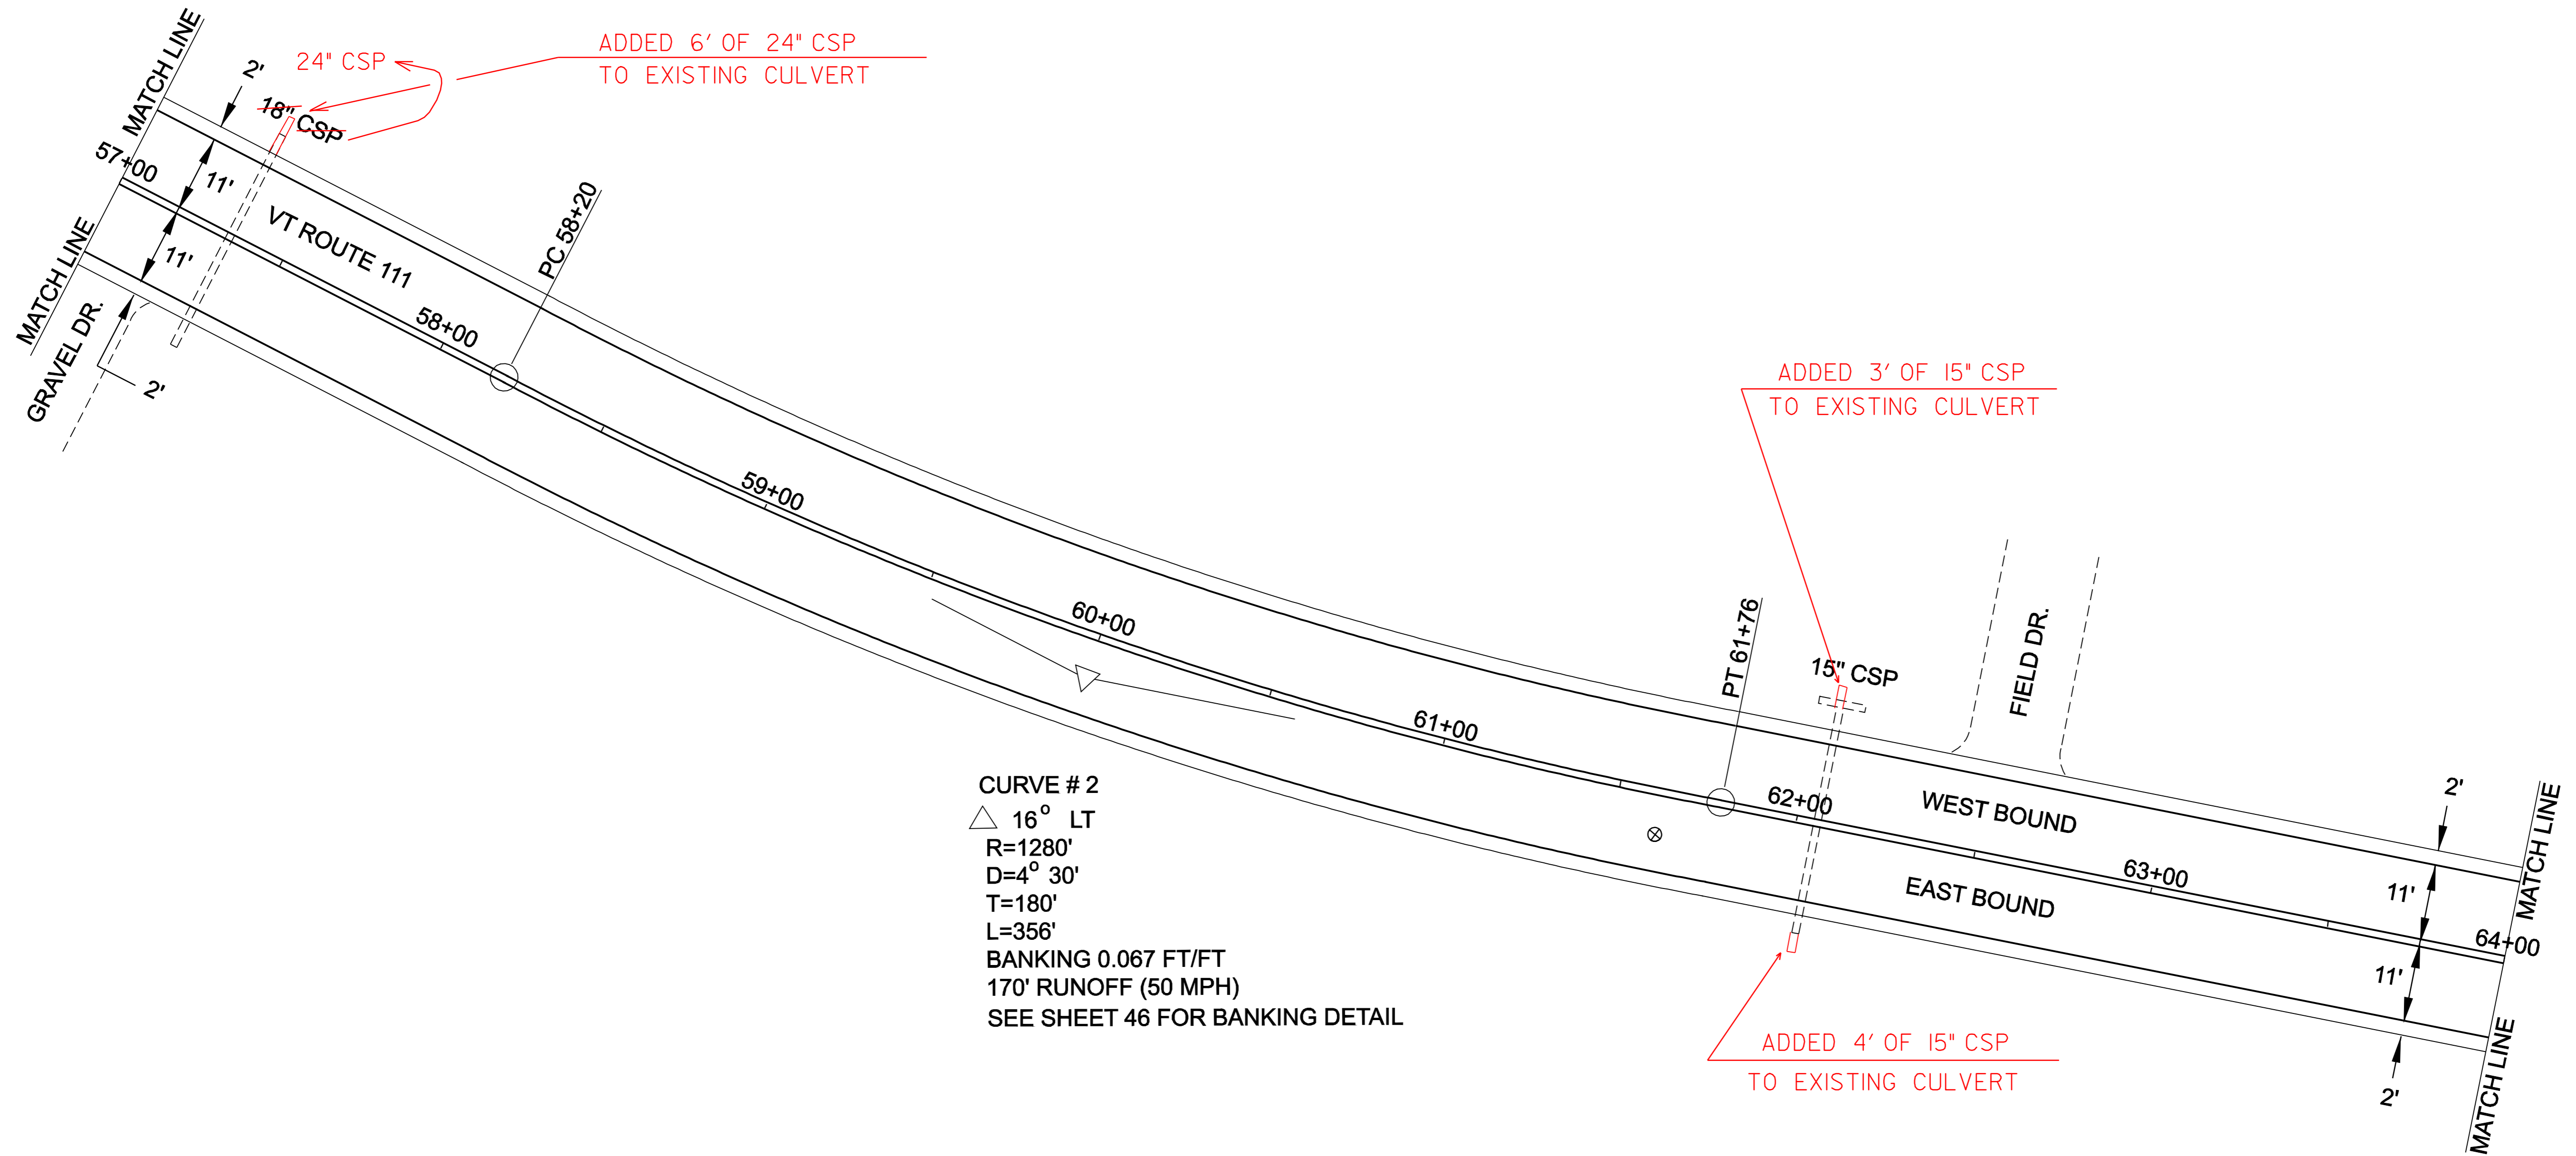

MORGAN VT. ROUTE 111 PAVEMENT CORE INFORMATION				
CORE #	STATION/POS.	DEPTH (in)	STRIPPED	DRAINABLE BASE
2	61+62 RT	8	BOTTOM	YES

PROJECT
LAYOUT
SHEET # 2

DESIGNED BY LFW DATE 6/04
 DRAWN BY LFW DATE 6/04
 DESIGN FILE NO. pave/99cl92/99cl92.dgn
 PRF FILE 99cl92p02.i DATE PLOTTED 12-MAR-2007 11:33
 PROJ. NAME **MORGAN**
 PROJ. NO. **AC STP 2220(1)S**
 SHEET **9** OF **61** SHEETS