


TEMPORARY AND DURABLE 4" WHITE LINE
STA 64+00 TO 71+00 SOLID RT AND LT

TEMPORARY AND DURABLE 4" YELLOW LINE
STA 64+00 TO 71+00 SOLID RT SOLID LT

DITCHING LOCATIONS (REFER TO SHEET 7 FOR DETAILS)
STA 64+00 TO 71+00 LT

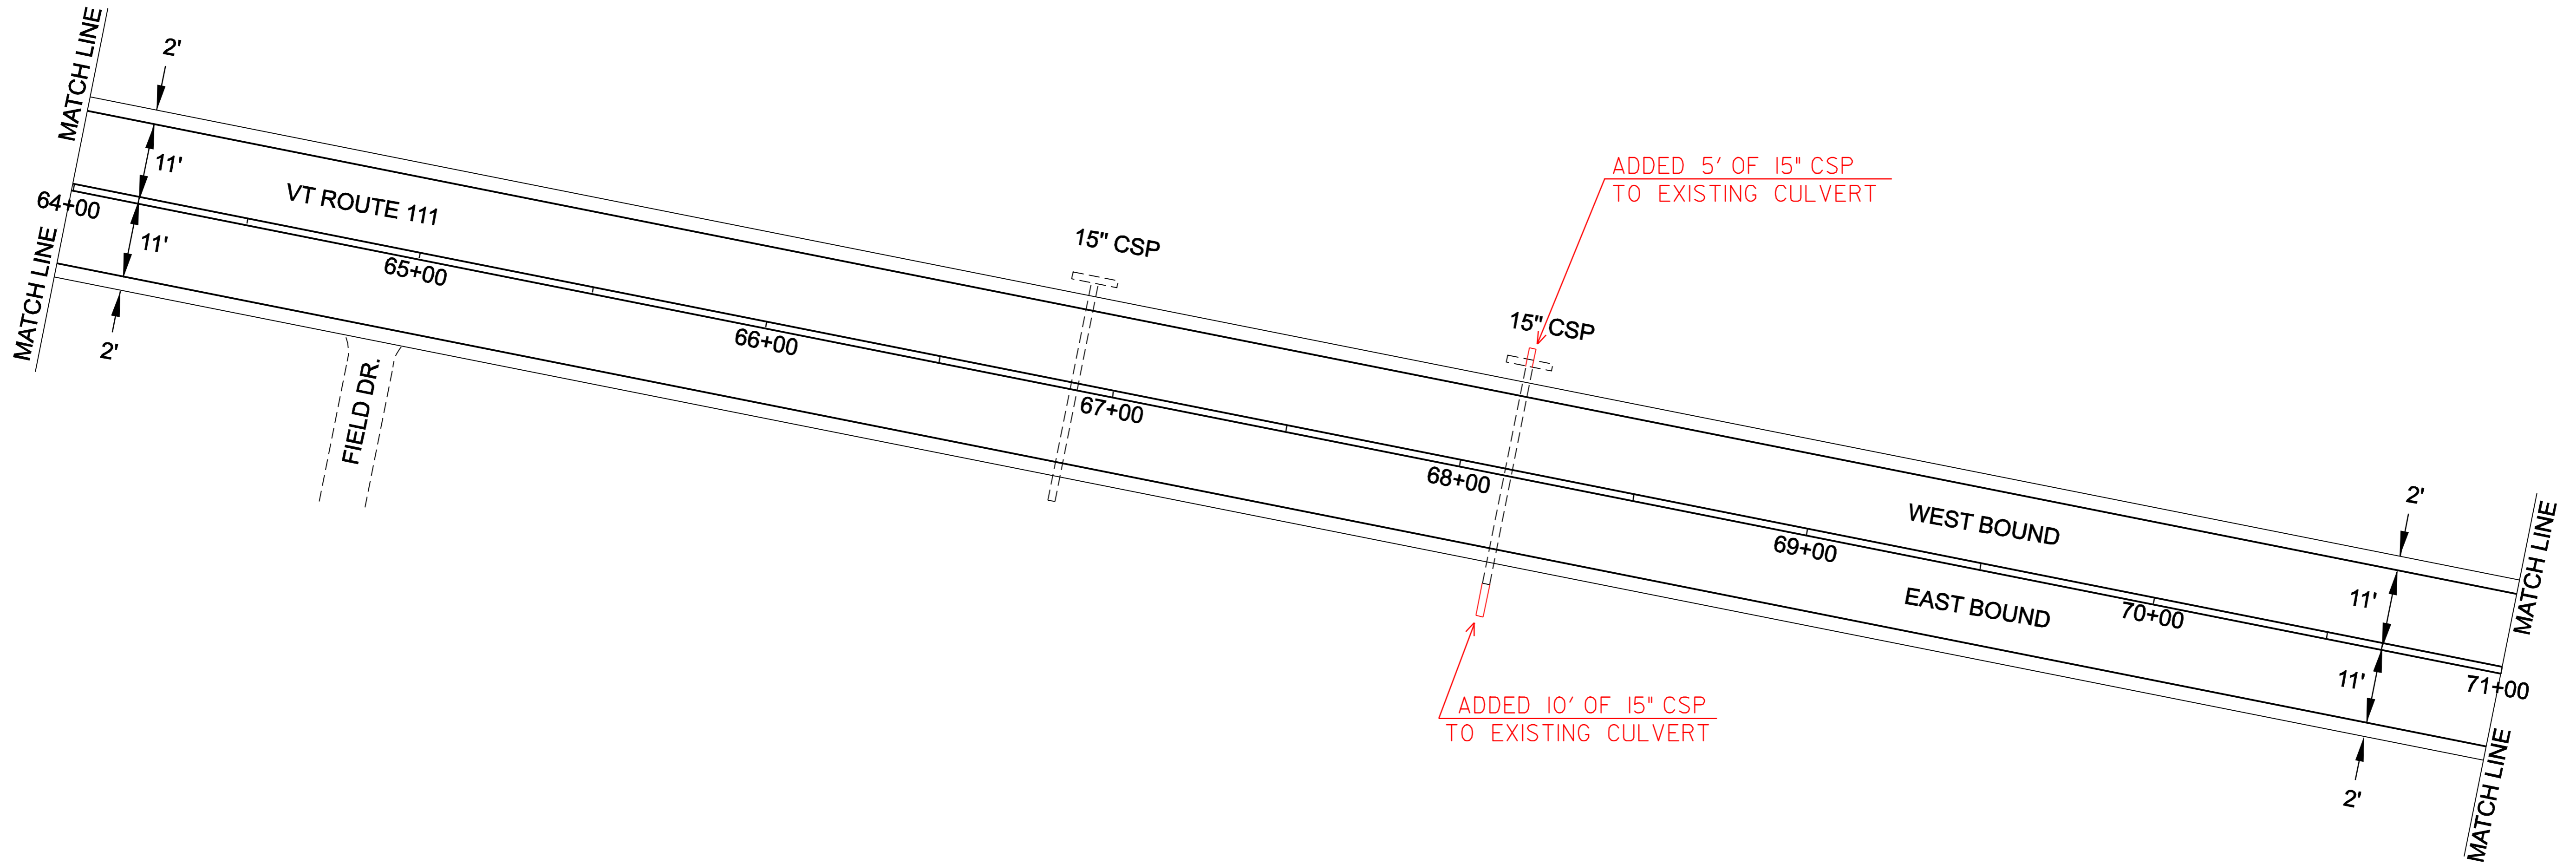

PROJECT LAYOUT SHEET #3	DESIGNED BY	LFW	DATE	6/04
	DRAWN BY	LFW	DATE	6/04
	DESIGN FILE NO.	pave/99cl92/99cl92.dgn		
	PRF FILE	99cl92p03.1	DATE PLOTTED	12-MAR-2007 11:3
	PROJ. NAME	MORGAN		
	PROJ. NO.	AC STP 2220(1)S		
SHEET	10	OF	61	SHEETS