


TEMPORARY AND DURABLE 4" WHITE LINE
 STA 71+00 TO 78+00 SOLID RT AND LT

TEMPORARY AND DURABLE 4" YELLOW LINE
 STA 71+00 TO 78+00 SOLID RT SOLID LT

DITCHING LOCATIONS (REFER TO SHEET 7 FOR DETAILS)
 STA 71+00 TO 78+00 LT

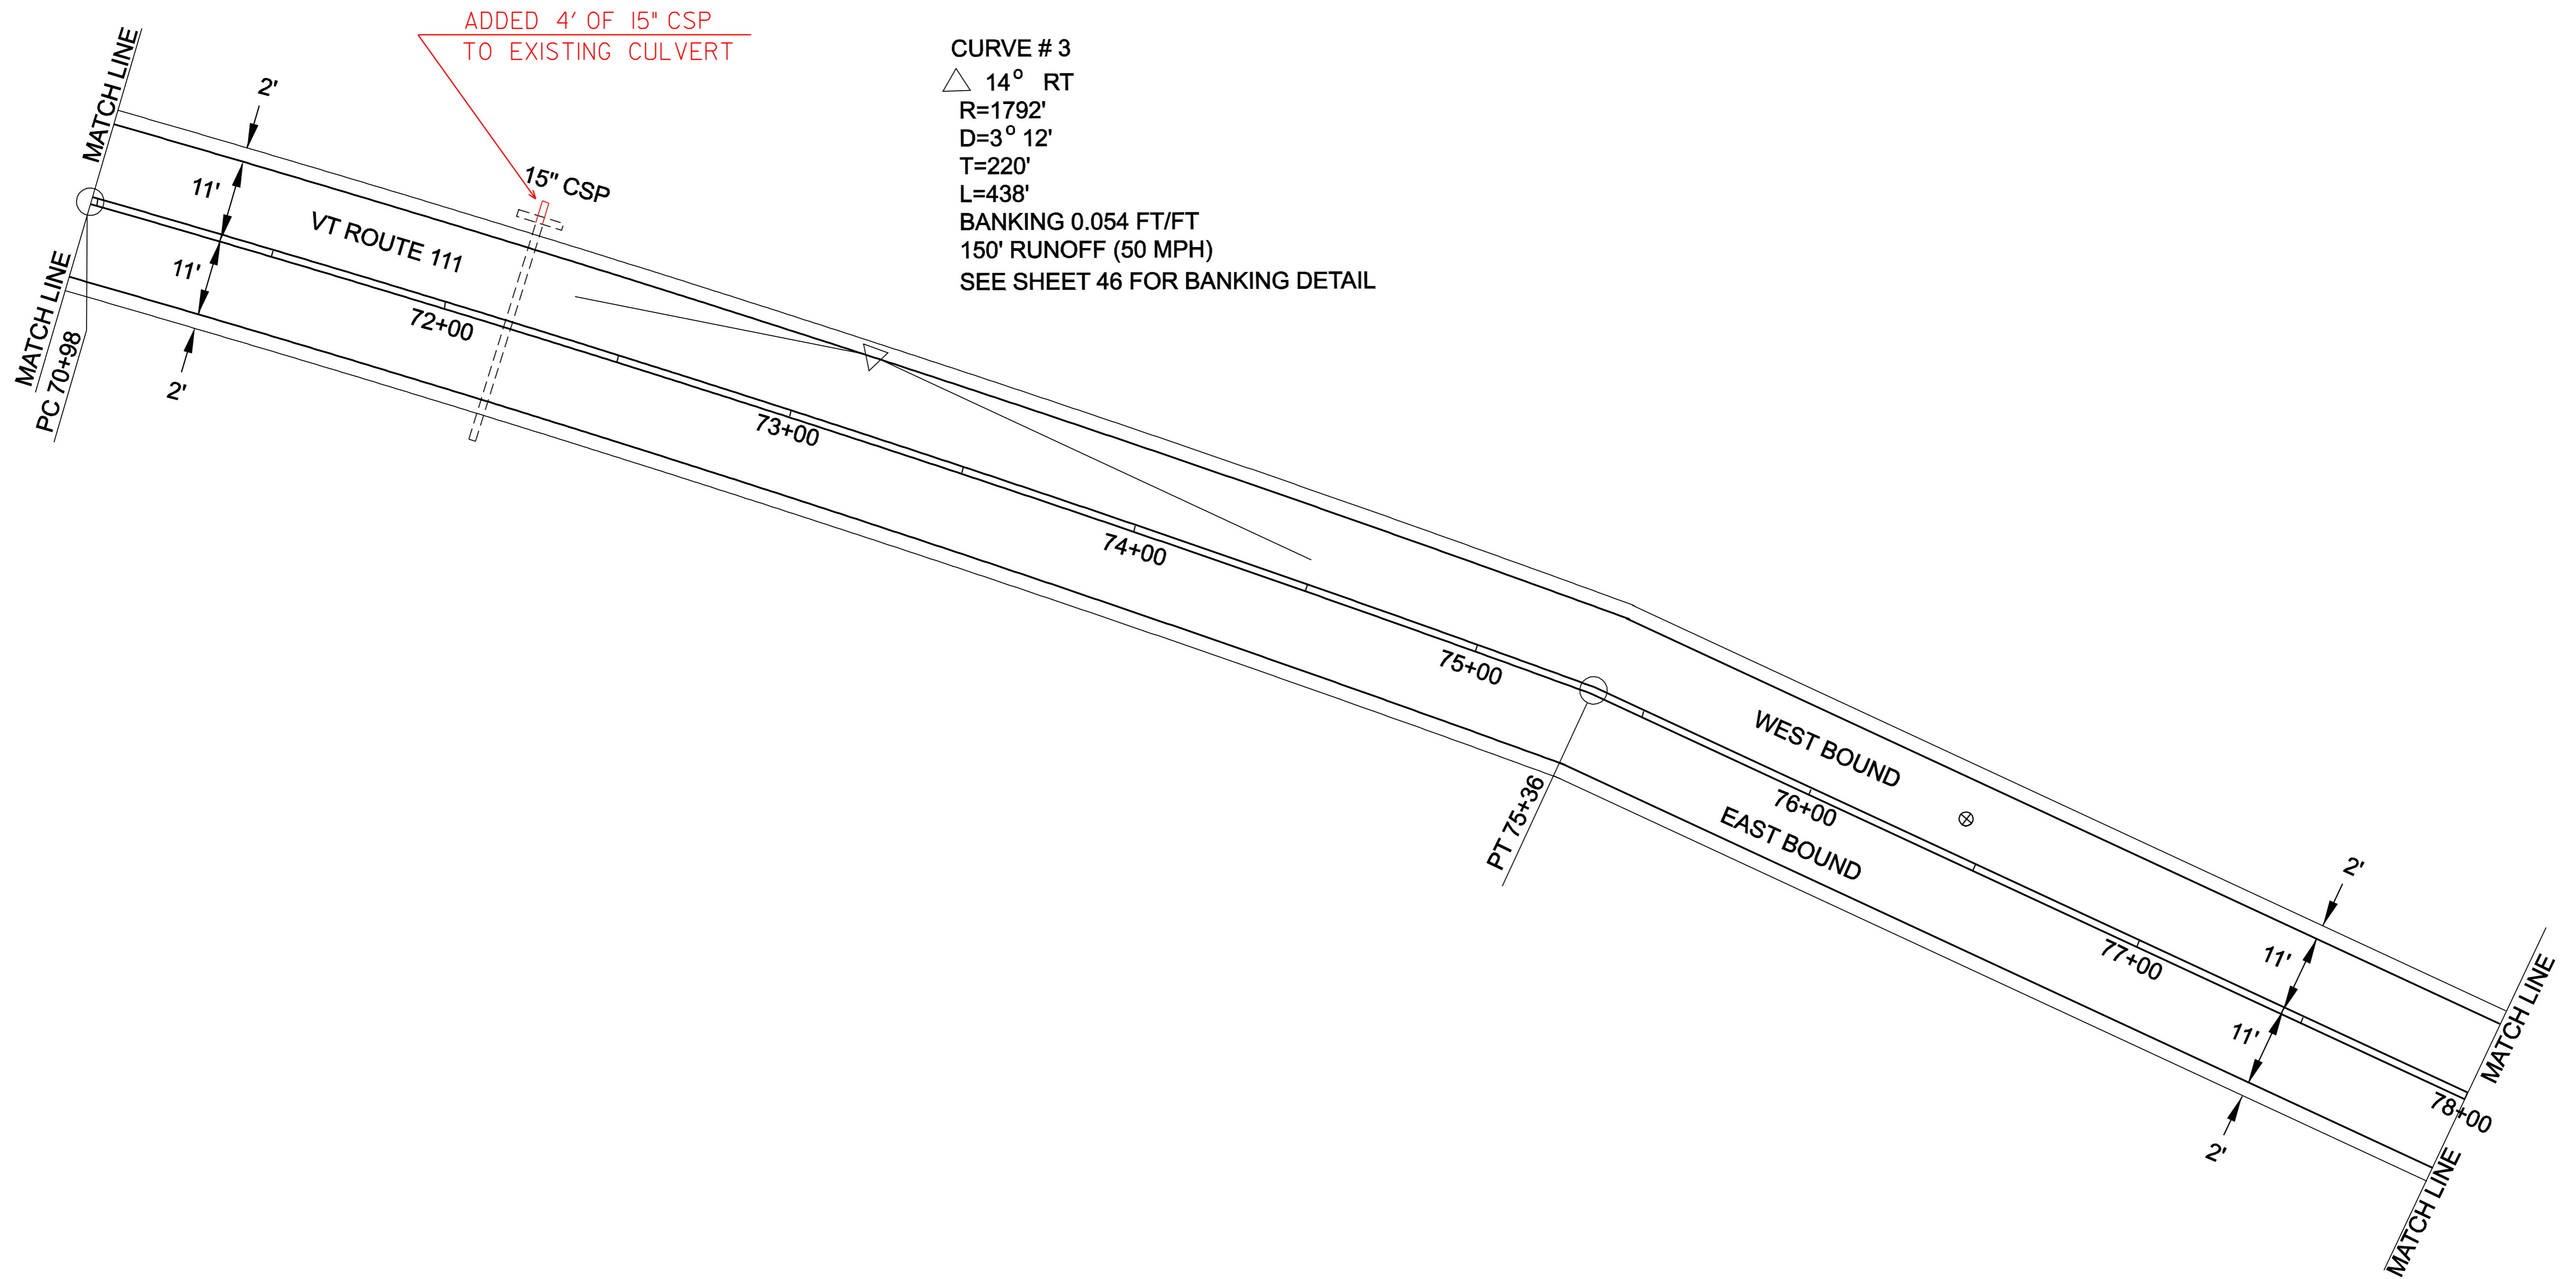

CURVE # 3
 △ 14° RT
 R=1792'
 D=3° 12'
 T=220'
 L=438'
 BANKING 0.054 FT/FT
 150' RUNOFF (50 MPH)
 SEE SHEET 46 FOR BANKING DETAIL

MORGAN VT. ROUTE 111 PAVEMENT CORE INFORMATION				
CORE #	STATION/POS.	DEPTH (in)	STRIPPED	DRAINABLE BASE
3	76+45 LT	5 1/2	NO	NO

PROJECT LAYOUT
SHEET # 4

DESIGNED BY LFW DATE 6/04
 DRAWN BY LFW DATE 6/04
 DESIGN FILE NO. pave/99cl92/99cl92.dgn
 PRF FILE 99cl92p04.1 DATE PLOTTED 12-MAR-2007 11:3
 PROJ. NAME **MORGAN**
 PROJ. NO. **AC STP 2220(1)S**
 SHEET **11** OF **61** SHEETS