


TEMPORARY AND DURABLE 4" WHITE LINE
 STA 85+00 TO 92+00 SOLID RT AND LT

TEMPORARY AND DURABLE 4" YELLOW LINE
 STA 85+00 TO 92+00 SOLID RT SOLID LT

DITCHING LOCATIONS (REFER TO SHEET 7 FOR DETAILS)
 STA 85+00 TO 85+40 LT
 STA 88+00 TO 89+56 LT
 STA 89+97 TO 92+00 LT

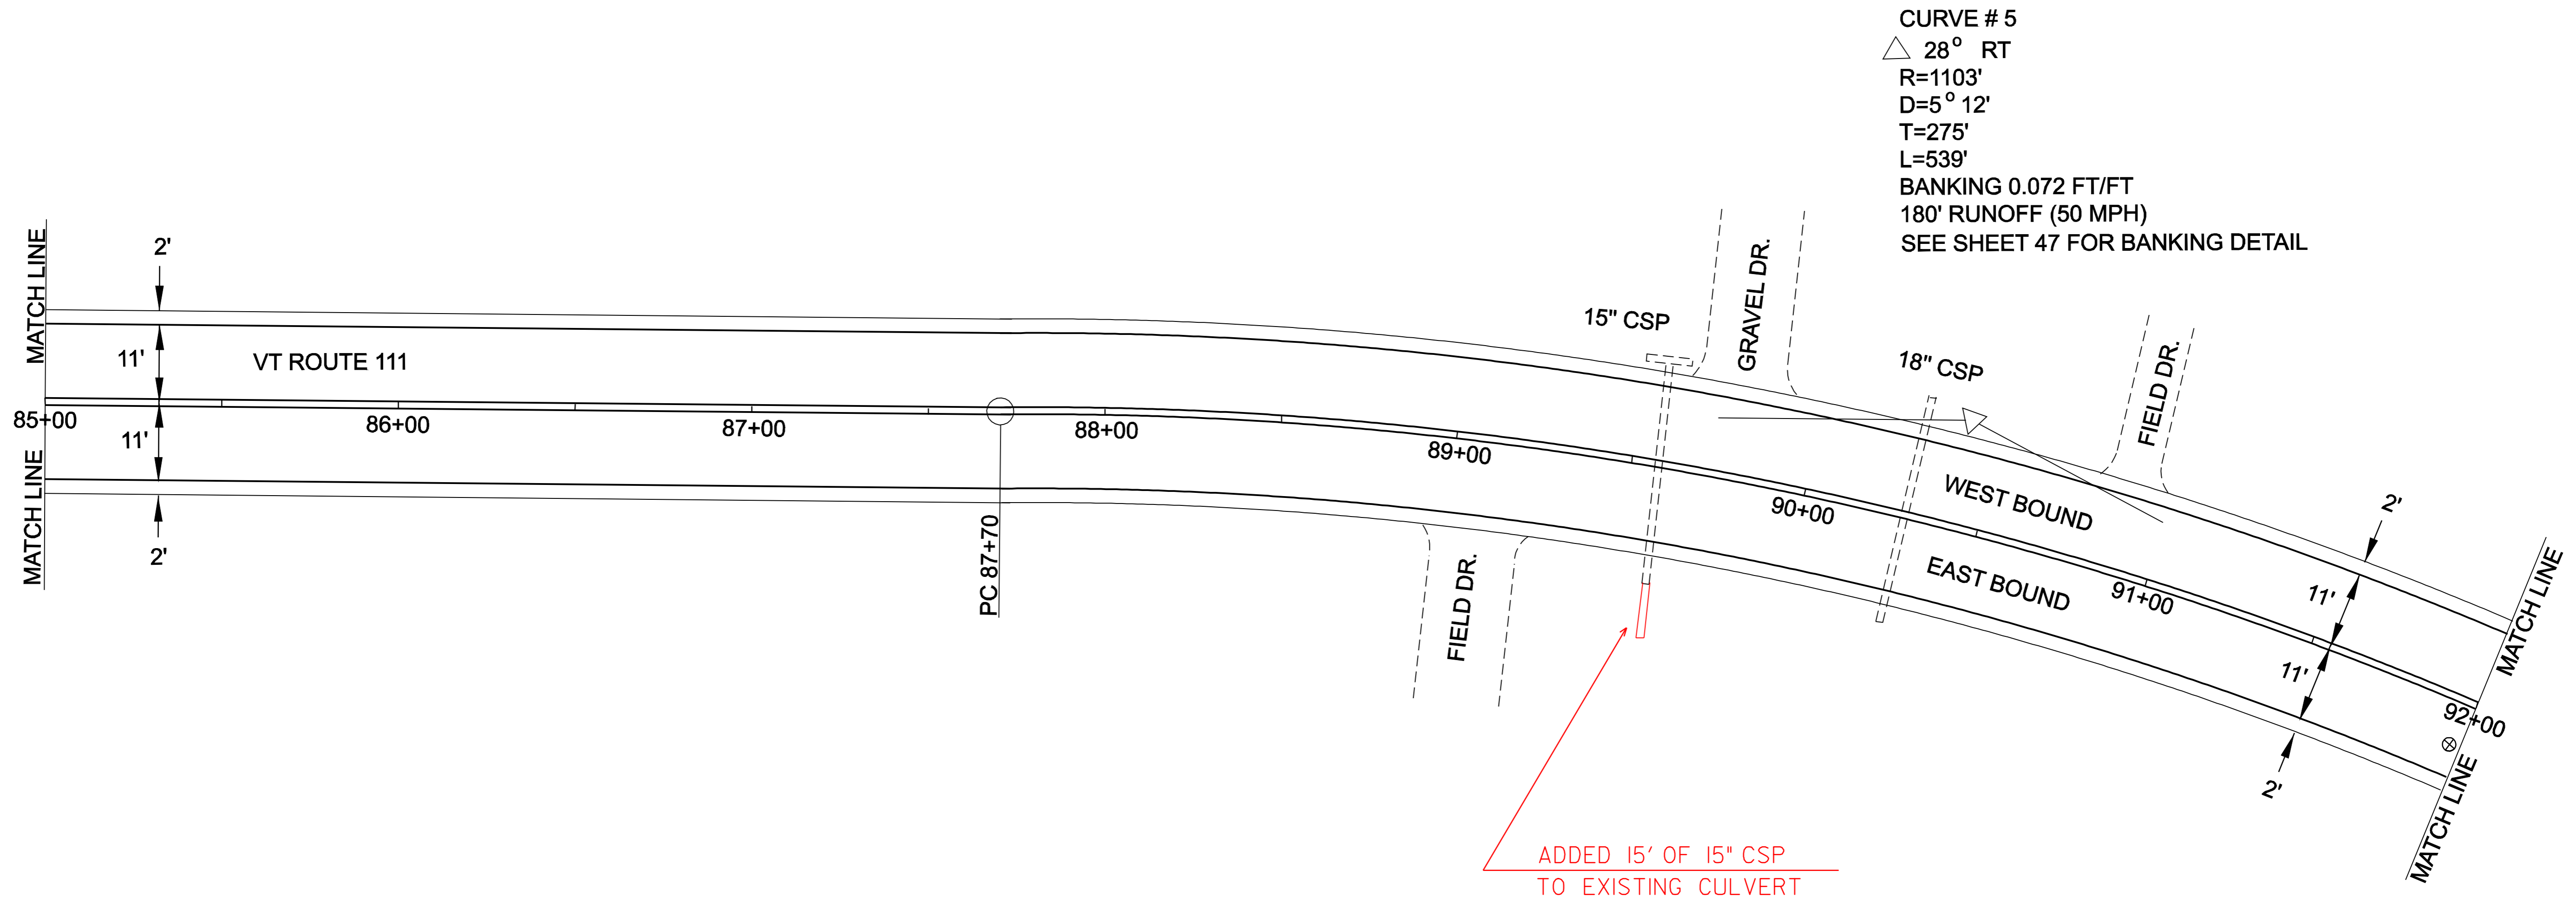

CURVE # 5
 △ 28° RT
 R=1103'
 D=5° 12'
 T=275'
 L=539'
 BANKING 0.072 FT/FT
 180' RUNOFF (50 MPH)
 SEE SHEET 47 FOR BANKING DETAIL

ADDED 15' OF 15" CSP
 TO EXISTING CULVERT

MORGAN VT. ROUTE 111 PAVEMENT CORE INFORMATION				
CORE #	STATION/POS.	DEPTH (in)	STRIPPED	DRAINABLE BASE
4	91+98 RT	4 3/4	BOTTOM	YES

PROJECT
LAYOUT
SHEET #6

DESIGNED BY LFW DATE 6/04
 DRAWN BY LFW DATE 6/04
 DESIGN FILE NO. pave/99cl92/99cl92.dgn
 PRF FILE 99cl92p06.1 DATE 12-MAR-2007 IIS:3
 PROJ. NAME **MORGAN**
 PROJ. NO. **AC STP 2220(1)S**
 SHEET **13** OF **61** SHEETS