


TEMPORARY AND DURABLE 4" WHITE LINE  
STA 92+00 TO 100+00 SOLID RT AND LT

TEMPORARY AND DURABLE 4" YELLOW LINE  
STA 92+00 TO 100+00 SOLID RT SOLID LT

DITCHING LOCATIONS (REFER TO SHEET 7 FOR DETAILS)  
STA 92+00 TO 92+33 LT  
STA 93+00 TO 99+46 LT  
STA 99+77 TO 100+00 LT

INSTALLED NEW 18" x 40' CSP  
DRIVE CULVERT

CURVE # 6  
△ 16° RT  
R=712'  
D=8° 03'  
T=100'  
L=199'  
BANKING 0.080 FT/FT  
190' RUNOFF (50 MPH)  
SEE SHEET 47 FOR BANKING DETAIL

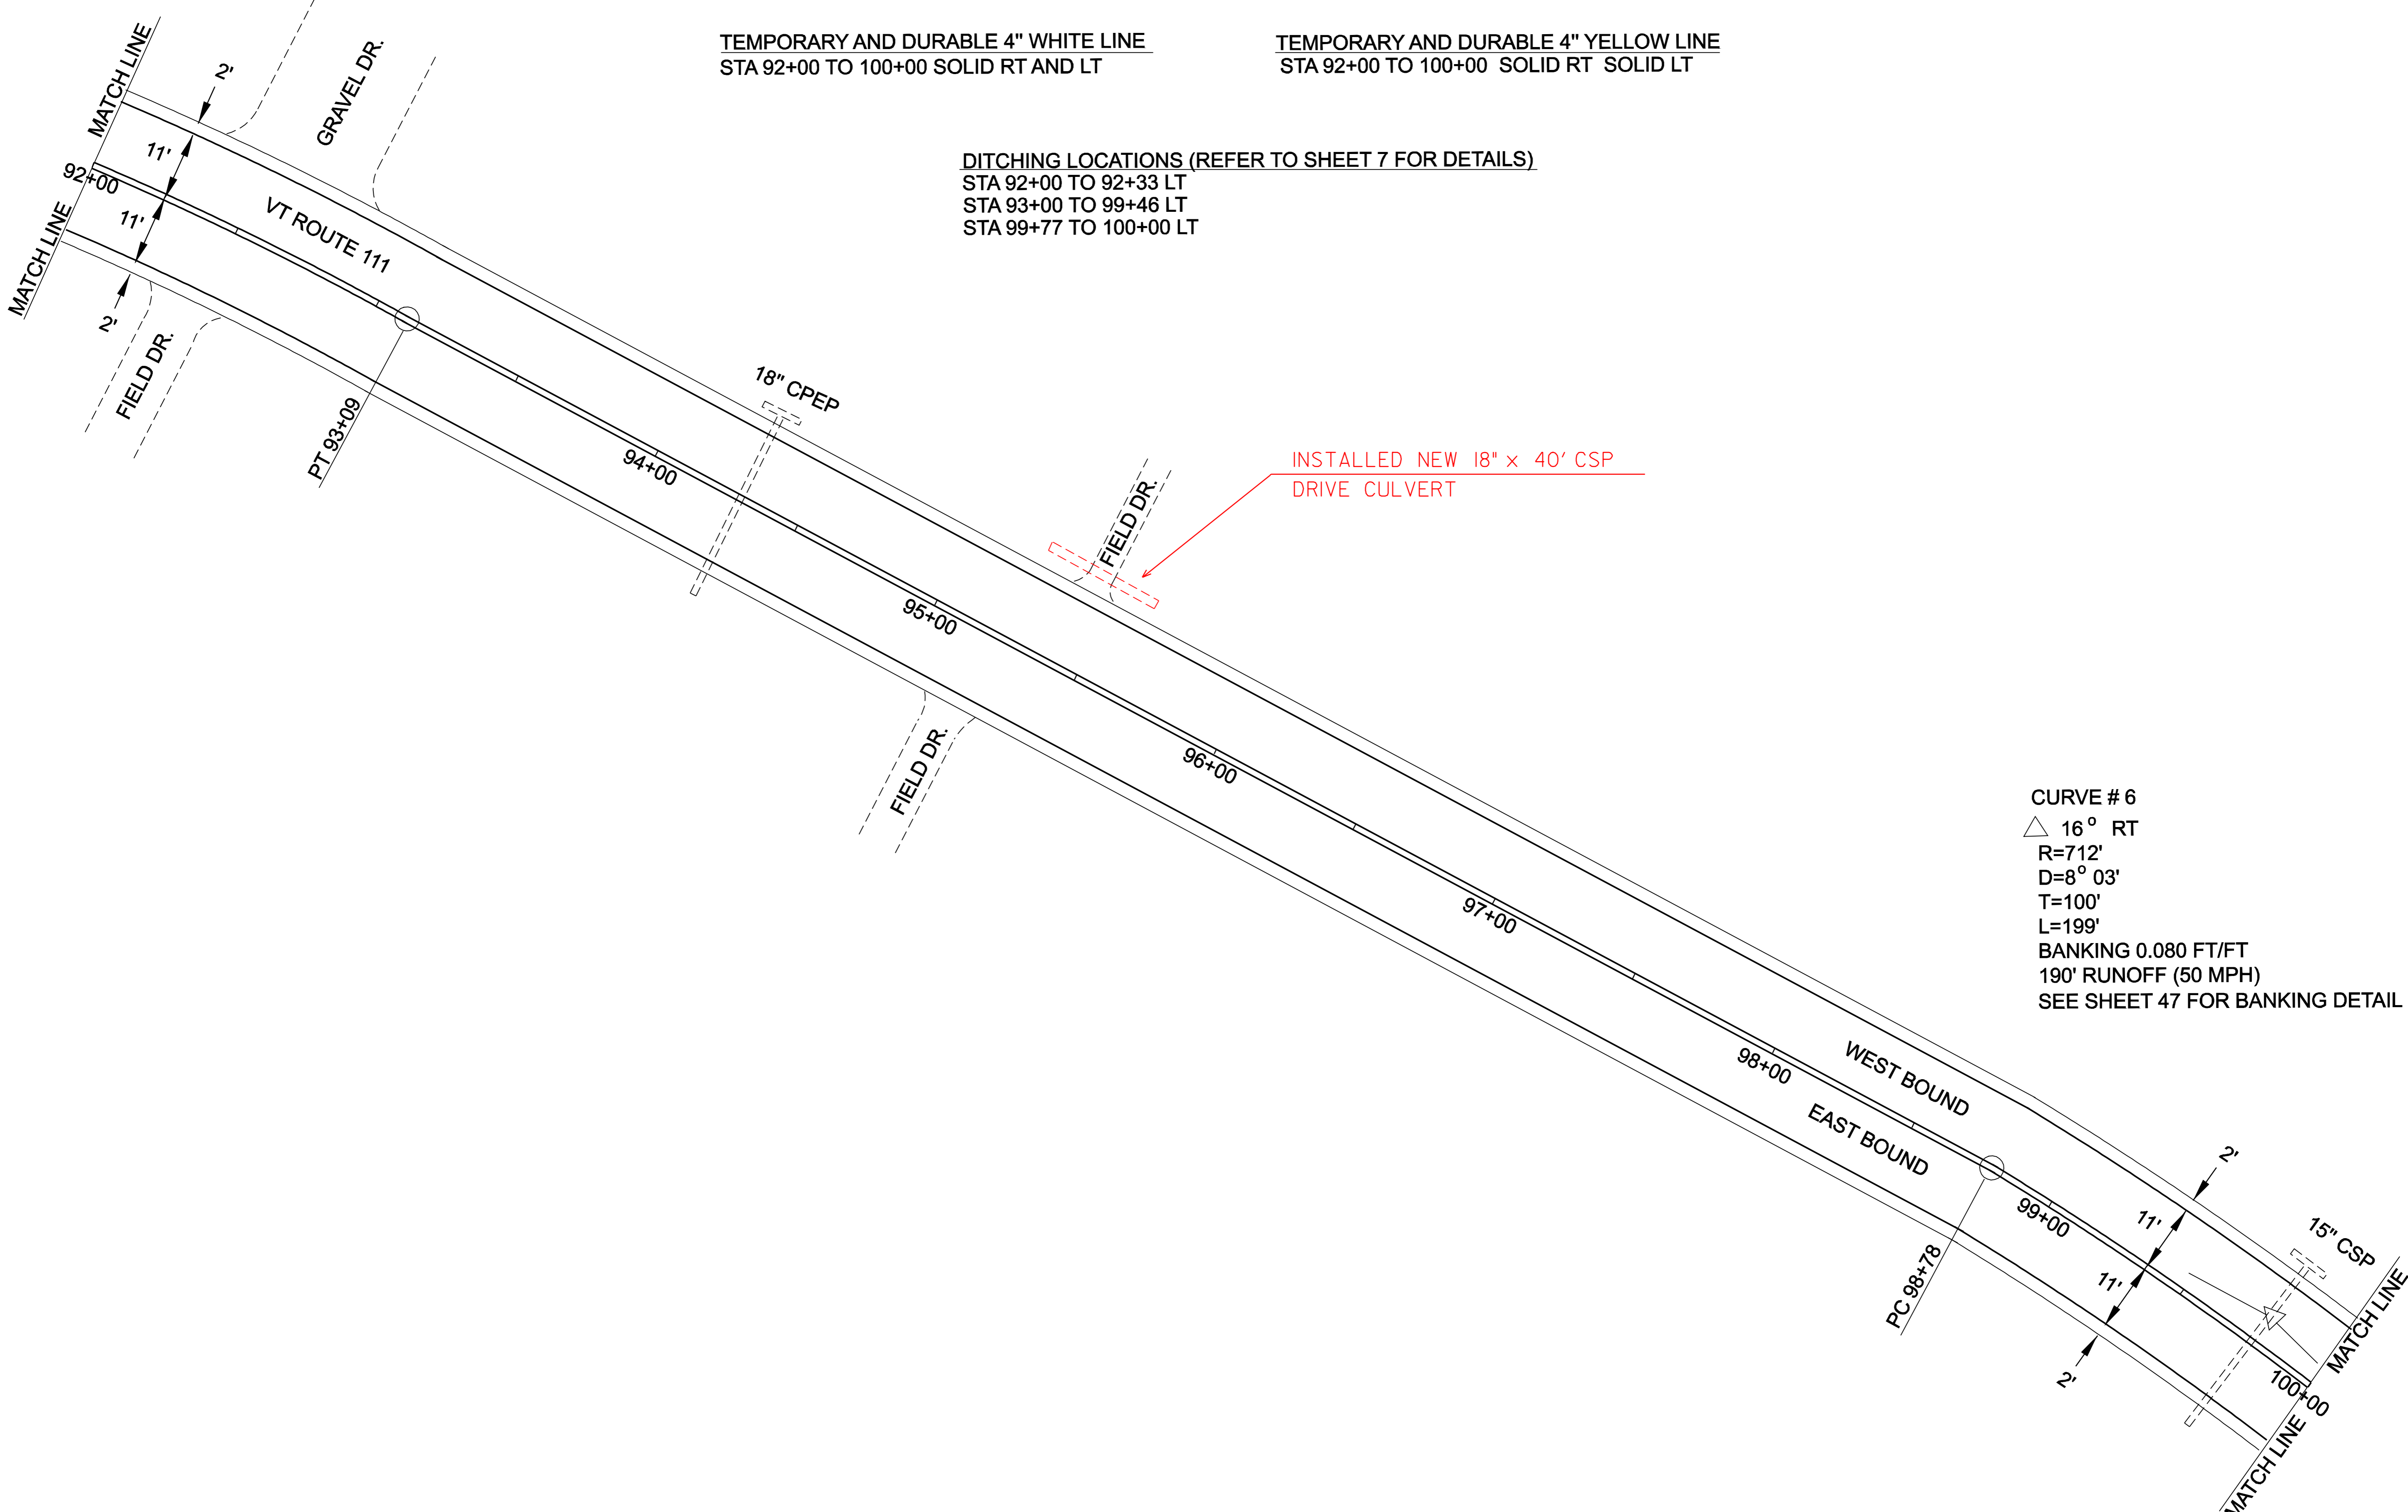

PROJECT LAYOUT SHEET # 7	DESIGNED BY	LFW	DATE	6/04
	DRAWN BY	LFW	DATE	6/04
	DESIGN FILE NO.	pave/99cl92/99cl92.dgn		
	PRF FILE	99cl92p07.1	DATE PLOTTED	12-MAR-2007 11:33
	PROJ. NAME	MORGAN		
PROJ. NO.	AC STP 2220(1)S			
SHEET	14	OF	61	SHEETS