


TEMPORARY AND DURABLE 4" WHITE LINE
STA 167+50 TO 175+00 SOLID RT AND LT

TEMPORARY AND DURABLE 4" YELLOW LINE
STA 167+50 TO 175+00 SOLID RT SOLID LT

DITCHING LOCATIONS (REFER TO SHEET 7 FOR DETAILS)
STA 168+00 TO 169+76 RT
STA 169+35 TO 171+38 LT
STA 172+00 TO 175+00 RT

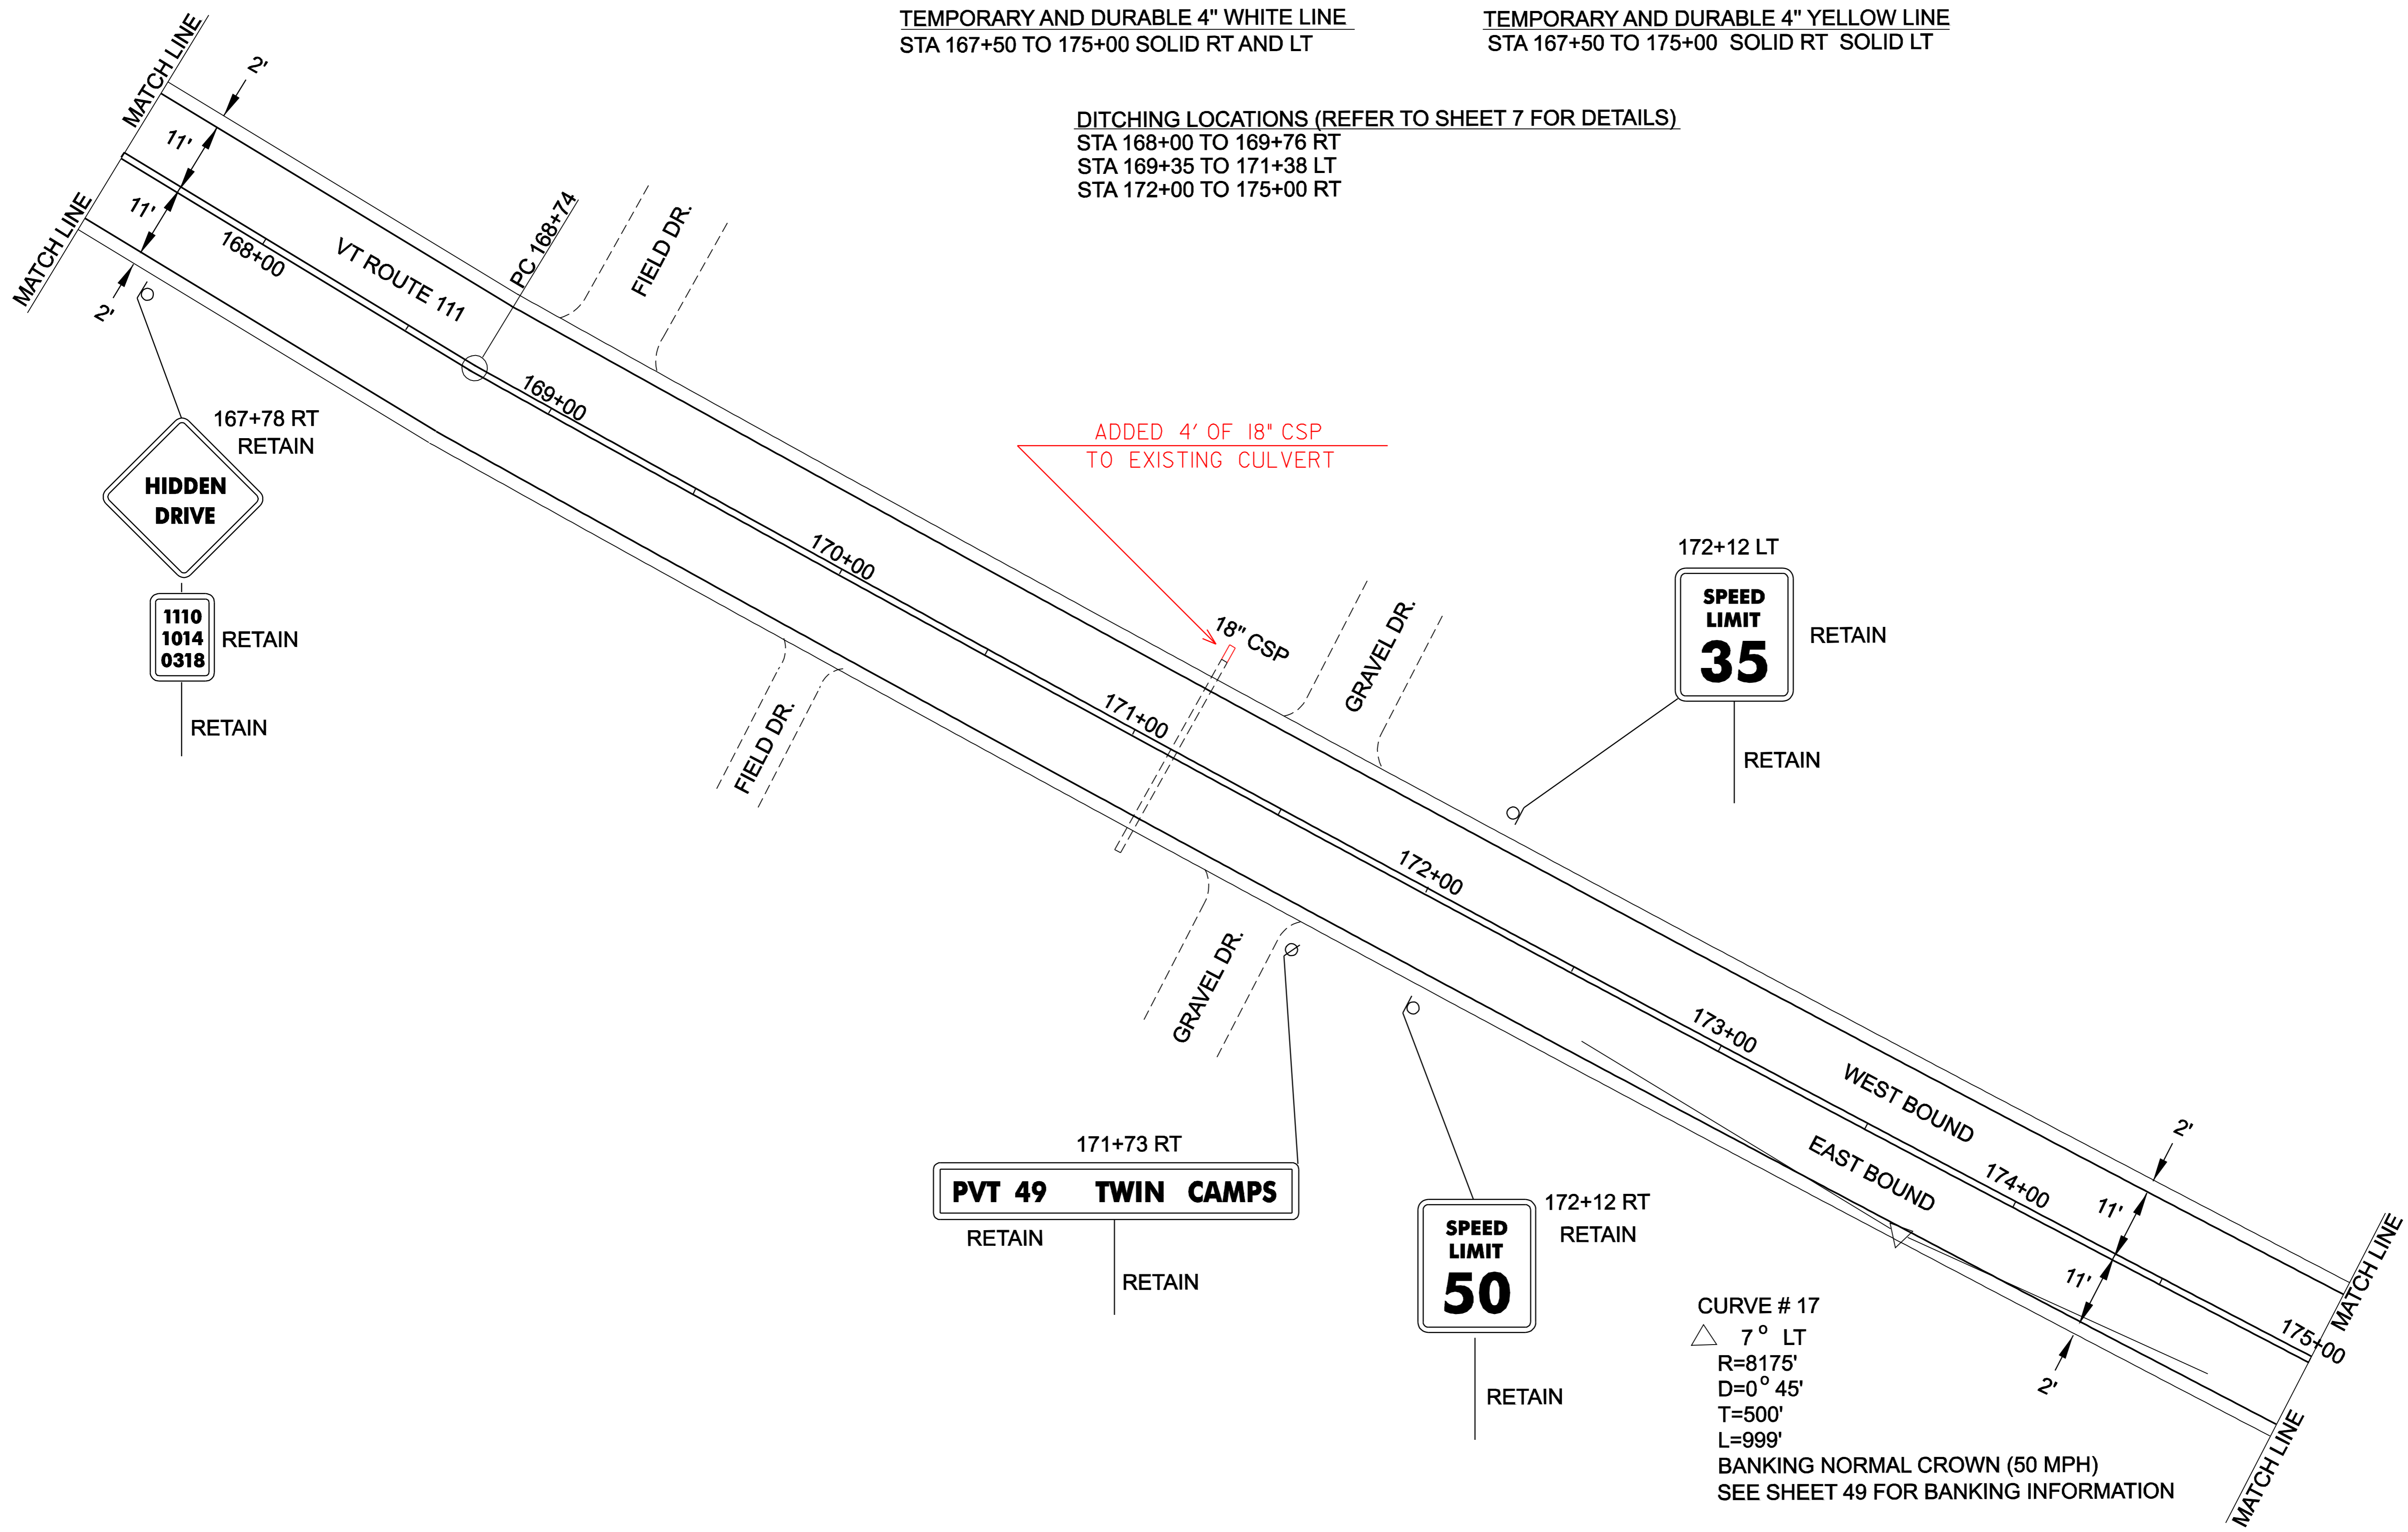

CURVE # 17
△ 7° LT
R=8175'
D=0° 45'
T=500'
L=999'
BANKING NORMAL CROWN (50 MPH)
SEE SHEET 49 FOR BANKING INFORMATION

PROJECT LAYOUT SHEET #17	DESIGNED BY	LFW	DATE	6/04
	DRAWN BY	LFW	DATE	6/04
	DESIGN FILE NO.	pave/99cl92/99cl92.dgn		
	PRF FILE	99cl92p17.1	DATE PLOTTED	12-MAR-2007 11:3
	PROJ. NAME	MORGAN		
PROJ. NO.	AC STP 2220(1)S			
SHEET	24	OF	61	SHEETS