

DITCHING LOCATIONS (REFER TO SHEET 7 FOR DETAILS)

STA 175+00 TO 175+83 RT
 STA 176+40 TO 179+25 LT
 STA 179+64 TO 182+50 LT
 STA 181+25 TO 182+50 RT

TEMPORARY AND DURABLE 4" WHITE LINE

STA 175+00 TO 183+00 SOLID RT AND LT


TEMPORARY AND DURABLE 4" YELLOW LINE

STA 175+00 TO 183+00 SOLID RT SOLID LT

ERECTING SALVAGED SIGNS

AS SHOWN - 1

REMOVING SIGNS
 AS SHOWN - 2

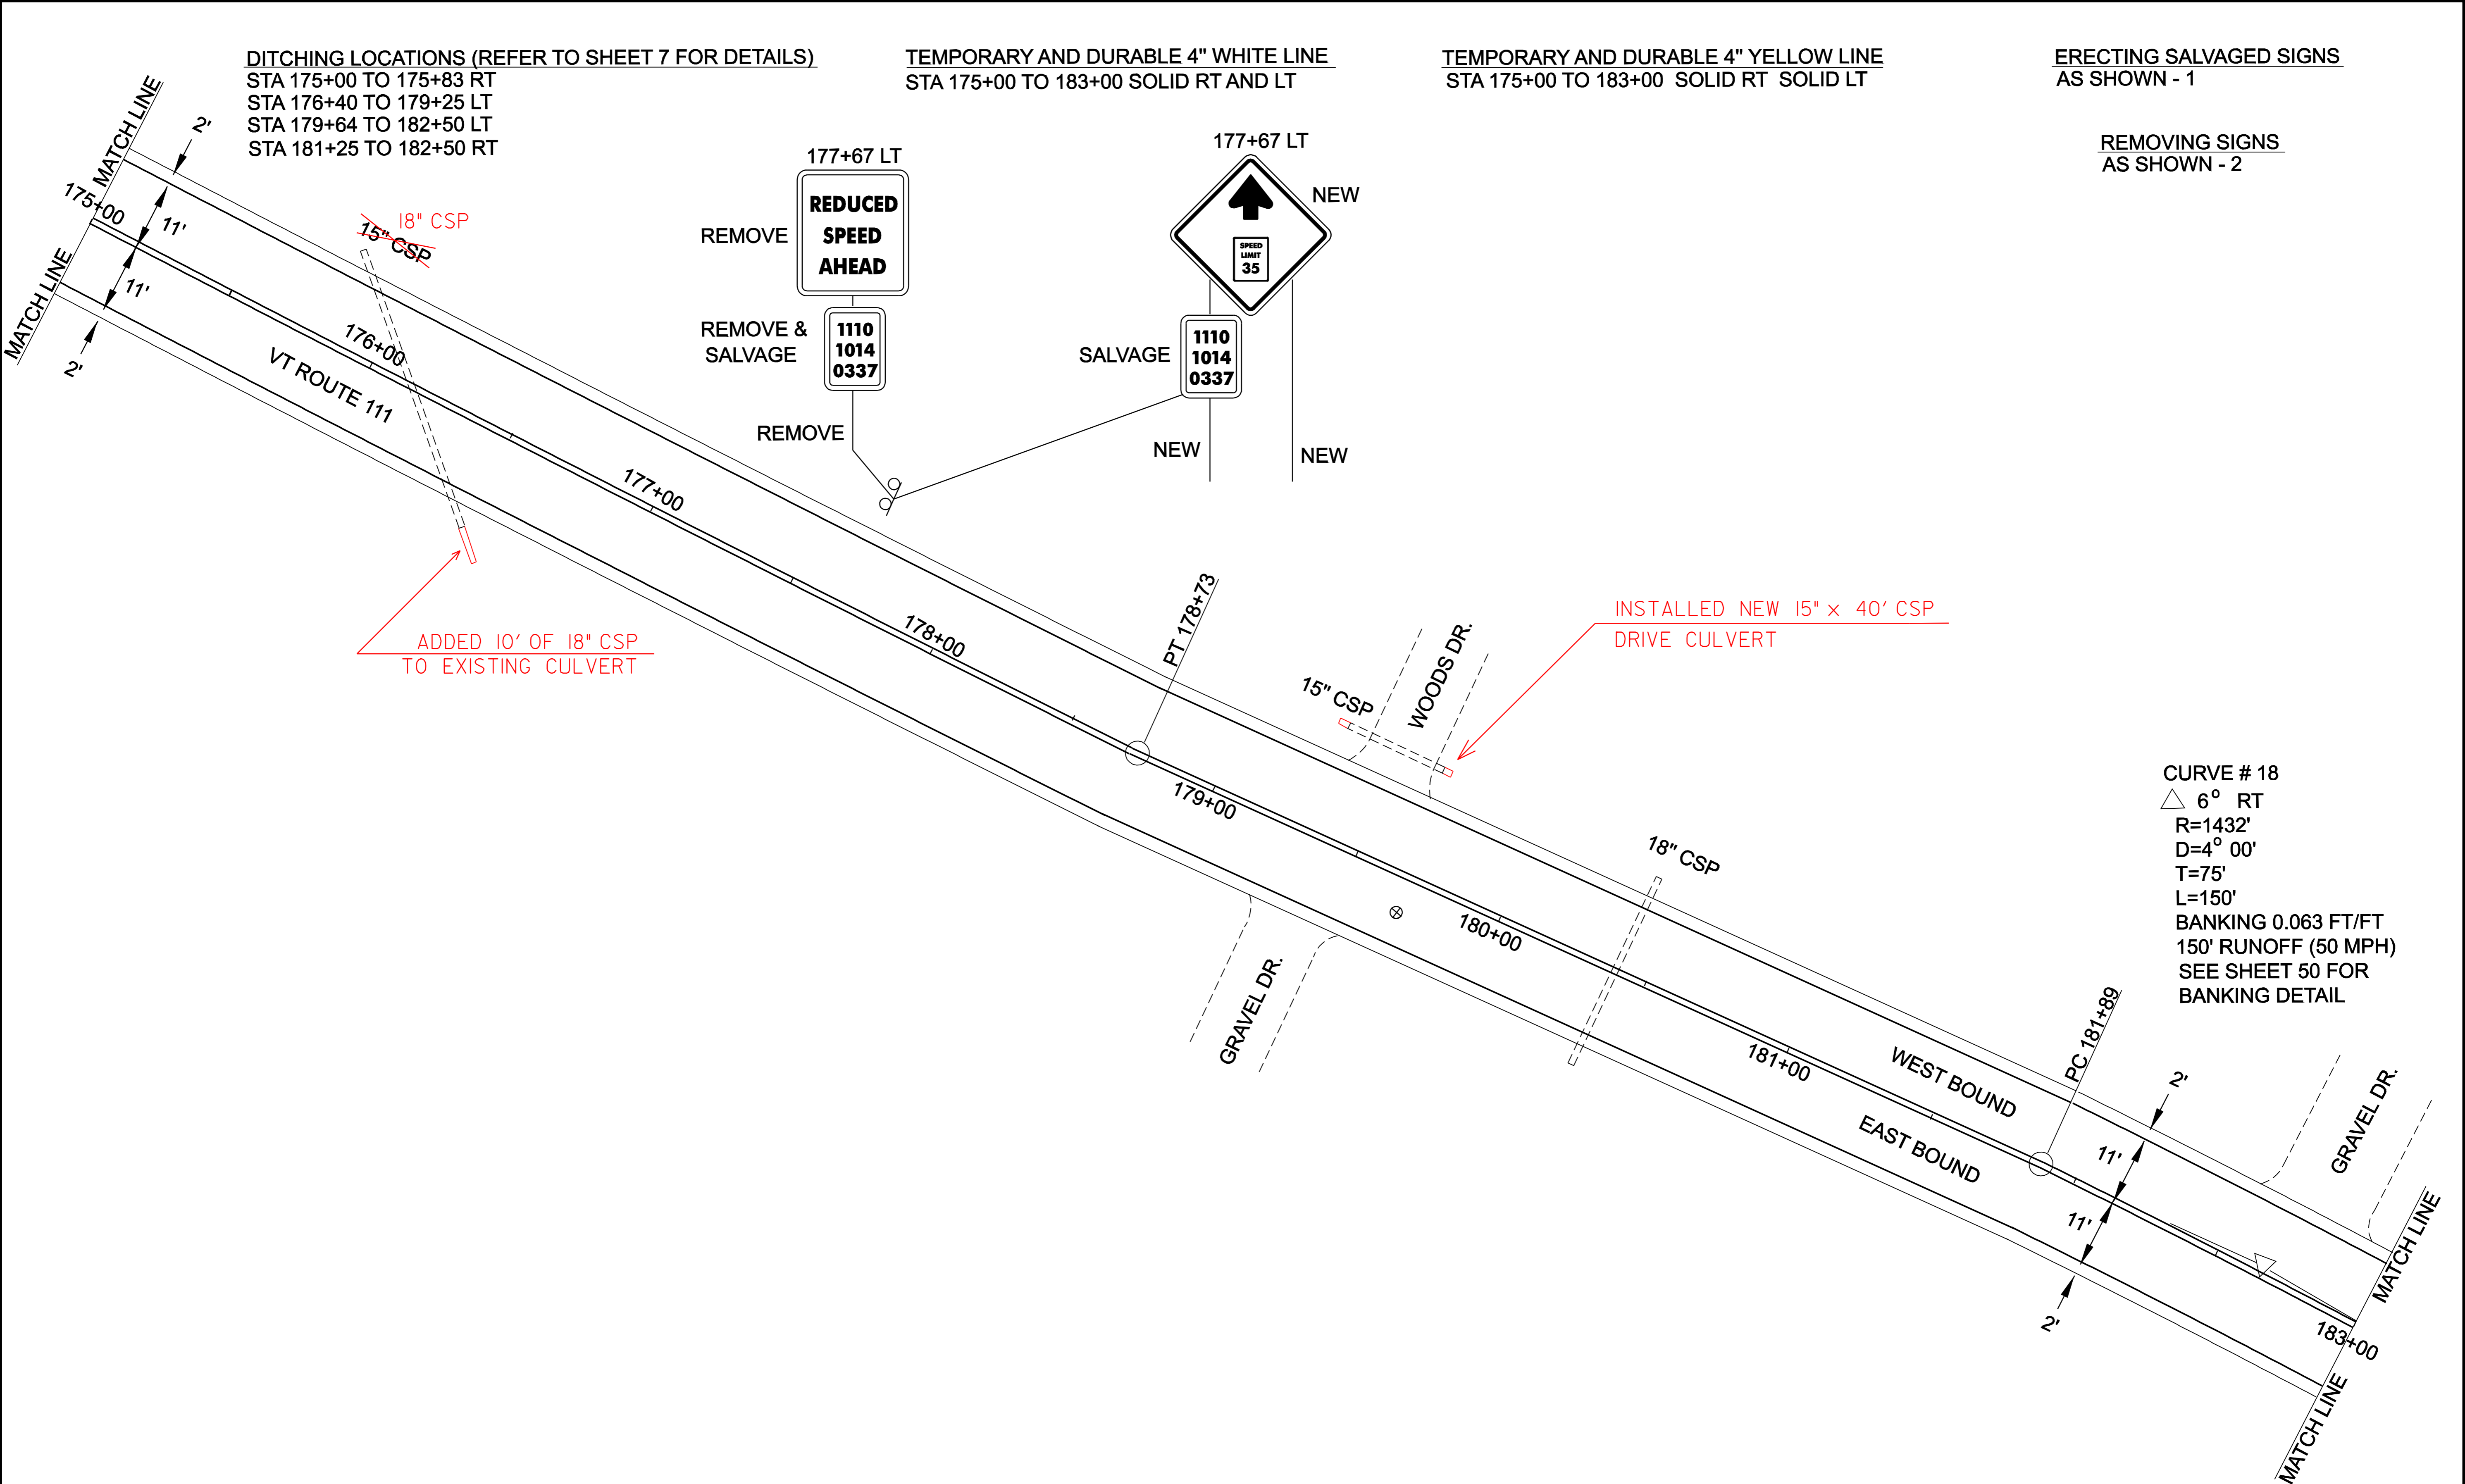

MORGAN VT. ROUTE 111 PAVEMENT CORE INFORMATION				
CORE #	STATION/POS.	DEPTH (in)	STRIPPED	DRAINABLE BASE
12	179+63 RT	4 1/2	NO	NO

PROJECT
LAYOUT
SHEET #18

DESIGNED BY LFW DATE 6/04
 DRAWN BY LFW DATE 6/04
 DESIGN FILE NO. pave/99cl92/99cl92.dgn
 PRF FILE 99cl92p18.1 DATE 12-MAR-2007 11:33
 PROJ. NAME **MORGAN**
 PROJ. NO. **AC STP 2220(1)S**
 SHEET **25** OF **61** SHEETS