


TEMPORARY AND DURABLE 4" WHITE LINE  
 STA 183+00 TO 190+50 SOLID RT AND LT

TEMPORARY AND DURABLE 4" YELLOW LINE  
 STA 183+00 TO 184+27 SOLID RT SOLID LT  
 STA 184+27 TO 190+50 DASHED RT SOLID LT

DITCHING LOCATIONS (REFER TO SHEET 7 FOR DETAILS)  
 STA 185+20 TO 190+08 LT

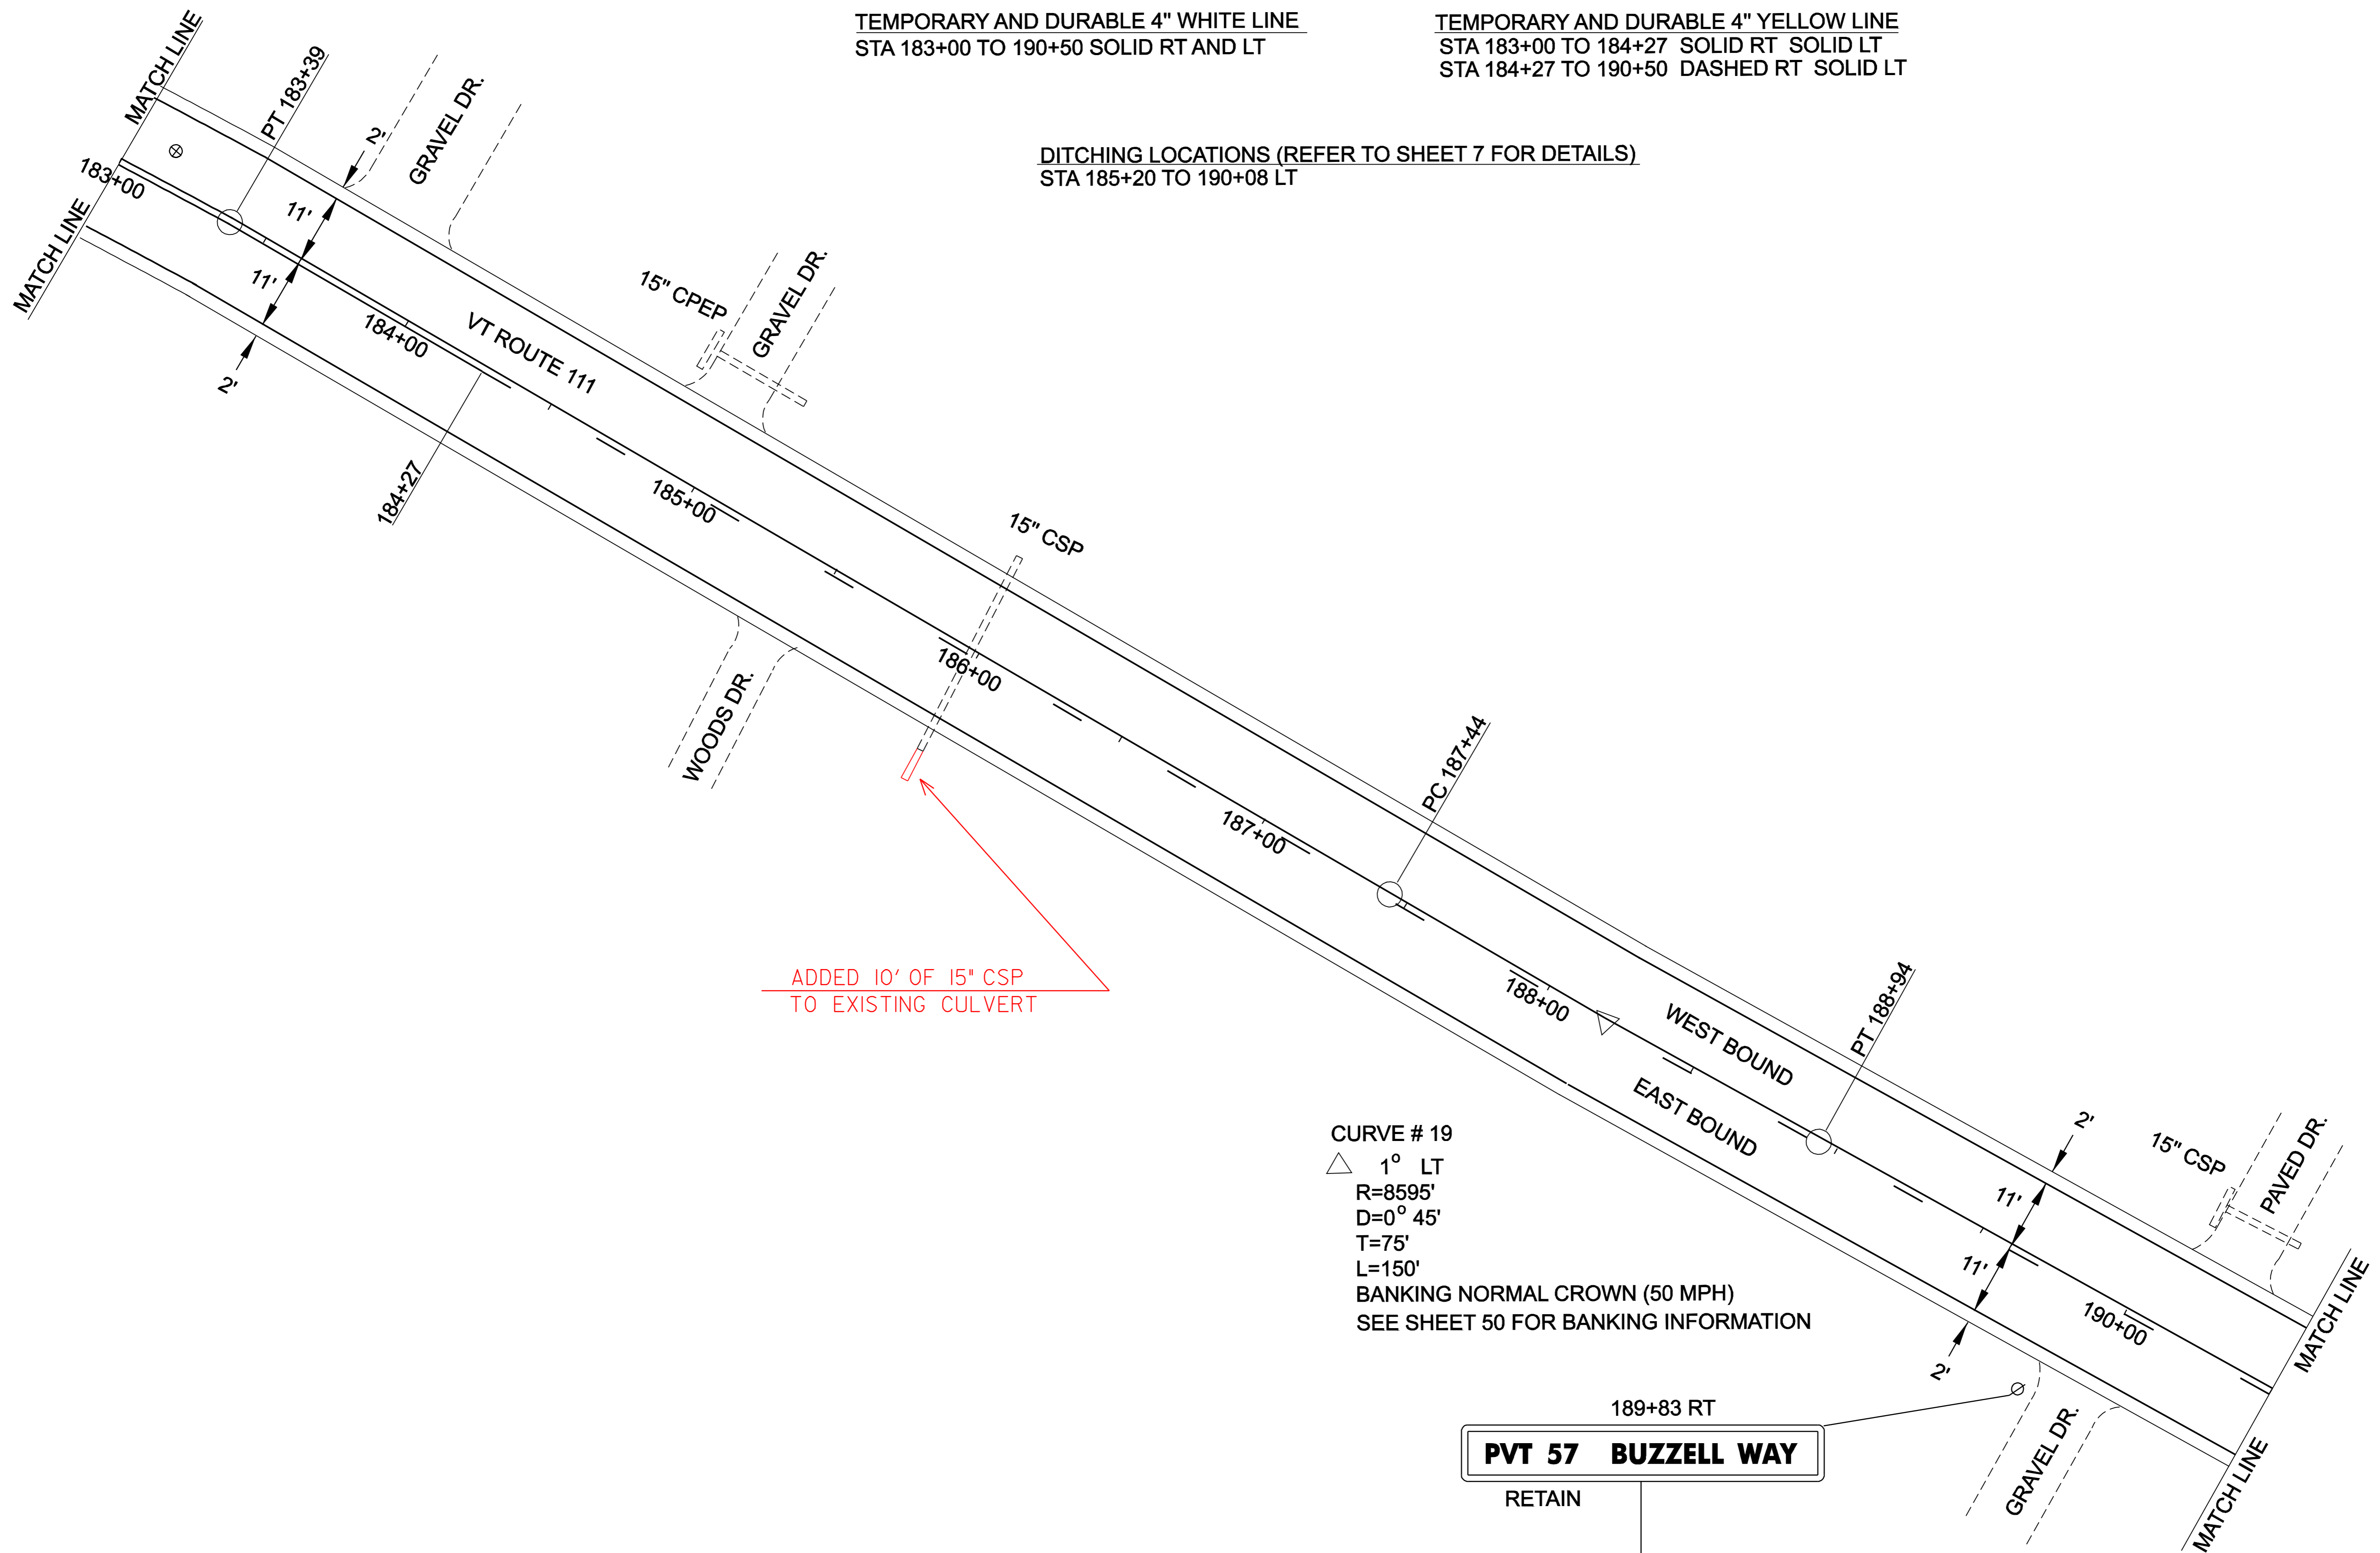

ADDED 10' OF 15" CSP  
 TO EXISTING CULVERT

CURVE # 19  
 △ 1° LT  
 R=8595'  
 D=0° 45'  
 T=75'  
 L=150'  
 BANKING NORMAL CROWN (50 MPH)  
 SEE SHEET 50 FOR BANKING INFORMATION

189+83 RT  
**PVT 57 BUZZELL WAY**  
 RETAIN  
 RETAIN

MORGAN VT. ROUTE 111 PAVEMENT CORE INFORMATION				
CORE #	STATION/POS.	DEPTH (in)	STRIPPED	DRAINABLE BASE
13	183+11 LT	5	NO	NO

PROJECT  
LAYOUT  
SHEET #19

DESIGNED BY LFW DATE 6/04  
 DRAWN BY LFW DATE 6/04  
 DESIGN FILE NO. pave/99cl92/99cl92.dgn  
 PRF FILE 99cl92p19.1 DATE 12-MAR-2007 11:3  
 PROJ. NAME **MORGAN**  
 PROJ. NO. **AC STP 2220(1)S**  
 SHEET **26** OF **61** SHEETS