


TEMPORARY AND DURABLE 4" WHITE LINE
STA 190+50 TO 197+00 SOLID RT AND LT

TEMPORARY AND DURABLE 4" YELLOW LINE
STA 190+50 TO 191+66 DASHED RT SOLID LT
STA 191+66 TO 192+19 SOLID RT SOLID LT
STA 192+19 TO 197+00 SOLID RT DASHED LT

DITCHING LOCATIONS (REFER TO SHEET 7 FOR DETAILS)
STA 192+15 TO 194+88 LT
STA 196+58 TO 197+00 LT

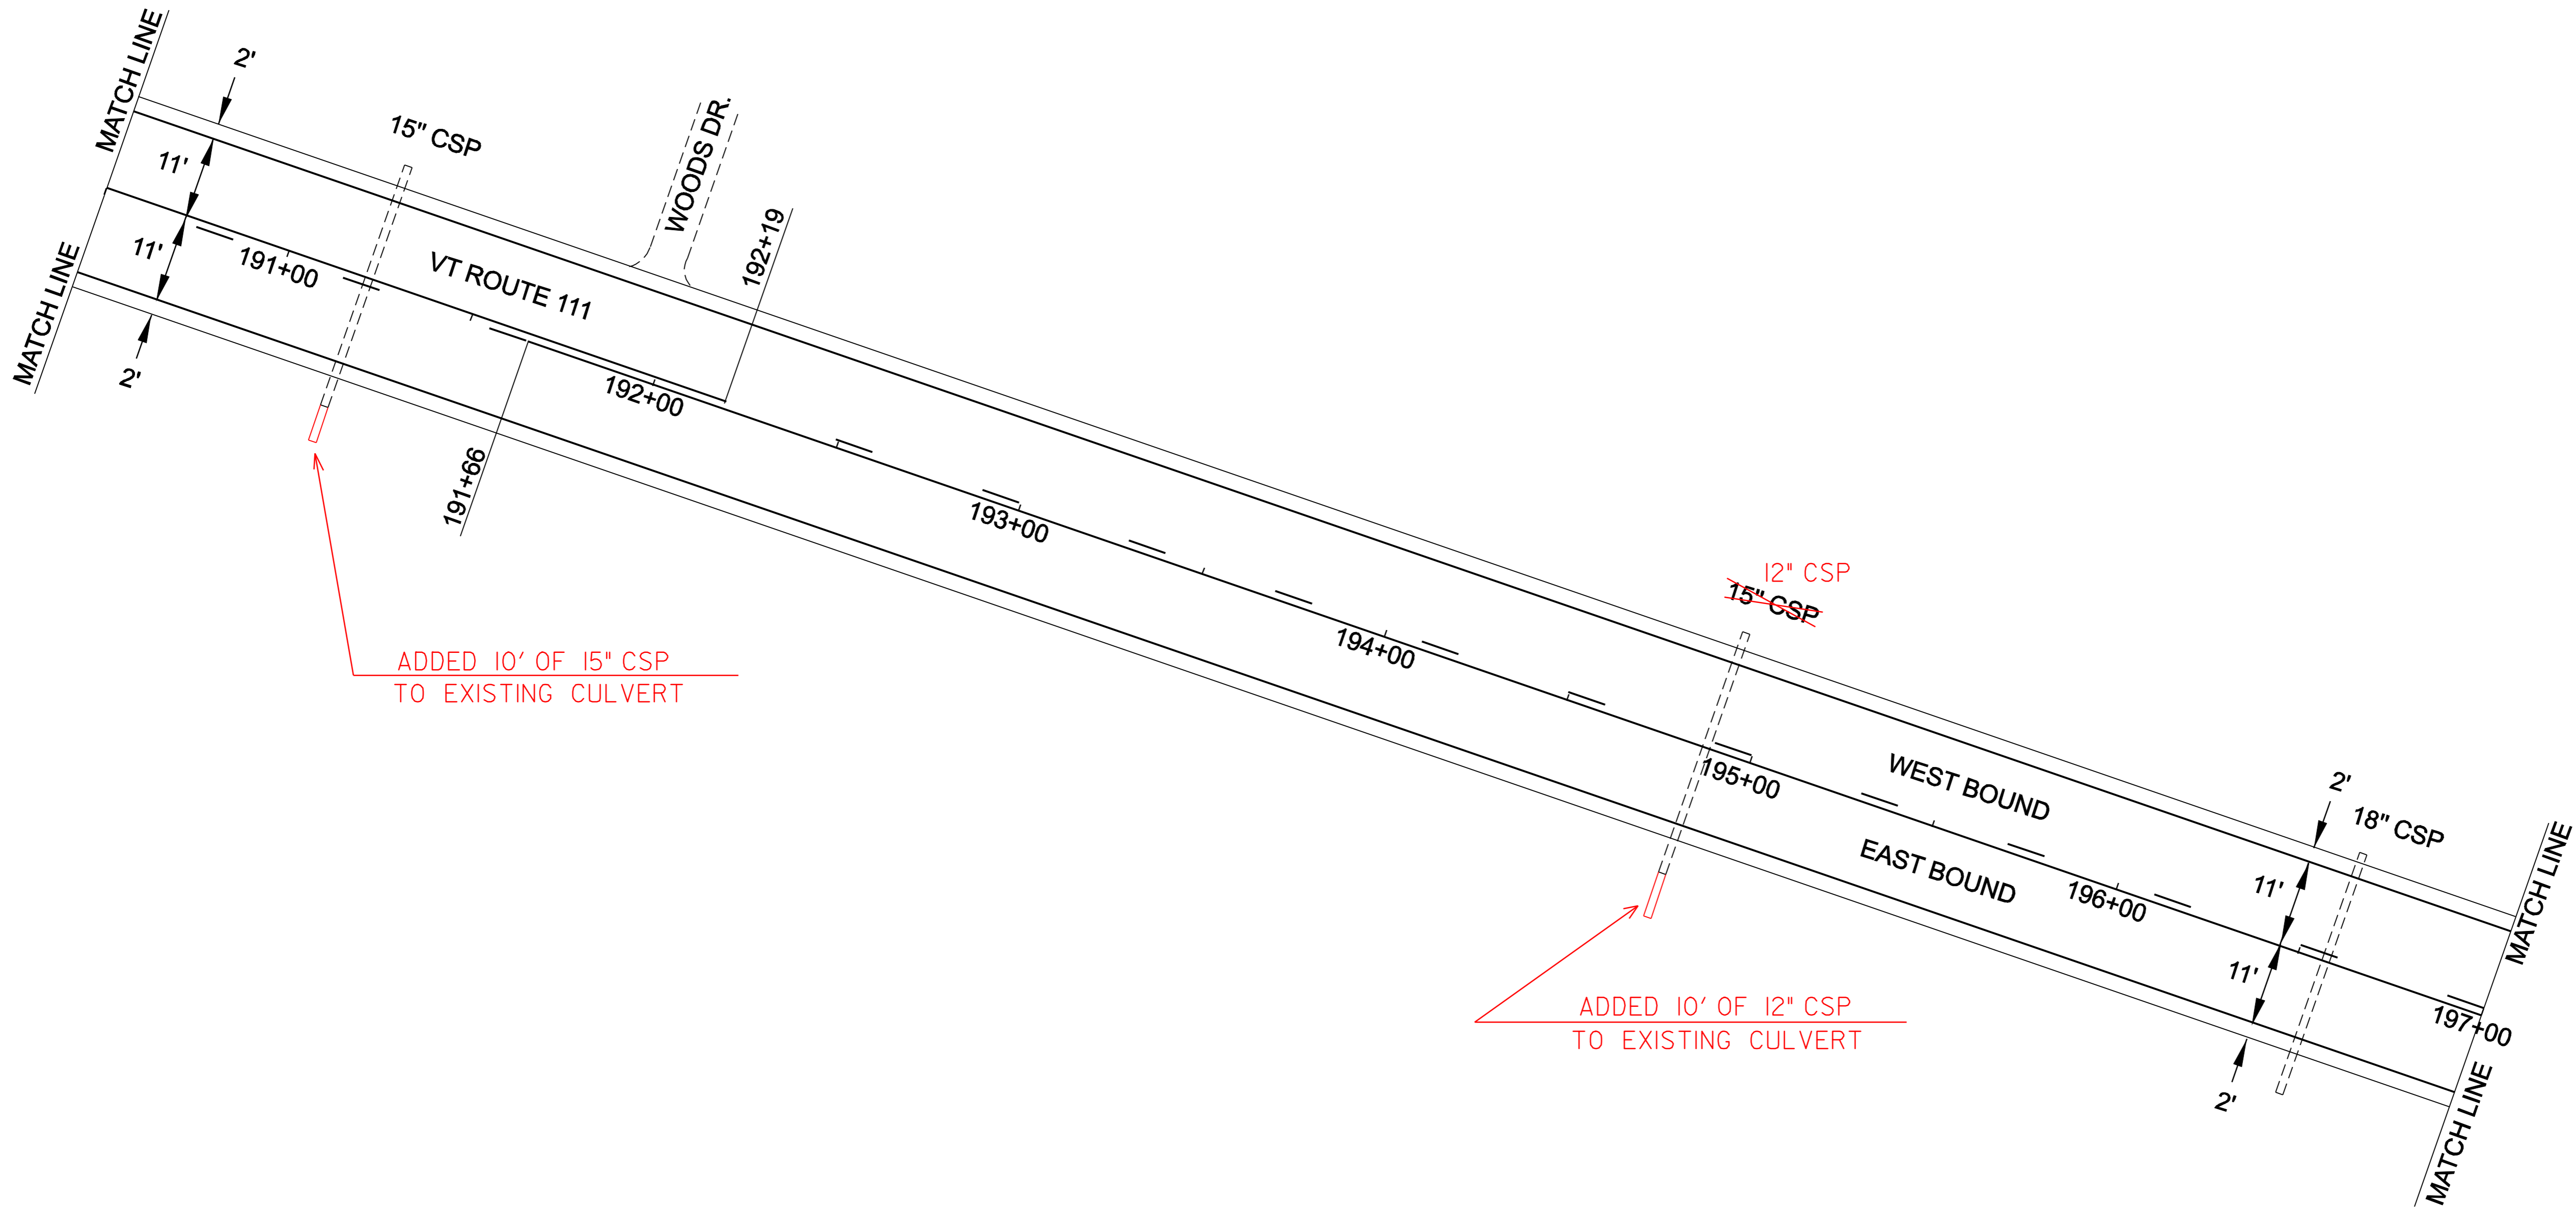

PROJECT LAYOUT SHEET #20	DESIGNED BY	LFW	DATE	6/04
	DRAWN BY	LFW	DATE	6/04
	DESIGN FILE NO.	pave/99cl92/99cl92.dgn		
	PRF FILE	99cl92p20.1	DATE PLOTTED	12-MAR-2007 11:3
	PROJ. NAME	MORGAN		
PROJ. NO.	AC STP 2220(1)S			
SHEET	27	OF	61	SHEETS