

TEMPORARY AND DURABLE 4" WHITE LINE  
STA 213+00 TO 221+50 SOLID RT AND LT

TEMPORARY AND DURABLE 4" YELLOW LINE  
STA 213+00 TO 221+50 SOLID RT SOLID LT

REMOVING SIGNS  
AS SHOWN - 1

DITCHING LOCATIONS (REFER TO SHEET 7 FOR DETAILS)  
STA 213+00 TO 213+50 LT

~~REMOVE AND RESET GUARDRAIL  
STA 218+25.0 TO 221+50.0 RT (325')~~

REMOVAL AND DISPOSAL OF GUIDE POSTS  
STA 213+00 TO 214+08 RT (7)

~~STEEL BEAM GUARDRAIL W/8 FOOT POSTS  
STA 213+01.5 TO 213+76.5 RT (75')~~

~~MANUFACTURED TERMINAL SECTION (FLARED)  
STA 213+76.5 TO 214+14.0 RT~~

STA 213+00 TO 214+08 RT (7)  
REMOVAL AND DISPOSAL OF  
GUIDE POSTS



~~213+0 ~ 214+03.5 RT  
STA 213+01.5 TO 213+76.5 RT (75')~~  
STEEL BEAM GUARDRAIL  
WITH 8' POSTS

~~214+03.5 ~ 214+14 RT  
STA 213+76.5 TO 214+14.0 RT~~  
NEW MANUFACTURED TERMINAL  
SECTION (FLARED)

BR - 6  
MM 4.091 =  
STA. 215+99  
FIELD MEASURED STA. 215+94)  
RECLAIM AND PAVE

ANCHOR FOR STEEL BEAM GUARDRAIL  
218+60 RT  
219+10 RT

218+50  
STA 218+25.0 TO 221+50.0 RT (325')  
REMOVE AND RESET GUARDRAIL

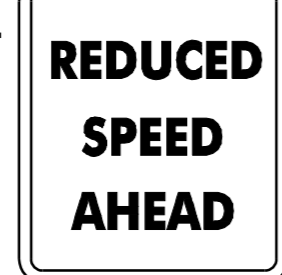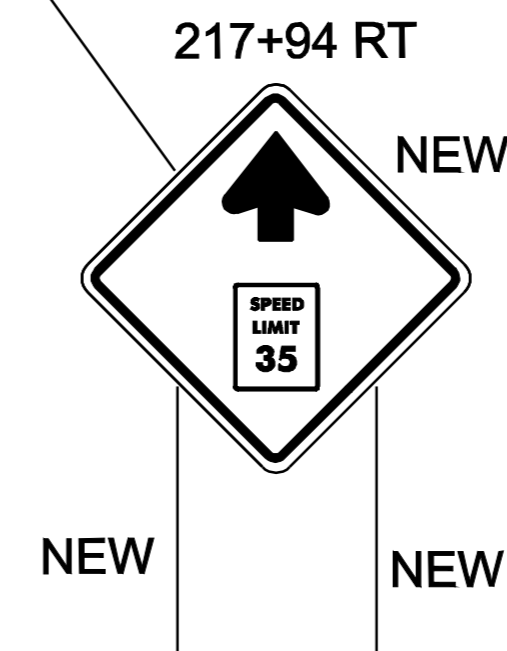

MORGAN VT. ROUTE 111 PAVEMENT CORE INFORMATION				
CORE #	STATION/POS.	DEPTH (in)	STRIPPED	DRAINABLE BASE
15	220+55 LT	2	NO	NO

PROJECT  
LAYOUT  
SHEET #23

DESIGNED BY LFW DATE 6/04  
DRAWN BY LFW DATE 6/04  
DESIGN FILE NO. pave/99cl92/99cl92.dgn  
PRF FILE 99cl92p23.1 DATE 12-MAR-2007 11:3  
PROJ. NAME MORGAN  
PROJ. NO. AC STP 2220(1)S  
SHEET 30 OF 61 SHEETS

