



TEMPORARY AND DURABLE 4" WHITE LINE  
 STA 221+50 TO 230+50 SOLID RT AND LT  
 (WITH EDGELINE BREAK FOR TOWN HIGHWAY)

TEMPORARY AND DURABLE 4" YELLOW LINE  
 STA 221+50 TO 230+50 SOLID RT SOLID LT  
 (WITH 40' BREAK FOR CENTERLINE)

REMOVING SIGNS  
 AS SHOWN - 3

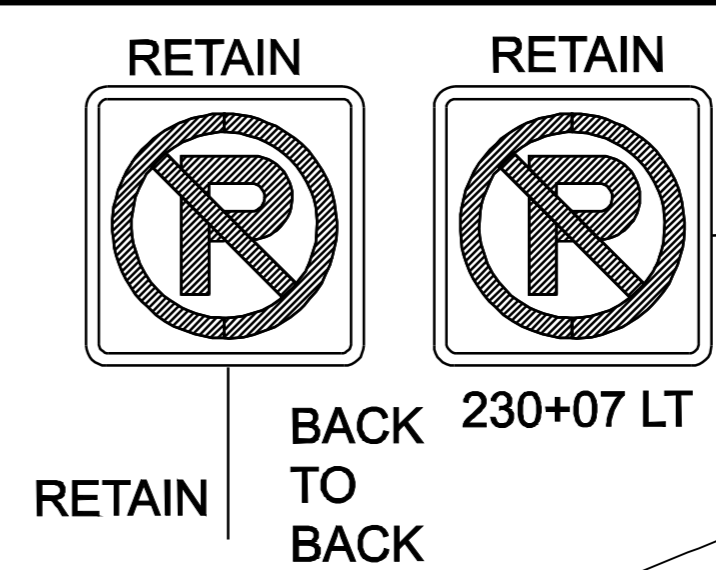



CURVE # 22  
 Δ 45° RT  
 R=1388'  
 D=4° 08'  
 T=575'  
 L=1090'  
 BANKING 0.064 FT/FT  
 160' RUNOFF (50MPH)  
 SEE SHEET 51 FOR  
 BANKING DETAIL

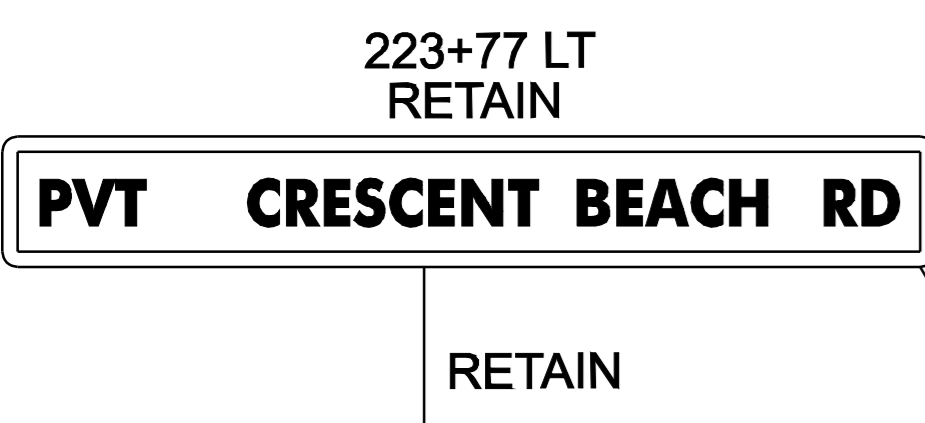










222+62.5 RT  
 STA 221+50.0 TO 222+74.0 RT (125')  
 REMOVE AND RESET GUARDRAIL

STA 222+74.0 TO 223+12.0 RT (38')  
 REMOVAL AND DISPOSAL OF  
 GUARDRAIL

222+62.5 ~ 223+0 RT  
 STA 222+74.0 TO 223+12.0 RT  
 NEW MANUFACTURED TERMINAL  
 SECTION (FLARED)

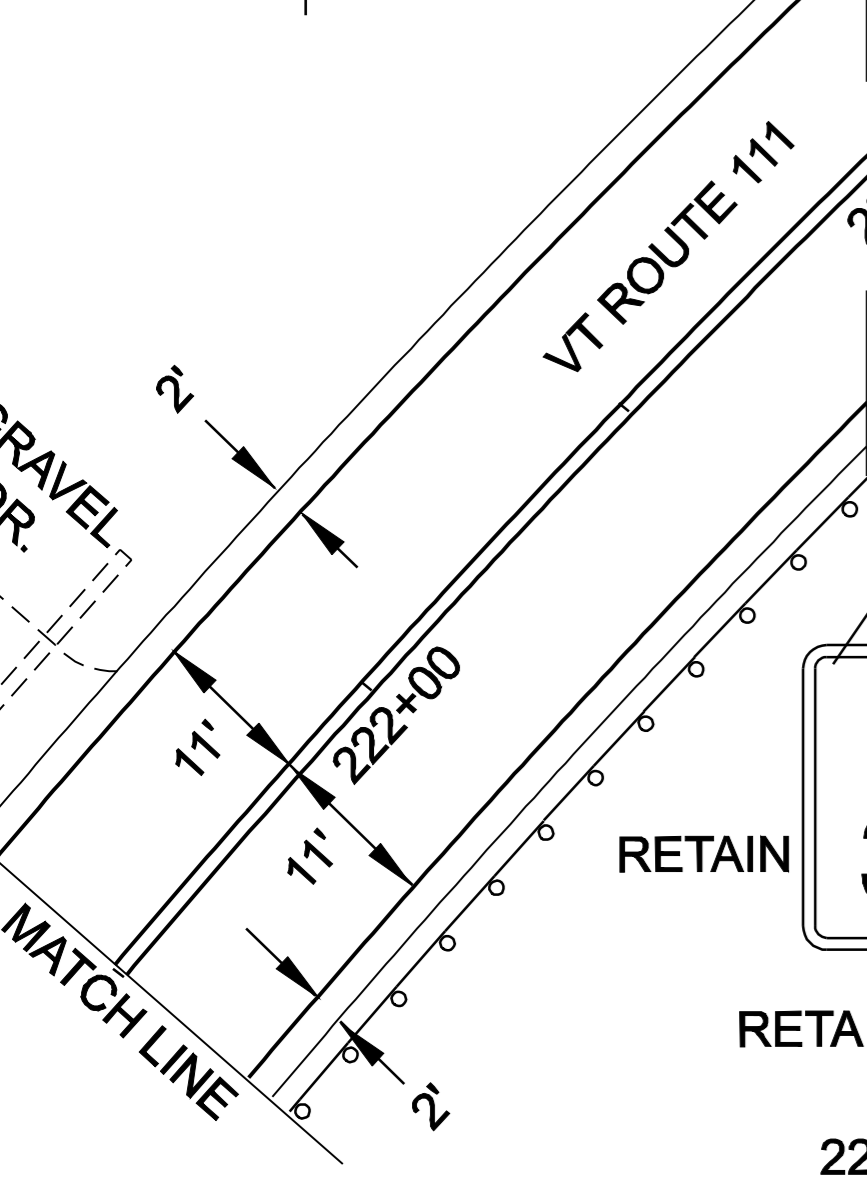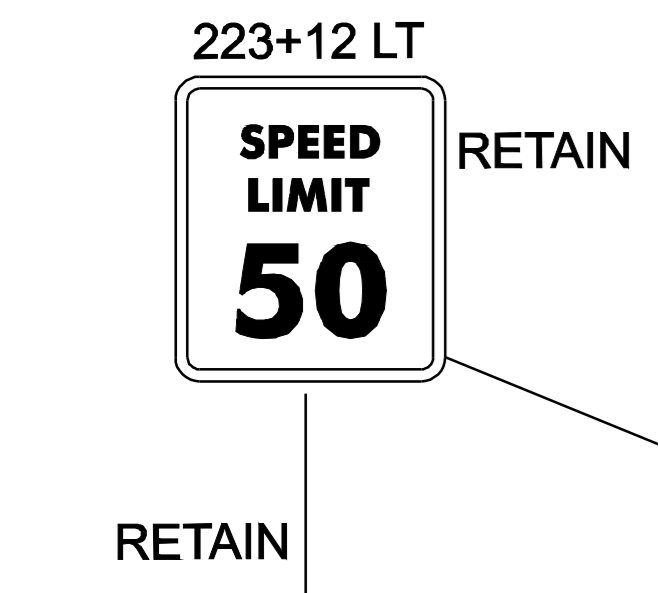

TH - 27  
 MM 4.237 =  
 STA. 223+70  
 (FIELD MEASURED  
 STA. 223+70)

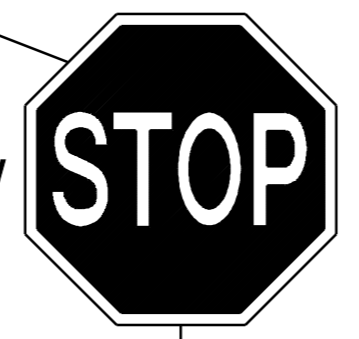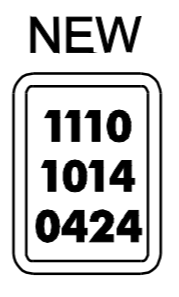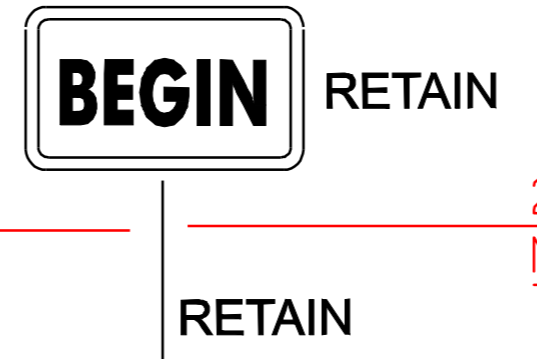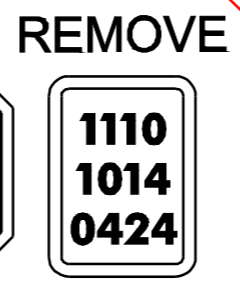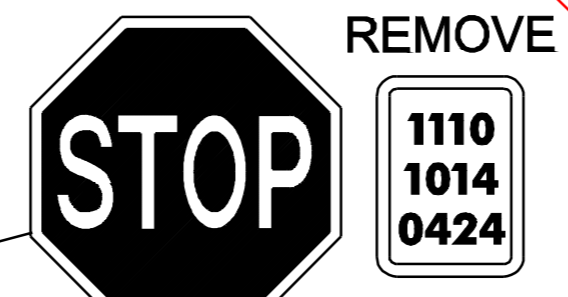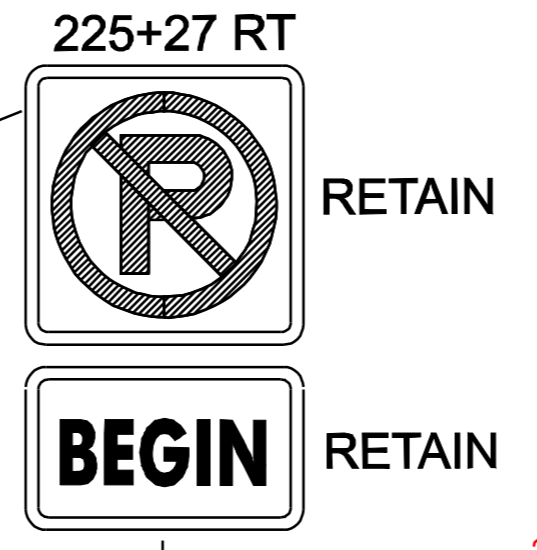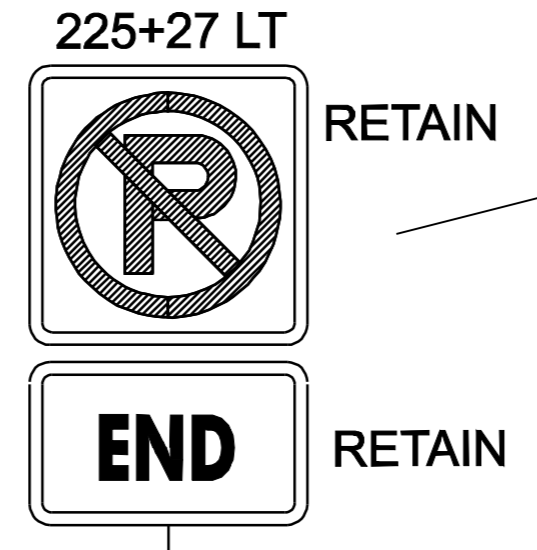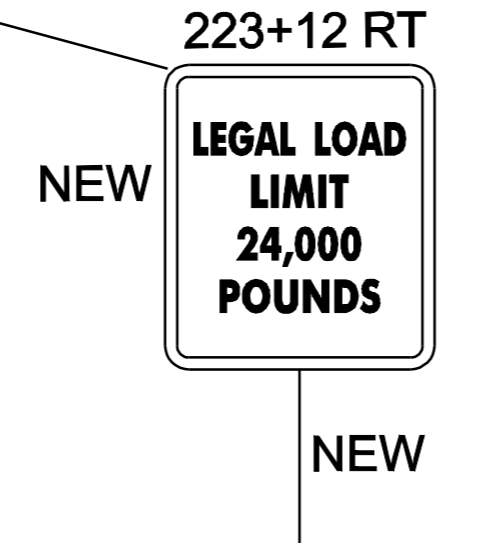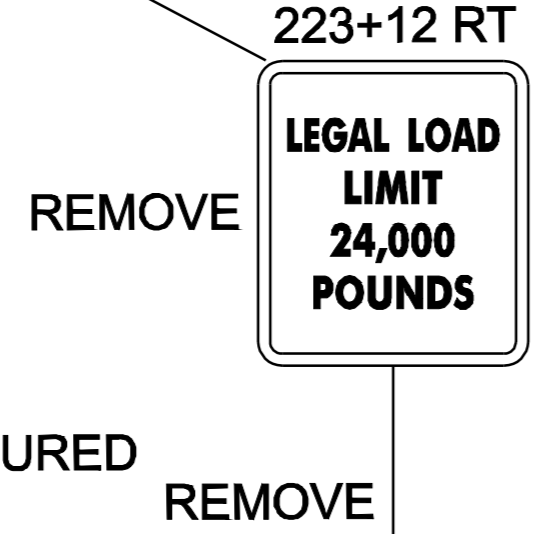

223+55 ~ 224+17 RT  
 STA 223+35.0 TO 223+92.0 RT (87.5')  
 REMOVE AND RESET GUARDRAIL  
 ANCHOR @ 223+60 RT  
 ANCHOR @ 224+07 RT

225+11.5 ~ 225+49 RT  
 NEW MANUFACTURED  
 TERMINAL SECTION (FLARED)

224+24 ~ 225+11.5 RT  
 STA 223+99.0 TO 225+24.0 RT (125')  
 REMOVE AND RESET GUARDRAIL  
 ANCHOR @ 224+34 RT

ADDED CENTERLINE,  
 EDGE LINE; STOP &  
 STOP BAR AS SHOWN

MORGAN VT. ROUTE 111 PAVEMENT CORE INFORMATION				
CORE #	STATION/POS.	DEPTH (in)	STRIPPED	DRAINABLE BASE
16	223+40 RT	7	NO	NO

DITCHING LOCATIONS (REFER TO SHEET 7 FOR DETAILS)  
 STA 221+94 TO 223+70 LT

~~REMOVE AND RESET GUARDRAIL  
 STA 221+50.0 TO 222+74.0 RT (125')  
 STA 223+35.0 TO 223+92.0 RT (87.5')  
 STA 223+99.0 TO 225+24.0 RT (125')~~

REMOVAL AND DISPOSAL OF GUARDRAIL  
 STA 222+74.0 TO 223+12.0 RT (38')

~~MANUFACTURED TERMINAL SECTION (FLARED)  
 STA 222+74.0 TO 223+12.0 RT~~

PROJECT LAYOUT  
SHEET #24

DESIGNED BY LFW DATE 6/04  
 DRAWN BY LFW DATE 6/04  
 DESIGN FILE NO. pave/99cl92/99cl92.dgn  
 PRF FILE 99cl92p24.1 DATE PLOTTED 12-MAR-2007 11:33  
 PROJ. NAME MORGAN  
 PROJ. NO. AC STP 2220(1)S  
 SHEET 31 OF 61 SHEETS