


TEMPORARY AND DURABLE 4" WHITE LINE  
STA 230+50 TO 238+00 SOLID RT AND LT

TEMPORARY AND DURABLE 4" YELLOW LINE  
STA 230+50 TO 238+00 SOLID RT SOLID LT

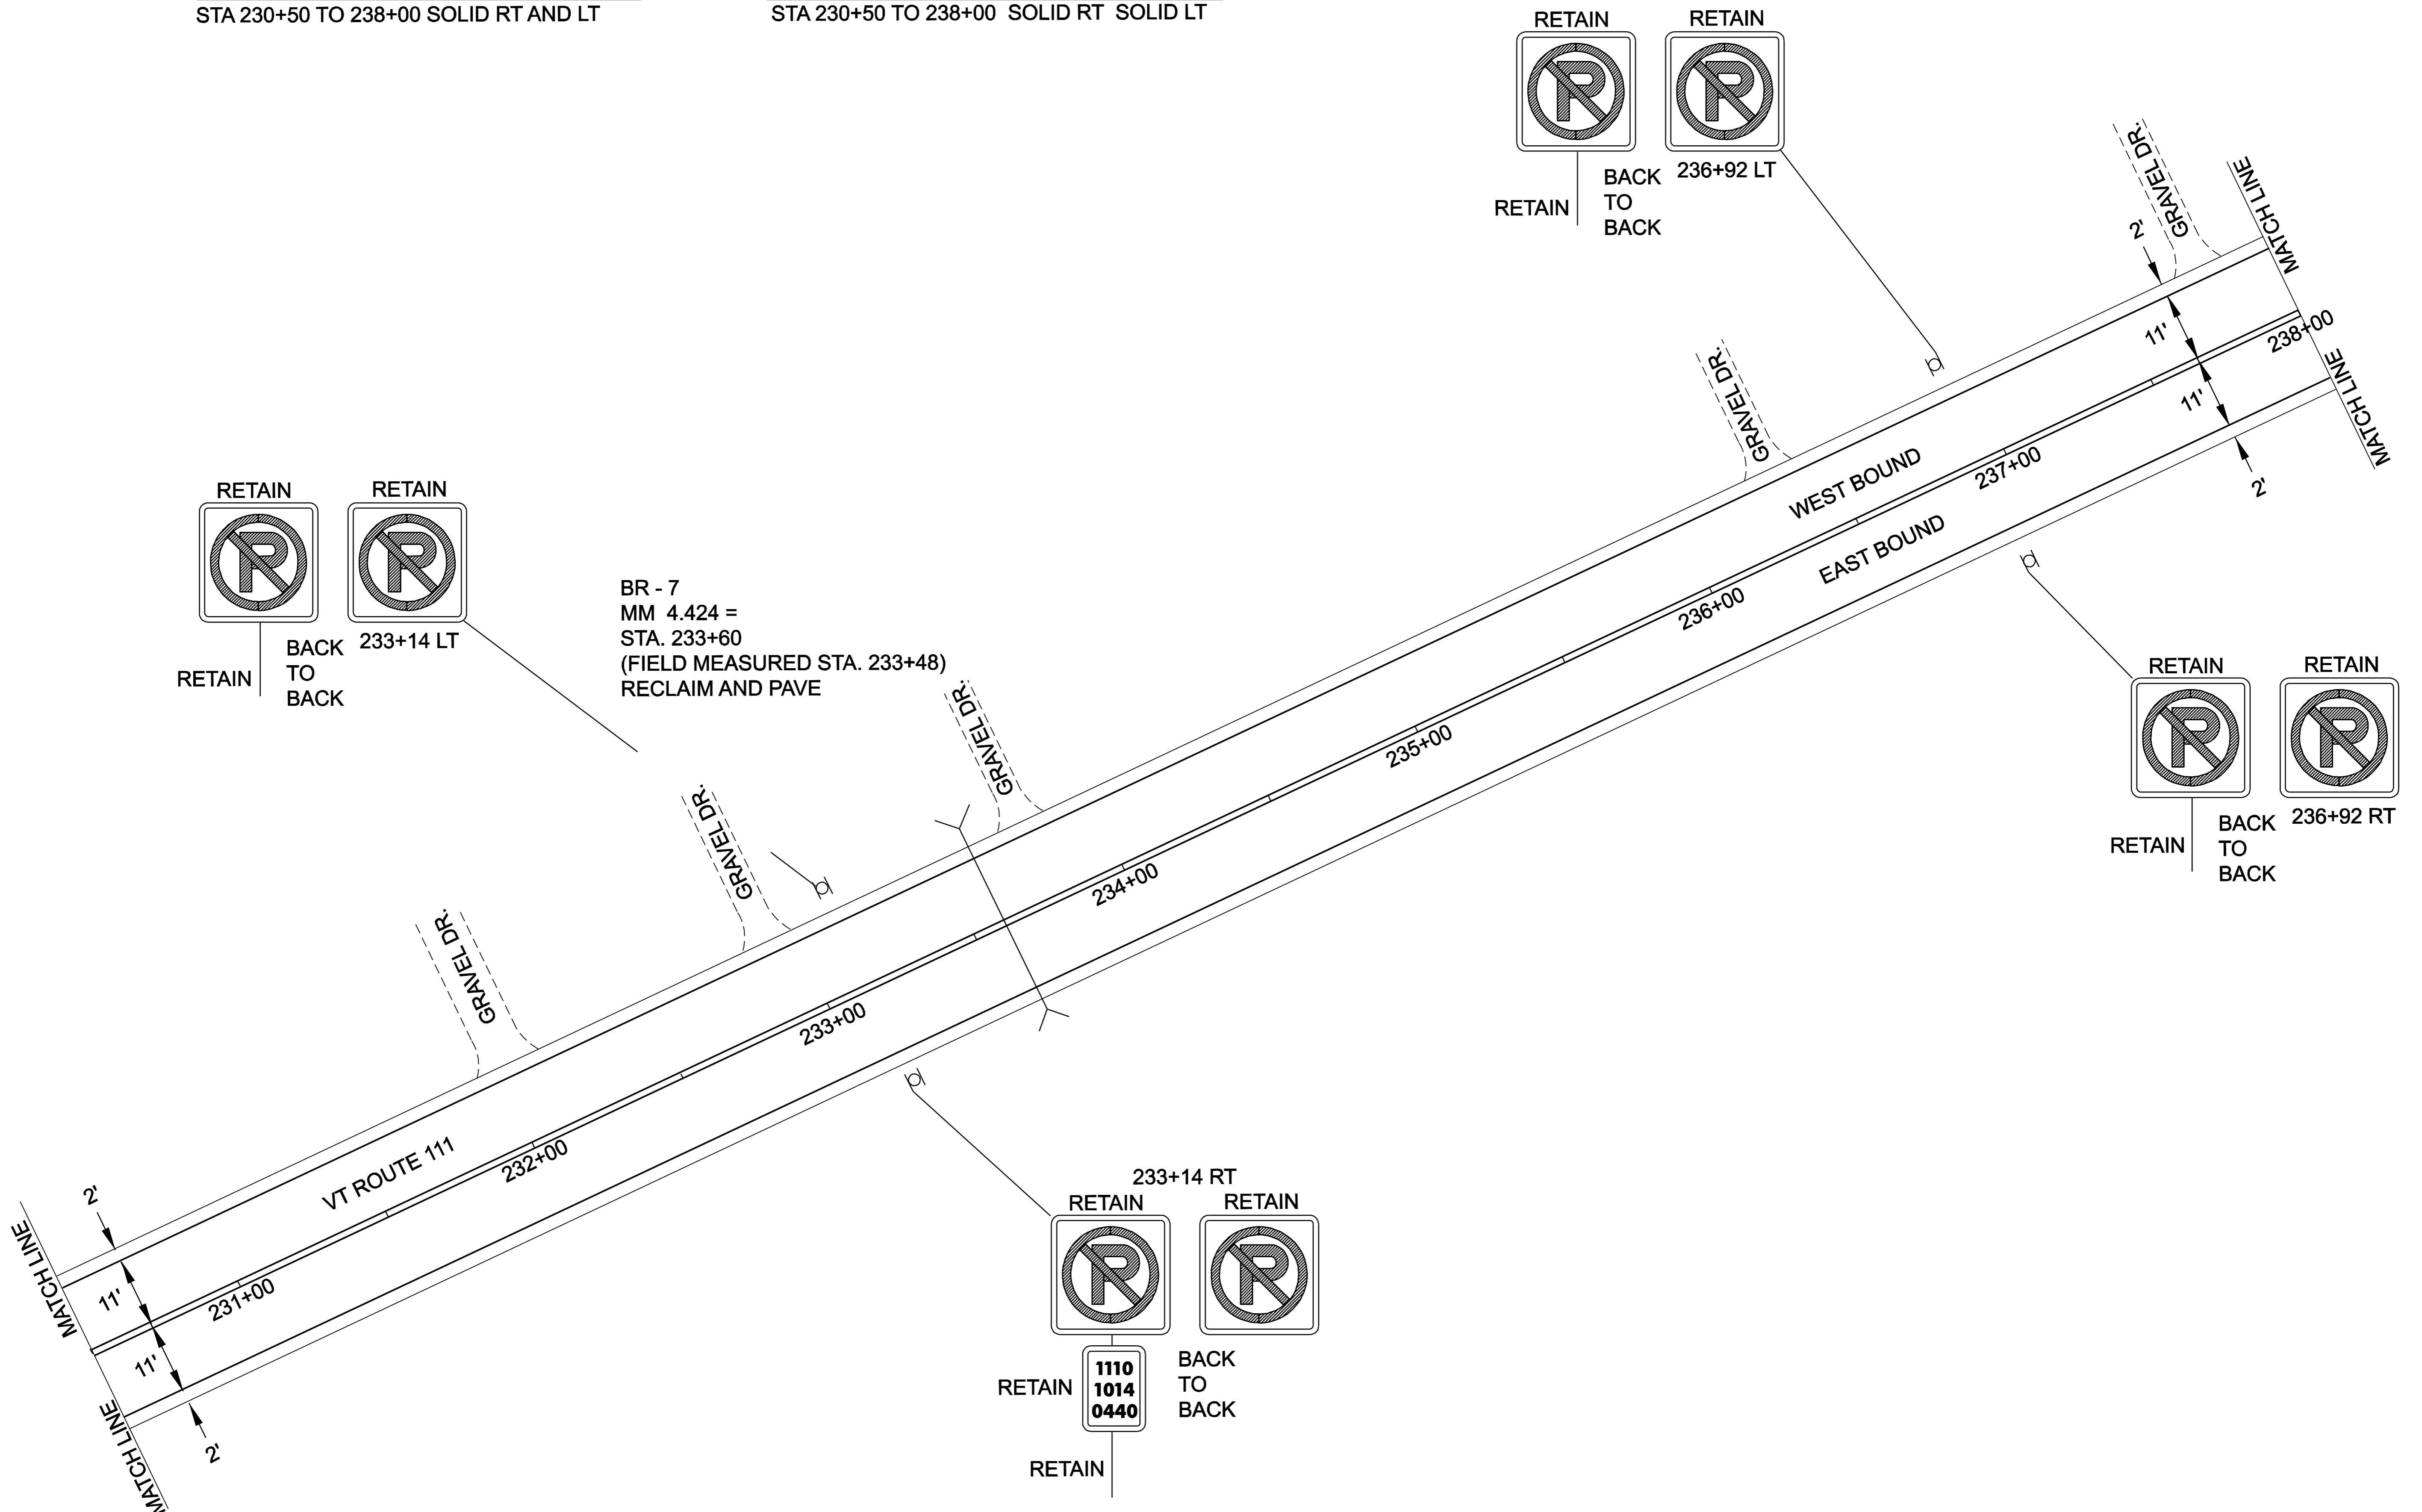

RETAIN  
RETAIN  
RETAIN  
BACK TO BACK  
233+14 LT

BR - 7  
MM 4.424 =  
STA. 233+60  
(FIELD MEASURED STA. 233+48)  
RECLAIM AND PAVE

RETAIN  
RETAIN  
RETAIN  
BACK TO BACK  
236+92 LT

RETAIN  
RETAIN  
RETAIN  
BACK TO BACK  
236+92 RT

233+14 RT  
RETAIN  
RETAIN  
RETAIN  
1110  
1014  
0440  
BACK TO BACK

PROJECT LAYOUT SHEET #25	DESIGNED BY	LFW	DATE	6/04
	DRAWN BY	LFW	DATE	6/04
	DESIGN FILE NO.	pave/99cl92/99cl92.dgn		
	PRF FILE	99cl92p25.1	DATE PLOTTED	12-MAR-2007 11:3
	PROJ. NAME	MORGAN		
PROJ. NO.	AC STP 2220(1)S			
SHEET	32	OF	61	SHEETS