

TEMPORARY AND DURABLE 4" WHITE LINE
STA 244+50 TO 252+00 SOLID RT AND LT

TEMPORARY AND DURABLE 4" YELLOW LINE
STA 244+50 TO 252+00 SOLID RT SOLID LT


ADJUST ELEVATION OF VALVE BOX
STA 245+77 RT (MONITORING WELL)

STA 250+62.0 TO 250+87.0 LT (25') AND
STA 251+37.0 TO 251+62.0 LT (25')
REMOVAL AND DISPOSAL OF GUARDRAIL

STA 250+62.0 TO 250+87.0 LT (25')
HEAVY DUTY STEEL BEAM GUARDRAIL
WITH ANCHOR AT 250+62.0 LT

STA 250+87.0 TO 251+37.0 LT (50')
BRIDGE RAIL - HEAVY DUTY STEEL
BEAM - FASCIA MOUNTED (MOD. 1)

STA 251+37.0 TO 251+62.0 LT (25')
HEAVY DUTY STEEL BEAM GUARDRAIL
WITH ANCHOR AT 250+62.0 LT

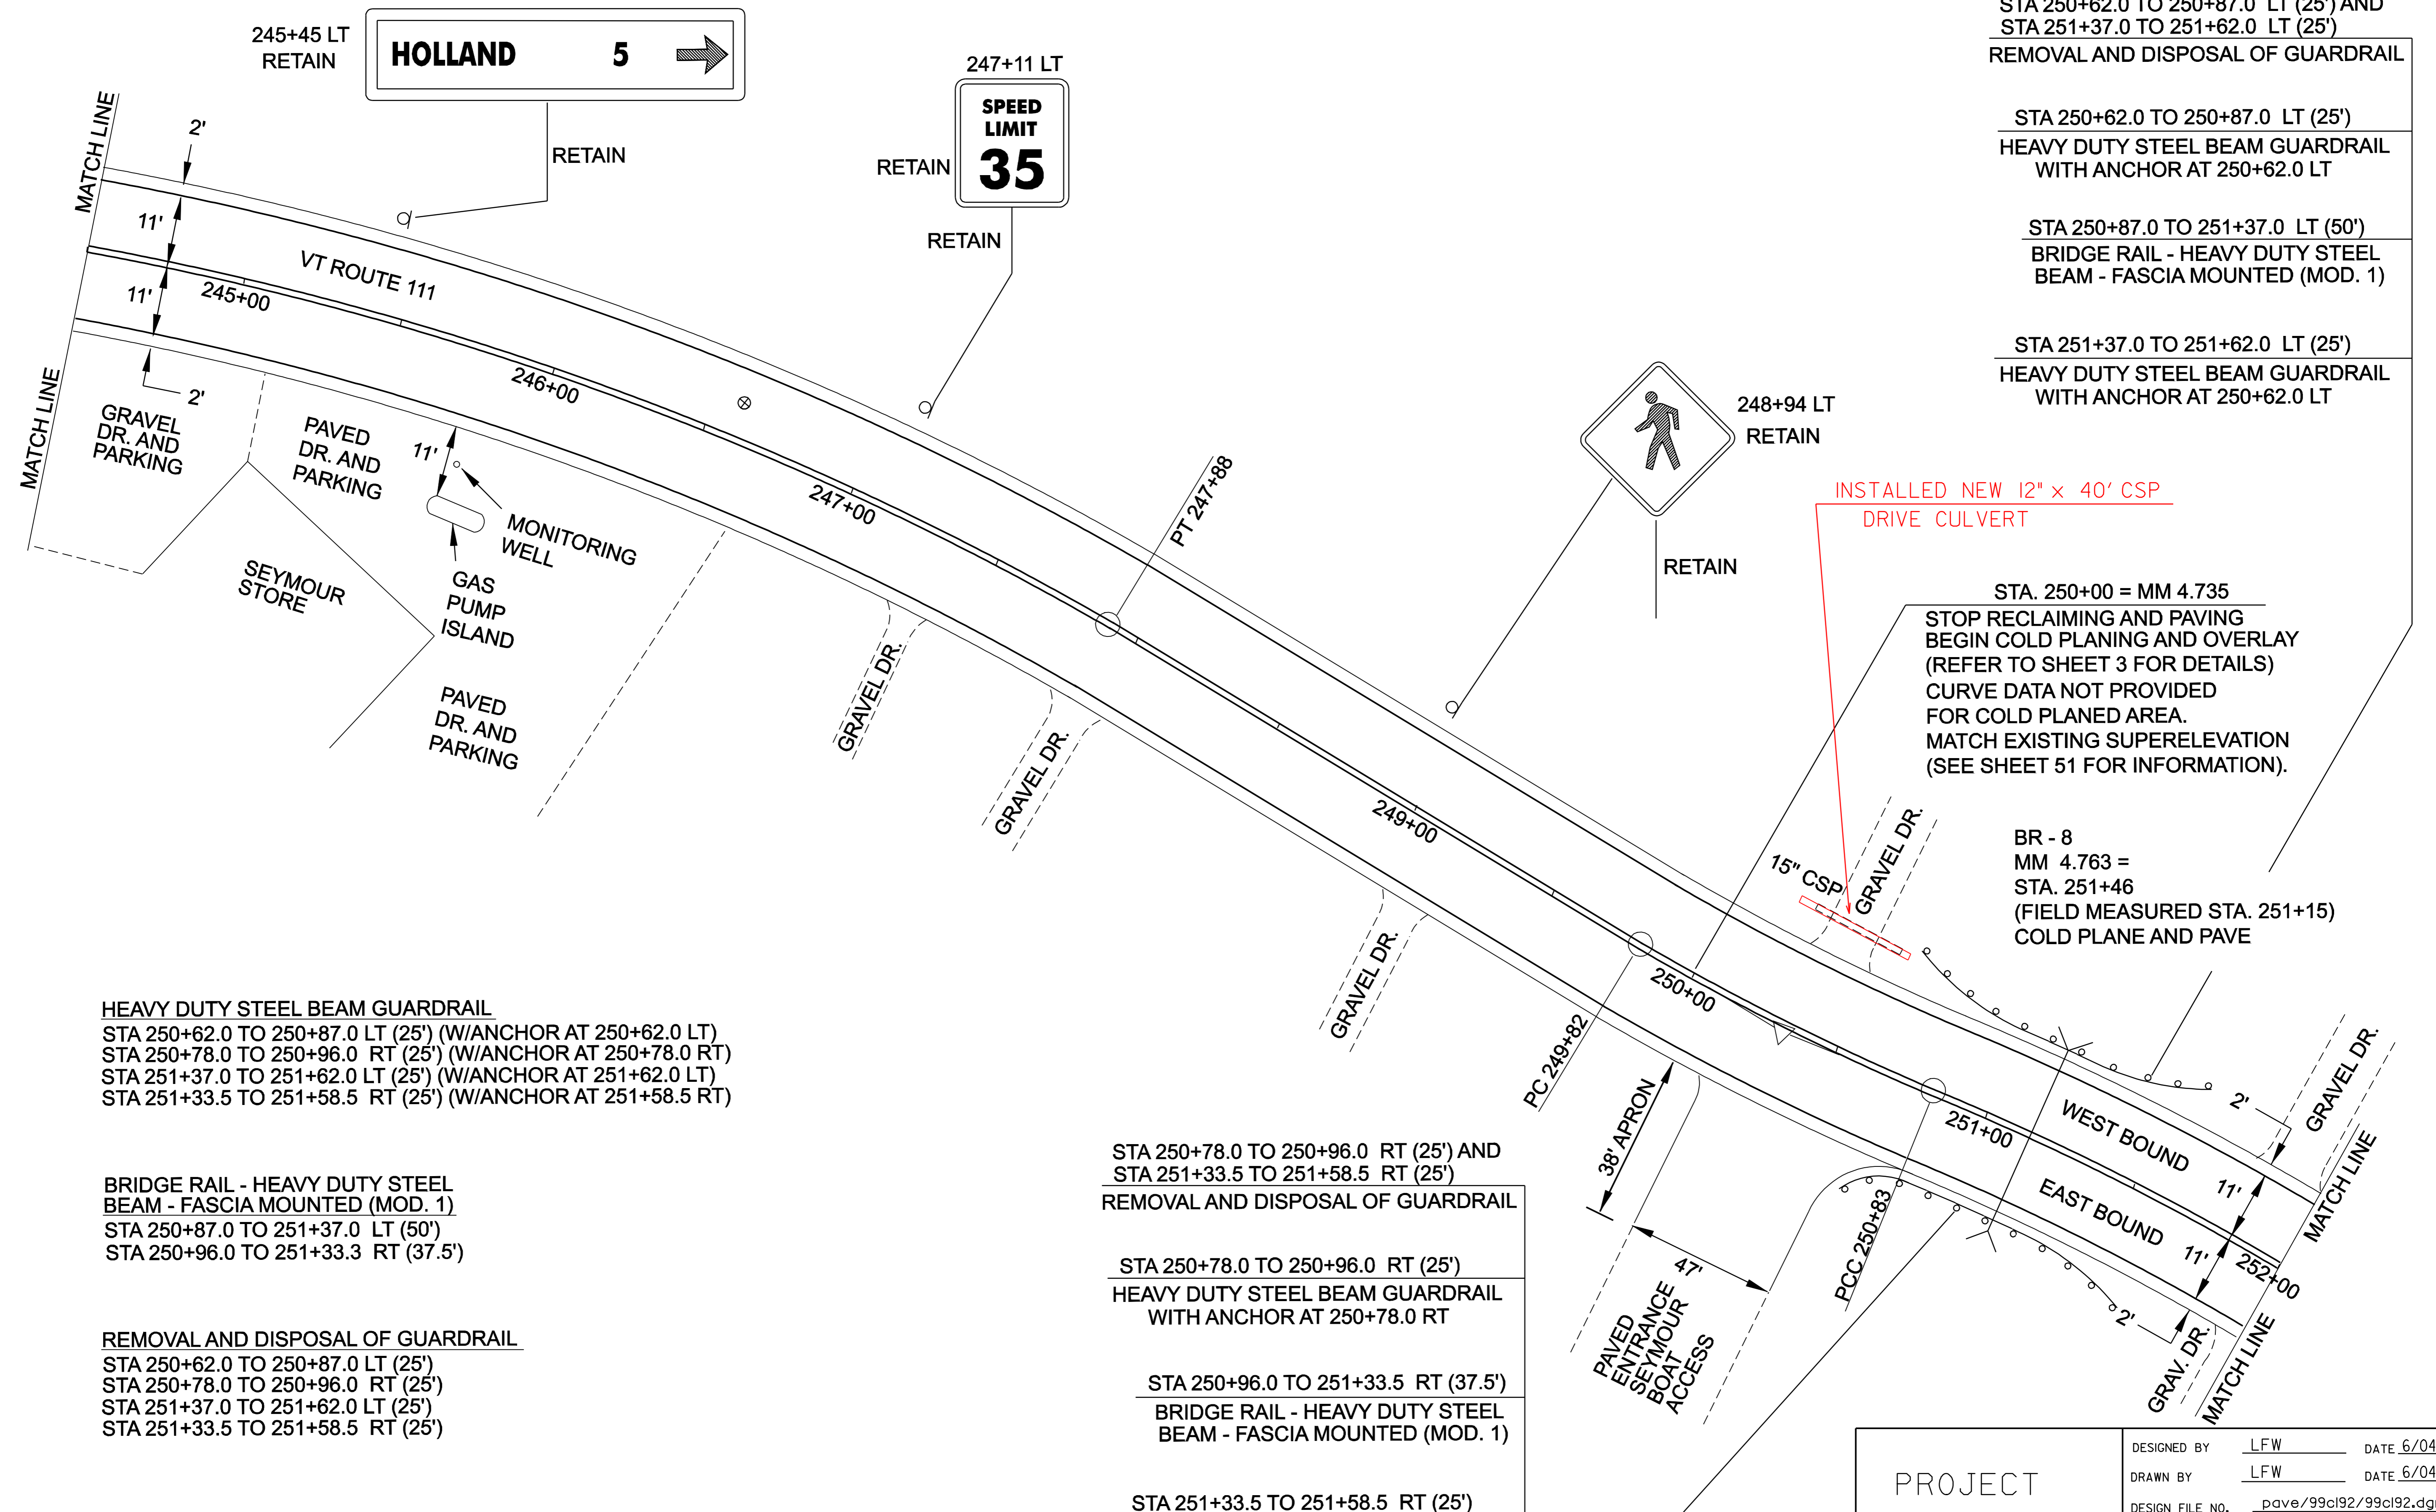

INSTALLED NEW 12" x 40' CSP
DRIVE CULVERT

STA. 250+00 = MM 4.735
STOP RECLAIMING AND PAVING
BEGIN COLD PLANING AND OVERLAY
(REFER TO SHEET 3 FOR DETAILS)
CURVE DATA NOT PROVIDED
FOR COLD PLANED AREA.
MATCH EXISTING SUPERELEVATION
(SEE SHEET 51 FOR INFORMATION).

BR - 8
MM 4.763 =
STA. 251+46
(FIELD MEASURED STA. 251+15)
COLD PLANE AND PAVE

HEAVY DUTY STEEL BEAM GUARDRAIL
STA 250+62.0 TO 250+87.0 LT (25') (W/ANCHOR AT 250+62.0 LT)
STA 250+78.0 TO 250+96.0 RT (25') (W/ANCHOR AT 250+78.0 RT)
STA 251+37.0 TO 251+62.0 LT (25') (W/ANCHOR AT 251+62.0 LT)
STA 251+33.5 TO 251+58.5 RT (25') (W/ANCHOR AT 251+58.5 RT)

BRIDGE RAIL - HEAVY DUTY STEEL
BEAM - FASCIA MOUNTED (MOD. 1)
STA 250+87.0 TO 251+37.0 LT (50')
STA 250+96.0 TO 251+33.3 RT (37.5')

REMOVAL AND DISPOSAL OF GUARDRAIL
STA 250+62.0 TO 250+87.0 LT (25')
STA 250+78.0 TO 250+96.0 RT (25')
STA 251+37.0 TO 251+62.0 LT (25')
STA 251+33.5 TO 251+58.5 RT (25')

STA 250+78.0 TO 250+96.0 RT (25') AND
STA 251+33.5 TO 251+58.5 RT (25')
REMOVAL AND DISPOSAL OF GUARDRAIL

STA 250+78.0 TO 250+96.0 RT (25')
HEAVY DUTY STEEL BEAM GUARDRAIL
WITH ANCHOR AT 250+78.0 RT

STA 250+96.0 TO 251+33.5 RT (37.5')
BRIDGE RAIL - HEAVY DUTY STEEL
BEAM - FASCIA MOUNTED (MOD. 1)

STA 251+33.5 TO 251+58.5 RT (25')
HEAVY DUTY STEEL BEAM GUARDRAIL
WITH ANCHOR AT 251+58.5 RT

MORGAN VT. ROUTE 111 PAVEMENT CORE INFORMATION				
CORE #	STATION/POS.	DEPTH (in)	STRIPPED	DRAINABLE BASE
18	246+58 LT	3 1/2	NO	NO

PROJECT
LAYOUT
SHEET #27

DESIGNED BY LFW DATE 6/04
DRAWN BY LFW DATE 6/04
DESIGN FILE NO. pave/99cl92/99cl92.dgn
PRF FILE 99cl92p27.1 DATE PLOTTED 12-MAR-2007 11:3
PROJ. NAME MORGAN
PROJ. NO. AC STP 2220(1)S
SHEET 34 OF 61 SHEETS