


DITCHING LOCATIONS (REFER TO SHEET 7 FOR DETAILS)
 STA 282+00 TO 283+40 LT
 STA 283+64 TO 289+50 LT

TEMPORARY AND DURABLE 4" WHITE LINE
 STA 282+00 TO 289+50 SOLID RT AND LT

TEMPORARY AND DURABLE 4" YELLOW LINE
 STA 282+00 TO 289+50 SOLID RT SOLID LT

REHABILITATION
 CHANGE ELEVATION OF DROP INLET, CATCH BASIN OR MANHOLE
 STA 287+57 LT

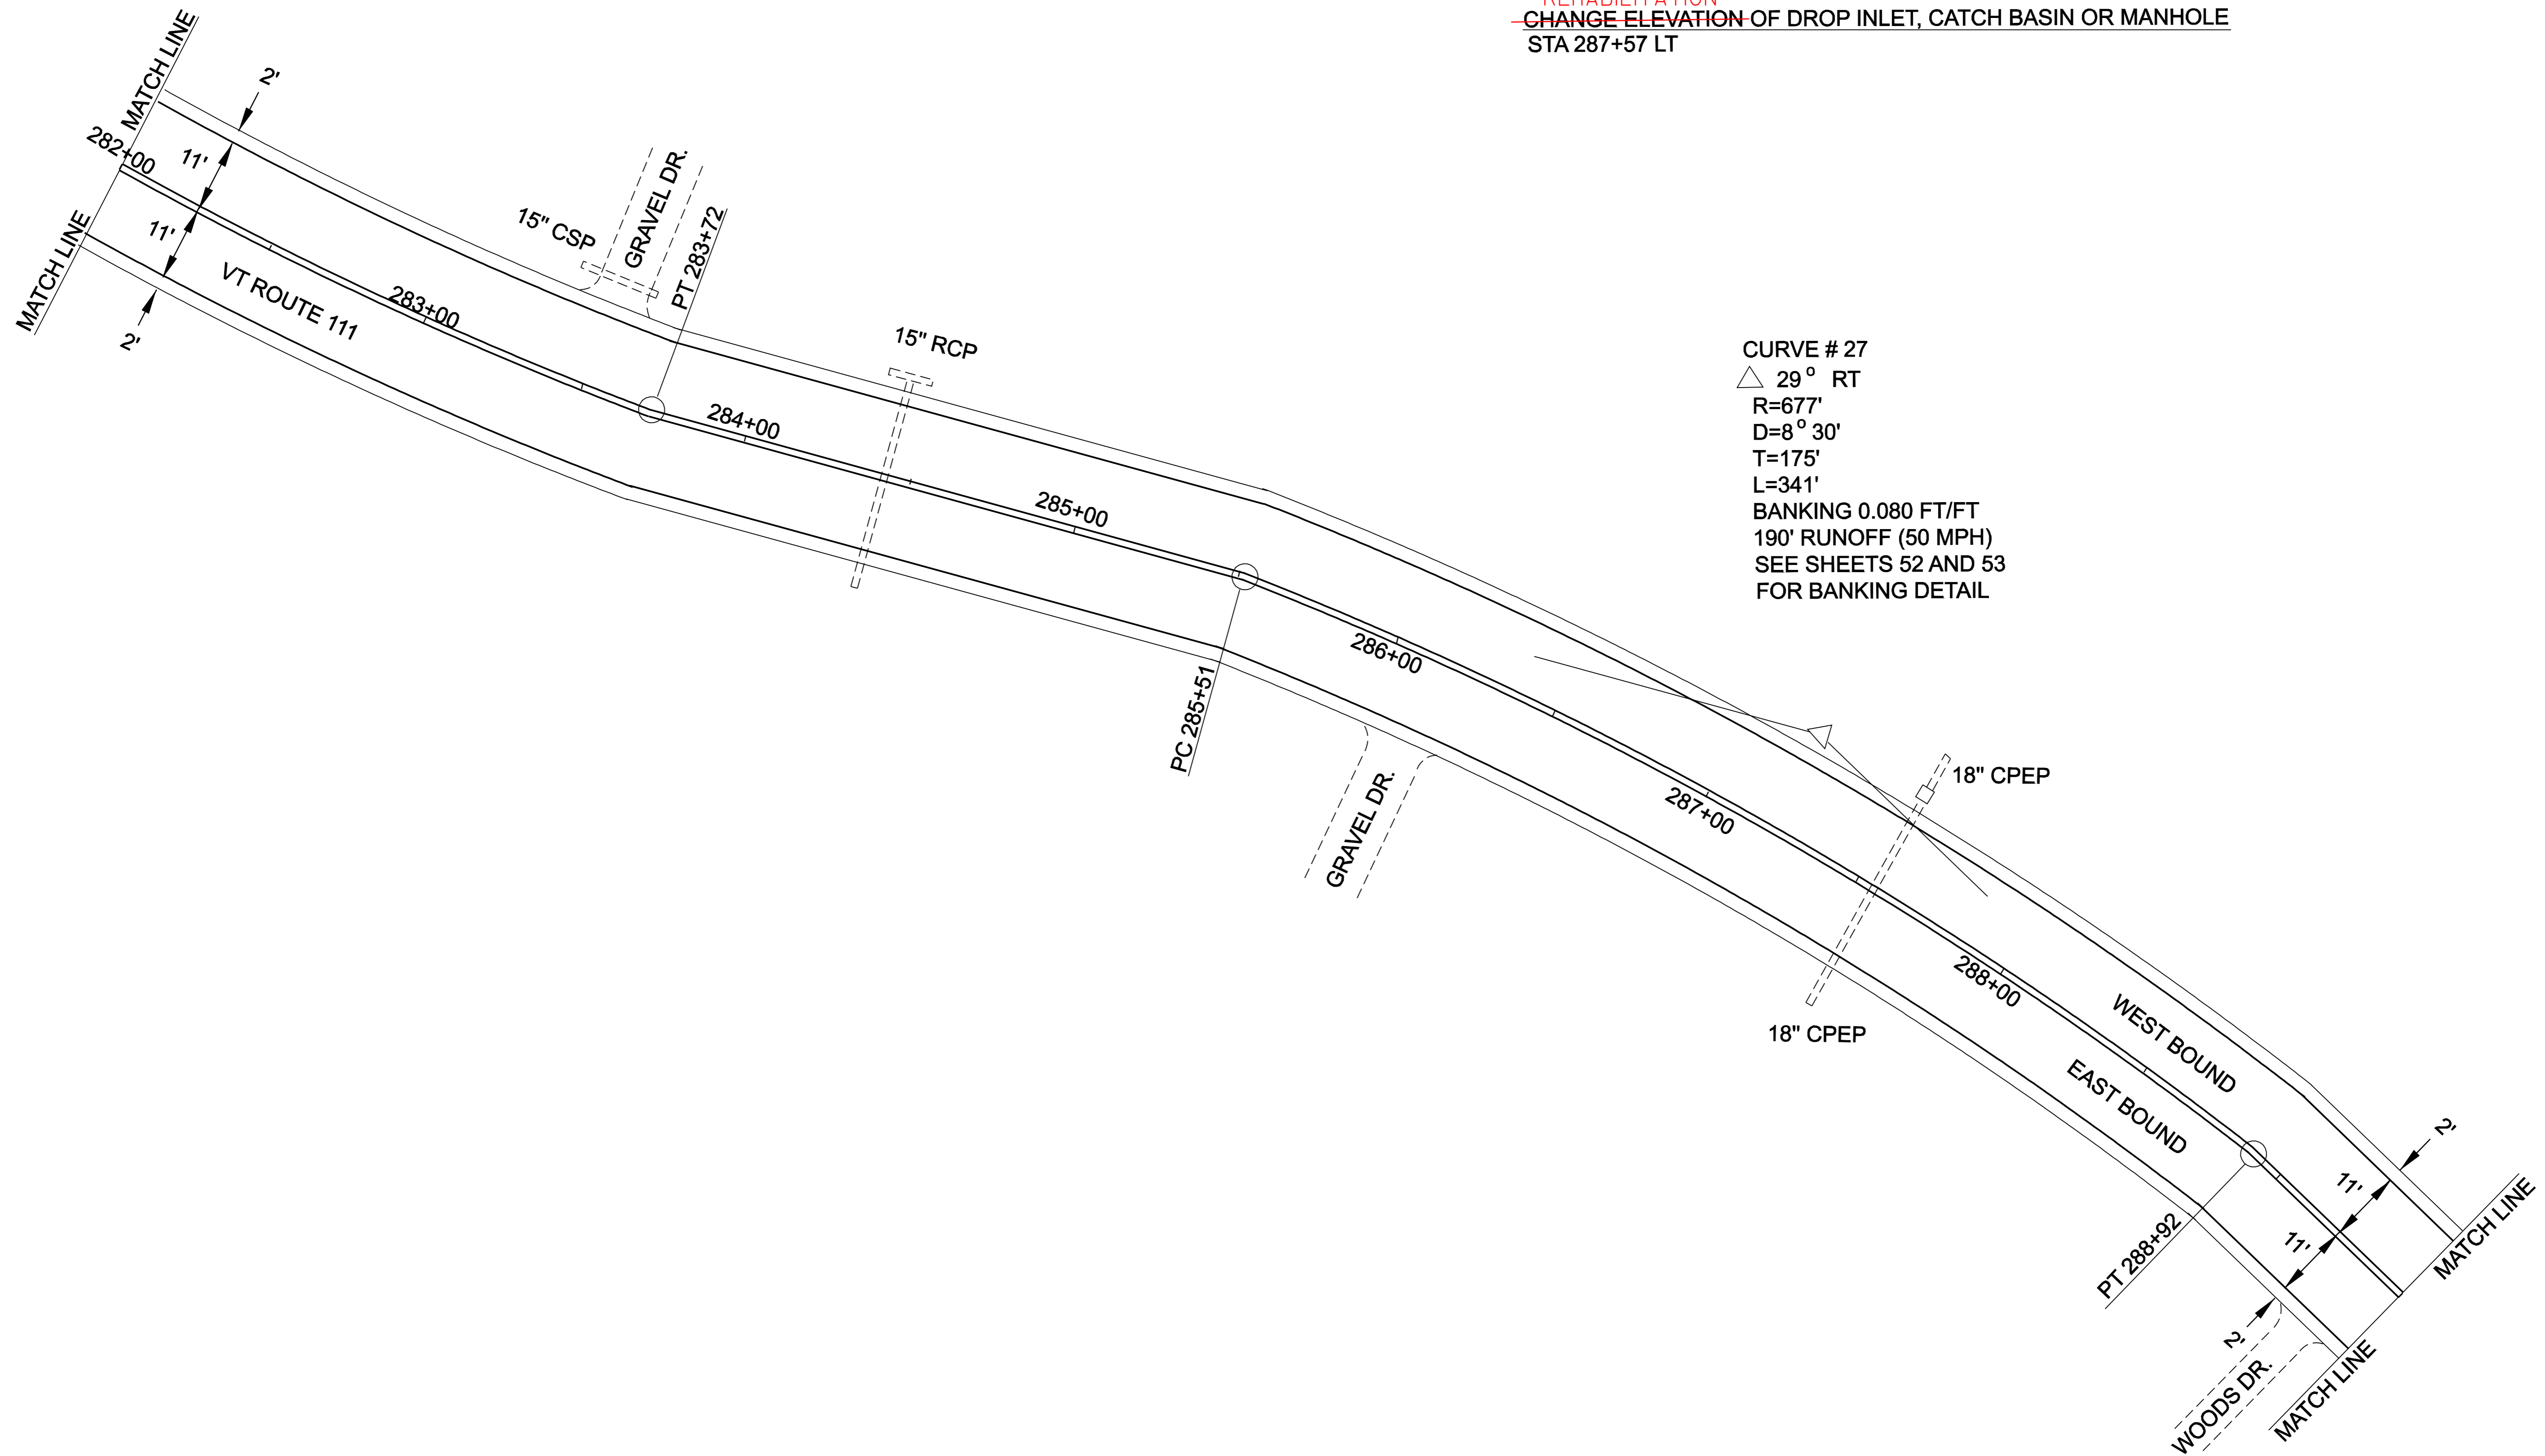

CURVE # 27
 △ 29° RT
 R=677'
 D=8° 30'
 T=175'
 L=341'
 BANKING 0.080 FT/FT
 190' RUNOFF (50 MPH)
 SEE SHEETS 52 AND 53
 FOR BANKING DETAIL

PROJECT LAYOUT SHEET #32	DESIGNED BY	LFW	DATE	6/04
	DRAWN BY	LFW	DATE	6/04
	DESIGN FILE NO.	pave/99cl92/99cl92.dgn		
	PRF FILE	99cl92p32.1	DATE PLOTTED	12-MAR-2007 11:3
	PROJ. NAME	MORGAN		
PROJ. NO.	AC STP 2220(1)S			
SHEET	39	OF	61	SHEETS