


DITCHING LOCATIONS (REFER TO SHEET 7 FOR DETAILS)
 STA 296+00 TO 298+40 LT
 STA 300+40 TO 303+00 LT

TEMPORARY AND DURABLE 4" WHITE LINE
 STA 296+00 TO 303+00 SOLID RT AND LT

TEMPORARY AND DURABLE 4" YELLOW LINE
 STA 296+00 TO 303+00 SOLID RT SOLID LT

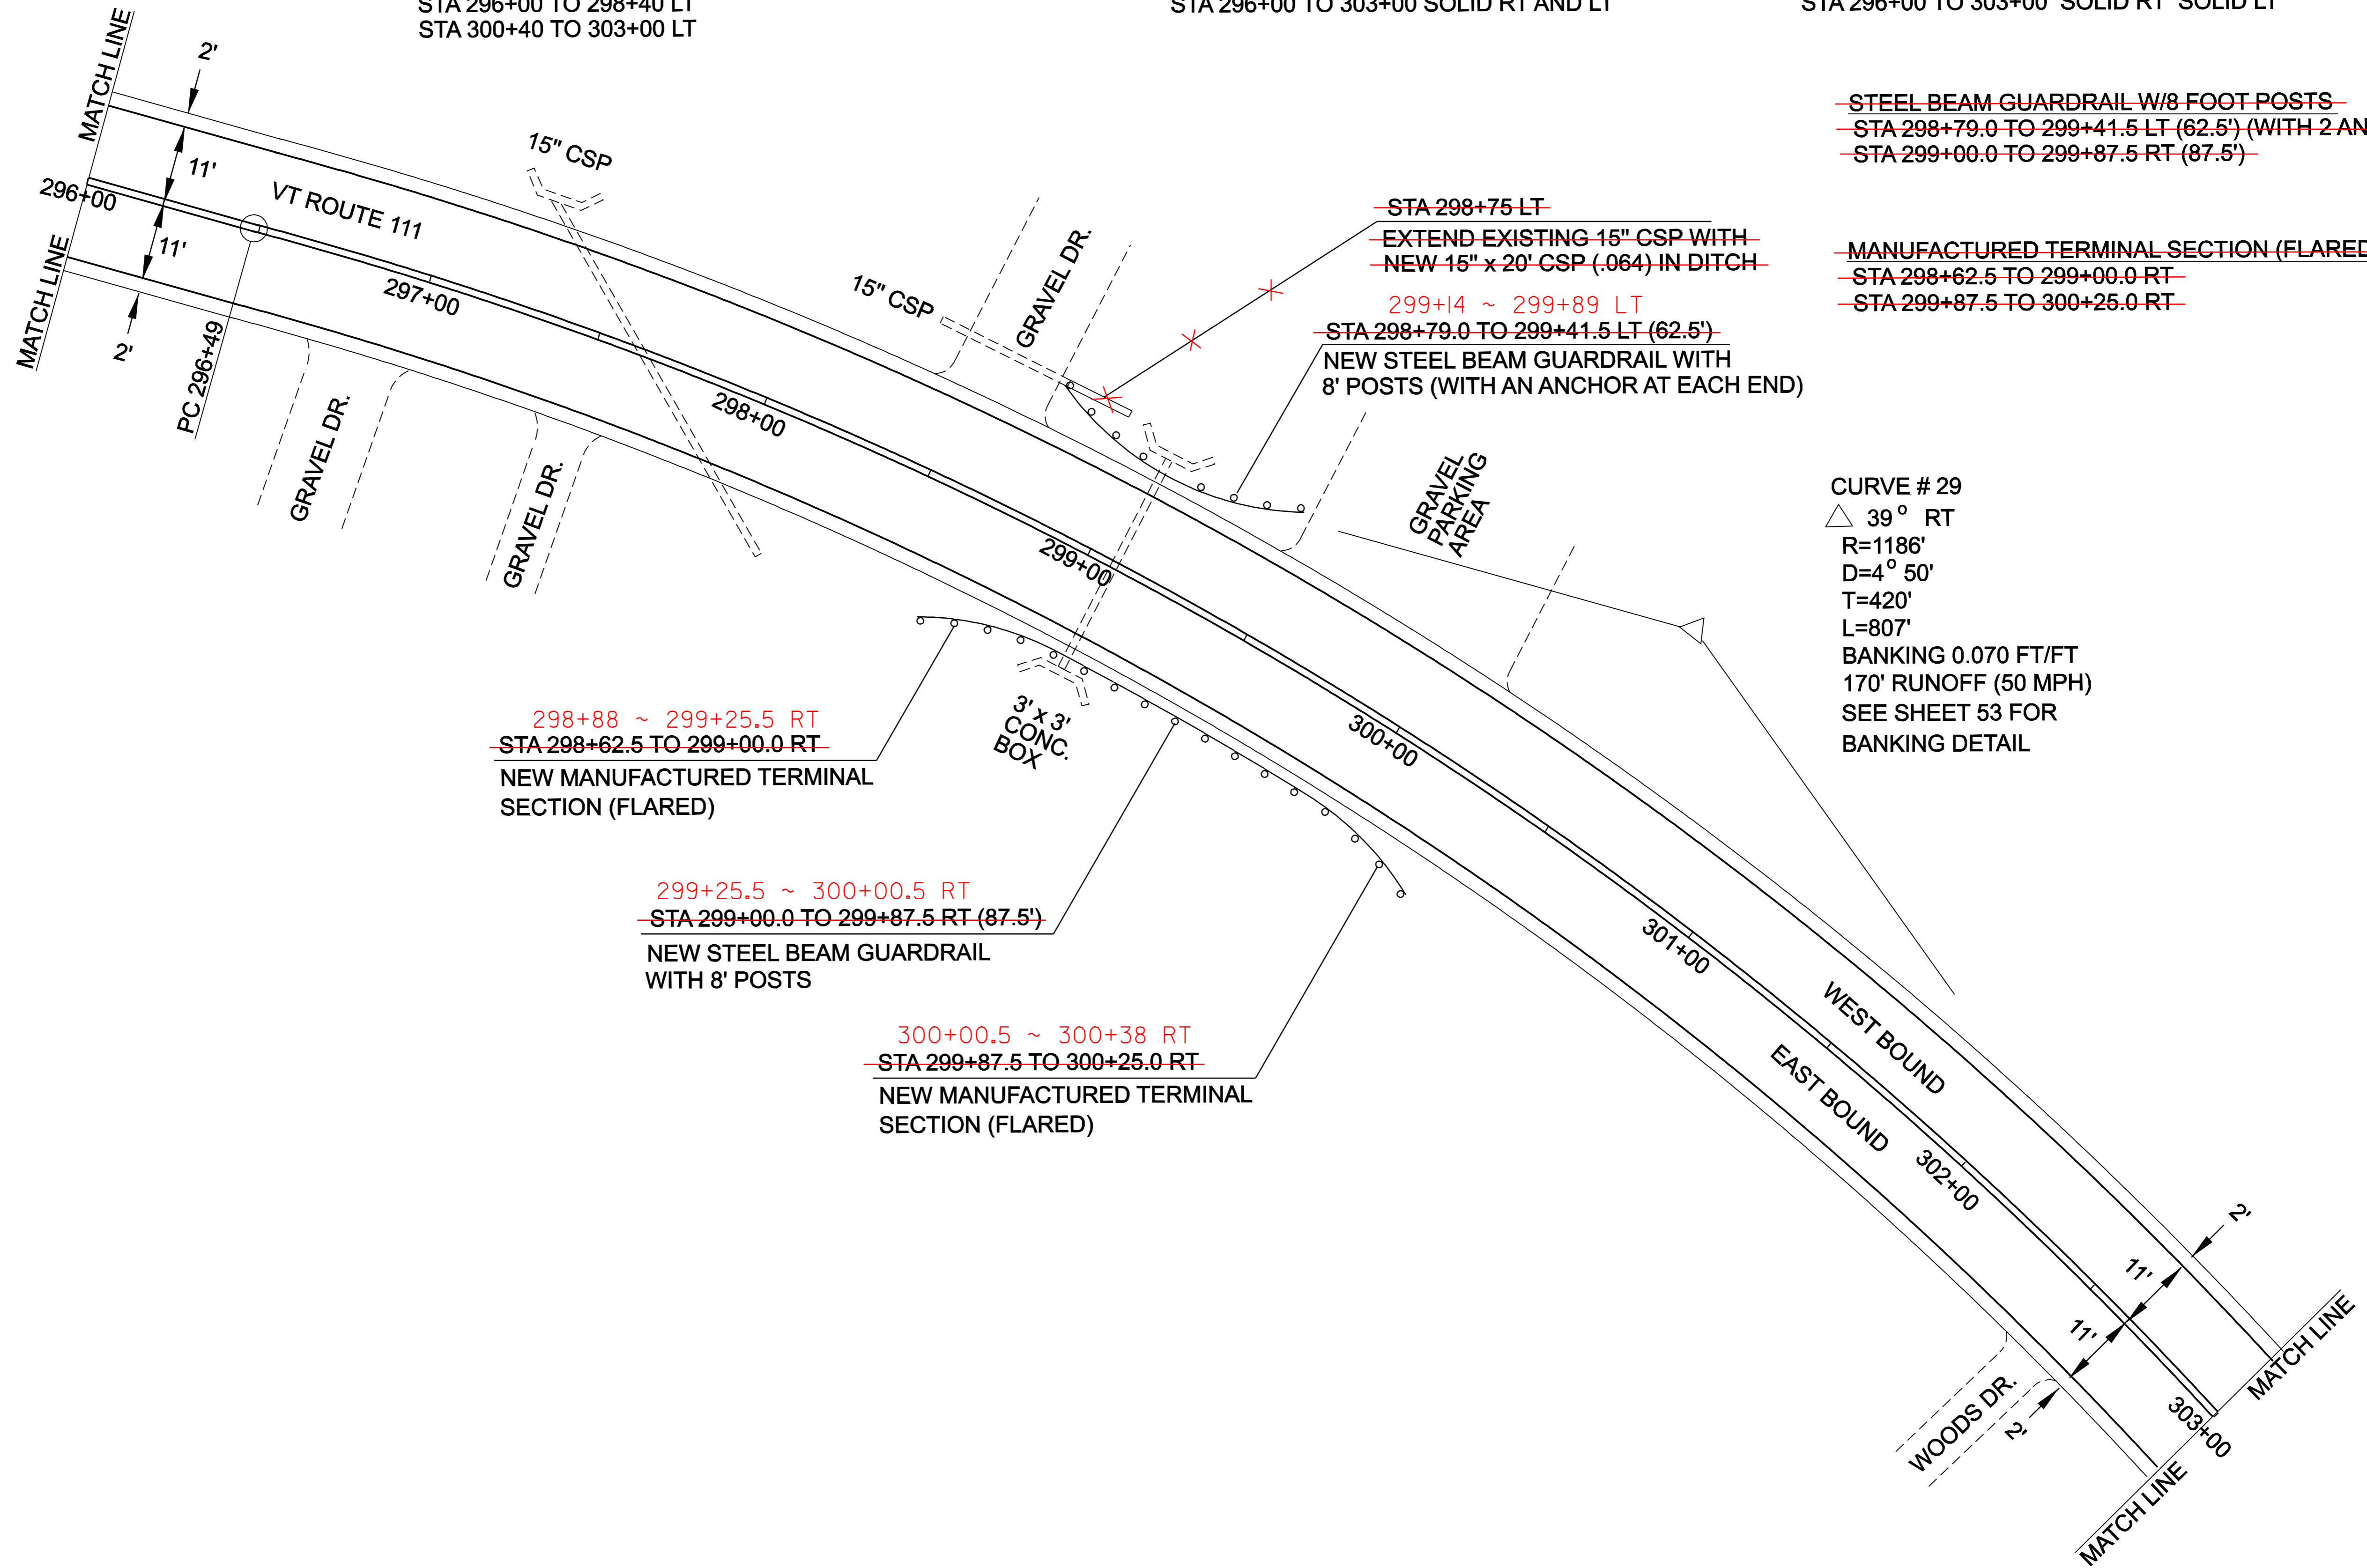

- ~~STEEL BEAM GUARDRAIL W/8 FOOT POSTS~~
- ~~STA 298+79.0 TO 299+41.5 LT (62.5') (WITH 2 ANCHORS)~~
- ~~STA 299+00.0 TO 299+87.5 RT (87.5')~~
- ~~MANUFACTURED TERMINAL SECTION (FLARED)~~
- ~~STA 298+62.5 TO 299+00.0 RT~~
- ~~STA 299+87.5 TO 300+25.0 RT~~

~~STA 298+75 LT~~
~~EXTEND EXISTING 15" CSP WITH~~
~~NEW 15" x 20' CSP (.064) IN DITCH~~
 299+14 ~ 299+89 LT
~~STA 298+79.0 TO 299+41.5 LT (62.5')~~
 NEW STEEL BEAM GUARDRAIL WITH
 8' POSTS (WITH AN ANCHOR AT EACH END)

CURVE # 29
 △ 39° RT
 R=1186'
 D=4° 50'
 T=420'
 L=807'
 BANKING 0.070 FT/FT
 170' RUNOFF (50 MPH)
 SEE SHEET 53 FOR
 BANKING DETAIL

~~298+88 ~ 299+25.5 RT~~
~~STA 298+62.5 TO 299+00.0 RT~~
 NEW MANUFACTURED TERMINAL
 SECTION (FLARED)

~~299+25.5 ~ 300+00.5 RT~~
~~STA 299+00.0 TO 299+87.5 RT (87.5')~~
 NEW STEEL BEAM GUARDRAIL
 WITH 8' POSTS

~~300+00.5 ~ 300+38 RT~~
~~STA 299+87.5 TO 300+25.0 RT~~
 NEW MANUFACTURED TERMINAL
 SECTION (FLARED)

PROJECT LAYOUT SHEET #34	DESIGNED BY	LFW	DATE	6/04
	DRAWN BY	LFW	DATE	6/04
	DESIGN FILE NO.	pave/99cl92/99cl92.dgn		
	PRF FILE	99cl92p34.1	DATE PLOTTED	12-MAR-2007 11:3
	PROJ. NAME	MORGAN		
PROJ. NO.	AC STP 2220(1)S			
SHEET	41	OF	61	SHEETS