


TEMPORARY AND DURABLE 4" WHITE LINE  
STA 318+50 TO 325+50 SOLID RT AND LT

TEMPORARY AND DURABLE 4" YELLOW LINE  
STA 318+50 TO 325+50 SOLID RT SOLID LT

DITCHING LOCATIONS (REFER TO SHEET 7 FOR DETAILS)

- STA 318+50 TO 318+75 LT
- STA 319+22 RT (CULVERT OUTLET)
- STA 319+16 TO 322+34 LT
- STA 321+07 TO 322+34 RT
- STA 322+66 TO 325+00 LT
- STA 325+25 TO 325+57 LT

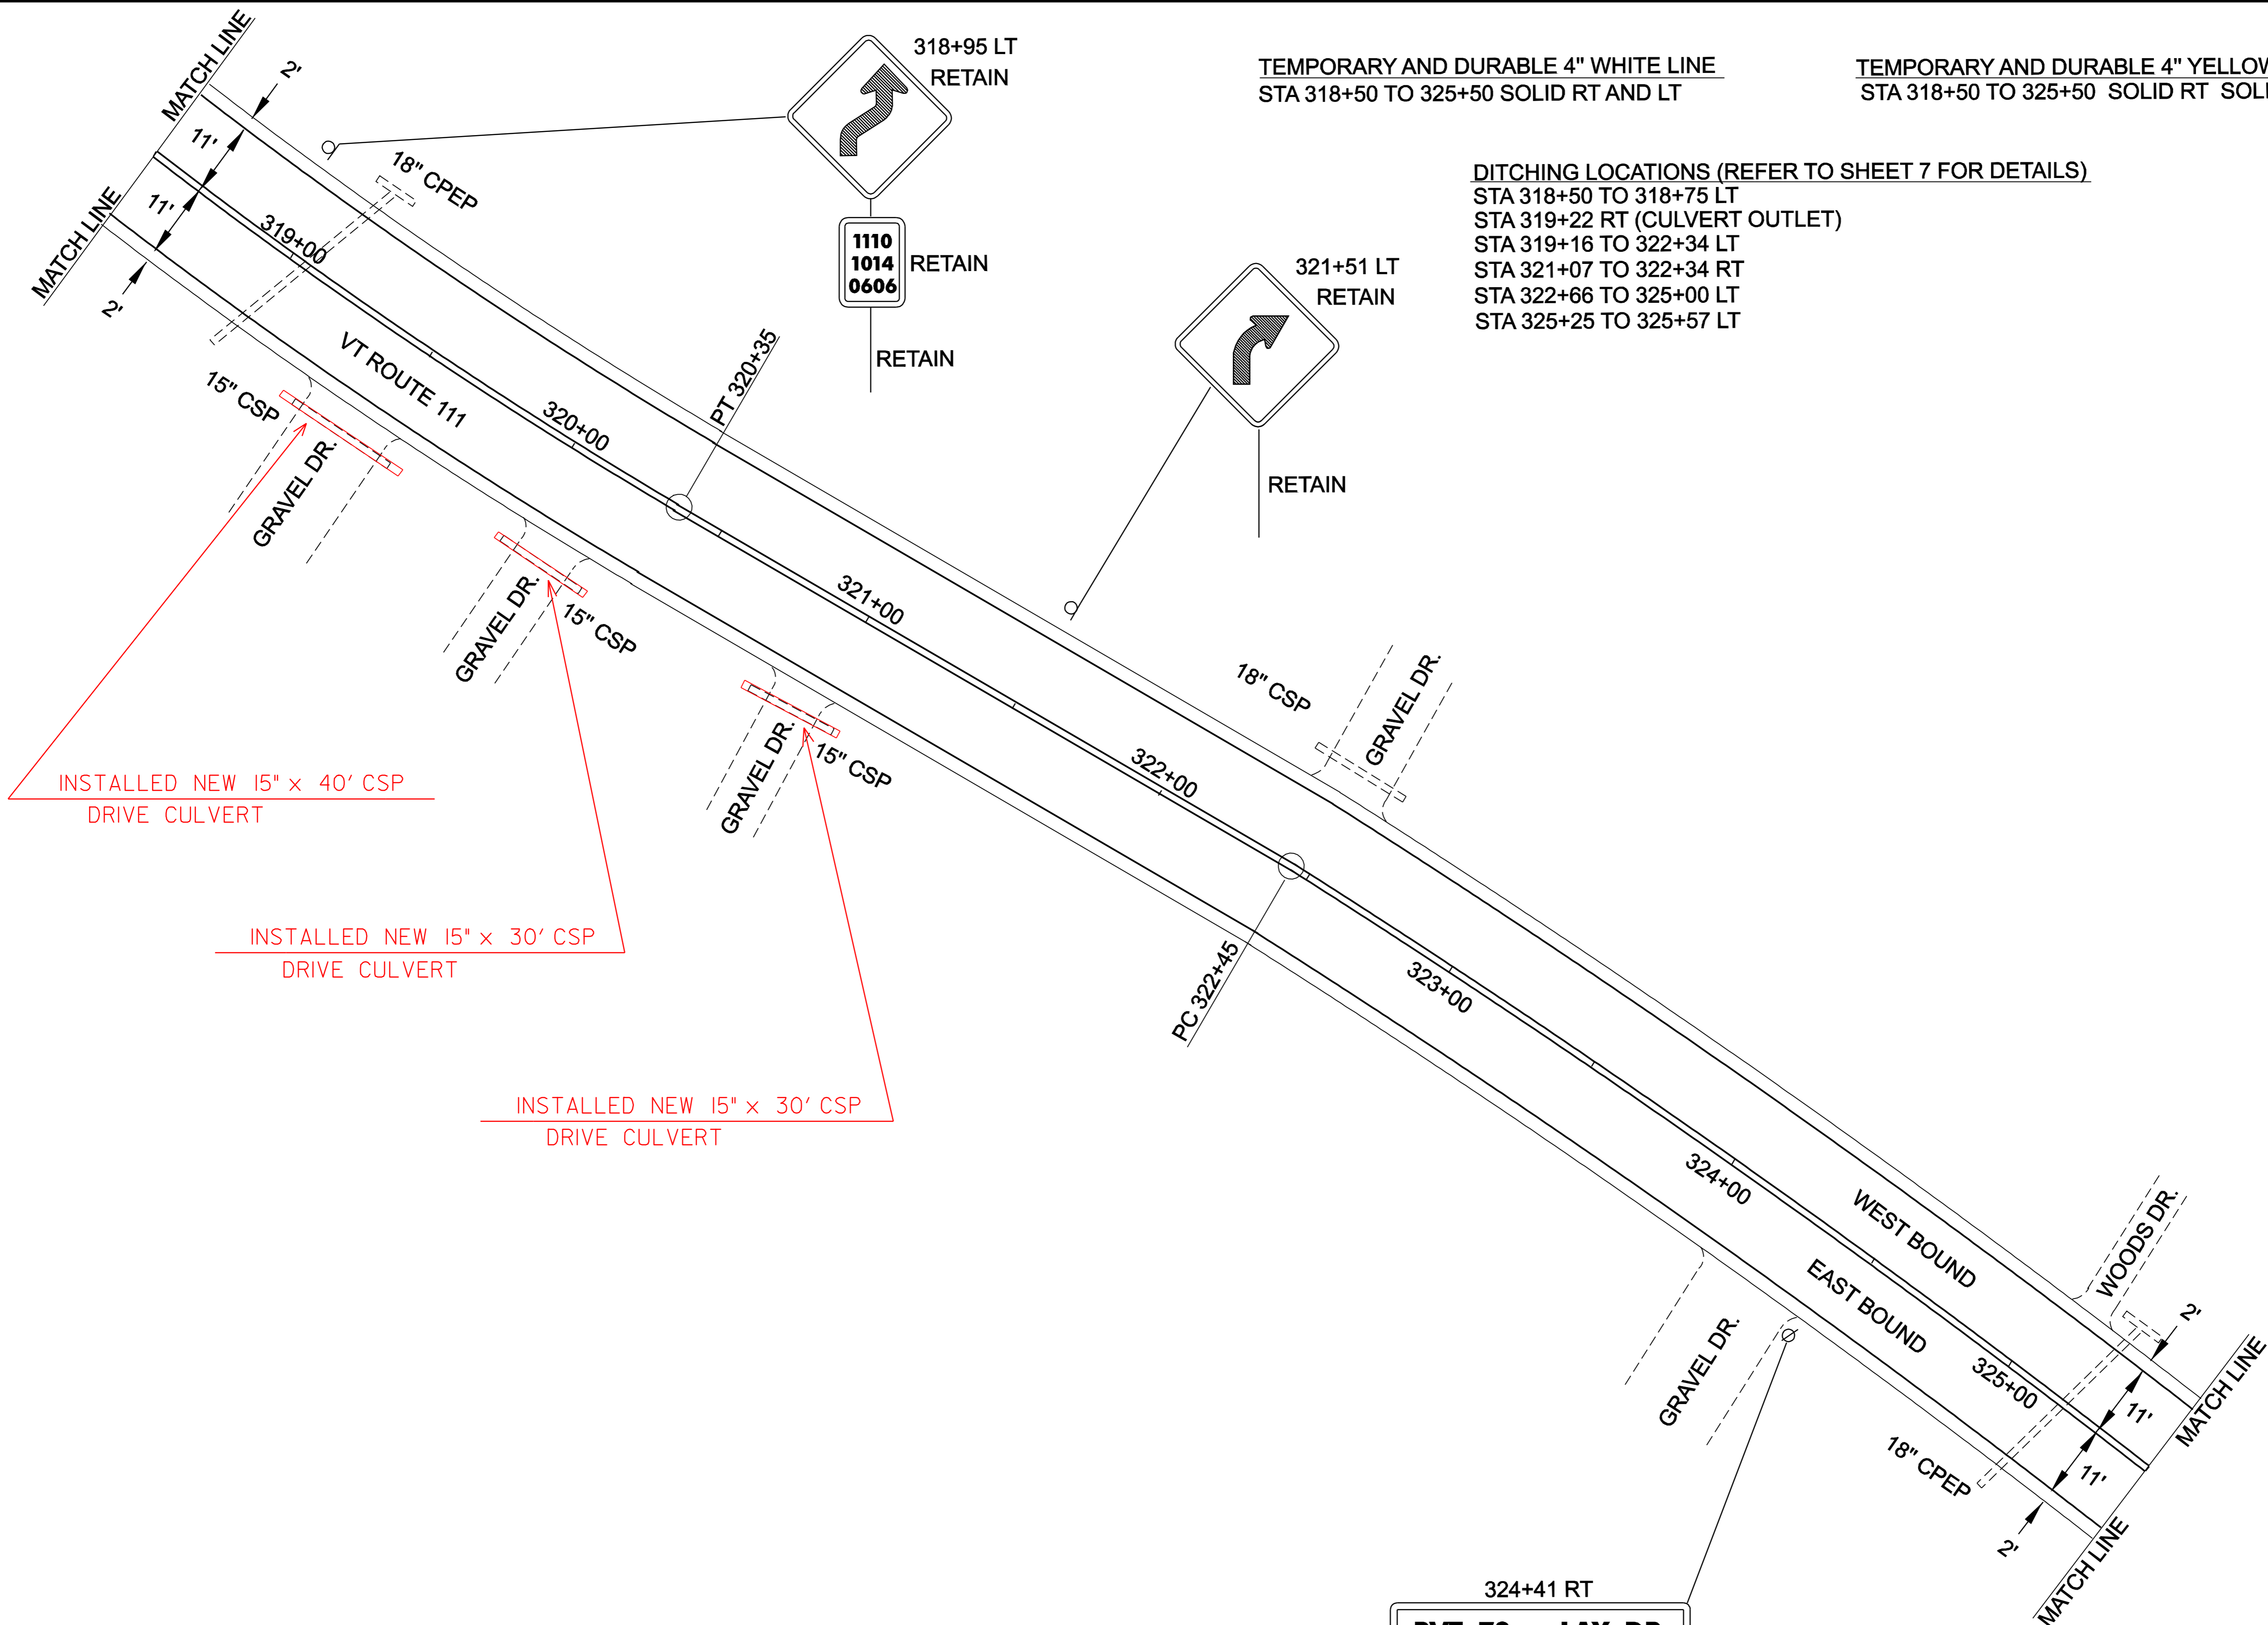

INSTALLED NEW 15" x 40' CSP  
DRIVE CULVERT

INSTALLED NEW 15" x 30' CSP  
DRIVE CULVERT

INSTALLED NEW 15" x 30' CSP  
DRIVE CULVERT

324+41 RT  
**PVT 72 LAY DR.**  
RETAIN  
RETAIN

PROJECT LAYOUT SHEET #37	DESIGNED BY	LFW	DATE	6/04
	DRAWN BY	LFW	DATE	6/04
	DESIGN FILE NO.	pave/99cl92/99cl92.dgn		
	PRF FILE	99cl92p37.1	DATE PLOTTED	12-MAR-2007 11:3
	PROJ. NAME	MORGAN		
PROJ. NO.	AC STP 2220(1)S			
SHEET	44	OF	61	SHEETS