


TEMPORARY AND DURABLE 4" WHITE LINE
STA 325+50 TO 327+36 SOLID RT AND LT

TEMPORARY AND DURABLE 4" YELLOW LINE
STA 325+50 TO 327+36 SOLID RT SOLID LT

DITCHING LOCATIONS (REFER TO SHEET 7 FOR DETAILS)
STA 325+98 TO 327+55 LT

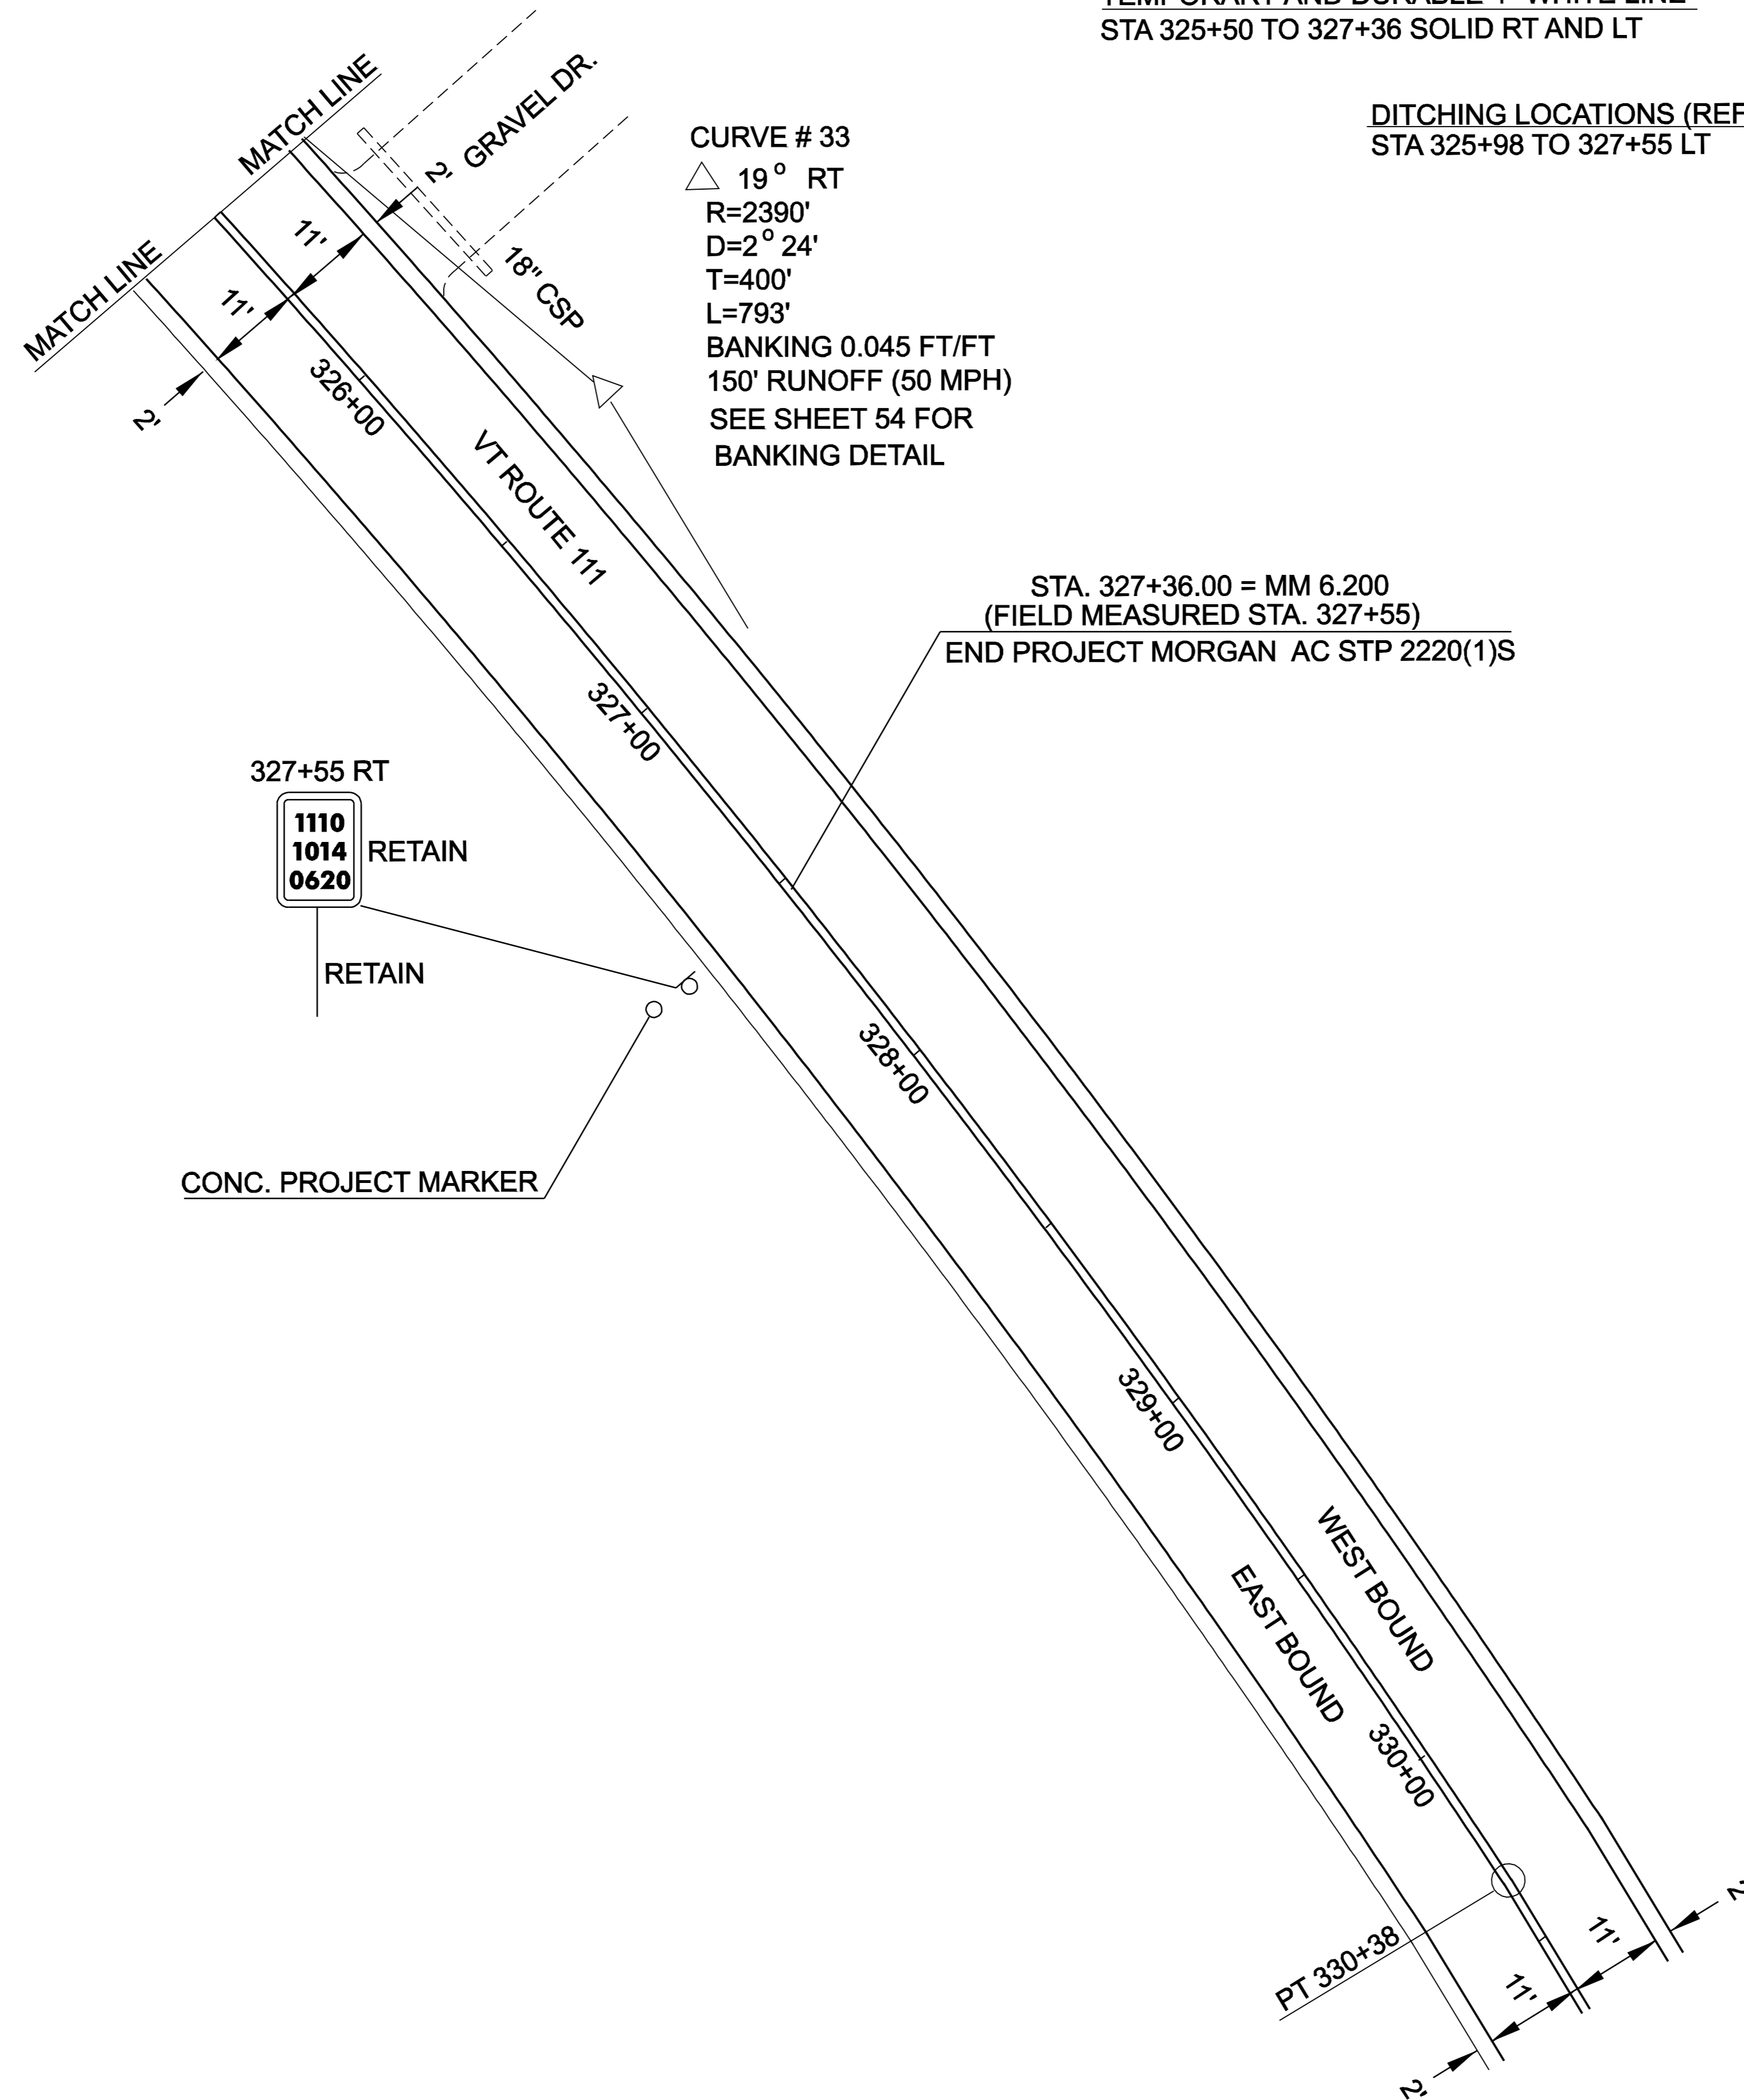

327+55 RT
1110
1014
0620
RETAIN
RETAIN
CONC. PROJECT MARKER

STA. 327+36.00 = MM 6.200
(FIELD MEASURED STA. 327+55)
END PROJECT MORGAN AC STP 2220(1)S

PROJECT LAYOUT SHEET #38	DESIGNED BY	LFW	DATE	6/04
	DRAWN BY	LFW	DATE	6/04
	DESIGN FILE NO.	pave/99cl92/99cl92.dgn		
	PRF FILE	99cl92p38.1	DATE PLOTTED	12-MAR-2007 11:3
	PROJ. NAME	MORGAN		
	PROJ. NO.	AC STP 2220(1)S		
SHEET	45	OF	61	SHEETS