



MORGAN - BRIDGE #5
STA 159+73 = MM 3.025
(FIELD MEASURED STA 159+73)

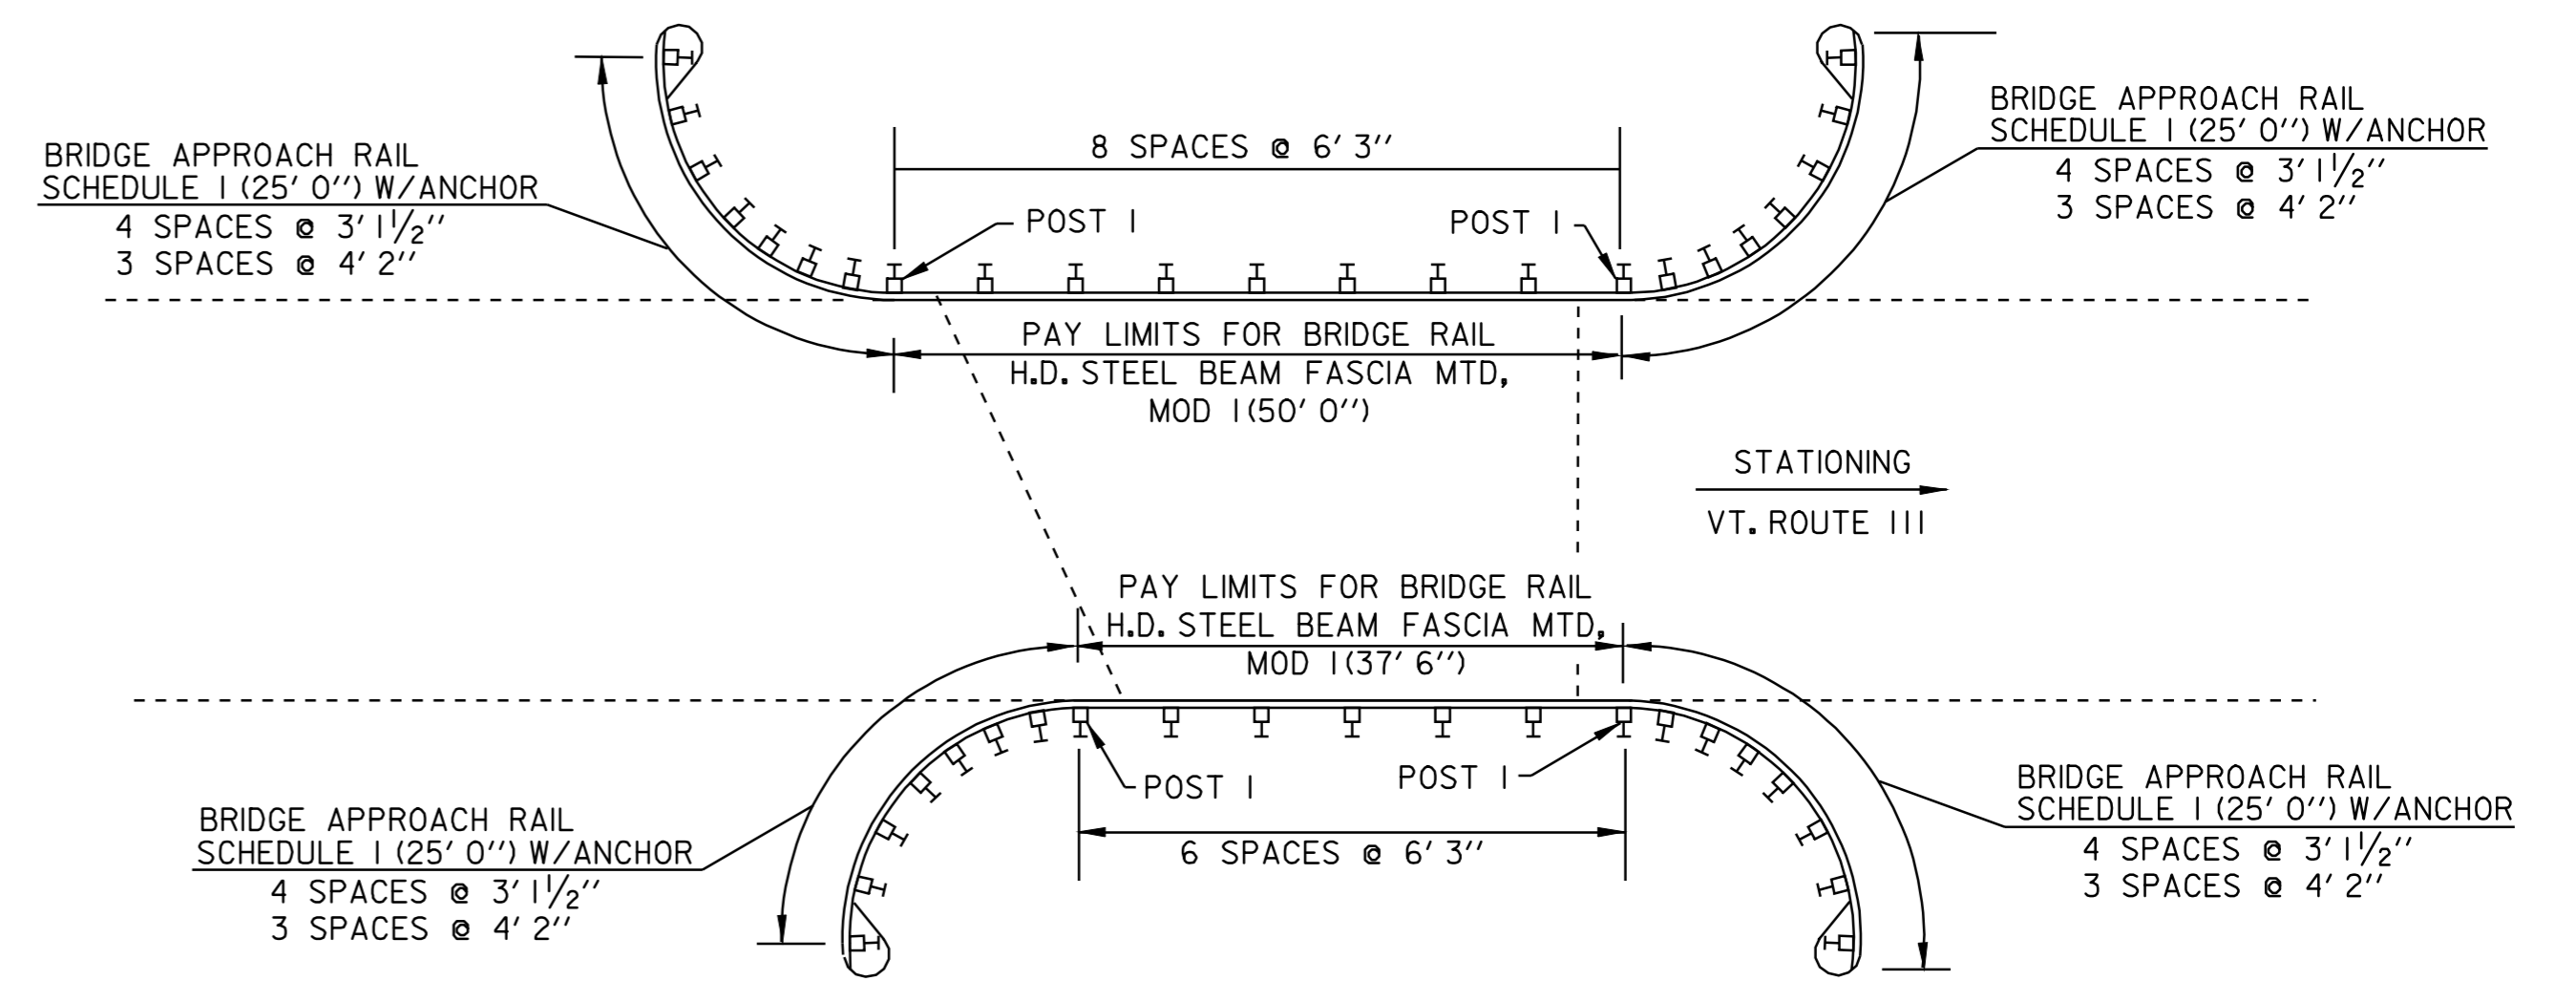

MORGAN - BRIDGE #8
STA 251+46 = MM 4.763
(FIELD MEASURED STA 251+15)

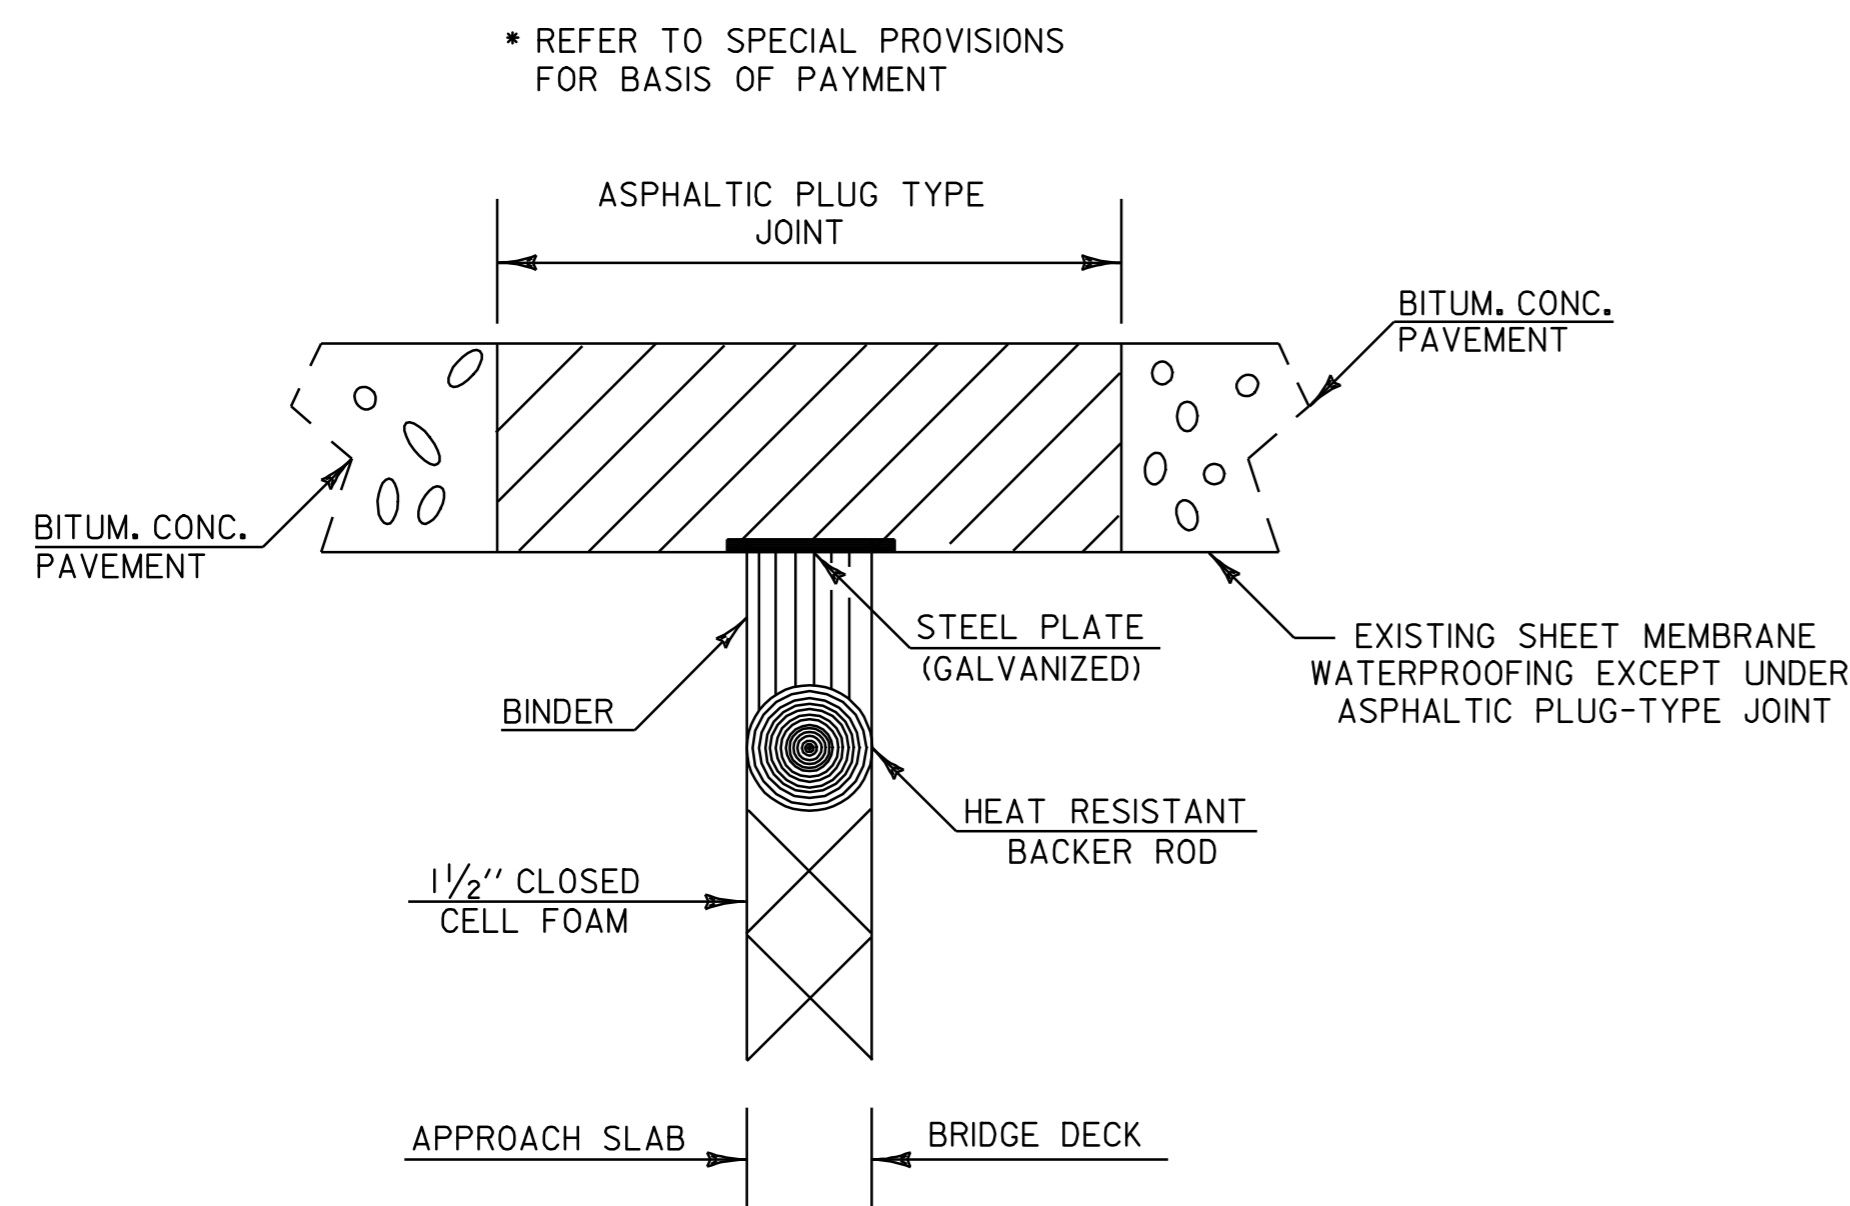

- ASPHALTIC PLUG TYPE JOINT DETAIL -

LOCATION
MORGAN
 BRIDGE #8 (25 FEET) - STA 250+87 (FIELD MEASURE)
 BRIDGE #8 (25 FEET) - STA 251+40 (FIELD MEASURE)

BRIDGE DETAIL SHEET #2	DESIGNED BY	LFW	DATE	6/04
	DRAWN BY	LFW	DATE	6/04
	DESIGN FILE NO.	pave/99cl92/99cl92.dgn		
	PRF FILE	99cl92br2.i	DATE PLOTTED	12-MAR-2007 11:3
	PROJ. NAME	MORGAN		
PROJ. NO.	AC STP 2220(1)S			
SHEET	59	OF	61	SHEETS