


STATE OF VERMONT
AGENCY OF TRANSPORTATION



PROPOSED IMPROVEMENT
TOWN OF BENNINGTON
COUNTY OF BENNINGTON
VT.ROUTE 9 / US ROUTE 7

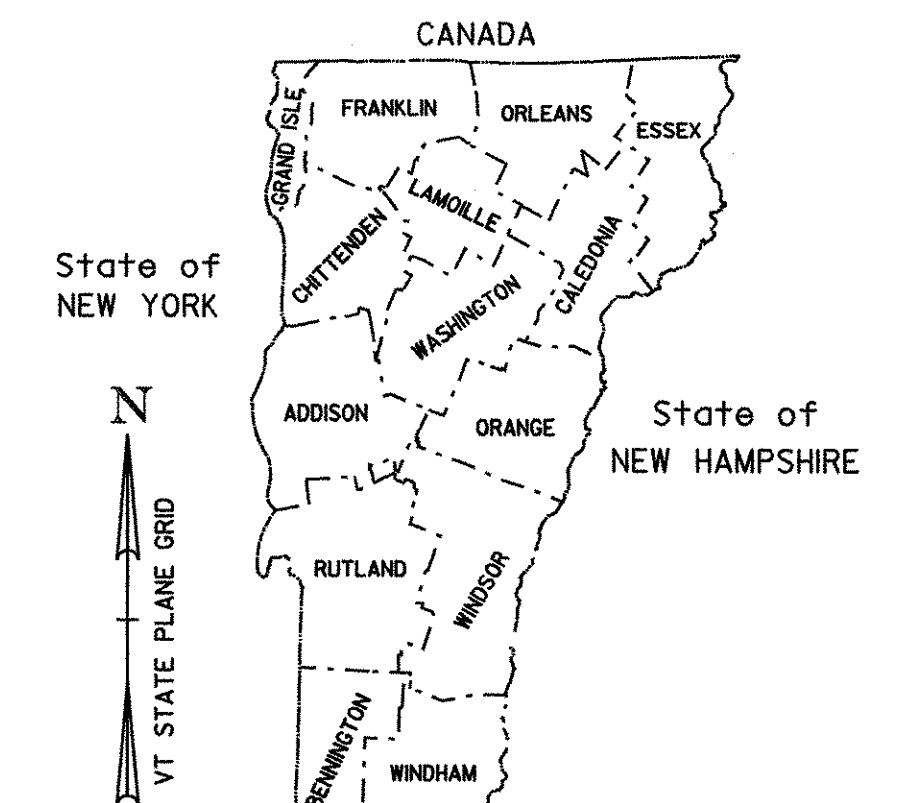

PROJECT LOCATION
NH 2225(1)S
NH 2202(1)S

RECORD PLANS

CONTRACTOR: F.W. WHITCOMB CONSTRUCTION - WALPOLE, NH

RESIDENT ENGINEER: T. POCKETTE

CONSTRUCTION BEGAN: AUGUST 4, 2003

CONSTRUCTION COMPLETE:

RECORD PLANS BY: T. POCKETTE, C. BUMP


I HEREBY CERTIFY THAT ALL THE CONSTRUCTION REQUIRED BY THIS SET OF DRAWINGS HAS BEEN ACCOMPLISHED AS INDICATED HEREIN.

BY: *[Signature]* RESIDENT ENGINEER


DATE: *SEPT 26, 2005*

NOTE: Any further information concerning final quantities, amounts or other details relative to this project may be found at Central Files in the electronic archives.

**BENNINGTON
NH 2225(1)S
VT ROUTE 9**
SEE SHEET 81 OF 108

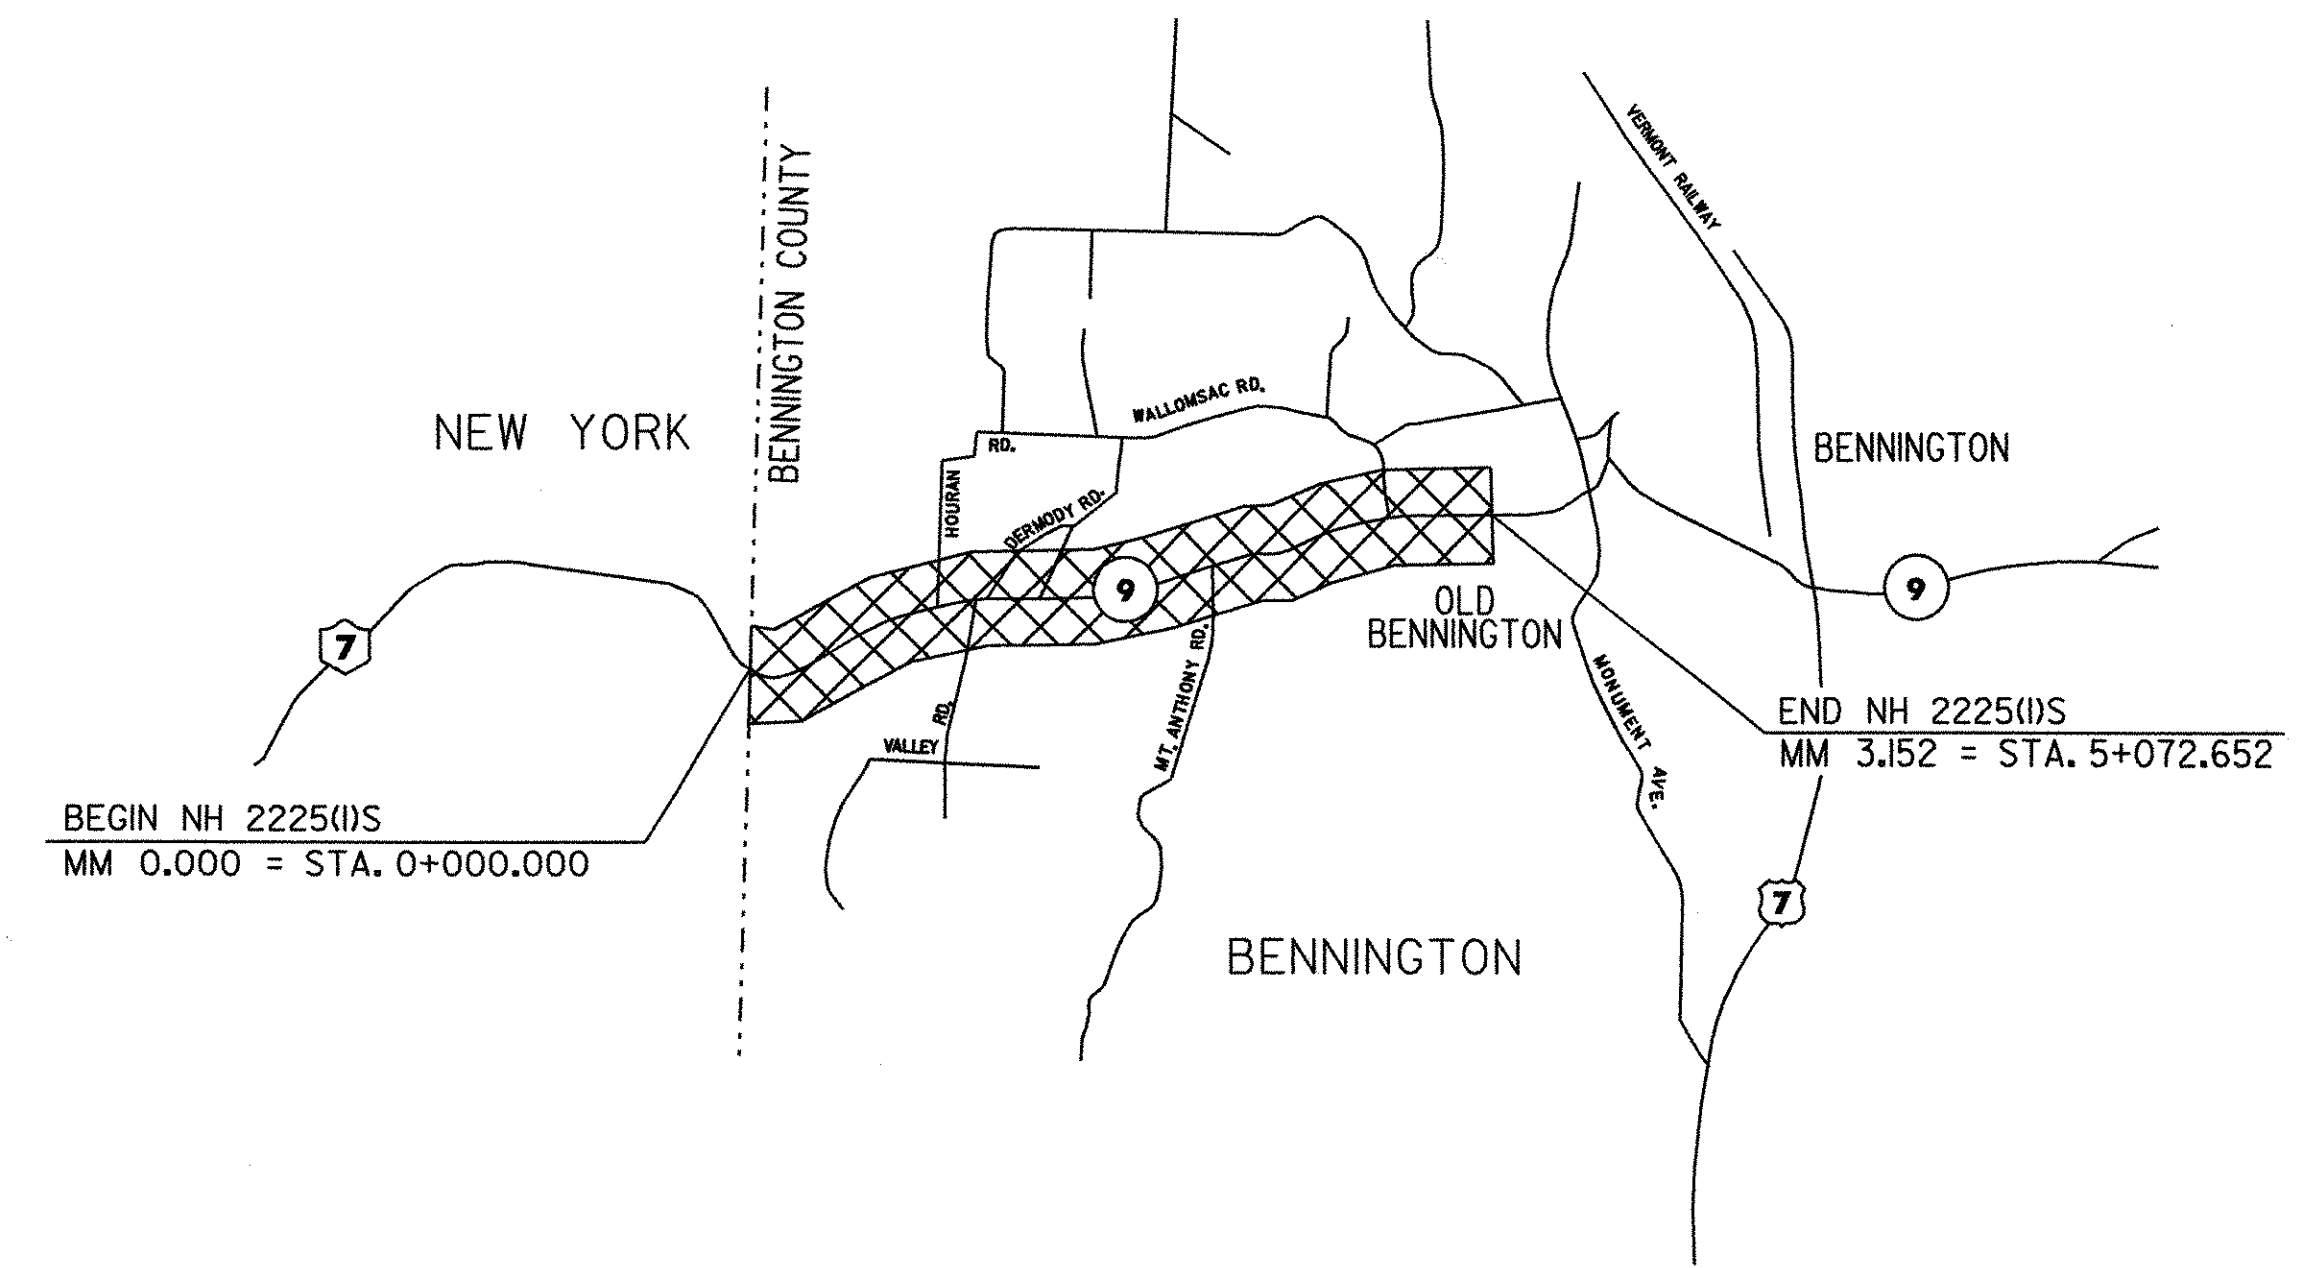


**BENNINGTON
NH 2202(1)S
VT ROUTE 9 / US ROUTE 7**
SEE SHEET 5 OF 108

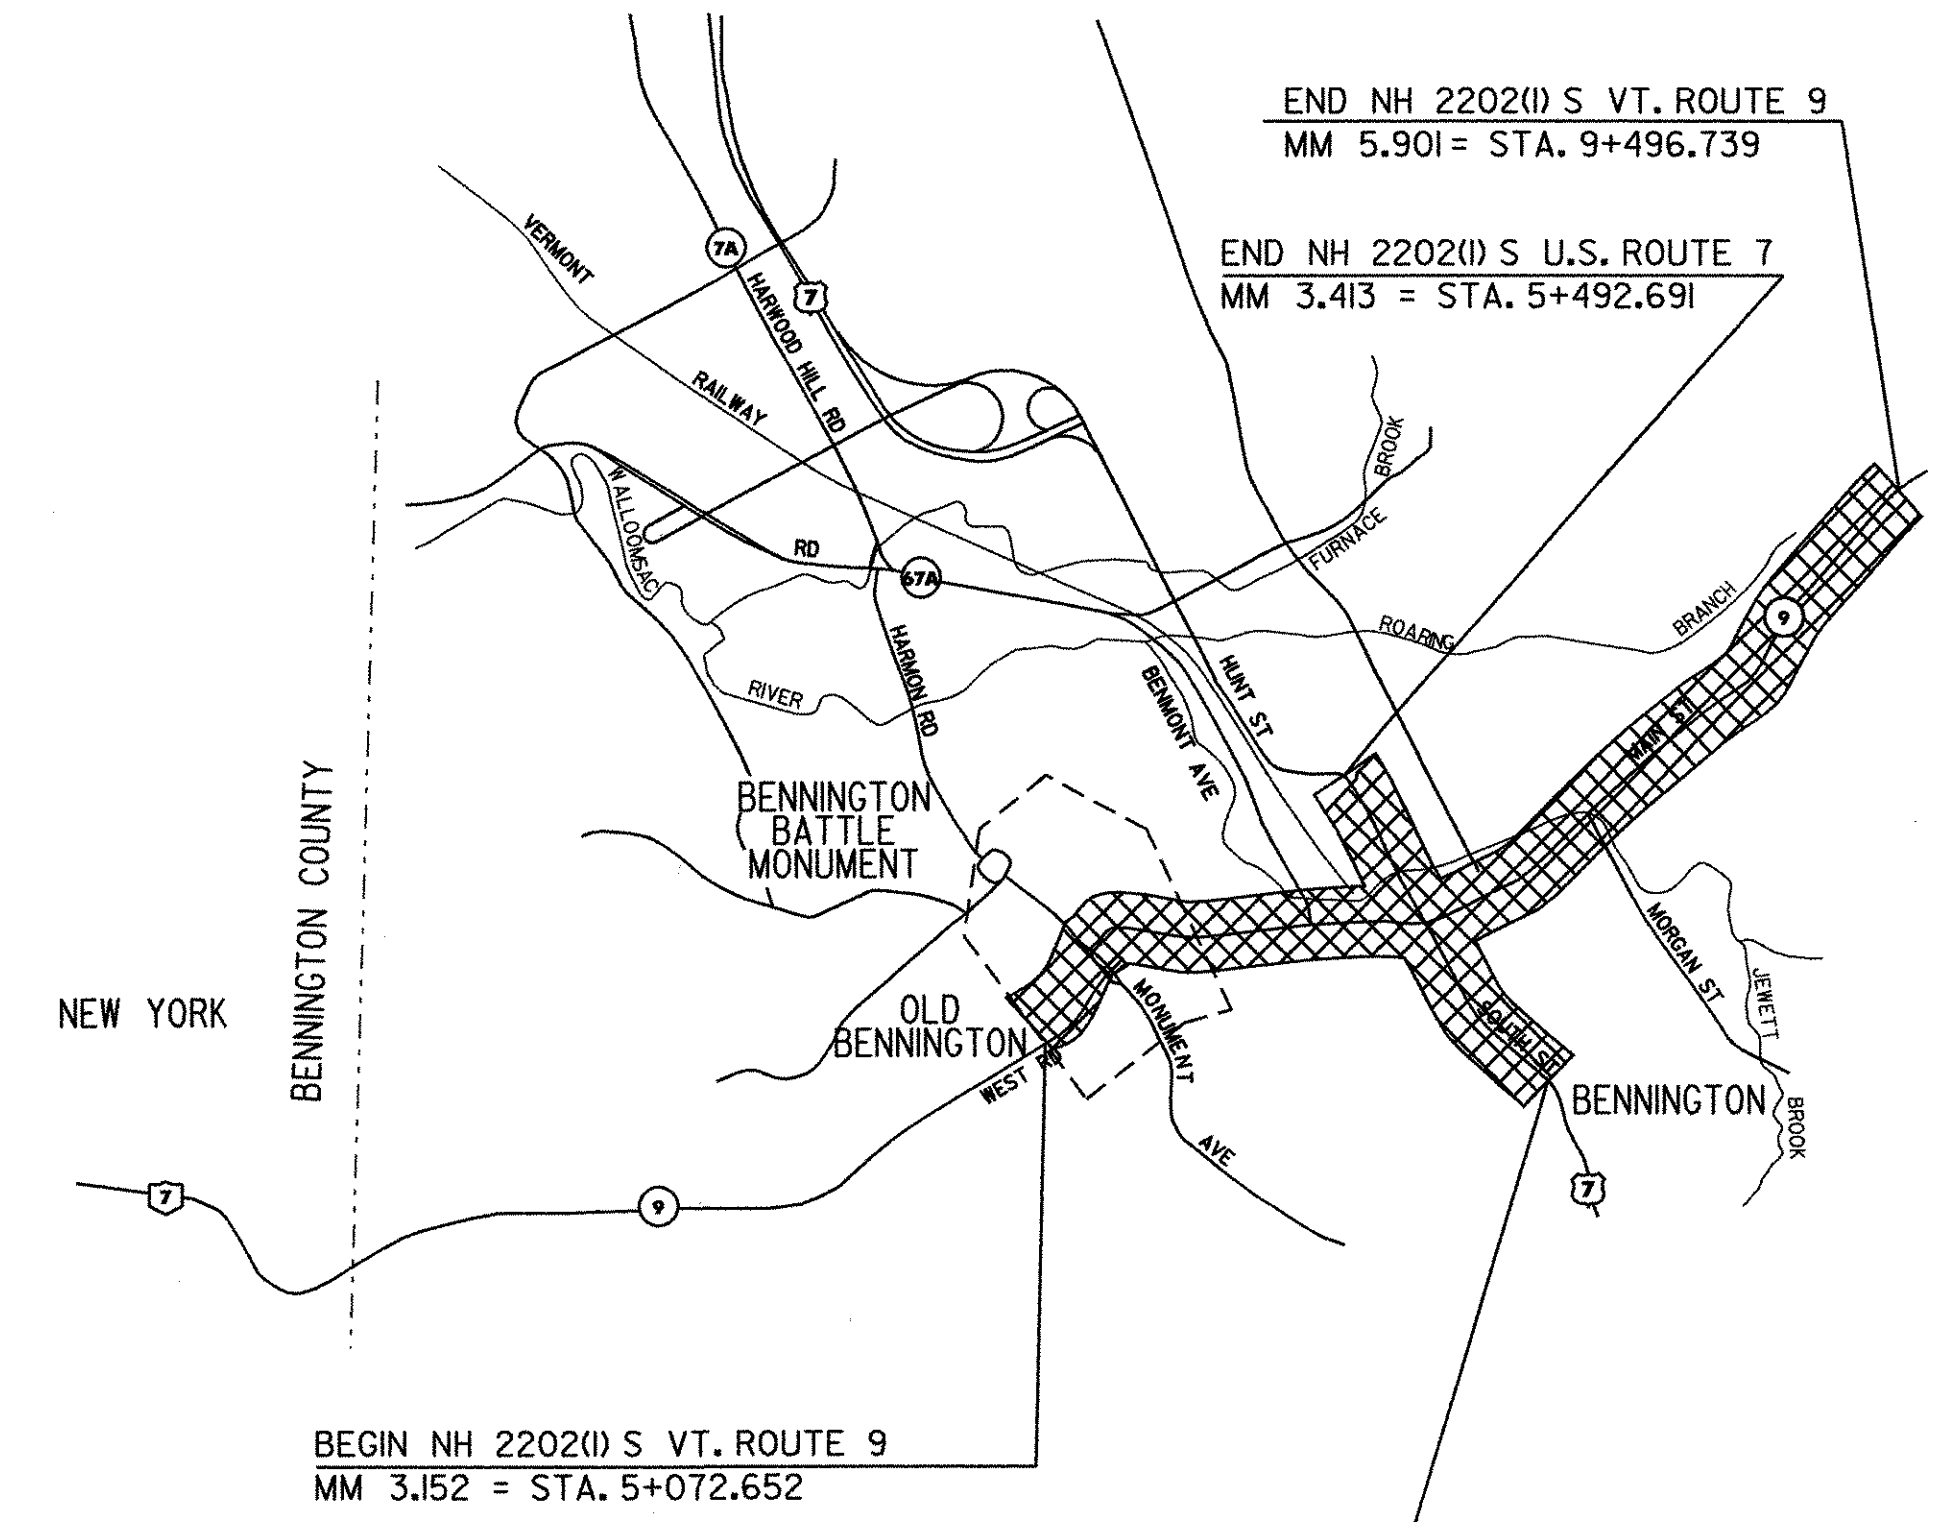

CONVENTIONAL SIGNS

COUNTY LINE	---
TOWN LINE	- - - -
LIMITS OF ACCESS	—o—o—o—o—
POINT OF ACCESS	X
FENCE LINE	-x-x-
STONE WALL	=====
TRAVELED WAY	=====
GUARD RAIL	—o—o—o—o—
RAILROAD	—+—+—+—+—
SURVEY LINE	—+—+—+—+—
CULVERT	—+—+—+—+—
POWER POLE	⊕
TELEPHONE POLE	⊕
TREES	⊗
CONTROL OF ACCESS	///
PROPERTY LINE	—+—+—+—+—
R.O.W. TAKING LINE	—+—+—+—+—
SLOPE RIGHTS	—+—+—+—+—
TOP OF CUT	—+—+—+—+—
TOE OF SLOPE	—+—+—+—+—

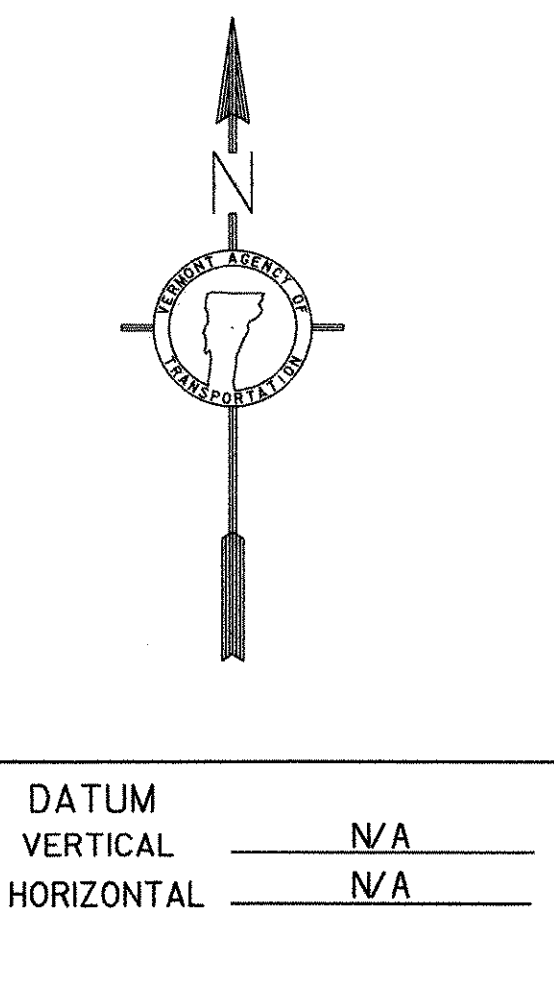

PLANS PREPARED BY

CHA CLOUGH, HARBOUR & ASSOCIATES LLP
ENGINEERS, SURVEYORS, PLANNERS & LANDSCAPE ARCHITECTS

III WINNERS CIRCLE ALBANY, NEW YORK, 12205

BY: _____

UNLESS OTHERWISE NOTED, ALL DRAWINGS AND DETAILS OF THE PROJECT PLANS ARE NOT TO SCALE.

RIGHT OF WAY LIMITS, IF APPLICABLE, ARE PROVIDED SOLELY FOR THE CONVENIENCE OF THE STATE AND ITS CONTRACTOR DURING THE COURSE OF THIS PAVING PROJECT. ANY REFERENCES TO OFFSETS ON THESE PLANS ARE APPROXIMATE AND SHOULD NOT BE RELIED UPON FOR ANY OTHER PURPOSES.

THESE PLANS ARE SUBJECT TO SUCH ENGINEERING CHANGES AS MAY BE REQUIRED BY THE FEDERAL HIGHWAY ADMINISTRATION OR THE DIRECTOR OF PROJECT DEVELOPMENT.

CONSTRUCTION IS TO BE CARRIED ON IN ACCORDANCE WITH THESE PLANS AND THE STANDARD SPECIFICATIONS FOR CONSTRUCTION DATED 2001, AS APPROVED BY THE FEDERAL HIGHWAY ADMINISTRATION ON JANUARY 4, 2001 FOR USE ON THIS PROJECT, INCLUDING ALL SUBSEQUENT REVISIONS AND SUCH REVISED SPECIFICATIONS AND SPECIAL PROVISIONS AS ARE INCORPORATED IN THESE PLANS.



APPROVED _____ DATE _____
DIRECTOR OF PROGRAM DEVELOPMENT

DEPARTMENT OF TRANSPORTATION
FEDERAL HIGHWAY ADMINISTRATION

APPROVED _____ DATE _____
DIVISION ADMINISTRATOR

PROJECT BENNINGTON BENNINGTON
NH 2202(1)S NH 2225(1)S
SHEET 1 OF 108 SHEETS