

646.40 DURABLE 100 mm WHITE LINE
 (ALL LINES WILL INCLUDE EDGE LINE BREAKS AND RADIUS FOR TOWN HIGHWAYS)
 VT. ROUTE 9:
 STA. 5+072.652 - STA. 5+320.0 LT & RT

646.41 DURABLE 100 mm YELLOW LINE
 (ALL LINES WILL INCLUDE C/L BREAKS FOR TOWN HIGHWAYS) S=SOLID, D=DASHED
 VT. ROUTE 9:
 STA. 5+072.652 - STA. 5+320.0 LT ☒ RT S - S


646.42 DURABLE 200 mm WHITE LINE
 STA. 5+316.2 - STA. 5+319.8 RT, SHOULDER HATCHING (9.2 m)

675.50 REMOVING SIGNS
 AS SHOWN - 2 3

646.60 TEMPORARY 100 mm WHITE LINE
 (ALL LINES WILL INCLUDE EDGE LINE BREAKS AND RADIUS FOR TOWN HIGHWAYS)
 VT. ROUTE 9:
 STA. 5+072.652 - STA. 5+320.0 LT & RT

646.61 TEMPORARY 100 mm YELLOW LINE
 (ALL LINES WILL INCLUDE C/L BREAKS FOR TOWN HIGHWAYS) S=SOLID, D=DASHED
 VT. ROUTE 9:
 STA. 5+072.652 - STA. 5+320.0 LT ☒ RT S - S

675.60 ERECTING SALVAGED SIGNS
 AS SHOWN - 1

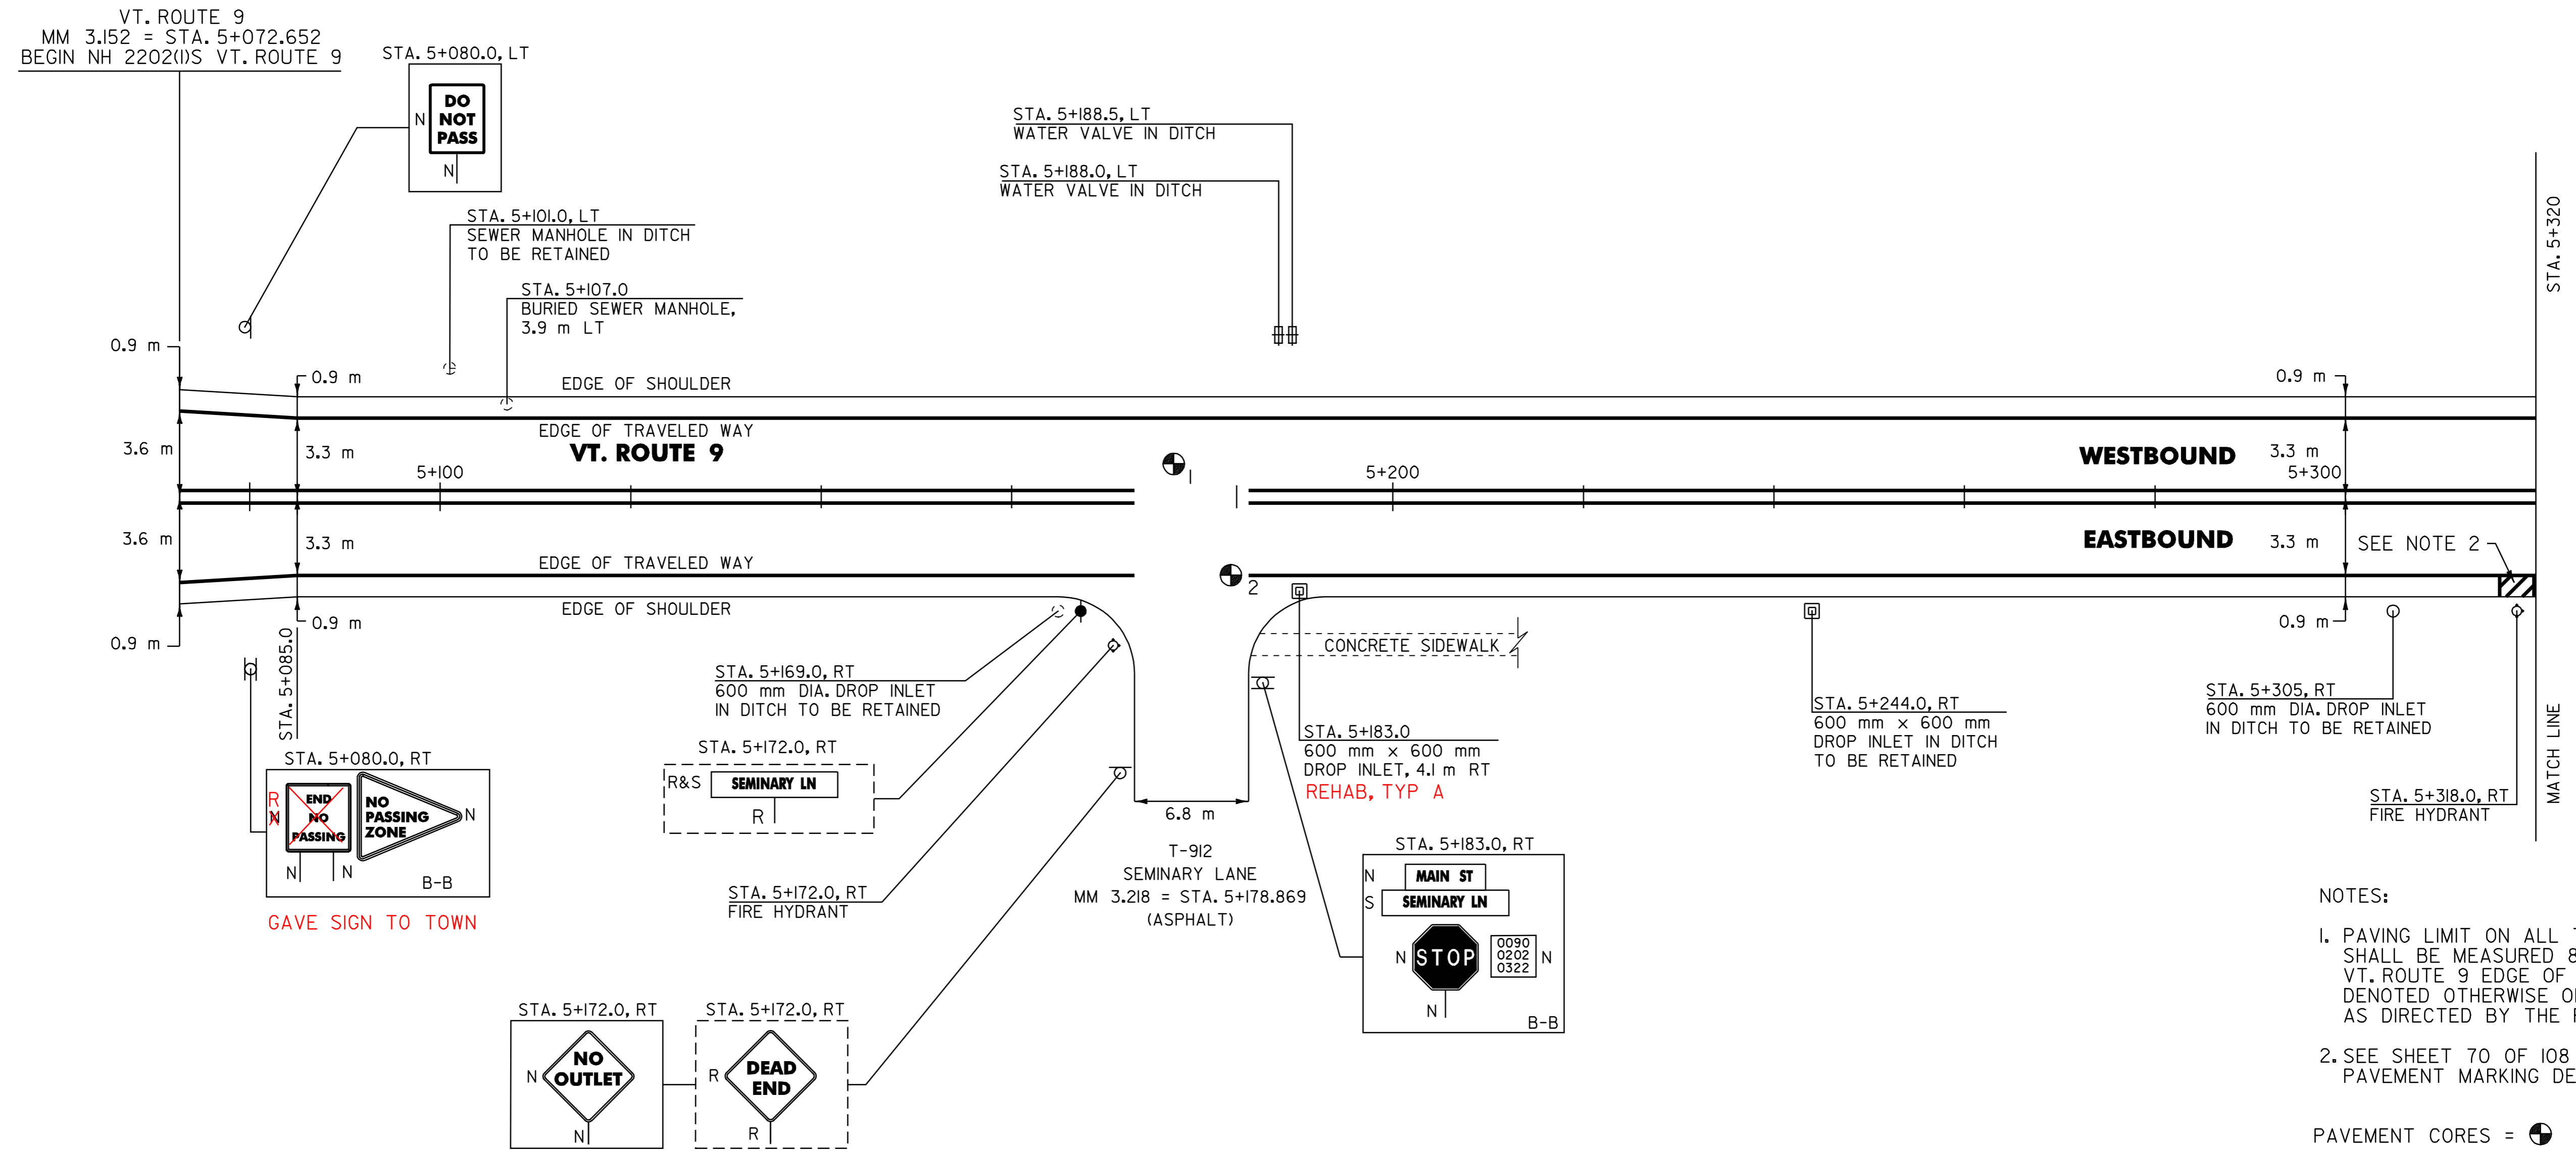

- NOTES:
- PAVING LIMIT ON ALL TOWN HIGHWAYS SHALL BE MEASURED 8 m BACK FROM VT. ROUTE 9 EDGE OF SHOULDER UNLESS DENOTED OTHERWISE ON THE PLANS OR AS DIRECTED BY THE RESIDENT ENGINEER.
 - SEE SHEET 70 OF 108 FOR FIRE HYDRANT PAVEMENT MARKING DETAIL.

PAVEMENT CORES =

#	TOTAL DEPTH (mm)	PCC	COMMENTS
1	140	Y	
2	152	Y	

412 REHAB
 604.40 CHANGE ELEVATION OF DI, CB OR MH CLASS I
 VT. ROUTE 9:
 STA. 5+183.0 RT

604.42 CHANGE ELEVATION OF SEWER MANHOLE
 VT. ROUTE 9:
 STA. 5+107.0 LT

DATUM

VERTICAL	N/A
HORIZONTAL	N/A

SIGN LEGEND
 R= REMOVE
 S= SALVAGE
 N= NEW
 RET= RETAIN
 B-B= BACK TO BACK
 EXISTING= - - - - -
 NEW= _____

PAVING PROJECT LAYOUT # 1

SURVEYED BY	N/A	DATE	N/A
DRAWN BY	J.A.R.	DATE	4/01
SQUAD LEADER	T.P.K.		
DESIGN FILE NO.	pave/99d156/pd156.dgn		
IPARM FILE	pd156101.i	DATE PLOTTED	NOV-2005 10:21
PROJ. NAME	BENNINGTON		
PROJ. NO.	NH 2202(1)S		
SHEET 14 OF 108		SHEETS	