

646.40 DURABLE 100 mm WHITE LINE
 (ALL LINES WILL INCLUDE EDGE LINE BREAKS AND RADIUS FOR TOWN HIGHWAYS)
 VT. ROUTE 9:
 STA. 5+520.0 - STA. 5+680.0 LT & RT
 STA. 5+530.0 - STA. 5+550.0 LT, DOTTED LINE
 STA. 5+545.0 - STA. 5+585.0 RT, DOTTED LINE
 STA. 5+570.0 - STA. 5+585.0 LT, DOTTED LINE

646.46 DURABLE 600 mm STOP BAR (TYPE ITAPE)
 VT. ROUTE 9:
 STA. 5+574.768 LT, T-2

646.66 TEMPORARY 600 mm STOP BAR
 VT. ROUTE 9:
 STA. 5+574.768 LT, T-2

646.50 DURABLE LETTER OR SYMBOL (TYPE ITAPE)
 VT. ROUTE 9:
 STA. 5+574.768 LT, T-2, "S,T,O,P" (4 EA)

646.70 TEMPORARY LETTER OR SYMBOL
 VT. ROUTE 9:
 STA. 5+574.768 LT, T-2, "S,T,O,P" (8 EA)

646.51 DURABLE CROSSWALK MARKINGS WITH DIAGONAL LINES (MOD.)
 VT. ROUTE 9:
 STA. 5+587.0

646.71 TEMPORARY CROSSWALK MARKINGS WITH DIAGONAL LINE
 VT. ROUTE 9:
 STA. 5+587.0

646.60 TEMPORARY 100 mm WHITE LINE
 (ALL LINES WILL INCLUDE EDGE LINE BREAKS AND RADIUS FOR TOWN HIGHWAYS)





VT. ROUTE 9:
 STA. 5+520.0 - STA. 5+680.0 LT & RT
 STA. 5+530.0 - STA. 5+550.0 LT, DOTTED LINE
 STA. 5+545.0 - STA. 5+585.0 RT, DOTTED LINE
 STA. 5+570.0 - STA. 5+585.0 LT, DOTTED LINE

646.41 DURABLE 100 mm YELLOW LINE
 (ALL LINES WILL INCLUDE C/L BREAKS FOR TOWN HIGHWAYS) S=SOLID, D=DASHED

VT. ROUTE 9:
 STA. 5+520.0 - STA. 5+680.0 LT S - S
 STA. 5+574.768 DOUBLE SOLID LT, T-2 S

646.61 TEMPORARY 100 mm YELLOW LINE
 (ALL LINES WILL INCLUDE C/L BREAKS FOR TOWN HIGHWAYS) S=SOLID, D=DASHED

VT. ROUTE 9:
 STA. 5+520.0 - STA. 5+680.0 LT S - S
 STA. 5+574.768 DOUBLE SOLID LT, T-2 S

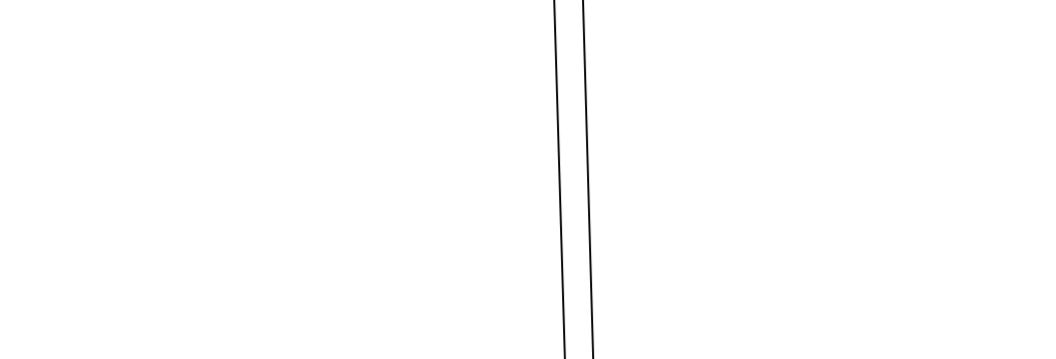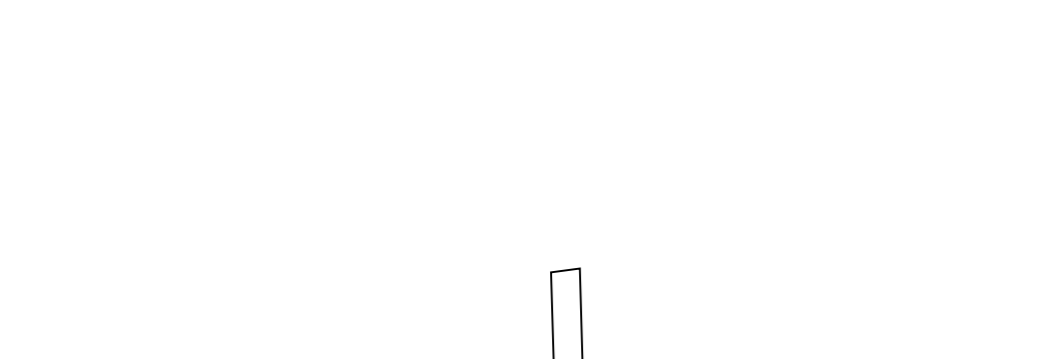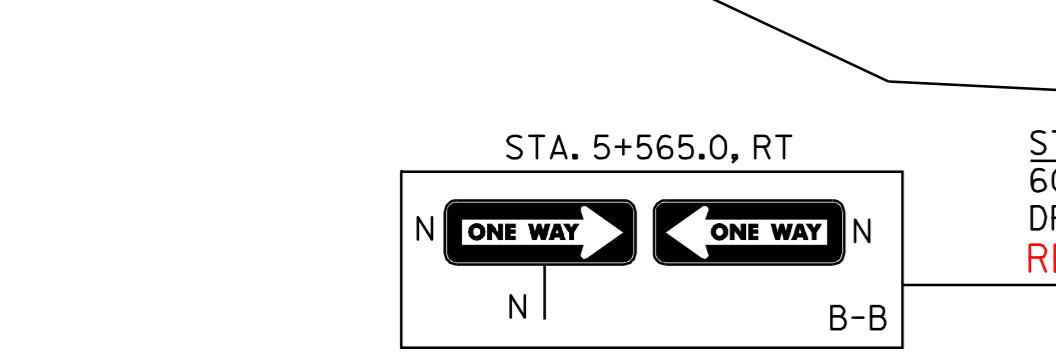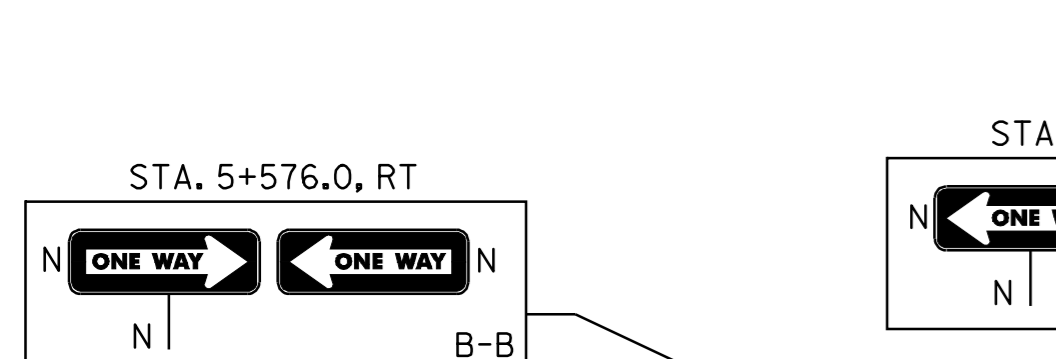

604.412 REHABILITATION OF DI, CB OR MH, CLASS I
~~604.40 CHANGE ELEVATION OF DI, CB OR MH~~

VT. ROUTE 9:
 STA. 5+548.0 RT
 STA. 5+582.0 LT
 STA. 5+586.0 LT
 STA. 5+587.0 RT
 STA. 5+674.0 RT

604.40 CHANGE ELEVATION OF DI, CB OR MH
~~604.412 REHABILITATION OF DI, CB OR MH, CLASS I~~

VT. ROUTE 9:
 STA. 5+648.0 RT

604.42 CHANGE ELEVATION OF SEWER MANHOLE

VT. ROUTE 9:
 STA. 5+648.0 LT

616.47 BITUMINOUS CONCRETE GUTTERS & TRAFFIC ISLANDS

VT. ROUTE 9:
 STA. 5+588.0 - STA. 5+680.0 RT (5.8 +)

ADJUST ELEVATION OF WATER VALVE
 STA 05+570 LT

604.42 CHANGE ELEVATION OF SEWER MANHOLE


VT. ROUTE 9:
 STA. 5+648.0 LT

616.47 BITUMINOUS CONCRETE GUTTERS & TRAFFIC ISLANDS

VT. ROUTE 9:
 STA. 5+588.0 - STA. 5+680.0 RT (5.8 +)

ADJUST ELEVATION OF WATER VALVE
 STA 05+570 LT

DATUM	
VERTICAL	N/A
HORIZONTAL	N/A

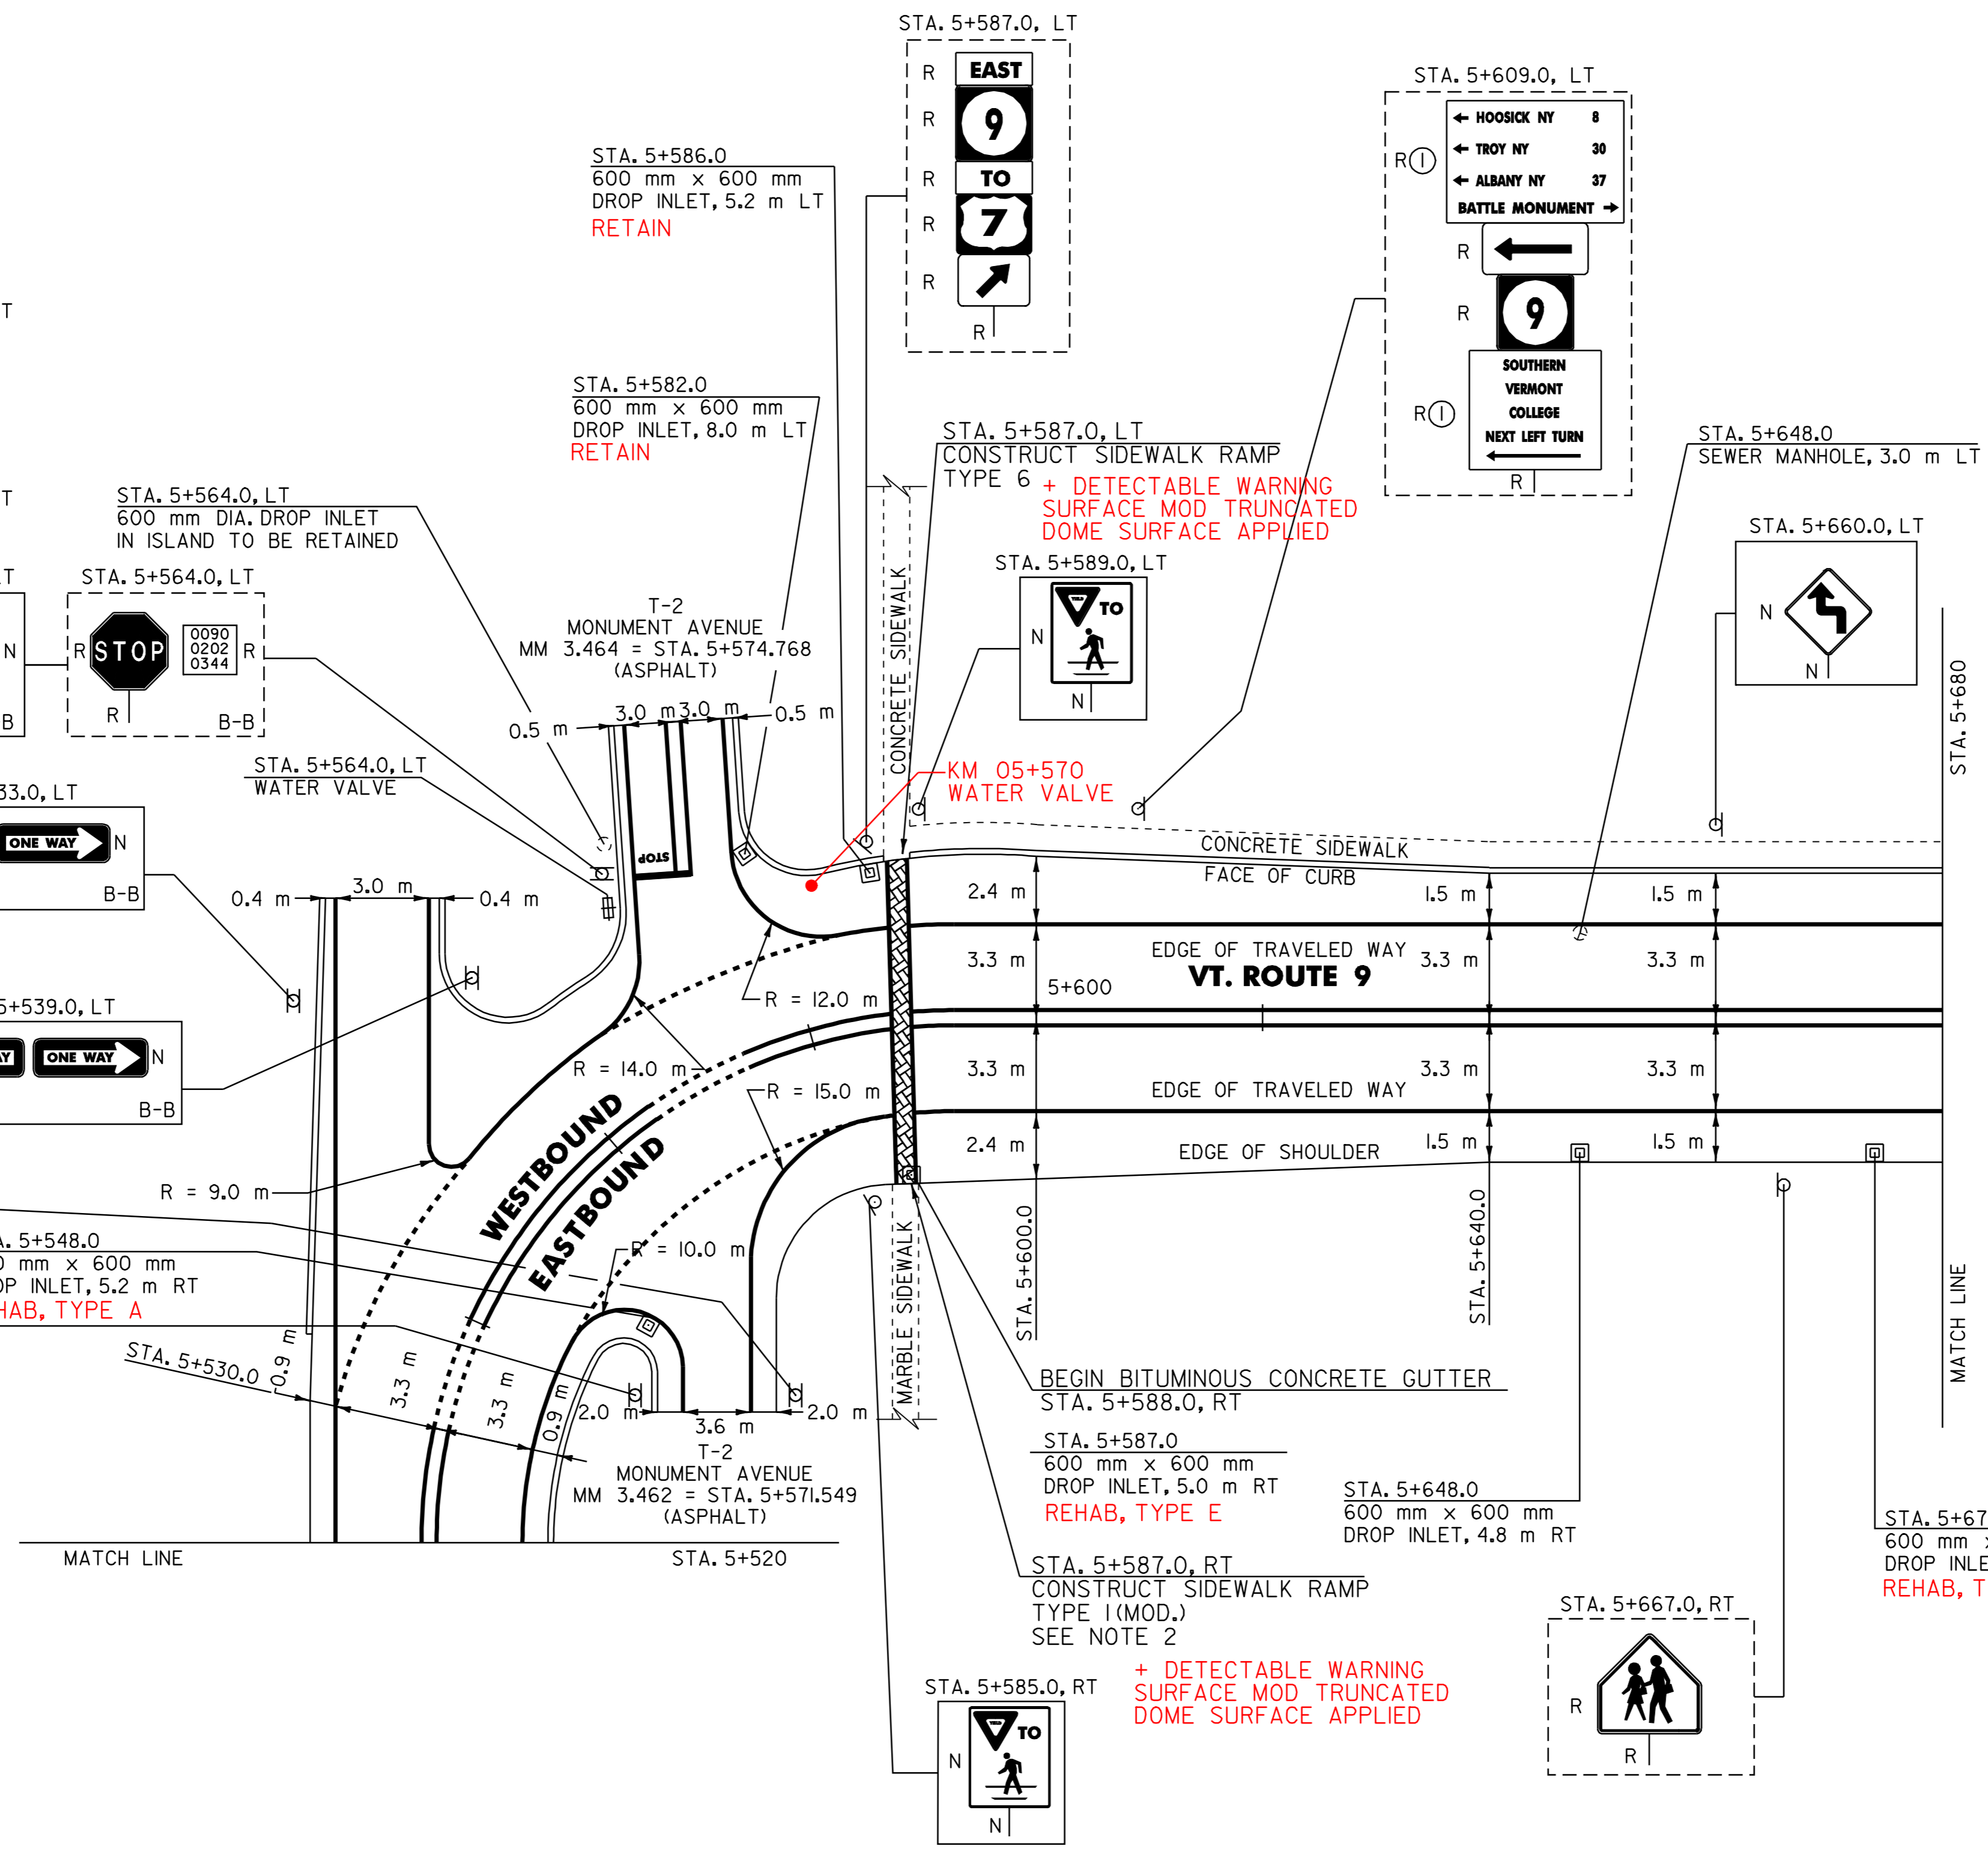

ITEM 618.30 DETECTABLE WARNING SURFACE MOD TRUNCATED DOME SURFACE APPLIED
 STA 5+587.0 LT .743m²
 STA 5+588.0 RT .743 m²

- NOTES:
- PAVING LIMIT ON ALL TOWN HIGHWAYS SHALL BE MEASURED 8 m BACK FROM VT. ROUTE 9 EDGE OF SHOULDER UNLESS DENOTED OTHERWISE ON THE PLANS OR AS DIRECTED BY THE RESIDENT ENGINEER.
 - IMPACTS TO THE EXISTING MARBLE SIDEWALK SHALL BE MINIMIZED DURING CONSTRUCTION OF THE NEW SIDEWALK RAMP. THE CONCRETE AT THIS RAMP SHALL BE COLORED TO MATCH THE COLOR OF THE EXISTING MARBLE SIDEWALK AS DIRECTED BY THE RESIDENT ENGINEER.

SIGN LEGEND
 R= REMOVE
 S= SALVAGE
 N= NEW
 RET= RETAIN
 B-B= BACK TO BACK
 EXISTING= - - - - -
 NEW= _____
 (1) SIGN TO BE RETURNED TO THE VILLAGE OF OLD BENNINGTON

PAVING PROJECT LAYOUT # 3

SURVEYED BY	N/A	DATE	N/A
DRAWN BY	J.A.R.	DATE	4/01
SQUAD LEADER	T.P.K.		
DESIGN FILE NO.	pave/99dl56/pdl56.dgn		
IPARM FILE	pdl56i03.i	DATE PLOTTED	NOV-2005 10:21
PROJ. NAME	BENNINGTON		
PROJ. NO.	NH 2202(1)S		
SHEET 16 OF 108	SHEETS		