

646.40 DURABLE 100 mm WHITE LINE
(ALL LINES WILL INCLUDE EDGE LINE BREAKS AND RADIUS FOR TOWN HIGHWAYS)

VT. ROUTE 9:
STA. 5+680.0 - STA. 5+860.0 LT & RT

646.60 TEMPORARY 100 mm WHITE LINE
(ALL LINES WILL INCLUDE EDGE LINE BREAKS AND RADIUS FOR TOWN HIGHWAYS)

VT. ROUTE 9:
STA. 5+680.0 - STA. 5+860.0 LT & RT

646.41 DURABLE 100 mm YELLOW LINE
(ALL LINES WILL INCLUDE C/L BREAKS FOR TOWN HIGHWAYS) S=SOLID, D=DASHED

VT. ROUTE 9:
STA. 5+680.0 - STA. 5+860.0 LT S - S
STA. 5+708.343 DOUBLE SOLID LT, T-910

646.61 TEMPORARY 100 mm YELLOW LINE
(ALL LINES WILL INCLUDE C/L BREAKS FOR TOWN HIGHWAYS) S=SOLID, D=DASHED

VT. ROUTE 9:
STA. 5+680.0 - STA. 5+860.0 LT S - S
STA. 5+708.343 DOUBLE SOLID LT, T-910

646.46 DURABLE 600 mm STOP BAR (TYPE I TAPE)

VT. ROUTE 9:
STA. 5+708.343 LT, T-910

646.66 TEMPORARY 600 mm STOP BAR

VT. ROUTE 9:
STA. 5+708.343 LT, T-910

646.50 DURABLE LETTER OR SYMBOL (TYPE I TAPE)

VT. ROUTE 9:
STA. 5+708.343 LT, T-910, "S,T,O,P" (4 EA)
STA. 5+720.0 RT, "S,C,H,O,O,L" (6 EA)

646.70 TEMPORARY LETTER OR SYMBOL

VT. ROUTE 9:
STA. 5+708.343 LT, T-910, "S,T,O,P" (8 EA)
STA. 5+720.0 RT, "S,C,H,O,O,L" (12 EA)

646.51 DURABLE CROSSWALK MARKINGS WITH DIAGONAL LINES (MOD.)


VT. ROUTE 9:
STA. 5+708.343 LT, T-910

646.71 TEMPORARY CROSSWALK MARKINGS WITH DIAGONAL LINES

VT. ROUTE 9:
STA. 5+708.343 LT, T-910

675.50 REMOVING SIGNS

AS SHOWN - 5

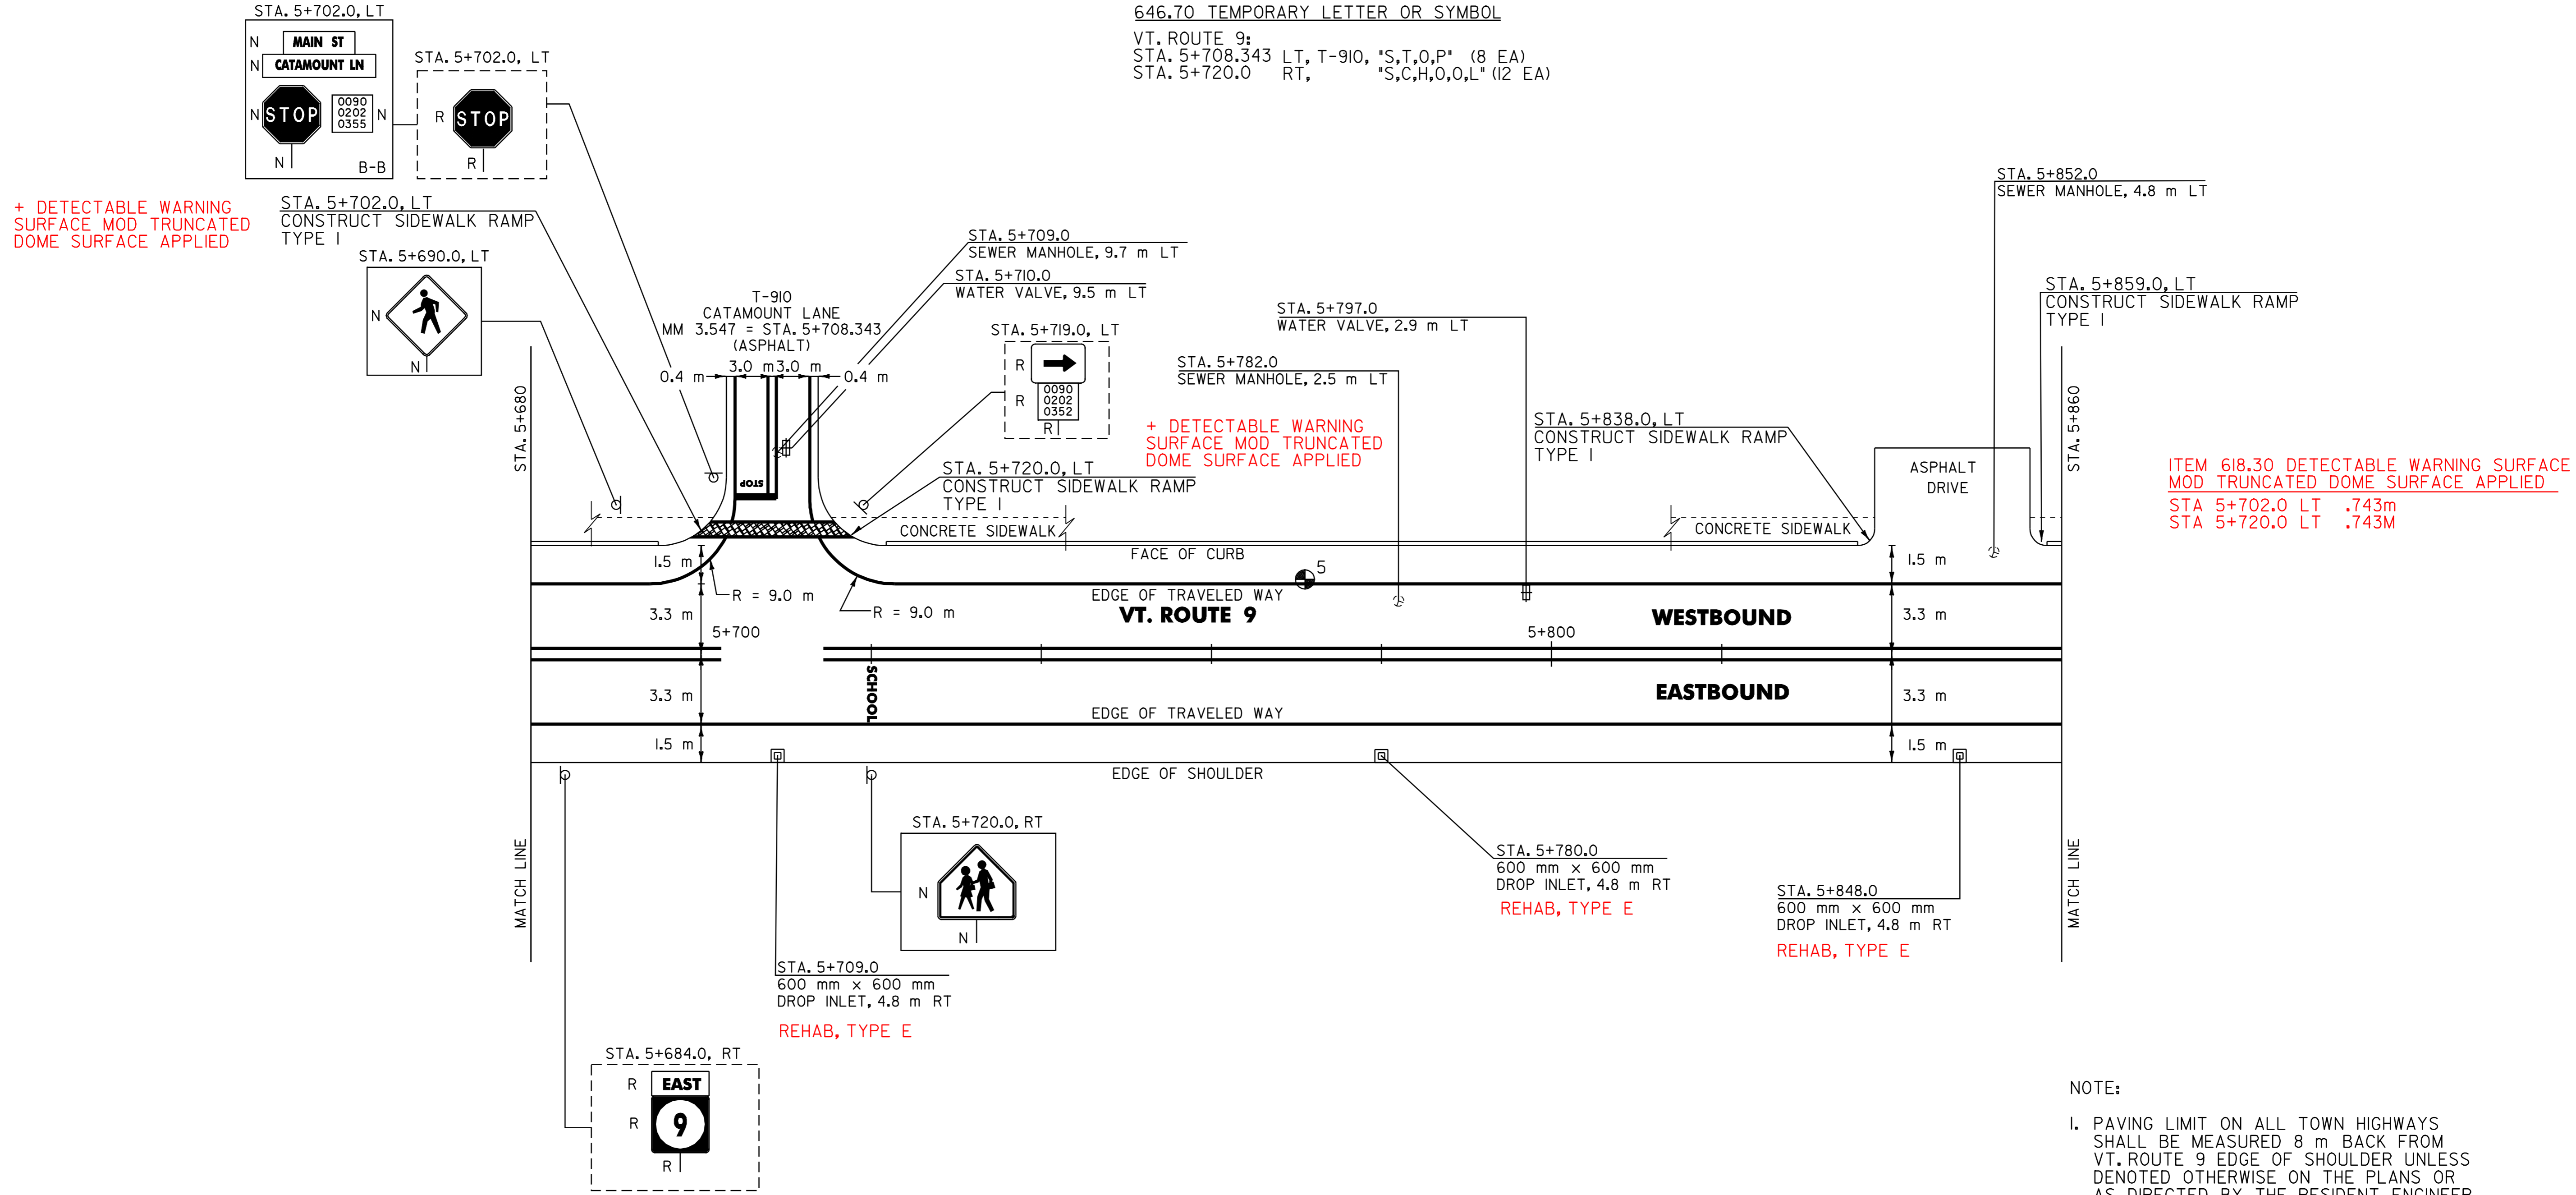

+ DETECTABLE WARNING SURFACE MOD TRUNCATED DOME SURFACE APPLIED

+ DETECTABLE WARNING SURFACE MOD TRUNCATED DOME SURFACE APPLIED

ITEM 618.30 DETECTABLE WARNING SURFACE MOD TRUNCATED DOME SURFACE APPLIED
STA 5+702.0 LT .743m
STA 5+720.0 LT .743M

~~604.412 REHABILITATION OF DI, CB OR MH, CLASS 1~~
~~604.40 CHANGE ELEVATION OF DI, CB OR MH~~

~~VT. ROUTE 9:~~
~~STA. 5+709.0 RT~~
~~STA. 5+780.0 RT~~

604.412 REHABILITATION OF DI, CB OR MH, CLASS 1

VT. ROUTE 9:
STA. 5+848.0 RT
VT. ROUTE 9:
STA. 5+709.0 RT
STA. 5+780.0 RT

604.42 CHANGE ELEVATION OF SEWER MANHOLE

VT. ROUTE 9:
STA. 5+709.0 LT
STA. 5+782.0 LT
STA. 5+852.0 LT

629.20 ADJUST ELEVATION OF VALVE BOX

VT. ROUTE 9:
STA. 5+710.0 LT
STA. 5+797.0 LT

616.47 BITUMINOUS CONCRETE GUTTERS & TRAFFIC ISLANDS

VT. ROUTE 9:
STA. 5+680.0 - STA. 5+860.0 RT (13.0 ft)

NOTE:
1. PAVING LIMIT ON ALL TOWN HIGHWAYS SHALL BE MEASURED 8 m BACK FROM VT. ROUTE 9 EDGE OF SHOULDER UNLESS DENOTED OTHERWISE ON THE PLANS OR AS DIRECTED BY THE RESIDENT ENGINEER.

PAVEMENT CORES =

#	TOTAL DEPTH (mm)	PCC	COMMENTS
5	127	Y	

DATUM

VERTICAL	N/A
HORIZONTAL	N/A

SIGN LEGEND
R= REMOVE
S= SALVAGE
N= NEW
RET= RETAIN
B-B= BACK TO BACK
EXISTING= - - - - -
NEW= _____

PAVING PROJECT LAYOUT # 4

SURVEYED BY	N/A	DATE	N/A
DRAWN BY	J.A.R.	DATE	4/01
SQUAD LEADER	T.P.K.		
DESIGN FILE NO.	pave/99d156/pd156.dgn		
IPARM FILE	pd156104.i	DATE PLOTTED	NOV-2005 10:21
PROJ. NAME	BENNINGTON		
PROJ. NO.	NH 2202(1)S		
SHEET 17 OF 108	SHEETS		