

646.40 DURABLE 100 mm WHITE LINE
 (ALL LINES WILL INCLUDE EDGE LINE BREAKS AND RADIUS FOR TOWN HIGHWAYS)
 VT. ROUTE 9:
 STA. 5+860.0 - STA. 6+040.0 LT & RT

646.60 TEMPORARY 100 mm WHITE LINE
 (ALL LINES WILL INCLUDE EDGE LINE BREAKS AND RADIUS FOR TOWN HIGHWAYS)
 VT. ROUTE 9:
 STA. 5+860.0 - STA. 6+040.0 LT & RT


646.41 DURABLE 100 mm YELLOW LINE
 (ALL LINES WILL INCLUDE C/L BREAKS FOR TOWN HIGHWAYS) S=SOLID, D=DASHED
 VT. ROUTE 9:
 STA. 5+860.0 - STA. 6+040.0 LT ☉ RT S - S

646.61 TEMPORARY 100 mm YELLOW LINE
 (ALL LINES WILL INCLUDE C/L BREAKS FOR TOWN HIGHWAYS) S=SOLID, D=DASHED
 VT. ROUTE 9:
 STA. 5+860.0 - STA. 6+040.0 LT ☉ RT S - S

646.50 DURABLE LETTER OR SYMBOL (TYPE I TAPE)
 VT. ROUTE 9:
 STA. 5+985.0 LT, "S,C,H,O,O,L" (6 EA)

646.70 TEMPORARY LETTER OR SYMBOL
 VT. ROUTE 9:
 STA. 5+985.0 LT, "S,C,H,O,O,L" (12 EA)

675.50 REMOVING SIGNS
 AS SHOWN - 2

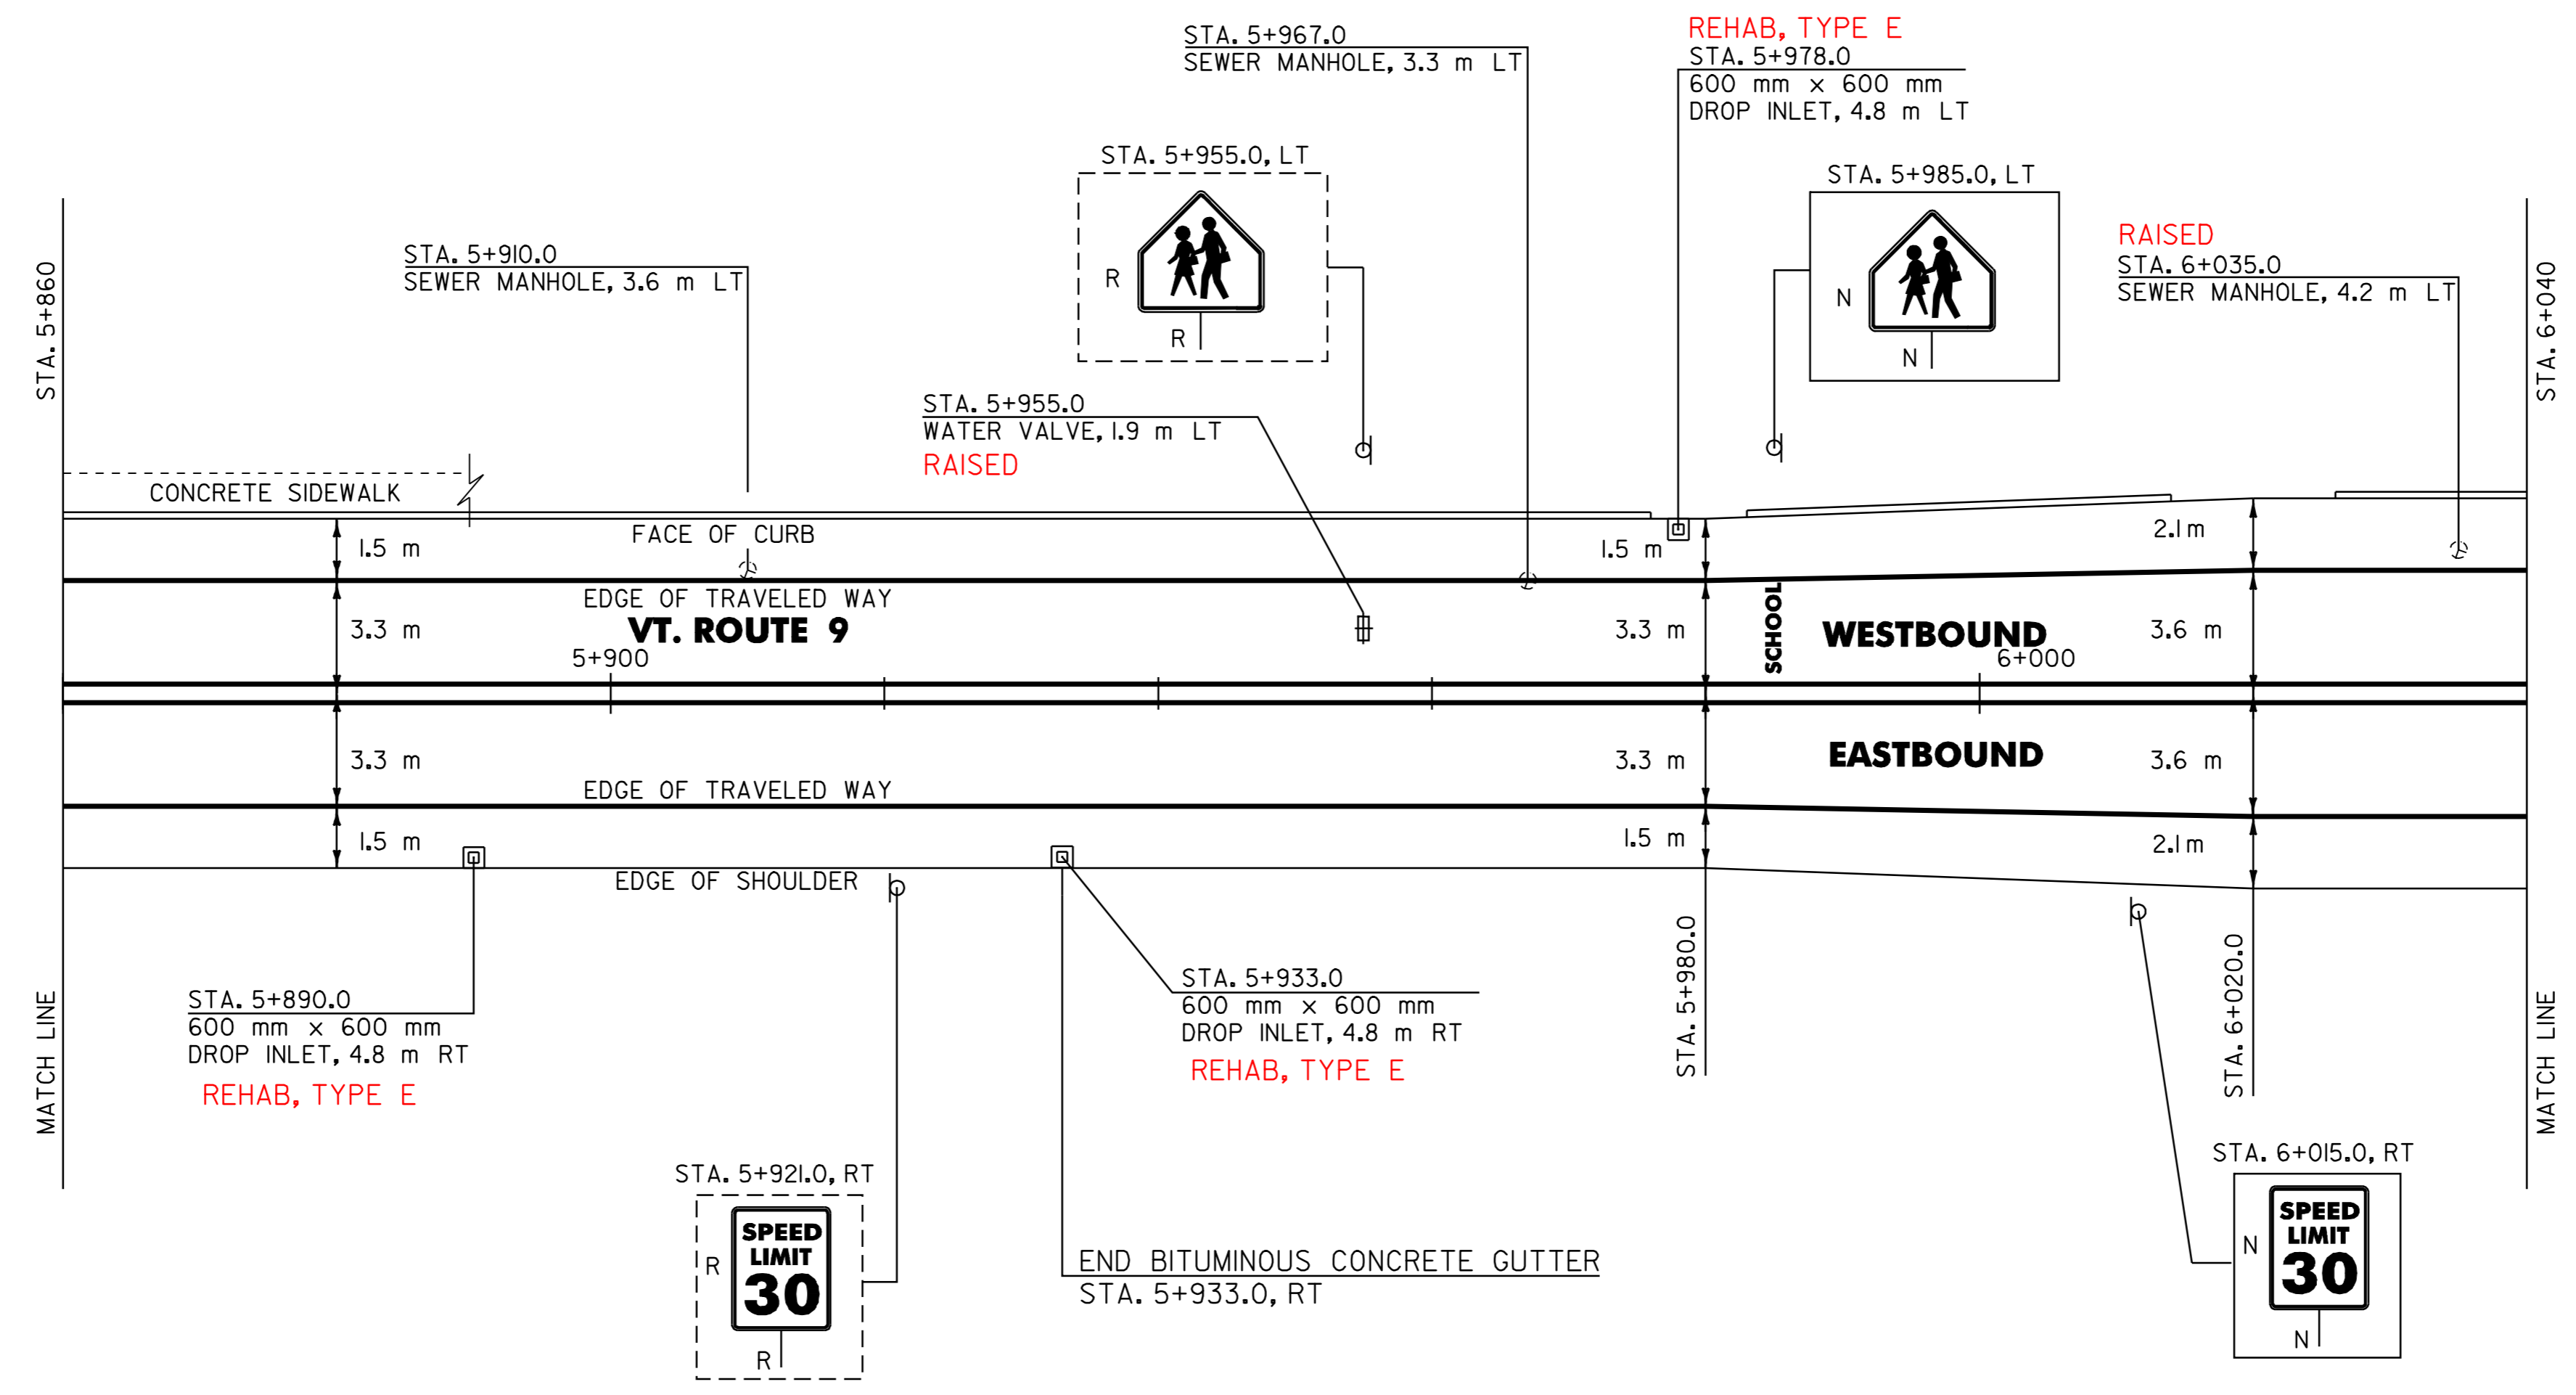

604.412 REHABILITATION OF DI, CB OR MH, CLASS I
~~604.40 CHANGE ELEVATION OF DI, CB OR MH~~
 VT. ROUTE 9:
 STA. 5+890.0 RT
 STA. 5+978.0 LT

629.20 ADJUST ELEVATION OF VALVE BOX
 VT. ROUTE 9:
 STA. 5+955.0 LT

604.412 REHABILITATION OF DI, CB OR MH, CLASS I
 VT. ROUTE 9:
 STA. 5+933.0 RT

616.47 BITUMINOUS CONCRETE GUTTERS & TRAFFIC ISLANDS
 VT. ROUTE 9:
 STA. 5+860.0 - 5+933.0 RT (5.0 +)

604.42 CHANGE ELEVATION OF SEWER MANHOLE
 VT. ROUTE 9:
 STA. 5+910.0 LT
 STA. 5+967.0 LT
 STA. 6+035.0 LT

DATUM	
VERTICAL	N/A
HORIZONTAL	N/A

SIGN LEGEND
 R= REMOVE
 S= SALVAGE
 N= NEW
 RET= RETAIN
 B-B= BACK TO BACK
 EXISTING= - - - - -
 NEW= _____

PAVING PROJECT LAYOUT # 5

SURVEYED BY	N/A	DATE	N/A
DRAWN BY	J.A.R.	DATE	4/01
SQUAD LEADER	T.P.K.		
DESIGN FILE NO.	pave/99d156/pd156.dgn		
IPARM FILE	pd156105.i	DATE PLOTTED	NOV-2005 10:21 AM
PROJ. NAME	BENNINGTON		
PROJ. NO.	NH 2202(1)S		
SHEET 18 OF 108	SHEETS		