

646.40 DURABLE 100 mm WHITE LINE  
(ALL LINES WILL INCLUDE EDGE LINE BREAKS AND RADIUS FOR TOWN HIGHWAYS)  
VT. ROUTE 9:  
STA. 6+040.0 - STA. 6+200.0 LT & RT

646.60 TEMPORARY 100 mm WHITE LINE  
(ALL LINES WILL INCLUDE EDGE LINE BREAKS AND RADIUS FOR TOWN HIGHWAYS)  
VT. ROUTE 9:  
STA. 6+040.0 - STA. 6+200.0 LT & RT

646.41 DURABLE 100 mm YELLOW LINE  
(ALL LINES WILL INCLUDE C/L BREAKS FOR TOWN HIGHWAYS) S=SOLID, D=DASHED  
VT. ROUTE 9:  
STA. 6+040.0 - STA. 6+200.0 LT S  
STA. 6+186.318 DOUBLE SOLID LT, T-320 S

646.61 TEMPORARY 100 mm YELLOW LINE  
(ALL LINES WILL INCLUDE C/L BREAKS FOR TOWN HIGHWAYS) S=SOLID, D=DASHED  
VT. ROUTE 9:  
STA. 6+040.0 - STA. 6+200.0 LT S  
STA. 6+186.318 DOUBLE SOLID LT, T-320 S

646.46 DURABLE 600 mm STOP BAR (TYPE ITAPE)  
VT. ROUTE 9:  
STA. 6+186.318 LT, T-320 S

646.66 TEMPORARY 600 mm STOP BAR  
VT. ROUTE 9:  
STA. 6+186.318 LT, T-320 S

646.50 DURABLE LETTER OR SYMBOL (TYPE ITAPE)  
VT. ROUTE 9:  
STA. 6+186.318 LT, T-320, "S,T,O,P" (4 EA)

646.70 TEMPORARY LETTER OR SYMBOL  
VT. ROUTE 9:  
STA. 6+186.318 LT, T-320, "S,T,O,P" (8 EA)

646.51 DURABLE CROSSWALK MARKINGS WITH DIAGONAL LINES (MOD.2)  
VT. ROUTE 9:  
STA. 6+186.318 LT, T-320 S


646.71 TEMPORARY CROSSWALK MARKINGS WITH DIAGONAL LINES  
VT. ROUTE 9:  
STA. 6+186.318 LT, T-320 S

675.50 REMOVING SIGNS  
AS SHOWN - 8

675.60 ERECTING SALVAGED SIGNS  
AS SHOWN - 1

ITEM 618.30 DETECTABLE WARNING SURFACE  
MOD TRUNCATED DOME SURFACE APPLIED  
STA. 6+182 LT .929M2

ITEM 618.30 DETECTABLE WARNING SURFACE  
MOD TRUNCATED DOME CAST IN PLACE  
STA. 6+191 LT .743M2

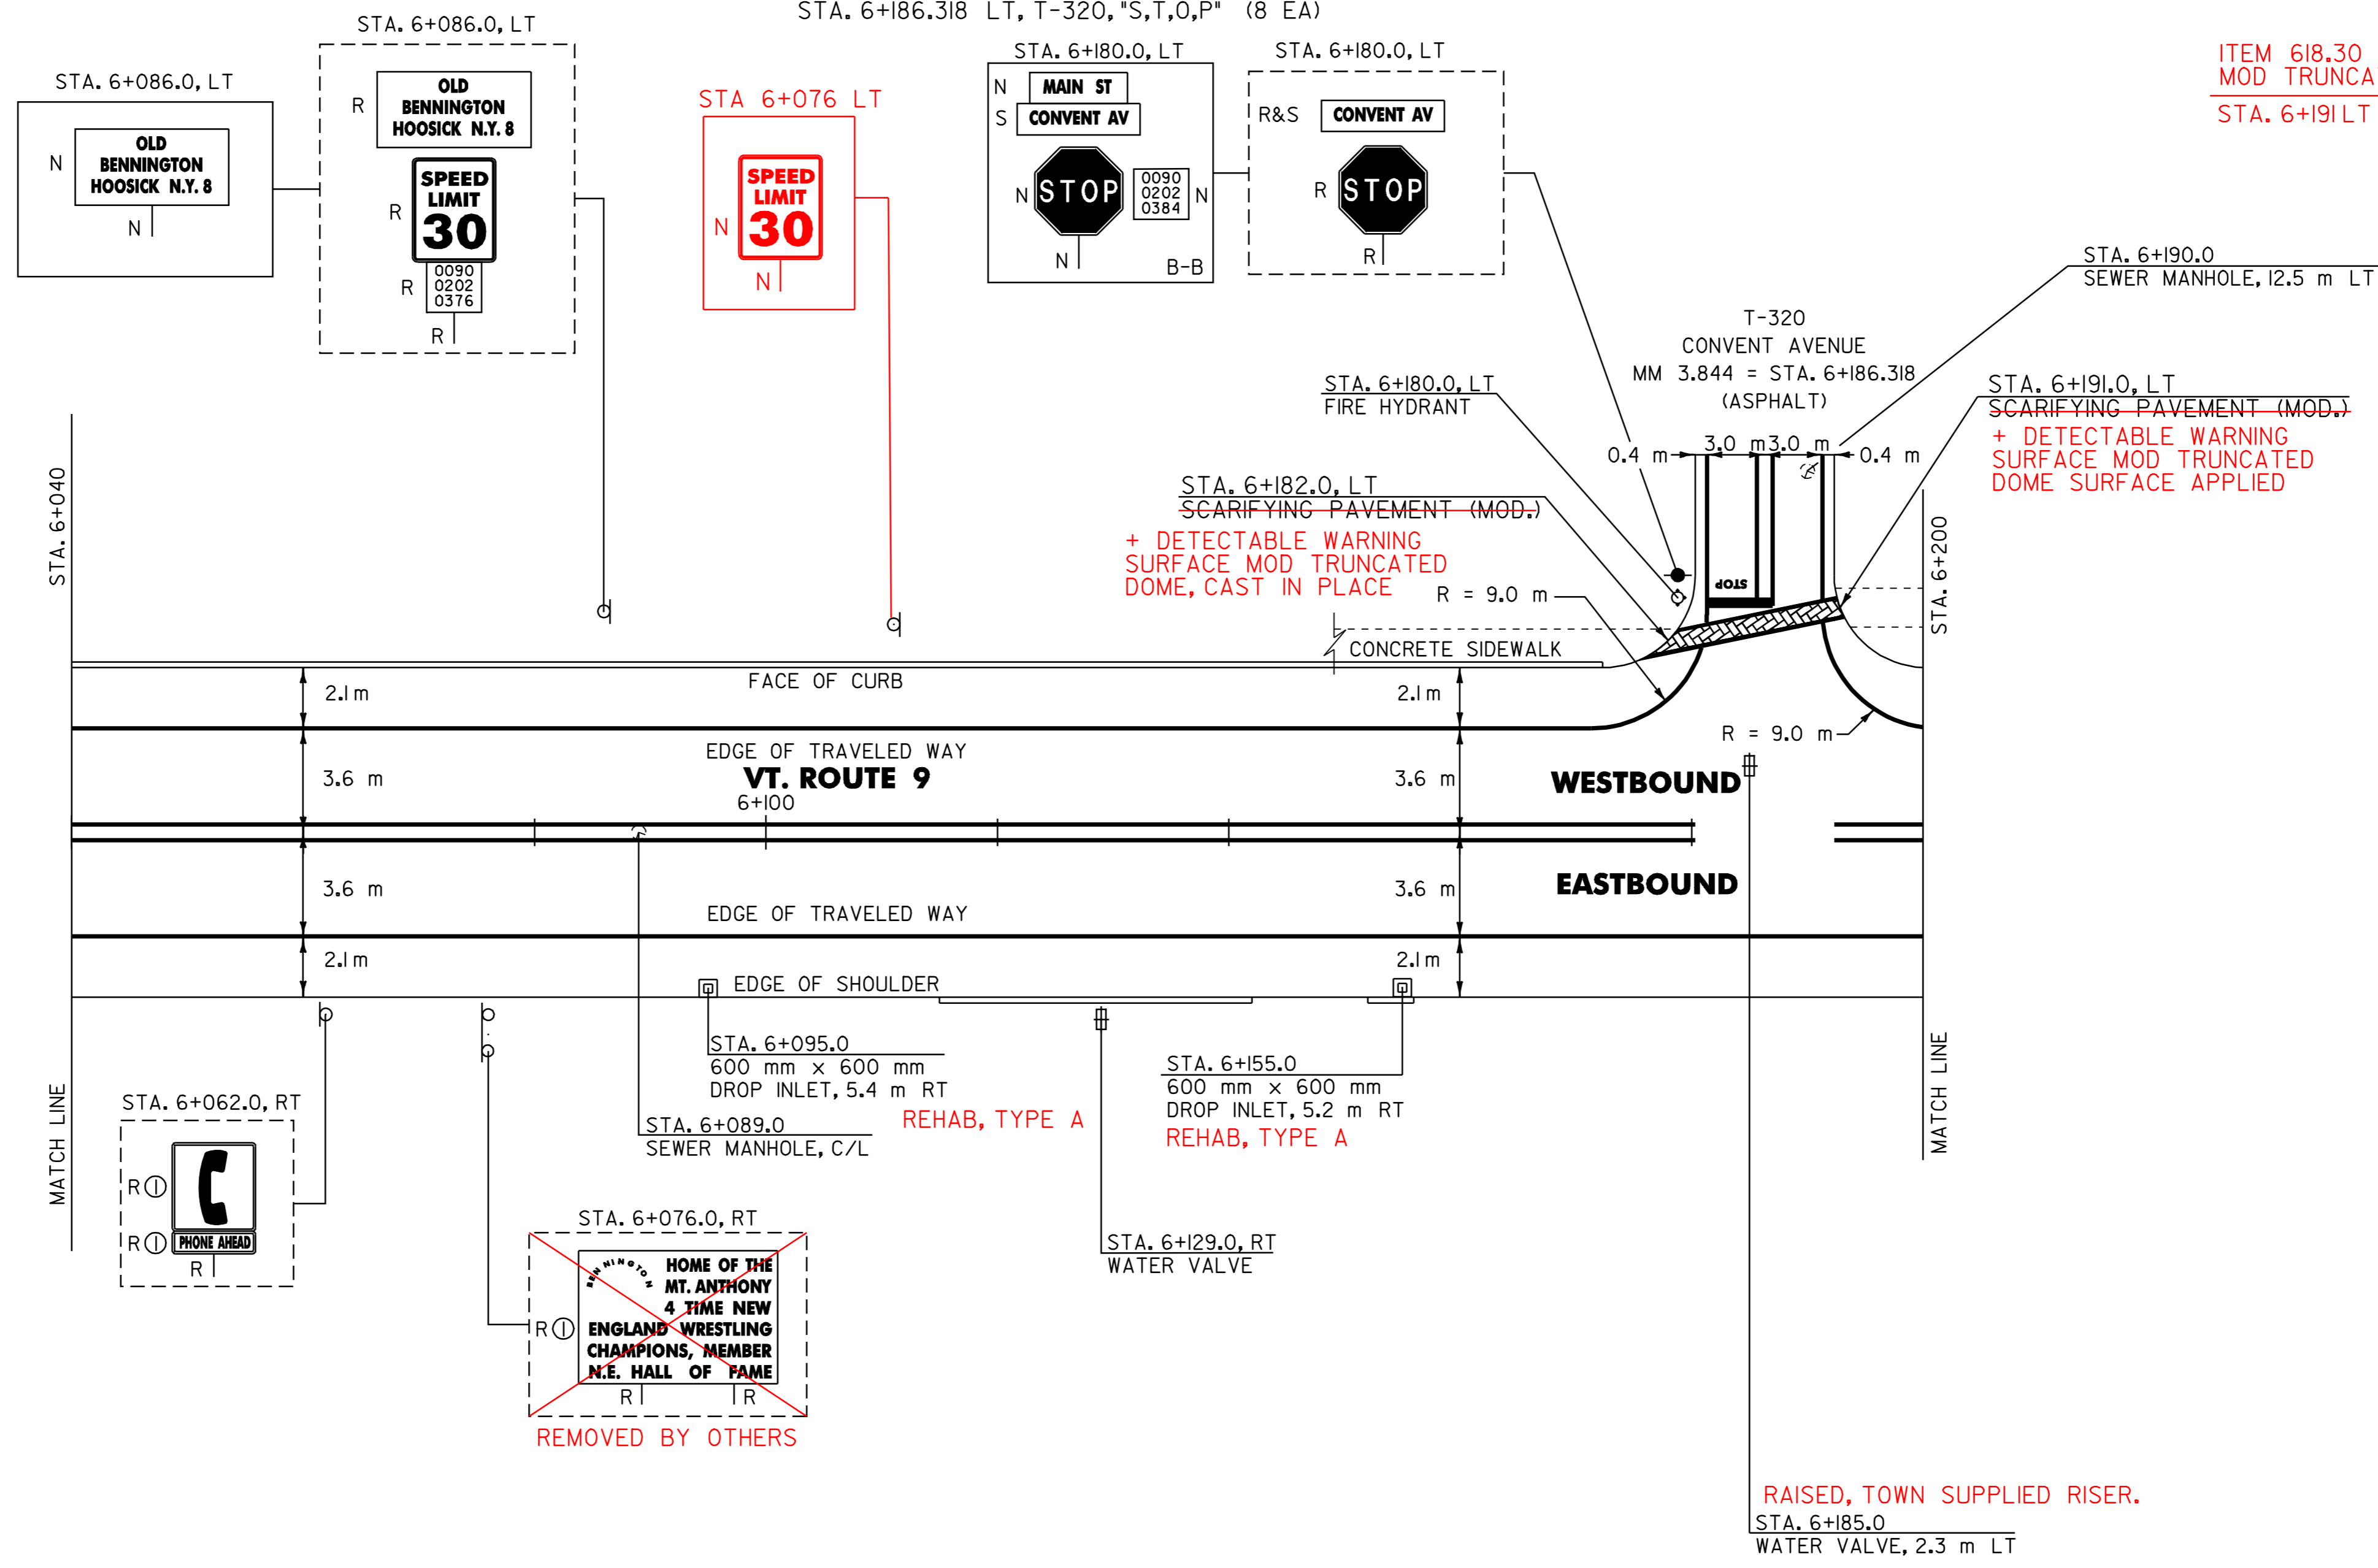

REPLACED WITH 618.30 DET. WARN. SURFACE  
~~212.20 SCARIFYING PAVEMENT (MOD.)~~

VT. ROUTE 9:  
~~STA. 6+182.0 LT (5 m<sup>2</sup>)~~  
~~STA. 6+191.0 LT (5 m<sup>2</sup>)~~

~~604.40 CHANGE ELEVATION OF DI, CB OR MH~~

VT. ROUTE 9:  
~~STA. 6+155.0 RT~~

604.412 REHABILITATION OF DI, CB OR MH, CLASS 1

VT. ROUTE 9: STA. 6+095.0 RT  
VT. ROUTE 9: STA. 6+155.0 RT 4 X 6 2 GRATES

604.42 CHANGE ELEVATION OF SEWER MANHOLE

VT. ROUTE 9:  
STA. 6+089.0 C/L  
STA. 6+190.0 LT

629.20 ADJUST ELEVATION OF VALVE BOX

VT. ROUTE 9:  
STA. 6+185.0 LT

SIGN LEGEND

- R= REMOVE
  - S= SALVAGE
  - N= NEW
  - RET= RETAIN
  - B-B= BACK TO BACK
  - EXISTING= -----
  - NEW= \_\_\_\_\_
- ① SIGN TO BE RETURNED TO THE TOWN OF BENNINGTON

NOTE:  
1. PAVING LIMIT ON ALL TOWN HIGHWAYS SHALL BE MEASURED 8 m BACK FROM VT. ROUTE 9 EDGE OF SHOULDER UNLESS DENOTED OTHERWISE ON THE PLANS OR AS DIRECTED BY THE RESIDENT ENGINEER.

PAVING PROJECT LAYOUT # 6

SURVEYED BY	N/A	DATE	N/A
DRAWN BY	J.A.R.	DATE	4/01
SQUAD LEADER	T.P.K.		
DESIGN FILE NO.	pave/99dl56/pdl56.dgn		
IPARM FILE	pdl56106.i	DATE	NOV-2005 10
PROJ. NAME	BENNINGTON		
PROJ. NO.	NH 2202(1)S		
SHEET	19 OF 108	SHEETS	

DATUM	
VERTICAL	N/A
HORIZONTAL	N/A