

646.40 DURABLE 100 mm WHITE LINE  
(ALL LINES WILL INCLUDE EDGE LINE BREAKS AND RADIUS FOR TOWN HIGHWAYS)

VT. ROUTE 9:  
STA. 6+400.0 - STA. 6+580.0 LT & RT

646.60 TEMPORARY 100 mm WHITE LINE  
(ALL LINES WILL INCLUDE EDGE LINE BREAKS AND RADIUS FOR TOWN HIGHWAYS)

VT. ROUTE 9:  
STA. 6+400.0 - STA. 6+580.0 LT & RT

646.41 DURABLE 100 mm YELLOW LINE  
(ALL LINES WILL INCLUDE C/L BREAKS FOR TOWN HIGHWAYS) S=SOLID, D=DASHED

VT. ROUTE 9:  
STA. 6+400.0 - STA. 6+565.0 S - S  
STA. 6+565.0 - STA. 6+580.0 DOUBLE SOLID RT & LT (MEDIAN TAPER)  
STA. 6+522.671 DOUBLE SOLID RT, T-398

646.61 TEMPORARY 100 mm YELLOW LINE  
(ALL LINES WILL INCLUDE C/L BREAKS FOR TOWN HIGHWAYS) S=SOLID, D=DASHED

VT. ROUTE 9:  
STA. 6+400.0 - STA. 6+565.0 S - S  
STA. 6+565.0 - STA. 6+580.0 DOUBLE SOLID RT & LT (MEDIAN TAPER)  
STA. 6+522.671 DOUBLE SOLID RT, T-398

646.43 DURABLE 200 mm YELLOW LINE  
VT. ROUTE 9:  
STA. 6+565.0 - STA. 6+580.0 C/L, HATCHED MEDIAN (15 m)

646.46 DURABLE 600 mm STOP BAR (TYPE I TAPE)  
VT. ROUTE 9:  
STA. 6+522.671 RT, T-398


646.66 TEMPORARY 600 mm STOP BAR  
VT. ROUTE 9:  
STA. 6+522.671 RT, T-398

646.50 DURABLE LETTER OR SYMBOL (TYPE I TAPE)  
VT. ROUTE 9:  
STA. 6+522.671 RT, T-398, "S,T,O,P" (4 EA)

646.70 TEMPORARY LETTER OR SYMBOL  
VT. ROUTE 9:  
STA. 6+522.671 RT, T-398, "S,T,O,P" (8 EA)

675.50 REMOVING SIGNS  
AS SHOWN - 10

675.60 ERECTING SALVAGED SIGNS  
AS SHOWN - 1

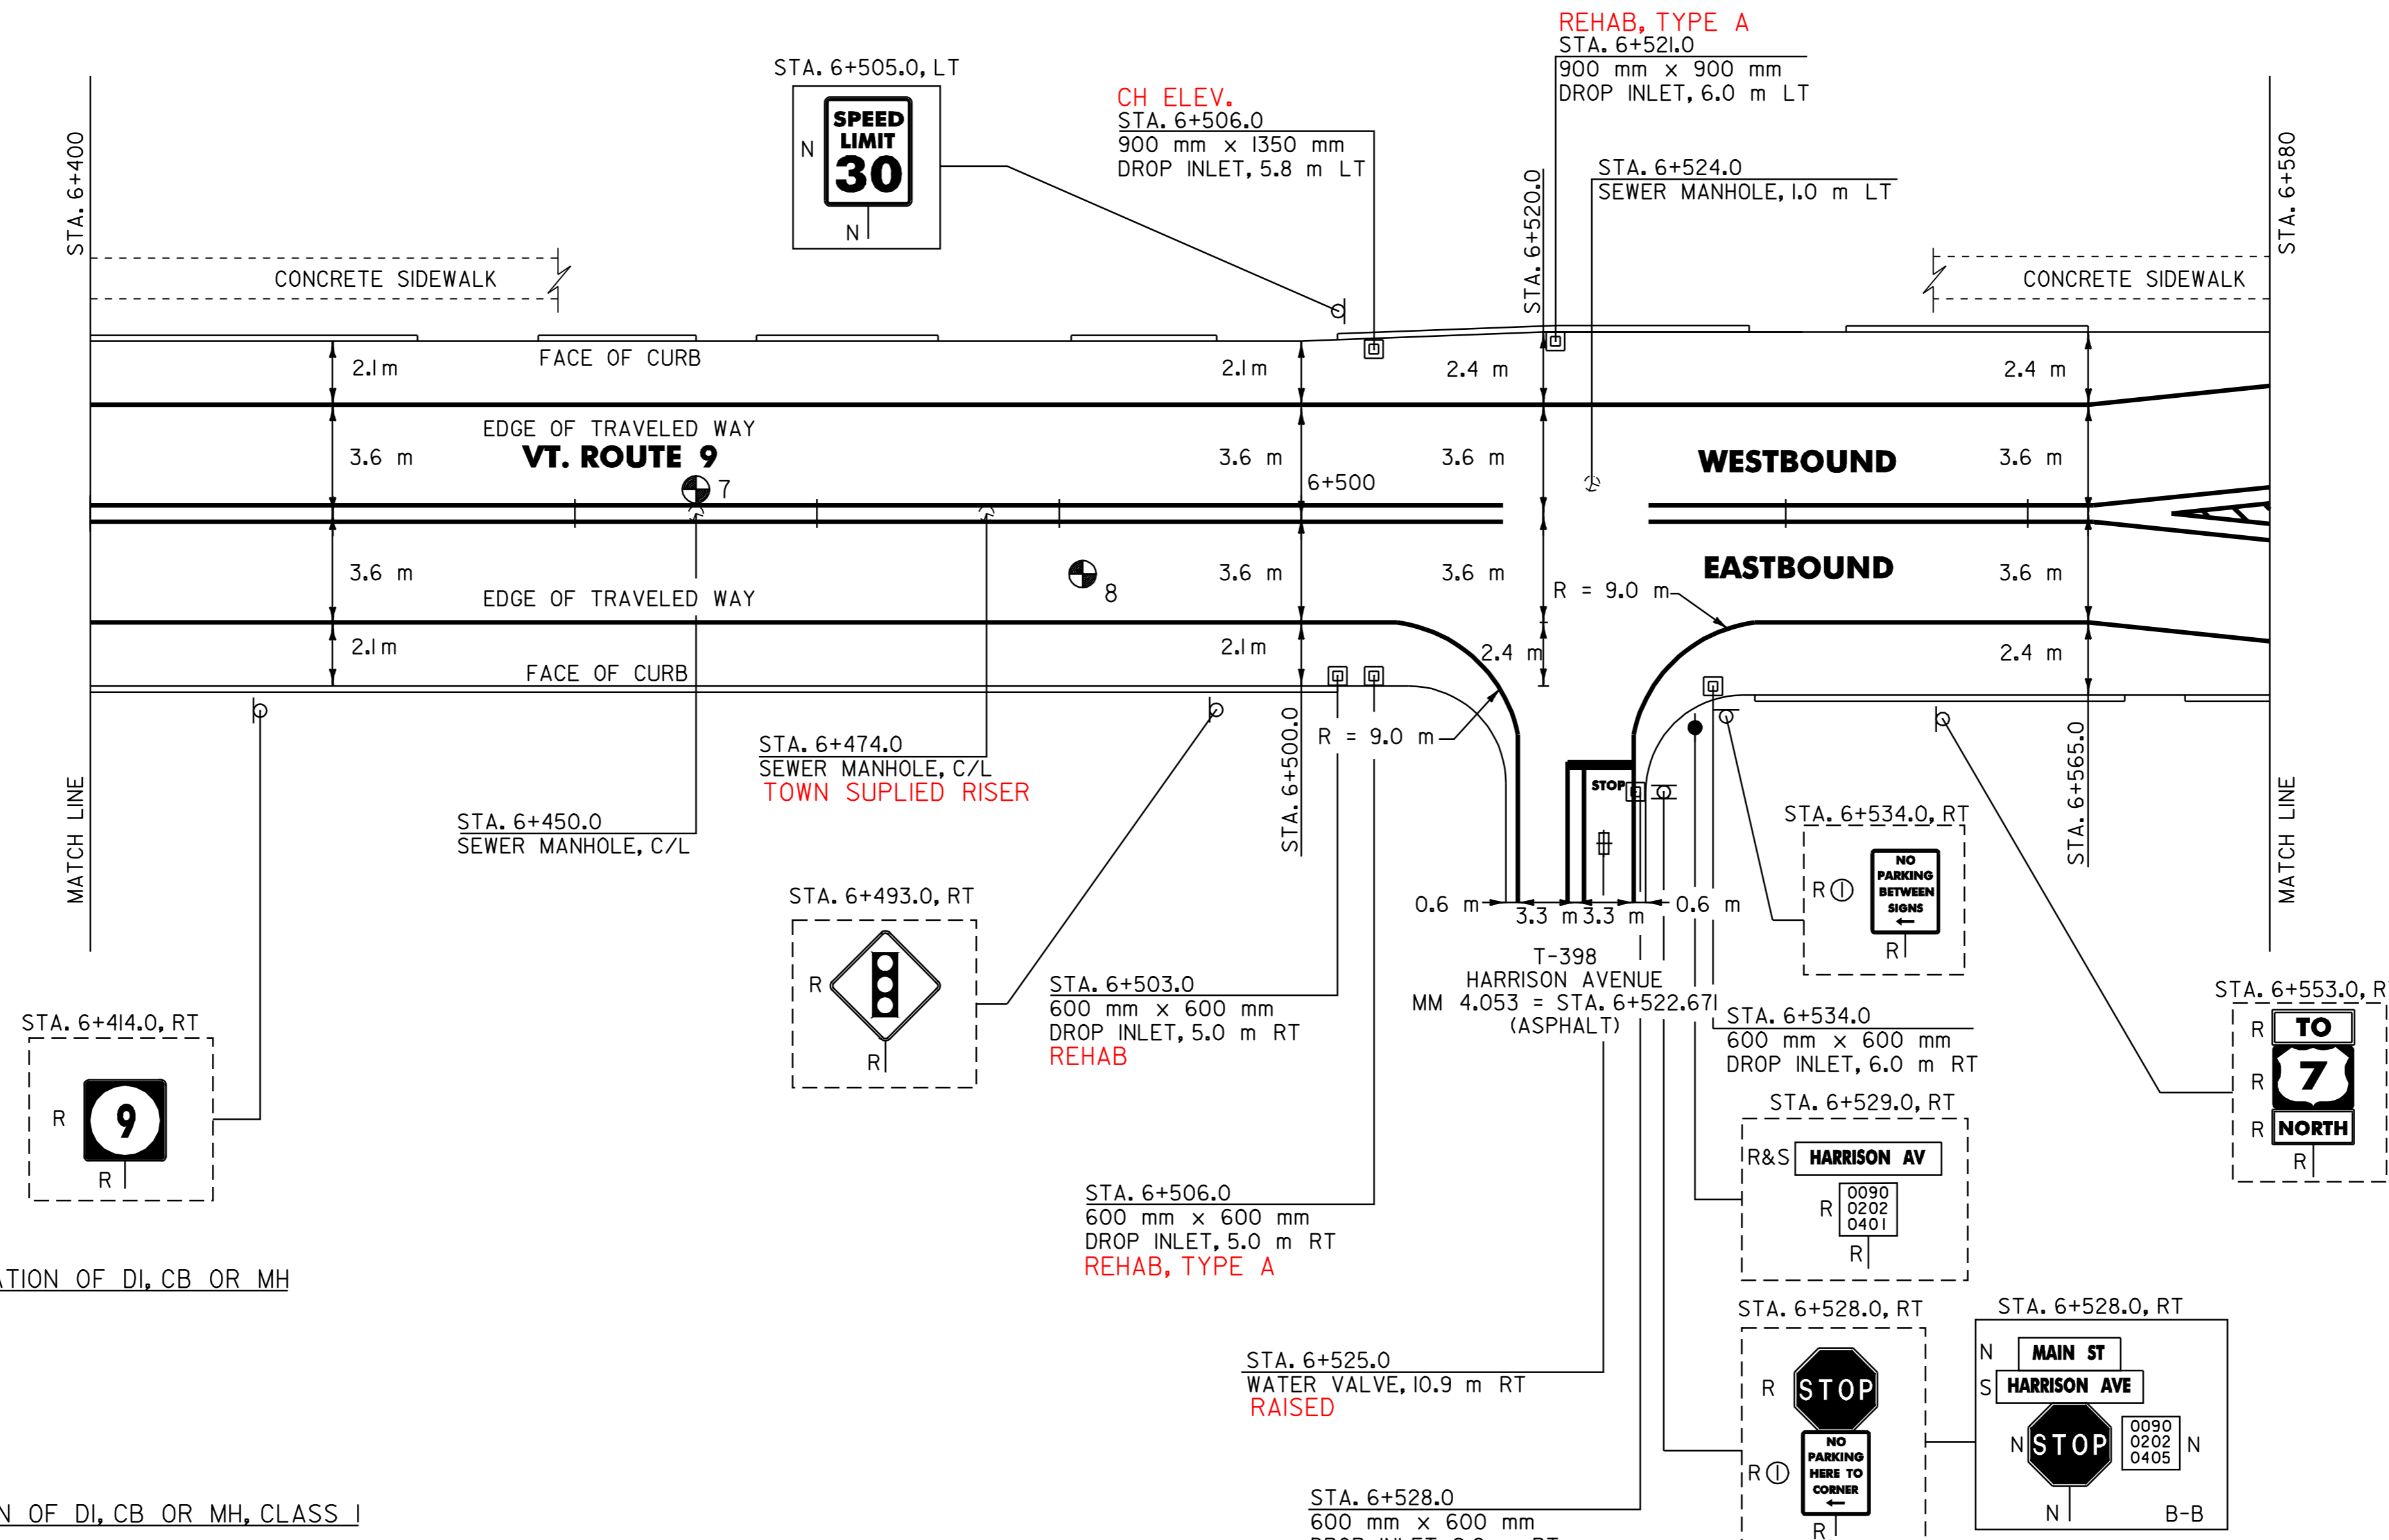

604.40 CHANGE ELEVATION OF DI, CB OR MH

VT. ROUTE 9:  
~~STA. 6+503.0 RT~~  
~~STA. 6+506.0 RT LT~~  
~~STA. 6+528.0 RT~~  
~~STA. 6+534.0 RT~~

604.412 REHABILITATION OF DI, CB OR MH, CLASS I

VT. ROUTE 9:  
~~STA. 6+506.0 LT~~ STA. 6+503.0 RT  
~~STA. 6+521.0 LT~~ STA. 6+506.0 RT  
STA. 6+528.0 RT 3'-6" W/2 GRATES

604.42 CHANGE ELEVATION OF SEWER MANHOLE

VT. ROUTE 9:  
STA. 6+450.0 C/L  
STA. 6+474.0 C/L  
STA. 6+524.0 LT RT

629.20 ADJUST ELEVATION OF VALVE BOX

VT. ROUTE 9:  
STA. 6+525.0 RT

NOTE:

I. PAVING LIMIT ON ALL TOWN HIGHWAYS SHALL BE MEASURED 8 m BACK FROM VT. ROUTE 9 EDGE OF SHOULDER UNLESS DENOTED OTHERWISE ON THE PLANS OR AS DIRECTED BY THE RESIDENT ENGINEER.

PAVEMENT CORES =

#	TOTAL DEPTH (mm)	PCC	COMMENTS
7	100	Y	
8	140	Y	

SIGN LEGEND  
R= REMOVE  
S= SALVAGE  
N= NEW  
RET= RETAIN  
B-B= BACK TO BACK  
EXISTING= -----  
NEW= \_\_\_\_\_

Ⓢ SIGN TO BE RETURNED TO THE TOWN OF BENNINGTON

**PAVING PROJECT LAYOUT # 8**

SURVEYED BY N/A DATE N/A  
DRAWN BY J.A.R. DATE 4/01  
SQUAD LEADER T.P.K.  
DESIGN FILE NO. pave/99dl56/pdl56.dgn  
IPARM pdl56108.i DATE NOV-2005 10:  
FILE PL0721  
PROJ. NAME BENNINGTON  
PROJ. NO. NH 2202(I)S  
SHEET 21 OF 108 SHEETS

DATUM

VERTICAL	<u>N/A</u>
HORIZONTAL	<u>N/A</u>