

646.40 DURABLE 100 mm WHITE LINE
 (ALL LINES WILL INCLUDE EDGE LINE BREAKS AND RADIUS FOR TOWN HIGHWAYS)
 VT. ROUTE 9:
 STA. 6+760.0 - STA. 6+900.0 LT & RT

646.60 TEMPORARY 100 mm WHITE LINE
 (ALL LINES WILL INCLUDE EDGE LINE BREAKS AND RADIUS FOR TOWN HIGHWAYS)
 VT. ROUTE 9:
 STA. 6+760.0 - STA. 6+900.0 LT & RT

646.41 DURABLE 100 mm YELLOW LINE
 (ALL LINES WILL INCLUDE C/L BREAKS FOR TOWN HIGHWAYS) S=SOLID, D=DASHED
 LT C RT
 S - S

646.61 TEMPORARY 100 mm YELLOW LINE
 (ALL LINES WILL INCLUDE C/L BREAKS FOR TOWN HIGHWAYS) S=SOLID, D=DASHED
 LT C RT
 S - S

646.46 DURABLE 600 mm STOP BAR (TYPE 1 TAPE)
 VT. ROUTE 9:
 STA. 6+833.275 RT, T-406

646.66 TEMPORARY 600 mm STOP BAR
 VT. ROUTE 9:
 STA. 6+833.275 RT, T-406


646.50 DURABLE LETTER OR SYMBOL (TYPE 1 TAPE)
 VT. ROUTE 9:
 STA. 6+833.275 RT, T-406, "S,T,O,P" (4 EA)

646.70 TEMPORARY LETTER OR SYMBOL
 VT. ROUTE 9:
 STA. 6+833.275 RT, T-406, "S,T,O,P" (8 EA)

646.51 DURABLE CROSSWALK MARKINGS WITH DIAGONAL LINES (MOD 2)
 VT. ROUTE 9:
 STA. 6+833.275 RT, T-406

646.71 TEMPORARY CROSSWALK MARKINGS WITH DIAGONAL LINES
 VT. ROUTE 9:
 STA. 6+833.275 RT, T-406

675.50 REMOVING SIGNS
 AS SHOWN - 86

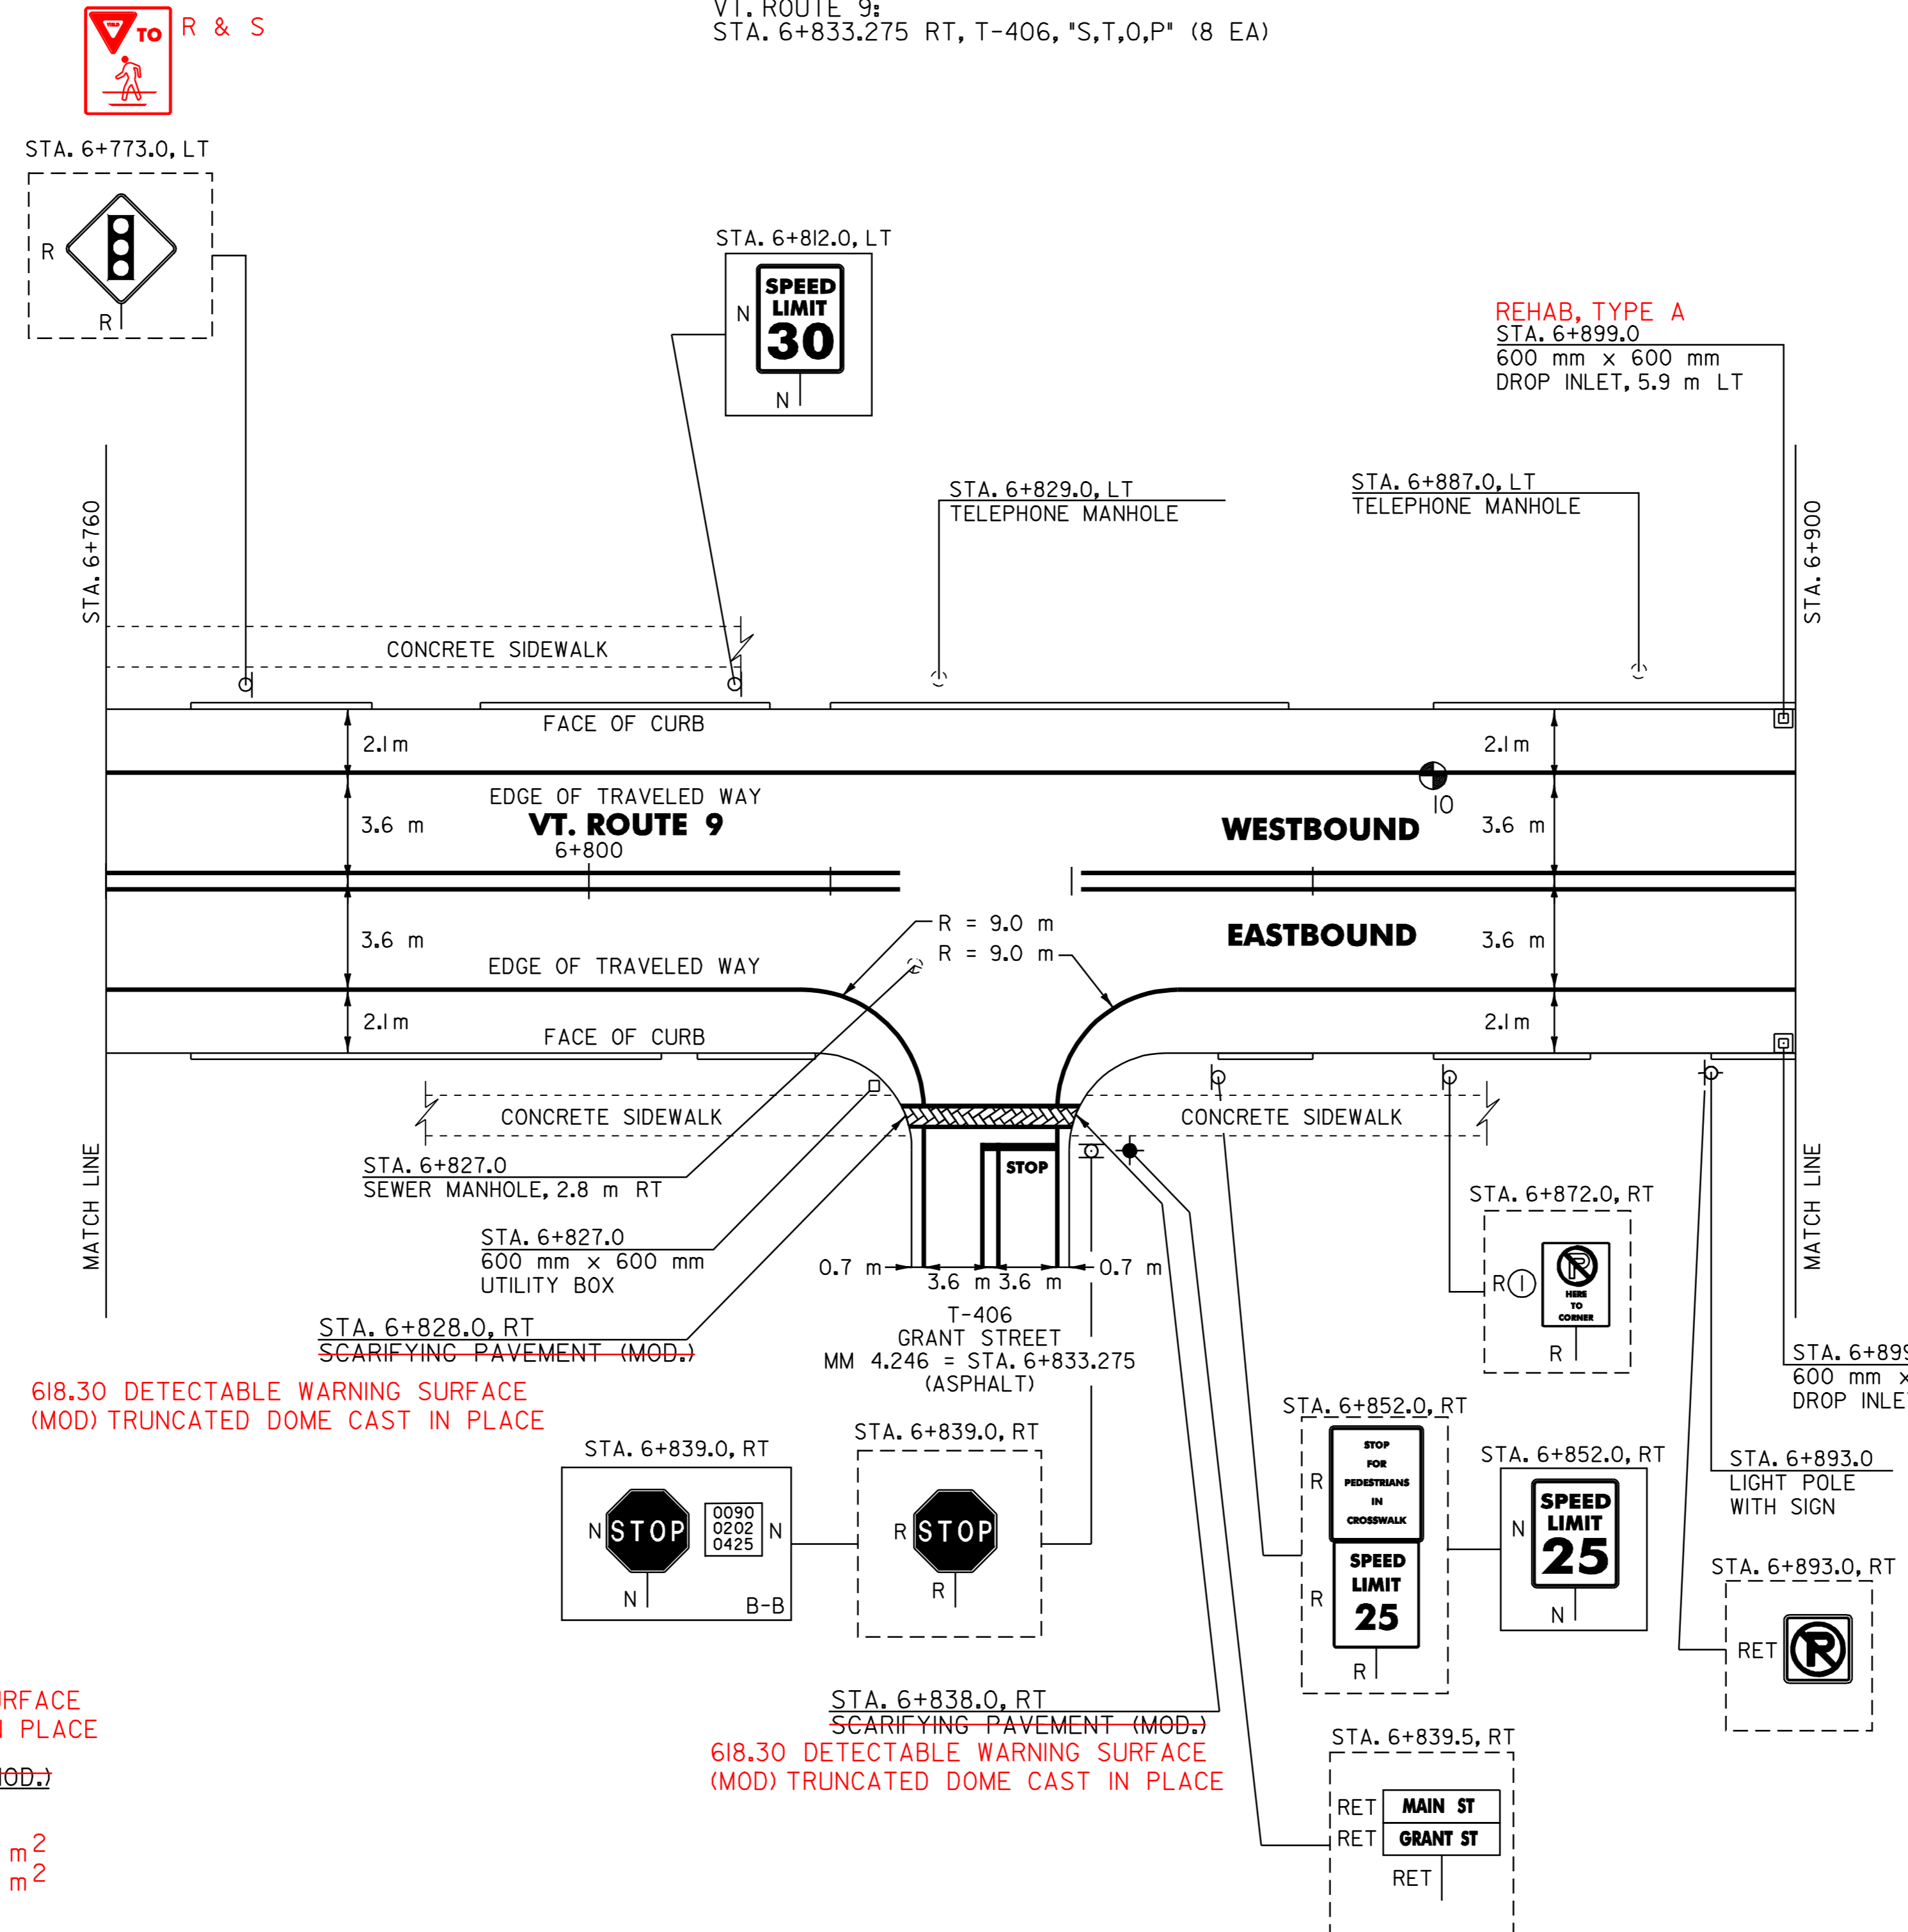

618.30 DETECTABLE WARNING SURFACE (MOD) TRUNCATED DOME CAST IN PLACE

618.30 DETECTABLE WARNING SURFACE (MOD) TRUNCATED DOME CAST IN PLACE

212.20 SCARIFYING PAVEMENT (MOD)

VT. ROUTE 9:
 STA. 6+828.0 RT (5 m²) 0.743 m²
 STA. 6+838.0 RT (5 m²) 0.929 m²

REHAB
 604.40 CHANGE ELEVATION OF DI, CB OR MH CLASS I

VT. ROUTE 9:
 STA. 6+899.0 LT
 STA. 6+899.0 RT

604.42 CHANGE ELEVATION OF SEWER MANHOLE

VT. ROUTE 9:
 STA. 6+827.0 RT

NOTE:
 I. PAVING LIMIT ON ALL TOWN HIGHWAYS SHALL BE MEASURED 8 m BACK FROM VT. ROUTE 9 EDGE OF SHOULDER UNLESS DENOTED OTHERWISE ON THE PLANS OR AS DIRECTED BY THE RESIDENT ENGINEER.

PAVEMENT CORES =

#	TOTAL DEPTH (mm)	PCC	COMMENTS
10	83	Y	

DATUM	
VERTICAL	N/A
HORIZONTAL	N/A

SIGN LEGEND
 R= REMOVE
 S= SALVAGE
 N= NEW
 RET= RETAIN
 B-B= BACK TO BACK
 EXISTING= _____
 NEW= _____
 (1) SIGN TO BE RETURNED TO THE TOWN OF BENNINGTON

PAVING PROJECT LAYOUT # 10

SURVEYED BY N/A DATE N/A
 DRAWN BY J.A.R. DATE 4/01
 SQUAD LEADER T.P.K.
 DESIGN FILE NO. pave/99dl56/pdl56.dgn
 IPARM FILE pdl56i10.i DATE NOV-2005 10
 PROJ. NAME BENNINGTON
 PROJ. NO. NH 2202(1)S
 SHEET 23 OF 108 SHEETS