


646.40 DURABLE 100 mm WHITE LINE
(ALL LINES WILL INCLUDE EDGE LINE BREAKS AND RADIUS FOR TOWN HIGHWAYS)
VT. ROUTE 9:
STA. 7+080.0 - STA. 7+103.7 RT, SOLID LINE (LANE LINE)
STA. 7+080.0 - STA. 7+096.8 LT, PARKING SPACES
STA. 7+083.2 - STA. 7+095.4 RT, PARKING SPACES
STA. 7+133.3 - STA. 7+155.0 RT, SOLID LINE (LANE LINE)
STA. 7+136.2 - STA. 7+188.6 LT, PARKING SPACES
STA. 7+142.9 - STA. 7+190.1 RT, PARKING SPACES
STA. 7+155.0 - STA. 7+190.0 LT, DOTTED LINE
STA. 7+209.8 - STA. 7+260.0 RT, PARKING SPACES
STA. 7+210.2 - STA. 7+242.5 LT, PARKING SPACES
STA. 7+255.4 - STA. 7+260.0 LT, PARKING SPACES

646.40 DURABLE 100 mm WHITE LINE
(ALL LINES WILL INCLUDE EDGE LINE BREAKS AND RADIUS FOR TOWN HIGHWAYS)
VT. ROUTE 9:
STA. 7+080.0 - STA. 7+103.7 RT, SOLID LINE (LANE LINE)
STA. 7+080.0 - STA. 7+096.8 LT, PARKING SPACES
STA. 7+083.2 - STA. 7+095.4 RT, PARKING SPACES
STA. 7+133.3 - STA. 7+155.0 RT, SOLID LINE (LANE LINE)
STA. 7+136.2 - STA. 7+188.6 LT, PARKING SPACES
STA. 7+142.9 - STA. 7+190.1 RT, PARKING SPACES
STA. 7+155.0 - STA. 7+190.0 LT, DOTTED LINE
STA. 7+209.8 - STA. 7+260.0 RT, PARKING SPACES
STA. 7+210.2 - STA. 7+242.5 LT, PARKING SPACES
STA. 7+255.4 - STA. 7+260.0 LT, PARKING SPACES

646.41 DURABLE 100 mm YELLOW LINE
(ALL LINES WILL INCLUDE C/L BREAKS FOR TOWN HIGHWAYS) S=SOLID, D=DASHED
VT. ROUTE 9:
STA. 7+190.0 - STA. 7+260.0 LT S C RT S
STA. 7+080.0 - STA. 7+103.7 DOUBLE SOLID LT
STA. 7+133.3 - STA. 7+190.0 DOUBLE SOLID RT
646.61 TEMPORARY 100 mm YELLOW LINE
(ALL LINES WILL INCLUDE C/L BREAKS FOR TOWN HIGHWAYS) S=SOLID, D=DASHED
VT. ROUTE 9:
STA. 7+190.0 - STA. 7+260.0 LT S C RT S
STA. 7+080.0 - STA. 7+103.7 DOUBLE SOLID LT
STA. 7+133.3 - STA. 7+190.0 DOUBLE SOLID RT

646.46 DURABLE 600 mm STOP BAR (TYPE ITAPE)
VT. ROUTE 9:
STA. 7+104.0 RT KM 07+092 RT
STA. 7+133.0 LT
646.66 TEMPORARY 600 mm STOP BAR
VT. ROUTE 9:
STA. 7+104.0 RT
STA. 7+133.0 LT
646.50 DURABLE LETTER OR SYMBOL (TYPE ITAPE)
VT. ROUTE 9:
STA. 7+081.3 RT, "O,N,L,Y" (4 EA)
STA. 7+082.0 RT, ARROW (2 EA)
STA. 7+085.0 RT, ARROW (1EA)
STA. 7+139.3 LT, HANDICAP SYMBOL (1EA)
STA. 7+150.0 LT, ARROW (1EA)
STA. 7+153.0 LT, ARROW (2 EA)
STA. 7+153.7 LT, "O,N,L,Y" (4 EA)
STA. 7+187.0 RT, HANDICAP SYMBOL (1EA)
646.70 TEMPORARY LETTER OR SYMBOL
VT. ROUTE 9:
STA. 7+082.0 RT, ARROW (4 EA)
STA. 7+085.0 RT, ARROW (2 EA)
STA. 7+150.0 LT, ARROW (2 EA)
STA. 7+153.0 LT, ARROW (4 EA)

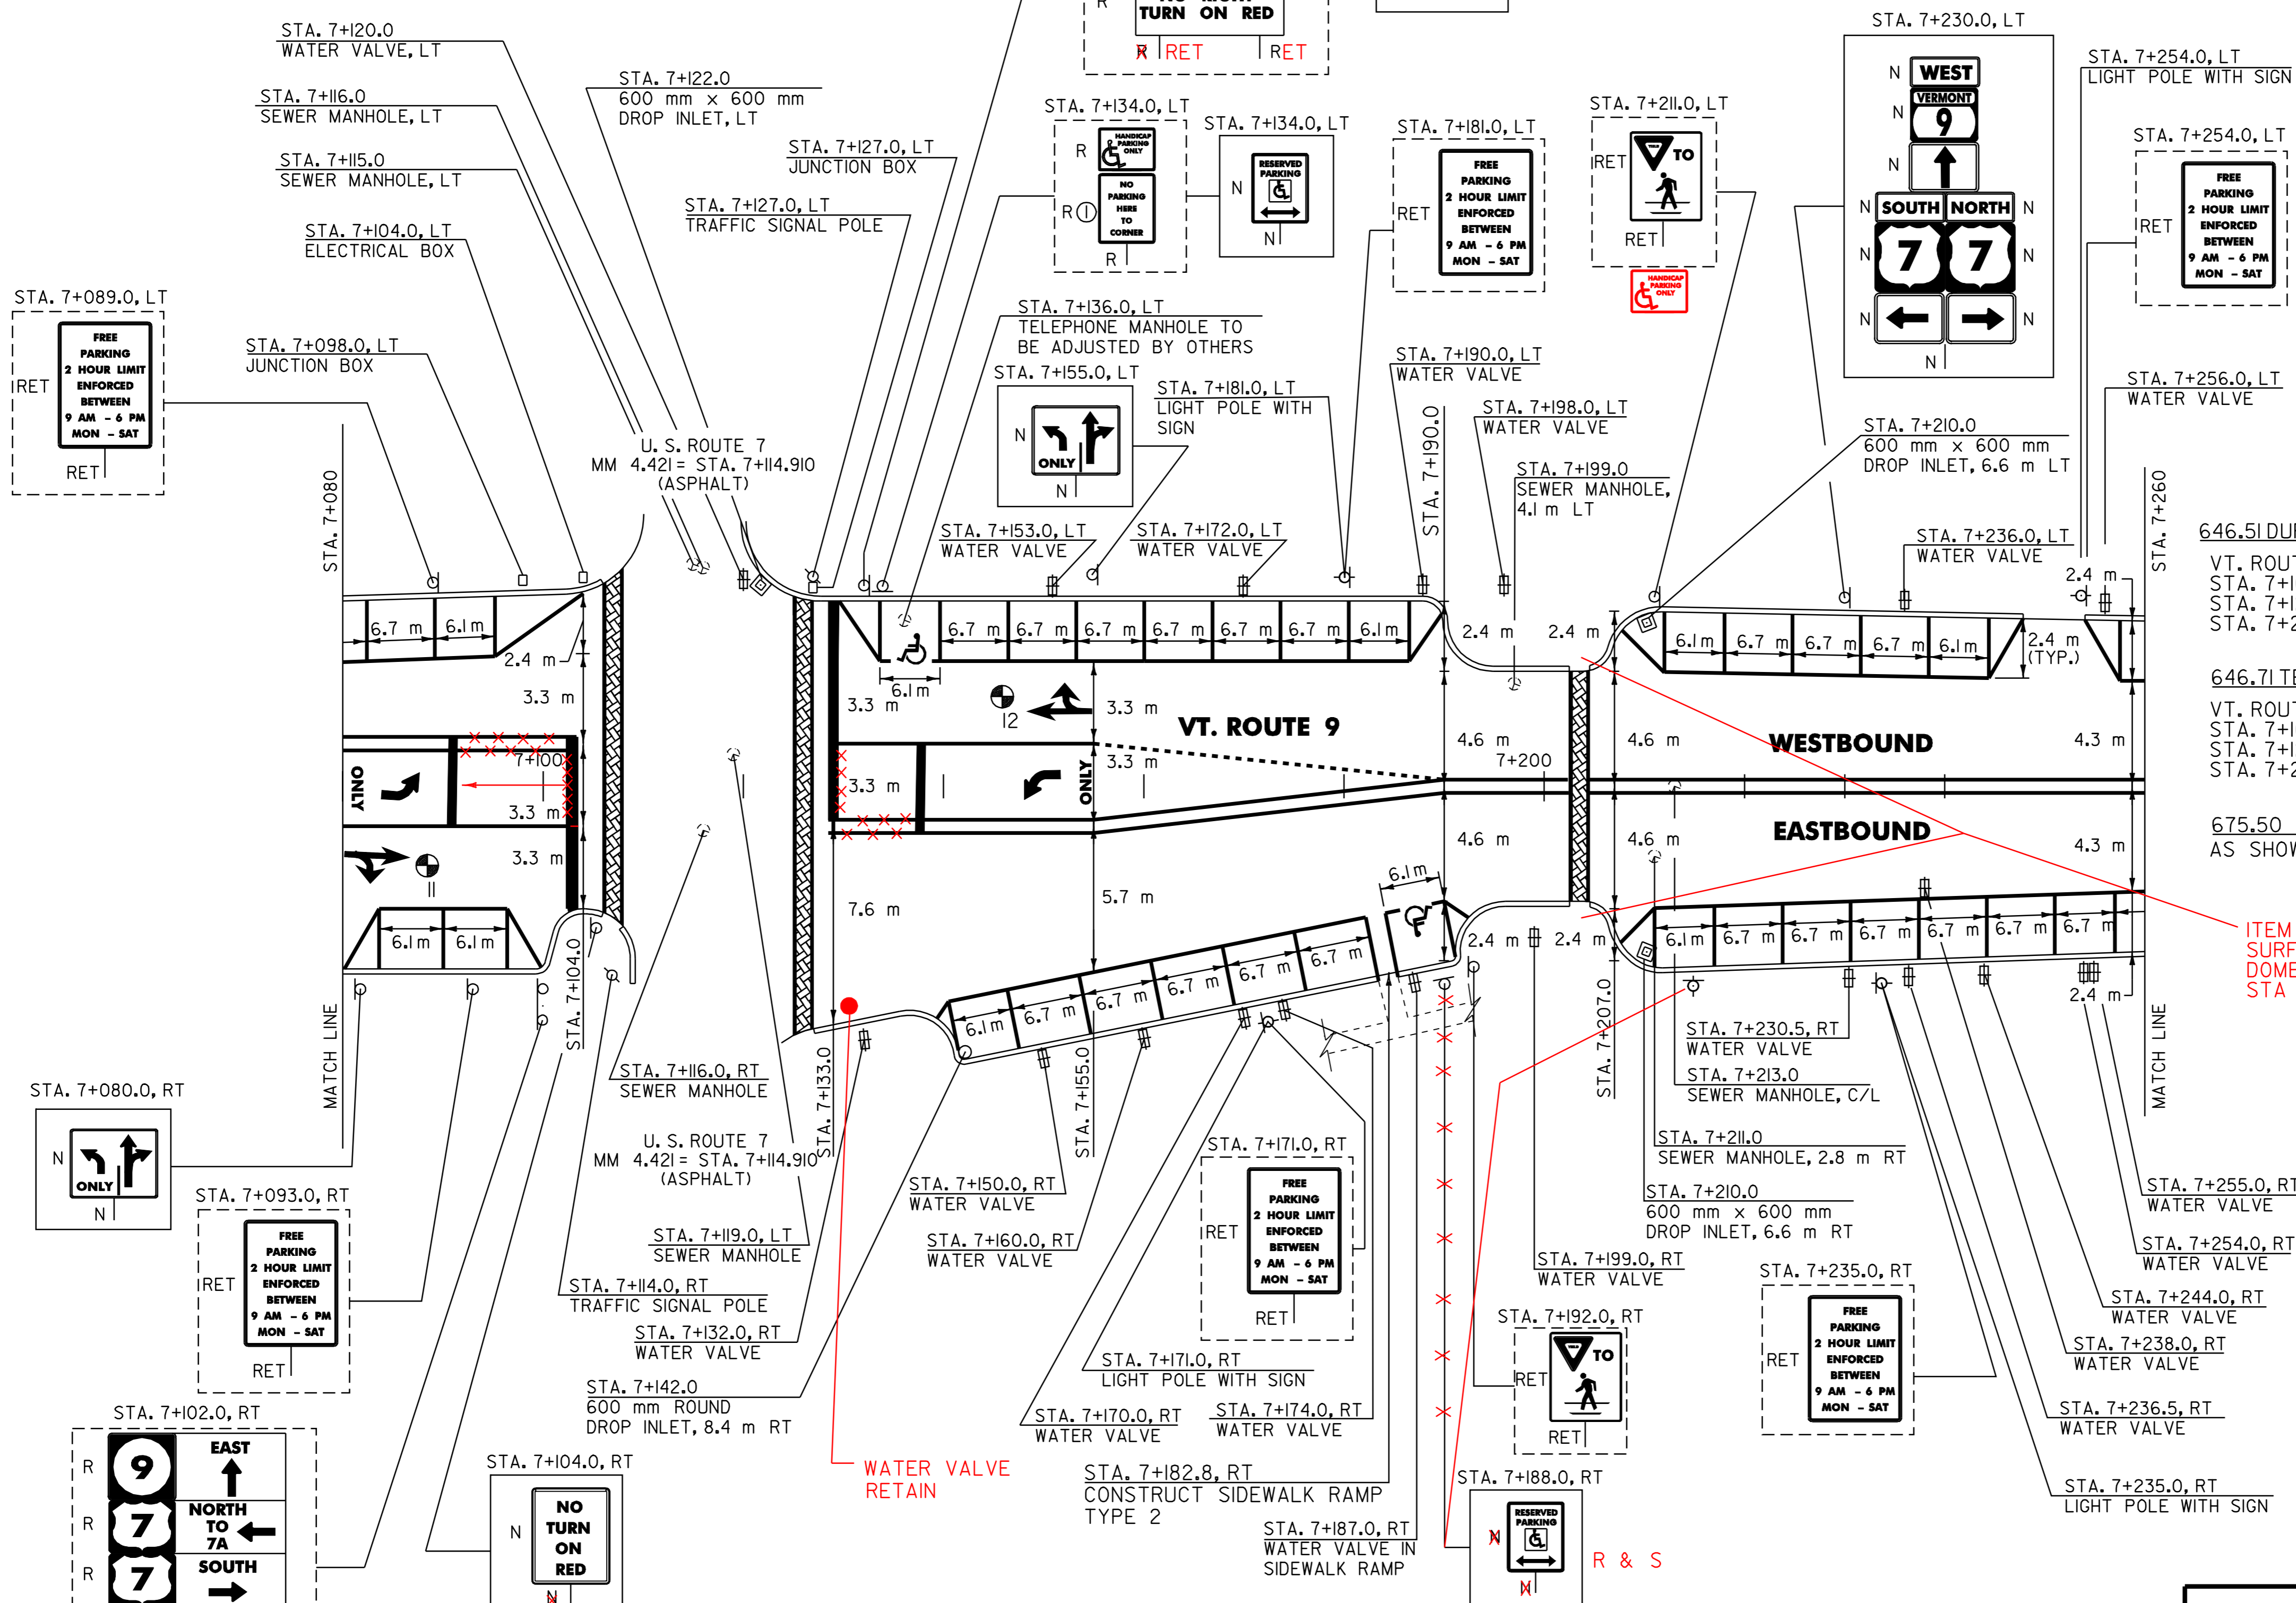

646.51 DURABLE CROSSWALK MARKINGS WITH DIAGONAL LINES (MOD.2)

VT. ROUTE 9:
STA. 7+107.0
STA. 7+126.0
STA. 7+203.0

646.71 TEMPORARY CROSSWALK MARKINGS WITH DIAGONAL LINES

VT. ROUTE 9:
STA. 7+107.0
STA. 7+126.0
STA. 7+203.0

675.50 REMOVING SIGNS
AS SHOWN - 10 11

ITEM 618.30 DETECTABLE WARNING (MOD)
SURFACE MOD TRUNCATED
DOME SURFACE APPLIED
STA 7+200 LT&RT 0.93m² EA

NOTE:
1. SEE SHEET 37 OF 108 FOR U.S. ROUTE 7 DETAILS ASSOCIATED WITH THE INTERSECTION OF VT. ROUTE 9.

PAVEMENT CORES =

#	TOTAL DEPTH (mm)	PCC	COMMENTS
11	89	Y	
12	83	Y	

DATUM

VERTICAL	N/A
HORIZONTAL	N/A

604.40 CHANGE ELEVATION OF DI, CB OR MH
VT. ROUTE 9:
STA. 7+122.0 LT
STA. 7+142.0 RT REHAB
STA. 7+210.0 RT
STA. 7+210.0 LT

604.42 CHANGE ELEVATION OF SEWER MANHOLE

VT. ROUTE 9:
STA. 7+115.0 LT
STA. 7+116.0 LT
STA. 7+116.0 RT
STA. 7+119.0 LT
STA. 7+199.0 LT
STA. 7+211.0 RT
STA. 7+213.0 C/L

629.20 ADJUST ELEVATION OF VALVE BOX

VT. ROUTE 9:
STA. 7+120.0 LT
STA. 7+187.0 RT
STA. 7+238.0 RT

SIGN LEGEND
R= REMOVE
S= SALVAGE
N= NEW
RET= RETAIN
B=B= BACK TO BACK
EXISTING= - - - - -
NEW= _____
① SIGN TO BE RETURNED TO THE TOWN OF BENNINGTON

PAVING PROJECT LAYOUT # 12

SURVEYED BY N/A DATE N/A
DRAWN BY J.A.R. DATE 4/01
SQUAD LEADER T.P.K.
DESIGN FILE NO. pave/99d156/pd156.dgn
IPARM pd156112.i DATE 27 NOV-2005 10
FILE
PROJ. NAME BENNINGTON
PROJ. NO. NH 2202(1)S
SHEET 25 OF 108 SHEETS