

646.40 DURABLE 100 mm WHITE LINE
 (ALL LINES WILL INCLUDE EDGE LINE BREAKS AND RADIUS FOR TOWN HIGHWAYS)

VT. ROUTE 9:
 STA. 7+447.6 - STA. 7+466.5 LT, PARKING SPACES
 STA. 7+454.4 - STA. 7+480.0 RT, PARKING SPACES
 STA. 7+476.9 - STA. 7+483.0 LT, PARKING SPACES
 STA. 7+480.0 - STA. 7+620.0 RT
 STA. 7+483.0 - STA. 7+620.0 LT

646.60 TEMPORARY 100 mm WHITE LINE
 (ALL LINES WILL INCLUDE EDGE LINE BREAKS AND RADIUS FOR TOWN HIGHWAYS)

VT. ROUTE 9:
 STA. 7+447.6 - STA. 7+466.5 LT, PARKING SPACES
 STA. 7+454.4 - STA. 7+480.0 RT, PARKING SPACES
 STA. 7+476.9 - STA. 7+483.0 LT, PARKING SPACES
 STA. 7+480.0 - STA. 7+620.0 RT
 STA. 7+483.0 - STA. 7+620.0 LT

646.41 DURABLE 100 mm YELLOW LINE
 (ALL LINES WILL INCLUDE C/L BREAKS FOR TOWN HIGHWAYS) S=SOLID, D=DASHED

VT. ROUTE 9:
 STA. 7+440.0 - STA. 7+620.0

646.61 TEMPORARY 100 mm YELLOW LINE
 (ALL LINES WILL INCLUDE C/L BREAKS FOR TOWN HIGHWAYS) S=SOLID, D=DASHED

VT. ROUTE 9:
 STA. 7+440.0 - STA. 7+620.0

646.42 DURABLE 200 mm WHITE LINE

VT. ROUTE 9:
 STA. 7+501.2 - STA. 7+504.8 RT, SHOULDER HATCHING (18.6 m)
 STA. 7+605.2 - STA. 7+608.8 RT, SHOULDER HATCHING (18.6 m)

646.51 DURABLE CROSSWALK MARKINGS WITH DIAGONAL LINES (MOD.)

VT. ROUTE 9:
 STA. 7+490.0
 STA. 7+496.324 RT, T-442
 STA. 7+496.324 LT, T-442

646.71 TEMPORARY CROSSWALK MARKINGS WITH DIAGONAL LINES

VT. ROUTE 9:
 STA. 7+490.0
 STA. 7+496.324 RT, T-442
 STA. 7+496.324 LT, T-442

646.46 DURABLE 600 mm STOP BAR (TYPE 1 TAPE)

VT. ROUTE 9:
 STA. 7+496.324 RT, T-442

646.66 TEMPORARY 600 mm STOP BAR

VT. ROUTE 9:
 STA. 7+496.324 RT, T-442

646.50 DURABLE LETTER OR SYMBOL (TYPE 1 TAPE)

VT. ROUTE 9:
 STA. 7+496.324 RT, T-442, "S,T,O,P" (4 EA)

646.70 TEMPORARY LETTER OR SYMBOL

VT. ROUTE 9:
 STA. 7+496.324 RT, T-442, "S,T,O,P" (8 EA)


675.50 REMOVING SIGNS
 AS SHOWN - 9

ITEM 618.30 DETECTABLE WARNING SURFACE
 MOD TRUNCATED DOME SURFACE APPLIED

VT ROUTE 9
 STA 7+483 RT .743 m²
 STA 7+483 LT .743 m²
 STA 7+493 RT .929 m²
 STA 7+493 LT .929 m²

ITEM 618.30 DETECTABLE WARNING SURFACE
 MOD TRUNCATED DOME CAST IN PLACE

VT ROUTE 9
 STA 7+502 LT .929 m²
 STA 7+502 RT .929 m²

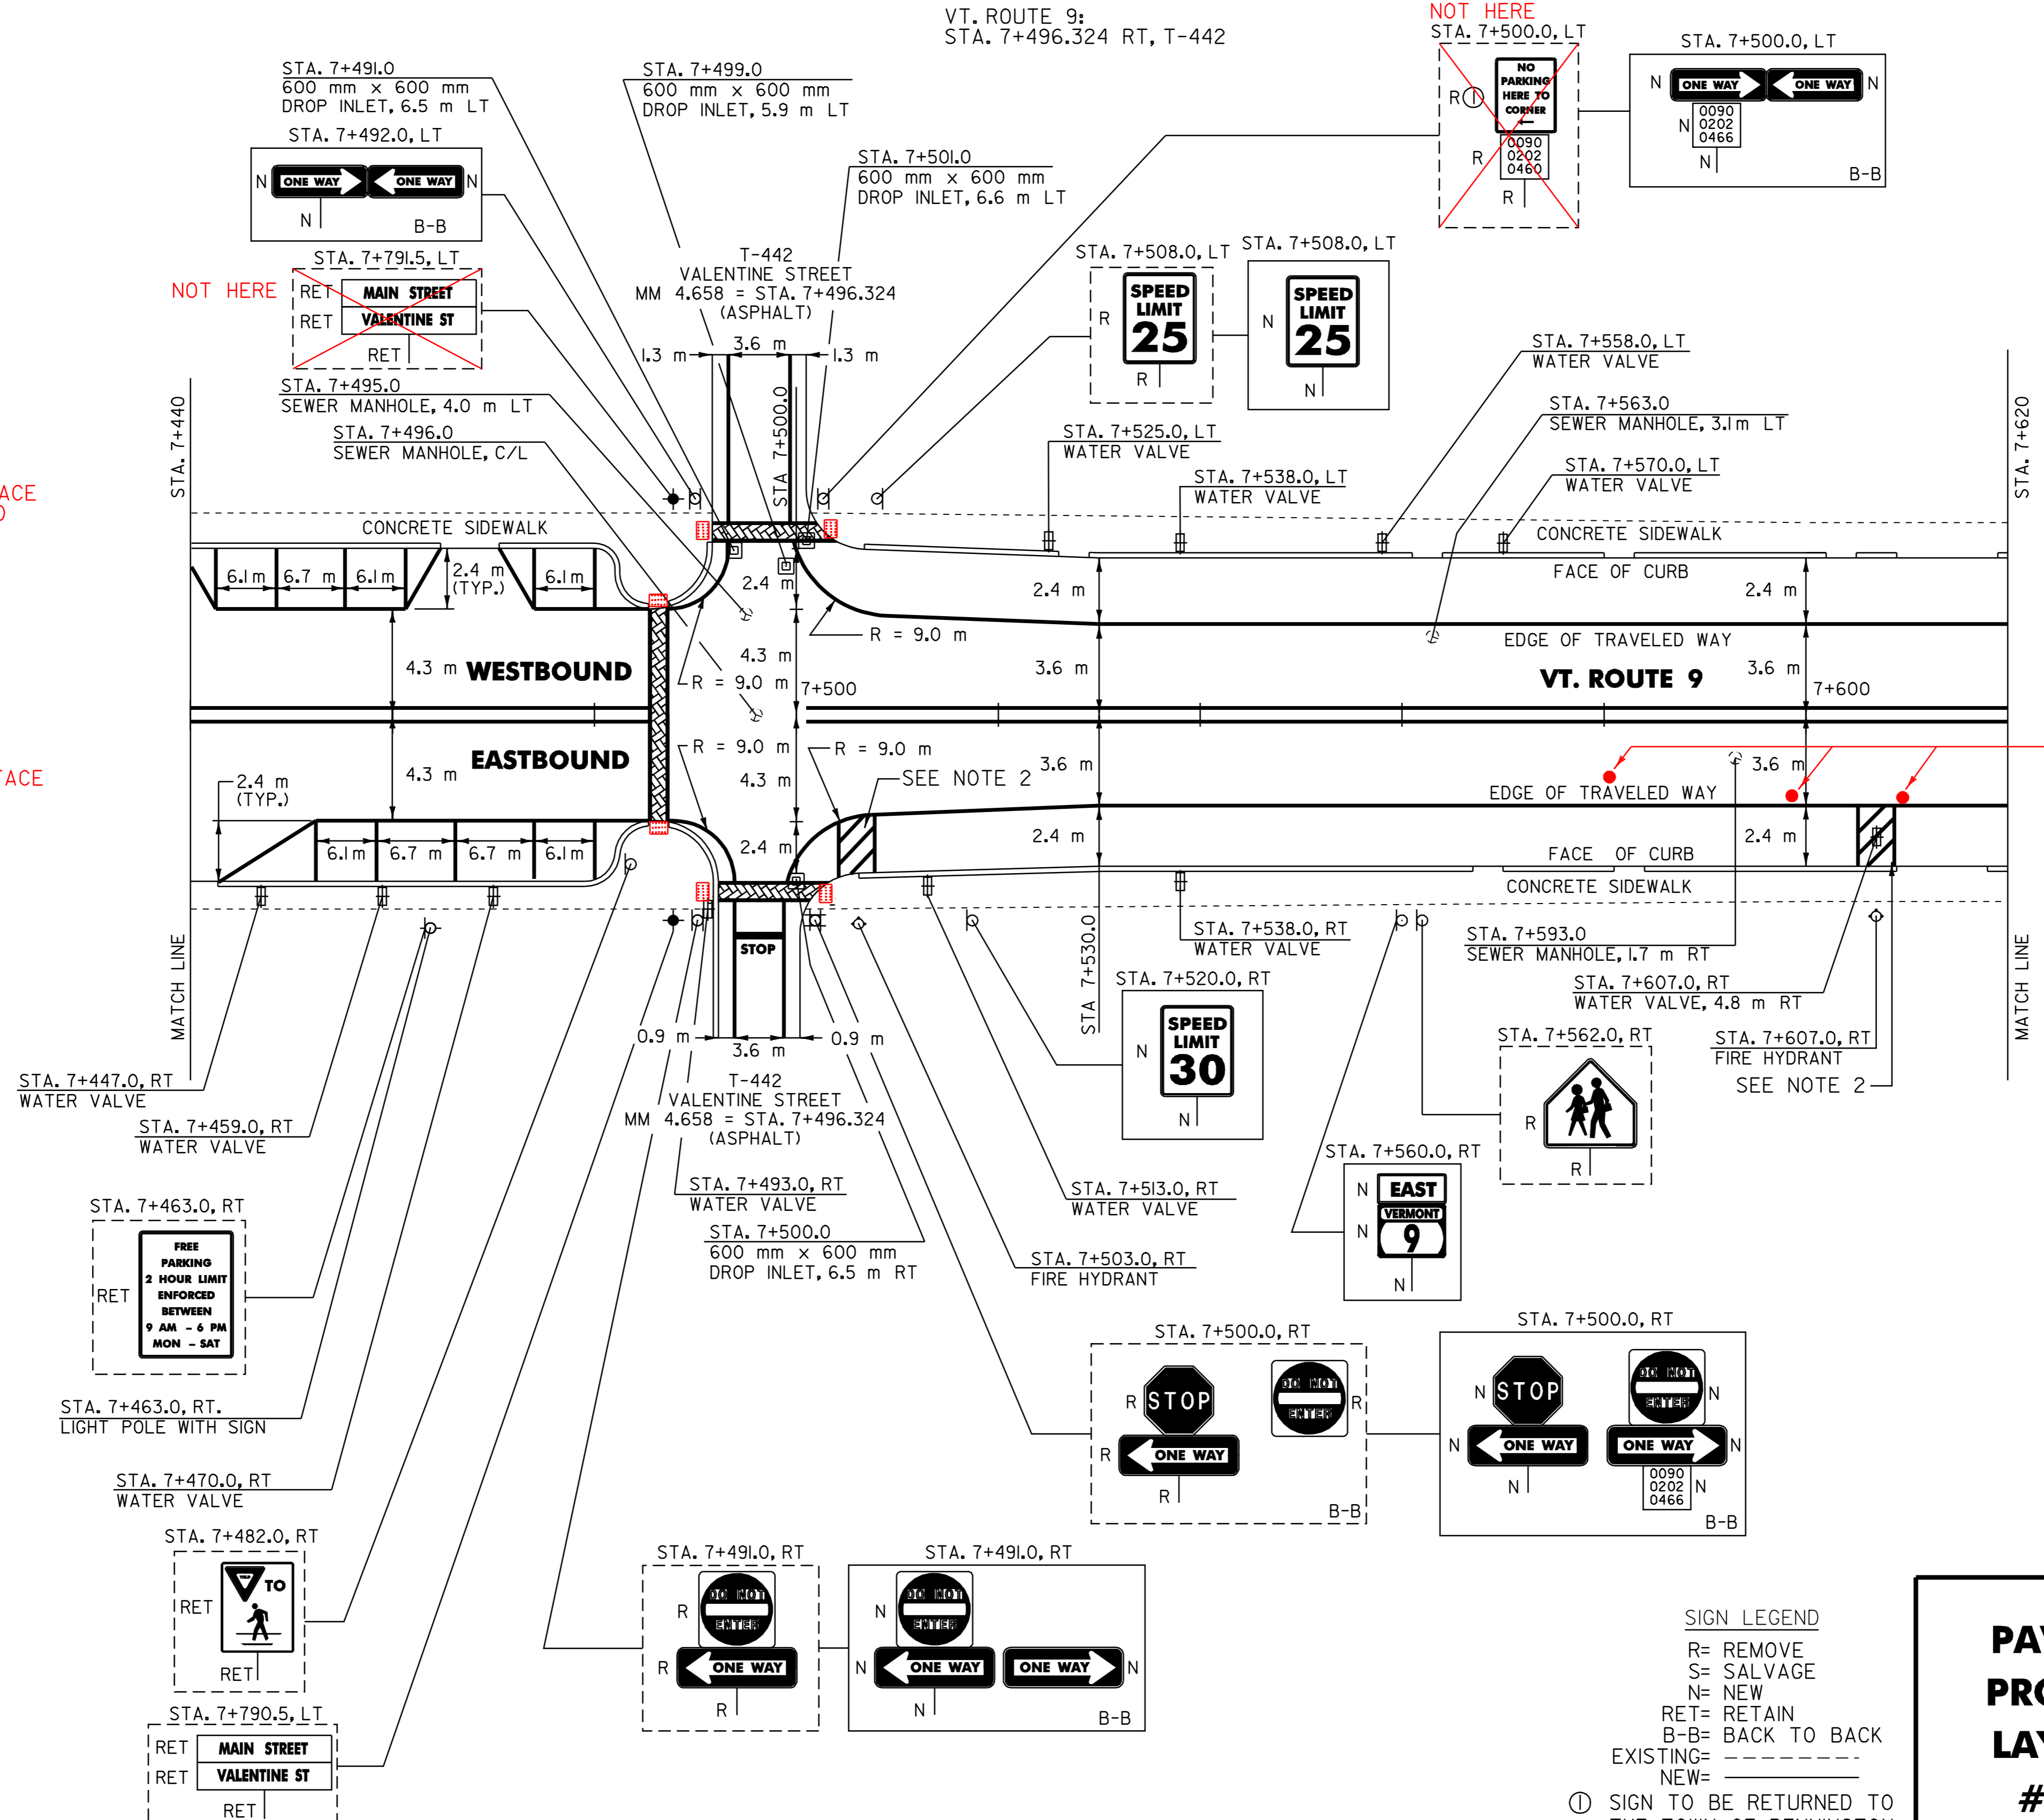

604.40 CHANGE ELEVATION OF DI, CB OR MH

VT. ROUTE 9:
 STA. 7+491.0 LT
 STA. 7+499.0 LT
 STA. 7+500.0 RT
 STA. 7+501.0 LT

604.42 CHANGE ELEVATION OF SEWER MANHOLE

VT. ROUTE 9:
 STA. 7+495.0 LT
 STA. 7+496.0 C/L
 STA. 7+563.0 LT
 STA. 7+593.0 RT

629.20 ADJUST ELEVATION OF VALVE BOX

VT. ROUTE 9:
 STA. 7+607.0 RT

NOTES:

- PAVING LIMIT ON ALL TOWN HIGHWAYS SHALL BE MEASURED 8 m BACK FROM VT. ROUTE 9 EDGE OF SHOULDER UNLESS DENOTED OTHERWISE ON THE PLANS OR AS DIRECTED BY THE RESIDENT ENGINEER.
- SEE SHEET 70 OF 108 FOR FIRE HYDRANT PAVEMENT MARKING DETAIL.

DATUM

VERTICAL	N/A
HORIZONTAL	N/A

SIGN LEGEND

R= REMOVE
 S= SALVAGE
 N= NEW
 RET= RETAIN
 B-B= BACK TO BACK
 EXISTING= _____
 NEW= _____

Ⓢ SIGN TO BE RETURNED TO THE TOWN OF BENNINGTON

PAVING PROJECT LAYOUT # 14

SURVEYED BY	N/A	DATE	N/A
DRAWN BY	J.A.R.	DATE	4/01
SQUAD LEADER	T.P.K.		
DESIGN FILE NO.	_pave/99dl56/pdl56.dgn		
IPARM FILE	_pdl56ll4.l	DATE PLOT	4/11/05
PROJ. NAME	BENNINGTON		
PROJ. NO.	NH 2202(1)S		
SHEET 27 OF 108		SHEETS	