

646.40 DURABLE 100 mm WHITE LINE
(ALL LINES WILL INCLUDE EDGE LINE BREAKS AND RADIUS FOR TOWN HIGHWAYS)

VT. ROUTE 9:
STA. 9+100.0 - STA. 9+360.0 LT & RT

646.60 TEMPORARY 100 mm WHITE LINE
(ALL LINES WILL INCLUDE EDGE LINE BREAKS AND RADIUS FOR TOWN HIGHWAYS)

VT. ROUTE 9:
STA. 9+100.0 - STA. 9+360.0 LT & RT

646.41 DURABLE 100 mm YELLOW LINE
(ALL LINES WILL INCLUDE C/L BREAKS FOR TOWN HIGHWAYS) S=SOLID, D=DASHED

VT. ROUTE 9:
STA. 9+100.0 - STA. 9+360.0 LT S - RT S


646.61 TEMPORARY 100 mm YELLOW LINE
(ALL LINES WILL INCLUDE C/L BREAKS FOR TOWN HIGHWAYS) S=SOLID, D=DASHED

VT. ROUTE 9:
STA. 9+100.0 - STA. 9+360.0 LT S - RT S

646.42 DURABLE 200 mm WHITE LINE

VT. ROUTE 9:
STA. 9+192.2 - STA. 9+195.8 LT, SHOULDER HATCHING (11.1 m)
STA. 9+323.2 - STA. 9+326.8 RT, SHOULDER HATCHING (11.1 m)

675.50 REMOVING SIGNS
AS SHOWN - 2

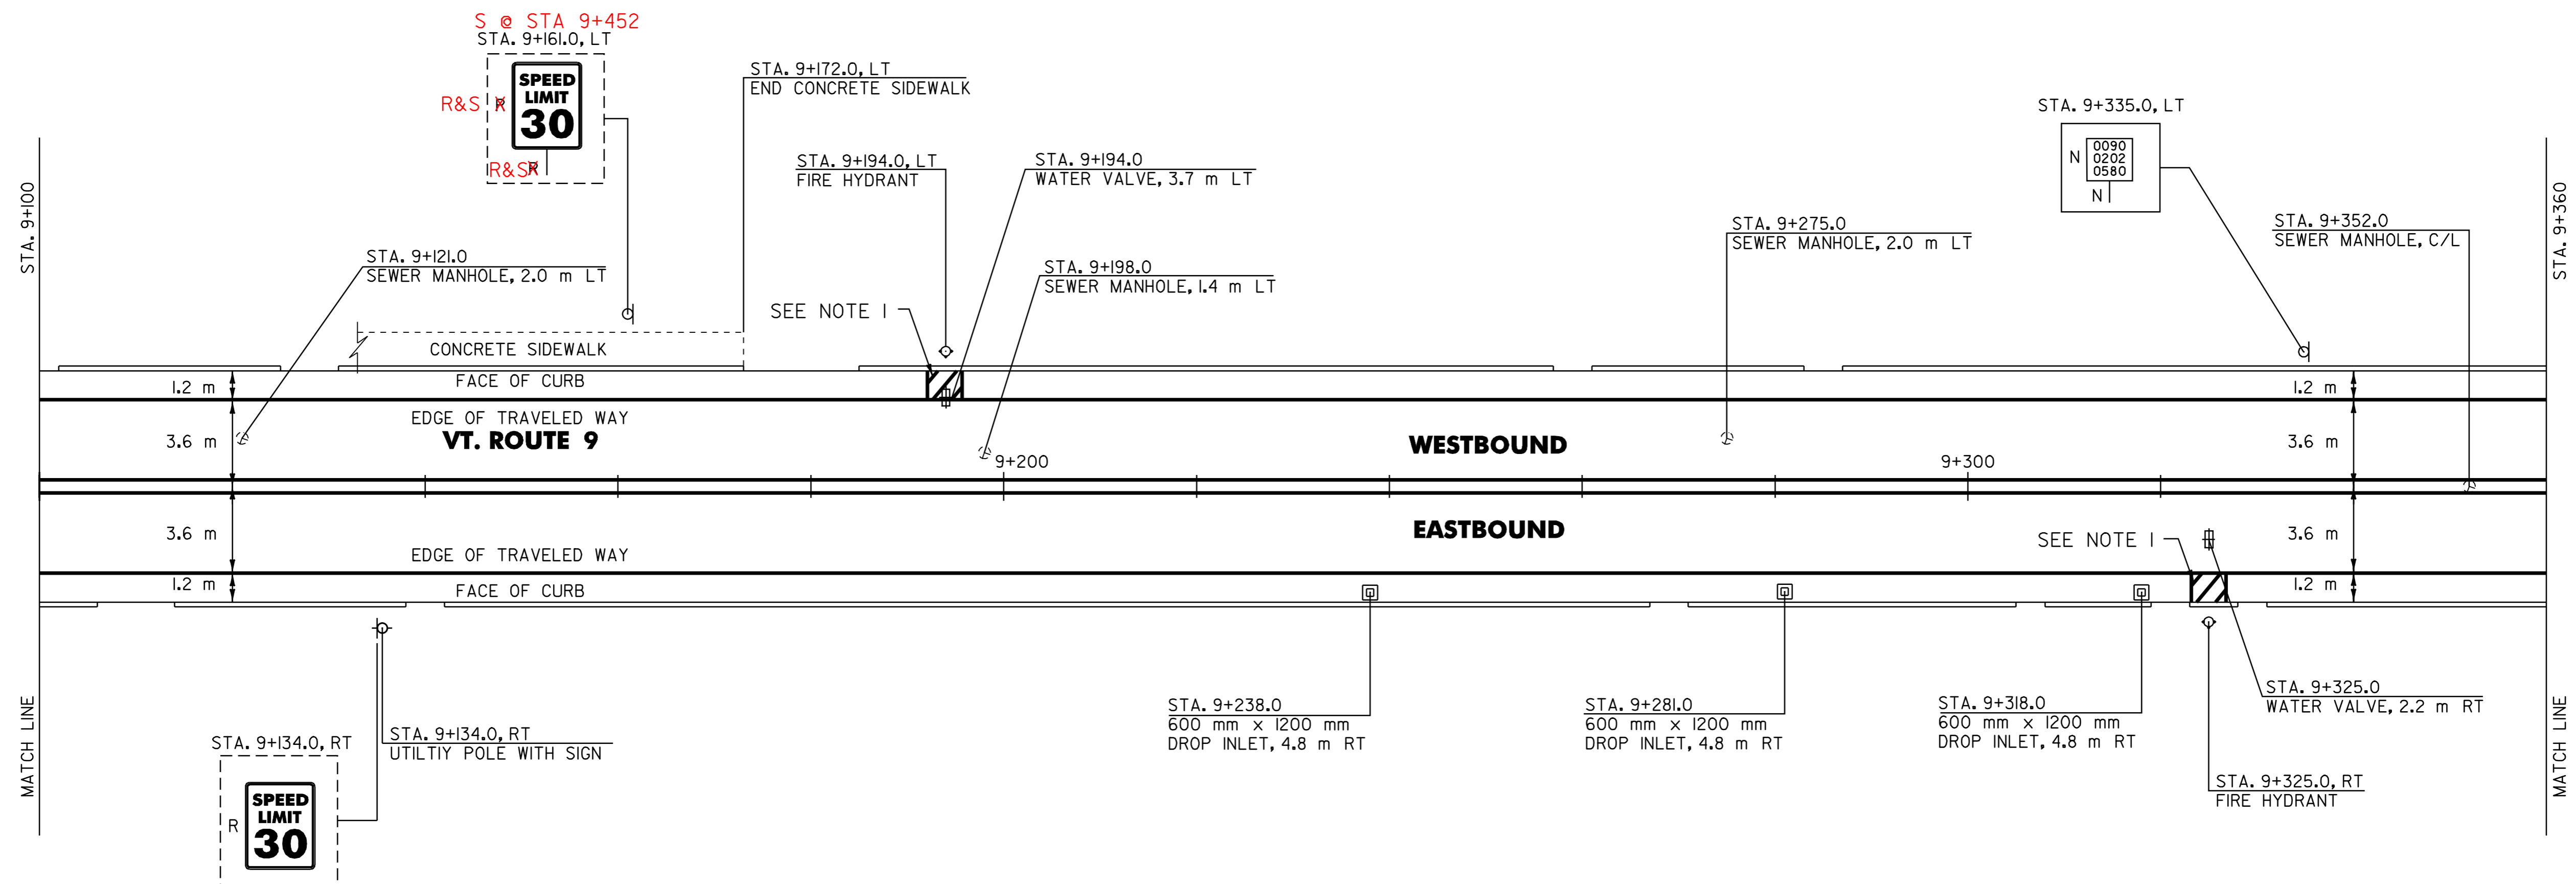

604.40 CHANGE ELEVATION OF DI, CB OR MH

VT. ROUTE 9:
STA. 9+238.0 RT
STA. 9+281.0 RT
STA. 9+318.0 RT

629.20 ADJUST ELEVATION OF VALVE BOX

VT. ROUTE 9:
STA. 9+194.0 LT
STA. 9+325.0 RT

604.42 CHANGE ELEVATION OF SEWER MANHOLE

VT. ROUTE 9:
STA. 9+121.0 LT
STA. 9+198.0 LT
STA. 9+275.0 LT
STA. 9+352.0 C/L

NOTE:
I. SEE SHEET 70 OF 108 FOR FIRE HYDRANT PAVEMENT MARKING DETAIL.

DATUM	
VERTICAL	N/A
HORIZONTAL	N/A

SIGN LEGEND
R= REMOVE
S= SALVAGE
N= NEW
RET= RETAIN
B-B= BACK TO BACK
EXISTING= _____
NEW= _____

**PAVING
PROJECT
LAYOUT
22**

SURVEYED BY	N/A	DATE	N/A
DRAWN BY	J.A.R.	DATE	4/01
SQUAD LEADER	T.P.K.		
DESIGN FILE NO.	pave/99d156/pdl56.dgn		
IPARM FILE	pdl56122.i	DATE PLOTTED	NOV-2005 10
PROJ. NAME	BENNINGTON		
PROJ. NO.	NH 2202(1)S		
SHEET 35 OF 108	SHEETS		