

646.41 DURABLE 100 mm YELLOW LINE
(ALL LINES WILL INCLUDE C/L BREAKS FOR TOWN HIGHWAYS) S=SOLID, D=DASHED

VT. ROUTE 9:
STA. 9+360.0 - STA. 9+496.739 LT ☉ RT S - S

646.40 DURABLE 100 mm WHITE LINE
(ALL LINES WILL INCLUDE EDGE LINE BREAKS AND RADIUS FOR TOWN HIGHWAYS)

VT. ROUTE 9:
STA. 9+360.0 - STA. 9+496.739 LT & RT

675.50 REMOVING SIGNS
AS SHOWN - 6


675.60 ERECTING SALVAGED SIGNS
AS SHOWN - 1

646.61 TEMPORARY 100 mm YELLOW LINE
(ALL LINES WILL INCLUDE C/L BREAKS FOR TOWN HIGHWAYS) S=SOLID, D=DASHED

VT. ROUTE 9:
STA. 9+360.0 - STA. 9+496.739 LT ☉ RT S - S

646.60 TEMPORARY 100 mm WHITE LINE
(ALL LINES WILL INCLUDE EDGE LINE BREAKS AND RADIUS FOR TOWN HIGHWAYS)

VT. ROUTE 9:
STA. 9+360.0 - STA. 9+496.739 LT & RT

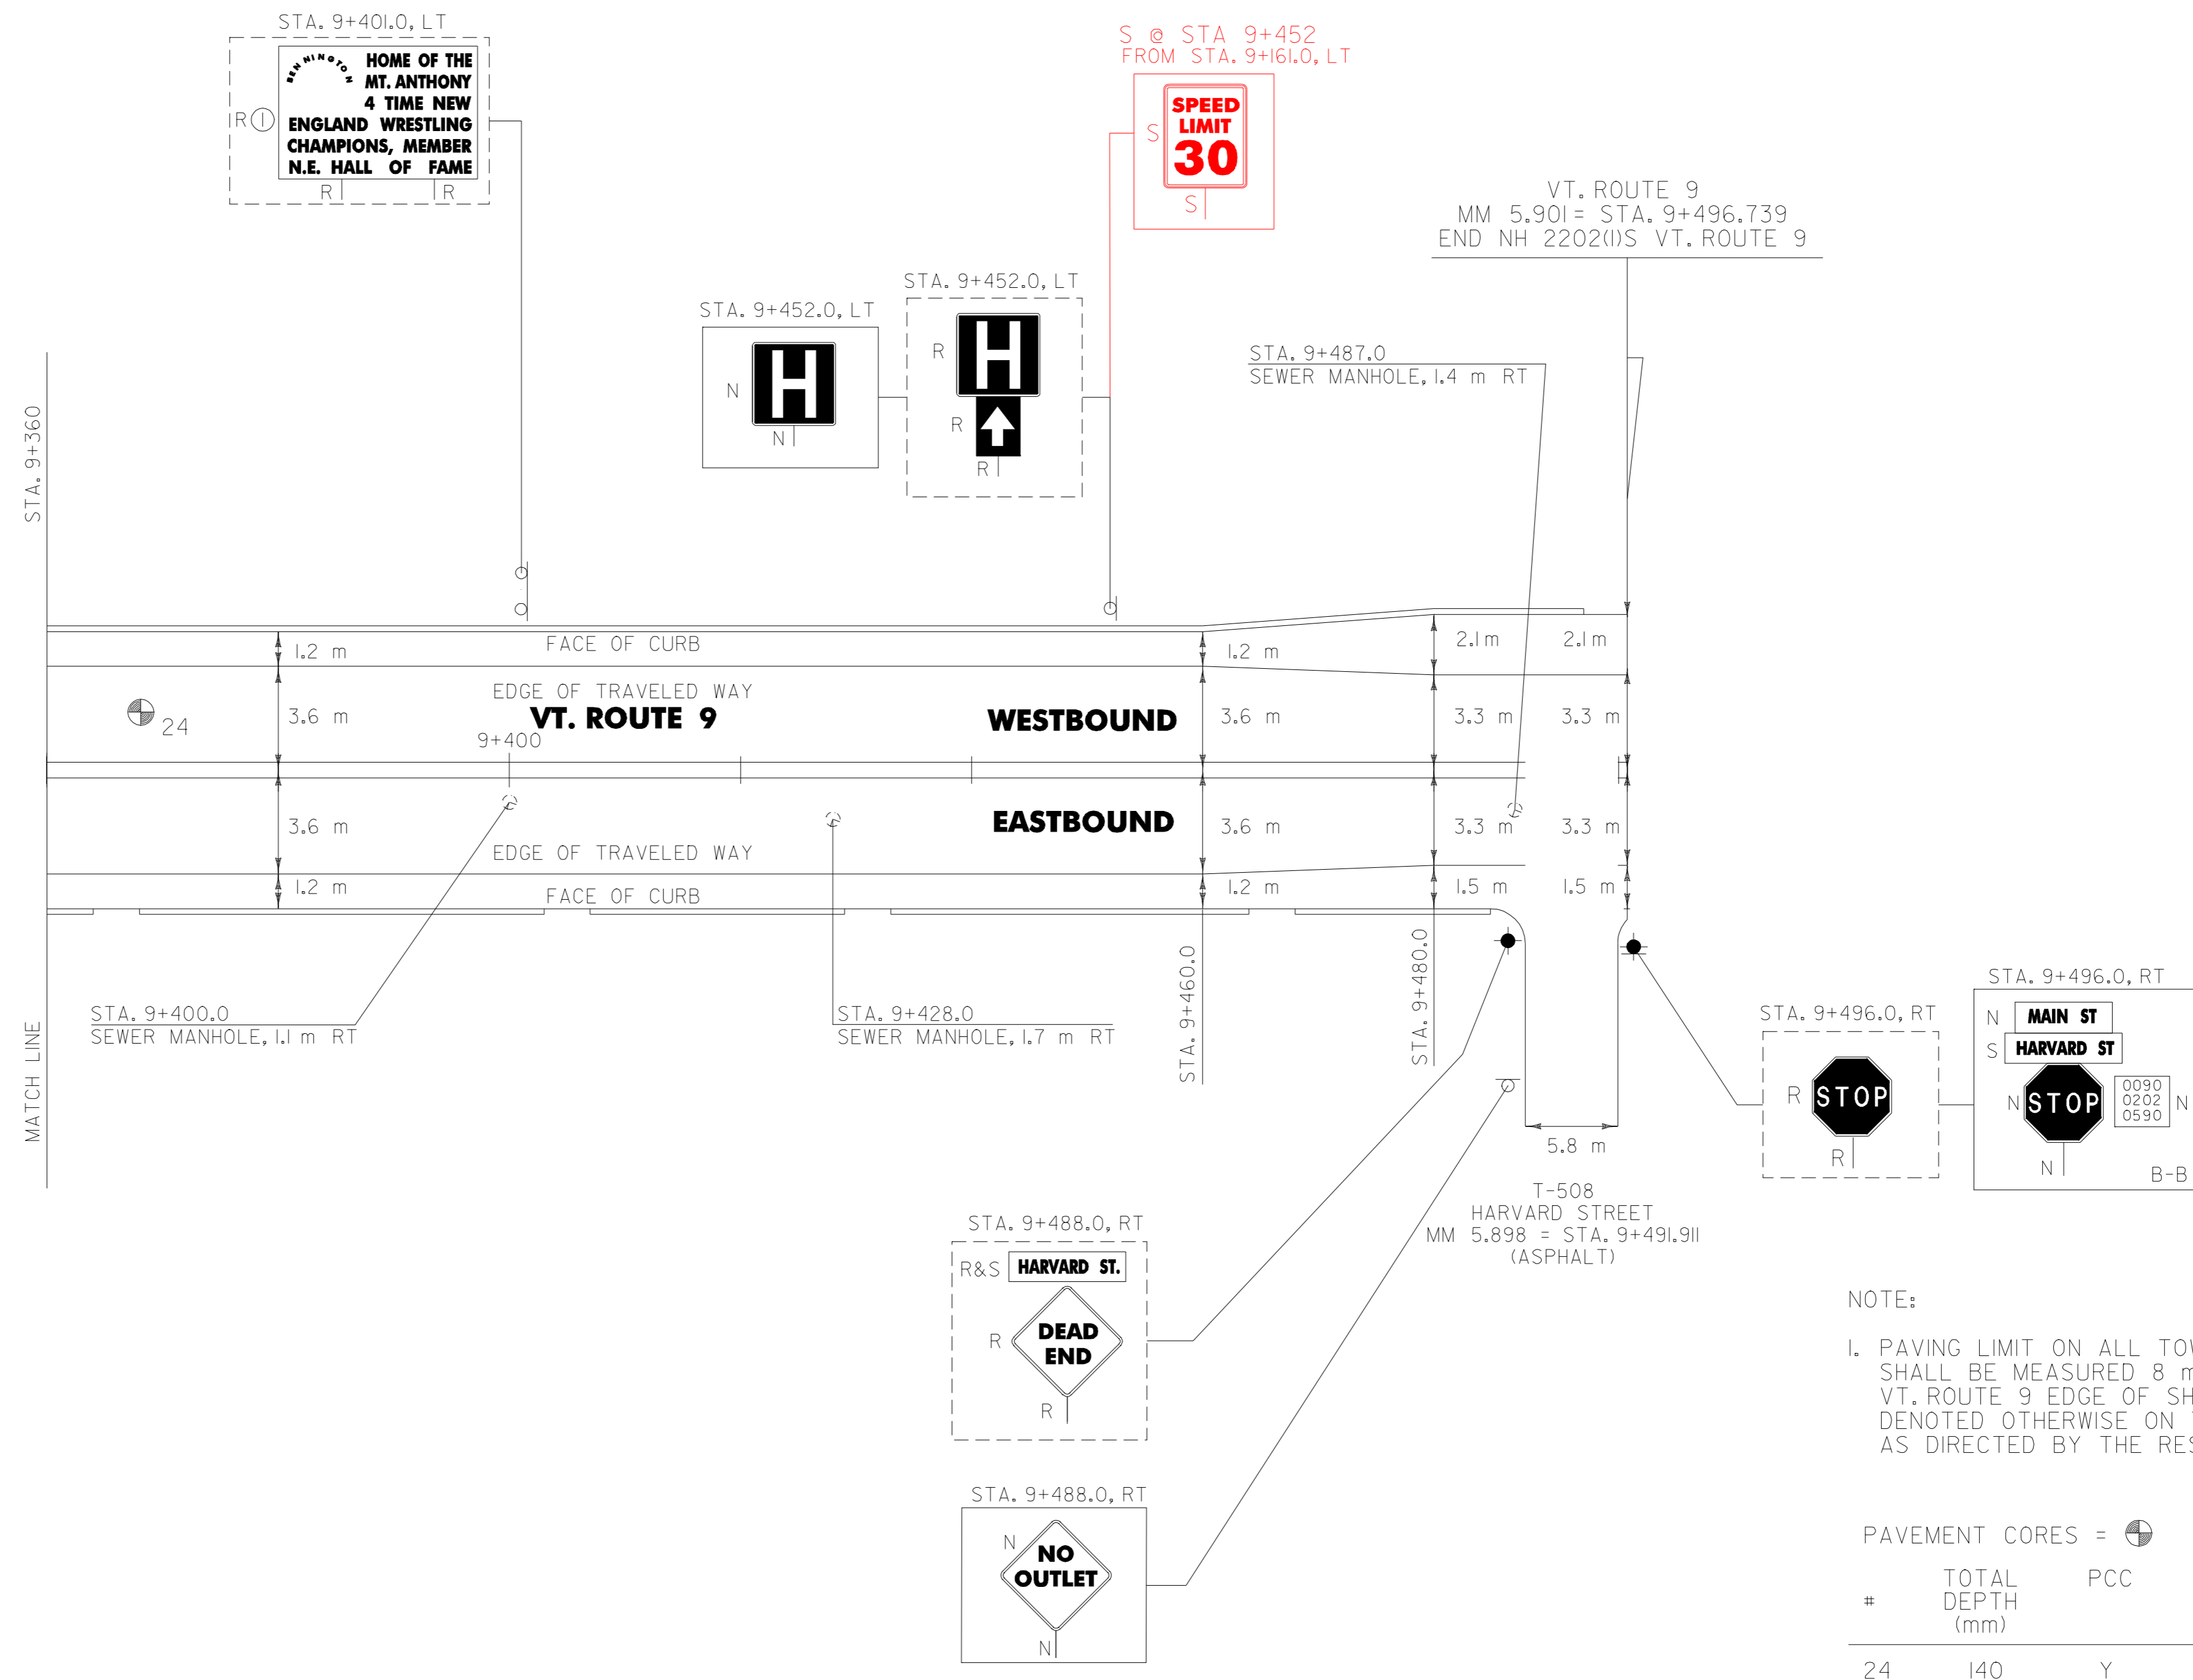

NOTE:
1. PAVING LIMIT ON ALL TOWN HIGHWAYS SHALL BE MEASURED 8 m BACK FROM VT. ROUTE 9 EDGE OF SHOULDER UNLESS DENOTED OTHERWISE ON THE PLANS OR AS DIRECTED BY THE RESIDENT ENGINEER.

PAVEMENT CORES =

#	TOTAL DEPTH (mm)	PCC	COMMENTS
24	140	Y	

604.42 CHANGE ELEVATION OF SEWER MANHOLE

VT. ROUTE 9:
STA. 9+400.0 RT
STA. 9+428.0 RT
STA. 9+487.0 RT

SIGN LEGEND
R= REMOVE
S= SALVAGE
N= NEW
RET= RETAIN
B-B= BACK TO BACK
EXISTING= _____
NEW= _____

PAVING PROJECT LAYOUT # 23

SURVEYED BY N/A DATE N/A
DRAWN BY J.A.R. DATE 4/01
SQUAD LEADER T.P.K.
DESIGN FILE NO. pave/99dl56/pdl56.dgn
IPARM FILE pdl56l23.i DATE PLOT 4/01
PROJ. NAME BENNINGTON
PROJ. NO. NH 2202(1)S
SHEET 36 OF 108 SHEETS

DATUM	
VERTICAL	<u>N/A</u>
HORIZONTAL	<u>N/A</u>