

604.42 CHANGING ELEVATION OF DI, CB OR MH
 U.S. ROUTE 7:
 STA. 4+633.7 LT
 STA. 4+633.7 RT **REHAB TYPE I**
 STA. 4+634.3 RT **REHAB TYPE I**
 STA. 4+653.1 LT **REHAB TYPE I**
 STA. 4+653.7 LT **REHAB TYPE I**
 STA. 4+656.7 RT
 STA. 4+657.3 RT
 STA. 4+657.7 RT
 STA. 4+667.7 RT
 STA. 4+761.7 RT **REHAB TYPE I**
 STA. 4+855.7 RT
 STA. 4+863.7 RT
 STA. 4+654 RT **REHAB TYPE I**

604.42 CHANGE ELEVATION OF SEWER MANHOLE
 U.S. ROUTE 7:
 STA. 4+633.7 LT
 STA. 4+856.7 LT
 STA. 4+858.7 LT


629.20 ADJUST ELEVATION OF VALVE BOX
 U.S. ROUTE 7:
 STA. 4+655.7 RT
 STA. 4+666.7 RT
 STA. 4+671.7 RT
 STA. 4+755.7 RT
 STA. 4+861.7 RT
 STA. 4+864.7 RT

646.41 DURABLE 100 mm YELLOW LINE
 (ALL LINES WILL INCLUDE C/L BREAKS FOR TOWN HIGHWAYS) S=SOLID, D=DASHED
 U.S. ROUTE 7:
 STA. 4+628.473 - STA. 4+680.0 S - S
 STA. 4+850.0 - STA. 4+880.0 S - S
 STA. 4+663.879 DOUBLE SOLID RT, T-430
 STA. 4+680.0 - STA. 4+747.4 DOUBLE SOLID LT
 STA. 4+814.0 - STA. 4+850.0 DOUBLE SOLID RT
 646.61 TEMPORARY 100 mm YELLOW LINE
 (ALL LINES WILL INCLUDE C/L BREAKS FOR TOWN HIGHWAYS) S=SOLID, D=DASHED
 U.S. ROUTE 7:
 STA. 4+628.473 - STA. 4+680.0 S - S
 STA. 4+850.0 - STA. 4+880.0 S - S
 STA. 4+663.879 DOUBLE SOLID RT, T-430
 STA. 4+680.0 - STA. 4+747.4 DOUBLE SOLID LT
 STA. 4+814.0 - STA. 4+850.0 DOUBLE SOLID RT

646.40 DURABLE 100 mm WHITE LINE
 (ALL LINES WILL INCLUDE EDGE LINE BREAKS AND RADIUS FOR TOWN HIGHWAYS)
 U.S. ROUTE 7:
 STA. 4+628.473 - STA. 4+730.0 RT
 STA. 4+628.473 - STA. 4+634.573 LT, PARKING SPACES
 STA. 4+678.9 - STA. 4+697.8 LT, PARKING SPACES
 STA. 4+680.0 - STA. 4+730.0 RT, DOTTED LINE
 STA. 4+716.0 - STA. 4+741.6 LT, PARKING SPACES
 STA. 4+730.0 - STA. 4+752.7 RT, SOLID LINE (LANE LINE)
 STA. 4+792.8 - STA. 4+874.9 LT
 STA. 4+792.8 - STA. 4+880.0 RT
 STA. 4+802.0 - STA. 4+835.0 LT, SOLID LINE (LANE LINE)
 STA. 4+835.0 - STA. 4+850.0 LT, DOTTED LINE
 STA. 4+871.2 - STA. 4+880.0 LT, PARKING SPACES
 U.S. ROUTE 7:
 STA. 4+628.473 - STA. 4+730.0 RT
 STA. 4+628.473 - STA. 4+634.573 LT, PARKING SPACES
 STA. 4+678.9 - STA. 4+697.8 LT, PARKING SPACES
 STA. 4+680.0 - STA. 4+730.0 RT, DOTTED LINE
 STA. 4+716.0 - STA. 4+741.6 LT, PARKING SPACES
 STA. 4+730.0 - STA. 4+752.7 RT, SOLID LINE (LANE LINE)
 STA. 4+792.8 - STA. 4+874.9 LT
 STA. 4+792.8 - STA. 4+880.0 RT
 STA. 4+802.0 - STA. 4+835.0 LT, SOLID LINE (LANE LINE)
 STA. 4+835.0 - STA. 4+850.0 LT, DOTTED LINE
 STA. 4+871.2 - STA. 4+880.0 LT, PARKING SPACES

646.46 TEMPORARY 600 mm STOP BAR (TYPE I TAPE)
 U.S. ROUTE 7:
 STA. 4+663.879 RT, T-430
 STA. 4+747.7 RT
 STA. 4+753.0 RT
 STA. 4+801.7 LT
 STA. 4+813.7 LT
 646.50 DURABLE LETTER OR SYMBOL (TYPE I TAPE)
 U.S. ROUTE 7:
 STA. 4+663.879 RT, T-430, *S,T,O,P* (4 EA)
 STA. 4+681.9 LT, HANDICAP SYMBOL (1EA)
 STA. 4+731.3 RT, *O,N,L,Y* (4 EA)
 STA. 4+732.0 RT, ARROW (2 EA)
 STA. 4+735.0 RT, ARROW (1EA)
 STA. 4+830.0 LT, ARROW (1EA)
 STA. 4+833.0 LT, ARROW (2 EA)
 STA. 4+833.7 LT, *O,N,L,Y* (4 EA)
 STA. 4+810.0 LT, ARROW (2 EA)
 646.70 TEMPORARY LETTER OR SYMBOL
 U.S. ROUTE 7:
 STA. 4+663.879 RT, T-430, *S,T,O,P* (8 EA)
 STA. 4+732.0 RT, ARROW (4 EA)
 STA. 4+735.0 RT, ARROW (2 EA)
 STA. 4+830.0 LT, ARROW (2 EA)
 STA. 4+833.0 LT, ARROW (4 EA)

646.51 DURABLE CROSSWALK MARKING WITH DIAGONAL LINES (MOD.)
 U.S. ROUTE 7:
 STA. 4+663.879 RT, T-430
 STA. 4+671.0
 STA. 4+764.7
 STA. 4+791.6
 STA. 4+858.610 RT, T-342
 VT ROUTE 9
 STA 7+14 RT
 STA 7+14 RT - LT
 STA 7+14 LT
 STA 7+127 LT - RT
 618.20 BRICK PAVING (MOD.)
 U.S. 7 & VT. 9 INTERSECTION (PUTNAM SQUARE)
 646.71 TEMPORARY CROSSWALK MARKING WITH DIAGONAL LINES
 U.S. ROUTE 7:
 STA. 4+663.879 RT, T-430
 STA. 4+671.0
 STA. 4+764.7
 STA. 4+791.6
 STA. 4+858.610 RT, T-342
 675.50 REMOVING SIGNS
 AS SHOWN - 18
 675.60 ERECTING SALVAGED SIGNS
 AS SHOWN - 1
 REMOVE & RESET CURB
 STA 04+761.7 RT
 ITEM 618.30 DETECTABLE WARNING SURFACE
 MOD TRUNCATED DOME SURFACE APPLIED
 STA 4+656 RT STA 4+850
 STA 4+670 RT STA 4+867 RT
 STA 4+672 LT & RT

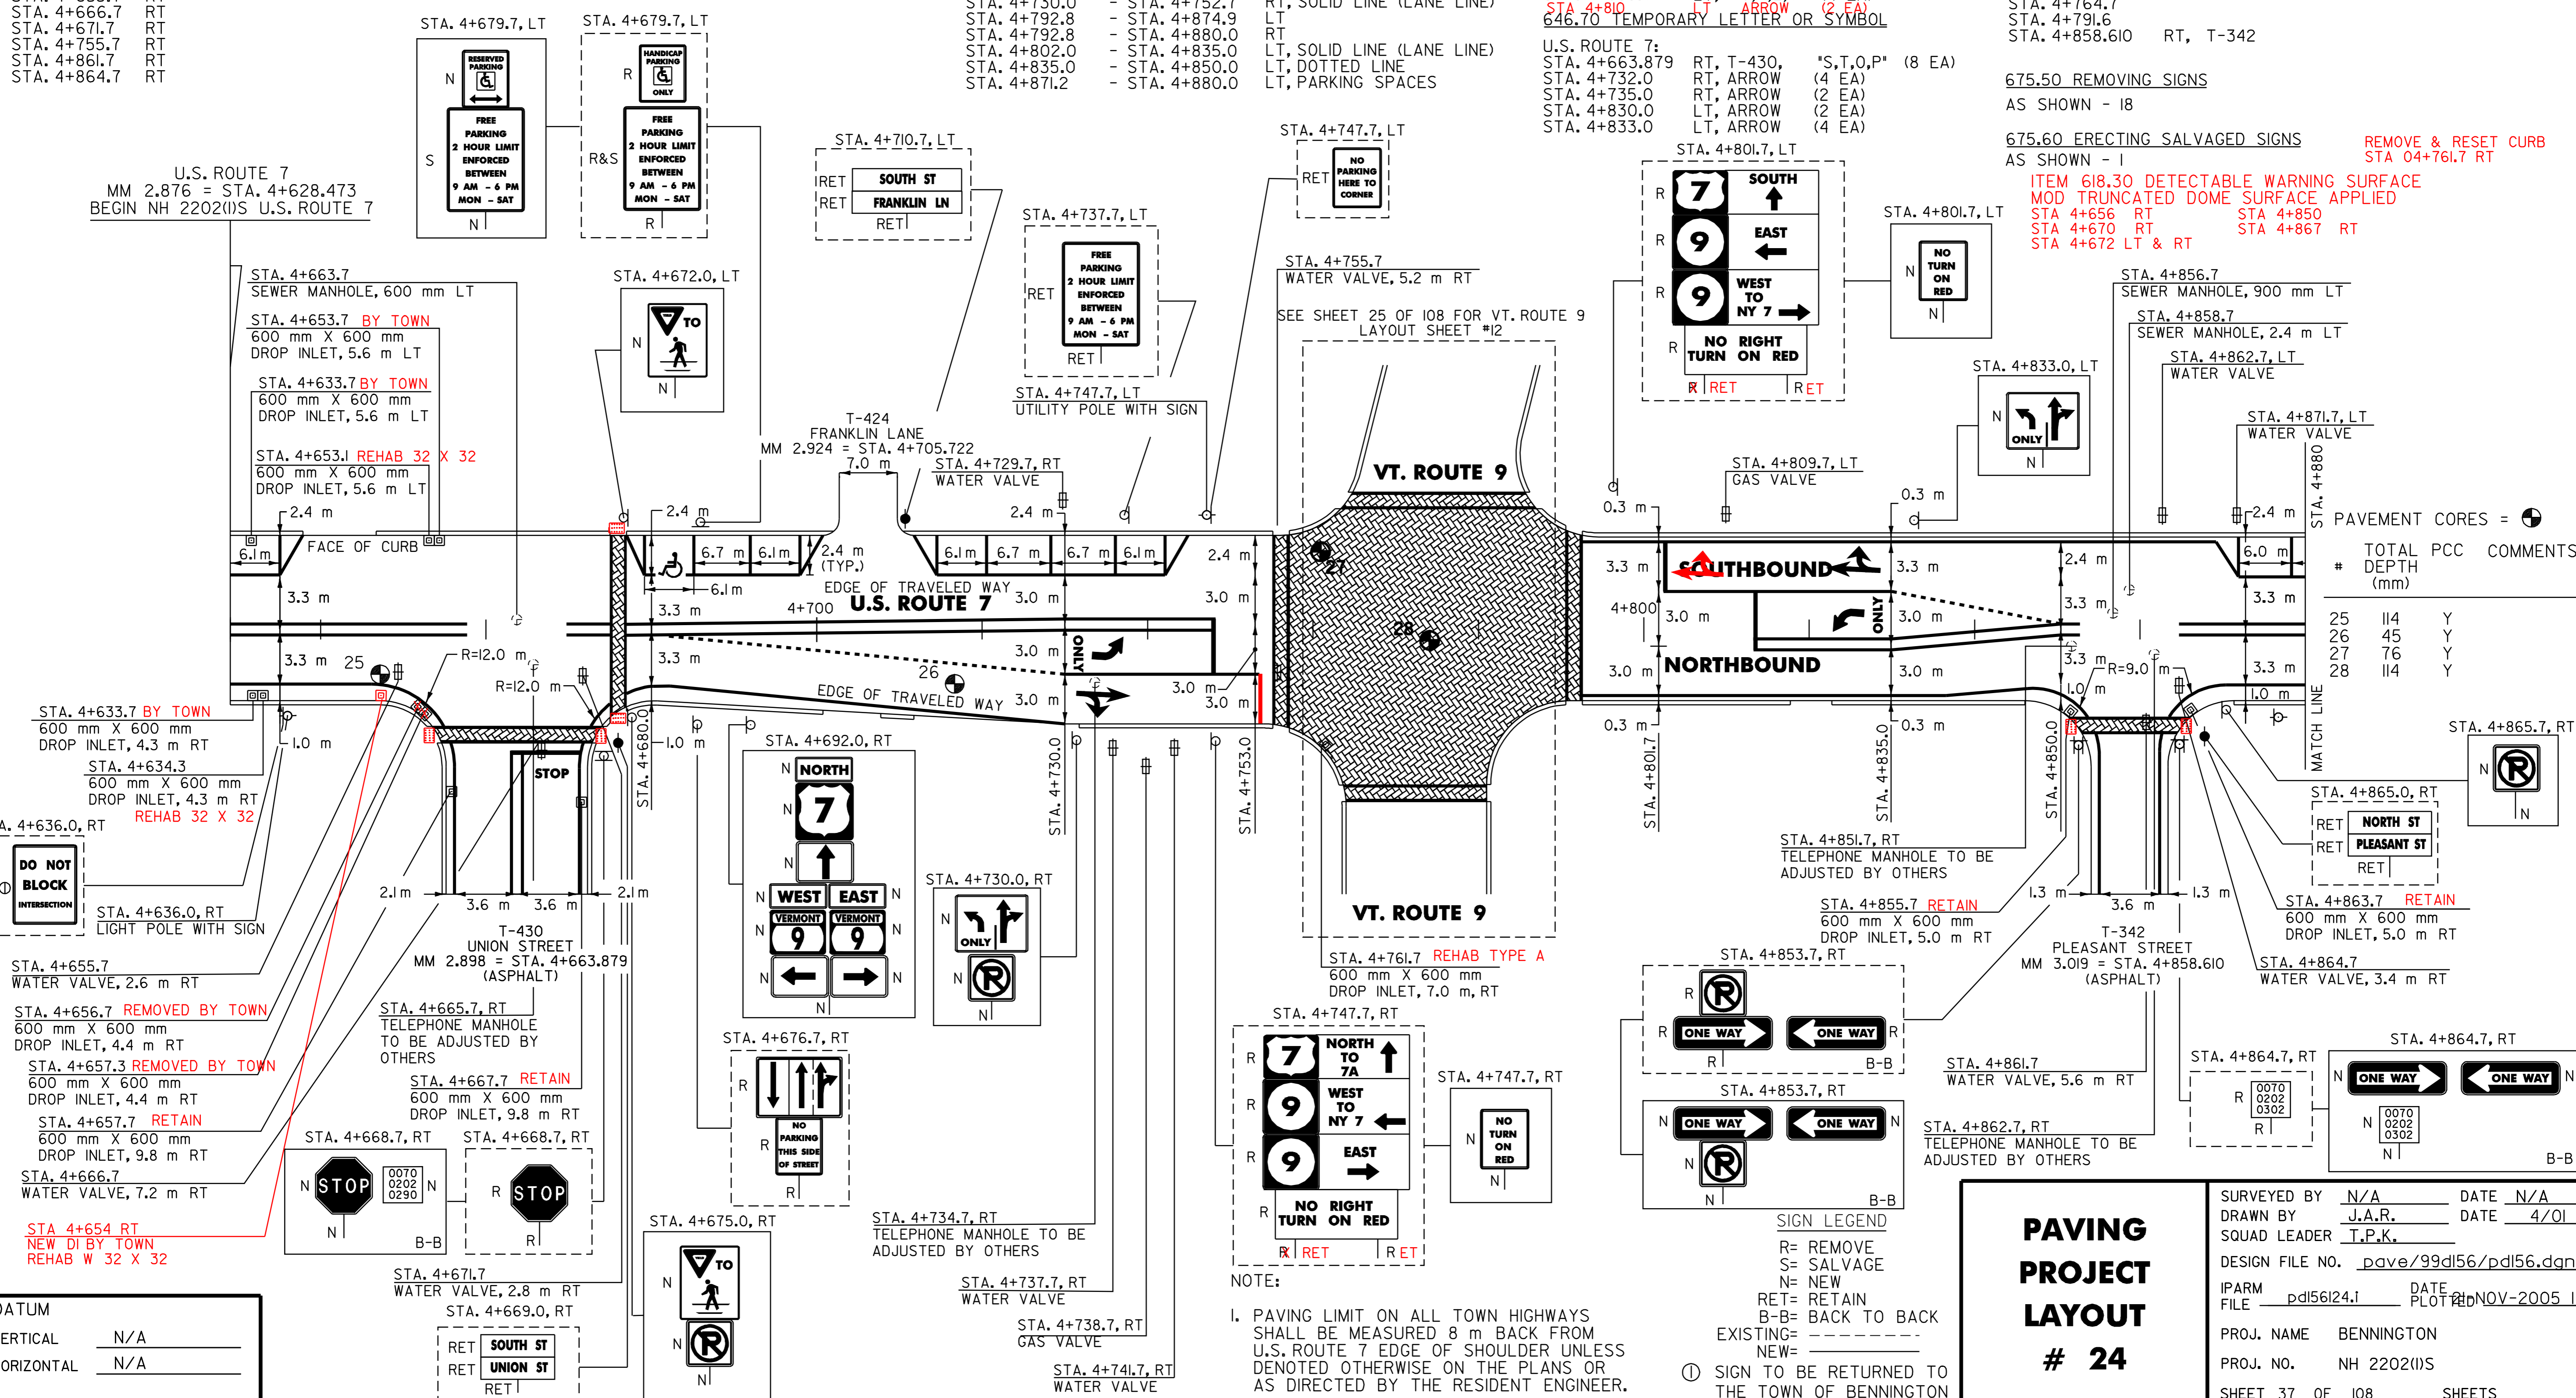

PAVEMENT CORES =

#	DEPTH (mm)	COMMENTS
25	114	Y
26	45	Y
27	76	Y
28	114	Y

NOTE:
 1. PAVING LIMIT ON ALL TOWN HIGHWAYS SHALL BE MEASURED 8 m BACK FROM U.S. ROUTE 7 EDGE OF SHOULDER UNLESS DENOTED OTHERWISE ON THE PLANS OR AS DIRECTED BY THE RESIDENT ENGINEER.

PAVING PROJECT LAYOUT # 24

SURVEYED BY N/A DATE N/A
 DRAWN BY J.A.R. DATE 4/01
 SQUAD LEADER T.P.K.
 DESIGN FILE NO. pave/99d156/pd156.dgn
 IPARM pd156124.i DATE NOV-2005
 FILE 0202 PLOT 0302
 PROJ. NAME BENNINGTON
 PROJ. NO. NH 2202(1)S
 SHEET 37 OF 108 SHEETS

DATUM
 VERTICAL N/A
 HORIZONTAL N/A