

646.4 DURABLE 100 mm YELLOW LINE
(ALL LINES WILL INCLUDE C/L BREAKS FOR TOWN HIGHWAYS) S=SOLID, D=DASHED

U.S. ROUTE 7:
STA. 4+880.0 - STA. 5+120.0

646.6 TEMPORARY 100 mm YELLOW LINE
(ALL LINES WILL INCLUDE C/L BREAKS FOR TOWN HIGHWAYS) S=SOLID, D=DASHED

U.S. ROUTE 7:
STA. 4+880.0 - STA. 5+120.0

646.40 DURABLE 100 mm WHITE LINE
(ALL LINES WILL INCLUDE EDGE LINE BREAKS AND RADIUS FOR TOWN HIGHWAYS)

U.S. ROUTE 7:
STA. 4+880.0 - STA. 5+120.0 RT
STA. 4+880.0 - STA. 4+896.8 LT, PARKING SPACES
STA. 4+918.3 - STA. 4+943.9 LT, PARKING SPACES
STA. 4+951.9 - STA. 4+977.5 LT, PARKING SPACES
STA. 4+987.6 - STA. 4+999.8 LT, PARKING SPACES
STA. 5+011.5 - STA. 5+030.4 LT, PARKING SPACES
STA. 5+030.4 - STA. 5+120.0 LT

646.60 TEMPORARY 100 mm WHITE LINE
(ALL LINES WILL INCLUDE EDGE LINE BREAKS AND RADIUS FOR TOWN HIGHWAYS)

U.S. ROUTE 7:
STA. 4+880.0 - STA. 5+120.0 RT
STA. 4+880.0 - STA. 4+896.8 LT, PARKING SPACES
STA. 4+918.3 - STA. 4+943.9 LT, PARKING SPACES
STA. 4+951.9 - STA. 4+977.5 LT, PARKING SPACES
STA. 4+987.6 - STA. 4+999.8 LT, PARKING SPACES
STA. 5+011.5 - STA. 5+030.4 LT, PARKING SPACES
STA. 5+030.4 - STA. 5+120.0 LT

646.5 DURABLE CROSSWALK MARKING WITH DIAGONAL LINES (MOD.)

U.S. ROUTE 7:
STA. 4+911.5
STA. 5+046.7

646.7 TEMPORARY CROSSWALK MARKING WITH DIAGONAL LINES


U.S. ROUTE 7:
STA. 4+911.5
STA. 5+046.7



675.50 REMOVING SIGNS
AS SHOWN - 2

ITEM 618.30 DETECTABLE WARNING SURFACE
MOD TRUNCATED DOME CAST IN PLACE
STA 5+047 LT & RT 0.929 m² EA

ITEM 618.30 DETECTABLE WARNING SURFACE
MOD TRUNCATED DOME SURFACE APPLIED
STA 4+913 LT & RT 0.743 m² EA

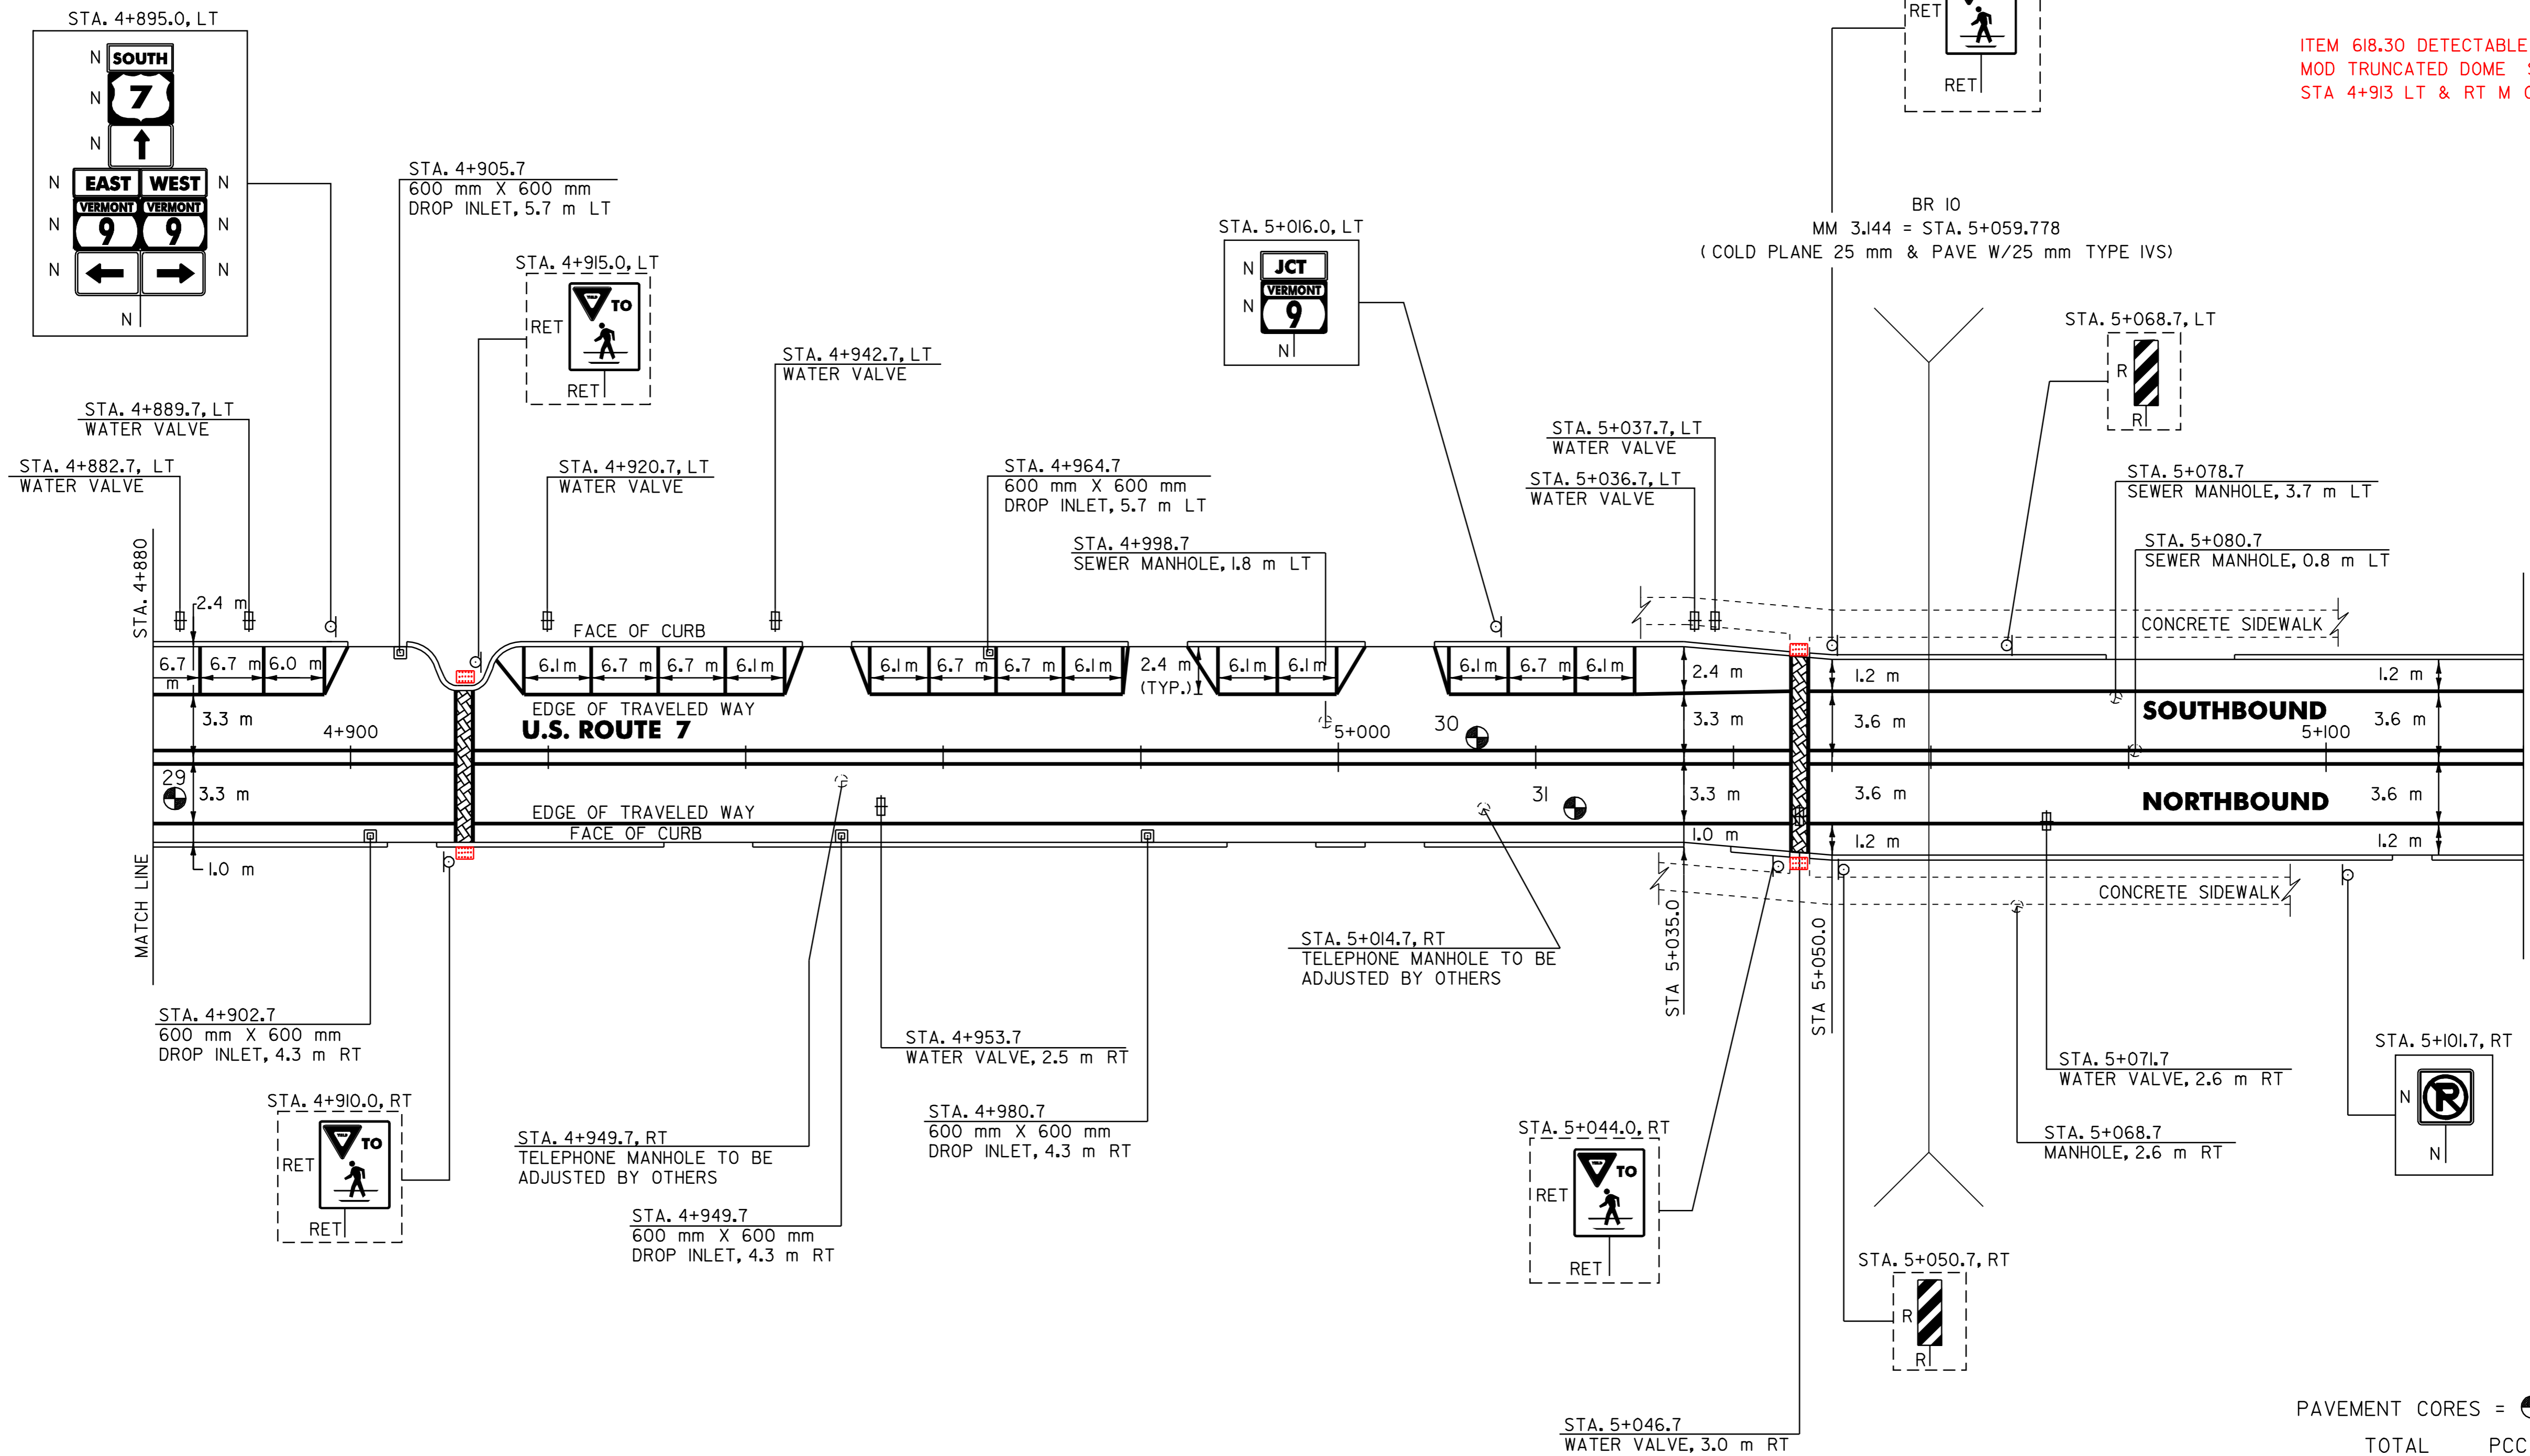

DATUM

VERTICAL	N/A
HORIZONTAL	N/A

604.40 CHANGE ELEVATION OF DI, CB OR MH

U.S. ROUTE 7:
STA. 4+902.7 RT
STA. 4+905.7 LT
STA. 4+949.7 RT
STA. 4+964.7 LT
STA. 4+980.7 RT

604.42 CHANGE ELEVATION OF SEWER MANHOLE

U.S. ROUTE 7:
STA. 4+998.7 LT
STA. 5+078.7 LT
STA. 5+080.7 LT

629.20 ADJUST ELEVATION OF VALVE BOX

U.S. ROUTE 7:
STA. 4+953.7 RT
STA. 5+046.7 RT
STA. 5+071.7 RT

STA 5+ 037 LT & RT

SIGN LEGEND

- R= REMOVE
- S= SALVAGE
- N= NEW
- RET= RETAIN
- B-B= BACK TO BACK
- EXISTING=
- NEW=

PAVING PROJECT LAYOUT # 25

SURVEYED BY <u>N/A</u> DATE <u>N/A</u>	DRAWN BY <u>J.A.R.</u> DATE <u>4/01</u>
SQUAD LEADER <u>T.P.K.</u>	
DESIGN FILE NO. <u>pave/99d156/pdl56.dgn</u>	
IPARM FILE <u>pdl56125.i</u>	DATE PLOT <u>24 NOV-2005 10</u>
PROJ. NAME <u>BENNINGTON</u>	
PROJ. NO. <u>NH 2202(1)S</u>	
SHEET 38 OF 108 SHEETS	

PAVEMENT CORES =

#	TOTAL DEPTH (mm)	PCC	COMMENTS
29	51	Y	
30	133	N	
31	114	-	