

646.40 DURABLE 100 mm WHITE LINE  
(ALL LINES WILL INCLUDE EDGE LINE BREAKS AND RADIUS FOR TOWN HIGHWAYS)

BENNINGTON:  
STA. I+080.0 - STA. I+620.0 LT & RT

646.41 DURABLE 100 mm YELLOW LINE  
(ALL LINES WILL INCLUDE C/L BREAKS FOR TOWN HIGHWAYS) S=SOLID, D=DASHED

BENNINGTON:  
STA. I+080.0 - STA. I+620.0 LT S  
STA. I+393.692 DOUBLE SOLID LT, T-72  
STA. I+599.688 DOUBLE SOLID RT, T-42

646.61 TEMPORARY 100 mm YELLOW LINE

BENNINGTON:  
STA. I+393.692 DOUBLE SOLID LT, T-72  
STA. I+599.688 DOUBLE SOLID RT, T-42

646.46 DURABLE 600 mm STOP BAR

BENNINGTON:  
STA. I+393.692 LT, T-72  
STA. I+599.688 RT, T-42

646.66 TEMPORARY 600 mm STOP BAR

BENNINGTON:  
STA. I+393.692 LT, T-72  
STA. I+599.688 RT, T-42

646.50 DURABLE LETTER OR SYMBOL

BENNINGTON:  
STA. I+393.692 LT, T-72, 'S,T,O,P' (4 EA)  
STA. I+599.688 RT, T-42, 'S,T,O,P' (4 EA)

646.70 TEMPORARY LETTER OR SYMBOL


BENNINGTON:  
STA. I+393.692 LT, T-72, 'S,T,O,P' (4 EA)  
STA. I+599.688 RT, T-42, 'S,T,O,P' (4 EA)

675.50 REMOVING SIGNS

AS SHOWN - 16

675.60 ERECTING SALVAGED SIGNS

AS SHOWN - 3

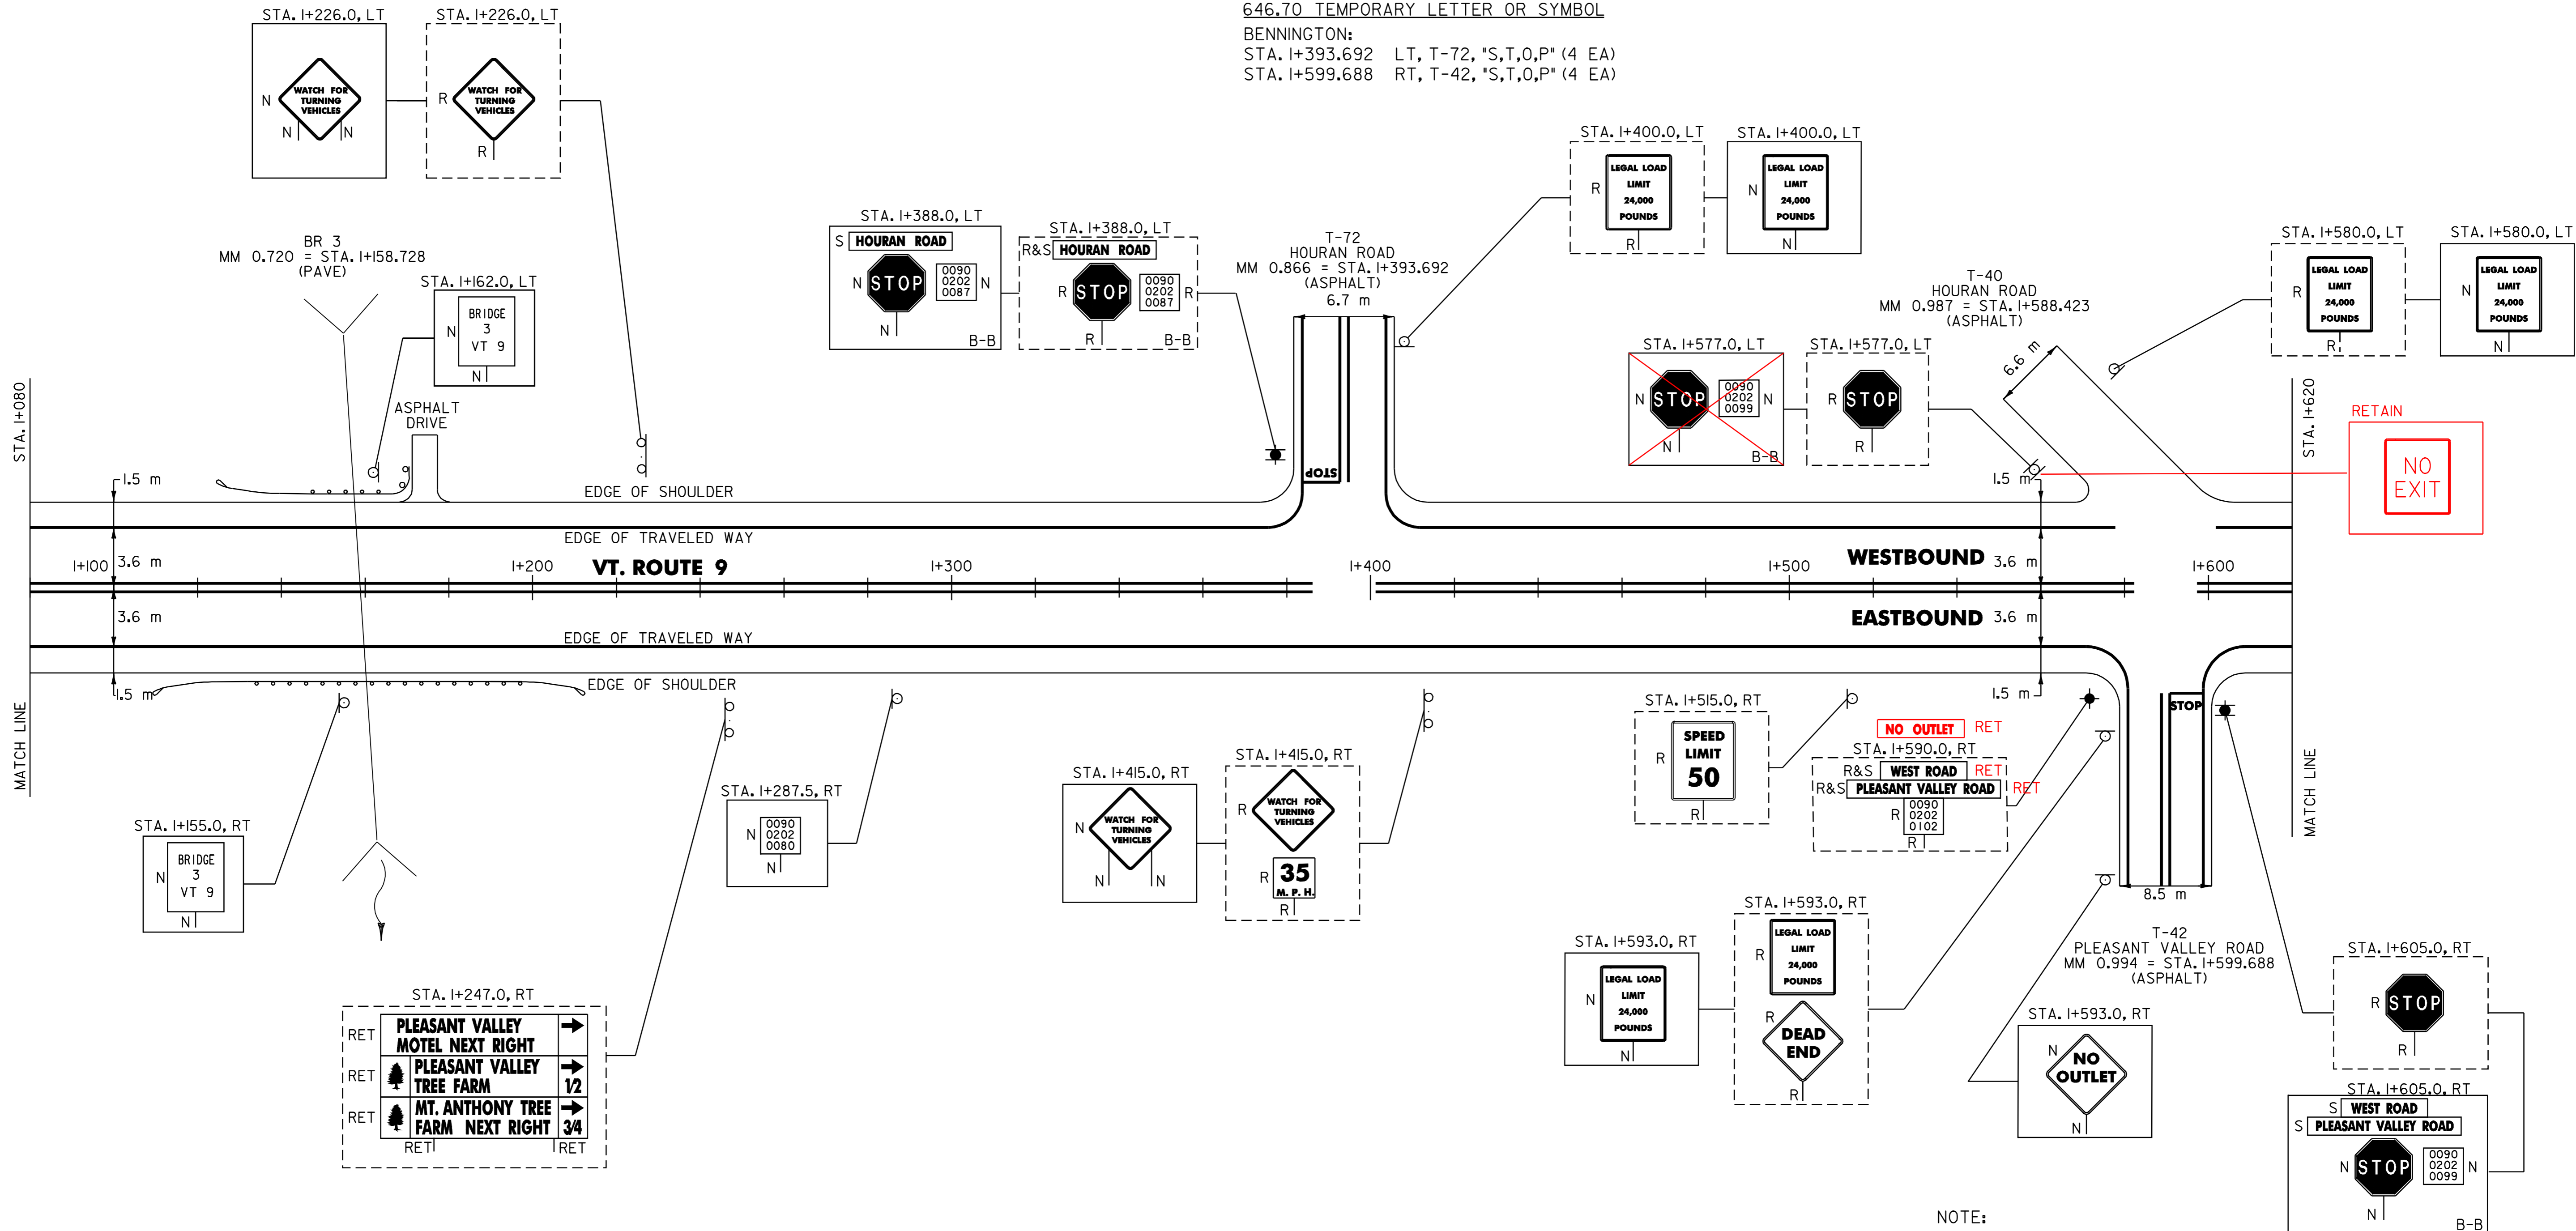

NOTE:  
I. PAVING LIMIT ON ALL TOWN HIGHWAYS SHALL BE MEASURED 8 m BACK FROM VT. ROUTE 9 EDGE OF SHOULDER UNLESS DENOTED OTHERWISE ON THE PLANS OR AS DIRECTED BY THE RESIDENT ENGINEER.

621.20 STEEL BEAM GUARDRAIL W/2.4 m POSTS (MOD.)  
BENNINGTON:  
0+108.5 STA. I+109.6 - STA. I+212.2 RT (102.6 m)  
STA. I+124.8 - STA. I+155.2 LT (30.4 m)  
0+122.9 I+161LT  
621.505 MANUFACTURED TERMINAL SECTION (FLARED)  
BENNINGTON:  
STA. I+109.6 RT I+097.1 - I+168.5 RT  
STA. I+124.8 LT I+111.5 - I+122.9 LT  
STA. I+155.2 LT  
STA. I+212.2 RT I+211.4 - I+222.8 RT

621.80 REMOVAL AND DISPOSAL OF GUARDRAIL  
BENNINGTON:  
STA. I+101.0 - STA. I+201.0 RT (100.0 m)  
STA. I+115.0 - STA. I+166.0 LT (51.0 m)

SIGN LEGEND  
R= REMOVE  
S= SALVAGE  
N= NEW  
RET= RETAIN  
B-B= BACK TO BACK  
EXISTING= - - - - -  
NEW= \_\_\_\_\_

<h2>PAVING PROJECT LAYOUT</h2> <h3># 3</h3>	SURVEYED BY	N/A	DATE	N/A
	DRAWN BY	C.A.K.	DATE	12/00
	SQUAD LEADER	T.P.K.		
	DESIGN FILE NO.	/pave/99d156/pd156.dgn		
	IPARM FILE	pb054103.1	DATE PLOTTED	\$DATE\$
PROJ. NAME	BENNINGTON			
PROJ. NO.	NH 2225(I)S			
SHEET	89 OF 108	SHEETS		

DATUM	
VERTICAL	N/A
HORIZONTAL	N/A