


646.40 DURABLE 100 mm WHITE LINE
 (ALL LINES WILL INCLUDE EDGE LINE BREAKS AND RADIUS FOR TOWN HIGHWAYS)
 BENNINGTON:
 STA. 3+240.0 - STA. 3+780.0 LT & RT

646.41 DURABLE 100 mm YELLOW LINE
 (ALL LINES WILL INCLUDE C/L BREAKS FOR TOWN HIGHWAYS) S=SOLID, D=DASHED
 BENNINGTON:
 STA. 3+240.0 - STA. 3+780.0 S Q RT
 S - S

675.50 REMOVING SIGNS
 AS SHOWN - 4

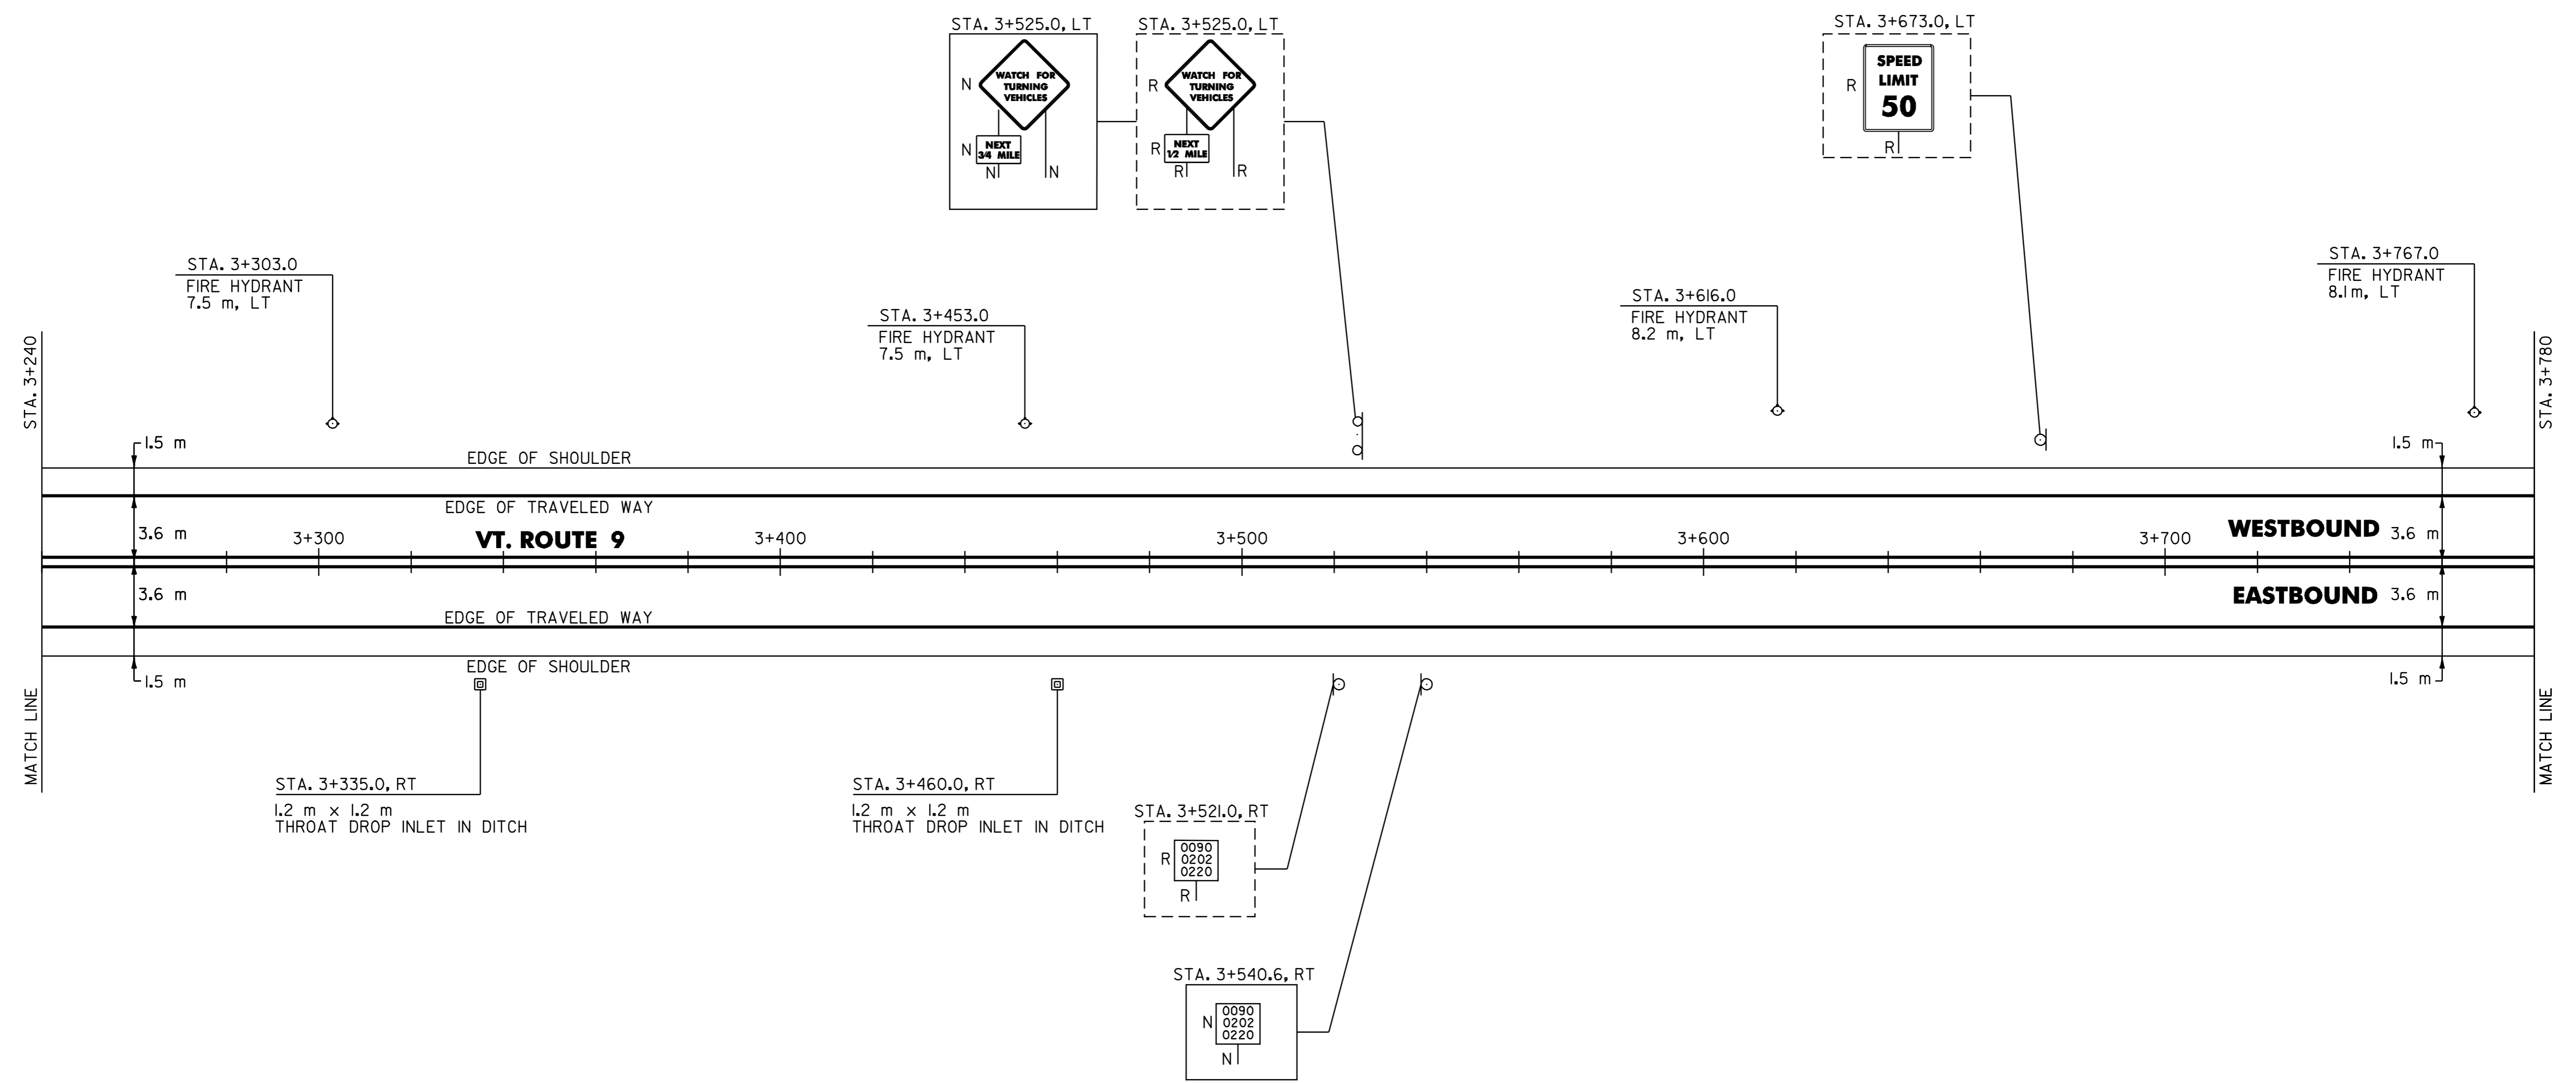

DATUM	
VERTICAL	N/A
HORIZONTAL	N/A

604.412 REHABING DI, CB OR MH, CLASS I
 BENNINGTON:
 STA. 3+335.0 RT
 STA. 3+460.0 RT

SIGN LEGEND
 R= REMOVE
 S= SALVAGE
 N= NEW
 RET= RETAIN
 B-B= BACK TO BACK
 EXISTING= - - - - -
 NEW= _____

PAVING PROJECT LAYOUT # 7

SURVEYED BY	N/A	DATE	N/A
DRAWN BY	C.A.K.	DATE	12/00
SQUAD LEADER	T.P.K.		
DESIGN FILE NO.	/pave/99dl56/pdl56.dgn		
IPARM FILE	pb054107.i	DATE PLOTTED	\$DATE\$
PROJ. NAME	BENNINGTON		
PROJ. NO.	NH 2225(I)S		
SHEET	93 OF 108	SHEETS	