


STATE OF VERMONT
AGENCY OF TRANSPORTATION



PROPOSED IMPROVEMENT
TOWN OF BENNINGTON
COUNTY OF BENNINGTON
VT.ROUTE 9 / US ROUTE 7

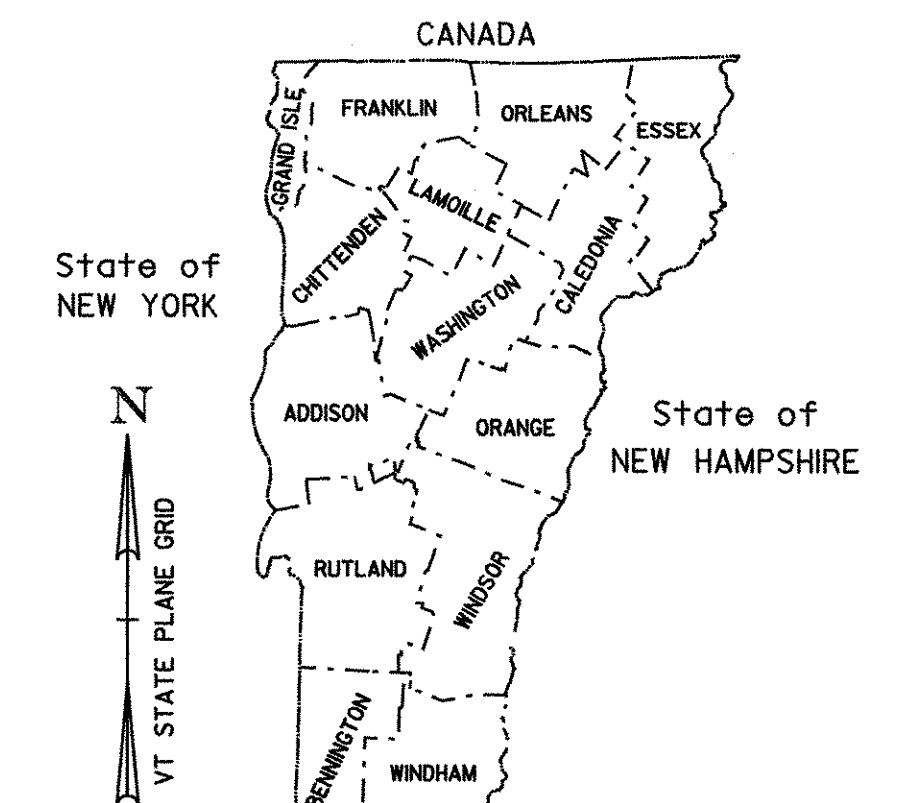

PROJECT LOCATION
NH 2225(1)S
NH 2202(1)S

RECORD PLANS

CONTRACTOR: F.W. WHITCOMB CONSTRUCTION - WALPOLE, NH

RESIDENT ENGINEER: T. POCKETTE

CONSTRUCTION BEGAN: AUGUST 4, 2003

CONSTRUCTION COMPLETE:

RECORD PLANS BY: T. POCKETTE, C. BUMP


I HEREBY CERTIFY THAT ALL THE CONSTRUCTION REQUIRED BY THIS SET OF DRAWINGS HAS BEEN ACCOMPLISHED AS INDICATED HEREIN.

BY: *[Signature]* RESIDENT ENGINEER


DATE: *SEPT 26, 2005*

NOTE: Any further information concerning final quantities, amounts or other details relative to this project may be found at Central Files in the electronic archives.

**BENNINGTON
NH 2225(1)S
VT ROUTE 9**
SEE SHEET 81 OF 108


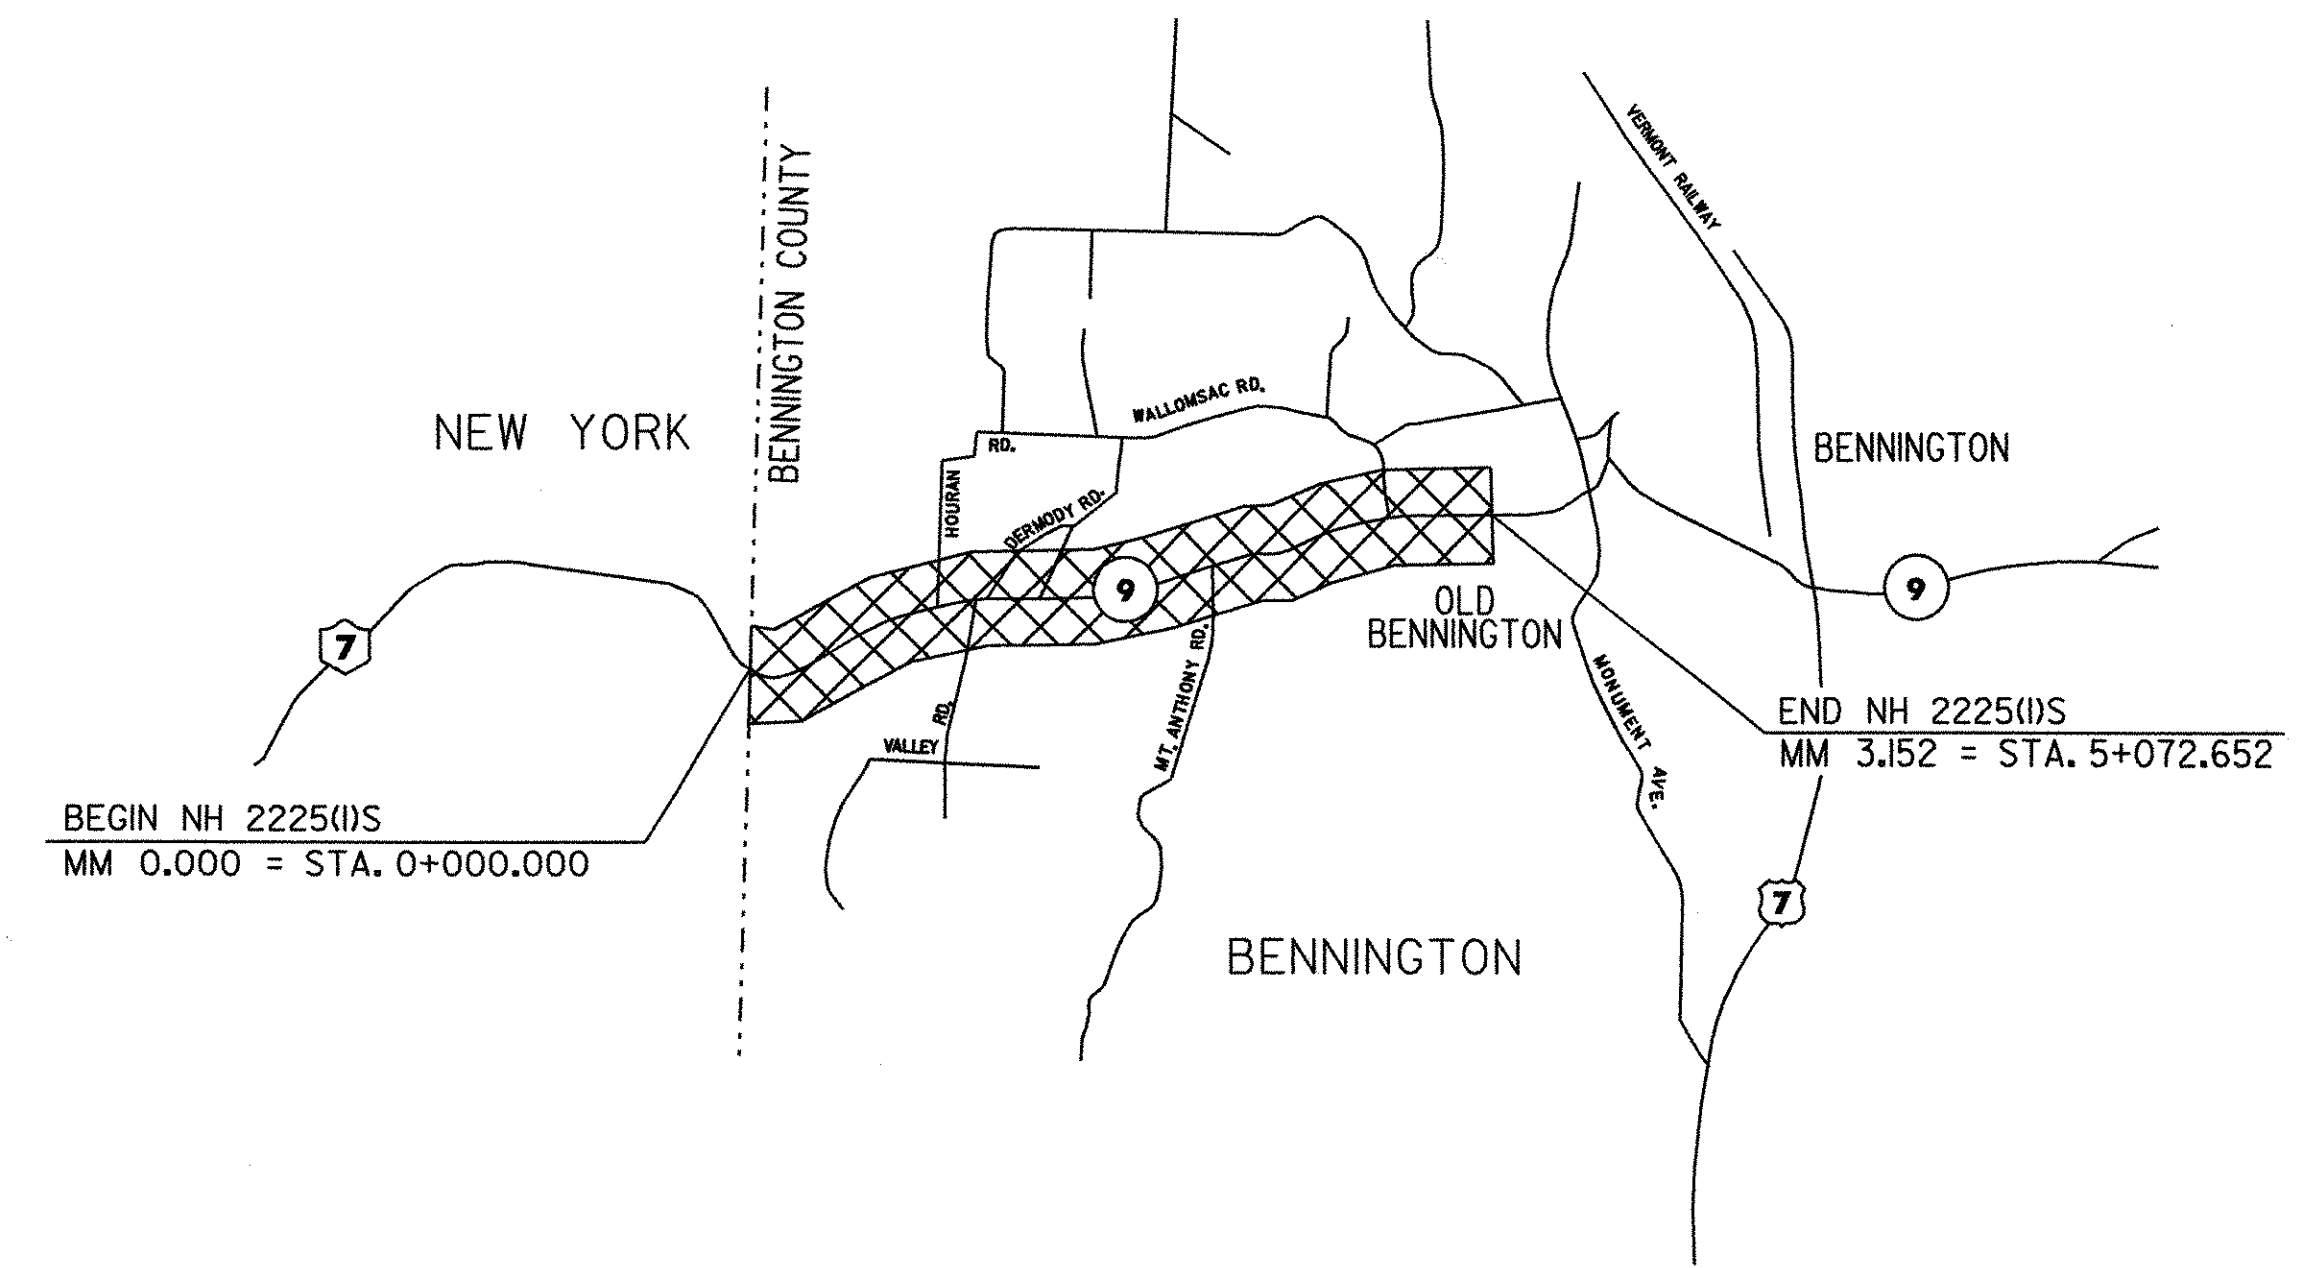


**BENNINGTON
NH 2202(1)S
VT ROUTE 9 / US ROUTE 7**
SEE SHEET 5 OF 108

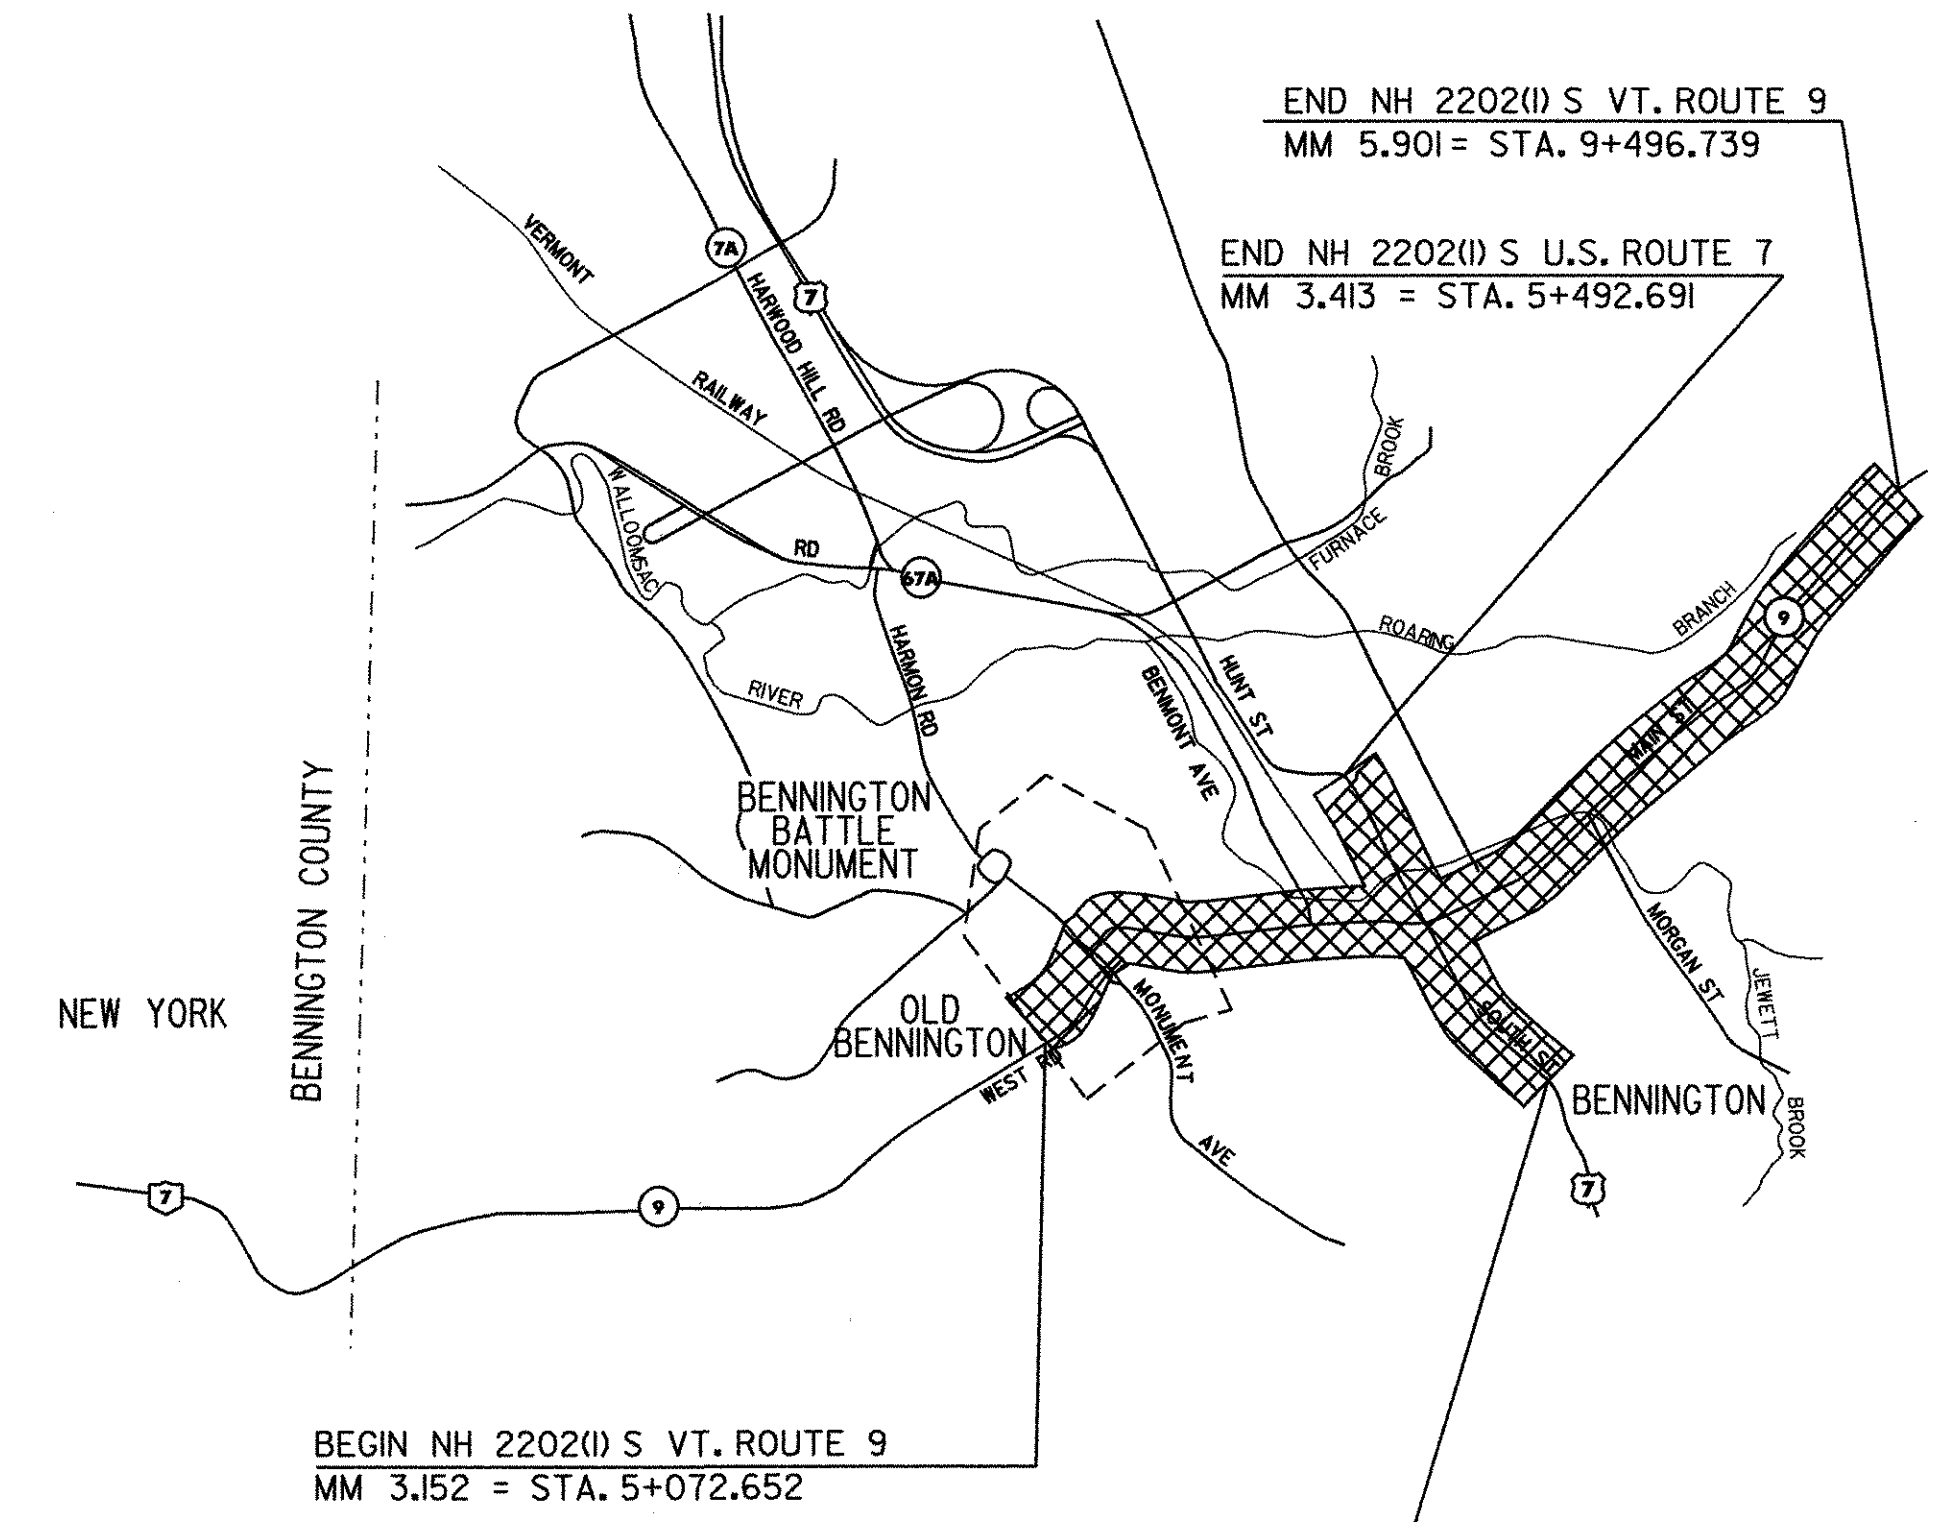

CONVENTIONAL SIGNS

COUNTY LINE	---
TOWN LINE	- - - -
LIMITS OF ACCESS	—o—o—o—
POINT OF ACCESS	X
FENCE LINE	-x-x-
STONE WALL	=====
TRAVELED WAY	=====
GUARD RAIL	—o—o—o—
RAILROAD	—+—+—+—
SURVEY LINE	—+—+—+—
CULVERT	—+—+—+—
POWER POLE	⊕
TELEPHONE POLE	⊕
TREES	⊗ * *
CONTROL OF ACCESS	///
PROPERTY LINE	—+—+—+—
R.O.W. TAKING LINE	—+—+—+—
SLOPE RIGHTS	—o—o—o—
TOP OF CUT	—+—+—+—
TOE OF SLOPE	—o—o—o—

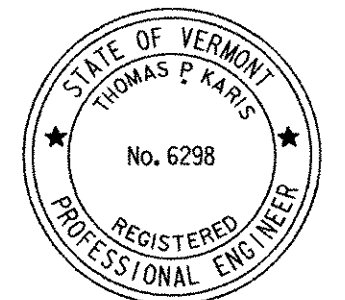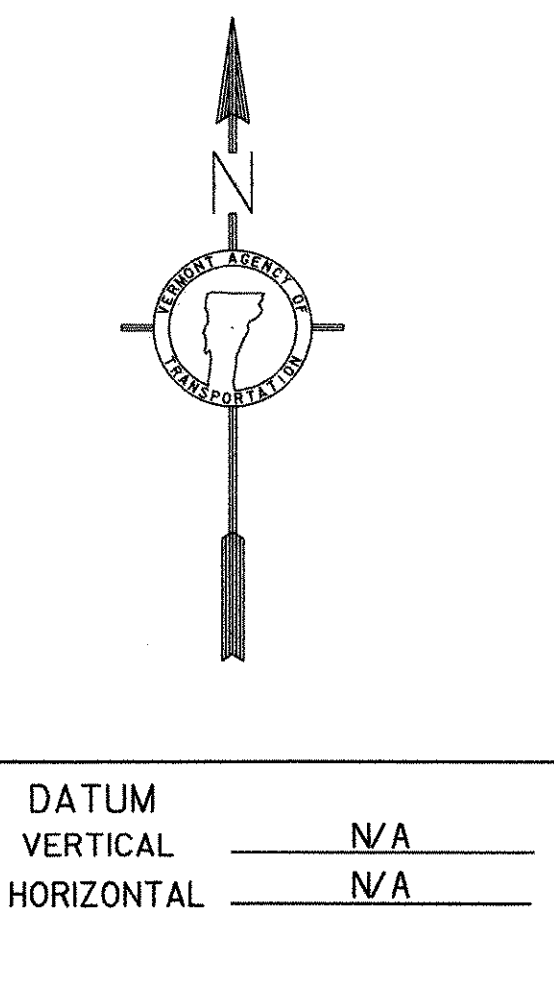

PLANS PREPARED BY
CHA CLOUGH, HARBOUR & ASSOCIATES LLP
ENGINEERS, SURVEYORS, PLANNERS & LANDSCAPE ARCHITECTS
111 WINNERS CIRCLE ALBANY, NEW YORK, 12205

BY _____

UNLESS OTHERWISE NOTED, ALL DRAWINGS AND DETAILS OF THE PROJECT PLANS ARE NOT TO SCALE.

RIGHT OF WAY LIMITS, IF APPLICABLE, ARE PROVIDED SOLELY FOR THE CONVENIENCE OF THE STATE AND ITS CONTRACTOR DURING THE COURSE OF THIS PAVING PROJECT. ANY REFERENCES TO OFFSETS ON THESE PLANS ARE APPROXIMATE AND SHOULD NOT BE RELIED UPON FOR ANY OTHER PURPOSES.

THESE PLANS ARE SUBJECT TO SUCH ENGINEERING CHANGES AS MAY BE REQUIRED BY THE FEDERAL HIGHWAY ADMINISTRATION OR THE DIRECTOR OF PROJECT DEVELOPMENT.

CONSTRUCTION IS TO BE CARRIED ON IN ACCORDANCE WITH THESE PLANS AND THE STANDARD SPECIFICATIONS FOR CONSTRUCTION DATED 2001, AS APPROVED BY THE FEDERAL HIGHWAY ADMINISTRATION ON JANUARY 4, 2001 FOR USE ON THIS PROJECT, INCLUDING ALL SUBSEQUENT REVISIONS AND SUCH REVISED SPECIFICATIONS AND SPECIAL PROVISIONS AS ARE INCORPORATED IN THESE PLANS.



APPROVED _____ DATE _____
DIRECTOR OF PROGRAM DEVELOPMENT

DEPARTMENT OF TRANSPORTATION
FEDERAL HIGHWAY ADMINISTRATION

APPROVED _____ DATE _____
DIVISION ADMINISTRATOR

PROJECT BENNINGTON BENNINGTON
NH 2202(1)S NH 2225(1)S
SHEET 1 OF 108 SHEETS

INDEX OF SHEETS

INDEX

1	COMPOSITE TITLE SHEET
2	COMPOSITE INDEX OF SHEETS
3-4	COMPOSITE QUANTITY SHEETS

BENNINGTON NH 2202(I)S

5	TITLE SHEET
6	INDEX OF SHEETS
7	PROJECT TYPICAL SHEET
8	PAVING DETAILS & PAVEMENT JOINT DETAIL SHEET
9-10	QUANTITY SHEETS
11-13	ITEM DETAIL SUMMARY SHEETS
14-40	LAYOUT SHEETS
41-47	TRAFFIC LOOP LAYOUT SHEETS
48-68	TRAFFIC SIGN SUMMARY SHEETS
69	TRAFFIC SIGN DETAIL SHEET
70	PAVEMENT MARKINGS & SIDEWALK RAMP TEXTURING DETAIL SHEET
71-72	DETOUR SIGNING SHEETS
73-79	DETOUR SIGN SUMMARY SHEETS
80	CONSTRUCTION APPROACH SIGNING DETAIL SHEET

BENNINGTON NH 2225(I)S

81	TITLE SHEET
82	PROJECT TYPICAL SHEET
83	PAVING DETAILS AND PAVEMENT JOINT DETAIL SHEET
84-85	QUANTITY SHEETS
86	ITEM DETAIL SUMMARY SHEET
87-96	LAYOUT SHEETS
97-106	TRAFFIC SIGN SUMMARY SHEETS
107	TRAFFIC SIGN DETAIL SHEET
108	CONSTRUCTION APPROACH SIGNING SHEET

VAOT STANDARDS

C-1M	CAST IN PLACE CONCRETE CURB	01-03-00
C-2AM	PORTLAND CEMENT CONCRETE SIDEWALK	01-03-00
C-3M	SIDEWALK RAMPS	01-03-00
D-8M	REINFORCED CONCRETE DROP INLET	01-03-00
D-9M	REINFORCED CONCRETE DROP INLET	06-13-97
D-11M	STEEL GRATE, CAST IRON GRATE TYPE A, CAST IRON COVER	06-13-97
D-15M	CAST IRON GRATE WITH FRAME, TYPE D	06-13-97
E-100M	CONSTRUCTION APPROACH SIGNS	06-13-97
E-101M	CONSTRUCTION SIGN DETAILS	06-13-97
E-102M	CONSTRUCTION SIGN DETAILS	06-13-97
E-102AM	CONSTRUCTION SIGN DETAILS	06-13-97
E-103M	MAINLINE TRAFFIC CONTROL DIVIDED HIGHWAY ONE LANE CLOSED	09-24-98
E-106M	TRAFFIC CONTROL - MISCELLANEOUS DETAILS	06-13-97
E-107M	DELINEATION, BARRICADES AND DETOURS FOR CONSTRUCTION AREAS	06-13-97
E-107AM	BREAKAWAY BARRICADE DETAILS	06-13-97
E-108M	CONSTRUCTION ZONE LONGITUDINAL DROP OFFS	06-13-97
E-110M	MAJOR MAINTENANCE OPERATION LANE CLOSURE	06-13-97
E-111M	MAINTENANCE OPERATION APPROACH SIGNS	02-17-98
E-121M	STANDARD SIGN PLACEMENT - CONVENTIONAL ROAD	06-13-97
E-123M	GUIDE SIGN PLACEMENT- MISCELLANEOUS DETAILS	06-13-97
E-128AM	DETAILING VILLAGE SIGNS (A-M)	06-13-97
E-128BM	DETAILING VILLAGE SIGNS (N-W)	06-13-97
E-131M	GUIDE SIGN DETAILS	06-13-97
E-132M	GENERAL MOTORIST SERVICE SIGN DETAILS	06-13-97
E-134M	BRIDGE NUMBER PLAQUE	06-13-97
E-136AM	U.S. ROUTE MARKER SIGN DETAILS	06-13-97
E-136BM	STATE ROUTE MARKER SIGN DETAILS	06-13-97
E-138M	REFERENCE PLAQUE DETAILS STATE AND TOWN HIGHWAYS	06-13-97
E-140M	REGULATORY SIGN DETAILS	06-13-97
E-141M	REGULATORY SIGN DETAILS	06-13-97
E-142M	REGULATORY SIGN DETAILS	06-13-97
E-143M	REGULATORY SIGN DETAILS	06-13-97
E-144M	REGULATORY SIGN DETAILS	06-13-97
E-145AM	REGULATORY SIGN DETAILS - LANE USE CONTROL SIGNS	06-13-97
E-146M	REGULATORY SIGN DETAILS	06-13-97
E-151M	WARNING SIGN DETAILS	06-13-97
E-152M	WARNING SIGN DETAILS	06-13-97
E-153M	WARNING SIGN DETAILS	06-13-97
E-154M	WARNING SIGN DETAILS	06-13-97
E-155M	WARNING SIGN DETAILS	06-13-97
E-160M	FLANGED CHANNEL STEEL SIGN POST	06-13-97
E-162M	TUBULAR ALUMINUM SIGN POST	06-13-97
E-164M	SQUARE STEEL SIGN POST	06-13-97
E-172M	VEHICLE DETECTOR LOOP DETAILS	06-13-97
E-173M	PULL BOXES AND JUNCTION BOXES	06-13-97
E-191M	PAVEMENT MARKING DETAILS	02-01-99
E-192M	PAVEMENT MARKING DETAILS	12-28-98
E-193M	PAVEMENT MARKING DETAILS	06-13-97
G-1M	STEEL BEAM GUARDRAIL WITH STEEL POSTS	01-03-00
G-4M	YIELDING MARKER POSTS	06-13-97
G-19M	GENERIC GRADING PLAN FOR GUARDRAIL TERMINALS	10-21-98

DATUM	
VERTICAL	N/A
HORIZONTAL	N/A

INDEX OF SHEETS	SURVEYED BY	N/A	DATE	N/A
	DRAWN BY	J.A.R.	DATE	4/01
	SQUAD LEADER	T.P.K.		
	DESIGN FILE NO.	pave/99d156/pd156.dgn		
	IPARM FILE	pd156cl.i	DATE PLOTTED	21-NOV-2005
	PROJ. NAME	BENNINGTON		
	PROJ. NO.	NH 2202(I)S, NH 2225(I)S		
	SHEET	2	OF 108	SHEETS

STATE OF VERMONT AGENCY OF TRANSPORTATION




PROPOSED IMPROVEMENT CLASS I TOWN HIGHWAY VILLAGE OF OLD BENNINGTON/ TOWN OF BENNINGTON COUNTY OF BENNINGTON VT. ROUTE 9 / U.S. ROUTE 7

BEGINNING AT MILE MARKER 3.152 = STA. 5+072.652 AND EXTENDING EASTERLY ALONG VT. ROUTE 9 FOR A DISTANCE OF 4424.087 m (2.749 MILES) TO MILE MARKER 5.901 = STA. 9+496.739. THE PROJECT ALSO BEGINS AT MILE MARKER 2.876 = STA. 4+628.473 AND EXTENDS NORTHERLY ALONG U.S. ROUTE 7 FOR A DISTANCE OF 864.218 m (0.537 MILE) TO MILE MARKER 3.413 = STA. 5+492.691.

LENGTH OF ROADWAY 5288.305 m (3.286 MILES)
LENGTH OF PROJECT 5288.305 m (3.286 MILES)

WORK TO BE PERFORMED UNDER THIS PROJECT INCLUDES COLD PLANING, RESURFACING WITH A SHIM / LEVELING COURSE AND WEARING COURSE, VEHICLE DETECTOR LOOPS, NEW PAVEMENT MARKINGS, NEW SIGNS, DRAINAGE IMPROVEMENTS AND INCIDENTAL ITEMS.


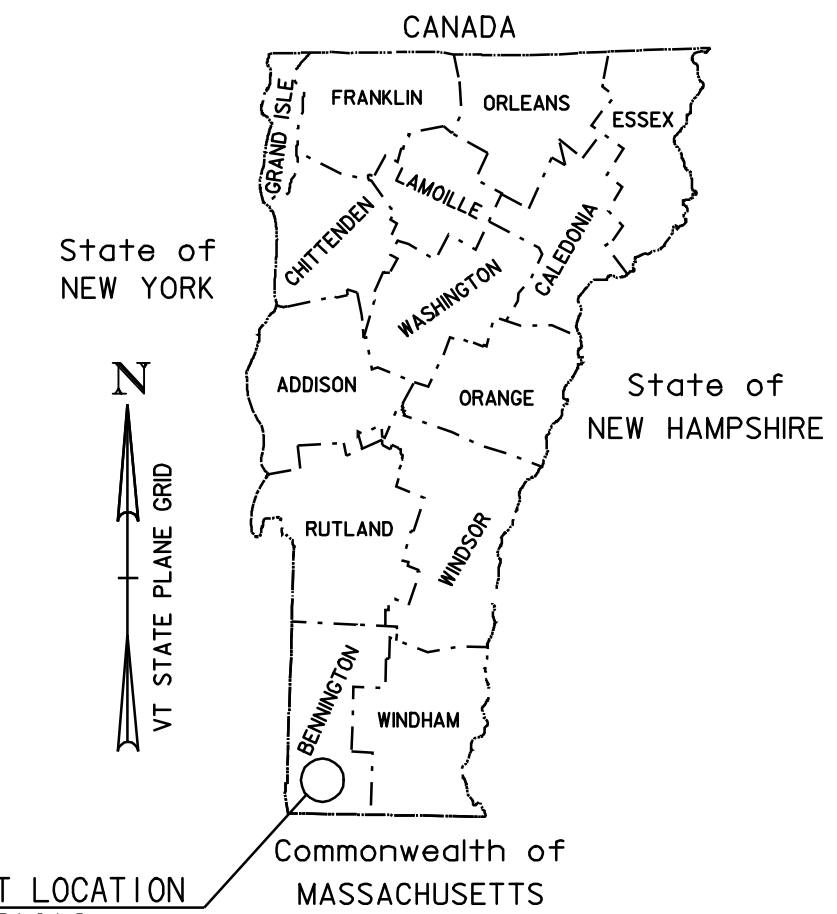


TRAFFIC DATA

VT. ROUTE 9 (BEGIN PROJECT TO MM 3.700)	VT. ROUTE 9 (MM 5.540 TO END PROJECT)
2002 ADT = 11,000	2002 ADT = 6,300
2002 DHV = 1,400	2002 DHV = 820
2012 ADT = 13,200	2012 ADT = 7,600
2012 DHV = 1,600	2012 DHV = 940
2002 ~ 2012 CUM. ESALS = 4,111,000	2002 ~ 2012 CUM. ESALS = 2,480,000
2002 ~ 2022 CUM. ESALS = 10,394,000	2002 ~ 2022 CUM. ESALS = 6,272,000
VT. ROUTE 9 (MM 3.700 TO MM 4.070)	U.S. ROUTE 7 (BEGIN PROJECT TO MM 2.970)
2002 ADT = 11,200	2002 ADT = 11,800
2002 DHV = 1,200	2002 DHV = 1,200
2012 ADT = 13,400	2012 ADT = 14,100
2012 DHV = 1,300	2012 DHV = 1,400
2002 ~ 2012 CUM. ESALS = 3,881,000	2002 ~ 2012 CUM. ESALS = 1,804,000
2002 ~ 2022 CUM. ESALS = 9,800,000	2002 ~ 2022 CUM. ESALS = 4,542,000
VT. ROUTE 9 (MM 4.070 TO MM 4.400)	U.S. ROUTE 7 (MM 2.970 TO MM 3.380)
2002 ADT = 10,400	2002 ADT = 11,300
2002 DHV = 1,200	2002 DHV = 1,200
2012 ADT = 12,400	2012 ADT = 13,600
2012 DHV = 1,300	2012 DHV = 1,400
2002 ~ 2012 CUM. ESALS = 2,360,000	2002 ~ 2012 CUM. ESALS = 2,157,000
2002 ~ 2022 CUM. ESALS = 5,930,000	2002 ~ 2022 CUM. ESALS = 5,443,000
VT. ROUTE 9 (MM 4.400 TO MM 4.970)	U.S. ROUTE 7 (MM 3.380 TO END PROJECT)
2002 ADT = 13,700	2002 ADT = 12,600
2002 DHV = 1,400	2002 DHV = 1,300
2012 ADT = 16,400	2012 ADT = 15,100
2012 DHV = 1,600	2012 DHV = 1,500
2002 ~ 2012 CUM. ESALS = 2,841,000	2002 ~ 2012 CUM. ESALS = 1,543,000
2002 ~ 2022 CUM. ESALS = 7,151,000	2002 ~ 2022 CUM. ESALS = 3,890,000
VT. ROUTE 9 (MM 4.970 TO MM 5.540)	
2002 ADT = 10,200	
2002 DHV = 1,100	
2012 ADT = 12,100	
2012 DHV = 1,200	
2002 ~ 2012 CUM. ESALS = 3,408,000	
2002 ~ 2022 CUM. ESALS = 8,551,000	

UNLESS OTHERWISE NOTED, ALL DRAWINGS AND DETAILS OF THE PROJECT PLANS ARE NOT TO SCALE
RIGHT OF WAY LIMITS, IF APPLICABLE, ARE PROVIDED SOLELY FOR THE CONVENIENCE OF THE STATE AND ITS CONTRACTOR DURING THE COURSE OF THIS PAVING PROJECT. ANY REFERENCES TO OFFSETS ON THESE PLANS ARE APPROXIMATE AND SHOULD NOT BE RELIED UPON FOR ANY OTHER PURPOSES

BITUMINOUS CONCRETE PAVEMENT SUPERPAVE MIXTURE DESIGN CRITERIA	
DESIGN LANE / DESIGN LIFE ESAL	5,197,000
DESIGN NUMBER OF GYRATIONS	100
PERFORMANCE GRADED ASPHALT BINDER	64-28

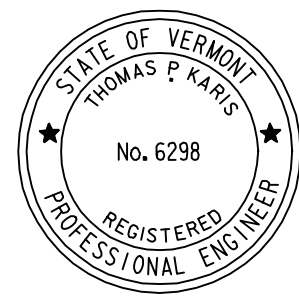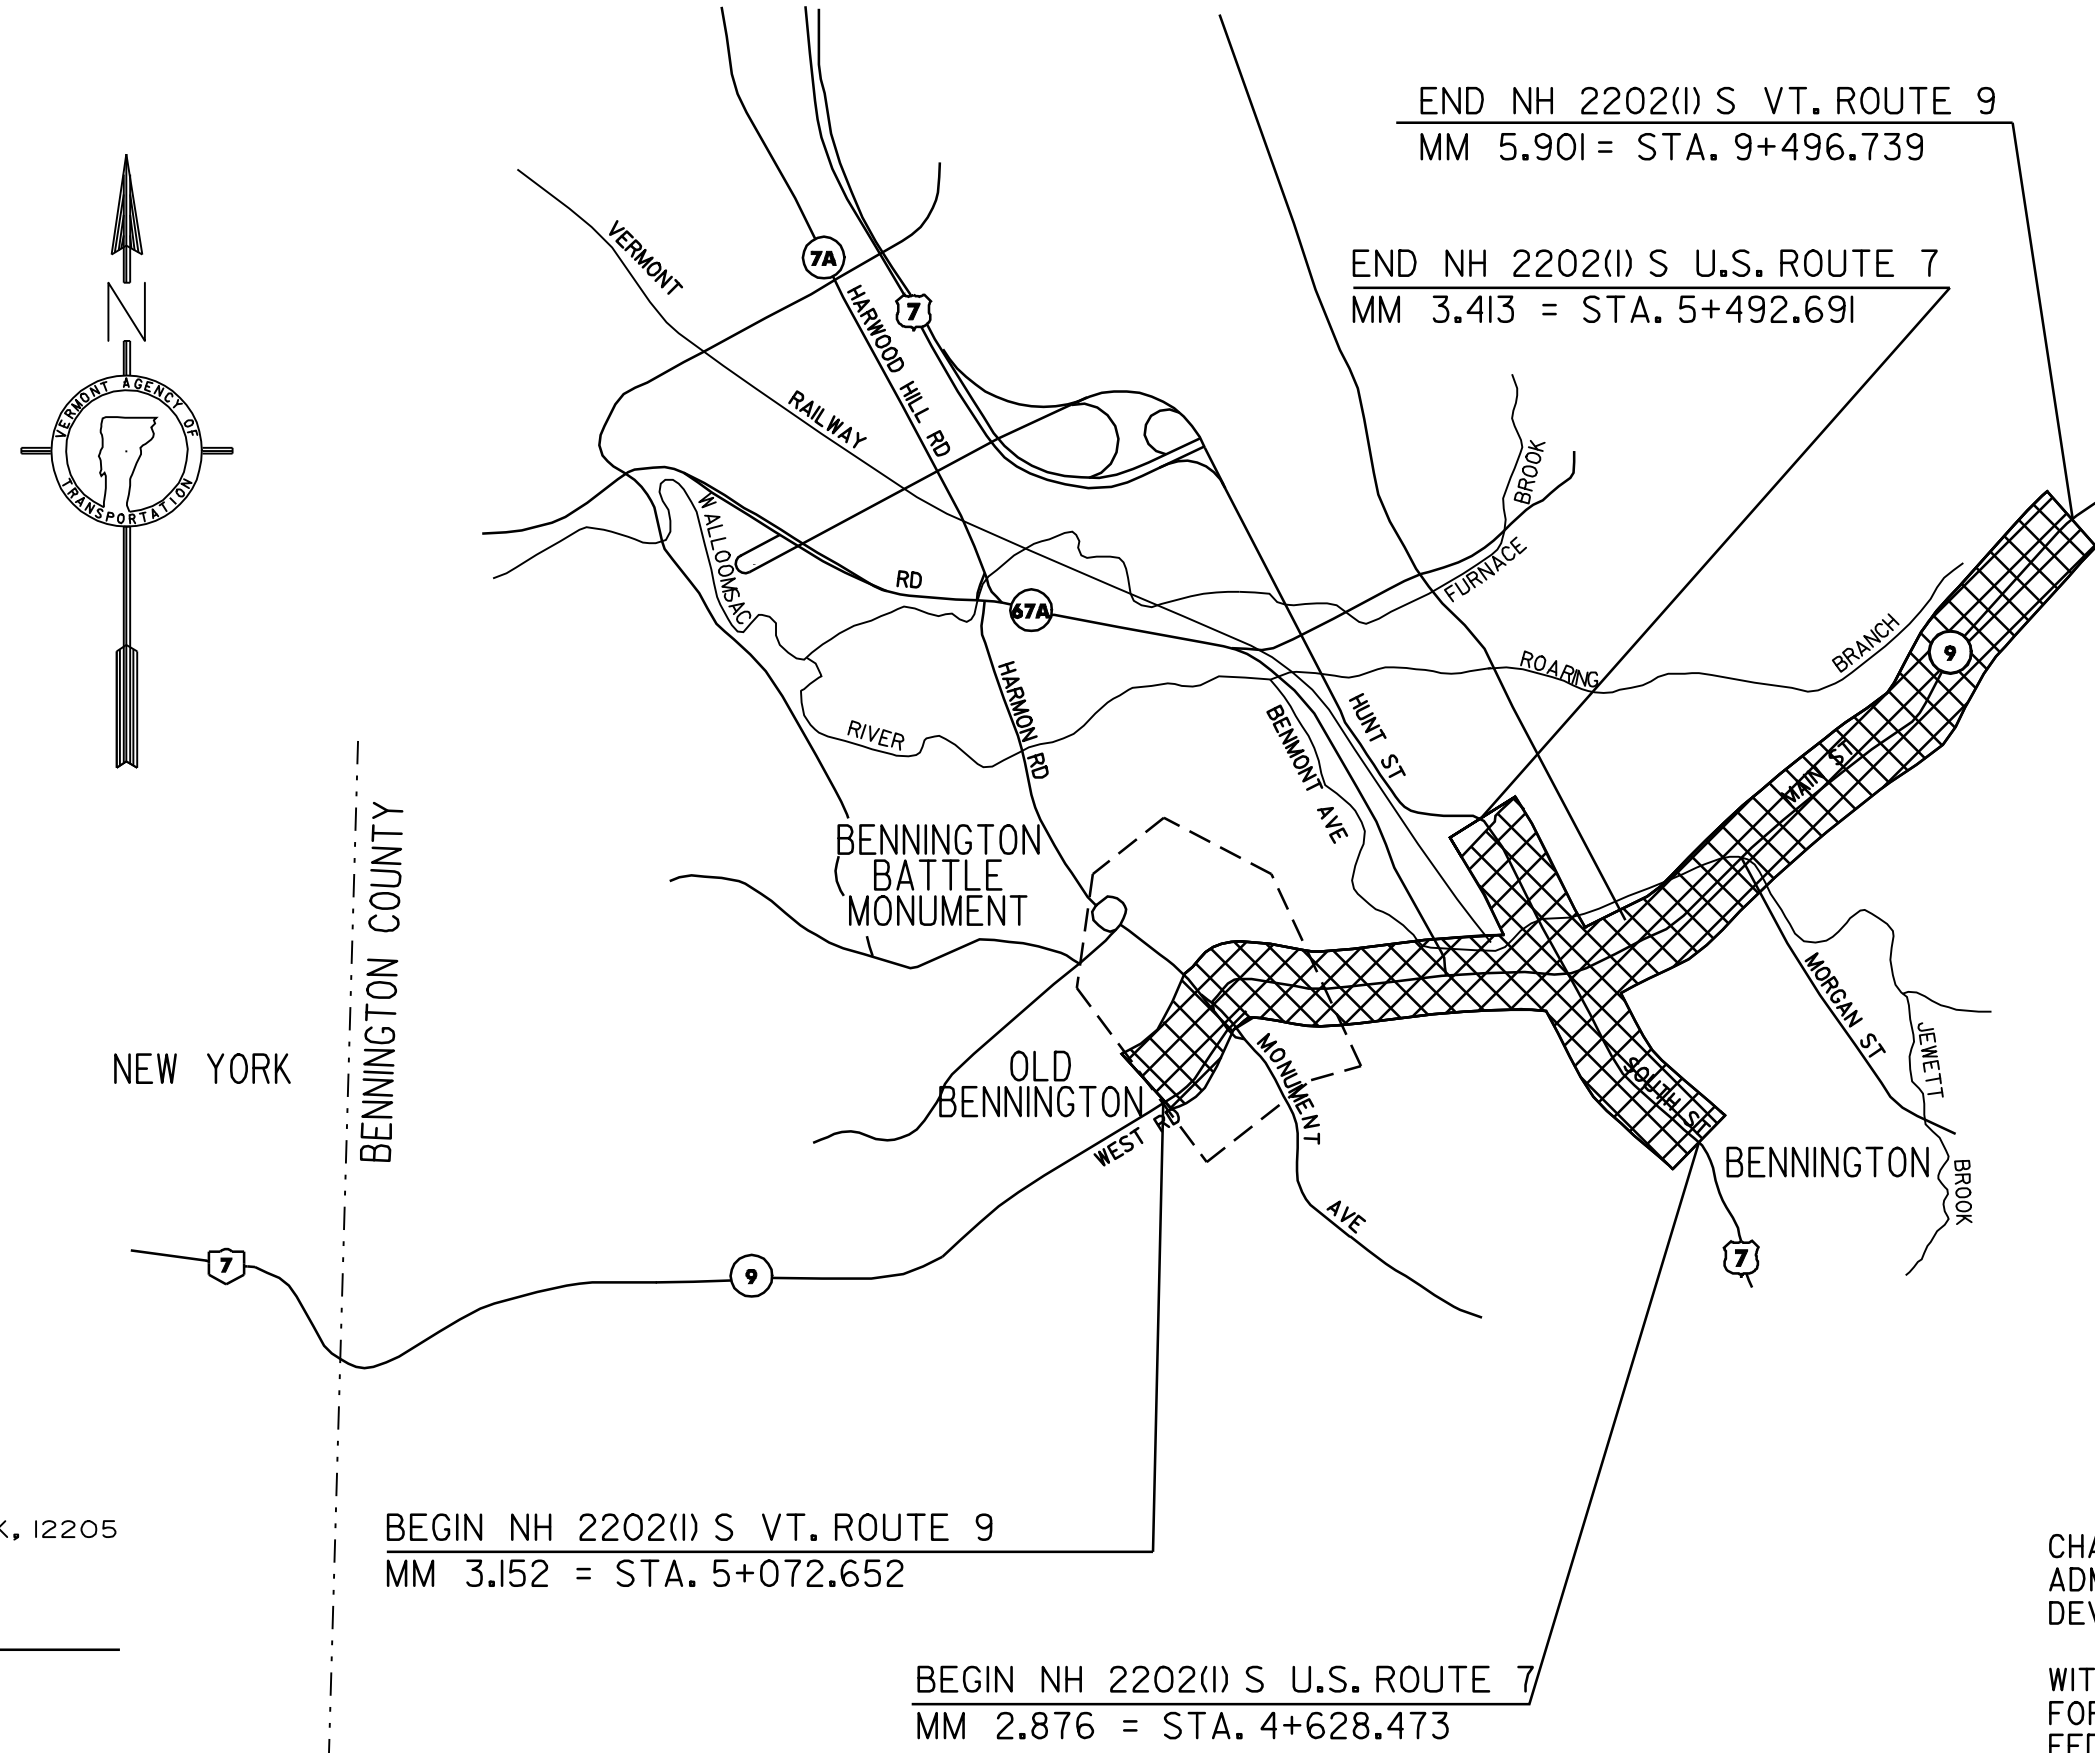

PLANS PREPARED BY
CHA CLOUGH, HARBOUR & ASSOCIATES LLP
ENGINEERS, SURVEYORS, PLANNERS & LANDSCAPE ARCHITECTS
111 WINNERS CIRCLE ALBANY, NEW YORK, 12205

DATUM
VERTICAL N/A
HORIZONTAL N/A

CONVENTIONAL SIGNS

COUNTY LINE	---
TOWN LINE	- - - - -
LIMITS OF ACCESS	○-○-○-○
POINT OF ACCESS	X
FENCE LINE	-x-x-
STONE WALL	○-○-○-○
TRAVELED WAY	- - -
GUARD RAIL	○-○-○-○
RAILROAD	-
SURVEY LINE	+
CULVERT	- - - - -
POWER POLE	⊕
TELEPHONE POLE	⊙
TREES	⊙
CONTROL OF ACCESS	///
PROPERTY LINE	---
R.O.W. TAKING LINE	- - - - -
SLOPE RIGHTS	SR
TOP OF CUT	△
TOE OF SLOPE	○

THESE PLANS ARE SUBJECT TO SUCH ENGINEERING CHANGES AS MAY BE REQUIRED BY THE FEDERAL HIGHWAY ADMINISTRATION OR THE DIRECTOR OF PROJECT DEVELOPMENT.
CONSTRUCTION IS TO BE CARRIED ON IN ACCORDANCE WITH THESE PLANS AND THE STANDARD SPECIFICATIONS FOR CONSTRUCTION DATED 2001, AS APPROVED BY THE FEDERAL HIGHWAY ADMINISTRATION ON JANUARY 4, 2001 FOR USE ON THIS PROJECT, INCLUDING ALL SUBSEQUENT REVISIONS AND SUCH REVISED SPECIFICATIONS AND SPECIAL PROVISIONS AS ARE INCORPORATED IN THESE PLANS.

Metric

APPROVED _____ DATE _____
DIRECTOR OF PROGRAM DEVELOPMENT

DEPARTMENT OF TRANSPORTATION
FEDERAL HIGHWAY ADMINISTRATION

APPROVED _____ DATE _____
DIVISION ADMINISTRATOR

PROJECT BENNINGTON
NH 2202(I)S
SHEET 5 OF 108 SHEETS

INDEX OF SHEETS

INDEX OF SHEETS

5	TITLE SHEET
6	INDEX OF SHEETS
7	PROJECT TYPICAL SHEET
8	PAVING DETAILS & PAVEMENT JOINT DETAIL SHEET
9-10	QUANTITY SHEETS
11-13	ITEM DETAIL SUMMARY SHEETS
14-40	LAYOUT SHEETS
41-47	TRAFFIC LOOP LAYOUT SHEETS
48-68	TRAFFIC SIGN SUMMARY SHEETS
69	TRAFFIC SIGN DETAIL SHEET
70	PAVEMENT MARKINGS & SIDEWALK RAMP TEXTURING DETAIL SHEET
71-72	DETOUR SIGNING SHEETS
73-79	DETOUR SIGN SUMMARY SHEETS
80	CONSTRUCTION APPROACH SIGNING DETAIL SHEET

VAOT STANDARDS


C-1M	CAST IN PLACE CONCRETE CURB	01-03-00
C-2AM	PORTLAND CEMENT CONCRETE SIDEWALK	01-03-00
C-3M	SIDEWALK RAMPS	01-03-00
D-8M	REINFORCED CONCRETE DROP INLET	01-03-00
D-9M	REINFORCED CONCRETE DROP INLET	06-13-97
D-11M	STEEL GRATE, CAST IRON GRATE TYPE A, CAST IRON COVER	06-13-97
D-15M	CAST IRON GRATE WITH FRAME, TYPE D	06-13-97
E-100M	CONSTRUCTION APPROACH SIGNS	06-13-97
E-101M	CONSTRUCTION SIGN DETAILS	06-13-97
E-102M	CONSTRUCTION SIGN DETAILS	06-13-97
E-102AM	CONSTRUCTION SIGN DETAILS	06-13-97
E-103M	MAINLINE TRAFFIC CONTROL DIVIDED HIGHWAY ONE LANE CLOSED	09-24-98
E-106M	TRAFFIC CONTROL - MISCELLANEOUS DETAILS	06-13-97
E-107M	DELINEATION, BARRICADES AND DETOURS FOR CONSTRUCTION AREAS	06-13-97
E-107AM	BREAKAWAY BARRICADE DETAILS	06-13-97
E-108M	CONSTRUCTION ZONE LONGITUDINAL DROP OFFS	06-13-97
E-110M	MAJOR MAINTENANCE OPERATION LANE CLOSURE	06-13-97
E-111M	MAINTENANCE OPERATION APPROACH SIGNS	02-17-98
E-121M	STANDARD SIGN PLACEMENT - CONVENTIONAL ROAD	06-13-97
E-123M	GUIDE SIGN PLACEMENT- MISCELLANEOUS DETAILS	06-13-97
E-128BM	DETAILING VILLAGE SIGNS (N-W)	06-13-97
E-132M	GENERAL MOTORIST SERVICE SIGN DETAILS	06-13-97
E-136AM	U.S. ROUTE MARKER SIGN DETAILS	06-13-97
E-136BM	STATE ROUTE MARKER SIGN DETAILS	06-13-97
E-138M	REFERENCE PLAQUE DETAILS STATE AND TOWN HIGHWAYS	06-13-97
E-140M	REGULATORY SIGN DETAILS	06-13-97
E-141M	REGULATORY SIGN DETAILS	06-13-97
E-142M	REGULATORY SIGN DETAILS	06-13-97
E-143M	REGULATORY SIGN DETAILS	06-13-97
E-145AM	REGULATORY SIGN DETAILS - LANE USE CONTROL SIGNS	06-13-97
E-146M	REGULATORY SIGN DETAILS	06-13-97
E-152M	WARNING SIGN DETAILS	06-13-97
E-153M	WARNING SIGN DETAILS	06-13-97
E-160M	FLANGED CHANNEL STEEL SIGN POST	06-13-97
E-162M	TUBULAR ALUMINUM SIGN POST	06-13-97
E-172M	VEHICLE DETECTOR LOOP DETAILS	06-13-97
E-173M	PULL BOXES AND JUNCTION BOXES	06-13-97
E-191M	PAVEMENT MARKING DETAILS	02-01-99
E-192M	PAVEMENT MARKING DETAILS	12-28-98
E-193M	PAVEMENT MARKING DETAILS	06-13-97
G-4M	YIELDING MARKER POSTS	06-13-97

FILE NAME: #FILES#
 DATE / USER: #DATE# #USER#

DATUM	
VERTICAL	N/A
HORIZONTAL	N/A


INDEX OF SHEETS

SURVEYED BY	N/A	DATE	N/A
DRAWN BY	J.A.R.	DATE	4/01
SQUAD LEADER	T.P.K.		
DESIGN FILE NO.	pave/99d156/pd156.dgn		
IPARM		DATE	
FILE	pd156i.1	PLOTTED	21-NOV-2005
PROJ. NAME	BENNINGTON		
PROJ. NO.	NH 2202(1)S		
SHEET	6	OF	108 SHEETS

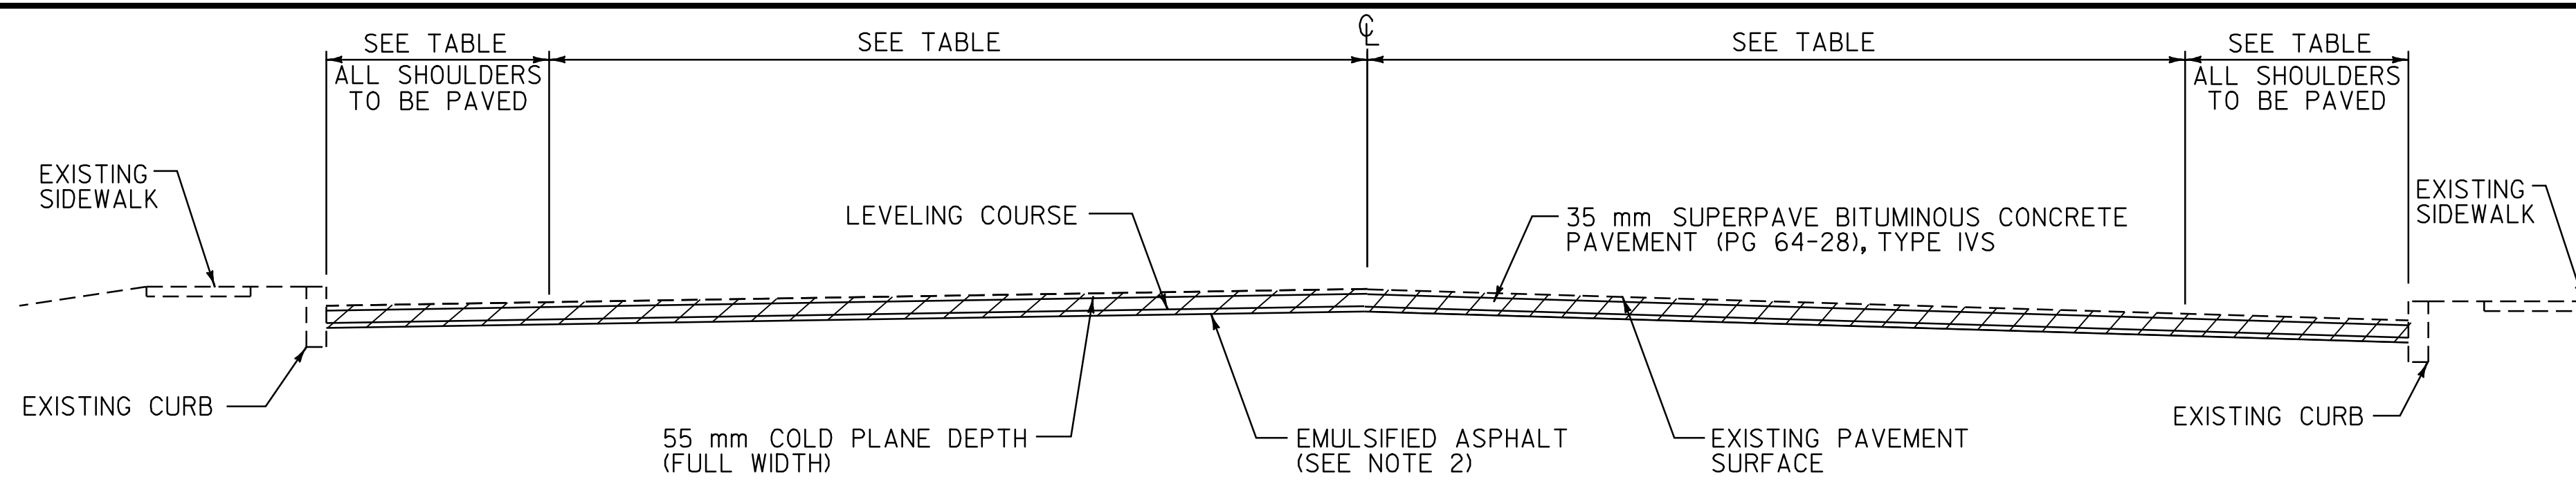


COLD PLANE TYPICAL SECTION - CURBED

VT. ROUTE 9 STA. 6+116.000 TO STA. 9+496.739
 U.S. ROUTE 7 STA. 4+628.473 TO STA. 5+052.278
 U.S. ROUTE 7 STA. 5+067.278 TO STA. 5+492.691

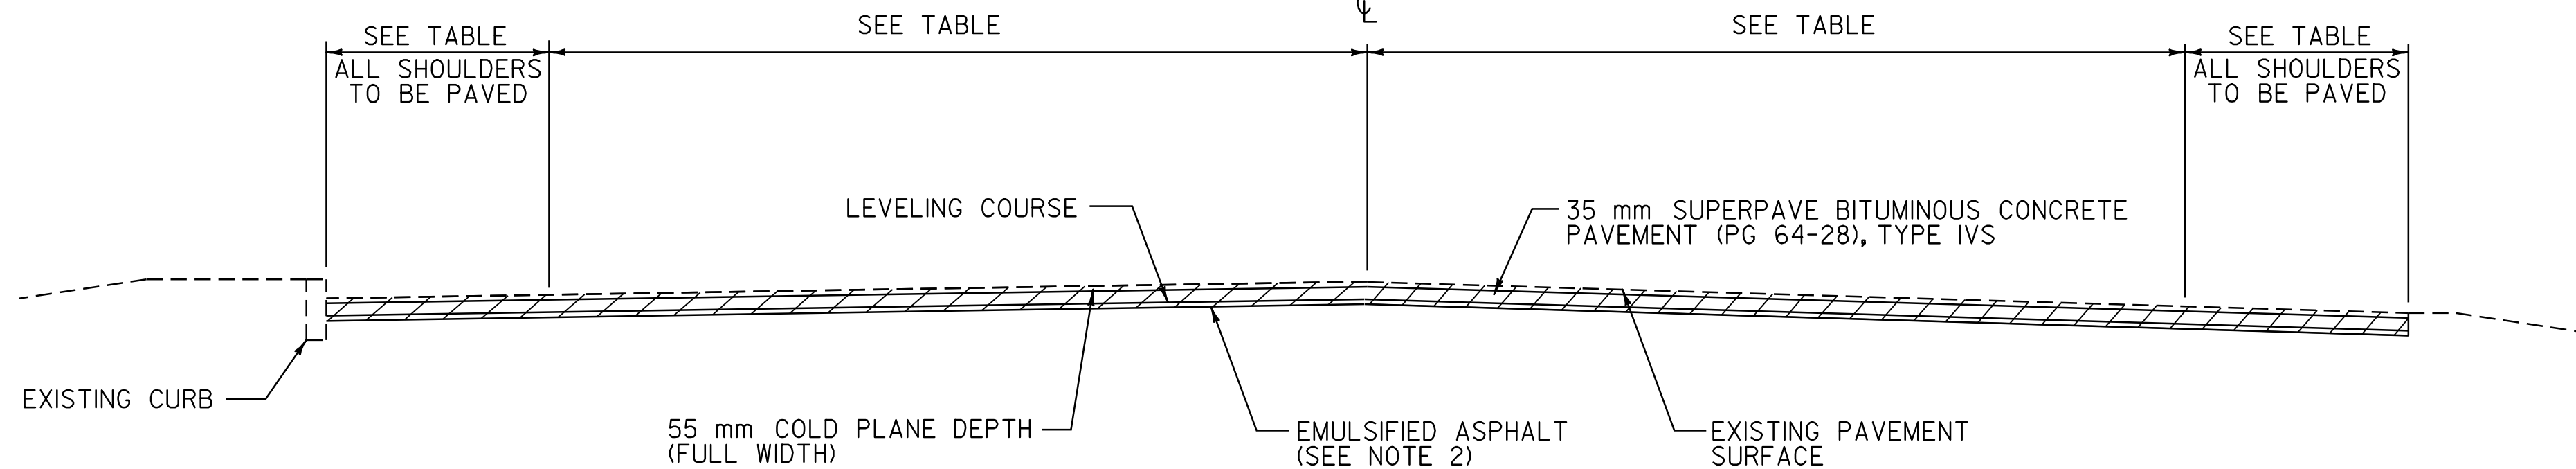

COLD PLANE TYPICAL SECTION

VT. ROUTE 9 STA. 5+480.000 TO STA. 6+116.000

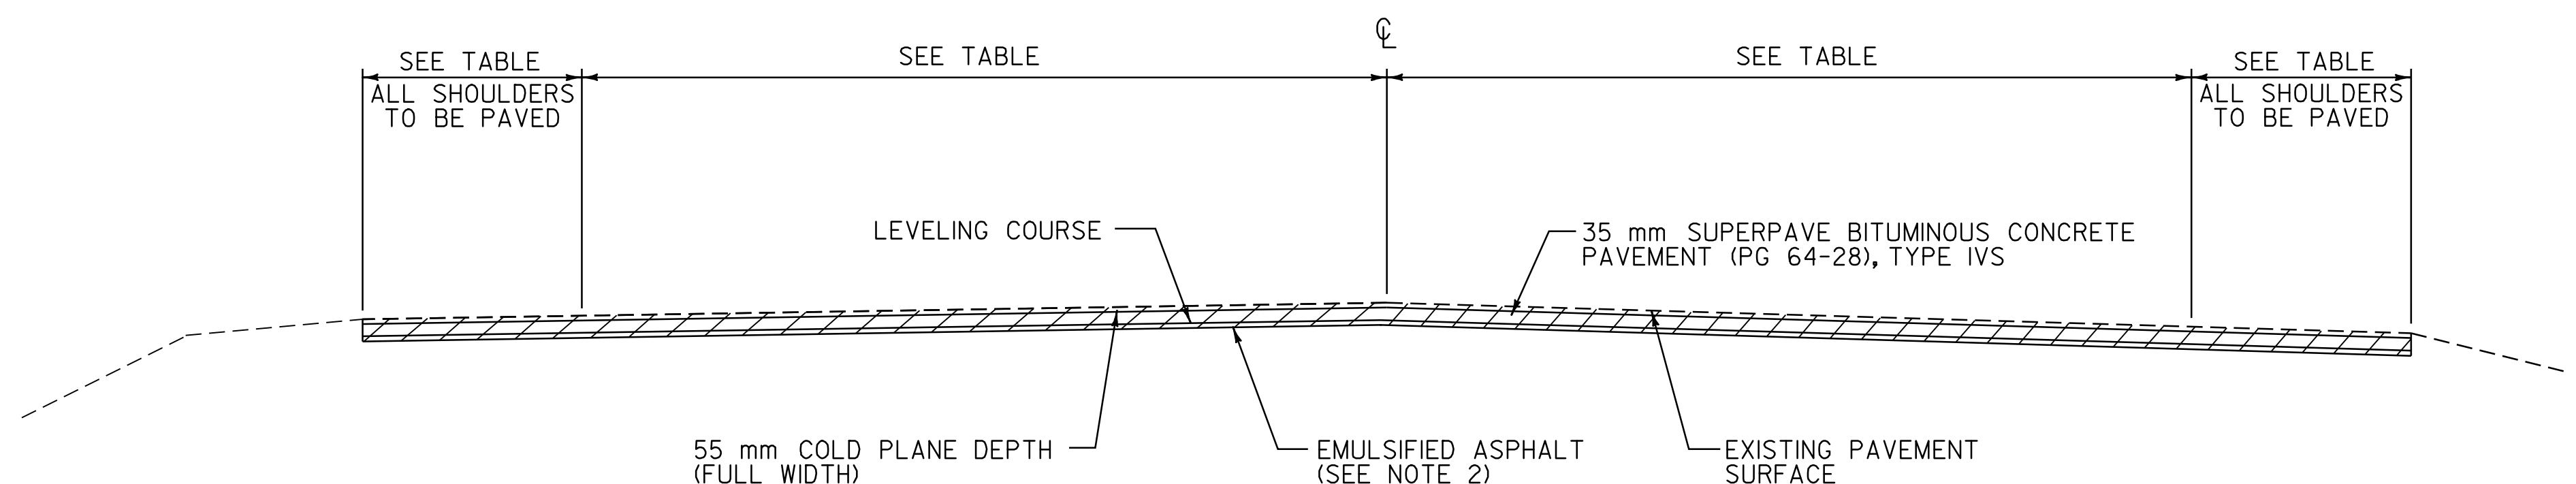

COLD PLANE TYPICAL SECTION

VT. ROUTE 9 STA. 5+072.652 TO STA. 5+480.000

PROJECT PAVING LIMITS

TOWN & ROUTE	BEGIN	END	LANE TYPICAL	WEARING DEPTH	LEVELING †	NOTES
BENNINGTON VT. ROUTE 9	5+072.652	5+085.0	0.9 m - 3.6 m - 3.6 m - 0.9 m	35 mm	4	COLD PLANE 55 mm, LEVEL WITH 15 mm TYPE IVS AND PAVE WITH 35 mm TYPE IVS
BENNINGTON VT. ROUTE 9	5+085.0	5+400.0	0.9 m - 3.3 m - 3.3 m - 0.9 m	35 mm	97	COLD PLANE 55 mm, LEVEL WITH 15 mm TYPE IVS AND PAVE WITH 35 mm TYPE IVS
BENNINGTON VT. ROUTE 9	5+400.0	5+480.0	VARIABLES - SEE LAYOUT SHEETS	35 mm	18	COLD PLANE 55 mm, LEVEL WITH 15 mm TYPE IVS AND PAVE WITH 35 mm TYPE IVS
BENNINGTON VT. ROUTE 9	5+480.0	5+640.0	VARIABLES - SEE LAYOUT SHEETS	35 mm	69	COLD PLANE 55 mm, LEVEL WITH 15 mm TYPE IVS AND PAVE WITH 35 mm TYPE IVS
BENNINGTON VT. ROUTE 9	5+640.0	5+980.0	1.5 m - 3.3 m - 3.3 m - 1.5 m	35 mm	118	COLD PLANE 55 mm, LEVEL WITH 15 mm TYPE IVS AND PAVE WITH 35 mm TYPE IVS
BENNINGTON VT. ROUTE 9	5+980.0	6+116.0	2.1 m - 3.6 m - 3.6 m - 2.1 m	35 mm	15	COLD PLANE 55 mm, LEVEL WITH 15 mm TYPE IVS AND PAVE WITH 35 mm TYPE IVS
BENNINGTON VT. ROUTE 9	6+116.0	6+520.0	2.1 m - 3.6 m - 3.6 m - 2.1 m	35 mm	205	COLD PLANE 55 mm, LEVEL WITH 15 mm TYPE IVS AND PAVE WITH 35 mm TYPE IVS
BENNINGTON VT. ROUTE 9	6+520.0	6+680.0	VARIABLES - SEE LAYOUT SHEETS	35 mm	69	COLD PLANE 55 mm, LEVEL WITH 15 mm TYPE IVS AND PAVE WITH 35 mm TYPE IVS
BENNINGTON VT. ROUTE 9	6+680.0	6+940.0	2.1 m - 3.6 m - 3.6 m - 2.1 m	35 mm	120	COLD PLANE 55 mm, LEVEL WITH 15 mm TYPE IVS AND PAVE WITH 35 mm TYPE IVS
BENNINGTON VT. ROUTE 9	6+940.0	7+530.0	VARIABLES - SEE LAYOUT SHEETS	35 mm	290	COLD PLANE 55 mm, LEVEL WITH 15 mm TYPE IVS AND PAVE WITH 35 mm TYPE IVS
BENNINGTON VT. ROUTE 9	7+530.0	8+080.0	2.4 m - 3.6 m - 3.6 m - 2.4 m	35 mm	237	COLD PLANE 55 mm, LEVEL WITH 15 mm TYPE IVS AND PAVE WITH 35 mm TYPE IVS
BENNINGTON VT. ROUTE 9	8+080.0	8+830.0	1.5 m - 3.6 m - 3.6 m - 1.5 m	35 mm	275	COLD PLANE 55 mm, LEVEL WITH 15 mm TYPE IVS AND PAVE WITH 35 mm TYPE IVS
BENNINGTON VT. ROUTE 9	8+830.0	9+460.0	1.2 m - 3.6 m - 3.6 m - 1.2 m	35 mm	218	COLD PLANE 55 mm, LEVEL WITH 15 mm TYPE IVS AND PAVE WITH 35 mm TYPE IVS
BENNINGTON VT. ROUTE 9	9+460.0	9+496.739	VARIABLES - SEE LAYOUT SHEETS	35 mm	13	COLD PLANE 55 mm, LEVEL WITH 15 mm TYPE IVS AND PAVE WITH 35 mm TYPE IVS
BENNINGTON U.S. ROUTE 7	4+628.473	4+850.0	VARIABLES - SEE LAYOUT SHEETS	35 mm	65	COLD PLANE 55 mm, LEVEL WITH 15 mm TYPE IVS AND PAVE WITH 35 mm TYPE IVS
BENNINGTON U.S. ROUTE 7	4+850.0	5+052.278	2.4 m - 3.3 m - 3.3 m - 1.0 m	35 mm	72	COLD PLANE 55 mm, LEVEL WITH 15 mm TYPE IVS AND PAVE WITH 35 mm TYPE IVS
BENNINGTON U.S. ROUTE 7	5+052.278	5+067.278	1.2 m - 3.6 m - 3.6 m - 1.2 m	35 mm	-	BR 10, COLD PLANE 25 mm AND PAVE WITH 25 mm TYPE IVS
BENNINGTON U.S. ROUTE 7	5+067.278	5+492.691	1.2 m - 3.6 m - 3.6 m - 1.2 m	35 mm	147	COLD PLANE 55 mm, LEVEL WITH 15 mm TYPE IVS AND PAVE WITH 35 mm TYPE IVS

DATUM	
VERTICAL	N/A
HORIZONTAL	N/A

NOTES

1. THE WEARING COURSE SHALL BE TYPE IVS SUPERPAVE BITUMINOUS CONCRETE PAVEMENT. THE LEVELING COURSE SHALL BE TYPE IVS SUPERPAVE UNLESS OTHERWISE DIRECTED BY THE RESIDENT ENGINEER. ALL ASPHALT CEMENT USED IN THE SUPERPAVE BITUMINOUS CONCRETE PAVEMENT SHALL BE PG 64-28.
2. EMULSIFIED ASPHALT SHALL BE APPLIED ON ALL EXISTING PAVEMENT SURFACES, ON ALL COLD PLANED SURFACES AND BETWEEN ALL COURSES OF PAVEMENT AT THE RATE OF 0.12 L/m² OR AS DIRECTED BY THE RESIDENT ENGINEER.
3. BITUMINOUS CONCRETE PAVEMENT TOLERANCE = ±5 mm (TOTAL PAVEMENT THICKNESS EXCLUDING LEVELING).
4. ITEM 616.47 BITUMINOUS CONCRETE GUTTERS AND TRAFFIC ISLANDS SHALL ONLY BE PAID WHERE INDICATED IN THE PLANS. ALL PAVING WHICH COULD INVOLVE SOME HAND-WORK (SUCH AS DRIVEWAYS, AROUND DROP INLETS, ETC.) SHALL BE PAID AS ITEM 490.30 SUPERPAVE BITUMINOUS CONCRETE PAVEMENT (PG 64-28).
5. A FULL DEPTH BUTT JOINT SHALL BE CONSTRUCTED AT THE BEGIN AND END PROJECT LOCATIONS AND AT ALL SIDE ROAD APPROACHES AS INDICATED ON THE PROJECT PLANS OR AS DIRECTED BY THE RESIDENT ENGINEER.
6. ITEMS 604.40 & 604.412 ARE ESTIMATED QUANTITIES AND SHALL BE PERFORMED AT LOCATIONS INDICATED ON THE LAYOUT SHEETS AND AS DIRECTED BY THE RESIDENT ENGINEER. ALL DI'S SHALL BE RAISED OR REHABILITATED SUCH THAT THE NEW GRATE ELEVATION IS LEVEL WITH THE SURROUNDING TERRAIN.
7. ALL DRIVES SHALL RECEIVE A PAVED APRON TO THE SIDEWALK AS DIRECTED BY THE RESIDENT ENGINEER. ANY AND ALL REQUIRED EXCAVATION IN DRIVE AREAS SHALL BE AS DIRECTED AND WILL BE PAID FOR UNDER ITEM 210.10 OR THE APPLICABLE RENTAL ITEM(S). IF REQUIRED, A NEW DRIVEWAY SUBBASE SHALL BE CONSTRUCTED AND WILL BE PAID FOR UNDER ITEM 301.28 SUBBASE OF CRUSHED GRAVEL (FINE GRADED). A NEW BITUMINOUS SURFACE SHALL BE CONSTRUCTED AS DIRECTED AND WILL BE PAID FOR UNDER ITEM 490.30. QUANTITIES OF THE ABOVE ITEMS HAVE BEEN INCLUDED TO PAY FOR THIS WORK.
8. ALL EXISTING SIDEWALK RAMPS REQUIRING A TEXTURED SURFACE AS INDICATED IN THE PLANS OR AS DIRECTED BY THE RESIDENT ENGINEER WILL BE PAID FOR UNDER ITEM 212.20 SCARIFYING PAVEMENT (MOD.).
9. FLANGED CHANNEL SIGN POSTS REQUIRE A SLEEVE TO BE MOUNTED IN THE SIDEWALK OR THROUGH EXISTING BRICK PAVERS AS INDICATED IN THE PLANS OR AS DIRECTED BY THE RESIDENT ENGINEER. THIS SLEEVE SHALL BE PAID FOR UNDER ITEM 675.301 FLANGED CHANNEL SIGN POSTS (MOD.) AND HAS BEEN ESTIMATED AT 1m OF POST PER LOCATION.

URBAN AREA SEED MIXTURE

% WT.	kg/ha.	NAME	PUR. %	GERM. %
42.2	38.0	CREeping RED FESCUE	98	85
10.0	9.0	PERENNIAL RYEGRASS	95	90
42.2	38.0	KENTUCKY BLUEGRASS	85	85
5.6	5.0	ANNUAL RYEGRASS	95	85
100.0	90.0			

SEED MIXTURE: SHALL NOT HAVE A WEED CONTENT EXCEEDING 0.40% BY WEIGHT AND SHALL BE FREE OF ALL NOXIOUS WEED SEED.

SEED: TO BE APPLIED PER SEEDING FORMULA DIRECTED BY THE RESIDENT ENGINEER.

FERTILIZER: FORMULA 10-20-10 TO BE USED WITH SEED, APPLIED AT THE RATE OF 560 kg/ha (HYDRO SEEDERS MAY USE 19-19-19 FORMULA)


AGRICULTURAL LIMESTONE: TO BE APPLIED AT THE RATE OF 4.5 tons/ha OR AS DIRECTED BY THE RESIDENT ENGINEER.

HAY MULCH: TO BE APPLIED ON EARTH SLOPES AT THE RATE OF 4.5 tons/ha, OR AS DIRECTED BY THE RESIDENT ENGINEER.

TOPSOIL: TO BE USED WITH SEED AS INDICATED ON THE PLANS OR AS DIRECTED BY THE RESIDENT ENGINEER.

PROJECT TYPICAL SHEET


SURVEYED BY	N/A	DATE	N/A
DRAWN BY	J.A.R.	DATE	4/01
SQUAD LEADER	T.P.K.		
DESIGN FILE NO.	pave/99dl56/pdl56.dgn		
IPARM FILE	pdl56pt1	DATE PLOTTED	21-NOV-2005
PROJ. NAME	BENNINGTON		
PROJ. NO.	NH 220211S		
SHEET	7 OF 108	SHEETS	

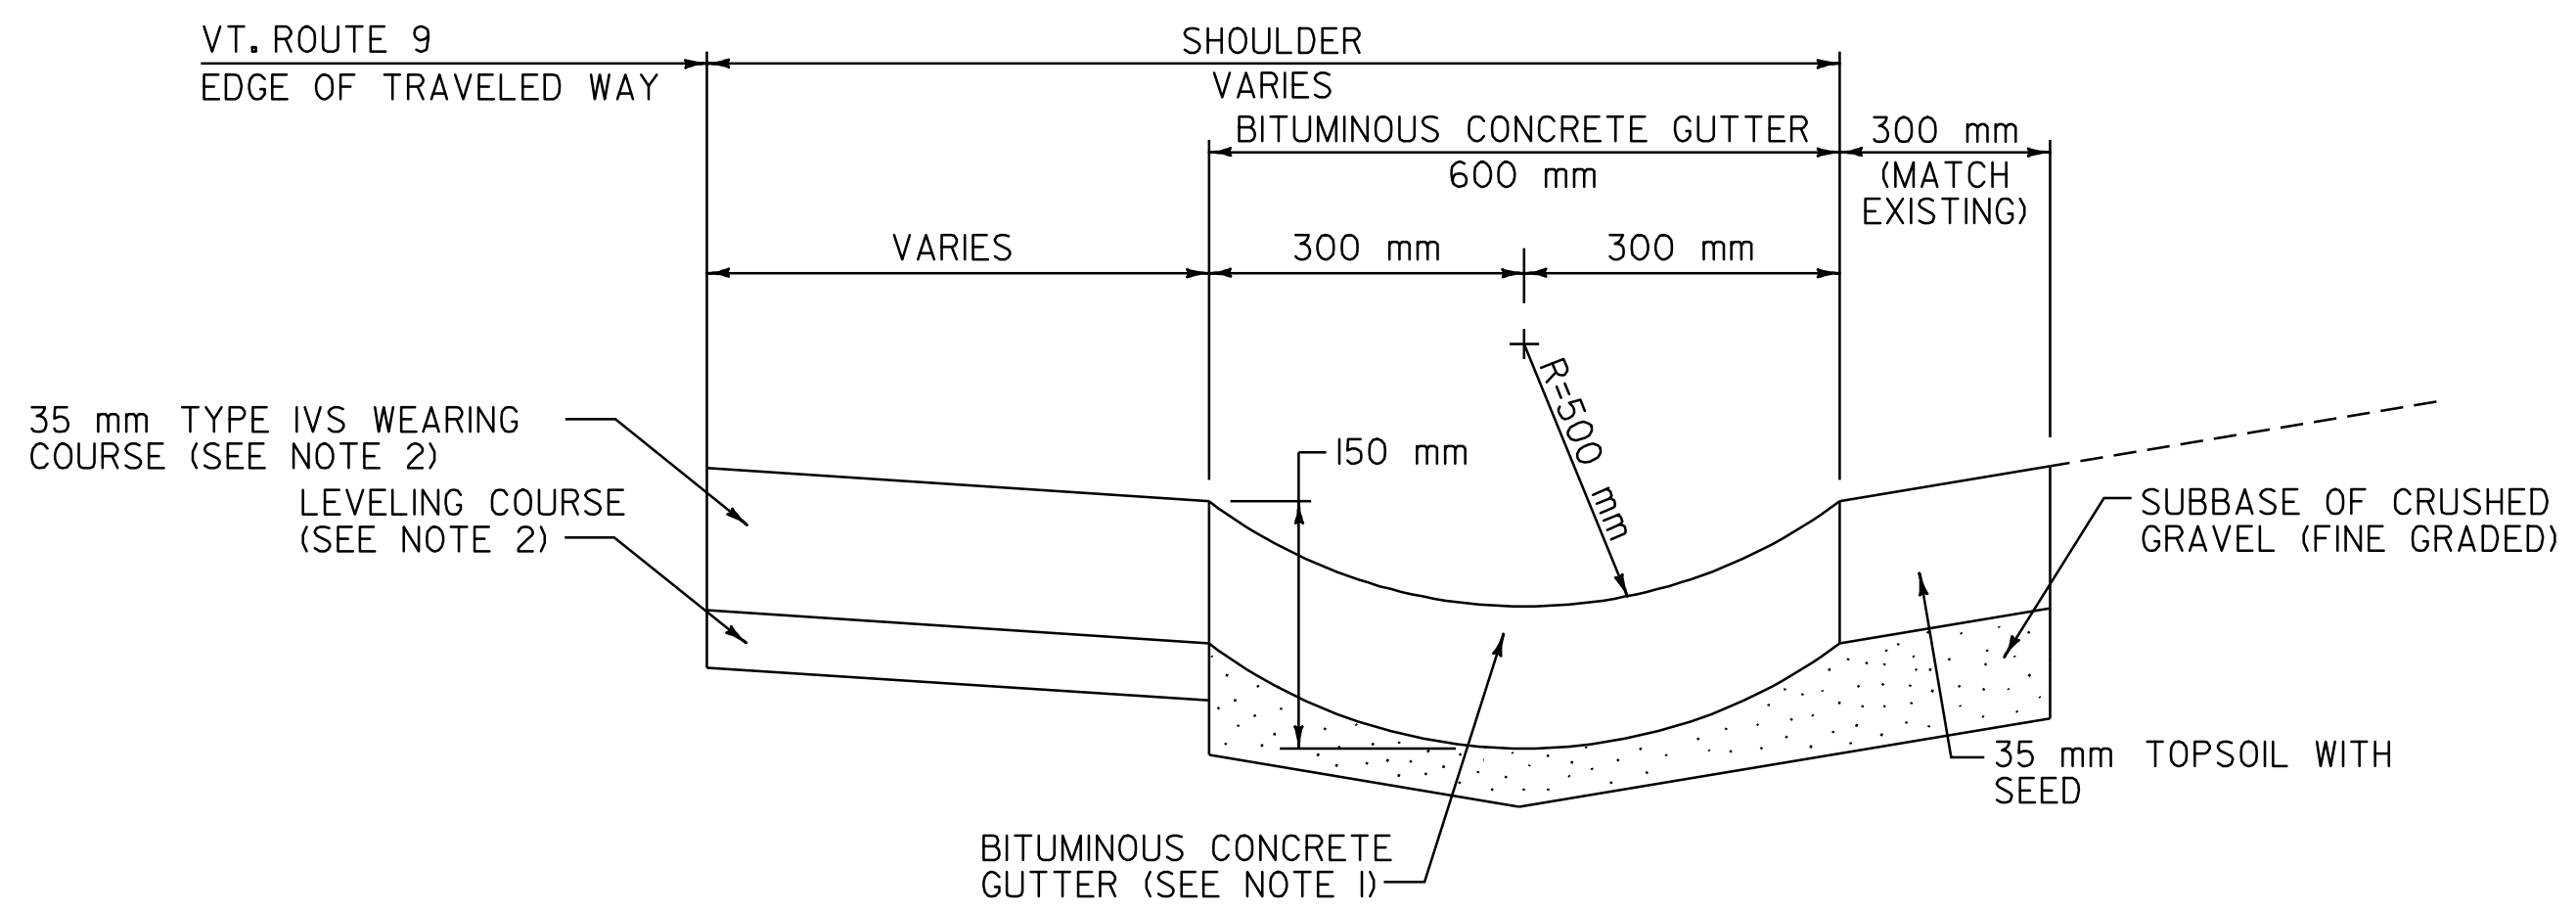

BITUMINOUS CONCRETE GUTTER DETAIL


VT. ROUTE 9 BENNINGTON STA. 5+588.0 - STA 5+933.0 RT

- NOTES:
1. BITUMINOUS CONCRETE GUTTER TO BE CONSTRUCTED BY PLACING 1-35 mm TYPE IVS SUPERPAVE BITUMINOUS CONCRETE PAVEMENT LIFT. PAYMENT UNDER ITEM 616.47 BITUMINOUS CONCRETE GUTTERS AND TRAFFIC ISLANDS.
 2. THE LEVELING COURSE AND 35 mm TYPE IVS WEARING COURSE ASSOCIATED WITH THE 300 mm ADJACENT TO THE TRAVELED WAY SHALL BE PLACED AT THE SAME CROSS SLOPE AS THE TRAVELED WAY. PAYMENT UNDER ITEM 490.30 SUPERPAVE BITUMINOUS CONCRETE PAVEMENT (PG 64-28).

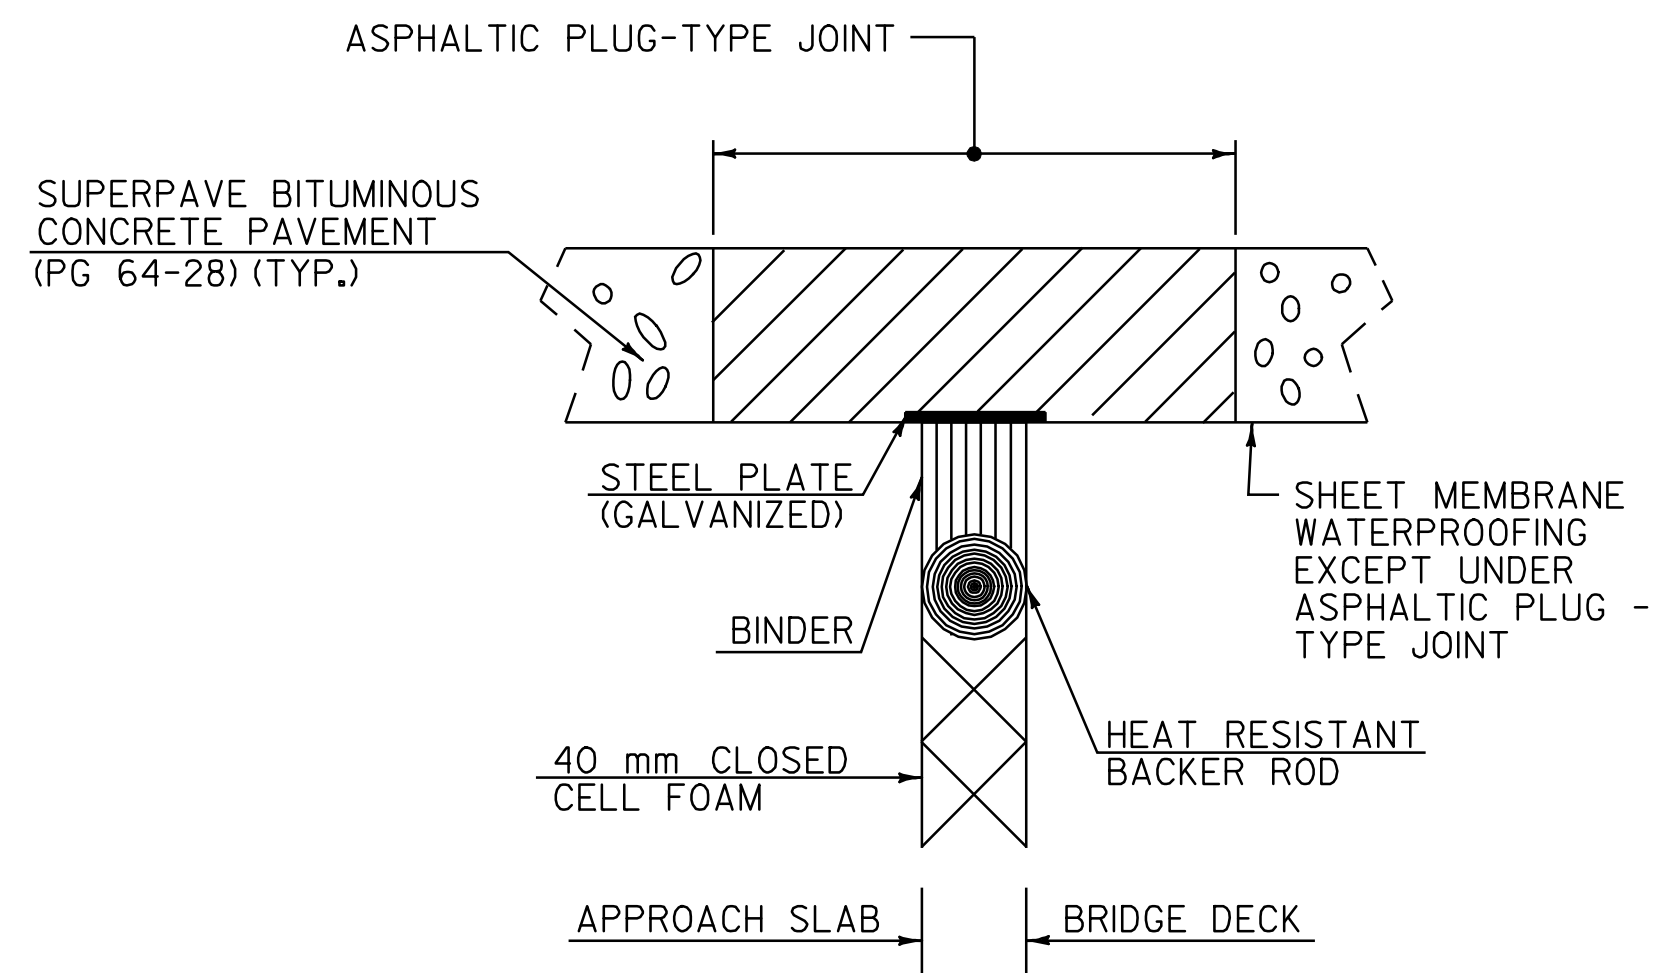

ASPHALTIC PLUG-TYPE JOINT DETAIL

U.S. ROUTE 7 BENNINGTON STA. 5+052.278 (9.6 m)

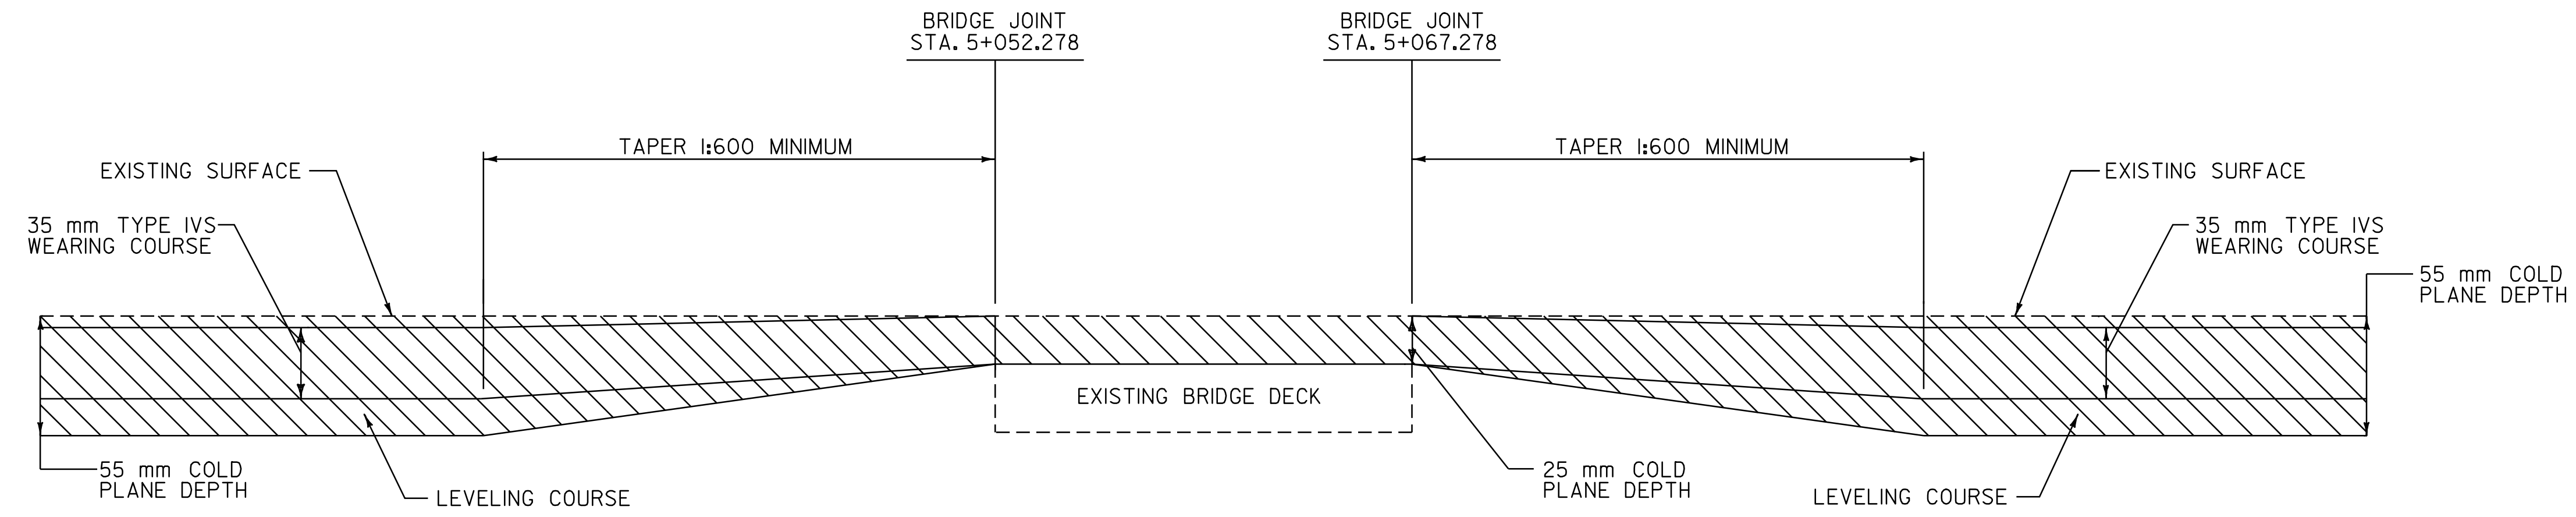

BRIDGE TRANSITION AREA DETAIL

BR 10 U.S. ROUTE 7 BENNINGTON STA. 5+052.278 - STA. 5+067.278

NOTE: THE CONTRACTOR MUST USE CARE WHEN COLD PLANING BR 10 AS NOT TO DAMAGE THE BRIDGE MEMBRANE.

PAVING DETAILS AND PAVEMENT JOINT DETAIL SHEET	SURVEYED BY	N/A	DATE	N/A
	DRAWN BY	J.A.R.	DATE	4/01
	SQUAD LEADER	T.P.K.		
	DESIGN FILE NO.	pave/99dl56/pdl56.dgn		
	IPARM FILE	pdl56pd.i	DATE PLOTTED	21-NOV-2005
	PROJ. NAME	BENNINGTON		
PROJ. NO.	NH 2202(1)S			
SHEET 8 OF 108			SHEETS	

DATUM	
VERTICAL	N/A
HORIZONTAL	N/A

FILE NAME: #FILES#
DATE/TIME: #DATE#
USER: #USER#

ITEM DETAIL SUMMARY SHEET 1



LOCATION			GUARDRAIL						MISCELLANEOUS										REMARKS	
STATION	STATION	POS.	621.20	621.20	621.52	621.60	621.80	621.81	203.15	203.16	203.28	212.20	301.28	616.28	616.40	616.41	618.10	619.17		
			STEEL BEAM G.R. m	2.4 m STEEL BEAM G.R. (MOD.) m	MANUF. TERM. SECTION EA	ANCHOR FOR G.R. EA	REMOVE & DISP. G.P. EA	REMOVE & DISP. G.R. m	COMMON EXCAVATION m ³	SOLID ROCK EXCAVATION m ³	EXCAVATION OF SURFACES & PAVEMENTS m ³	SCARIFYING PAVEMENT (MOD.) m ²	SUBBASE OF CRUSHED GRAVEL t	CAST IN PLACE PCC CURB TYPE B m	REMOVE & RESET CURB m	REMOVAL OF EXIST. CURB m	P. C. C. SIDEWALK 125 mm m ²	YIELD. MKR. POST EA		
VT. ROUTE 9																				
5+587.0		LT							4	2				5	3		4.5	11.5		CONSTRUCT SIDEWALK RAMP, TYPE 6.
5+587.0		RT							3	1.5				2.5	3		6	7		CONSTRUCT SIDEWALK RAMP, TYPE I (MOD.). MATCH COLOR TO EXISTING MARBLE SIDEWALK.
5+702.0		LT							3	1.5				2.5	3		6	7		CONSTRUCT SIDEWALK RAMP, TYPE I.
5+720.0		LT							3	1.5				2.5	3		6	7		CONSTRUCT SIDEWALK RAMP, TYPE I.
5+838.0		LT							3	1.5				2.5	3		6	7		CONSTRUCT SIDEWALK RAMP, TYPE I.
5+859.0		LT							3	1.5				2.5	3		6	7		CONSTRUCT SIDEWALK RAMP, TYPE I.
6+182.0		LT										5								SEE SHEET 70 OF 108 FOR SIDEWALK RAMP TEXTURING DETAIL.
6+191.0		LT										5								SEE SHEET 70 OF 108 FOR SIDEWALK RAMP TEXTURING DETAIL.
6+213.677		LT/RT																2		
6+369.0		LT										5								SEE SHEET 70 OF 108 FOR SIDEWALK RAMP TEXTURING DETAIL.
6+376.0		LT										3								SEE SHEET 70 OF 108 FOR SIDEWALK RAMP TEXTURING DETAIL.
6+596.0		RT												1		1				CONSTRUCT CONCRETE CURB, TYPE B.
6+597.0		LT										5								SEE SHEET 70 OF 108 FOR SIDEWALK RAMP TEXTURING DETAIL.
6+622.0		LT												1		1				CONSTRUCT CONCRETE CURB, TYPE B.
6+626.0		RT							5	2.5			4	6		7.5	11.5			CONSTRUCT SIDEWALK RAMP, TYPE 6.
6+639.0		LT										3								SEE SHEET 70 OF 108 FOR SIDEWALK RAMP TEXTURING DETAIL.
6+640.0		RT							1.4	0.7			1.8	3		3	5			CONSTRUCT SIDEWALK PANEL.
6+641.0		RT										3								SEE SHEET 70 OF 108 FOR SIDEWALK RAMP TEXTURING DETAIL.
6+650.0		LT										3								SEE SHEET 70 OF 108 FOR SIDEWALK RAMP TEXTURING DETAIL.
6+656.0		LT												1		1				CONSTRUCT CONCRETE CURB, TYPE B.
6+750.0		LT										3								SEE SHEET 70 OF 108 FOR SIDEWALK RAMP TEXTURING DETAIL.
6+750.0		RT										3								SEE SHEET 70 OF 108 FOR SIDEWALK RAMP TEXTURING DETAIL.
6+828.0		RT										5								SEE SHEET 70 OF 108 FOR SIDEWALK RAMP TEXTURING DETAIL.
6+838.0		RT										5								SEE SHEET 70 OF 108 FOR SIDEWALK RAMP TEXTURING DETAIL.
6+902.0		RT							0.6	0.3			0.8	1.5		1.5	2.3			CONSTRUCT SIDEWALK PANEL.
6+908.0		LT										3								SEE SHEET 70 OF 108 FOR SIDEWALK RAMP TEXTURING DETAIL.
6+910.0		LT												1		1				CONSTRUCT CONCRETE CURB, TYPE B.
6+911.0		RT										3								SEE SHEET 70 OF 108 FOR SIDEWALK RAMP TEXTURING DETAIL.
6+936.0		RT							0.6	0.3			0.8	1.5		1.5	2.3			CONSTRUCT SIDEWALK PANEL.
6+949.0		LT							0.6	0.3			0.8	1.5		1.5	2.3			CONSTRUCT SIDEWALK PANEL.
7+044.0		RT							4	2			5				13			CONSTRUCT SIDEWALK RAMP, TYPE 2.
7+103.0		RT														2.5				
7+128.0		LT														2.5				
SHEET 7 SUBTOTAL									31.2	15.6		54	30.7	35.5	5.0	53.5	82.9	2		

DATUM	
VERTICAL	N/A
HORIZONTAL	N/A

ITEM
DETAIL
SUMMARY
SHEET
#1

SURVEYED BY	N/A	DATE	N/A
DRAWN BY	J.A.R.	DATE	4/01
SQUAD LEADER	T.P.K.		
DESIGN FILE NO.	pave/99d156/pd156.dgn		
IPARM FILE	pd1561d1.i	DATE PLOTTED	21-NOV-2005
PROJ. NAME	BENNINGTON		
PROJ. NO.	NH 2202(1)S		
SHEET	11	OF	108 SHEETS

 FILE NAME: #FILES
 DATE / USER: #DATE#
 USER: #USER#

ITEM DETAIL SUMMARY SHEET 2



LOCATION			GUARDRAIL						MISCELLANEOUS										REMARKS
STATION	STATION	POS.	621.20	621.20	621.52	621.60	621.80	621.81	203.15	203.16	203.28	212.20	301.28	616.28	616.40	616.41	618.10	619.17	
			STEEL BEAM G.R. m	2.4 m STEEL BEAM G.R. (MOD.) m	MANUF. TERM. SECTION EA	ANCHOR FOR G.R. EA	REMOVE & DISP. G.P. EA	REMOVE & DISP. G.R. m	COMMON EXCAVATION m ³	SOLID ROCK EXCAVATION m ³	EXCAVATION OF SURFACES & PAVEMENTS m ³	SCARIFYING PAVEMENT (MOD.) m ²	SUBBASE OF CRUSHED GRAVEL t	CAST IN PLACE PCC CURB TYPE B m	REMOVE & RESET CURB m	REMOVAL OF EXIST. CURB m	P.C.C. SIDEWALK 125 mm m ²	YIELD. MKR. POST EA	
VT. ROUTE 9																			
7+182.8		RT							4	2			5				13		CONSTRUCT SIDEWALK RAMP, TYPE 2
7+413.6		RT							4	2			5				13		CONSTRUCT SIDEWALK RAMP, TYPE 2
7+725.0		LT										3							SEE SHEET 70 OF 108 FOR SIDEWALK RAMP TEXTURING DETAIL.
7+725.0		RT										3							SEE SHEET 70 OF 108 FOR SIDEWALK RAMP TEXTURING DETAIL.
7+810.0		RT							3	1.5			2.5	3		6	7		CONSTRUCT SIDEWALK RAMP, TYPE 1.
7+825.0		LT										5							SEE SHEET 70 OF 108 FOR SIDEWALK RAMP TEXTURING DETAIL.
7+825.0		RT										5							SEE SHEET 70 OF 108 FOR SIDEWALK RAMP TEXTURING DETAIL.
7+880.0		RT							1.7	0.8			2	2		2	6		CONSTRUCT SIDEWALK PANEL.
7+880.0		LT							0.6	0.3			0.8	1.5		1.5	2.3		CONSTRUCT SIDEWALK PANEL.
7+883.0		LT							5	2.5			4	6		7.5	11.5		CONSTRUCT SIDEWALK RAMP, TYPE 6.
7+884.0		RT										3							SEE SHEET 70 OF 108 FOR SIDEWALK RAMP TEXTURING DETAIL.
7+896.0		LT							0.5	0.3			5						SEE SHEET 70 OF 108 FOR SIDEWALK RAMP TEXTURING DETAIL.
7+905.0		LT											0.8	1.5		1.5	2.3		CONSTRUCT SIDEWALK PANEL.
7+982.0		RT							0.6	0.3			0.6	1.3		1.3	1.7		CONSTRUCT SIDEWALK PANEL.
7+988.0		RT										5							SEE SHEET 70 OF 108 FOR SIDEWALK RAMP TEXTURING DETAIL.
8+006.0		RT										5							SEE SHEET 70 OF 108 FOR SIDEWALK RAMP TEXTURING DETAIL.
8+016.0		RT							0.5	0.3			0.6	1.3		1.3	1.7		CONSTRUCT SIDEWALK PANEL.
8+027.0		LT										3							SEE SHEET 70 OF 108 FOR SIDEWALK RAMP TEXTURING DETAIL.
8+028.0		RT										3							SEE SHEET 70 OF 108 FOR SIDEWALK RAMP TEXTURING DETAIL.
8+042.0		RT										5							SEE SHEET 70 OF 108 FOR SIDEWALK RAMP TEXTURING DETAIL.
8+055.0		LT							0.6	0.3			0.8	1.5		1.5	2.3		CONSTRUCT SIDEWALK PANEL.
8+242.0		LT										5							SEE SHEET 70 OF 108 FOR SIDEWALK RAMP TEXTURING DETAIL.
8+259.0		LT							3	1.5			2.5	3		6	7		CONSTRUCT SIDEWALK RAMP, TYPE 1.
8+438.0		RT							0.7	0.4			0.9	1.6		1.6	2.6		CONSTRUCT SIDEWALK PANEL.
8+458.0		LT							0.9	0.5			1.1	1.6		1.6	3.2		CONSTRUCT SIDEWALK PANEL.
8+472.0		LT										3							SEE SHEET 70 OF 108 FOR SIDEWALK RAMP DETAIL.
8+483.0		LT							0.9	0.5			1.1	1.6		1.6	3.2		CONSTRUCT SIDEWALK PANEL.
8+915.0		LT							5	2.5			4	6		7.5	11.5		CONSTRUCT SIDEWALK RAMP, TYPE 6.
8+925.0		RT										5							SEE SHEET 70 OF 108 FOR SIDEWALK RAMP DETAIL.
8+979.0		LT																	CONSTRUCT SIDEWALK RAMP, TYPE 1.
8+988.0		LT										5							SEE SHEET 70 OF 108 FOR SIDEWALK RAMP TEXTURING DETAIL.
SHEET 8 SUBTOTAL									31	15.7		63	31.7	31.9		40.9	88.3		

DATUM
 VERTICAL N/A
 HORIZONTAL N/A

**ITEM
DETAIL
SUMMARY
SHEET
#2**

SURVEYED BY N/A DATE N/A
 DRAWN BY J.A.R. DATE 4/01
 SQUAD LEADER T.P.K.
 DESIGN FILE NO. pave/99d156/pd156.dgn
 IPARM FILE pd156id2.i DATE PLOTTED 21-NOV-2005
 PROJ. NAME BENNINGTON
 PROJ. NO. NH 2202(1)S
 SHEET 12 OF 108 SHEETS

FILE NAME: #FILES#
 DATE / TIME: #DATE#
 USER: #USER#

ITEM DETAIL SUMMARY SHEET 3



LOCATION			GUARDRAIL						MISCELLANEOUS									REMARKS	
STATION	STATION	POS.	621.20	621.20	621.52	621.60	621.80	621.81	203.15	203.16	203.28	212.20	301.28	616.28	616.40	616.41	618.10		619.17
			STEEL BEAM G.R. m	2.4 m STEEL BEAM G.R. (MOD.) m	MANUF. TERM. SECTION EA	ANCHOR FOR G.R. EA	REMOVE & DISP. G.P. EA	REMOVE & DISP. G.R. m	COMMON EXCAVATION m ³	SOLID ROCK EXCAVATION m ³	EXCAVATION OF SURFACES & PAVEMENTS m ³	SCARIFYING PAVEMENT (MOD.) m ²	SUBBASE OF CRUSHED GRAVEL t	CAST IN PLACE PCC CURB TYPE B m	REMOVE & RESET CURB m	REMOVAL OF EXIST. CURB m	P. C. C. SIDEWALK 125 mm m ²		YIELD. MKR. POST EA
U.S. ROUTE 7																			
	4+752.0	LT													2.5				
	4+795.0	RT													2.5				
	5+178.0	LT							5	2.5			4	6		7.5	11.5		CONSTRUCT SIDEWALK RAMP, TYPE 6.
	5+286.0	RT										5							SEE SHEET 70 OF 108 FOR SIDEWALK RAMP TEXTURING DETAIL.
	5+294.0	RT										5							SEE SHEET 70 OF 108 FOR SIDEWALK RAMP TEXTURING DETAIL.
	5+440.0	LT							0.9	0.5			1.1	1.8		1.8	3.2		CONSTRUCT SIDEWALK PANEL.
	5+456.0	RT										5							SEE SHEET 70 OF 108 FOR SIDEWALK RAMP TEXTURING DETAIL.
	5+462.0	LT							0.9	0.5			1.1	1.8		1.8	3.2		CONSTRUCT SIDEWALK PANEL.
	LENGTH OF PROJECT	LT. & RT.											12.4						NEW DRIVEWAY SUBBASE MATERIAL
SHEET SUBTOTAL									6.8	3.5		15	6.2	9.6	5.0	11.1	17.9	-	
SHEET 7 SUBTOTAL									31.2	15.6		54	30.7	35.5	5.0	53.5	82.9	2	
SHEET 8 SUBTOTAL									31	15.7		63	31.7	31.9	-	40.9	88.3	-	
ROUNDING									6	2.2		8	6.4	4	1	6.5	10.9	-	
TOTAL									75	37		140	95	81	11	112	200	2	

DATUM
 VERTICAL N/A
 HORIZONTAL N/A

ITEM
 DETAIL
 SUMMARY
 SHEET
 #3

SURVEYED BY N/A DATE N/A
 DRAWN BY J.A.R. DATE 4/01
 SQUAD LEADER T.P.K.
 DESIGN FILE NO. pave/99d156/pd156.dgn
 IPARM FILE pd1561d3.i DATE PLOTTED 21-NOV-2005
 PROJ. NAME BENNINGTON
 PROJ. NO. NH 2202(1)S
 SHEET 13 OF 108 SHEETS

FILE NAME ##FILES#
 DATE / TIME ##DATE##
 USER ##USER##

646.40 DURABLE 100 mm WHITE LINE
 (ALL LINES WILL INCLUDE EDGE LINE BREAKS AND RADIUS FOR TOWN HIGHWAYS)
 VT. ROUTE 9:
 STA. 5+072.652 - STA. 5+320.0 LT & RT

646.41 DURABLE 100 mm YELLOW LINE
 (ALL LINES WILL INCLUDE C/L BREAKS FOR TOWN HIGHWAYS) S=SOLID, D=DASHED
 VT. ROUTE 9:
 STA. 5+072.652 - STA. 5+320.0 LT ☐ RT S


646.42 DURABLE 200 mm WHITE LINE
 STA. 5+316.2 - STA. 5+319.8 RT, SHOULDER HATCHING (9.2 m)

675.50 REMOVING SIGNS
 AS SHOWN - 2 3

646.60 TEMPORARY 100 mm WHITE LINE
 (ALL LINES WILL INCLUDE EDGE LINE BREAKS AND RADIUS FOR TOWN HIGHWAYS)
 VT. ROUTE 9:
 STA. 5+072.652 - STA. 5+320.0 LT & RT

646.61 TEMPORARY 100 mm YELLOW LINE
 (ALL LINES WILL INCLUDE C/L BREAKS FOR TOWN HIGHWAYS) S=SOLID, D=DASHED
 VT. ROUTE 9:
 STA. 5+072.652 - STA. 5+320.0 LT ☐ RT S

675.60 ERECTING SALVAGED SIGNS
 AS SHOWN - 1

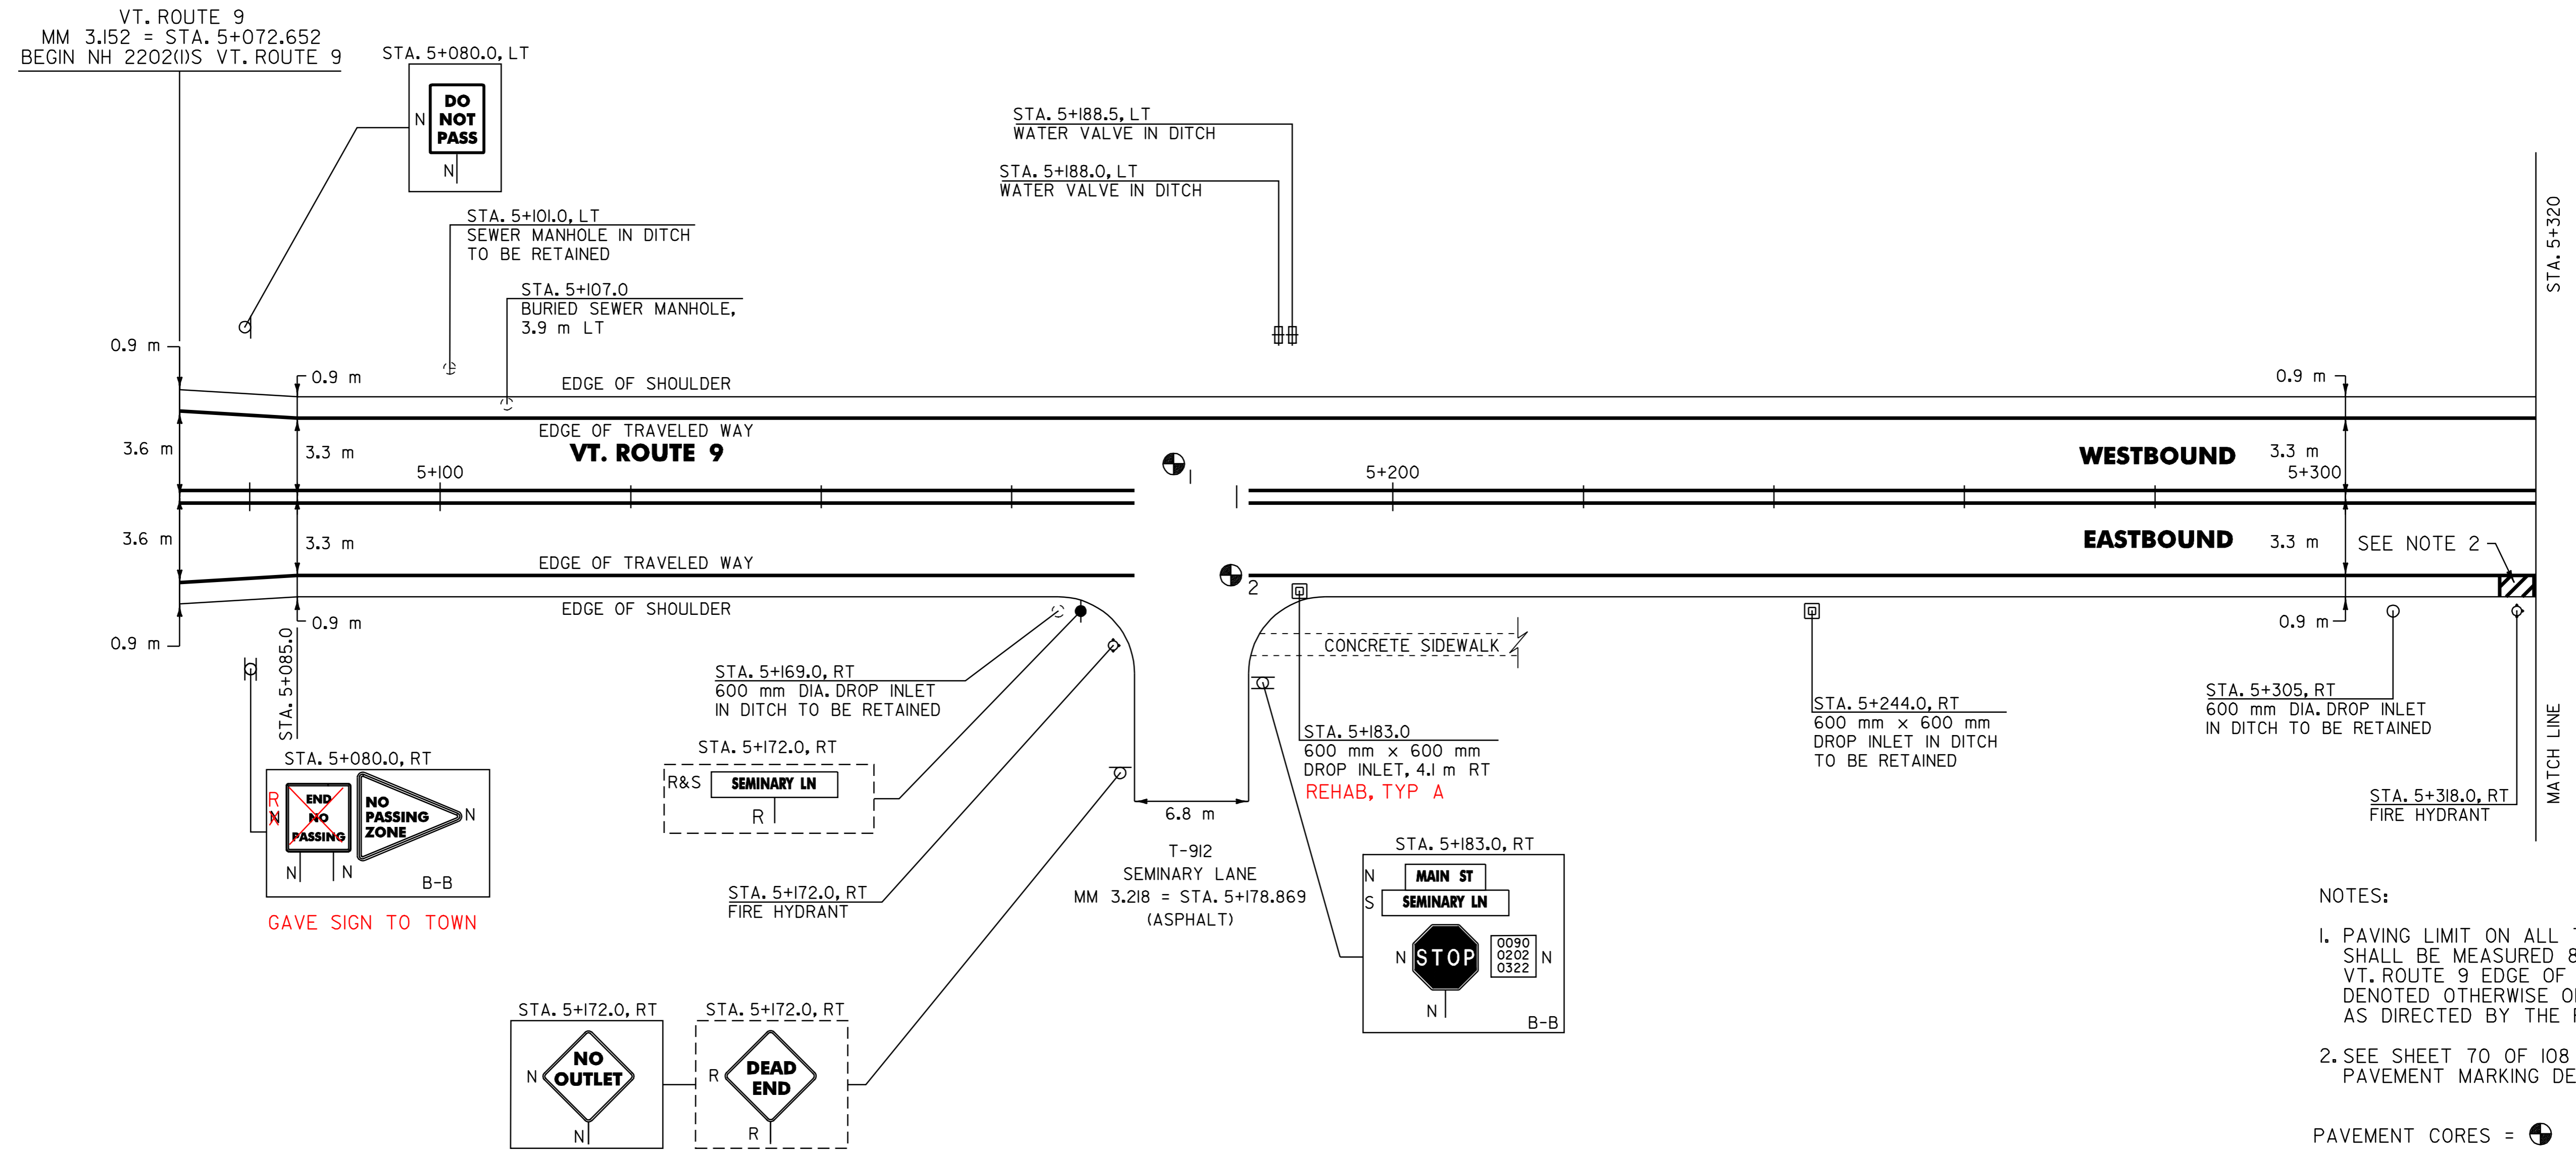

- NOTES:
- PAVING LIMIT ON ALL TOWN HIGHWAYS SHALL BE MEASURED 8 m BACK FROM VT. ROUTE 9 EDGE OF SHOULDER UNLESS DENOTED OTHERWISE ON THE PLANS OR AS DIRECTED BY THE RESIDENT ENGINEER.
 - SEE SHEET 70 OF 108 FOR FIRE HYDRANT PAVEMENT MARKING DETAIL.

PAVEMENT CORES =

#	TOTAL DEPTH (mm)	PCC	COMMENTS
1	140	Y	
2	152	Y	

412 REHAB
 604.40 CHANGE ELEVATION OF DI, CB OR MH CLASS I
 VT. ROUTE 9:
 STA. 5+183.0 RT

604.42 CHANGE ELEVATION OF SEWER MANHOLE
 VT. ROUTE 9:
 STA. 5+107.0 LT

DATUM

VERTICAL	N/A
HORIZONTAL	N/A

SIGN LEGEND
 R= REMOVE
 S= SALVAGE
 N= NEW
 RET= RETAIN
 B-B= BACK TO BACK
 EXISTING= - - - - -
 NEW= _____

PAVING PROJECT LAYOUT # 1

SURVEYED BY	N/A	DATE	N/A
DRAWN BY	J.A.R.	DATE	4/01
SQUAD LEADER	T.P.K.		
DESIGN FILE NO.	pave/99d156/pdl56.dgn		
IPARM FILE	pdl56101.i	DATE PLOTTED	NOV-2005 10:21
PROJ. NAME	BENNINGTON		
PROJ. NO.	NH 2202(1)S		
SHEET 14 OF 108	SHEETS		

646.40 DURABLE 100 mm WHITE LINE
 (ALL LINES WILL INCLUDE EDGE LINE BREAKS AND RADIUS FOR TOWN HIGHWAYS)
 VT. ROUTE 9:
 STA. 5+320.0 - STA. 5+520.0 LT & RT
 STA. 5+420.0 - STA. 5+460.0 RT, DOTTED LINE (EDGE LINE)

646.41 DURABLE 100 mm YELLOW LINE
 (ALL LINES WILL INCLUDE C/L BREAKS FOR TOWN HIGHWAYS) S=SOLID, D=DASHED
 VT. ROUTE 9:
 STA. 5+320.0 - STA. 5+520.0 LT S C RT S

646.46 DURABLE 600 mm STOP BAR (TYPE I TAPE)
 VT. ROUTE 9:
 STA. 5+452.457 RT, T-2
 STA 5+455 RT, T-2
 646.66 TEMPORARY 600 mm STOP BAR
 VT. ROUTE 9:
 STA. 5+452.457 RT, T-2


675.50 REMOVING SIGNS
 AS SHOWN - 24

ADJUST HEIGHT OF WATER VALVE
 STA 05+448 RT

646.60 TEMPORARY 100 mm WHITE LINE
 (ALL LINES WILL INCLUDE EDGE LINE BREAKS AND RADIUS FOR TOWN HIGHWAYS)
 VT. ROUTE 9:
 STA. 5+320.0 - STA. 5+520.0 LT & RT
 STA. 5+420.0 - STA. 5+460.0 RT, DOTTED LINE (EDGE LINE)

646.61 TEMPORARY 100 mm YELLOW LINE
 (ALL LINES WILL INCLUDE C/L BREAKS FOR TOWN HIGHWAYS) S=SOLID, D=DASHED
 VT. ROUTE 9:
 STA. 5+320.0 - STA. 5+520.0 LT S C RT S

646.50 DURABLE LETTER OR SYMBOL (TYPE I TAPE)
 VT. ROUTE 9:
 STA. 5+452.457 RT, T-2, "S,T,O,P" (4 EA)
 STA 5+455 RT, T-2 "STOP" (4 EA)
 646.70 TEMPORARY LETTER OR SYMBOL
 VT. ROUTE 9:
 STA. 5+452.457 RT, T-2, "S,T,O,P" (8 EA)

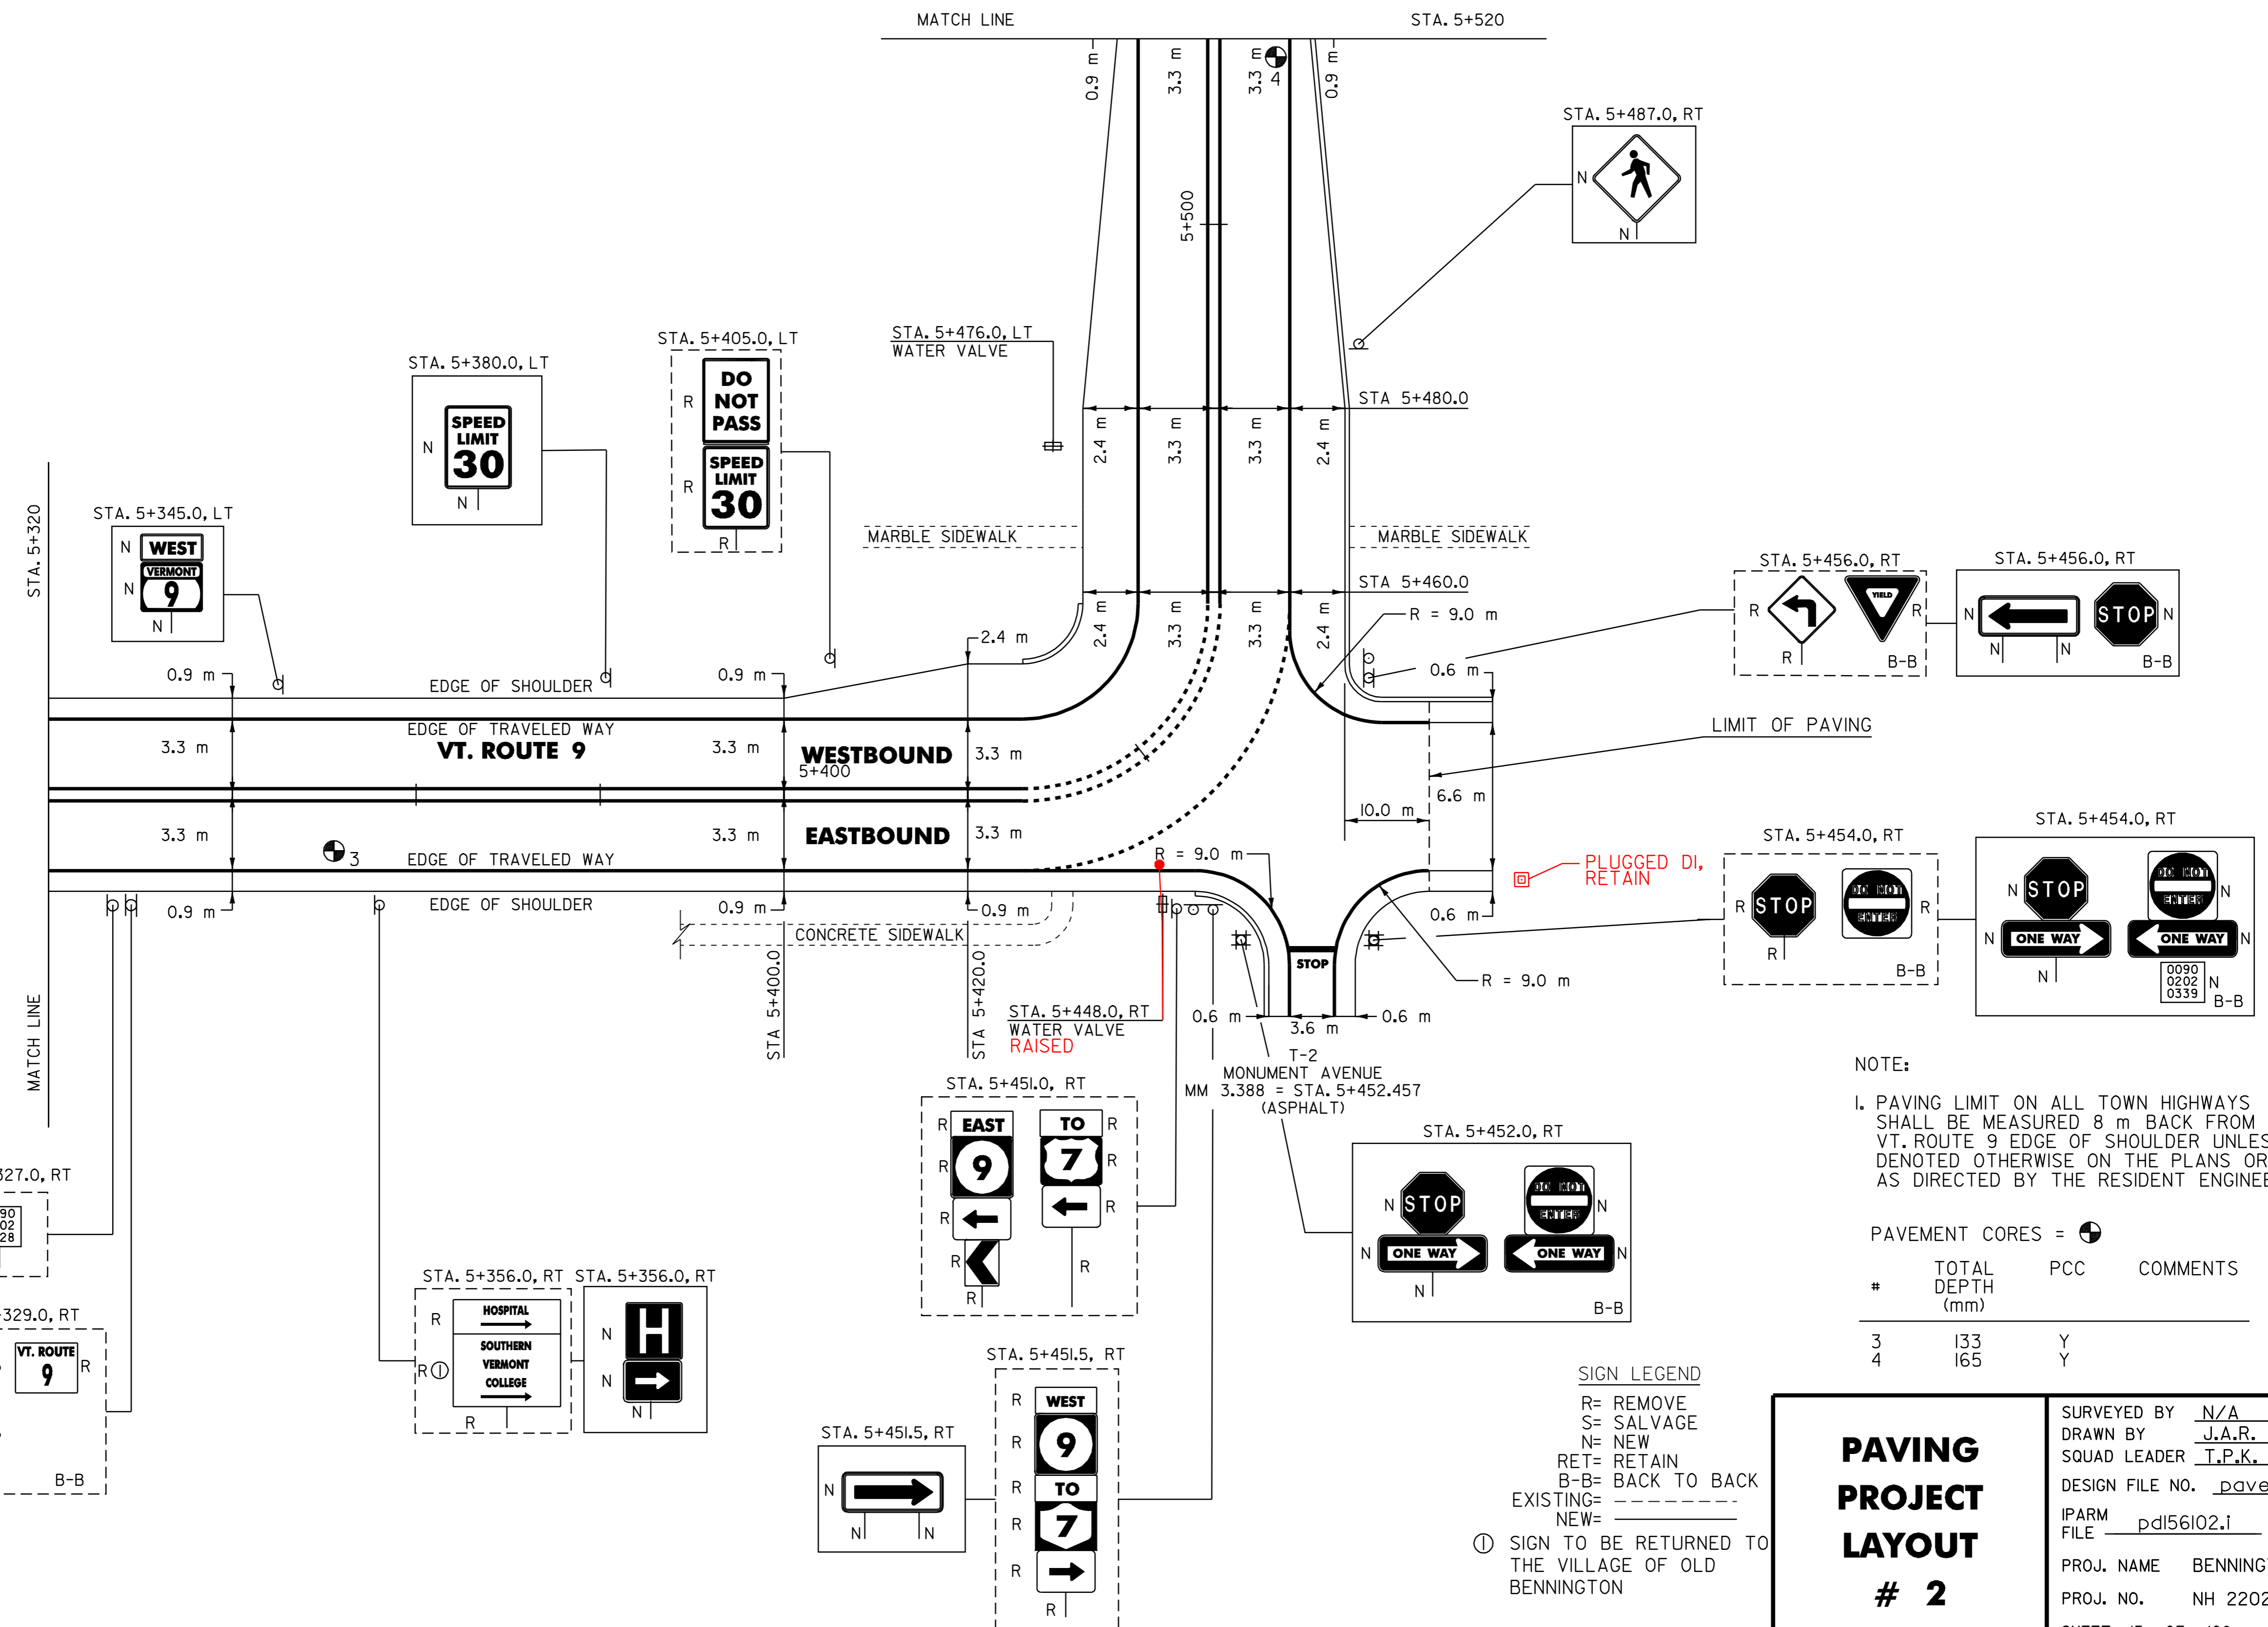

NOTE:
 1. PAVING LIMIT ON ALL TOWN HIGHWAYS SHALL BE MEASURED 8 m BACK FROM VT. ROUTE 9 EDGE OF SHOULDER UNLESS DENOTED OTHERWISE ON THE PLANS OR AS DIRECTED BY THE RESIDENT ENGINEER.

PAVEMENT CORES =

#	TOTAL DEPTH (mm)	PCC	COMMENTS
3	133	Y	
4	165	Y	

SIGN LEGEND
 R= REMOVE
 S= SALVAGE
 N= NEW
 RET= RETAIN
 B-B= BACK TO BACK
 EXISTING=
 NEW=
 ① SIGN TO BE RETURNED TO THE VILLAGE OF OLD BENNINGTON

PAVING PROJECT LAYOUT # 2

SURVEYED BY N/A DATE N/A
 DRAWN BY J.A.R. DATE 4/01
 SQUAD LEADER T.P.K.
 DESIGN FILE NO. pave/99d156/pd156.dgn
 IPARM FILE pd156102.i DATE NOV-2005 10
 PROJ. NAME BENNINGTON
 PROJ. NO. NH 2202(1)S
 SHEET 15 OF 108 SHEETS

DATUM

VERTICAL	N/A
HORIZONTAL	N/A

646.40 DURABLE 100 mm WHITE LINE
 (ALL LINES WILL INCLUDE EDGE LINE BREAKS AND RADIUS FOR TOWN HIGHWAYS)
 VT. ROUTE 9:
 STA. 5+520.0 - STA. 5+680.0 LT & RT
 STA. 5+530.0 - STA. 5+550.0 LT, DOTTED LINE
 STA. 5+545.0 - STA. 5+585.0 RT, DOTTED LINE
 STA. 5+570.0 - STA. 5+585.0 LT, DOTTED LINE

646.46 DURABLE 600 mm STOP BAR (TYPE ITAPE)
 VT. ROUTE 9:
 STA. 5+574.768 LT, T-2

646.66 TEMPORARY 600 mm STOP BAR
 VT. ROUTE 9:
 STA. 5+574.768 LT, T-2

646.50 DURABLE LETTER OR SYMBOL (TYPE ITAPE)
 VT. ROUTE 9:
 STA. 5+574.768 LT, T-2, "S,T,O,P" (4 EA)

646.70 TEMPORARY LETTER OR SYMBOL
 VT. ROUTE 9:
 STA. 5+574.768 LT, T-2, "S,T,O,P" (8 EA)

646.51 DURABLE CROSSWALK MARKINGS WITH DIAGONAL LINES (MOD.)
 VT. ROUTE 9:
 STA. 5+587.0

646.71 TEMPORARY CROSSWALK MARKINGS WITH DIAGONAL LINE
 VT. ROUTE 9:
 STA. 5+587.0

646.60 TEMPORARY 100 mm WHITE LINE
 (ALL LINES WILL INCLUDE EDGE LINE BREAKS AND RADIUS FOR TOWN HIGHWAYS)






VT. ROUTE 9:
 STA. 5+520.0 - STA. 5+680.0 LT & RT
 STA. 5+530.0 - STA. 5+550.0 LT, DOTTED LINE
 STA. 5+545.0 - STA. 5+585.0 RT, DOTTED LINE
 STA. 5+570.0 - STA. 5+585.0 LT, DOTTED LINE

646.41 DURABLE 100 mm YELLOW LINE
 (ALL LINES WILL INCLUDE C/L BREAKS FOR TOWN HIGHWAYS) S=SOLID, D=DASHED

VT. ROUTE 9:
 STA. 5+520.0 - STA. 5+680.0 LT S - RT S
 STA. 5+574.768 DOUBLE SOLID LT, T-2

646.61 TEMPORARY 100 mm YELLOW LINE
 (ALL LINES WILL INCLUDE C/L BREAKS FOR TOWN HIGHWAYS) S=SOLID, D=DASHED

VT. ROUTE 9:
 STA. 5+520.0 - STA. 5+680.0 LT S - RT S
 STA. 5+574.768 DOUBLE SOLID LT, T-2

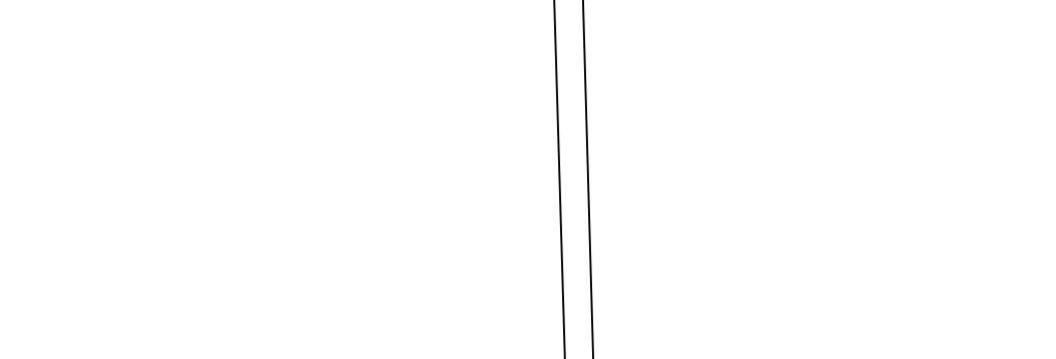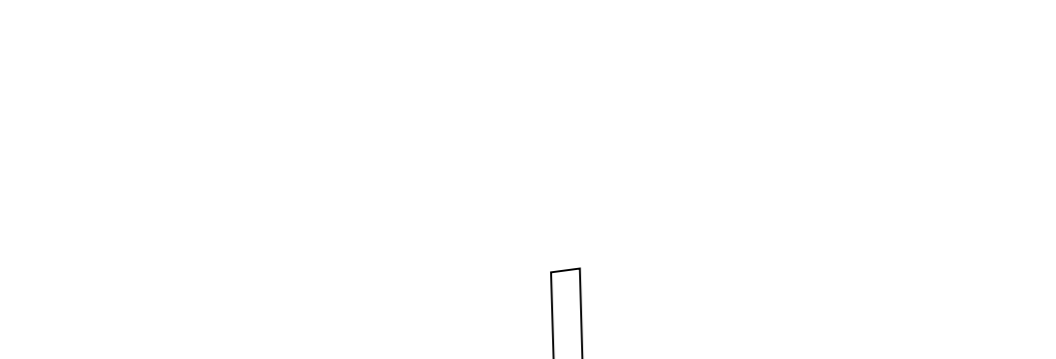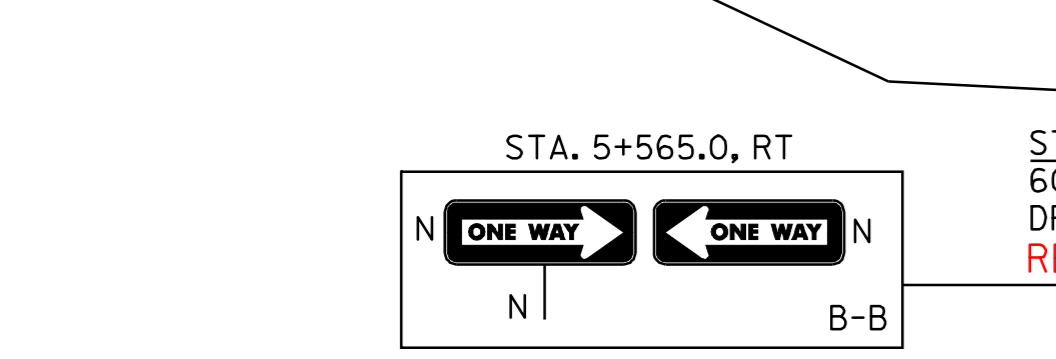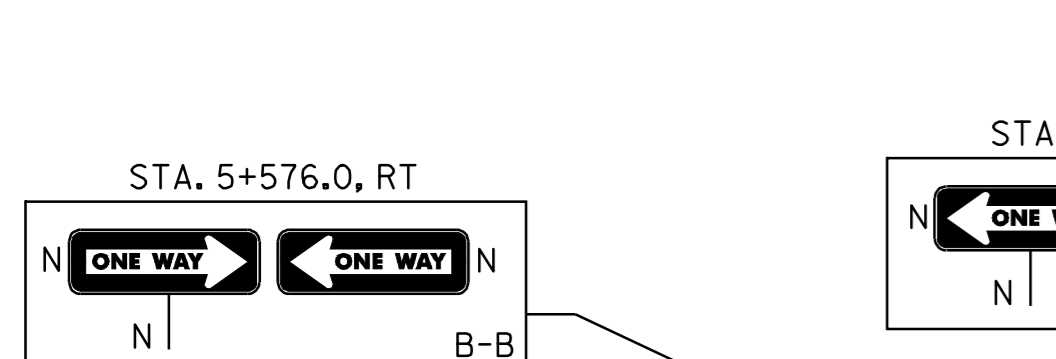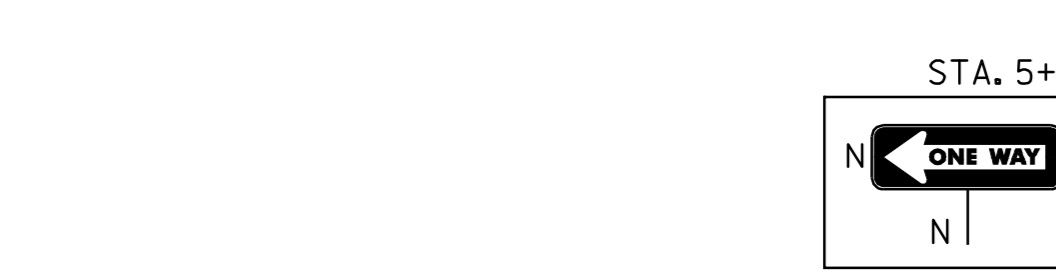

604.412 REHABILITATION OF DI, CB OR MH, CLASS I
~~604.40 CHANGE ELEVATION OF DI, CB OR MH~~

VT. ROUTE 9:
 STA. 5+548.0 RT
 STA. 5+582.0 LT
 STA. 5+586.0 LT
 STA. 5+587.0 RT
 STA. 5+674.0 RT

604.40 CHANGE ELEVATION OF DI, CB OR MH
~~604.412 REHABILITATION OF DI, CB OR MH, CLASS I~~

VT. ROUTE 9:
 STA. 5+648.0 RT

604.42 CHANGE ELEVATION OF SEWER MANHOLE

VT. ROUTE 9:
 STA. 5+648.0 LT

616.47 BITUMINOUS CONCRETE GUTTERS & TRAFFIC ISLANDS


VT. ROUTE 9:
 STA. 5+588.0 - STA. 5+680.0 RT (5.8 +)

604.42 CHANGE ELEVATION OF SEWER MANHOLE

VT. ROUTE 9:
 STA. 5+648.0 LT

ADJUST ELEVATION OF WATER VALVE
 STA 05+570 LT

DATUM	
VERTICAL	N/A
HORIZONTAL	N/A

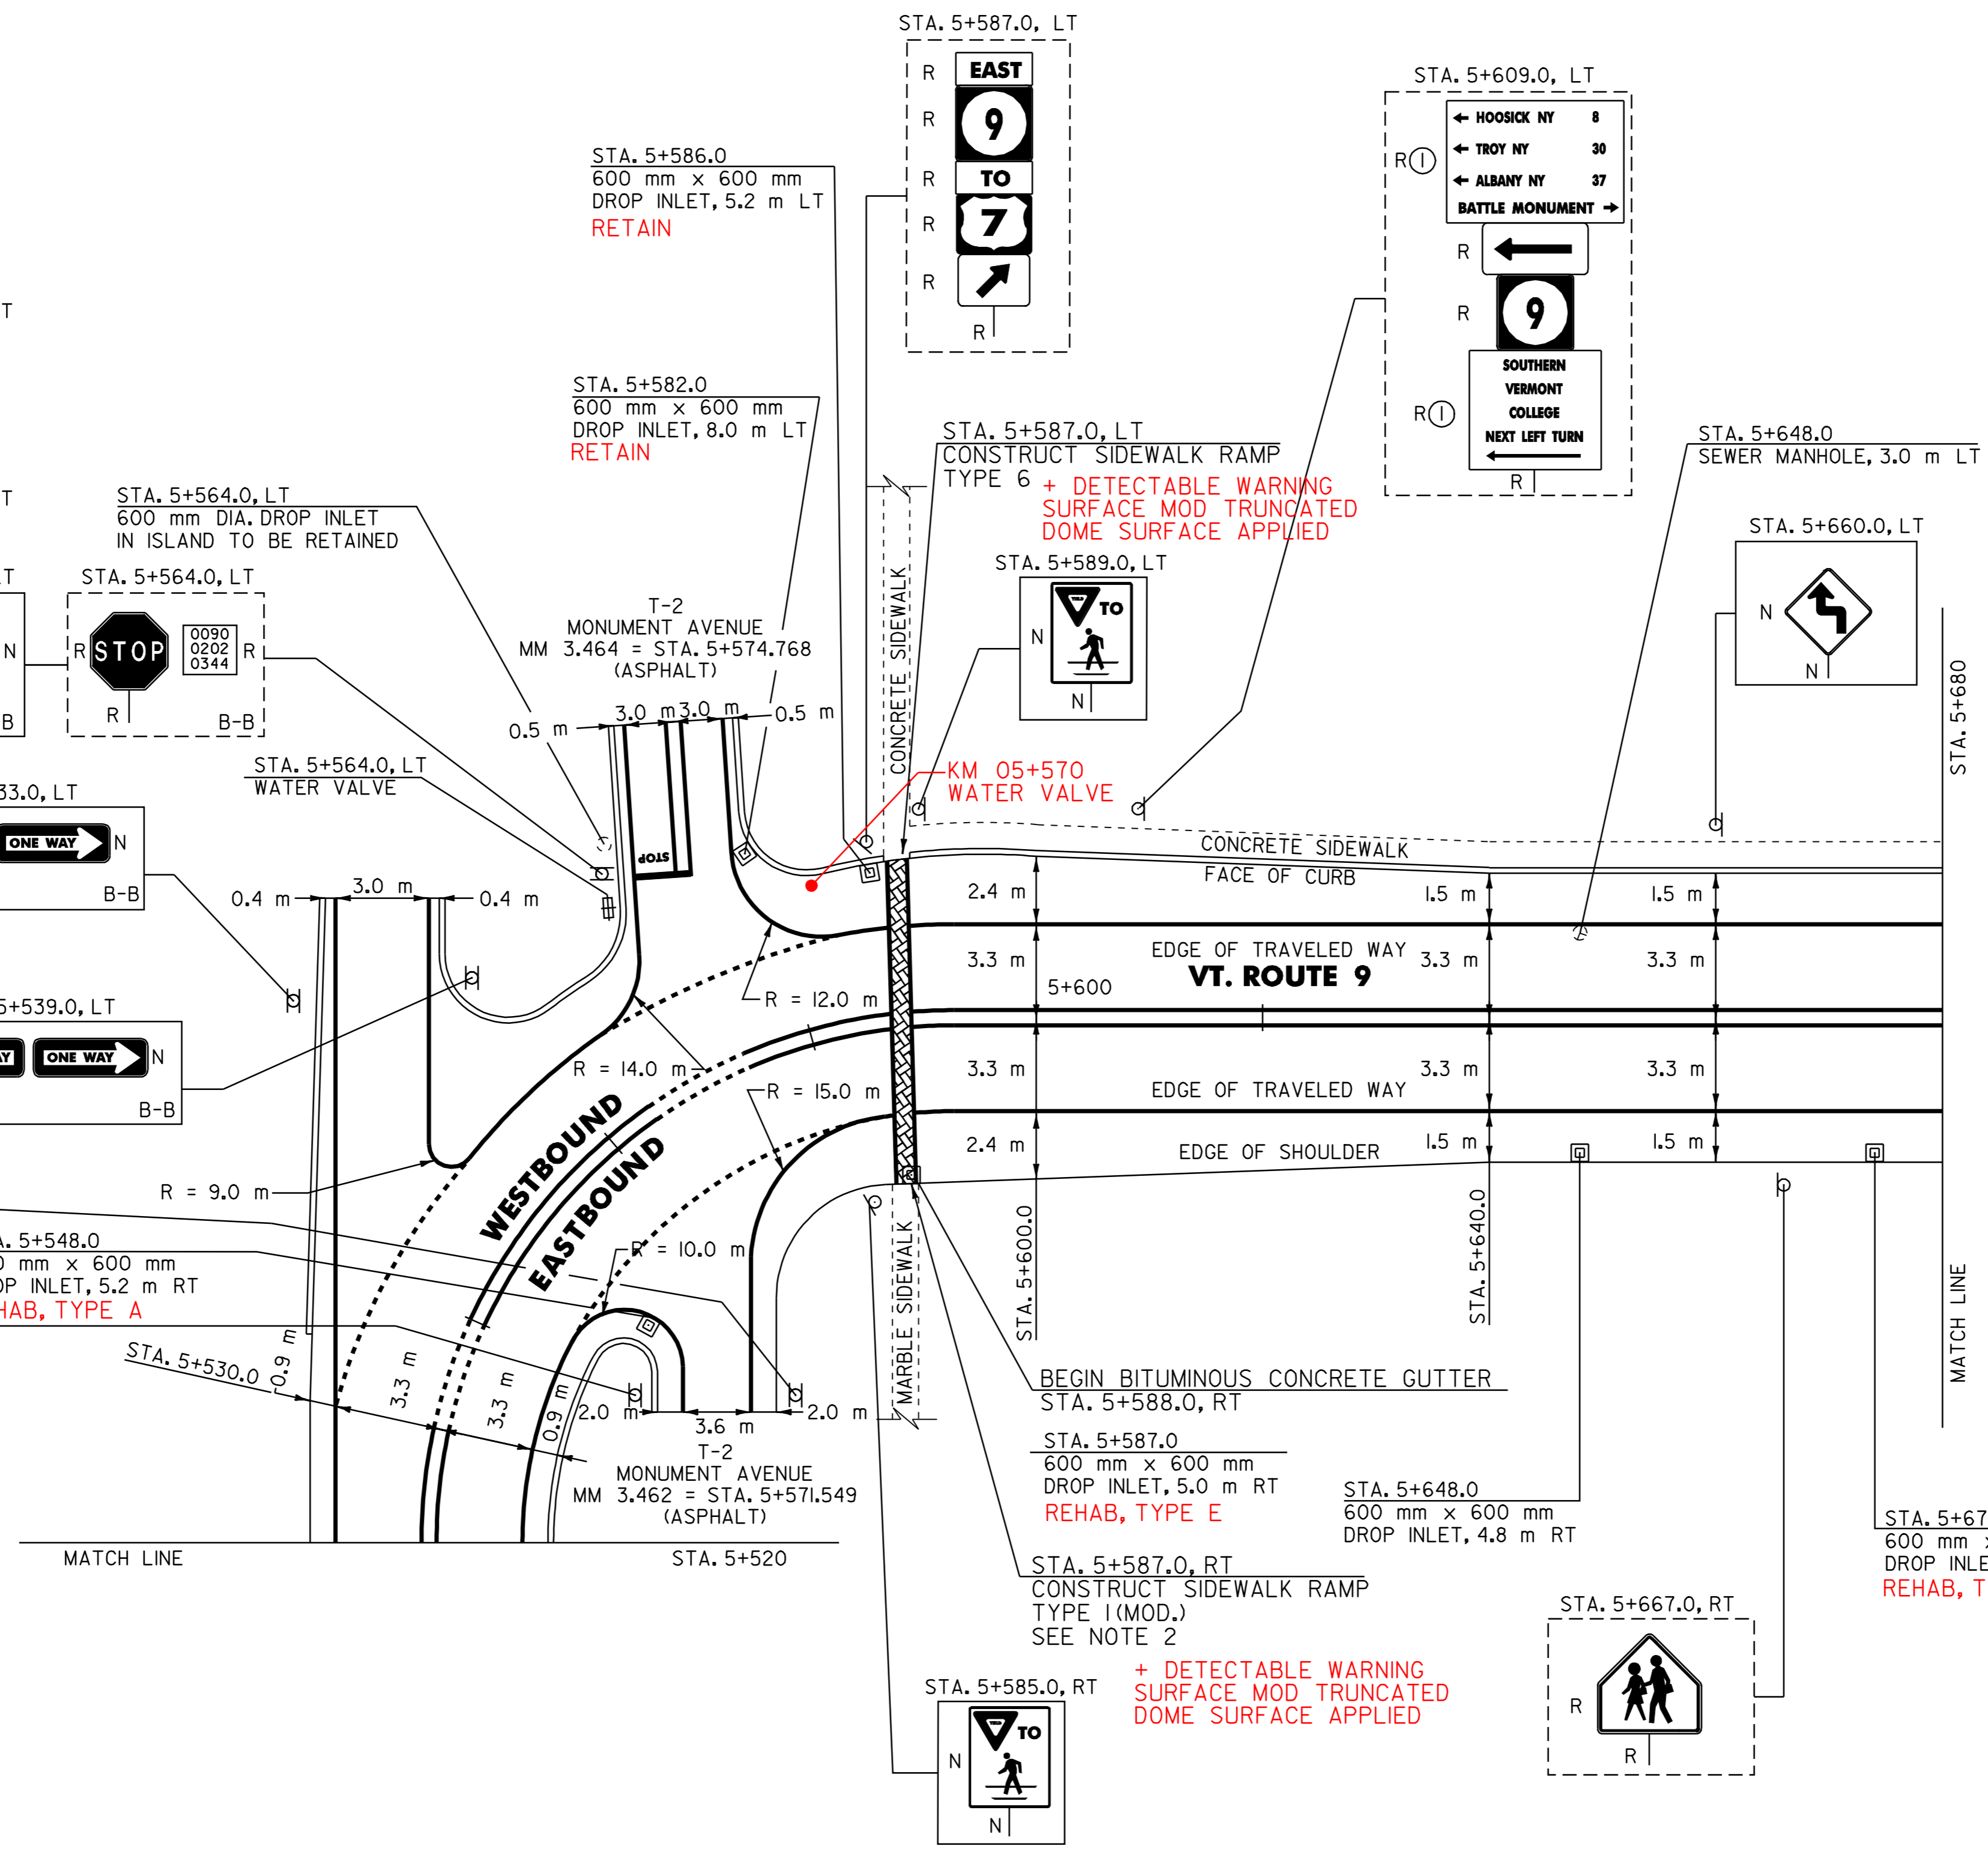

ITEM 618.30 DETECTABLE WARNING SURFACE MOD TRUNCATED DOME SURFACE APPLIED
 STA 5+587.0 LT .743m²
 STA 5+508.0 RT .743 m²

- NOTES:
- PAVING LIMIT ON ALL TOWN HIGHWAYS SHALL BE MEASURED 8 m BACK FROM VT. ROUTE 9 EDGE OF SHOULDER UNLESS DENOTED OTHERWISE ON THE PLANS OR AS DIRECTED BY THE RESIDENT ENGINEER.
 - IMPACTS TO THE EXISTING MARBLE SIDEWALK SHALL BE MINIMIZED DURING CONSTRUCTION OF THE NEW SIDEWALK RAMP. THE CONCRETE AT THIS RAMP SHALL BE COLORED TO MATCH THE COLOR OF THE EXISTING MARBLE SIDEWALK AS DIRECTED BY THE RESIDENT ENGINEER.

SIGN LEGEND

R= REMOVE
 S= SALVAGE
 N= NEW
 RET= RETAIN
 B-B= BACK TO BACK
 EXISTING= - - - - -
 NEW= _____

Ⓢ SIGN TO BE RETURNED TO THE VILLAGE OF OLD BENNINGTON

PAVING PROJECT LAYOUT # 3

SURVEYED BY	N/A	DATE	N/A
DRAWN BY	J.A.R.	DATE	4/01
SQUAD LEADER	T.P.K.		
DESIGN FILE NO.	pave/99dl56/pdl56.dgn		
IPARM FILE	pdl56i03.i	DATE PLOTTED	NOV-2005 10:21
PROJ. NAME	BENNINGTON		
PROJ. NO.	NH 2202(1)S		
SHEET 16 OF 108	SHEETS		

646.40 DURABLE 100 mm WHITE LINE
(ALL LINES WILL INCLUDE EDGE LINE BREAKS AND RADIUS FOR TOWN HIGHWAYS)

VT. ROUTE 9:
STA. 5+680.0 - STA. 5+860.0 LT & RT

646.60 TEMPORARY 100 mm WHITE LINE
(ALL LINES WILL INCLUDE EDGE LINE BREAKS AND RADIUS FOR TOWN HIGHWAYS)

VT. ROUTE 9:
STA. 5+680.0 - STA. 5+860.0 LT & RT

646.41 DURABLE 100 mm YELLOW LINE
(ALL LINES WILL INCLUDE C/L BREAKS FOR TOWN HIGHWAYS) S=SOLID, D=DASHED

VT. ROUTE 9:
STA. 5+680.0 - STA. 5+860.0 LT S - S
STA. 5+708.343 DOUBLE SOLID LT, T-910

646.61 TEMPORARY 100 mm YELLOW LINE
(ALL LINES WILL INCLUDE C/L BREAKS FOR TOWN HIGHWAYS) S=SOLID, D=DASHED

VT. ROUTE 9:
STA. 5+680.0 - STA. 5+860.0 LT S - S
STA. 5+708.343 DOUBLE SOLID LT, T-910

646.46 DURABLE 600 mm STOP BAR (TYPE I TAPE)

VT. ROUTE 9:
STA. 5+708.343 LT, T-910

646.66 TEMPORARY 600 mm STOP BAR

VT. ROUTE 9:
STA. 5+708.343 LT, T-910

646.50 DURABLE LETTER OR SYMBOL (TYPE I TAPE)

VT. ROUTE 9:
STA. 5+708.343 LT, T-910, "S,T,O,P" (4 EA)
STA. 5+720.0 RT, "S,C,H,O,O,L" (6 EA)

646.70 TEMPORARY LETTER OR SYMBOL

VT. ROUTE 9:
STA. 5+708.343 LT, T-910, "S,T,O,P" (8 EA)
STA. 5+720.0 RT, "S,C,H,O,O,L" (12 EA)

646.51 DURABLE CROSSWALK MARKINGS WITH DIAGONAL LINES (MOD.)


VT. ROUTE 9:
STA. 5+708.343 LT, T-910

646.71 TEMPORARY CROSSWALK MARKINGS WITH DIAGONAL LINES

VT. ROUTE 9:
STA. 5+708.343 LT, T-910

675.50 REMOVING SIGNS

AS SHOWN - 5

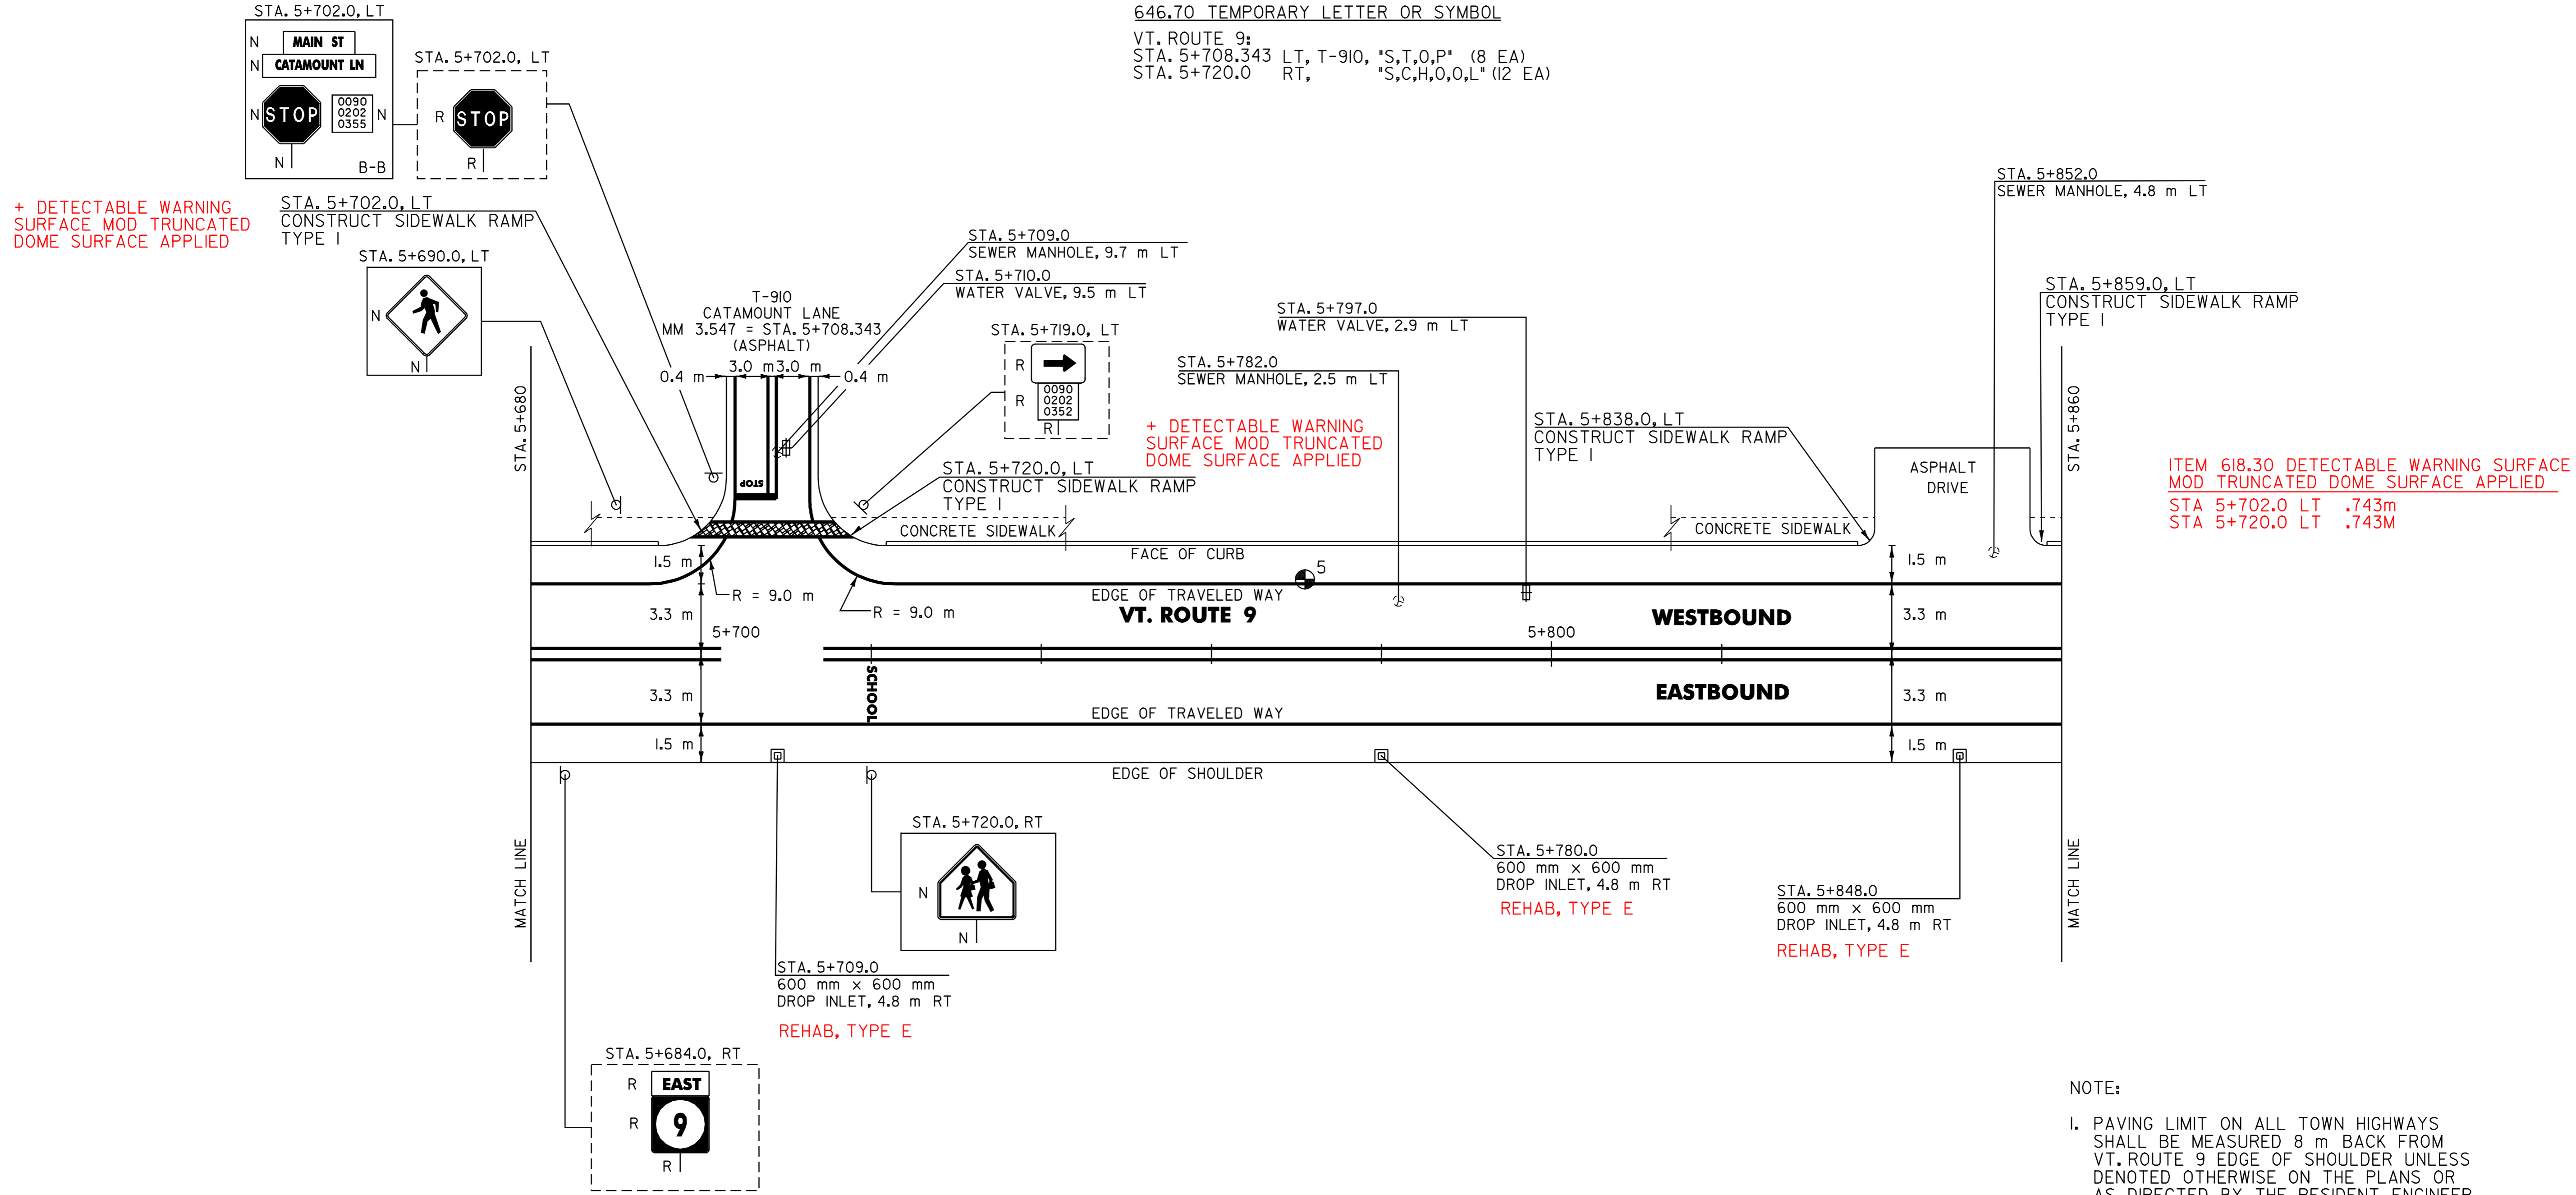

+ DETECTABLE WARNING SURFACE MOD TRUNCATED DOME SURFACE APPLIED

+ DETECTABLE WARNING SURFACE MOD TRUNCATED DOME SURFACE APPLIED

ITEM 618.30 DETECTABLE WARNING SURFACE MOD TRUNCATED DOME SURFACE APPLIED
STA 5+702.0 LT .743m
STA 5+720.0 LT .743M

604.412 REHABILITATION OF DI, CB OR MH, CLASS I
~~604.40 CHANGE ELEVATION OF DI, CB OR MH~~

~~VT. ROUTE 9:
STA. 5+709.0 RT
STA. 5+780.0 RT~~

604.412 REHABILITATION OF DI, CB OR MH, CLASS I

VT. ROUTE 9:
STA. 5+848.0 RT
VT. ROUTE 9:
STA. 5+709.0 RT
STA. 5+780.0 RT

604.42 CHANGE ELEVATION OF SEWER MANHOLE

VT. ROUTE 9:
STA. 5+709.0 LT
STA. 5+782.0 LT
STA. 5+852.0 LT

629.20 ADJUST ELEVATION OF VALVE BOX

VT. ROUTE 9:
STA. 5+710.0 LT
STA. 5+797.0 LT

616.47 BITUMINOUS CONCRETE GUTTERS & TRAFFIC ISLANDS

VT. ROUTE 9:
STA. 5+680.0 - STA. 5+860.0 RT (13.0 ft)

NOTE:
I. PAVING LIMIT ON ALL TOWN HIGHWAYS SHALL BE MEASURED 8 m BACK FROM VT. ROUTE 9 EDGE OF SHOULDER UNLESS DENOTED OTHERWISE ON THE PLANS OR AS DIRECTED BY THE RESIDENT ENGINEER.

PAVEMENT CORES =

#	TOTAL DEPTH (mm)	PCC	COMMENTS
5	127	Y	

DATUM

VERTICAL	N/A
HORIZONTAL	N/A

SIGN LEGEND
R= REMOVE
S= SALVAGE
N= NEW
RET= RETAIN
B-B= BACK TO BACK
EXISTING= - - - - -
NEW= _____

PAVING PROJECT LAYOUT # 4

SURVEYED BY	N/A	DATE	N/A
DRAWN BY	J.A.R.	DATE	4/01
SQUAD LEADER	T.P.K.		
DESIGN FILE NO.	pave/99d156/pd156.dgn		
IPARM FILE	pd156104.i	DATE PLOTTED	NOV-2005 10:21
PROJ. NAME	BENNINGTON		
PROJ. NO.	NH 2202(1)S		
SHEET 17 OF 108	SHEETS		

646.40 DURABLE 100 mm WHITE LINE
 (ALL LINES WILL INCLUDE EDGE LINE BREAKS AND RADIUS FOR TOWN HIGHWAYS)
 VT. ROUTE 9:
 STA. 5+860.0 - STA. 6+040.0 LT & RT

646.60 TEMPORARY 100 mm WHITE LINE
 (ALL LINES WILL INCLUDE EDGE LINE BREAKS AND RADIUS FOR TOWN HIGHWAYS)
 VT. ROUTE 9:
 STA. 5+860.0 - STA. 6+040.0 LT & RT


646.41 DURABLE 100 mm YELLOW LINE
 (ALL LINES WILL INCLUDE C/L BREAKS FOR TOWN HIGHWAYS) S=SOLID, D=DASHED
 VT. ROUTE 9:
 STA. 5+860.0 - STA. 6+040.0 LT ☉ RT S - S

646.61 TEMPORARY 100 mm YELLOW LINE
 (ALL LINES WILL INCLUDE C/L BREAKS FOR TOWN HIGHWAYS) S=SOLID, D=DASHED
 VT. ROUTE 9:
 STA. 5+860.0 - STA. 6+040.0 LT ☉ RT S - S

646.50 DURABLE LETTER OR SYMBOL (TYPE I TAPE)
 VT. ROUTE 9:
 STA. 5+985.0 LT, "S,C,H,O,O,L" (6 EA)

646.70 TEMPORARY LETTER OR SYMBOL
 VT. ROUTE 9:
 STA. 5+985.0 LT, "S,C,H,O,O,L" (12 EA)

675.50 REMOVING SIGNS
 AS SHOWN - 2

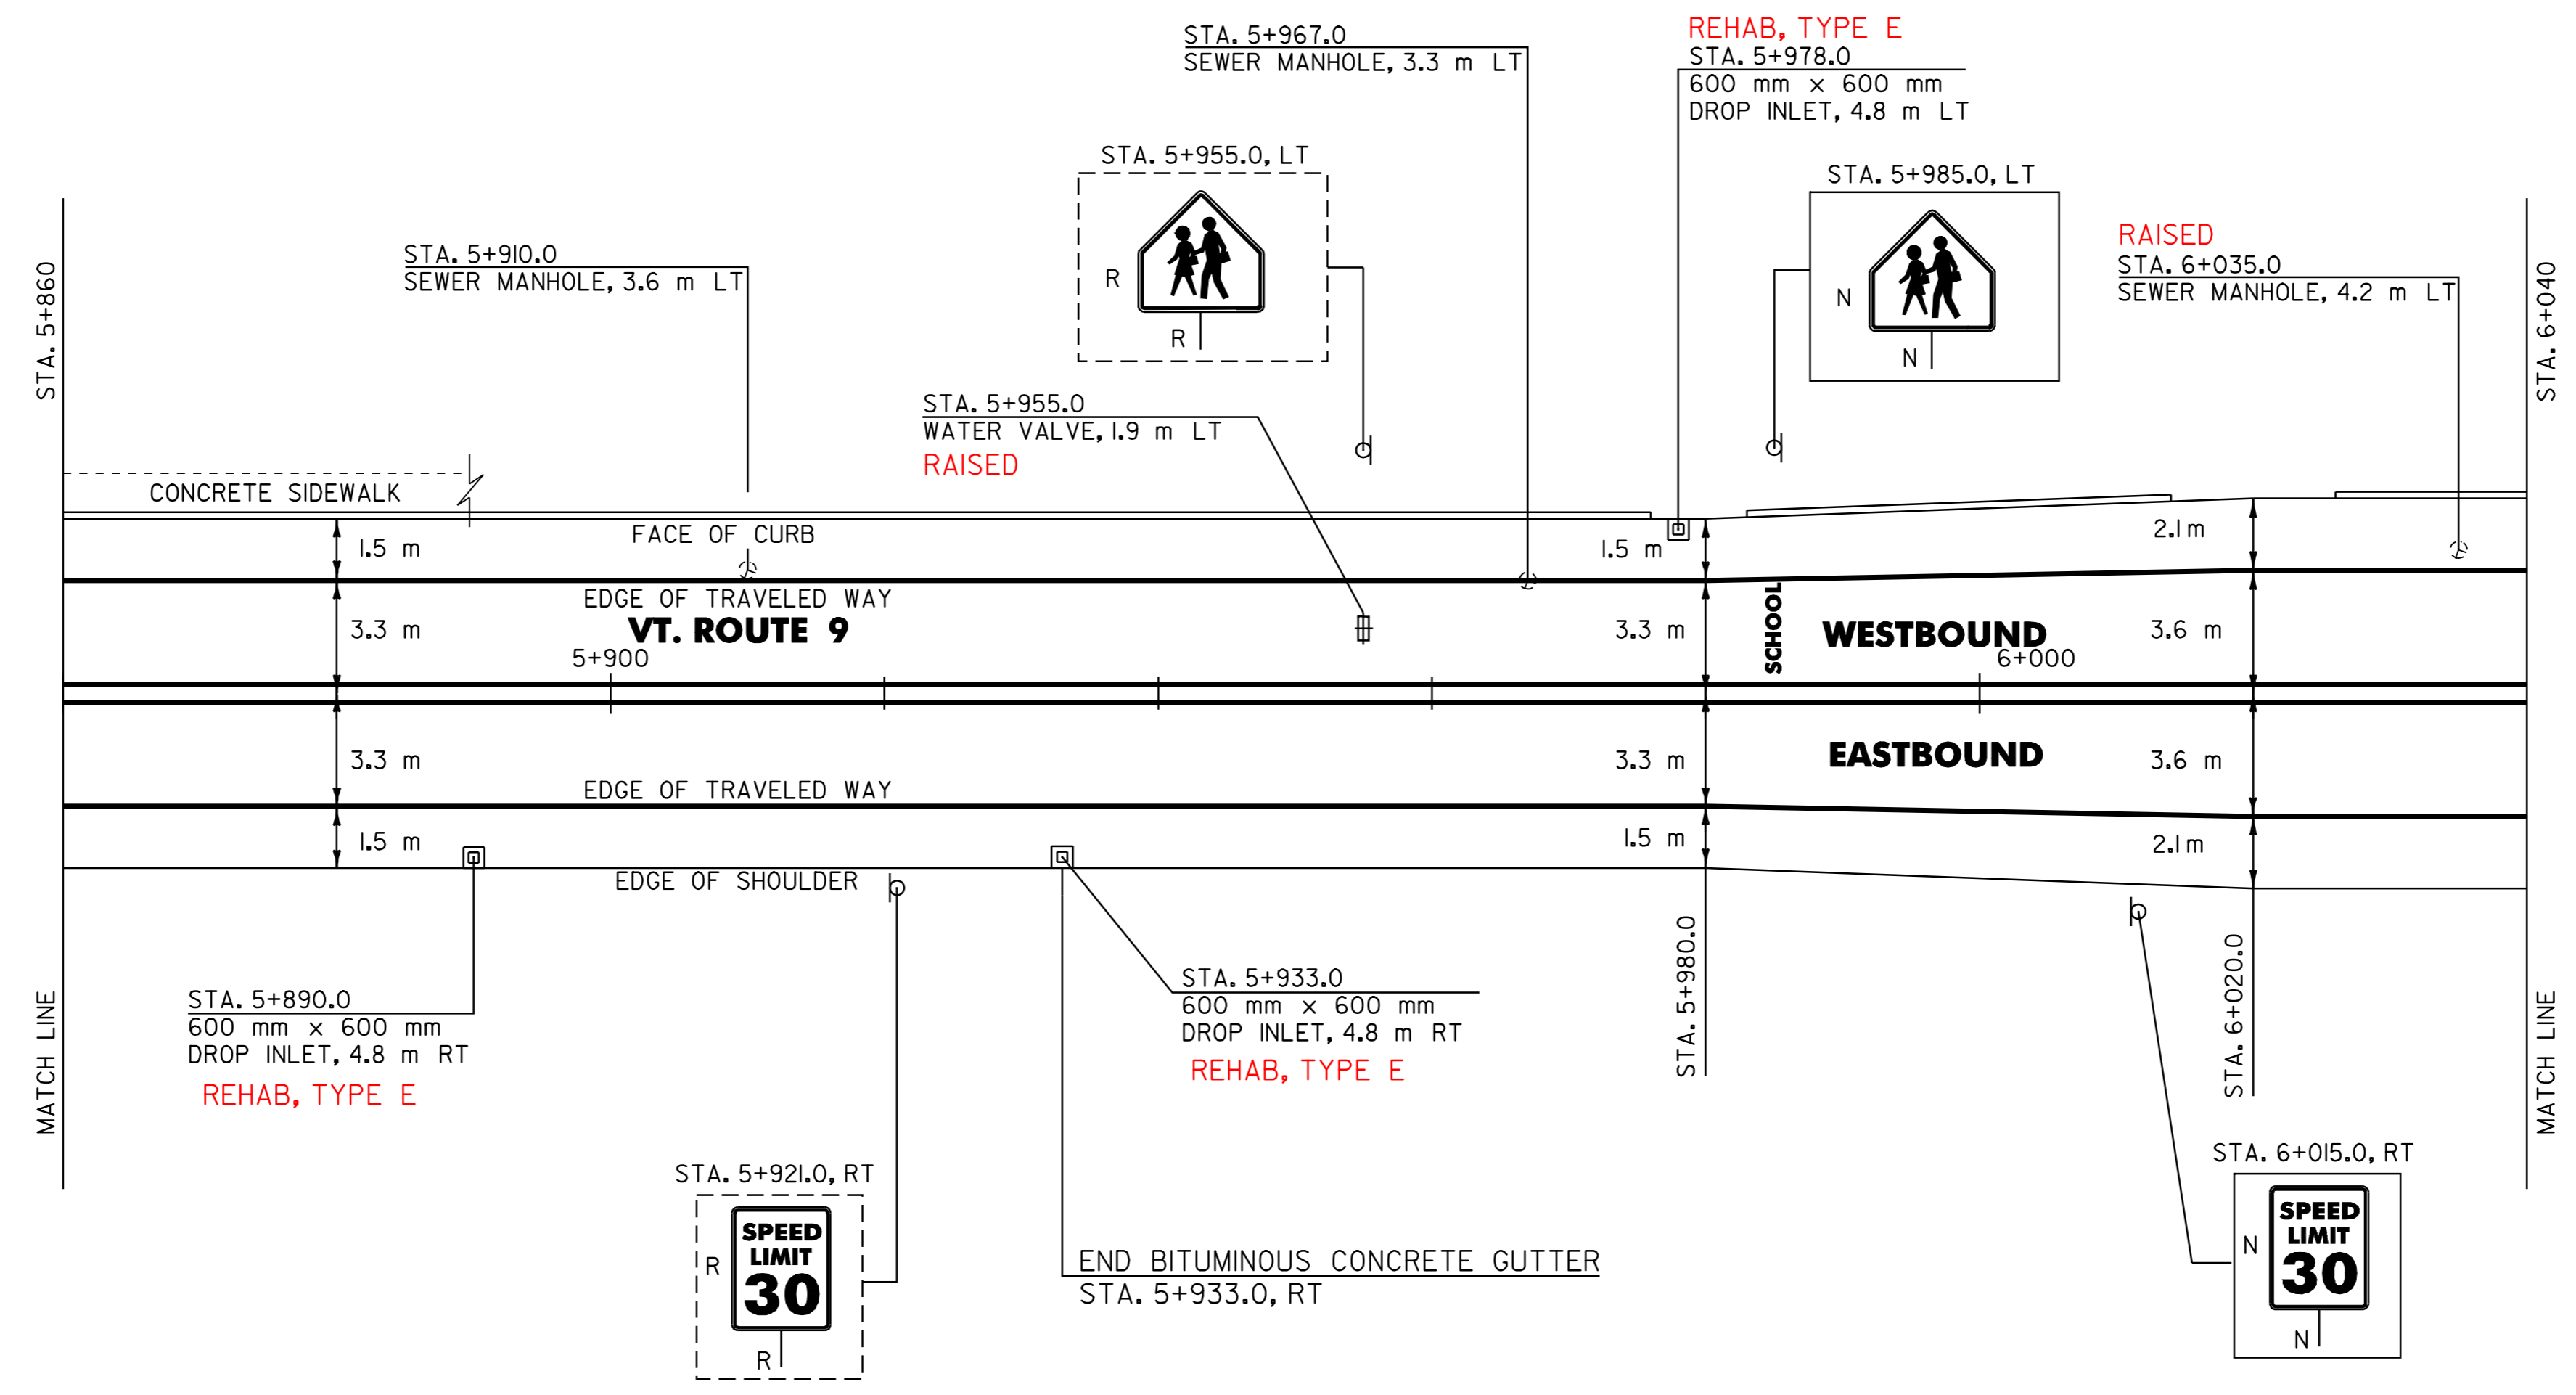

604.412 REHABILITATION OF DI, CB OR MH, CLASS I
~~604.40 CHANGE ELEVATION OF DI, CB OR MH~~
 VT. ROUTE 9:
 STA. 5+890.0 RT
 STA. 5+978.0 LT

629.20 ADJUST ELEVATION OF VALVE BOX
 VT. ROUTE 9:
 STA. 5+955.0 LT

604.412 REHABILITATION OF DI, CB OR MH, CLASS I
 VT. ROUTE 9:
 STA. 5+933.0 RT

616.47 BITUMINOUS CONCRETE GUTTERS & TRAFFIC ISLANDS
 VT. ROUTE 9:
 STA. 5+860.0 - 5+933.0 RT (5.0 +)

604.42 CHANGE ELEVATION OF SEWER MANHOLE
 VT. ROUTE 9:
 STA. 5+910.0 LT
 STA. 5+967.0 LT
 STA. 6+035.0 LT

DATUM	
VERTICAL	N/A
HORIZONTAL	N/A

SIGN LEGEND
 R= REMOVE
 S= SALVAGE
 N= NEW
 RET= RETAIN
 B-B= BACK TO BACK
 EXISTING= - - - - -
 NEW= _____

PAVING PROJECT LAYOUT # 5

SURVEYED BY	N/A	DATE	N/A
DRAWN BY	J.A.R.	DATE	4/01
SQUAD LEADER	T.P.K.		
DESIGN FILE NO.	pave/99d156/pd156.dgn		
IPARM FILE	pd156105.i	DATE PLOTTED	NOV-2005 10:21 AM
PROJ. NAME	BENNINGTON		
PROJ. NO.	NH 2202(1)S		
SHEET 18 OF 108	SHEETS		

646.40 DURABLE 100 mm WHITE LINE
(ALL LINES WILL INCLUDE EDGE LINE BREAKS AND RADIUS FOR TOWN HIGHWAYS)
VT. ROUTE 9:
STA. 6+040.0 - STA. 6+200.0 LT & RT

646.60 TEMPORARY 100 mm WHITE LINE
(ALL LINES WILL INCLUDE EDGE LINE BREAKS AND RADIUS FOR TOWN HIGHWAYS)
VT. ROUTE 9:
STA. 6+040.0 - STA. 6+200.0 LT & RT

646.41 DURABLE 100 mm YELLOW LINE
(ALL LINES WILL INCLUDE C/L BREAKS FOR TOWN HIGHWAYS) S=SOLID, D=DASHED
VT. ROUTE 9:
STA. 6+040.0 - STA. 6+200.0 LT S Q RT S
STA. 6+186.318 DOUBLE SOLID LT, T-320

646.61 TEMPORARY 100 mm YELLOW LINE
(ALL LINES WILL INCLUDE C/L BREAKS FOR TOWN HIGHWAYS) S=SOLID, D=DASHED
VT. ROUTE 9:
STA. 6+040.0 - STA. 6+200.0 LT S Q RT S
STA. 6+186.318 DOUBLE SOLID LT, T-320

646.46 DURABLE 600 mm STOP BAR (TYPE ITAPE)
VT. ROUTE 9:
STA. 6+186.318 LT, T-320

646.66 TEMPORARY 600 mm STOP BAR
VT. ROUTE 9:
STA. 6+186.318 LT, T-320

646.50 DURABLE LETTER OR SYMBOL (TYPE ITAPE)
VT. ROUTE 9:
STA. 6+186.318 LT, T-320, "S,T,O,P" (4 EA)

646.70 TEMPORARY LETTER OR SYMBOL
VT. ROUTE 9:
STA. 6+186.318 LT, T-320, "S,T,O,P" (8 EA)

646.51 DURABLE CROSSWALK MARKINGS WITH DIAGONAL LINES (MOD.2)
VT. ROUTE 9:
STA. 6+186.318 LT, T-320


646.71 TEMPORARY CROSSWALK MARKINGS WITH DIAGONAL LINES
VT. ROUTE 9:
STA. 6+186.318 LT, T-320

675.50 REMOVING SIGNS
AS SHOWN - 8

675.60 ERECTING SALVAGED SIGNS
AS SHOWN - 1

ITEM 618.30 DETECTABLE WARNING SURFACE
MOD TRUNCATED DOME SURFACE APPLIED
STA. 6+182 LT .929M2

ITEM 618.30 DETECTABLE WARNING SURFACE
MOD TRUNCATED DOME CAST IN PLACE
STA. 6+191 LT .743M2

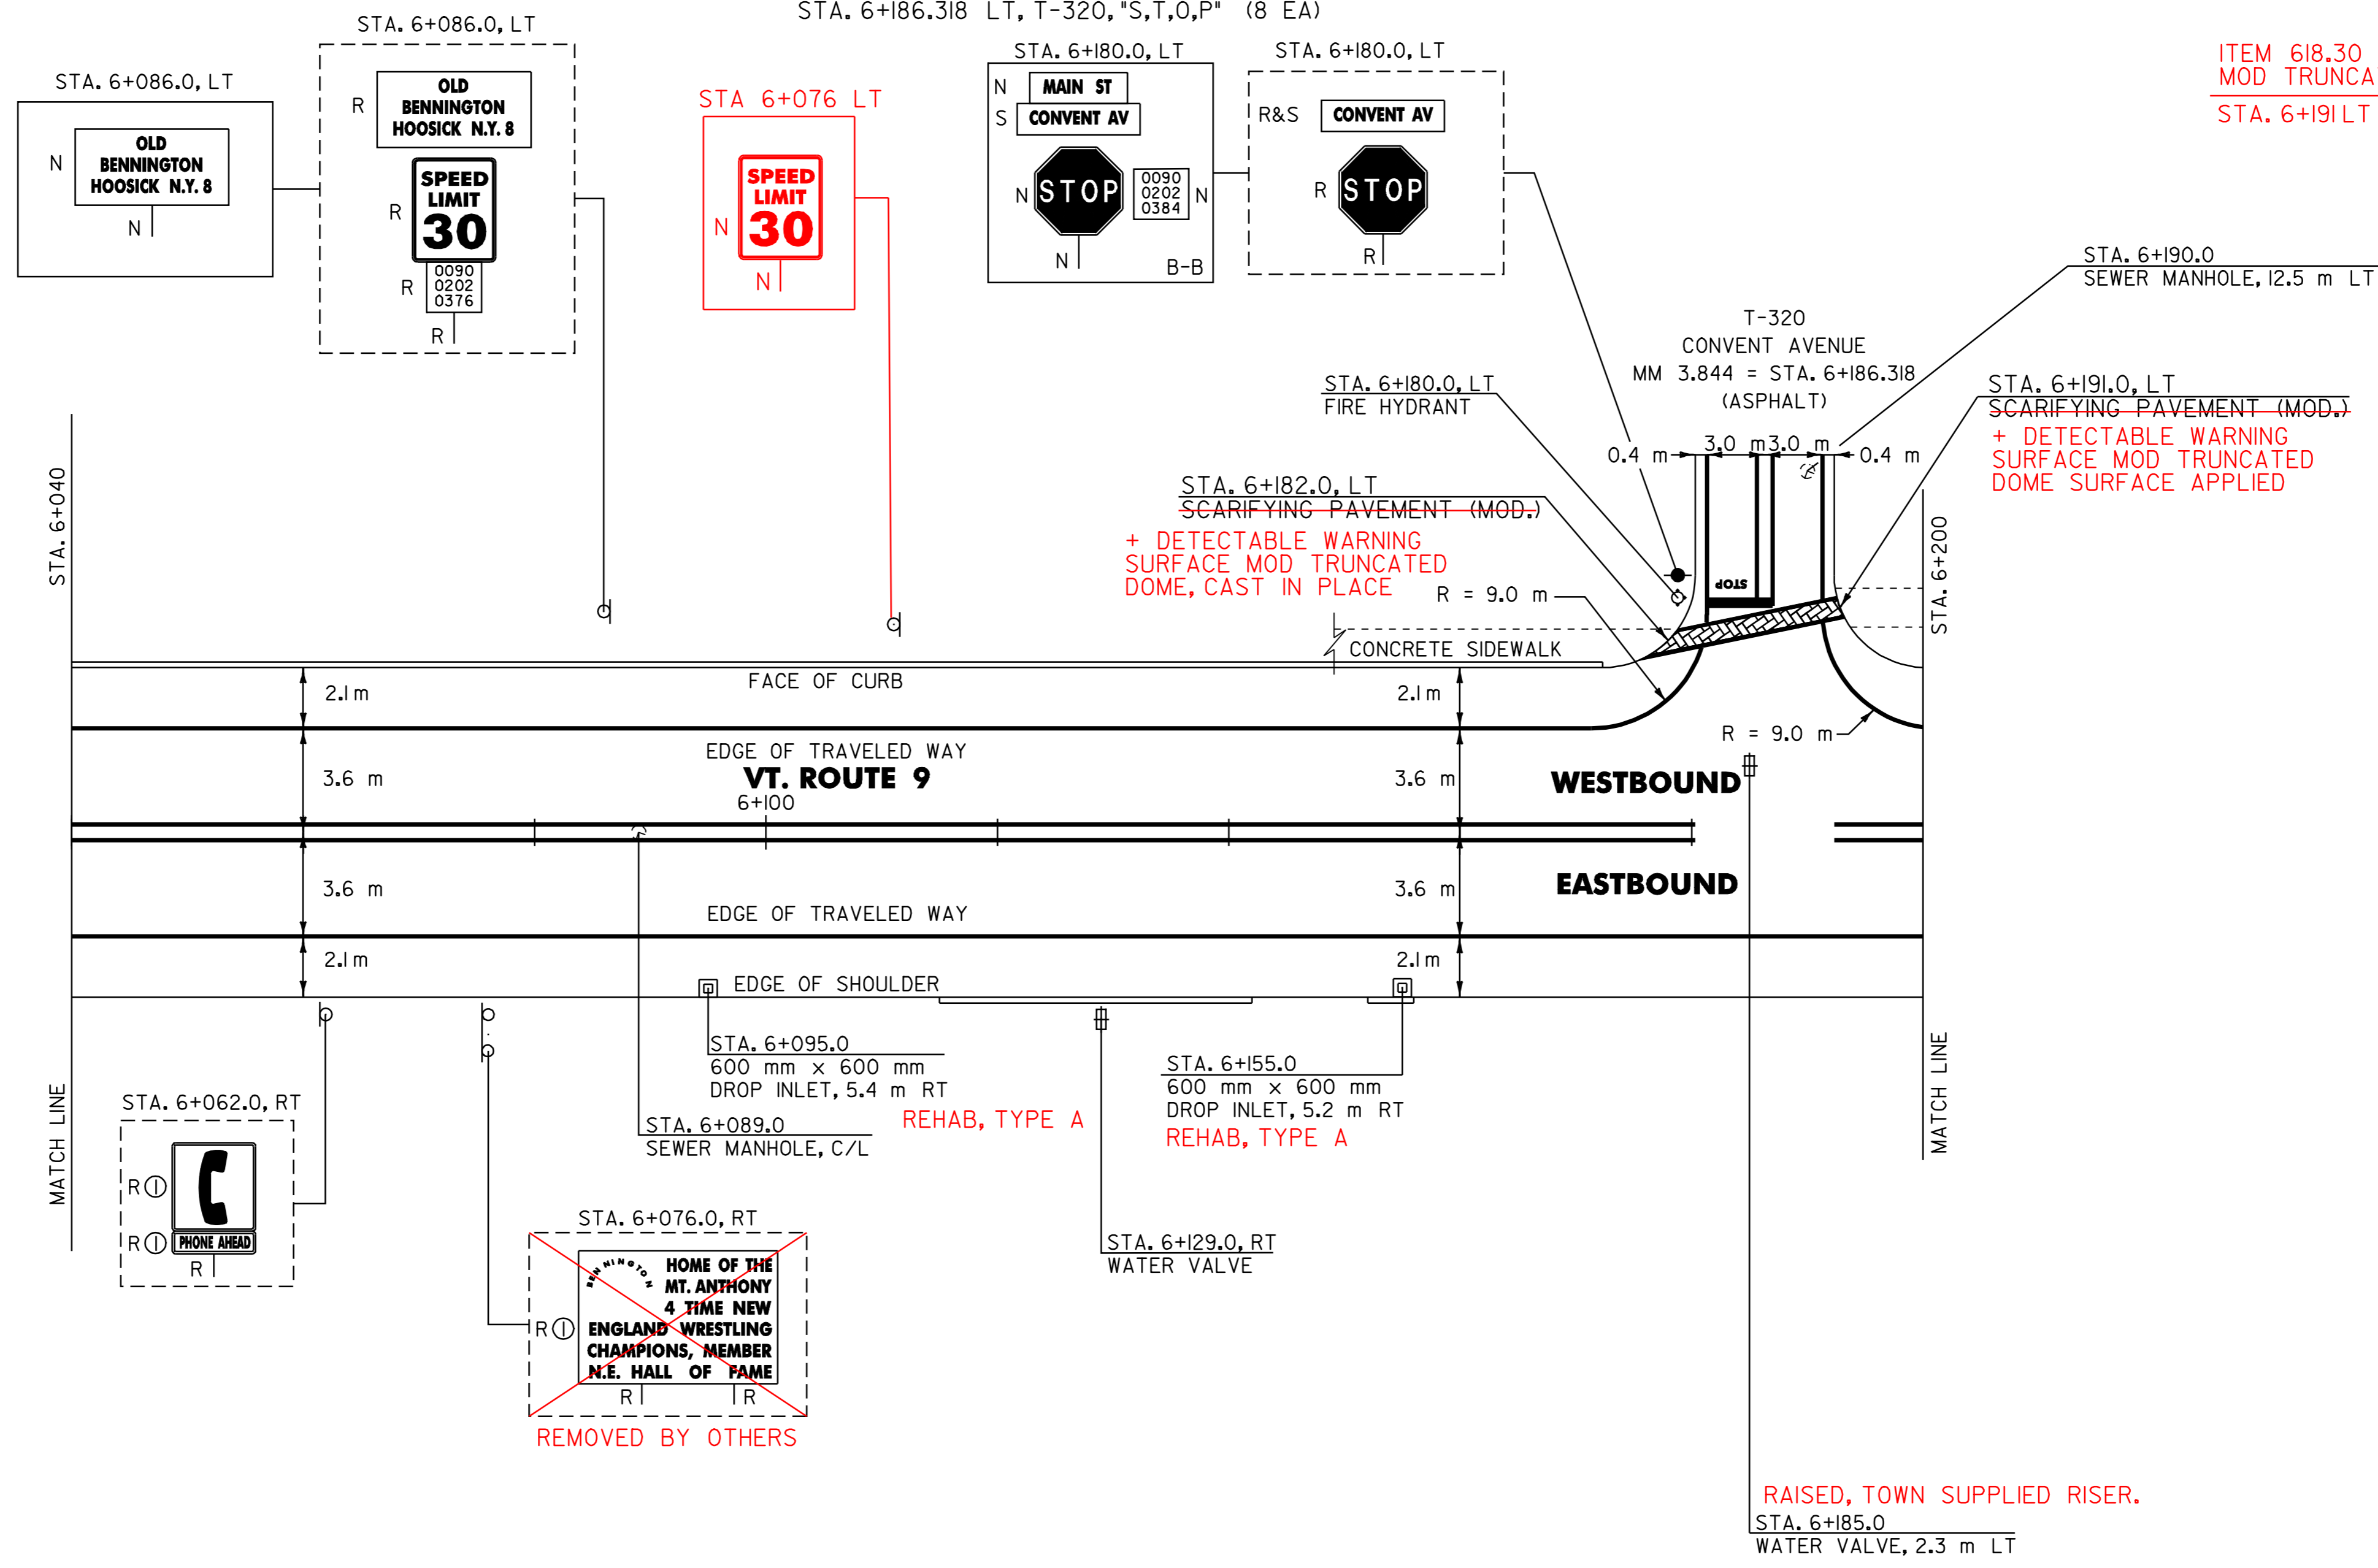

REPLACED WITH 618.30 DET. WARN. SURFACE
~~212.20 SCARIFYING PAVEMENT (MOD.)~~

VT. ROUTE 9:
~~STA. 6+182.0 LT (5 m²)~~
~~STA. 6+191.0 LT (5 m²)~~

~~604.40 CHANGE ELEVATION OF DI, CB OR MH~~

VT. ROUTE 9:
~~STA. 6+155.0 RT~~

604.412 REHABILITATION OF DI, CB OR MH, CLASS 1

VT. ROUTE 9: STA. 6+095.0 RT
VT. ROUTE 9: STA. 6+155.0 RT 4 X 6 2 GRATES

604.42 CHANGE ELEVATION OF SEWER MANHOLE

VT. ROUTE 9:
STA. 6+089.0 C/L
STA. 6+190.0 LT

629.20 ADJUST ELEVATION OF VALVE BOX

VT. ROUTE 9:
STA. 6+185.0 LT

SIGN LEGEND

- R= REMOVE
 - S= SALVAGE
 - N= NEW
 - RET= RETAIN
 - B-B= BACK TO BACK
 - EXISTING= -----
 - NEW= _____
- ① SIGN TO BE RETURNED TO THE TOWN OF BENNINGTON

NOTE:
1. PAVING LIMIT ON ALL TOWN HIGHWAYS SHALL BE MEASURED 8 m BACK FROM VT. ROUTE 9 EDGE OF SHOULDER UNLESS DENOTED OTHERWISE ON THE PLANS OR AS DIRECTED BY THE RESIDENT ENGINEER.

PAVING PROJECT LAYOUT # 6

SURVEYED BY	N/A	DATE	N/A
DRAWN BY	J.A.R.	DATE	4/01
SQUAD LEADER	T.P.K.		
DESIGN FILE NO.	pave/99d156/pd156.dgn		
IPARM FILE	pd156106.i	DATE	NOV-2005 10
PROJ. NAME	BENNINGTON		
PROJ. NO.	NH 2202(1)S		
SHEET	19 OF 108	SHEETS	

DATUM	
VERTICAL	N/A
HORIZONTAL	N/A

646.40 DURABLE 100 mm WHITE LINE
 (ALL LINES WILL INCLUDE EDGE LINE BREAKS AND RADIUS FOR TOWN HIGHWAYS)
 VT. ROUTE 9:
 STA. 6+200.0 - STA. 6+400.0 LT & RT

646.60 TEMPORARY 100 mm WHITE LINE
 (ALL LINES WILL INCLUDE EDGE LINE BREAKS AND RADIUS FOR TOWN HIGHWAYS)
 VT. ROUTE 9:
 STA. 6+200.0 - STA. 6+400.0 LT & RT

646.41 DURABLE 100 mm YELLOW LINE
 (ALL LINES WILL INCLUDE C/L BREAKS FOR TOWN HIGHWAYS) S=SOLID, D=DASHED
 LT C RT
 S - S

VT. ROUTE 9:
 STA. 6+200.0 - STA. 6+400.0
 STA. 6+226.552 DOUBLE SOLID RT, T-394
 STA. 6+373.002 DOUBLE SOLID LT, T-324

646.61 TEMPORARY 100 mm YELLOW LINE
 (ALL LINES WILL INCLUDE C/L BREAKS FOR TOWN HIGHWAYS) S=SOLID, D=DASHED
 LT C RT
 S - S

VT. ROUTE 9:
 STA. 6+200.0 - STA. 6+400.0
 STA. 6+226.552 DOUBLE SOLID RT, T-394
 STA. 6+373.002 DOUBLE SOLID LT, T-324

646.46 DURABLE 600 mm STOP BAR (TYPE ITAPE)
 VT. ROUTE 9:
 STA. 6+226.552 RT, T-394
 STA. 6+373.002 LT, T-324
 STA. 6+324.7 RT

646.66 TEMPORARY 600 mm STOP BAR
 VT. ROUTE 9:
 STA. 6+226.552 RT, T-394
 STA. 6+373.002 LT, T-324
 STA. 6+324.7 RT

646.50 DURABLE LETTER OR SYMBOL (TYPE ITAPE)
 VT. ROUTE 9:
 STA. 6+226.552 RT, T-394 "S,T,O,P" (4 EA)
 STA. 6+373.002 LT, T-324 "S,T,O,P" (4 EA)
 STA. 6+324.7 RT T-396 "STOP" 4 EA

646.51 DURABLE CROSSWALK MARKINGS WITH DIAGONAL LINES (MOD.2)
 VT. ROUTE 9:
 STA. 6+373.002 LT, T-324


646.71 TEMPORARY CROSSWALK MARKINGS WITH DIAGONAL LINES
 VT. ROUTE 9:
 STA. 6+373.002 LT, T-324

675.50 REMOVING SIGNS
 AS SHOWN - 13

675.60 ERECTING SALVAGED SIGNS
 AS SHOWN - 4

646.42 DURABLE 200 mm WHITE LINE
 STA. 6+363.2 - STA. 6+366.8 LT, SHOULDER HATCHING (16.7 m)

646.70 TEMPORARY LETTER OR SYMBOL
 VT. ROUTE 9:
 STA. 6+226.552 RT, T-394 "S,T,O,P" (8 EA)
 STA. 6+373.002 LT, T-324 "S,T,O,P" (8 EA)

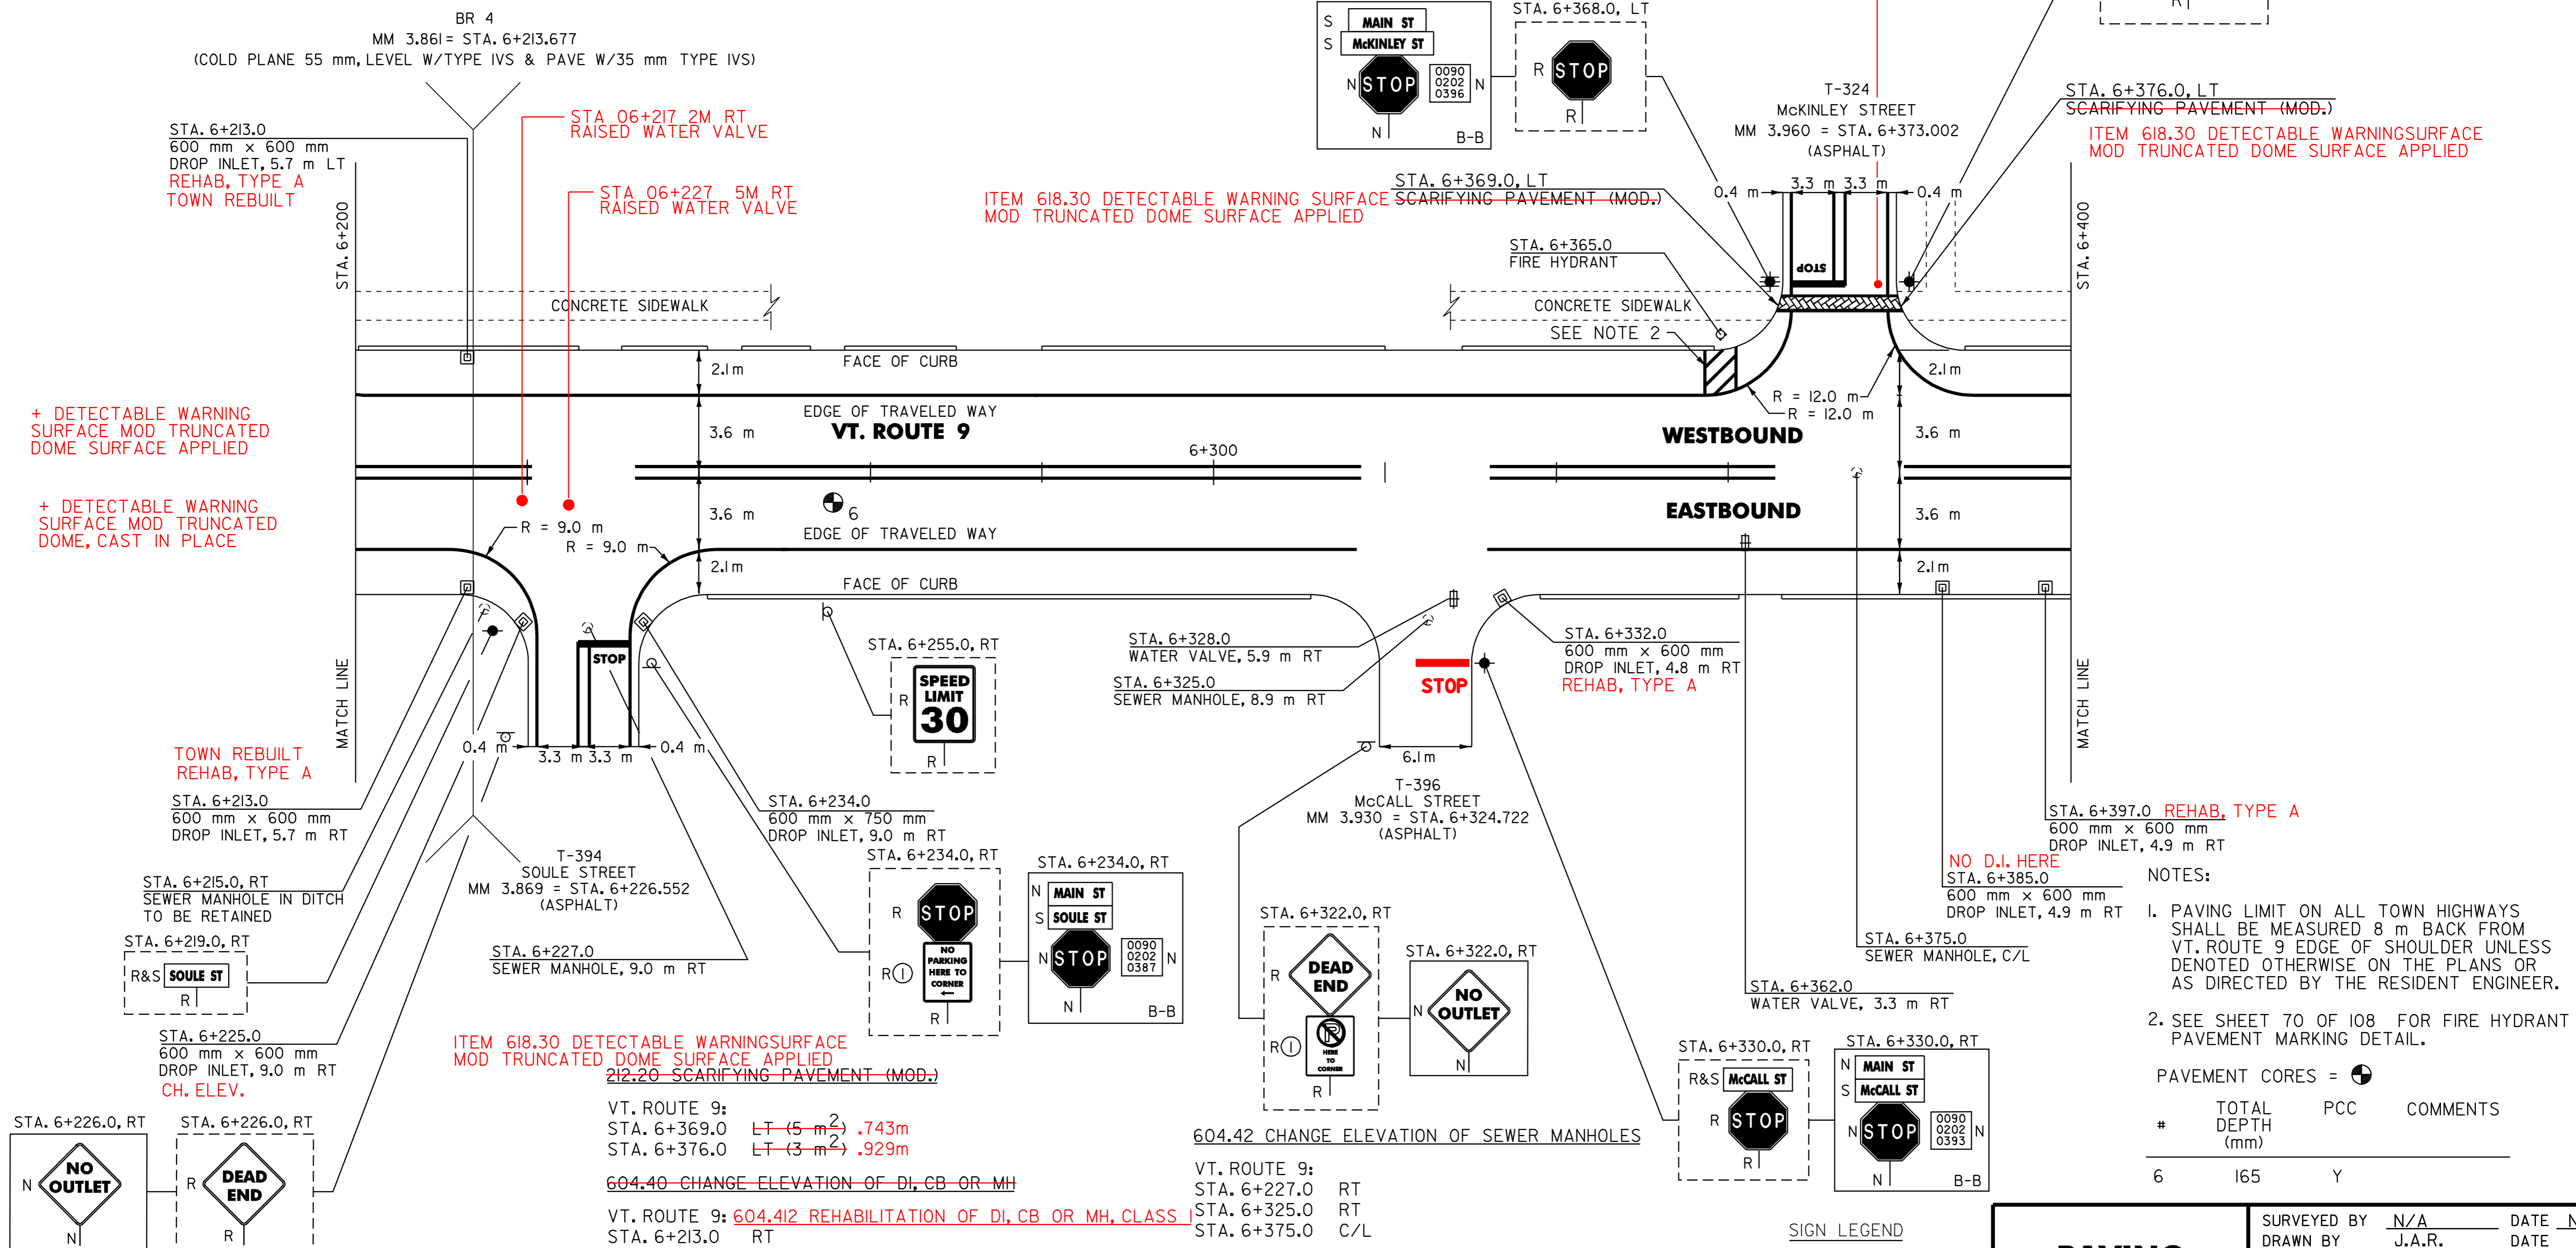

+ DETECTABLE WARNING SURFACE MOD TRUNCATED DOME SURFACE APPLIED

+ DETECTABLE WARNING SURFACE MOD TRUNCATED DOME, CAST IN PLACE

ITEM 618.30 DETECTABLE WARNING SURFACE MOD TRUNCATED DOME SURFACE APPLIED

ITEM 618.30 DETECTABLE WARNING SURFACE MOD TRUNCATED DOME SURFACE APPLIED

- NOTES:
- PAVING LIMIT ON ALL TOWN HIGHWAYS SHALL BE MEASURED 8 m BACK FROM VT. ROUTE 9 EDGE OF SHOULDER UNLESS DENOTED OTHERWISE ON THE PLANS OR AS DIRECTED BY THE RESIDENT ENGINEER.
 - SEE SHEET 70 OF 108 FOR FIRE HYDRANT PAVEMENT MARKING DETAIL.

#	TOTAL DEPTH (mm)	PCC	COMMENTS
6	165	Y	

DATUM

VERTICAL	N/A
HORIZONTAL	N/A

604.42 CHANGE ELEVATION OF SEWER MANHOLES
 VT. ROUTE 9:
 STA. 6+227.0 RT
 STA. 6+325.0 RT
 STA. 6+375.0 C/L

619.17 YIELDING MARKER POST
 VT. ROUTE 9:
 STA. 6+213.677 LT & RT

629.20 ADJUST ELEVATION OF VALVE BOX
 VT. ROUTE 9:
 STA. 6+328.0 RT
 STA. 6+362.0 RT

SIGN LEGEND

R= REMOVE
 S= SALVAGE
 N= NEW
 RET= RETAIN
 B-B= BACK TO BACK
 EXISTING= -----
 NEW= -----

Ⓢ SIGN TO BE RETURNED TO THE TOWN OF BENNINGTON

PAVING PROJECT LAYOUT # 7

SURVEYED BY N/A DATE N/A
 DRAWN BY J.A.R. DATE 4/01
 SQUAD LEADER T.P.K.
 DESIGN FILE NO. pave/99dl56/pdl56.dgn
 IPARM FILE pdl56i07.i DATE NOV-2005 10
 PROJ. NAME BENNINGTON
 PROJ. NO. NH 2202(1)S
 SHEET 20 OF 108 SHEETS

646.40 DURABLE 100 mm WHITE LINE
(ALL LINES WILL INCLUDE EDGE LINE BREAKS AND RADIUS FOR TOWN HIGHWAYS)

VT. ROUTE 9:
STA. 6+400.0 - STA. 6+580.0 LT & RT

646.60 TEMPORARY 100 mm WHITE LINE
(ALL LINES WILL INCLUDE EDGE LINE BREAKS AND RADIUS FOR TOWN HIGHWAYS)

VT. ROUTE 9:
STA. 6+400.0 - STA. 6+580.0 LT & RT

646.41 DURABLE 100 mm YELLOW LINE
(ALL LINES WILL INCLUDE C/L BREAKS FOR TOWN HIGHWAYS) S=SOLID, D=DASHED

VT. ROUTE 9:
STA. 6+400.0 - STA. 6+565.0 S - S
STA. 6+565.0 - STA. 6+580.0 DOUBLE SOLID RT & LT (MEDIAN TAPER)
STA. 6+522.671 DOUBLE SOLID RT, T-398

646.61 TEMPORARY 100 mm YELLOW LINE
(ALL LINES WILL INCLUDE C/L BREAKS FOR TOWN HIGHWAYS) S=SOLID, D=DASHED

VT. ROUTE 9:
STA. 6+400.0 - STA. 6+565.0 S - S
STA. 6+565.0 - STA. 6+580.0 DOUBLE SOLID RT & LT (MEDIAN TAPER)
STA. 6+522.671 DOUBLE SOLID RT, T-398

646.43 DURABLE 200 mm YELLOW LINE
VT. ROUTE 9:
STA. 6+565.0 - STA. 6+580.0 C/L, HATCHED MEDIAN (15 m)

646.46 DURABLE 600 mm STOP BAR (TYPE I TAPE)
VT. ROUTE 9:
STA. 6+522.671 RT, T-398


646.66 TEMPORARY 600 mm STOP BAR
VT. ROUTE 9:
STA. 6+522.671 RT, T-398

646.50 DURABLE LETTER OR SYMBOL (TYPE I TAPE)
VT. ROUTE 9:
STA. 6+522.671 RT, T-398, "S,T,O,P" (4 EA)

646.70 TEMPORARY LETTER OR SYMBOL
VT. ROUTE 9:
STA. 6+522.671 RT, T-398, "S,T,O,P" (8 EA)

675.50 REMOVING SIGNS
AS SHOWN - 10

675.60 ERECTING SALVAGED SIGNS
AS SHOWN - 1

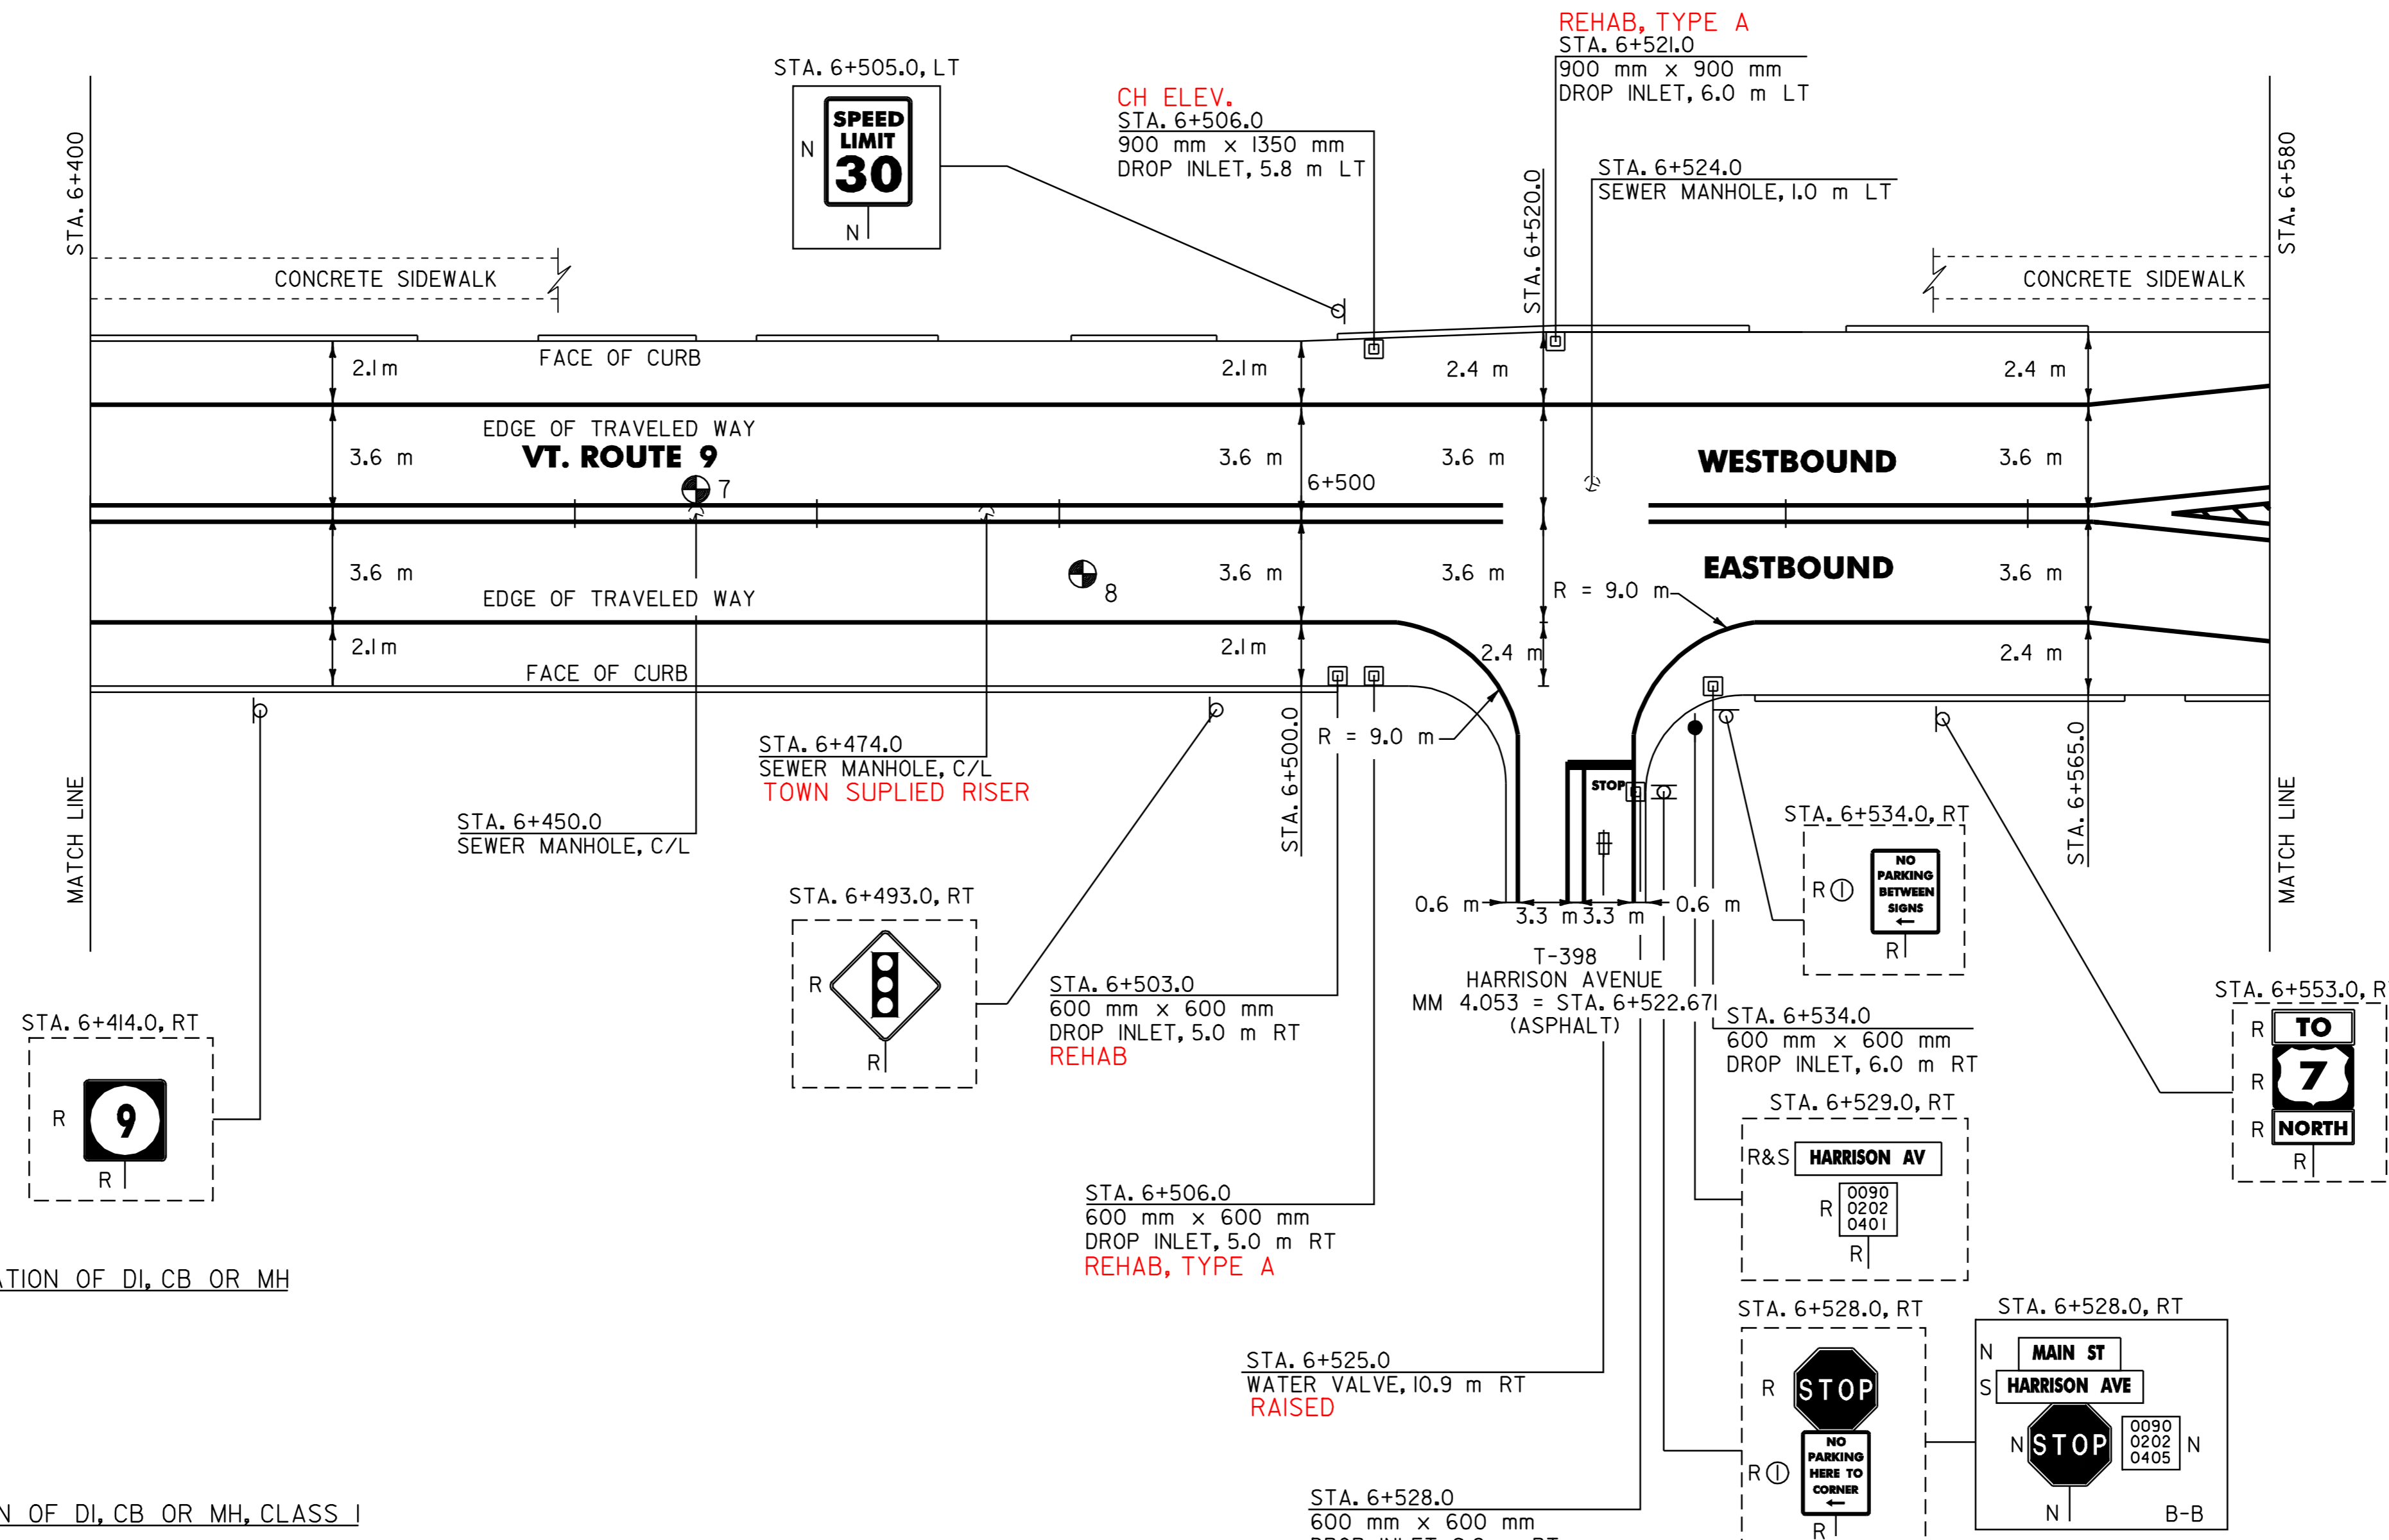

604.40 CHANGE ELEVATION OF DI, CB OR MH

VT. ROUTE 9:
~~STA. 6+503.0 RT~~
~~STA. 6+506.0 RT LT~~
~~STA. 6+528.0 RT~~
~~STA. 6+534.0 RT~~

604.412 REHABILITATION OF DI, CB OR MH, CLASS I

VT. ROUTE 9:
~~STA. 6+506.0 LT~~ STA. 6+503.0 RT
~~STA. 6+521.0 LT~~ STA. 6+506.0 RT
STA. 6+528.0 RT 3'-6" W/2 GRATES

604.42 CHANGE ELEVATION OF SEWER MANHOLE

VT. ROUTE 9:
STA. 6+450.0 C/L
STA. 6+474.0 C/L
STA. 6+524.0 LT RT

629.20 ADJUST ELEVATION OF VALVE BOX

VT. ROUTE 9:
STA. 6+525.0 RT

NOTE:

I. PAVING LIMIT ON ALL TOWN HIGHWAYS SHALL BE MEASURED 8 m BACK FROM VT. ROUTE 9 EDGE OF SHOULDER UNLESS DENOTED OTHERWISE ON THE PLANS OR AS DIRECTED BY THE RESIDENT ENGINEER.

PAVEMENT CORES =

#	TOTAL DEPTH (mm)	PCC	COMMENTS
7	100	Y	
8	140	Y	

SIGN LEGEND
R= REMOVE
S= SALVAGE
N= NEW
RET= RETAIN
B-B= BACK TO BACK
EXISTING= -----
NEW= _____

Ⓢ SIGN TO BE RETURNED TO THE TOWN OF BENNINGTON

PAVING PROJECT LAYOUT # 8

SURVEYED BY N/A DATE N/A
DRAWN BY J.A.R. DATE 4/01
SQUAD LEADER T.P.K.
DESIGN FILE NO. pave/99dl56/pdl56.dgn
IPARM pdl56108.i DATE NOV-2005 10:
FILE PL0721
PROJ. NAME BENNINGTON
PROJ. NO. NH 2202(I)S
SHEET 21 OF 108 SHEETS

DATUM


VERTICAL	<u>N/A</u>
HORIZONTAL	<u>N/A</u>

646.40 DURABLE 100 mm WHITE LINE
 (ALL LINES WILL INCLUDE EDGE LINE BREAKS AND RADIUS FOR TOWN HIGHWAYS)
 VT. ROUTE 9:
 STA. 6+580.0 - STA. 6+760.0 LT & RT
 STA. 6+595.092 LT, T-7
 STA. 6+630.497 LT, T-7

646.60 TEMPORARY 100 mm WHITE LINE
 (ALL LINES WILL INCLUDE EDGE LINE BREAKS AND RADIUS FOR TOWN HIGHWAYS)
 VT. ROUTE 9:
 STA. 6+580.0 - STA. 6+760.0 LT & RT
 STA. 6+595.092 LT, T-7
 STA. 6+630.497 LT, T-7

646.41 DURABLE 100 mm YELLOW LINE
 (ALL LINES WILL INCLUDE C/L BREAKS FOR TOWN HIGHWAYS) S=SOLID, D=DASHED
 VT. ROUTE 9:
 STA. 6+680.0 - STA. 6+760.0 S
 STA. 6+580.0 - STA. 6+611.5 S
 STA. 6+652.8 - STA. 6+680.0 S
 STA. 6+630.497 DOUBLE SOLID LT, T-7 (MEDIAN TAPER)
 STA. 6+633.716 DOUBLE SOLID RT, T-404
 STA. 6+622.0, LT

646.61 TEMPORARY 100 mm YELLOW LINE
 (ALL LINES WILL INCLUDE C/L BREAKS FOR TOWN HIGHWAYS) S=SOLID, D=DASHED
 VT. ROUTE 9:
 STA. 6+680.0 - STA. 6+760.0 S
 STA. 6+580.0 - STA. 6+611.5 S
 STA. 6+652.8 - STA. 6+680.0 S
 STA. 6+630.497 DOUBLE SOLID LT, T-7 (MEDIAN TAPER)
 STA. 6+633.716 DOUBLE SOLID RT, T-404
 STA. 6+622.0, LT

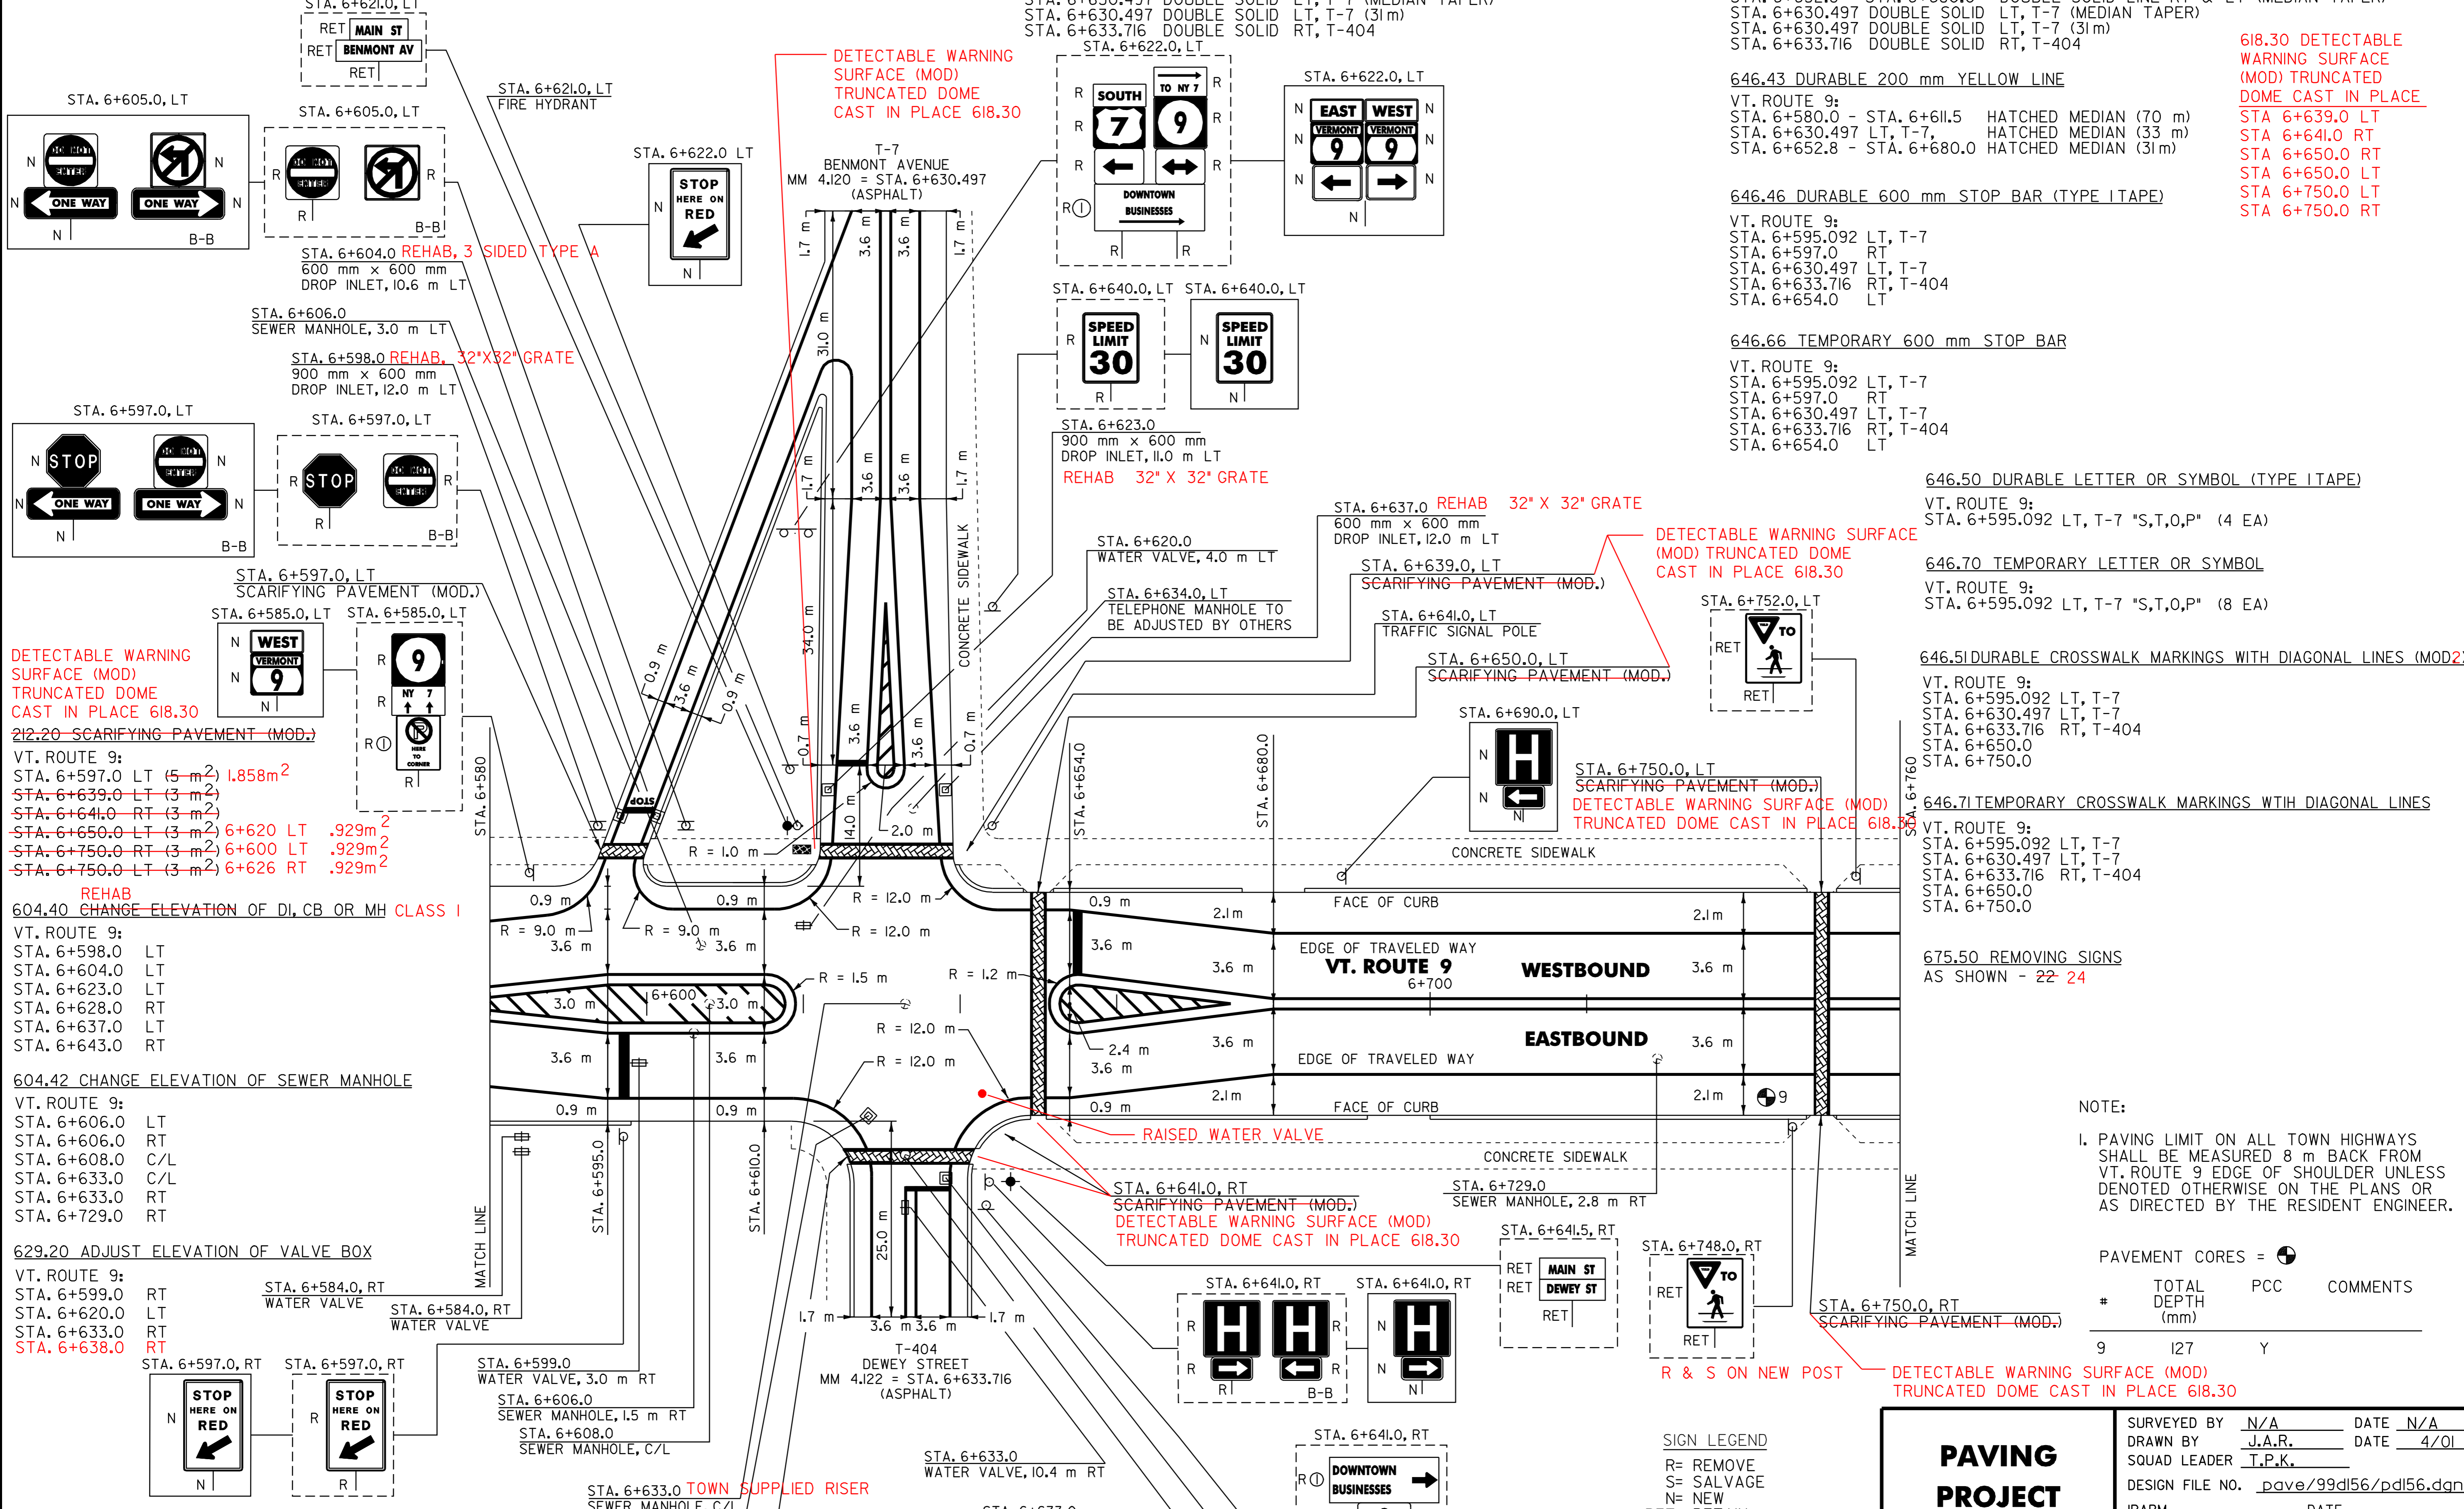

DETECTABLE WARNING SURFACE (MOD) TRUNCATED DOME CAST IN PLACE 618.30
~~212.20 SCARIFYING PAVEMENT (MOD.)~~
 VT. ROUTE 9:
 STA. 6+597.0 LT (5 m²) 1.858m²
 STA. 6+639.0 LT (3 m²)
 STA. 6+641.0 RT (3 m²)
 STA. 6+650.0 LT (3 m²) 6+620 LT .929m²
 STA. 6+750.0 RT (3 m²) 6+600 LT .929m²
 STA. 6+750.0 LT (3 m²) 6+626 RT .929m²

604.40 REHAB CHANGE ELEVATION OF DI, CB OR MH CLASS I
 VT. ROUTE 9:
 STA. 6+598.0 LT
 STA. 6+604.0 LT
 STA. 6+623.0 LT
 STA. 6+628.0 RT
 STA. 6+637.0 LT
 STA. 6+643.0 RT

604.42 REHAB CHANGE ELEVATION OF SEWER MANHOLE
 VT. ROUTE 9:
 STA. 6+606.0 LT
 STA. 6+606.0 RT
 STA. 6+608.0 C/L
 STA. 6+633.0 C/L
 STA. 6+633.0 RT
 STA. 6+729.0 RT

629.20 REHAB ADJUST ELEVATION OF VALVE BOX
 VT. ROUTE 9:
 STA. 6+599.0 RT
 STA. 6+620.0 LT
 STA. 6+633.0 RT
 STA. 6+638.0 RT

DATUM

VERTICAL	N/A
HORIZONTAL	N/A

DETECTABLE WARNING SURFACE (MOD) TRUNCATED DOME CAST IN PLACE 618.30

646.63 DURABLE 100 mm WHITE LINE
 (ALL LINES WILL INCLUDE EDGE LINE BREAKS AND RADIUS FOR TOWN HIGHWAYS)
 VT. ROUTE 9:
 STA. 6+580.0 - STA. 6+611.5 HATCHED MEDIAN (70 m)
 STA. 6+630.497 LT, T-7, HATCHED MEDIAN (33 m)
 STA. 6+652.8 - STA. 6+680.0 HATCHED MEDIAN (31 m)

646.43 DURABLE 200 mm YELLOW LINE
 VT. ROUTE 9:
 STA. 6+595.092 LT, T-7
 STA. 6+597.0 RT
 STA. 6+630.497 LT, T-7
 STA. 6+633.716 RT, T-404
 STA. 6+654.0 LT

646.46 DURABLE 600 mm STOP BAR (TYPE ITAPE)
 VT. ROUTE 9:
 STA. 6+595.092 LT, T-7
 STA. 6+597.0 RT
 STA. 6+630.497 LT, T-7
 STA. 6+633.716 RT, T-404
 STA. 6+654.0 LT

646.66 TEMPORARY 600 mm STOP BAR
 VT. ROUTE 9:
 STA. 6+595.092 LT, T-7
 STA. 6+597.0 RT
 STA. 6+630.497 LT, T-7
 STA. 6+633.716 RT, T-404
 STA. 6+654.0 LT

646.50 DURABLE LETTER OR SYMBOL (TYPE ITAPE)
 VT. ROUTE 9:
 STA. 6+595.092 LT, T-7 "S,T,O,P" (4 EA)

646.70 TEMPORARY LETTER OR SYMBOL
 VT. ROUTE 9:
 STA. 6+595.092 LT, T-7 "S,T,O,P" (8 EA)

646.51 DURABLE CROSSWALK MARKINGS WITH DIAGONAL LINES (MOD 2)
 VT. ROUTE 9:
 STA. 6+595.092 LT, T-7
 STA. 6+630.497 LT, T-7
 STA. 6+633.716 RT, T-404
 STA. 6+650.0
 STA. 6+750.0

646.71 TEMPORARY CROSSWALK MARKINGS WITH DIAGONAL LINES
 VT. ROUTE 9:
 STA. 6+595.092 LT, T-7
 STA. 6+630.497 LT, T-7
 STA. 6+633.716 RT, T-404
 STA. 6+650.0
 STA. 6+750.0

675.50 REMOVING SIGNS AS SHOWN - 22-24

NOTE:
 1. PAVING LIMIT ON ALL TOWN HIGHWAYS SHALL BE MEASURED 8 m BACK FROM VT. ROUTE 9 EDGE OF SHOULDER UNLESS DENOTED OTHERWISE ON THE PLANS OR AS DIRECTED BY THE RESIDENT ENGINEER.

PAVEMENT CORES =

#	TOTAL DEPTH (mm)	PCC	COMMENTS
9	127	Y	

PAVING PROJECT LAYOUT # 9

NOTE:
 R = REMOVE
 S = SALVAGE
 N = NEW
 RET = RETAIN
 B-B = BACK TO BACK
 EXISTING = - - - - -
 NEW = _____

Ⓢ SIGN TO BE RETURNED TO THE TOWN OF BENNINGTON

SURVEYED BY	N/A	DATE	N/A
DRAWN BY	J.A.R.	DATE	4/01
SQUAD LEADER	T.P.K.		
DESIGN FILE NO.	_pave/99dl56/pdl56.dgn		
IPARM FILE	pdl56109.i	DATE	21 NOV-2005 10:
PROJ. NAME	BENNINGTON		
PROJ. NO.	NH 2202(1)S		
SHEET	22 OF 108	SHEETS	

646.40 DURABLE 100 mm WHITE LINE
(ALL LINES WILL INCLUDE EDGE LINE BREAKS AND RADIUS FOR TOWN HIGHWAYS)

VT. ROUTE 9:
STA. 6+760.0 - STA. 6+900.0 LT & RT

646.60 TEMPORARY 100 mm WHITE LINE
(ALL LINES WILL INCLUDE EDGE LINE BREAKS AND RADIUS FOR TOWN HIGHWAYS)

VT. ROUTE 9:
STA. 6+760.0 - STA. 6+900.0 LT & RT

646.41 DURABLE 100 mm YELLOW LINE
(ALL LINES WILL INCLUDE C/L BREAKS FOR TOWN HIGHWAYS) S=SOLID, D=DASHED

VT. ROUTE 9:
STA. 6+760.0 - STA. 6+900.0 LT S - RT S
STA. 6+833.275 DOUBLE SOLID RT, T-406

646.61 TEMPORARY 100 mm YELLOW LINE
(ALL LINES WILL INCLUDE C/L BREAKS FOR TOWN HIGHWAYS) S=SOLID, D=DASHED

VT. ROUTE 9:
STA. 6+760.0 - STA. 6+900.0 LT S - RT S
STA. 6+833.275 DOUBLE SOLID RT, T-406

646.46 DURABLE 600 mm STOP BAR (TYPE 1 TAPE)

VT. ROUTE 9:
STA. 6+833.275 RT, T-406

646.66 TEMPORARY 600 mm STOP BAR

VT. ROUTE 9:
STA. 6+833.275 RT, T-406

646.50 DURABLE LETTER OR SYMBOL (TYPE 1 TAPE)

VT. ROUTE 9:
STA. 6+833.275 RT, T-406, "S,T,O,P" (4 EA)

646.70 TEMPORARY LETTER OR SYMBOL

VT. ROUTE 9:
STA. 6+833.275 RT, T-406, "S,T,O,P" (8 EA)

646.51 DURABLE CROSSWALK MARKINGS WITH DIAGONAL LINES (MOD.2)


VT. ROUTE 9:
STA. 6+833.275 RT, T-406

646.71 TEMPORARY CROSSWALK MARKINGS WITH DIAGONAL LINES

VT. ROUTE 9:
STA. 6+833.275 RT, T-406

675.50 REMOVING SIGNS

AS SHOWN - 86

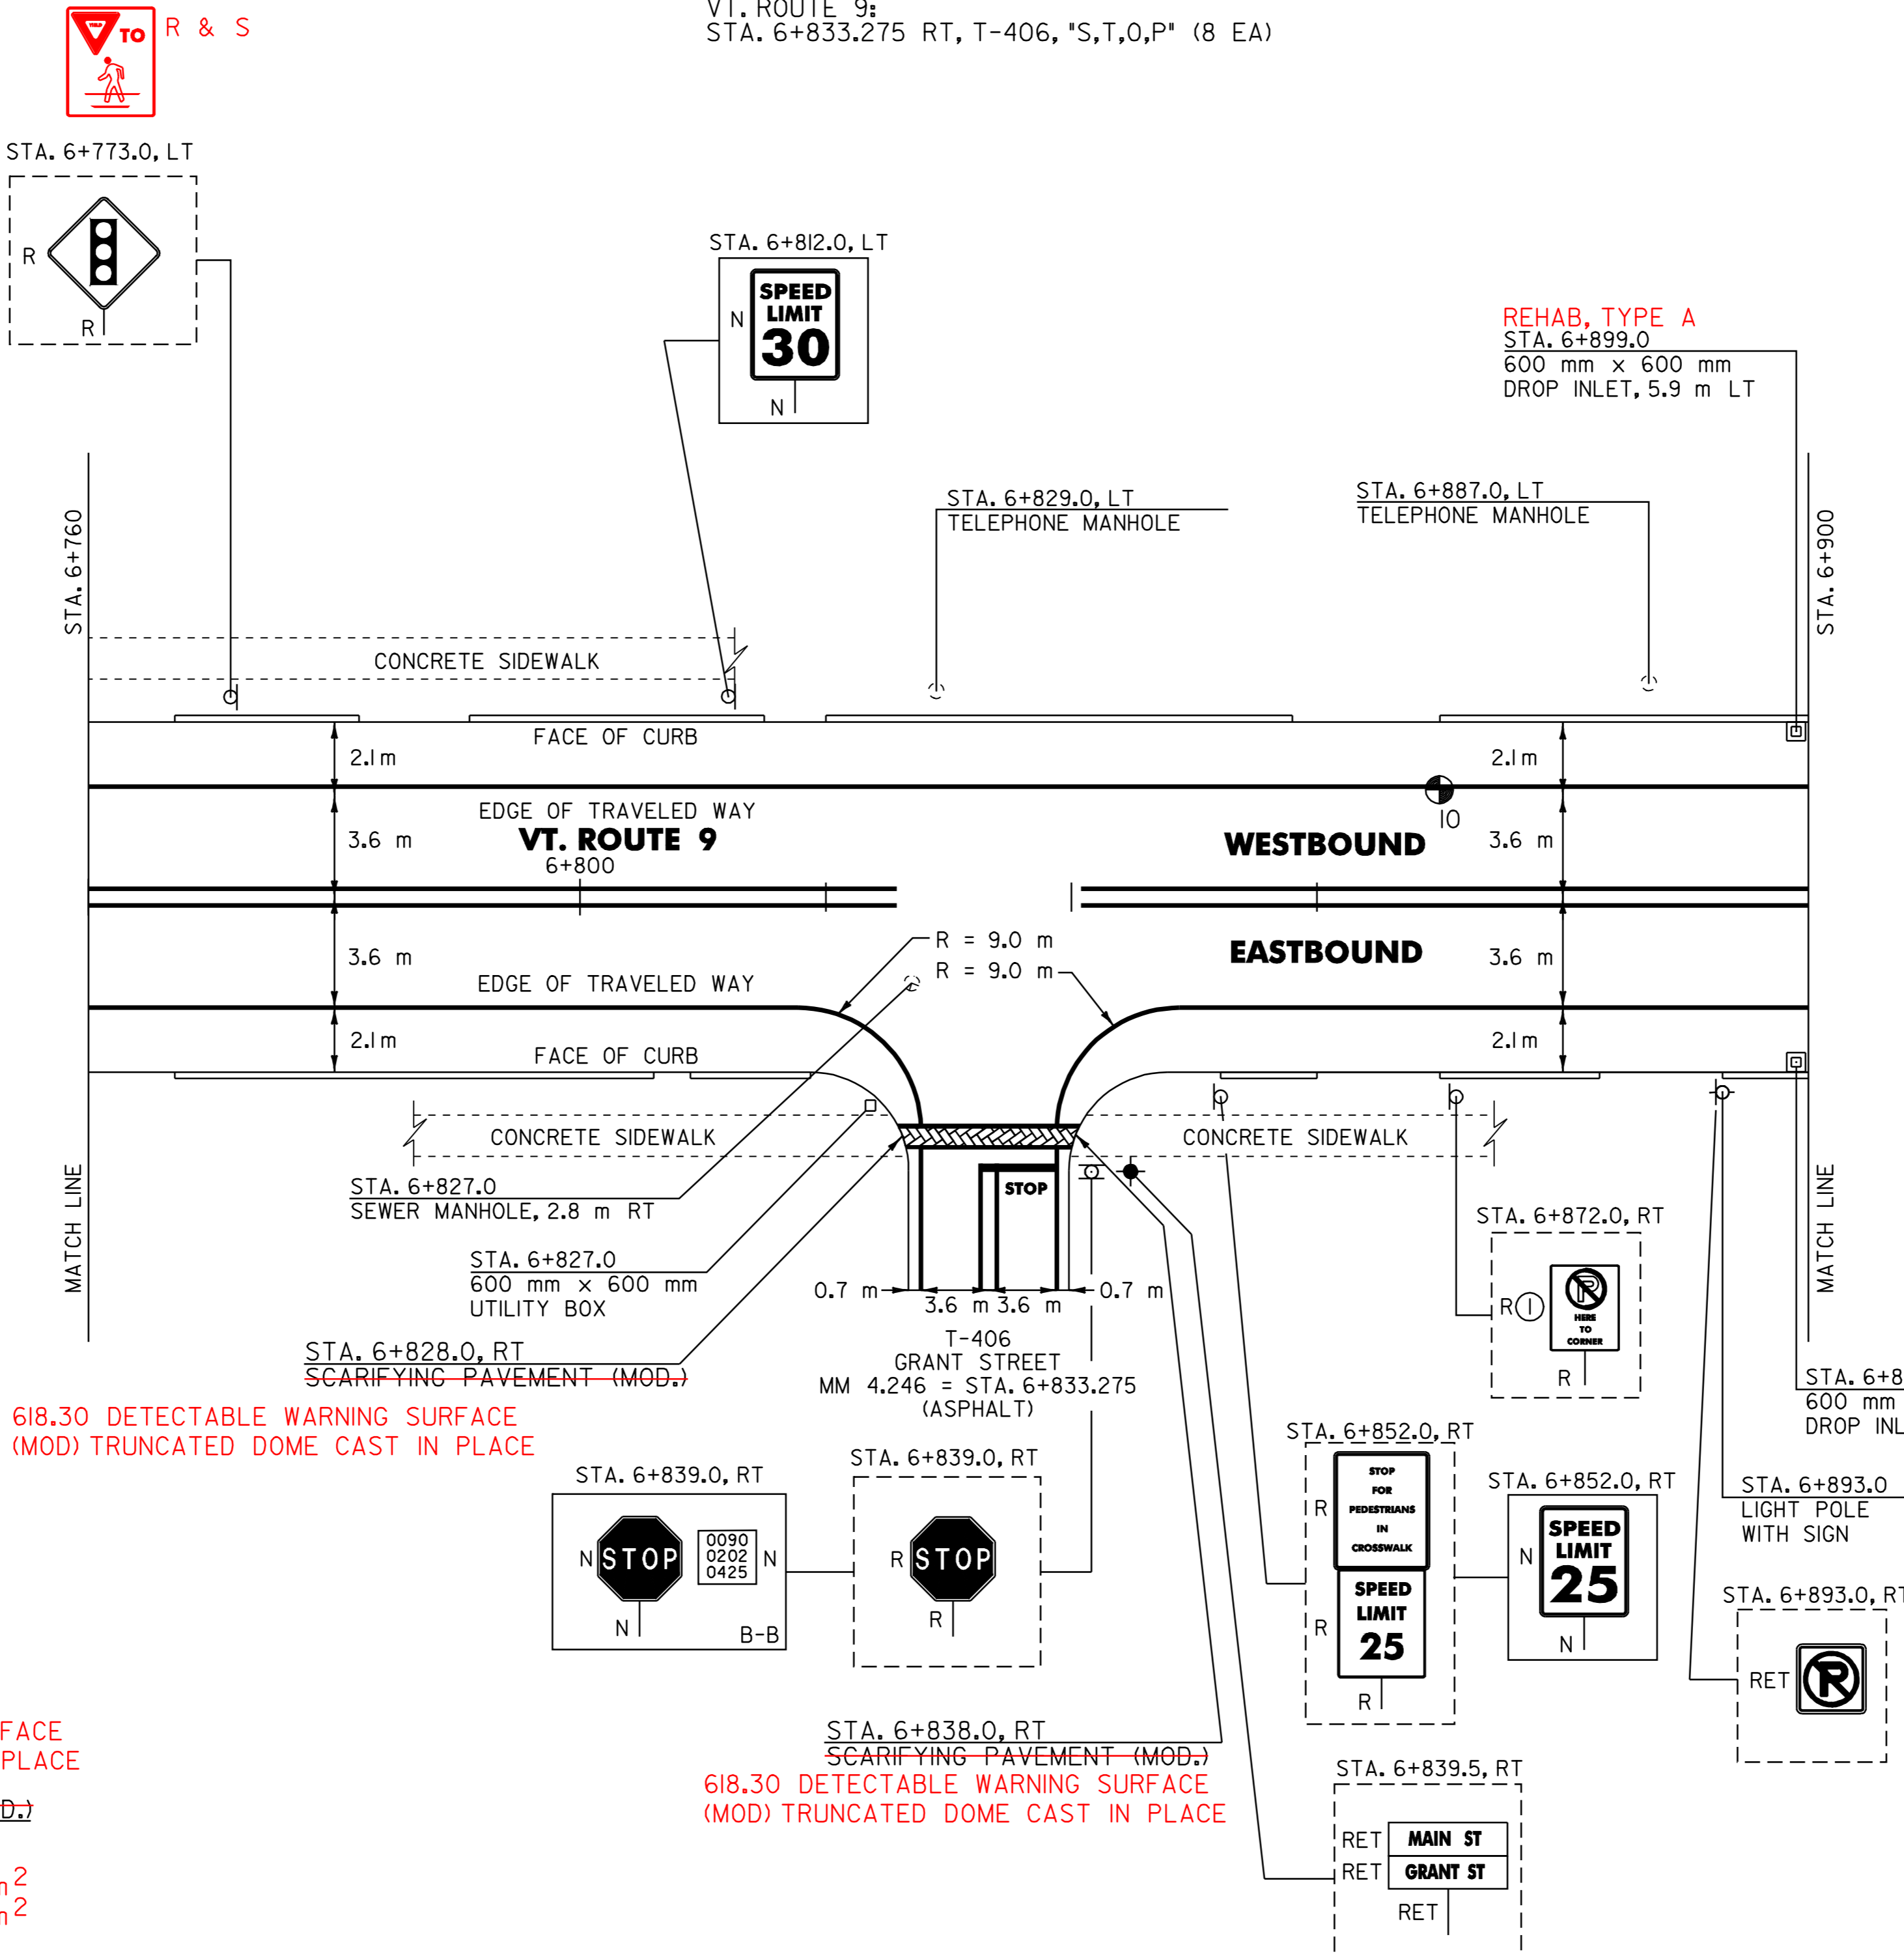

618.30 DETECTABLE WARNING SURFACE (MOD) TRUNCATED DOME CAST IN PLACE

618.30 DETECTABLE WARNING SURFACE (MOD) TRUNCATED DOME CAST IN PLACE

212.20 SCARIFYING PAVEMENT (MOD.)

VT. ROUTE 9:
STA. 6+828.0 RT (5 m²) 0.743 m²
STA. 6+838.0 RT (5 m²) 0.929 m²

REHAB
604.40 CHANGE ELEVATION OF DI, CB OR MH CLASS I

VT. ROUTE 9:
STA. 6+899.0 LT
STA. 6+899.0 RT

604.42 CHANGE ELEVATION OF SEWER MANHOLE

VT. ROUTE 9:
STA. 6+827.0 RT

NOTE:
I. PAVING LIMIT ON ALL TOWN HIGHWAYS SHALL BE MEASURED 8 m BACK FROM VT. ROUTE 9 EDGE OF SHOULDER UNLESS DENOTED OTHERWISE ON THE PLANS OR AS DIRECTED BY THE RESIDENT ENGINEER.

#	TOTAL DEPTH (mm)	PCC	COMMENTS
10	83	Y	

SIGN LEGEND
R= REMOVE
S= SALVAGE
N= NEW
RET= RETAIN
B-B= BACK TO BACK
EXISTING= _____
NEW= _____
Ⓢ SIGN TO BE RETURNED TO THE TOWN OF BENNINGTON

PAVING PROJECT LAYOUT # 10

SURVEYED BY N/A DATE N/A
DRAWN BY J.A.R. DATE 4/01
SQUAD LEADER T.P.K.
DESIGN FILE NO. pave/99dl56/pdl56.dgn
IPARM FILE pdl56i10.i DATE PLOTTED NOV-2005 10:
PROJ. NAME BENNINGTON
PROJ. NO. NH 2202(1)S
SHEET 23 OF 108 SHEETS


DATUM	
VERTICAL	<u>N/A</u>
HORIZONTAL	<u>N/A</u>

646.40 DURABLE 100 mm WHITE LINE
 (ALL LINES WILL INCLUDE EDGE LINE BREAKS AND RADIUS FOR TOWN HIGHWAYS)
 VT. ROUTE 9:
 STA. 6+900.0 - STA. 6+976.9 LT
 STA. 6+900.0 - STA. 6+975.4 RT
 STA. 6+921.789 SOLID LINE LT, T-330 (LANE LINE)
 STA. 6+975.4 - STA. 6+981.5 RT, PARKING SPACES
 STA. 6+976.9 - STA. 6+989.1 LT, PARKING SPACES
 STA. 6+994.4 - STA. 7+000.5 RT, PARKING SPACES
 STA. 7+000.0 - STA. 7+080.0 RT, DOTTED LINE
 STA. 7+011.2 - STA. 7+043.7 LT, PARKING SPACES
 STA. 7+037.1 - STA. 7+070.9 RT, PARKING SPACES
 STA. 7+057.8 - STA. 7+080.0 LT, PARKING SPACES
646.60 TEMPORARY 100 mm WHITE LINE
 (ALL LINES WILL INCLUDE EDGE LINE BREAKS AND RADIUS FOR TOWN HIGHWAYS)
 VT. ROUTE 9:
 STA. 6+900.0 - STA. 6+976.9 LT
 STA. 6+900.0 - STA. 6+975.4 RT
 STA. 6+921.789 SOLID LINE LT, T-330 (LANE LINE)
 STA. 6+975.4 - STA. 6+981.5 RT, PARKING SPACES
 STA. 6+976.9 - STA. 6+989.1 LT, PARKING SPACES
 STA. 6+994.4 - STA. 7+000.5 RT, PARKING SPACES
 STA. 7+000.0 - STA. 7+080.0 RT, DOTTED LINE
 STA. 7+011.2 - STA. 7+043.7 LT, PARKING SPACES
 STA. 7+037.1 - STA. 7+070.9 RT, PARKING SPACES
 STA. 7+057.8 - STA. 7+080.0 LT, PARKING SPACES

646.41 DURABLE 100 mm YELLOW LINE
 (ALL LINES WILL INCLUDE C/L BREAKS FOR TOWN HIGHWAYS) S=SOLID, D=DASHED
 VT. ROUTE 9:
 STA. 6+900.0 - STA. 6+905.0 LT S C RT
 STA. 6+941.3 - STA. 7+000.0 S - S
 STA. 6+921.789 DOUBLE SOLID LT, T-330
 STA. 6+923.398 DOUBLE SOLID RT, T-416
 STA. 7+000.0 - STA. 7+080.0 DOUBLE SOLID LT
646.61 TEMPORARY 100 mm YELLOW LINE
 (ALL LINES WILL INCLUDE C/L BREAKS FOR TOWN HIGHWAYS) S=SOLID, D=DASHED
 VT. ROUTE 9:
 STA. 6+900.0 - STA. 6+905.0 LT S C RT
 STA. 6+941.3 - STA. 7+000.0 S - S
 STA. 6+921.789 DOUBLE SOLID LT, T-330
 STA. 6+923.398 DOUBLE SOLID RT, T-416
 STA. 7+000.0 - STA. 7+080.0 DOUBLE SOLID LT

646.42 DURABLE 200 mm WHITE LINE
 VT. ROUTE 9:
 STA. 7+016.2 - STA. 7+019.8 RT, SHOULDER HATCHING (18.6 m)
646.46 DURABLE 600 mm STOP BAR (TYPE 1TAPE)
 VT. ROUTE 9:
 STA. 6+905.3 RT
 STA. 6+921.789 LT, T-330
 STA. 6+923.398 RT, T-416
 STA. 6+941.0 LT
646.66 TEMPORARY 600 mm STOP BAR
 VT. ROUTE 9:
 STA. 6+905.3 RT
 STA. 6+921.789 LT, T-330
 STA. 6+923.398 RT, T-416
 STA. 6+941.0 LT
646.50 DURABLE LETTER OR SYMBOL (TYPE 1TAPE)
 VT. ROUTE 9:
 STA. 6+921.789 LT, T-330, ARROW (6 EA)
 STA. 6+921.789 LT, T-330, "O,N,L,Y" (8 EA)
 STA. 7+040.1 RT, HANDICAP SYMBOL (1EA)

646.70 DURABLE TEMPORARY LETTER OR SYMBOL
 VT. ROUTE 9:
 STA. 6+921.789 LT, T-330, ARROW (12 EA)
646.51 DURABLE CROSSWALK MARKINGS WITH DIAGONAL LINES (MOD 2)
 VT. ROUTE 9:
 STA. 6+908.0
 STA. 6+921.789 LT, T-330
 STA. 6+923.398 RT, T-416
 STA. 6+931.0
646.71 TEMPORARY CROSSWALK MARKINGS WITH DIAGONAL LINES
 VT. ROUTE 9:
 STA. 6+908.0
 STA. 6+921.789 LT, T-330
 STA. 6+923.398 RT, T-416
 STA. 6+931.0
675.50 REMOVING SIGNS
 AS SHOWN - ~~X19~~
675.60 ERECTING SALVAGED SIGNS
 AS SHOWN - 4

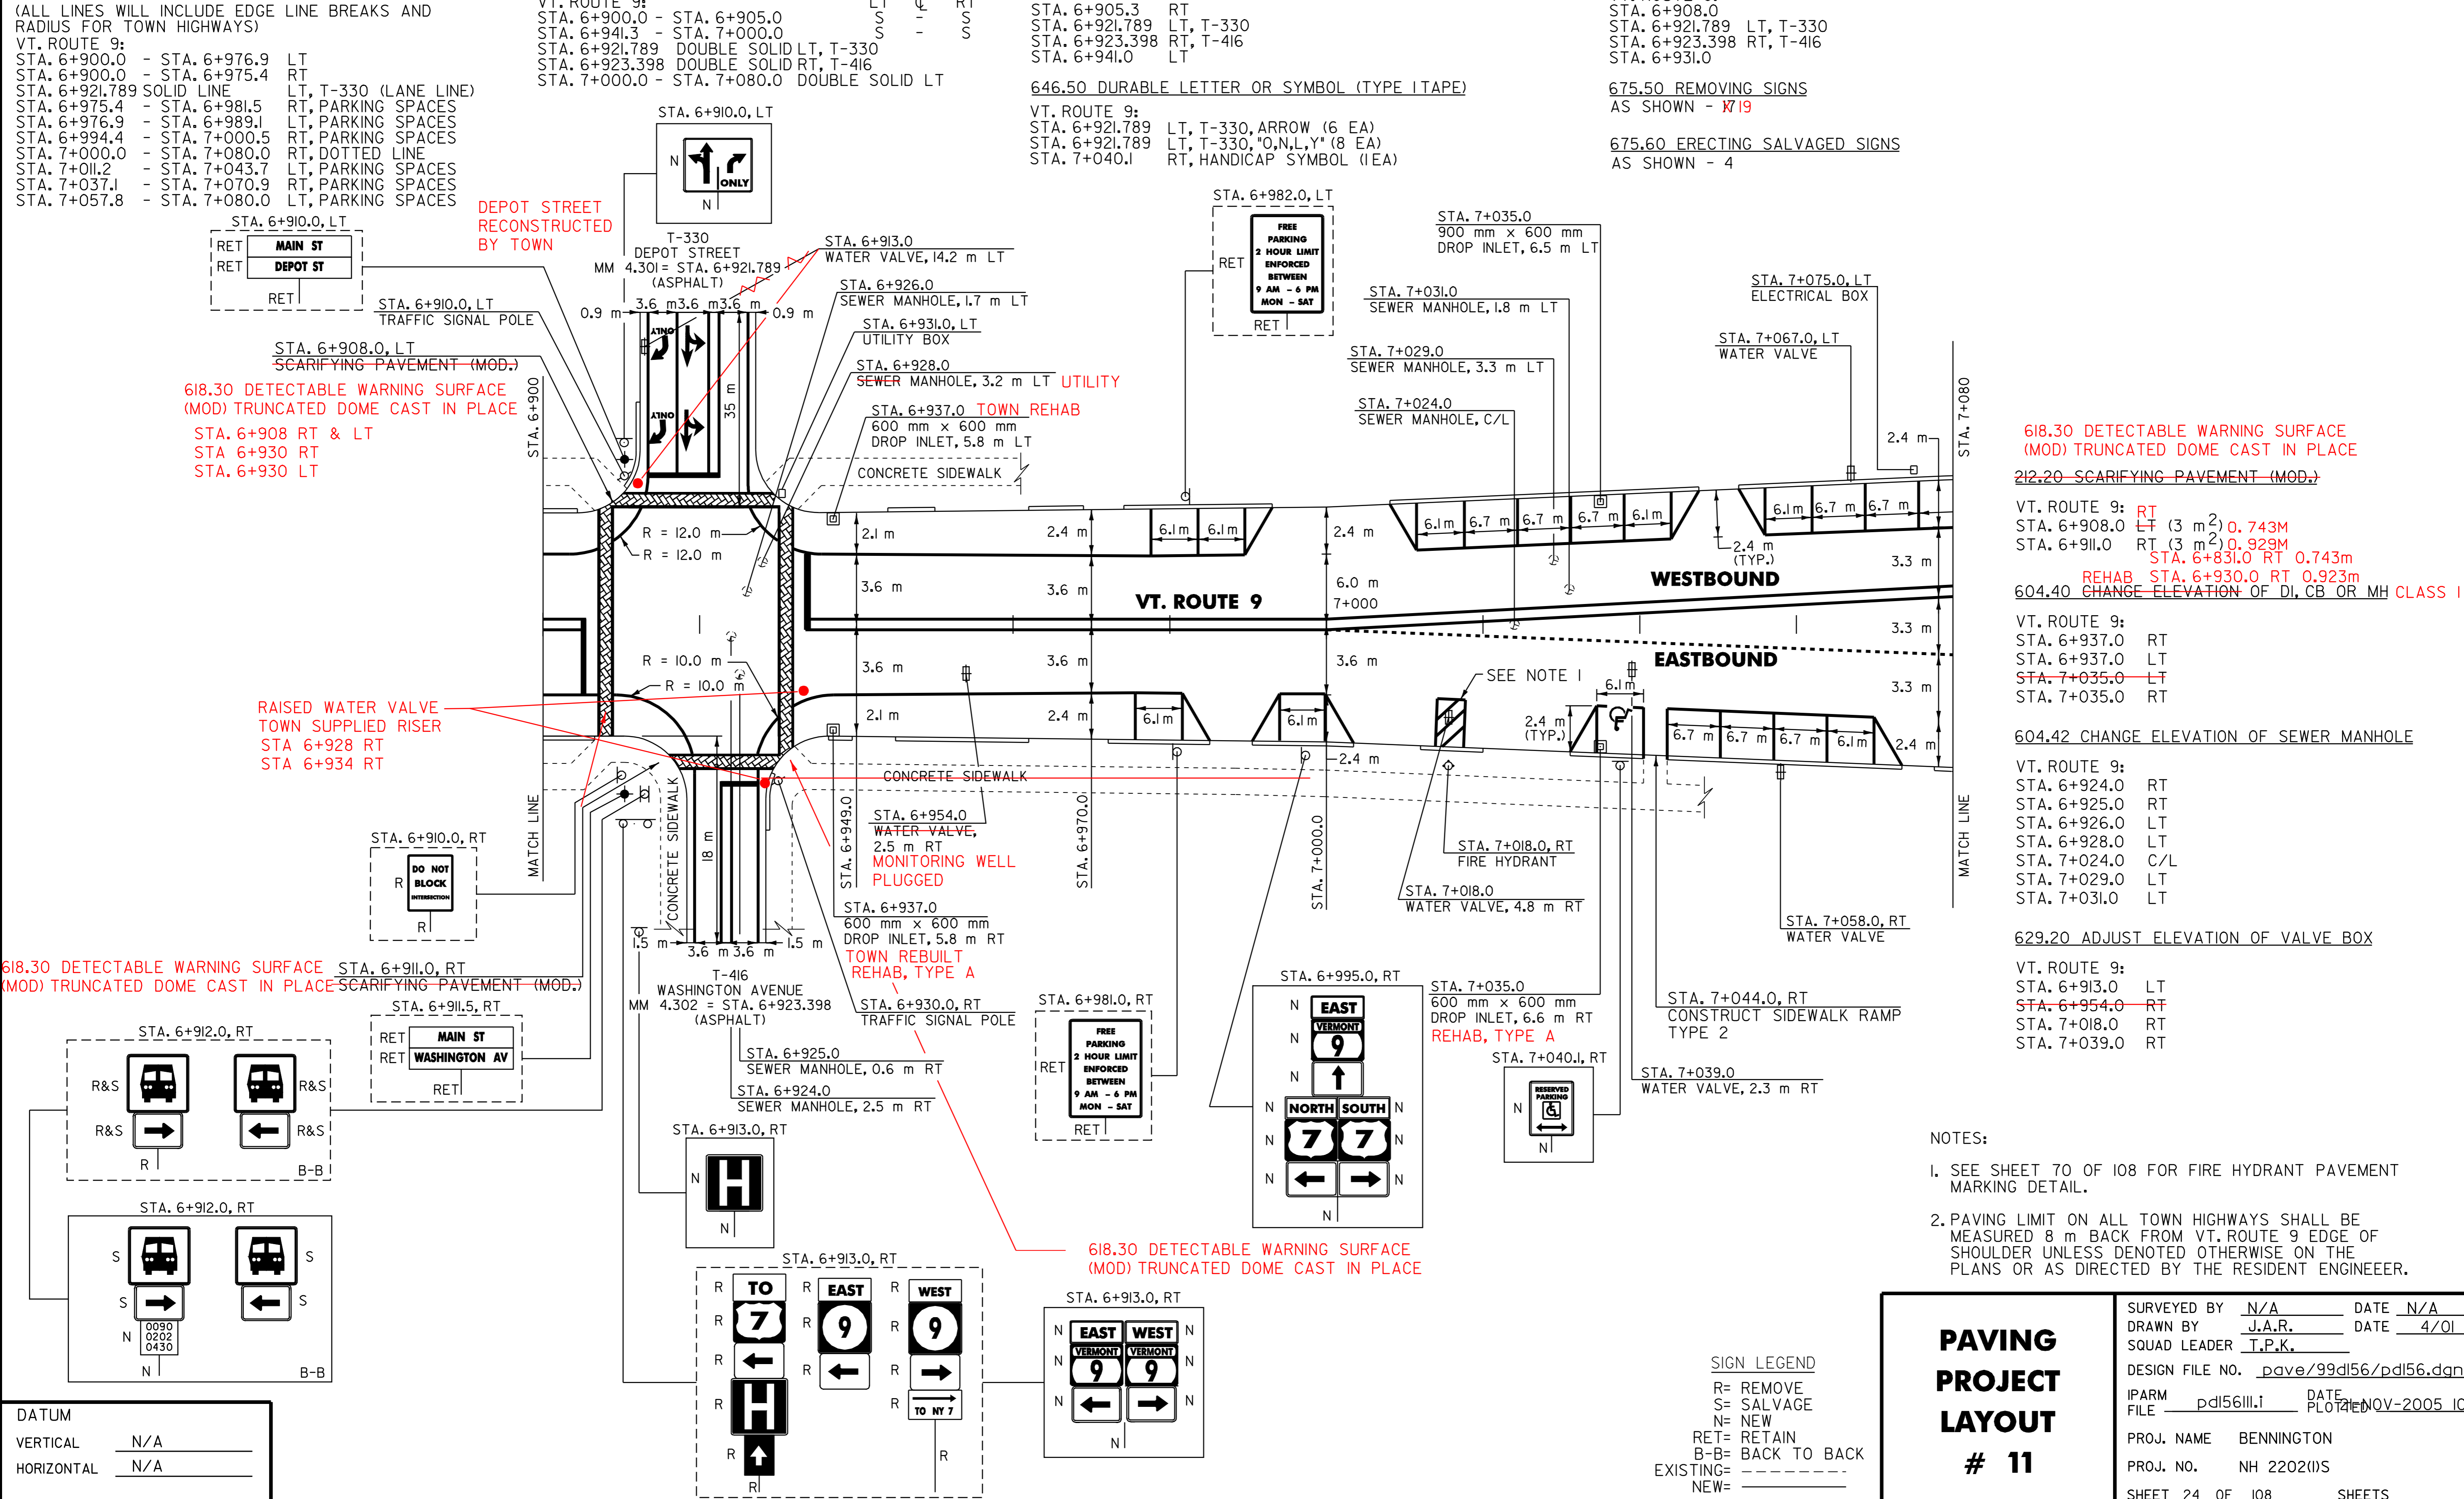

618.30 DETECTABLE WARNING SURFACE (MOD) TRUNCATED DOME CAST IN PLACE
 STA. 6+908 RT & LT
 STA. 6+930 RT
 STA. 6+930 LT

RAISED WATER VALVE TOWN SUPPLIED RISER
 STA. 6+928 RT
 STA. 6+934 RT

618.30 DETECTABLE WARNING SURFACE (MOD) TRUNCATED DOME CAST IN PLACE
~~212.20 SCARIFYING PAVEMENT (MOD)~~

VT. ROUTE 9: RT
 STA. 6+908.0 LT (3 m²) 0.743M
 STA. 6+911.0 RT (3 m²) 0.929M
 STA. 6+831.0 RT 0.743m
REHAB STA. 6+930.0 RT 0.923m
604.40 CHANGE ELEVATION OF DI, CB OR MH CLASS 1
 VT. ROUTE 9:
 STA. 6+937.0 RT
 STA. 6+937.0 LT
 STA. 7+035.0 LT
 STA. 7+035.0 RT

604.42 CHANGE ELEVATION OF SEWER MANHOLE

VT. ROUTE 9:
 STA. 6+924.0 RT
 STA. 6+925.0 RT
 STA. 6+926.0 LT
 STA. 6+928.0 LT
 STA. 7+024.0 C/L
 STA. 7+029.0 LT
 STA. 7+031.0 LT

629.20 ADJUST ELEVATION OF VALVE BOX

VT. ROUTE 9:
 STA. 6+913.0 LT
 STA. 6+954.0 RT
 STA. 7+018.0 RT
 STA. 7+039.0 RT

- NOTES:
- SEE SHEET 70 OF 108 FOR FIRE HYDRANT PAVEMENT MARKING DETAIL.
 - PAVING LIMIT ON ALL TOWN HIGHWAYS SHALL BE MEASURED 8 m BACK FROM VT. ROUTE 9 EDGE OF SHOULDER UNLESS DENOTED OTHERWISE ON THE PLANS OR AS DIRECTED BY THE RESIDENT ENGINEER.

PAVING PROJECT LAYOUT # 11

SURVEYED BY	N/A	DATE	N/A
DRAWN BY	J.A.R.	DATE	4/01
SQUAD LEADER	T.P.K.		
DESIGN FILE NO.	pave/99dl56/pdl56.dgn		
IPARM FILE	pdl56iii.1	DATE	21 NOV-2005 10:21
PROJ. NAME	BENNINGTON		
PROJ. NO.	NH 2202(1)S		
SHEET 24 OF 108	SHEETS		

SIGN LEGEND
 R= REMOVE
 S= SALVAGE
 N= NEW
 RET= RETAIN
 B-B= BACK TO BACK
 EXISTING= - - - - -
 NEW= _____


DATUM	
VERTICAL	N/A
HORIZONTAL	N/A

646.40 DURABLE 100 mm WHITE LINE
(ALL LINES WILL INCLUDE EDGE LINE BREAKS AND RADIUS FOR TOWN HIGHWAYS)
VT. ROUTE 9:
STA. 7+080.0 - STA. 7+103.7 RT, SOLID LINE (LANE LINE)
STA. 7+080.0 - STA. 7+096.8 LT, PARKING SPACES
STA. 7+083.2 - STA. 7+095.4 RT, PARKING SPACES
STA. 7+133.3 - STA. 7+155.0 RT, SOLID LINE (LANE LINE)
STA. 7+136.2 - STA. 7+188.6 LT, PARKING SPACES
STA. 7+142.9 - STA. 7+190.1 RT, PARKING SPACES
STA. 7+155.0 - STA. 7+190.0 LT, DOTTED LINE
STA. 7+209.8 - STA. 7+260.0 RT, PARKING SPACES
STA. 7+210.2 - STA. 7+242.5 LT, PARKING SPACES
STA. 7+255.4 - STA. 7+260.0 LT, PARKING SPACES

646.40 DURABLE 100 mm WHITE LINE
(ALL LINES WILL INCLUDE EDGE LINE BREAKS AND RADIUS FOR TOWN HIGHWAYS)
VT. ROUTE 9:
STA. 7+080.0 - STA. 7+103.7 RT, SOLID LINE (LANE LINE)
STA. 7+080.0 - STA. 7+096.8 LT, PARKING SPACES
STA. 7+083.2 - STA. 7+095.4 RT, PARKING SPACES
STA. 7+133.3 - STA. 7+155.0 RT, SOLID LINE (LANE LINE)
STA. 7+136.2 - STA. 7+188.6 LT, PARKING SPACES
STA. 7+142.9 - STA. 7+190.1 RT, PARKING SPACES
STA. 7+155.0 - STA. 7+190.0 LT, DOTTED LINE
STA. 7+209.8 - STA. 7+260.0 RT, PARKING SPACES
STA. 7+210.2 - STA. 7+242.5 LT, PARKING SPACES
STA. 7+255.4 - STA. 7+260.0 LT, PARKING SPACES

646.41 DURABLE 100 mm YELLOW LINE
(ALL LINES WILL INCLUDE C/L BREAKS FOR TOWN HIGHWAYS) S=SOLID, D=DASHED
VT. ROUTE 9:
STA. 7+190.0 - STA. 7+260.0 LT S C RT S
STA. 7+080.0 - STA. 7+103.7 DOUBLE SOLID LT
STA. 7+133.3 - STA. 7+190.0 DOUBLE SOLID RT
646.61 TEMPORARY 100 mm YELLOW LINE
(ALL LINES WILL INCLUDE C/L BREAKS FOR TOWN HIGHWAYS) S=SOLID, D=DASHED
VT. ROUTE 9:
STA. 7+190.0 - STA. 7+260.0 LT S C RT S
STA. 7+080.0 - STA. 7+103.7 DOUBLE SOLID LT
STA. 7+133.3 - STA. 7+190.0 DOUBLE SOLID RT

646.46 DURABLE 600 mm STOP BAR (TYPE ITAPE)
VT. ROUTE 9:
STA. 7+104.0 RT KM 07+092 RT
STA. 7+133.0 LT
646.66 TEMPORARY 600 mm STOP BAR
VT. ROUTE 9:
STA. 7+104.0 RT
STA. 7+133.0 LT
646.50 DURABLE LETTER OR SYMBOL (TYPE ITAPE)
VT. ROUTE 9:
STA. 7+081.3 RT, "O,N,L,Y" (4 EA)
STA. 7+082.0 RT, ARROW (2 EA)
STA. 7+085.0 RT, ARROW (1EA)
STA. 7+139.3 LT, HANDICAP SYMBOL (1EA)
STA. 7+150.0 LT, ARROW (1EA)
STA. 7+153.0 LT, ARROW (2 EA)
STA. 7+153.7 LT, "O,N,L,Y" (4 EA)
STA. 7+187.0 RT, HANDICAP SYMBOL (1EA)
646.70 TEMPORARY LETTER OR SYMBOL
VT. ROUTE 9:
STA. 7+082.0 RT, ARROW (4 EA)
STA. 7+085.0 RT, ARROW (2 EA)
STA. 7+150.0 LT, ARROW (2 EA)
STA. 7+153.0 LT, ARROW (4 EA)

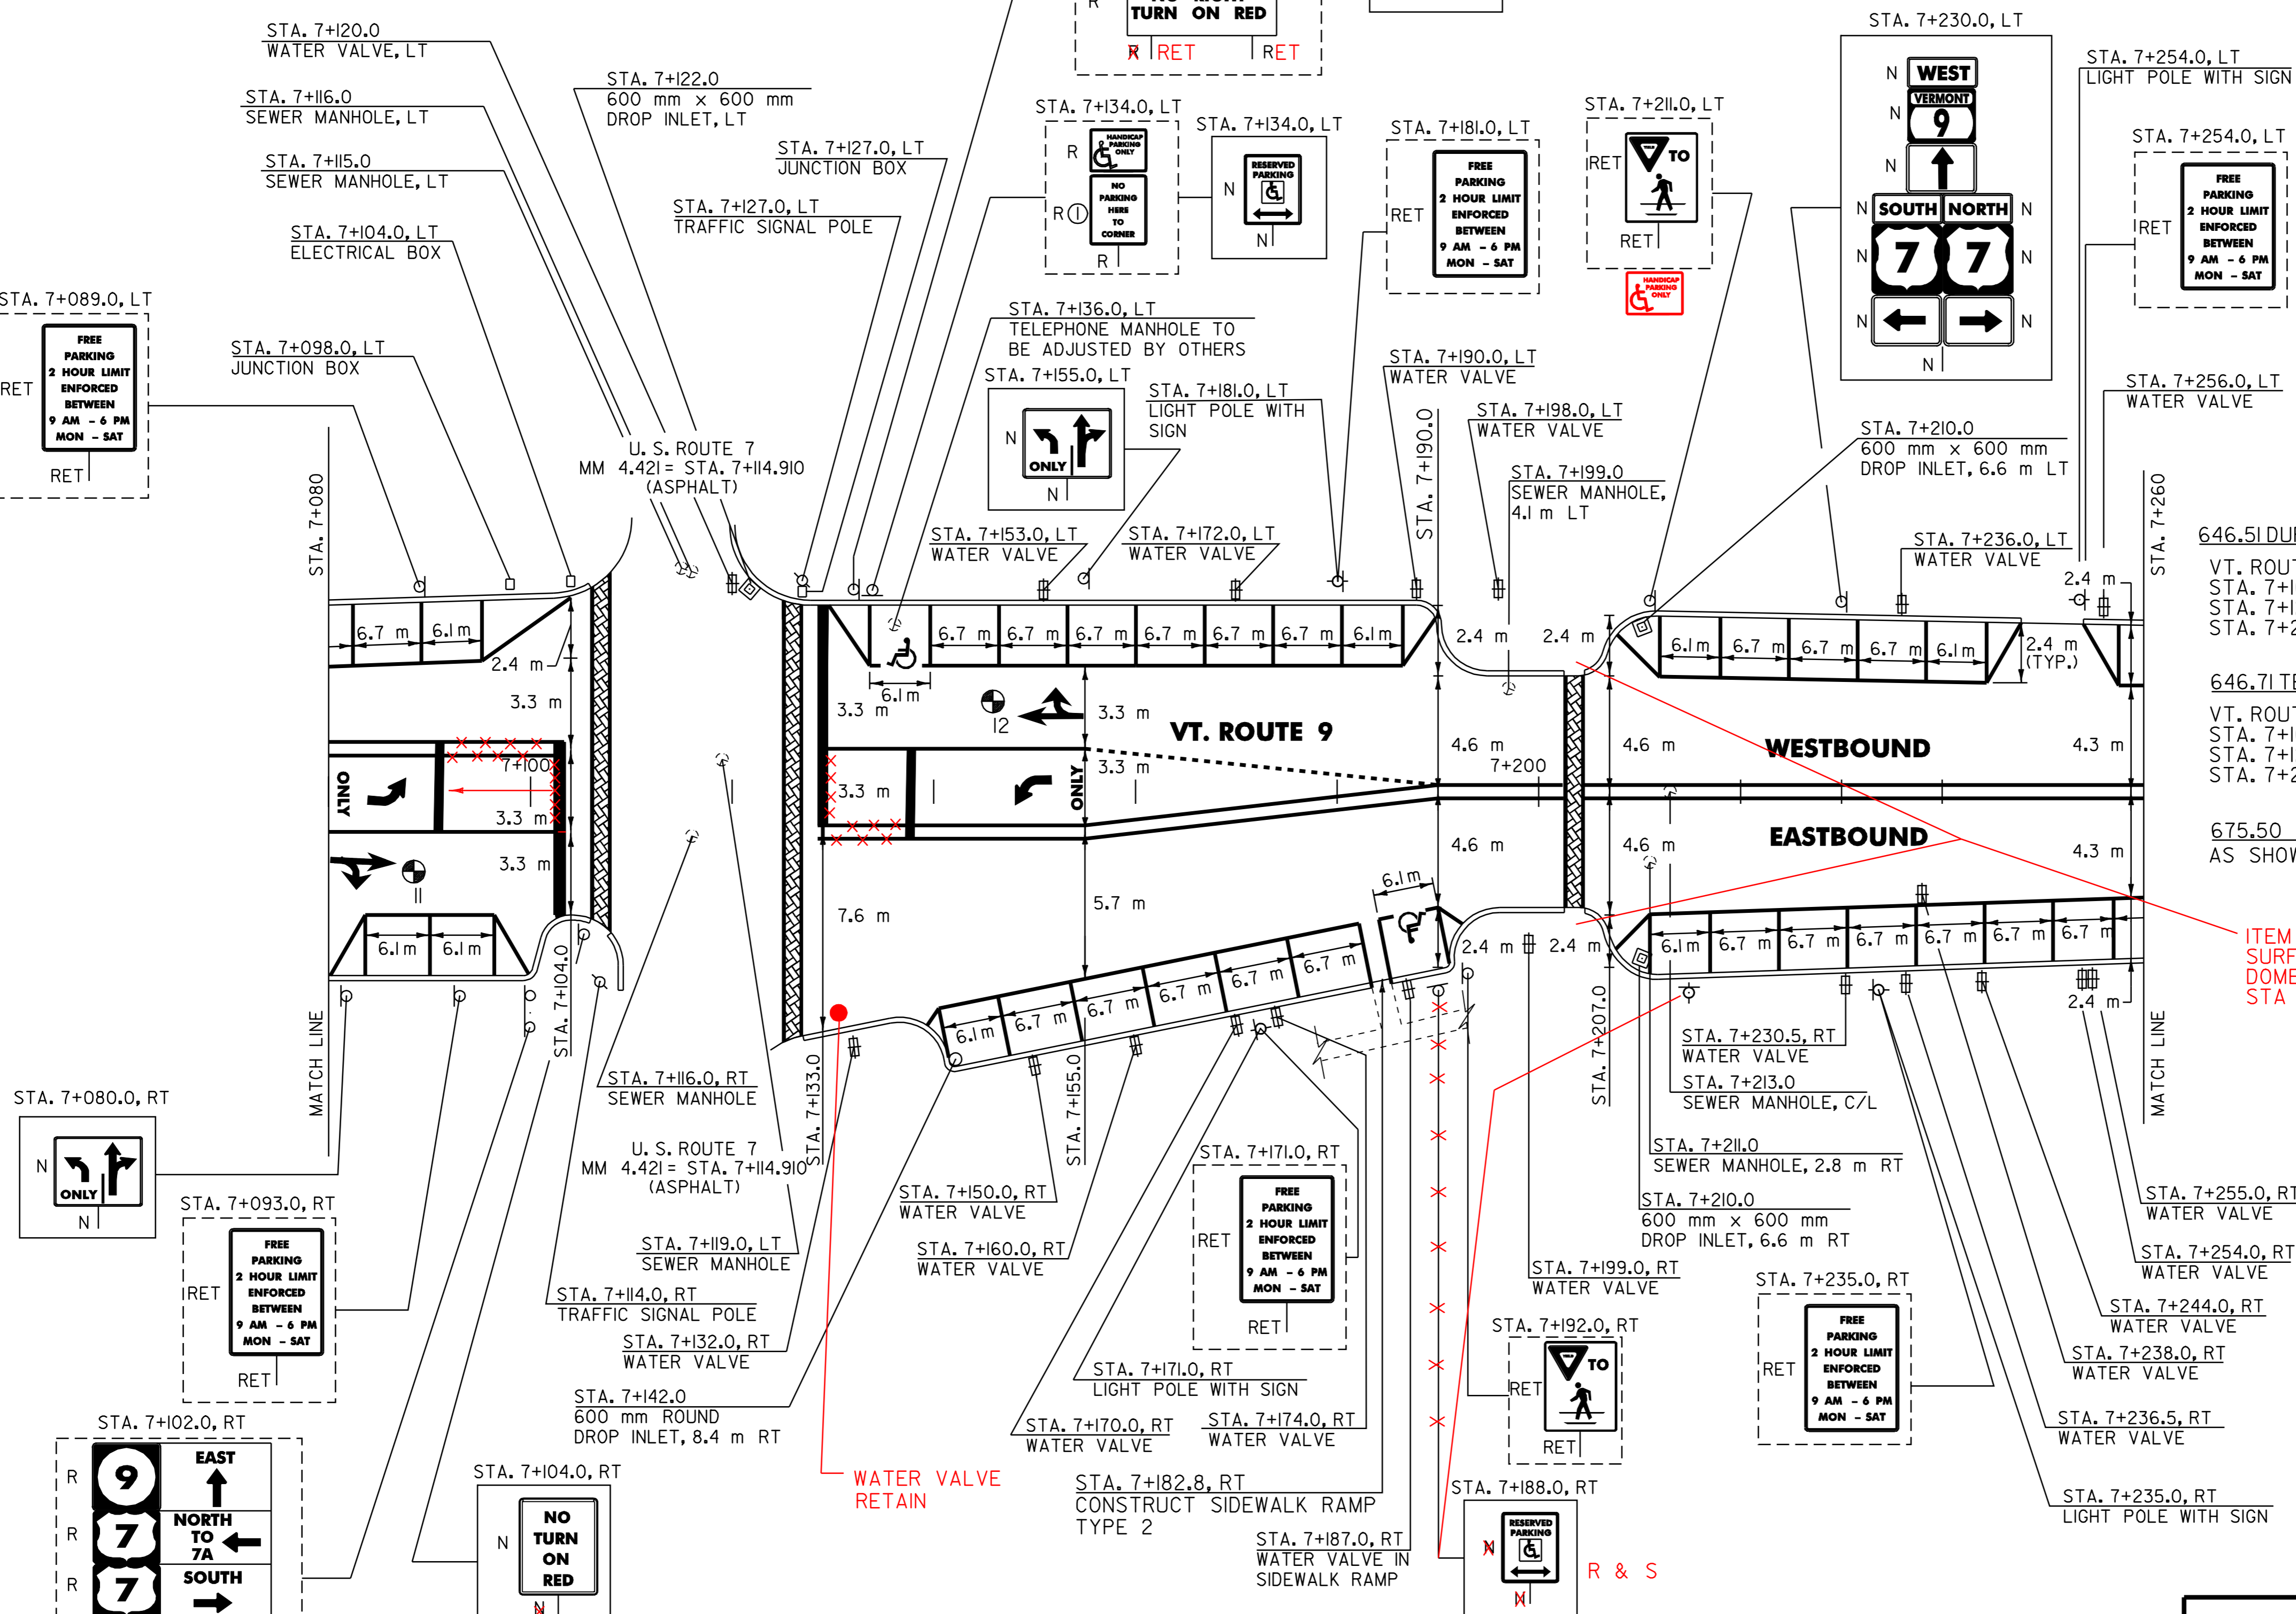

646.51 DURABLE CROSSWALK MARKINGS WITH DIAGONAL LINES (MOD.2)

VT. ROUTE 9:
STA. 7+107.0
STA. 7+126.0
STA. 7+203.0

646.71 TEMPORARY CROSSWALK MARKINGS WITH DIAGONAL LINES

VT. ROUTE 9:
STA. 7+107.0
STA. 7+126.0
STA. 7+203.0

675.50 REMOVING SIGNS
AS SHOWN - 10 11

ITEM 618.30 DETECTABLE WARNING (MOD)
SURFACE MOD TRUNCATED
DOME SURFACE APPLIED
STA 7+200 LT&RT 0.93m² EA

NOTE:
1. SEE SHEET 37 OF 108 FOR U.S. ROUTE 7 DETAILS ASSOCIATED WITH THE INTERSECTION OF VT. ROUTE 9.

PAVEMENT CORES =

#	TOTAL DEPTH (mm)	PCC	COMMENTS
11	89	Y	
12	83	Y	

DATUM

VERTICAL	N/A
HORIZONTAL	N/A

604.40 CHANGE ELEVATION OF DI, CB OR MH
VT. ROUTE 9:
STA. 7+122.0 LT
STA. 7+142.0 RT REHAB
STA. 7+210.0 RT
STA. 7+210.0 LT

604.42 CHANGE ELEVATION OF SEWER MANHOLE

VT. ROUTE 9:
STA. 7+115.0 LT
STA. 7+116.0 LT
STA. 7+116.0 RT
STA. 7+119.0 LT
STA. 7+199.0 LT
STA. 7+211.0 RT
STA. 7+213.0 C/L

629.20 ADJUST ELEVATION OF VALVE BOX

VT. ROUTE 9:
STA. 7+120.0 LT
STA. 7+187.0 RT
STA. 7+238.0 RT

SIGN LEGEND
R= REMOVE
S= SALVAGE
N= NEW
RET= RETAIN
B=B= BACK TO BACK
EXISTING= - - - - -
NEW= _____
① SIGN TO BE RETURNED TO THE TOWN OF BENNINGTON

PAVING PROJECT LAYOUT # 12

SURVEYED BY N/A DATE N/A
DRAWN BY J.A.R. DATE 4/01
SQUAD LEADER T.P.K.
DESIGN FILE NO. pave/99d156/pd156.dgn
IPARM pd156112.i DATE 27 NOV-2005 10
FILE
PROJ. NAME BENNINGTON
PROJ. NO. NH 2202(1)S
SHEET 25 OF 108 SHEETS

646.40 DURABLE 100 mm WHITE LINE
 (ALL LINES WILL INCLUDE EDGE LINE BREAKS AND RADIUS FOR TOWN HIGHWAYS)
 VT. ROUTE 9:
 STA. 7+260.0 - STA. 7+261.5 LT, PARKING SPACES
 STA. 7+260.0 - STA. 7+262.2 RT, PARKING SPACES
 STA. 7+265.8 - STA. 7+284.7 RT, PARKING SPACES
 STA. 7+271.9 - STA. 7+278.0 LT, PARKING SPACES
 STA. 7+305.0 - STA. 7+317.2 LT, PARKING SPACES
 STA. 7+314.6 - STA. 7+340.2 LT, PARKING SPACES
 STA. 7+336.7 - STA. 7+362.3 RT, PARKING SPACES
 STA. 7+347.4 - STA. 7+353.5 RT, PARKING SPACES
 STA. 7+363.6 - STA. 7+375.8 RT, PARKING SPACES
 STA. 7+391.5 - STA. 7+410.4 LT, PARKING SPACES
 STA. 7+406.2 - STA. 7+433.3 RT, PARKING SPACES
 STA. 7+426.9 - STA. 7+433.0 LT, PARKING SPACES


646.60 TEMPORARY 100 mm WHITE LINE
 (ALL LINES WILL INCLUDE EDGE LINE BREAKS AND RADIUS FOR TOWN HIGHWAYS)
 VT. ROUTE 9:
 STA. 7+260.0 - STA. 7+261.5 LT, PARKING SPACES
 STA. 7+260.0 - STA. 7+262.2 RT, PARKING SPACES
 STA. 7+265.8 - STA. 7+284.7 RT, PARKING SPACES
 STA. 7+271.9 - STA. 7+278.0 LT, PARKING SPACES
 STA. 7+305.0 - STA. 7+317.2 LT, PARKING SPACES
 STA. 7+314.6 - STA. 7+340.2 LT, PARKING SPACES
 STA. 7+336.7 - STA. 7+362.3 RT, PARKING SPACES
 STA. 7+347.4 - STA. 7+353.5 RT, PARKING SPACES
 STA. 7+363.6 - STA. 7+375.8 RT, PARKING SPACES
 STA. 7+391.5 - STA. 7+410.4 LT, PARKING SPACES
 STA. 7+406.2 - STA. 7+433.3 RT, PARKING SPACES
 STA. 7+426.9 - STA. 7+433.0 LT, PARKING SPACES

646.41 DURABLE 100 mm WHITE LINE
 (ALL LINES WILL INCLUDE C/L BREAKS FOR TOWN HIGHWAYS) S=SOLID, D=DASHED
 VT. ROUTE 9:
 STA. 7+260.0 - STA. 7+440.0 LT S
 STA. 7+290.328 DOUBLE SOLID LT, T-340
646.61 TEMPORARY 100 mm YELLOW LINE
 (ALL LINES WILL INCLUDE C/L BREAKS FOR TOWN HIGHWAYS) S=SOLID, D=DASHED
 VT. ROUTE 9:
 STA. 7+260.0 - STA. 7+440.0 LT S
 STA. 7+290.328 DOUBLE SOLID LT, T-340

646.42 DURABLE 200 mm WHITE LINE
 VT. ROUTE 9:
 STA. 7+262.2 - STA. 7+265.8 RT, SHOULDER HATCHING (18.6 m)
646.66 TEMPORARY 600 mm STOP BAR
 VT. ROUTE 9:
 STA. 7+290.328 LT, T-340
646.50 DURABLE LETTER OR SYMBOL (TYPE 1 TAPE)
 VT. ROUTE 9:
 STA. 7+290.328 LT, T-340, "S,T,O,P" (4 EA)
 STA. 7+308.1 LT, HANDICAP SYMBOL (1EA)
 STA. 7+409.5 RT, HANDICAP SYMBOL (1EA)
646.70 TEMPORARY LETTER OR SYMBOL
 VT. ROUTE 9:
 STA. 7+290.328 LT, T-340, "S,T,O,P" (8 EA)

646.51 DURABLE CROSSWALK MARKINGS WITH DIAGONAL LINES (MOD.2)
 VT. ROUTE 9:
 STA. 7+290.328 LT, T-340
 STA. 7+299.0
 STA. 7+383.0
 STA. 7+388.498 RT, T-438
646.71 TEMPORARY CROSSWALK MARKINGS WITH DIAGONAL LINES
 VT. ROUTE 9:
 STA. 7+290.328 LT, T-340
 STA. 7+299.0
 STA. 7+383.0
 STA. 7+388.498 RT, T-438

675.50 REMOVING SIGNS
 AS SHOWN - 6

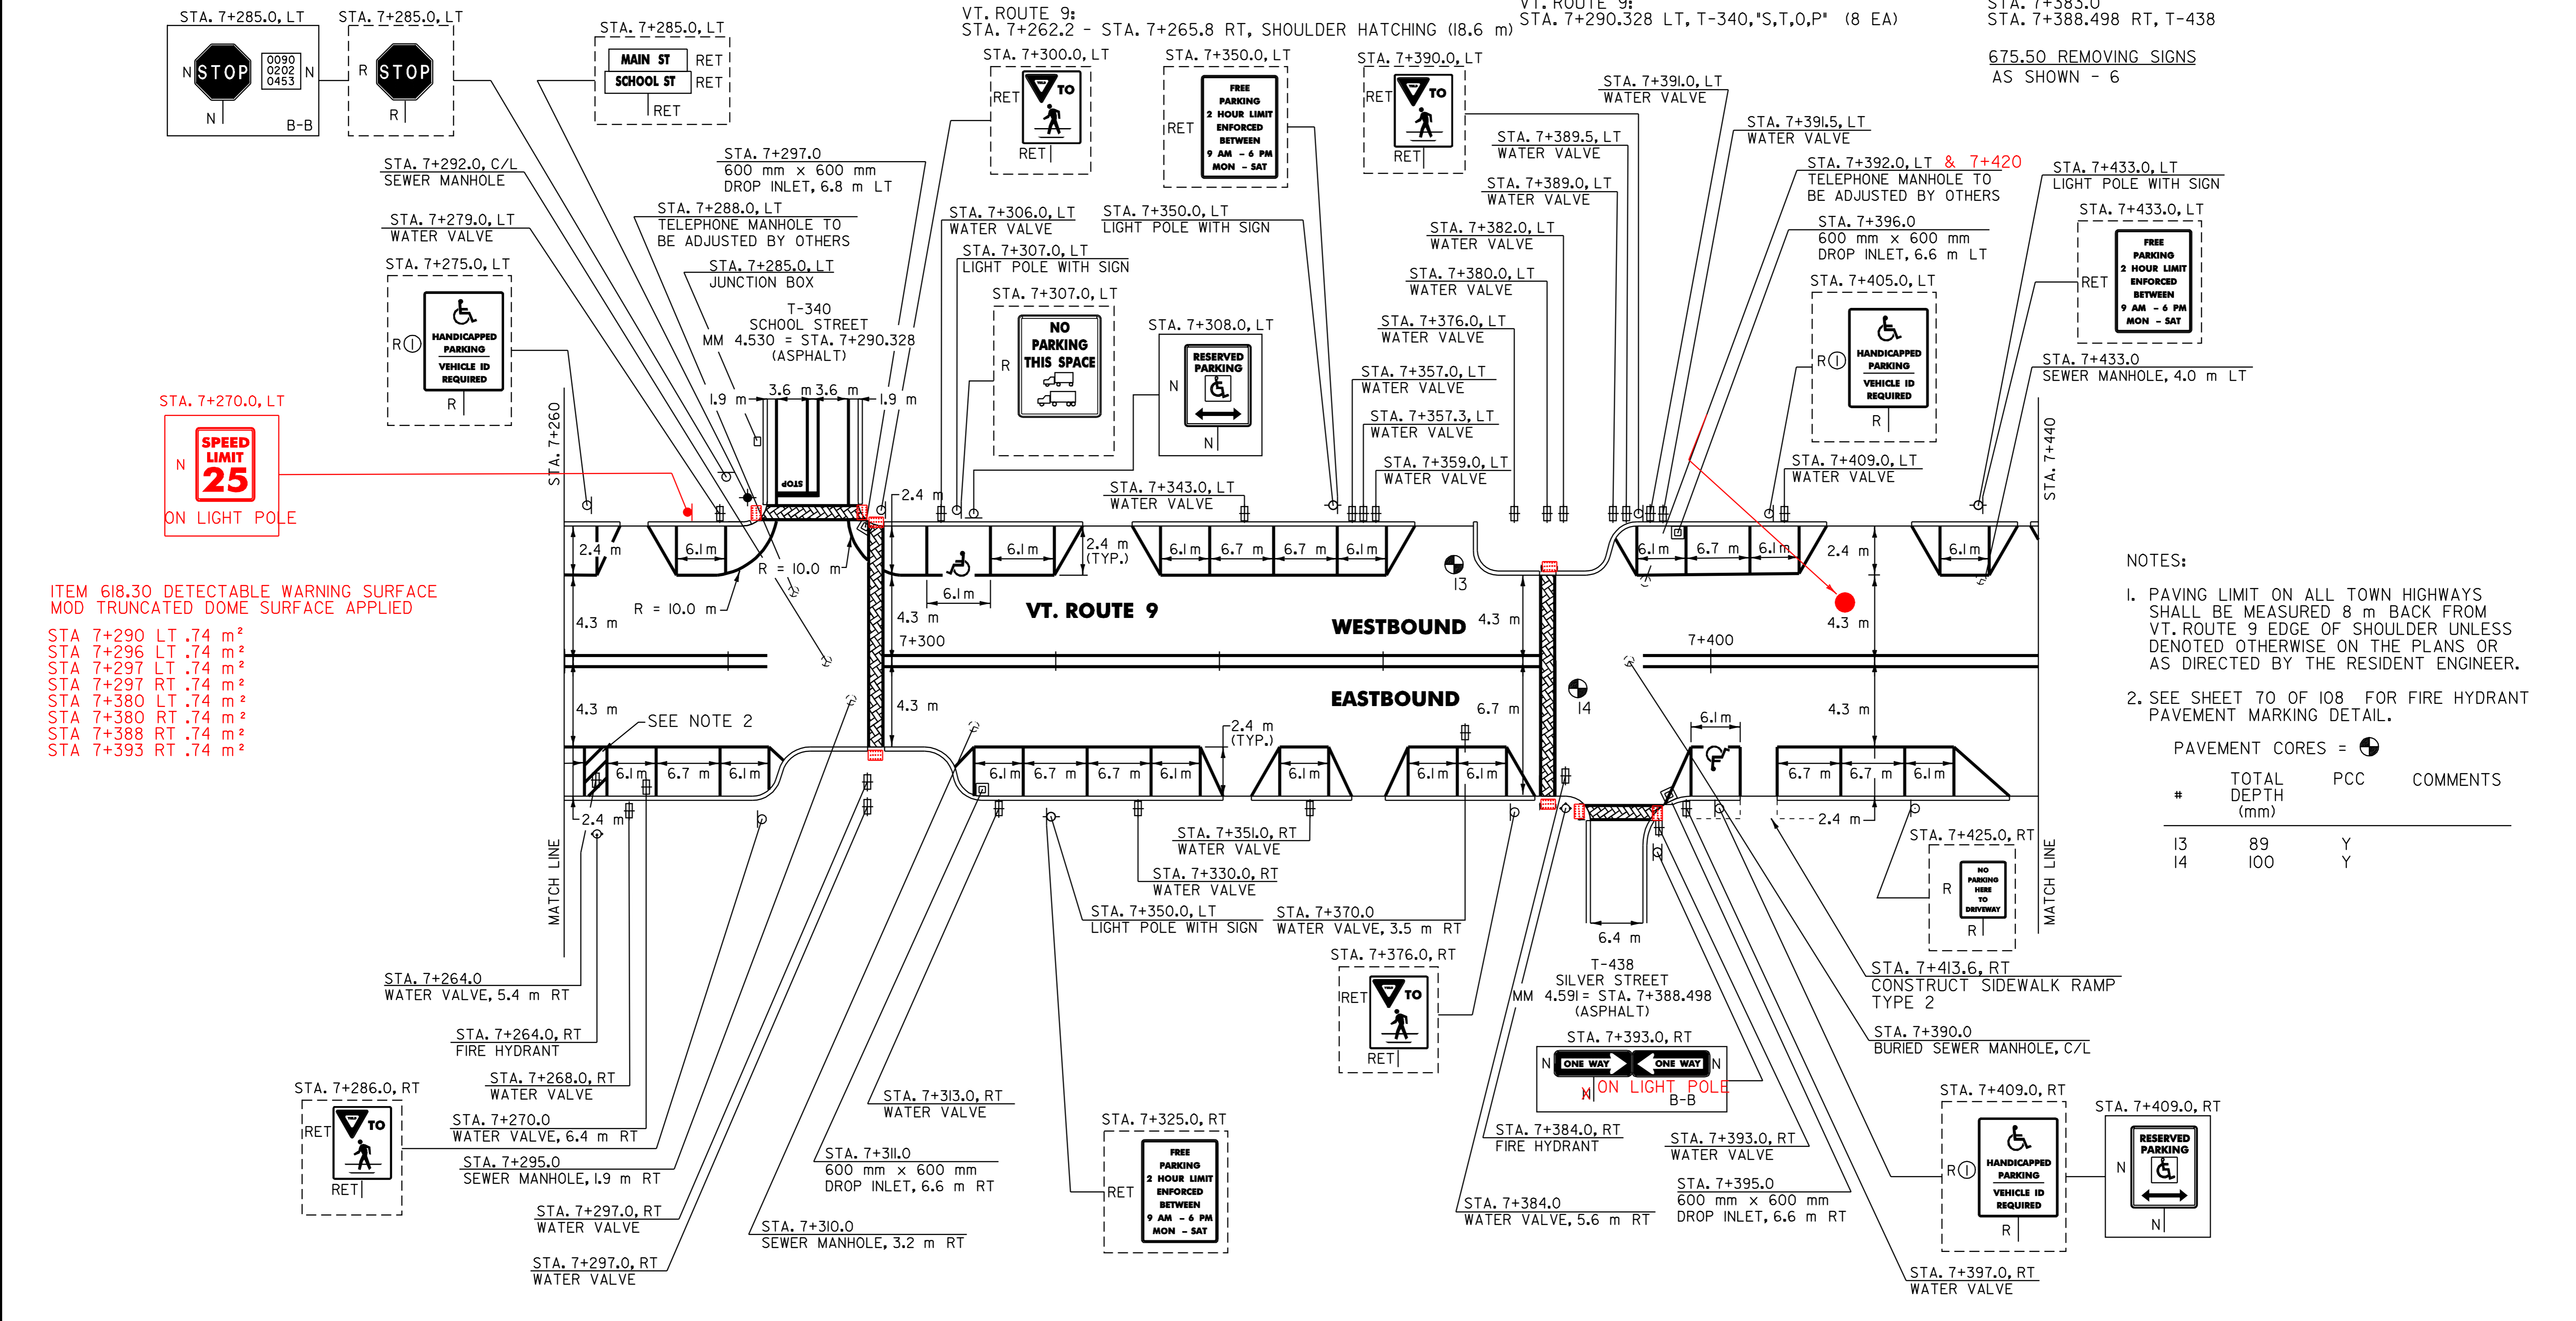

ITEM 618.30 DETECTABLE WARNING SURFACE MOD TRUNCATED DOME SURFACE APPLIED
 STA 7+290 LT .74 m²
 STA 7+296 LT .74 m²
 STA 7+297 LT .74 m²
 STA 7+297 RT .74 m²
 STA 7+380 LT .74 m²
 STA 7+380 RT .74 m²
 STA 7+388 RT .74 m²
 STA 7+393 RT .74 m²

- NOTES:**
- PAVING LIMIT ON ALL TOWN HIGHWAYS SHALL BE MEASURED 8 m BACK FROM VT. ROUTE 9 EDGE OF SHOULDER UNLESS DENOTED OTHERWISE ON THE PLANS OR AS DIRECTED BY THE RESIDENT ENGINEER.
 - SEE SHEET 70 OF 108 FOR FIRE HYDRANT PAVEMENT MARKING DETAIL.

PAVEMENT CORES =

#	TOTAL DEPTH (mm)	PCC	COMMENTS
13	89	Y	
14	100	Y	

604.40 CHANGE ELEVATION OF DI, CB OR MH 604.42 CHANGE ELEVATION OF SEWER MANHOLE 629.20 ADJUST ELEVATION OF VALVE BOX

DATUM

VERTICAL	N/A
HORIZONTAL	N/A

VT. ROUTE 9:
 STA. 7+297.0 LT
 STA. 7+311.0 RT
 STA. 7+395.0 RT
 STA. 7+396.0 LT

VT. ROUTE 9:
 STA. 7+297.0 C/L
 STA. 7+295.0 RT
 STA. 7+310.0 RT
 STA. 7+390.0 C/L
 STA. 7+433.0 LT

VT. ROUTE 9:
 STA. 7+264.0 RT
 STA. 7+270.0 RT
 STA. 7+370.0 RT
 STA. 7+384.0 RT

SIGN LEGEND
 R= REMOVE
 S= SALVAGE
 N= NEW
 RET= RETAIN
 B-B= BACK TO BACK
 EXISTING= -----
 NEW= _____
 (1) = SIGN TO BE RETURNED TO THE TOWN OF BENNINGTON

PAVING PROJECT LAYOUT # 13

SURVEYED BY N/A DATE N/A
 DRAWN BY J.A.R. DATE 4/01
 SQUAD LEADER T.P.K.

DESIGN FILE NO. pave/99d156/pd156.dgn
 IPARM FILE pd156113.1 DATE PLOT 4/11/2005 10:47

PROJ. NAME BENNINGTON
 PROJ. NO. NH 2202(1)S
 SHEET 26 OF 108 SHEETS

646.40 DURABLE 100 mm WHITE LINE
 (ALL LINES WILL INCLUDE EDGE LINE BREAKS AND RADIUS FOR TOWN HIGHWAYS)

VT. ROUTE 9:
 STA. 7+447.6 - STA. 7+466.5 LT, PARKING SPACES
 STA. 7+454.4 - STA. 7+480.0 RT, PARKING SPACES
 STA. 7+476.9 - STA. 7+483.0 LT, PARKING SPACES
 STA. 7+480.0 - STA. 7+620.0 RT
 STA. 7+483.0 - STA. 7+620.0 LT

646.60 TEMPORARY 100 mm WHITE LINE
 (ALL LINES WILL INCLUDE EDGE LINE BREAKS AND RADIUS FOR TOWN HIGHWAYS)

VT. ROUTE 9:
 STA. 7+447.6 - STA. 7+466.5 LT, PARKING SPACES
 STA. 7+454.4 - STA. 7+480.0 RT, PARKING SPACES
 STA. 7+476.9 - STA. 7+483.0 LT, PARKING SPACES
 STA. 7+480.0 - STA. 7+620.0 RT
 STA. 7+483.0 - STA. 7+620.0 LT

646.41 DURABLE 100 mm YELLOW LINE
 (ALL LINES WILL INCLUDE C/L BREAKS FOR TOWN HIGHWAYS) S=SOLID, D=DASHED

VT. ROUTE 9:
 STA. 7+440.0 - STA. 7+620.0 LT S - S

646.61 TEMPORARY 100 mm YELLOW LINE
 (ALL LINES WILL INCLUDE C/L BREAKS FOR TOWN HIGHWAYS) S=SOLID, D=DASHED

VT. ROUTE 9:
 STA. 7+440.0 - STA. 7+620.0 LT S - S

646.42 DURABLE 200 mm WHITE LINE

VT. ROUTE 9:
 STA. 7+501.2 - STA. 7+504.8 RT, SHOULDER HATCHING (18.6 m)
 STA. 7+605.2 - STA. 7+608.8 RT, SHOULDER HATCHING (18.6 m)

646.51 DURABLE CROSSWALK MARKINGS WITH DIAGONAL LINES (MOD.)

VT. ROUTE 9:
 STA. 7+490.0
 STA. 7+496.324 RT, T-442
 STA. 7+496.324 LT, T-442

646.71 TEMPORARY CROSSWALK MARKINGS WITH DIAGONAL LINES

VT. ROUTE 9:
 STA. 7+490.0
 STA. 7+496.324 RT, T-442
 STA. 7+496.324 LT, T-442

646.46 DURABLE 600 mm STOP BAR (TYPE 1 TAPE)

VT. ROUTE 9:
 STA. 7+496.324 RT, T-442

646.66 TEMPORARY 600 mm STOP BAR

VT. ROUTE 9:
 STA. 7+496.324 RT, T-442

646.50 DURABLE LETTER OR SYMBOL (TYPE 1 TAPE)

VT. ROUTE 9:
 STA. 7+496.324 RT, T-442, "S,T,O,P" (4 EA)

646.70 TEMPORARY LETTER OR SYMBOL

VT. ROUTE 9:
 STA. 7+496.324 RT, T-442, "S,T,O,P" (8 EA)


675.50 REMOVING SIGNS
 AS SHOWN - 9

ITEM 618.30 DETECTABLE WARNING SURFACE
 MOD TRUNCATED DOME SURFACE APPLIED

VT ROUTE 9
 STA 7+483 RT .743 m²
 STA 7+483 LT .743 m²
 STA 7+493 RT .929 m²
 STA 7+493 LT .929 m²

ITEM 618.30 DETECTABLE WARNING SURFACE
 MOD TRUNCATED DOME CAST IN PLACE

VT ROUTE 9
 STA 7+502 LT .929 m²
 STA 7+502 RT .929 m²

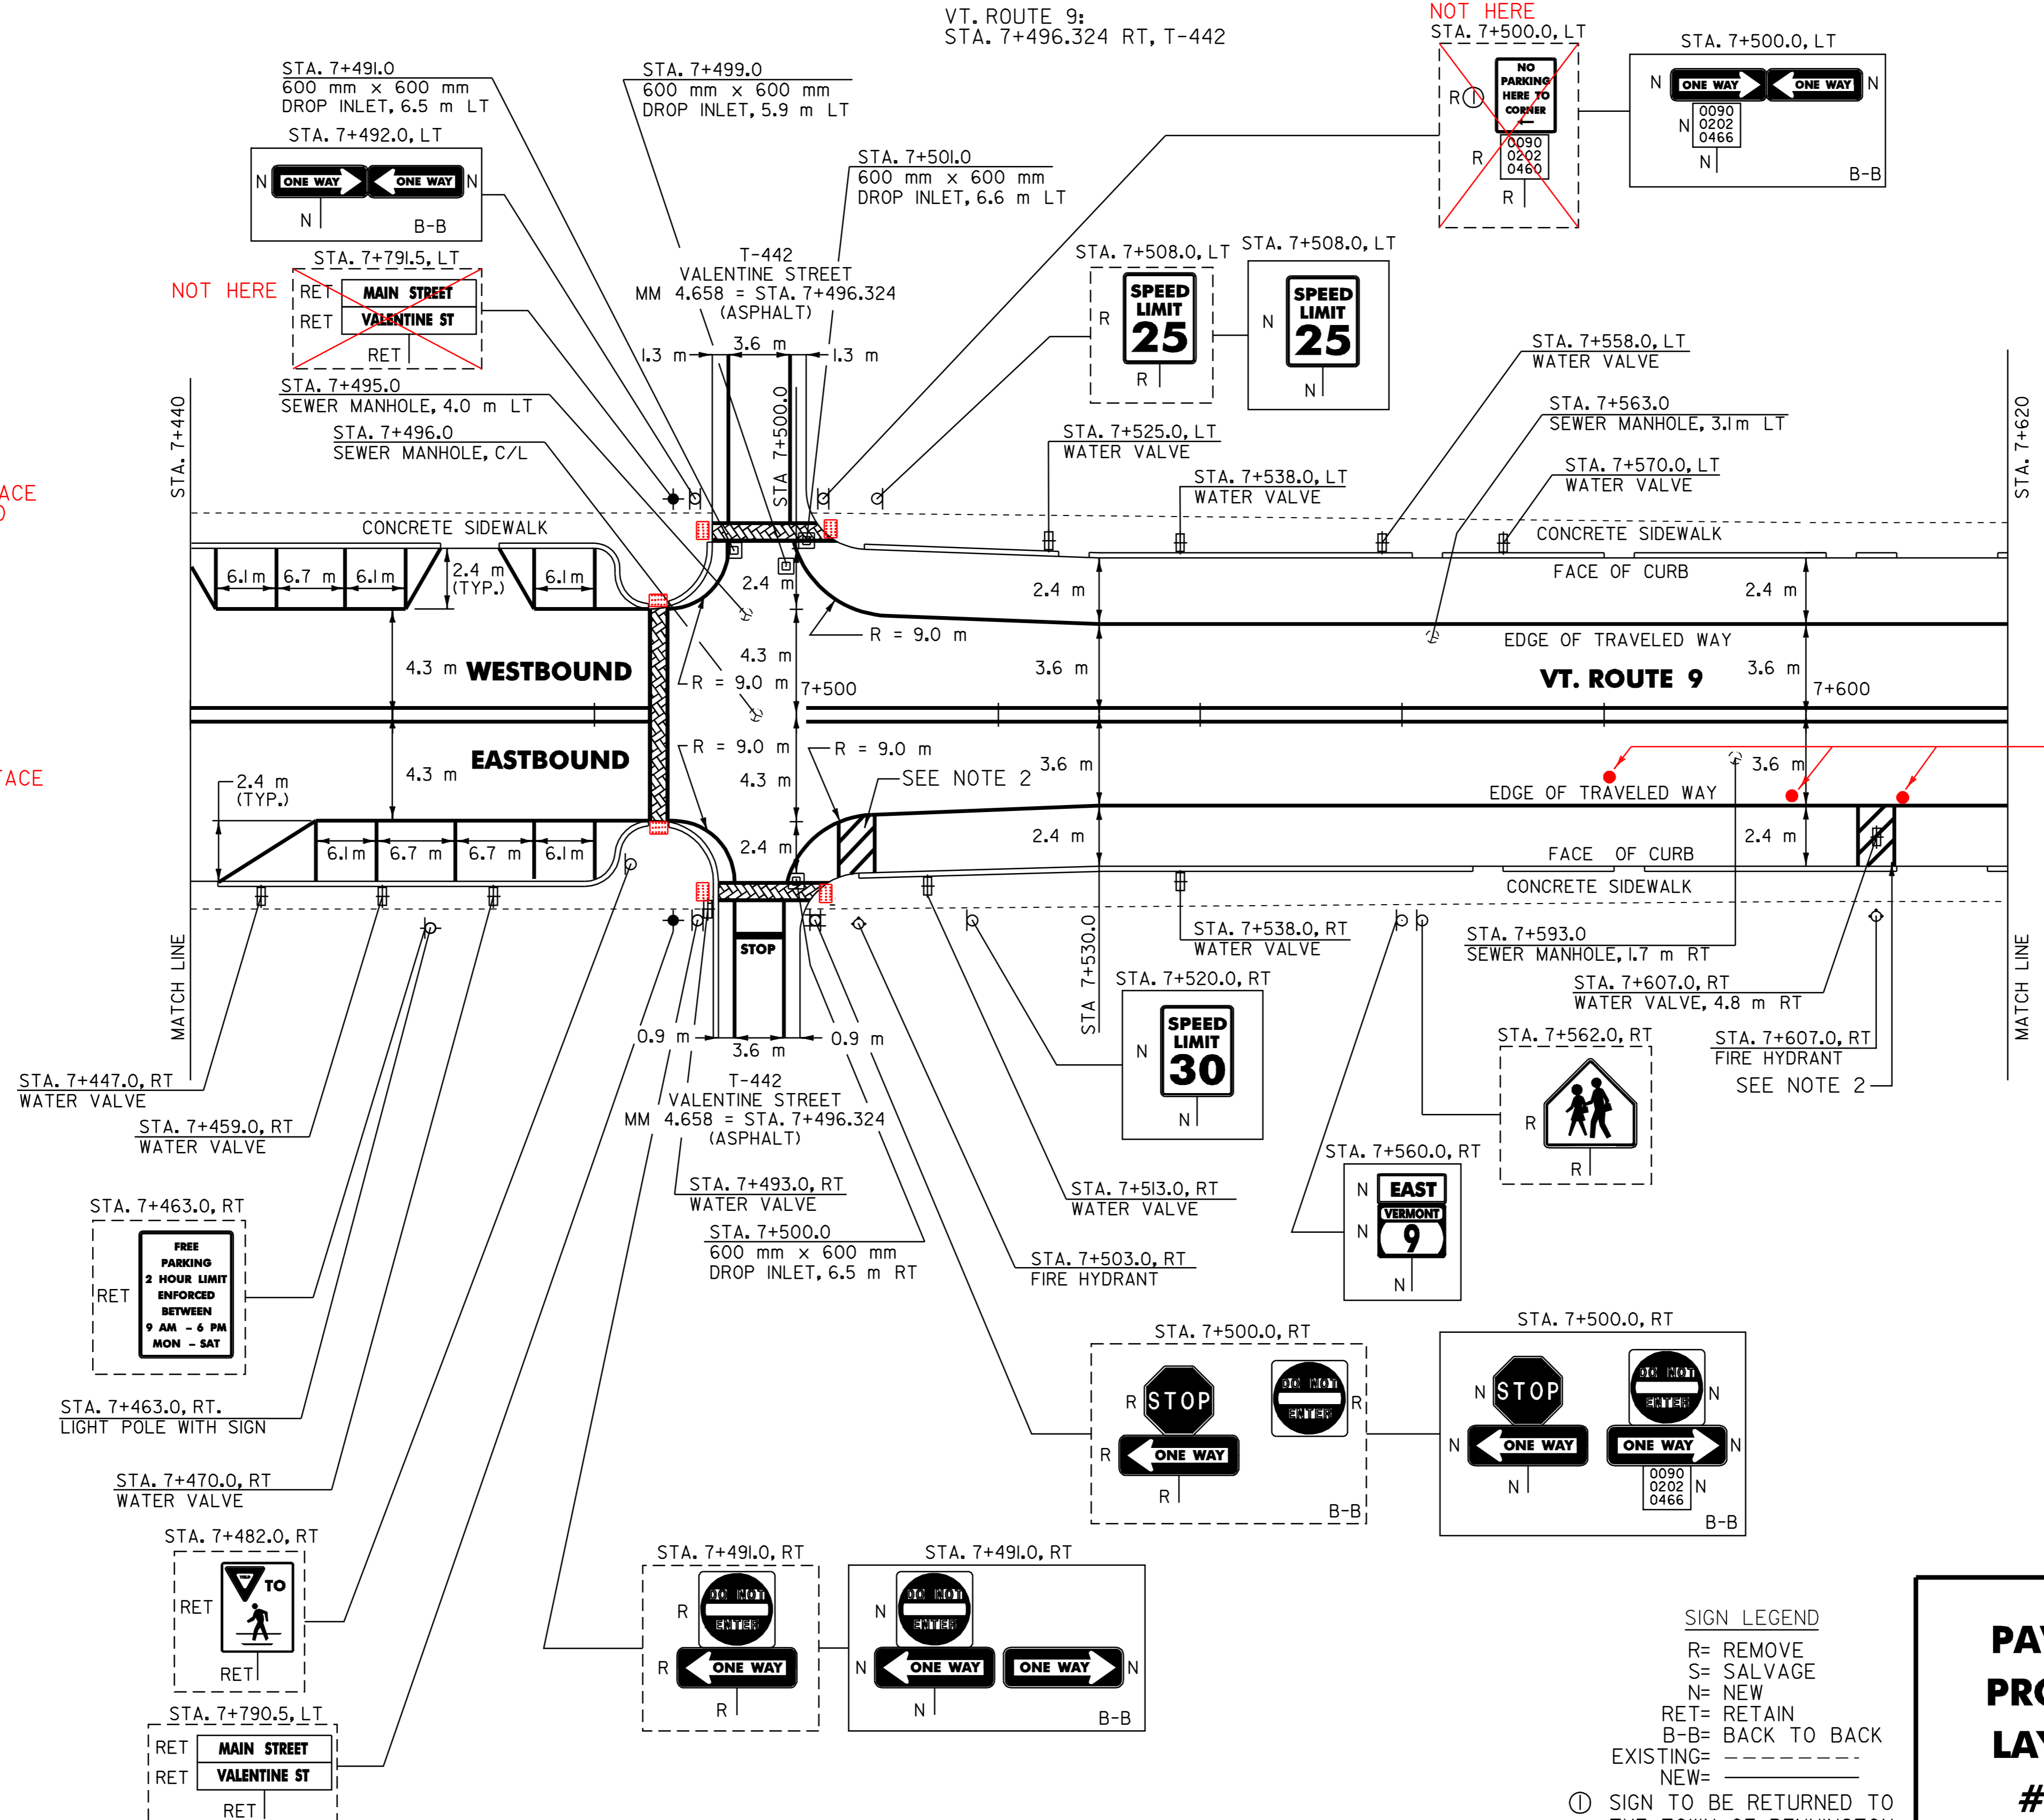

604.40 CHANGE ELEVATION OF DI, CB OR MH

VT. ROUTE 9:
 STA. 7+491.0 LT
 STA. 7+499.0 LT
 STA. 7+500.0 RT
 STA. 7+501.0 LT

604.42 CHANGE ELEVATION OF SEWER MANHOLE

VT. ROUTE 9:
 STA. 7+495.0 LT
 STA. 7+496.0 C/L
 STA. 7+563.0 LT
 STA. 7+593.0 RT

629.20 ADJUST ELEVATION OF VALVE BOX

VT. ROUTE 9:
 STA. 7+607.0 RT

NOTES:

- PAVING LIMIT ON ALL TOWN HIGHWAYS SHALL BE MEASURED 8 m BACK FROM VT. ROUTE 9 EDGE OF SHOULDER UNLESS DENOTED OTHERWISE ON THE PLANS OR AS DIRECTED BY THE RESIDENT ENGINEER.
- SEE SHEET 70 OF 108 FOR FIRE HYDRANT PAVEMENT MARKING DETAIL.

DATUM	
VERTICAL	N/A
HORIZONTAL	N/A

SIGN LEGEND

R= REMOVE
 S= SALVAGE
 N= NEW
 RET= RETAIN
 B-B= BACK TO BACK
 EXISTING= _____
 NEW= _____

Ⓢ SIGN TO BE RETURNED TO THE TOWN OF BENNINGTON

PAVING PROJECT LAYOUT # 14

SURVEYED BY	N/A	DATE	N/A
DRAWN BY	J.A.R.	DATE	4/01
SQUAD LEADER	T.P.K.		
DESIGN FILE NO.	_pave/99dl56/pdl56.dgn		
IPARM FILE	_pdl56ll4.l	DATE PLOT	7th NOV-2005 10
PROJ. NAME	BENNINGTON		
PROJ. NO.	NH 2202(1)S		
SHEET 27 OF 108		SHEETS	

646.40 DURABLE 100 mm WHITE LINE
 (ALL LINES WILL INCLUDE EDGE LINE BREAKS AND RADIUS FOR TOWN HIGHWAYS)
 VT. ROUTE 9:
 STA. 7+620.0 - STA. 7+800.0 LT & RT

646.41 DURABLE 100 mm YELLOW LINE
 (ALL LINES WILL INCLUDE C/L BREAKS FOR TOWN HIGHWAYS) S=SOLID, D=DASHED
 VT. ROUTE 9:
 STA. 7+620.0 - STA. 7+800.0 LT Q RT
 S - S

646.42 DURABLE 200 mm WHITE LINE
 VT. ROUTE 9:
 STA. 7+747.2 - STA. 7+750.8 RT, SHOULDER HATCHING (18.6)

646.51 DURABLE CROSSWALK MARKINGS WITH DIAGONAL LINES (MOD.2)
 VT. ROUTE 9:
 STA. 7+725.0


646.60 TEMPORARY 100 mm WHITE LINE
 (ALL LINES WILL INCLUDE EDGE LINE BREAKS AND RADIUS FOR TOWN HIGHWAYS)
 VT. ROUTE 9:
 STA. 7+620.0 - STA. 7+800.0 LT & RT

646.61 TEMPORARY 100 mm YELLOW LINE
 (ALL LINES WILL INCLUDE C/L BREAKS FOR TOWN HIGHWAYS) S=SOLID, D=DASHED
 VT. ROUTE 9:
 STA. 7+620.0 - STA. 7+800.0 LT Q RT
 S - S

646.71 TEMPORARY CROSSWALK MARKINGS WITH DIAGONAL LINES
 VT. ROUTE 9:
 STA. 7+725.0
 675.50 REMOVING SIGNS
 AS SHOWN - 7
 675.60 ERECTING SALVAGED SIGNS
 AS SHOWN - 4

646.60 TEMPORARY 100 mm WHITE LINE
 (ALL LINES WILL INCLUDE EDGE LINE BREAKS AND RADIUS FOR TOWN HIGHWAYS)
 VT. ROUTE 9:
 STA. 7+620.0 - STA. 7+800.0 LT & RT

646.61 TEMPORARY 100 mm YELLOW LINE
 (ALL LINES WILL INCLUDE C/L BREAKS FOR TOWN HIGHWAYS) S=SOLID, D=DASHED
 VT. ROUTE 9:
 STA. 7+620.0 - STA. 7+800.0 LT Q RT
 S - S

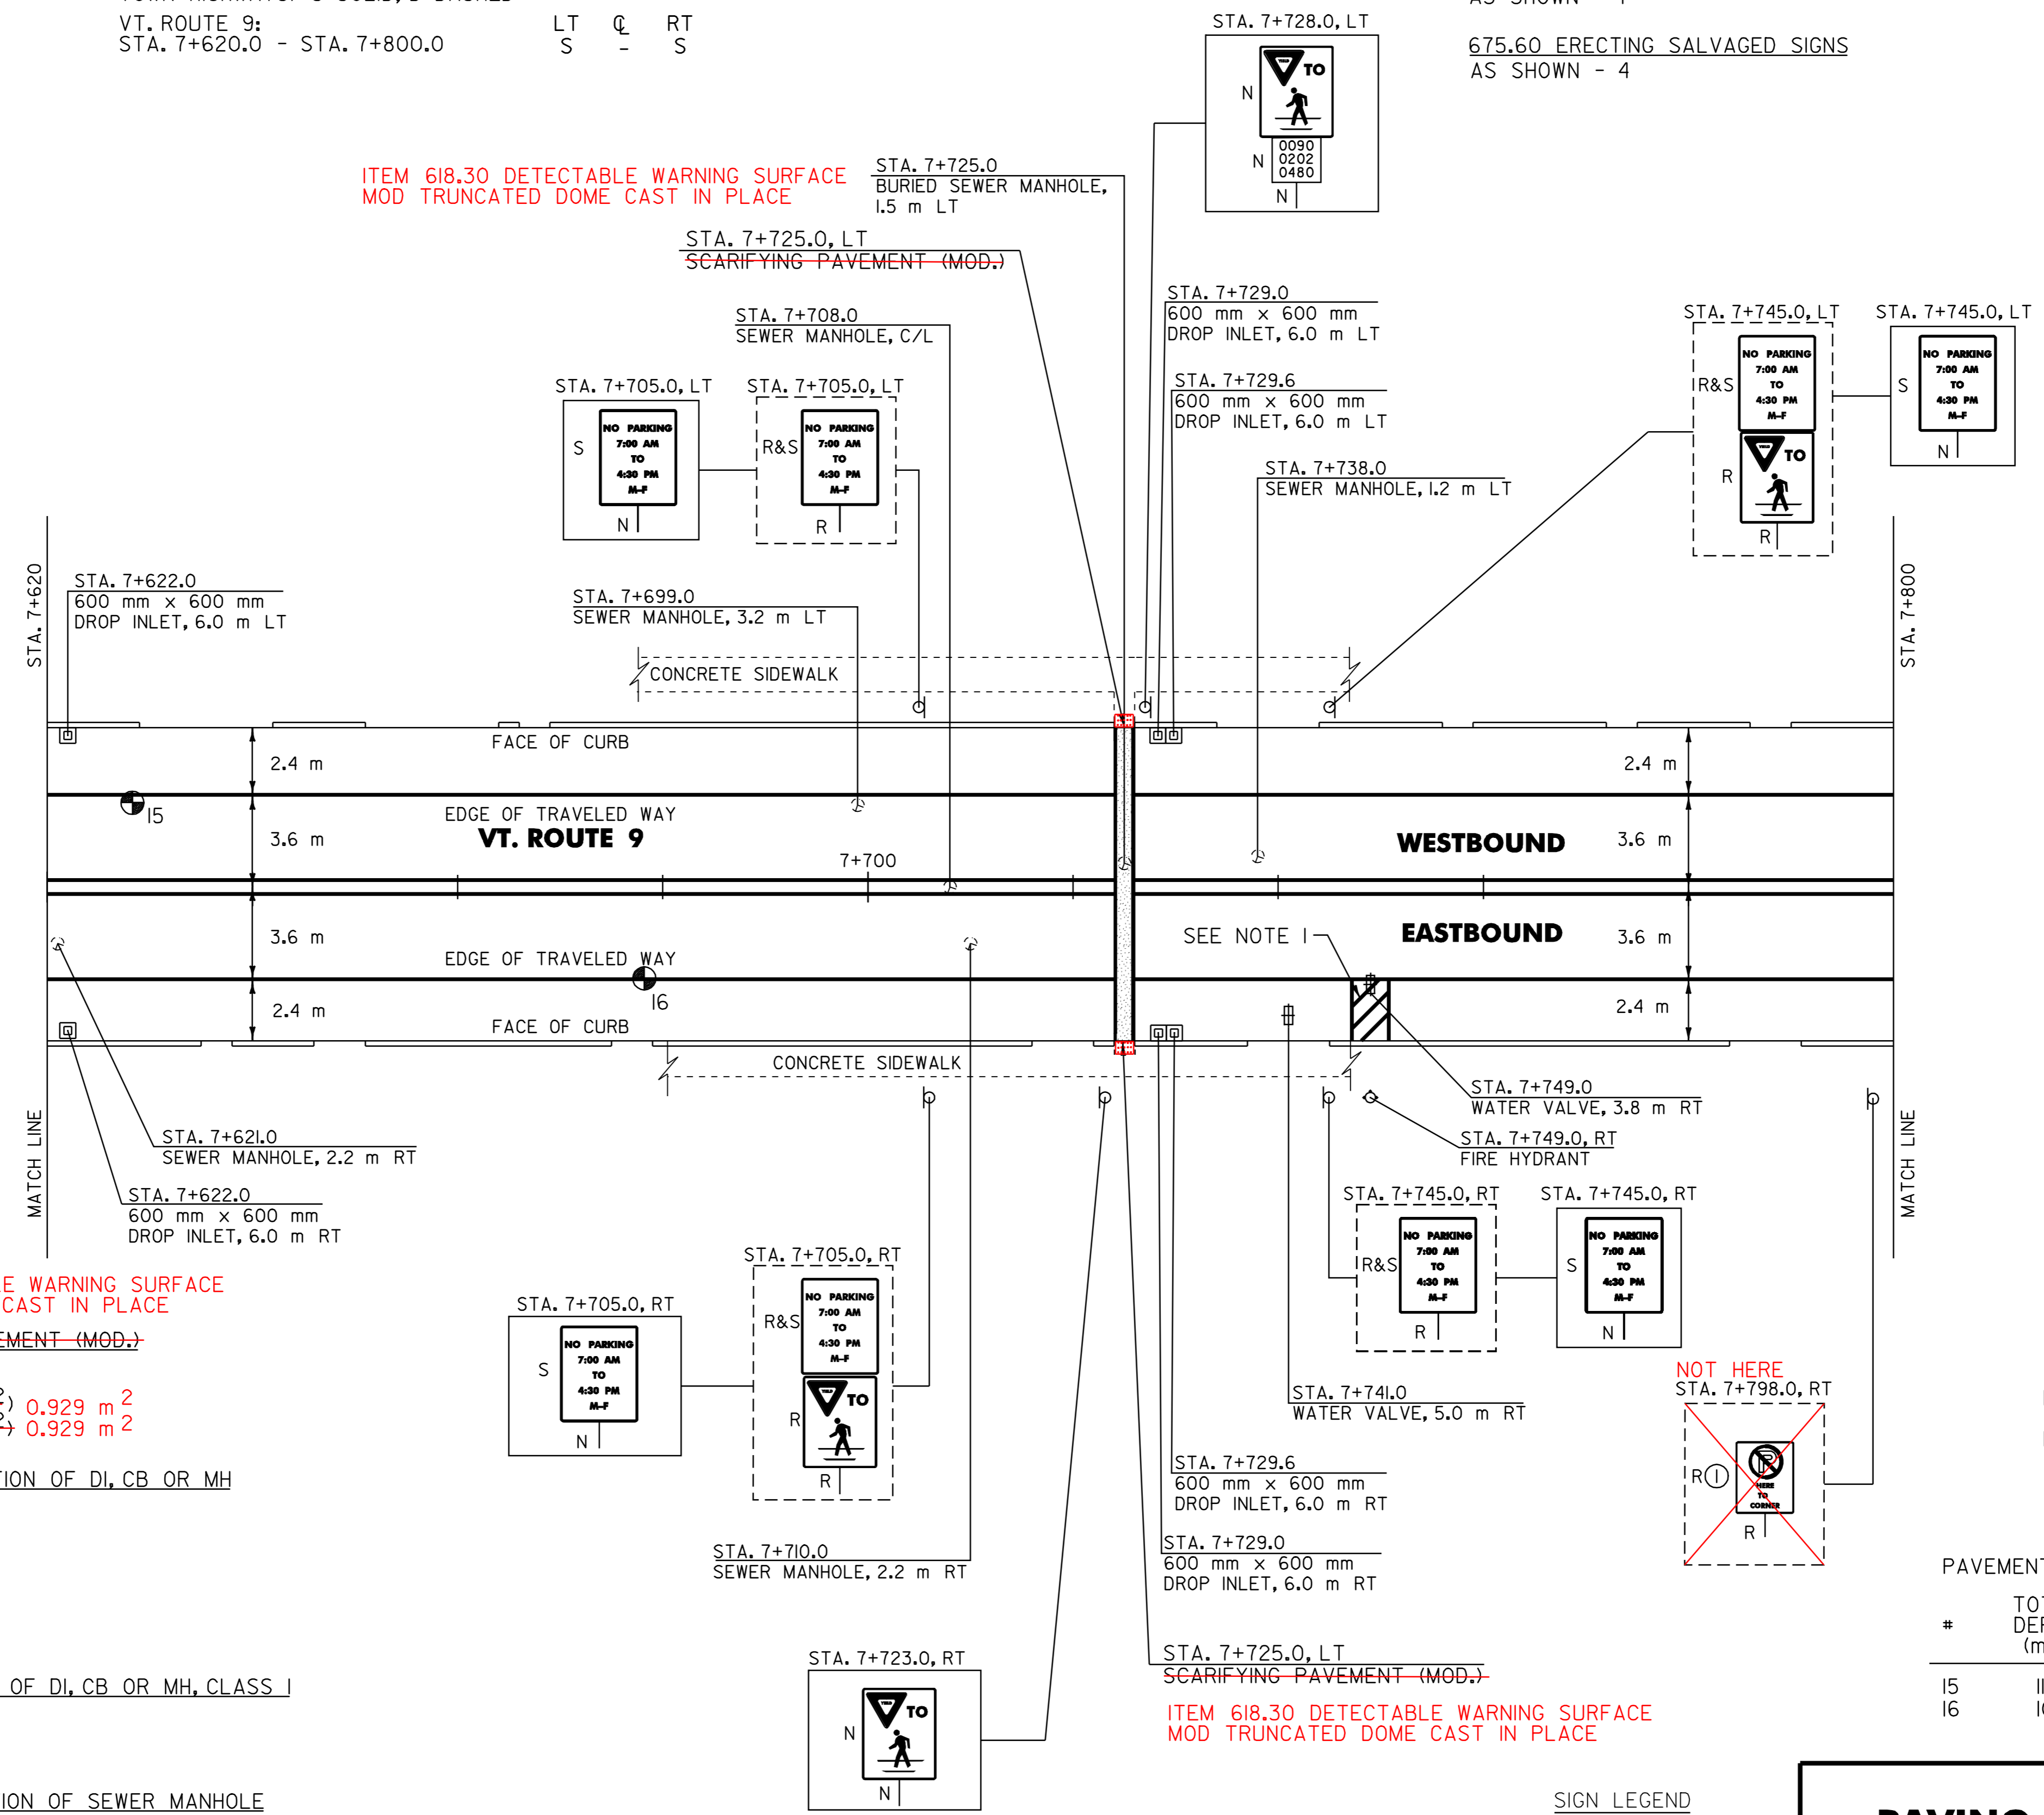

ITEM 618.30 DETECTABLE WARNING SURFACE
 MOD TRUNCATED DOME CAST IN PLACE
 STA. 7+725.0, LT
 BURIED SEWER MANHOLE,
 1.5 m LT
 STA. 7+725.0, LT
 SCARIFYING PAVEMENT (MOD.)

ITEM 618.30 DETECTABLE WARNING SURFACE
 MOD TRUNCATED DOME CAST IN PLACE
 212.20 SCARIFYING PAVEMENT (MOD.)

VT. ROUTE 9:
 STA. 7+725.0 RT (3 m²) 0.929 m²
 STA. 7+725.0 LT (3 m²) 0.929 m²

604.40 CHANGE ELEVATION OF DI, CB OR MH

VT. ROUTE 9:
 STA. 7+622.0 LT
 STA. 7+729.0 RT
 STA. 7+729.0 LT
 STA. 7+729.6 RT
 STA. 7+729.6 LT

604.412 REHABILITATION OF DI, CB OR MH, CLASS 1


VT. ROUTE 9:
 STA. 7+622.0 RT

604.42 CHANGE ELEVATION OF SEWER MANHOLE

VT. ROUTE 9:
 STA. 7+621.0 RT
 STA. 7+699.0 LT
 STA. 7+708.0 C/L
 STA. 7+710.0 RT
 STA. 7+725.0 LT
 STA. 7+738.0 LT

629.20 ADJUST ELEVATION OF VALVE BOX

VT. ROUTE 9:
 STA. 7+741.0 RT
 STA. 7+749.0 RT

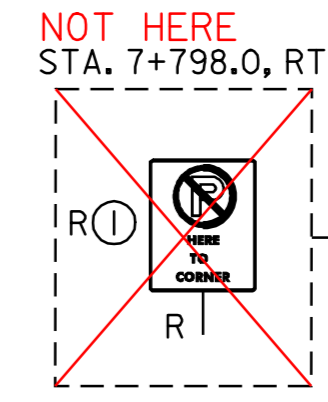

NOTE:
 1. SEE SHEET 70 OF I08 FIRE HYDRANT PAVEMENT MARKING DETAIL.

PAVEMENT CORES =

#	TOTAL DEPTH (mm)	PCC	COMMENTS
15	114	Y	
16	102	Y	

SIGN LEGEND
 R= REMOVE
 S= SALVAGE
 N= NEW
 RET= RETAIN
 B-B= BACK TO BACK
 EXISTING= -----
 NEW= _____
 (1) SIGN TO BE RETURNED TO THE TOWN OF BENNINGTON

PAVING PROJECT LAYOUT # 15

SURVEYED BY N/A DATE N/A
 DRAWN BY J.A.R. DATE 4/01
 SQUAD LEADER T.P.K.
 DESIGN FILE NO. pave/99dl56/pdl56.dgn
 IPARM pd156115.i DATE NOV-2005
 FILE PL074
 PROJ. NAME BENNINGTON
 PROJ. NO. NH 2202(1)S
 SHEET 28 OF 108 SHEETS

DATUM

VERTICAL	<u>N/A</u>
HORIZONTAL	<u>N/A</u>

646.40 DURABLE 100 mm WHITE LINE
(ALL LINES WILL INCLUDE EDGE LINE BREAKS AND RADIUS FOR TOWN HIGHWAYS)

VT. ROUTE 9:
STA. 7+800.0 - STA. 7+960.0 LT & RT

646.60 TEMPORARY 100 mm WHITE LINE
(ALL LINES WILL INCLUDE EDGE LINE BREAKS AND RADIUS FOR TOWN HIGHWAYS)

VT. ROUTE 9:
STA. 7+800.0 - STA. 7+960.0 LT & RT

646.41 DURABLE 100 mm YELLOW LINE
(ALL LINES WILL INCLUDE C/L BREAKS FOR TOWN HIGHWAYS) S=SOLID, D=DASHED

VT. ROUTE 9:
STA. 7+800.0 - STA. 7+876.7 LT S RT S
STA. 7+907.3 - STA. 7+960.0 S - S
STA. 7+821.412 DOUBLE SOLID RT, T-430
STA. 7+821.412 DOUBLE SOLID LT, T-342
STA. 7+890.614 DOUBLE SOLID LT, T-360

646.61 TEMPORARY 100 mm YELLOW LINE
(ALL LINES WILL INCLUDE C/L BREAKS FOR TOWN HIGHWAYS) S=SOLID, D=DASHED

VT. ROUTE 9:
STA. 7+800.0 - STA. 7+876.7 LT S RT S
STA. 7+907.3 - STA. 7+960.0 S - S
STA. 7+821.412 DOUBLE SOLID RT, T-430
STA. 7+821.412 DOUBLE SOLID LT, T-342
STA. 7+890.614 DOUBLE SOLID LT, T-360

646.46 DURABLE 600 mm STOP BAR (TYPE ITAPE)

VT. ROUTE 9:
STA. 7+821.412 RT, T-430
STA. 7+821.412 LT, T-342
STA. 7+877.0 RT
STA. 7+890.614 LT, T-360
STA. 7+907.0 LT

646.66 TEMPORARY 600 mm STOP BAR

VT. ROUTE 9:
STA. 7+821.412 RT, T-430
STA. 7+821.412 LT, T-342
STA. 7+877.0 RT
STA. 7+890.614 LT, T-360
STA. 7+907.0 LT

646.50 DURABLE LETTER OR SYMBOL (TYPE ITAPE)

VT. ROUTE 9:
STA. 7+821.412 RT, T-430, "S,T,O,P" (4 EA)
STA. 7+821.412 LT, T-342, "S,T,O,P" (4 EA)

646.70 TEMPORARY LETTER OR SYMBOL

VT. ROUTE 9:
STA. 7+821.412 RT, T-430, "S,T,O,P" (8 EA)
STA. 7+821.412 LT, T-342, "S,T,O,P" (8 EA)

646.51 DURABLE CROSSWALK MARKINGS WITH DIAGONAL LINES (MOD.)

VT. ROUTE 9:
STA. 7+821.412 RT, T-430
STA. 7+821.412 LT, T-342
STA. 7+884.0
STA. 7+890.614 LT, T-360

646.71 TEMPORARY CROSSWALK MARKINGS WITH DIAGONAL LINES


VT. ROUTE 9:
STA. 7+821.412 RT, T-430
STA. 7+821.412 LT, T-342
STA. 7+884.0
STA. 7+890.614 LT, T-360

675.50 REMOVING SIGNS
AS SHOWN - 7

675.60 ERECTING SALVAGED SIGNS
AS SHOWN - 3

ITEM 618.30 DETECTABLE WARNING SURFACE
MOD TRUNCATED DOME CAST IN PLACE

STA. 7+825.0, LT
~~SCARIFYING PAVEMENT (MOD.)~~

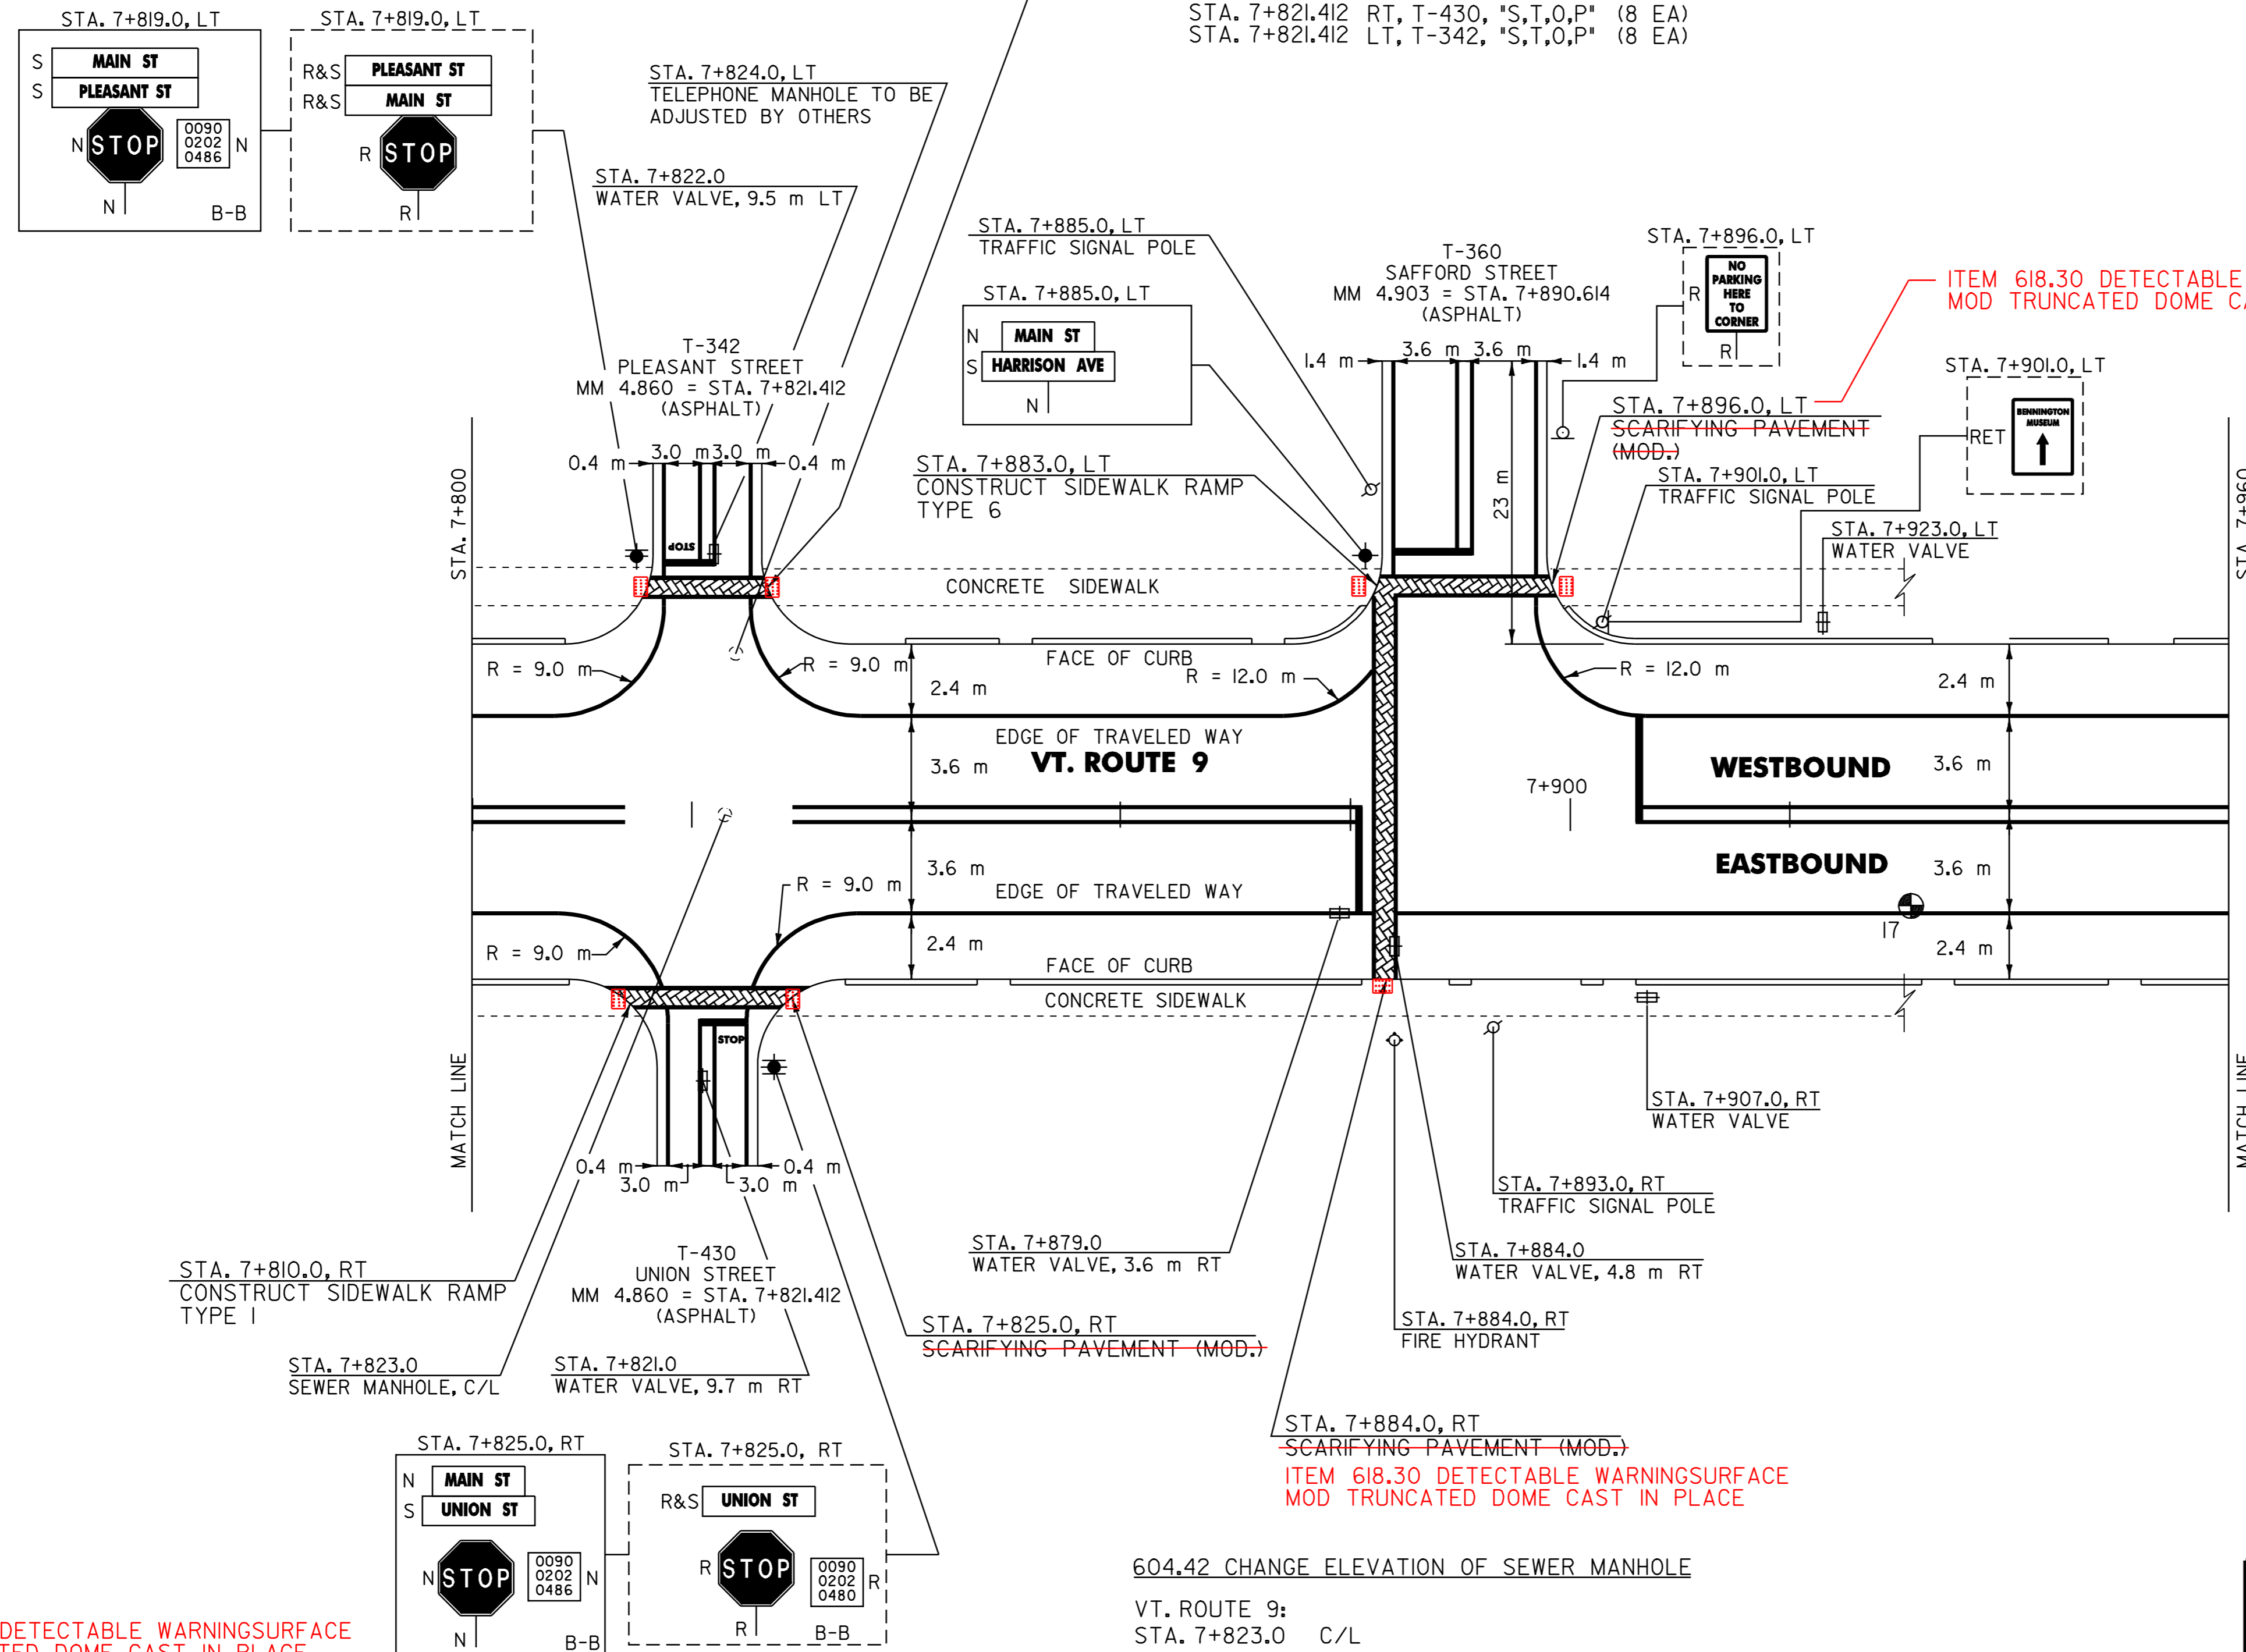

ITEM 618.30 DETECTABLE WARNING SURFACE
MOD TRUNCATED DOME CAST IN PLACE

ITEM 618.30 DETECTABLE WARNING SURFACE
MOD TRUNCATED DOME CAST IN PLACE

ITEM 618.30 DETECTABLE WARNING SURFACE
MOD TRUNCATED DOME CAST IN PLACE

~~212.20 SCARIFYING PAVEMENT (MOD.)~~

VT. ROUTE 9: STA 7+810 RT 0.29 m²
STA. 7+825.0 LT (5-m²) 0.929 m²
STA. 7+825.0 RT (5-m²) 0.929 m² STA 7+819 LT 0.929 m²
STA. 7+884.0 RT (3-m²) 0.929 m² STA 7+883 LT 1.858 m²
STA. 7+896.0 LT (5-m²) 0.929 m²

604.42 CHANGE ELEVATION OF SEWER MANHOLE

VT. ROUTE 9:
STA. 7+823.0 C/L

629.20 ADJUST ELEVATION OF VALVE BOX

VT. ROUTE 9:
STA. 7+821.0 RT
STA. 7+822.0 LT
STA. 7+879.0 RT
STA. 7+884.0 RT

NOTE:

1. PAVING LIMIT ON ALL TOWN HIGHWAYS SHALL BE MEASURED 8 m BACK FROM VT. ROUTE 9 EDGE OF SHOULDER UNLESS DENOTED OTHERWISE ON THE PLANS OR AS DIRECTED BY THE RESIDENT ENGINEER.

PAVEMENT CORES =

#	TOTAL DEPTH (mm)	PCC	COMMENTS
17	114	Y	

PAVING PROJECT LAYOUT # 16

SIGN LEGEND
R= REMOVE
S= SALVAGE
N= NEW
RET= RETAIN
B-B= BACK TO BACK
EXISTING= - - - - -
NEW= _____

SURVEYED BY N/A DATE N/A
DRAWN BY J.A.R. DATE 4/01
SQUAD LEADER T.P.K.
DESIGN FILE NO. pave/99dl56/pdl56.dgn
IPARM FILE pdl5116.1 DATE 4/01 NOV-2005 10
PROJ. NAME BENNINGTON
PROJ. NO. NH 2202(1)S
SHEET 29 OF 108 SHEETS

DATUM
VERTICAL N/A
HORIZONTAL N/A

646.40 DURABLE 100 mm WHITE LINE
(ALL LINES WILL INCLUDE EDGE LINE BREAKS AND RADIUS FOR TOWN HIGHWAYS)

VT. ROUTE 9:
STA. 7+960.0 - STA. 8+140.0 LT & RT

646.60 TEMPORARY 100 mm WHITE LINE
(ALL LINES WILL INCLUDE EDGE LINE BREAKS AND RADIUS FOR TOWN HIGHWAYS)

VT. ROUTE 9:
STA. 7+960.0 - STA. 8+140.0 LT & RT

646.41 DURABLE 100 mm YELLOW LINE
(ALL LINES WILL INCLUDE C/L BREAKS FOR TOWN HIGHWAYS) S=SOLID, D=DASHED

VT. ROUTE 9:
STA. 7+960.0 - STA. 7+977.7 S
STA. 8+005.0 - STA. 8+019.7 S
STA. 8+056.3 - STA. 8+140.0 S
STA. 7+998.440 DOUBLE SOLID RT, T-476
STA. 8+032.236 DOUBLE SOLID RT, T-3

646.61 TEMPORARY 100 mm YELLOW LINE
(ALL LINES WILL INCLUDE C/L BREAKS FOR TOWN HIGHWAYS) S=SOLID, D=DASHED

VT. ROUTE 9:
STA. 7+960.0 - STA. 7+977.7 S
STA. 8+005.0 - STA. 8+019.7 S
STA. 8+056.3 - STA. 8+140.0 S
STA. 7+998.440 DOUBLE SOLID RT, T-476
STA. 8+032.236 DOUBLE SOLID RT, T-3

646.42 DURABLE 200 mm WHITE LINE

VT. ROUTE 9:
STA. 8+058.2 - STA. 8+061.8 RT, SHOULDER HATCHING (16.3 m)

646.46 DURABLE 600 mm STOP BAR (TYPE ITAPE)

VT. ROUTE 9:
STA. 7+978.0 RT 7+988
STA. 7+998.440 RT, T-476
STA. 8+020.0 RT
STA. 8+032.236 RT, T-3
STA. 8+056.0 LT

646.46 DURABLE 600 mm STOP BAR (TYPE ITAPE)

VT. ROUTE 9:
STA. 7+978.0 RT
STA. 7+998.440 RT, T-476
STA. 8+020.0 RT
STA. 8+032.236 RT, T-3
STA. 8+056.0 LT

646.50 DURABLE LETTER OR SYMBOL (TYPE ITAPE)

VT. ROUTE 9:
STA. 7+998.440 RT, T-476, "S,T,O,P" (4 EA)

646.70 TEMPORARY LETTER OR SYMBOL


VT. ROUTE 9:
STA. 7+998.440 RT, T-476, "S,T,O,P" (8 EA)

646.51 DURABLE CROSSWALK MARKINGS WITH DIAGONAL LINES (MOD 2)

VT. ROUTE 9:
STA. 7+998.440 RT, T-476
STA. 8+027.0
STA. 8+032.236 RT, T-3

646.71 TEMPORARY CROSSWALK MARKINGS WITH DIAGONAL LINES

VT. ROUTE 9:
STA. 7+998.440 RT, T-476
STA. 8+027.0
STA. 8+032.236 RT, T-3

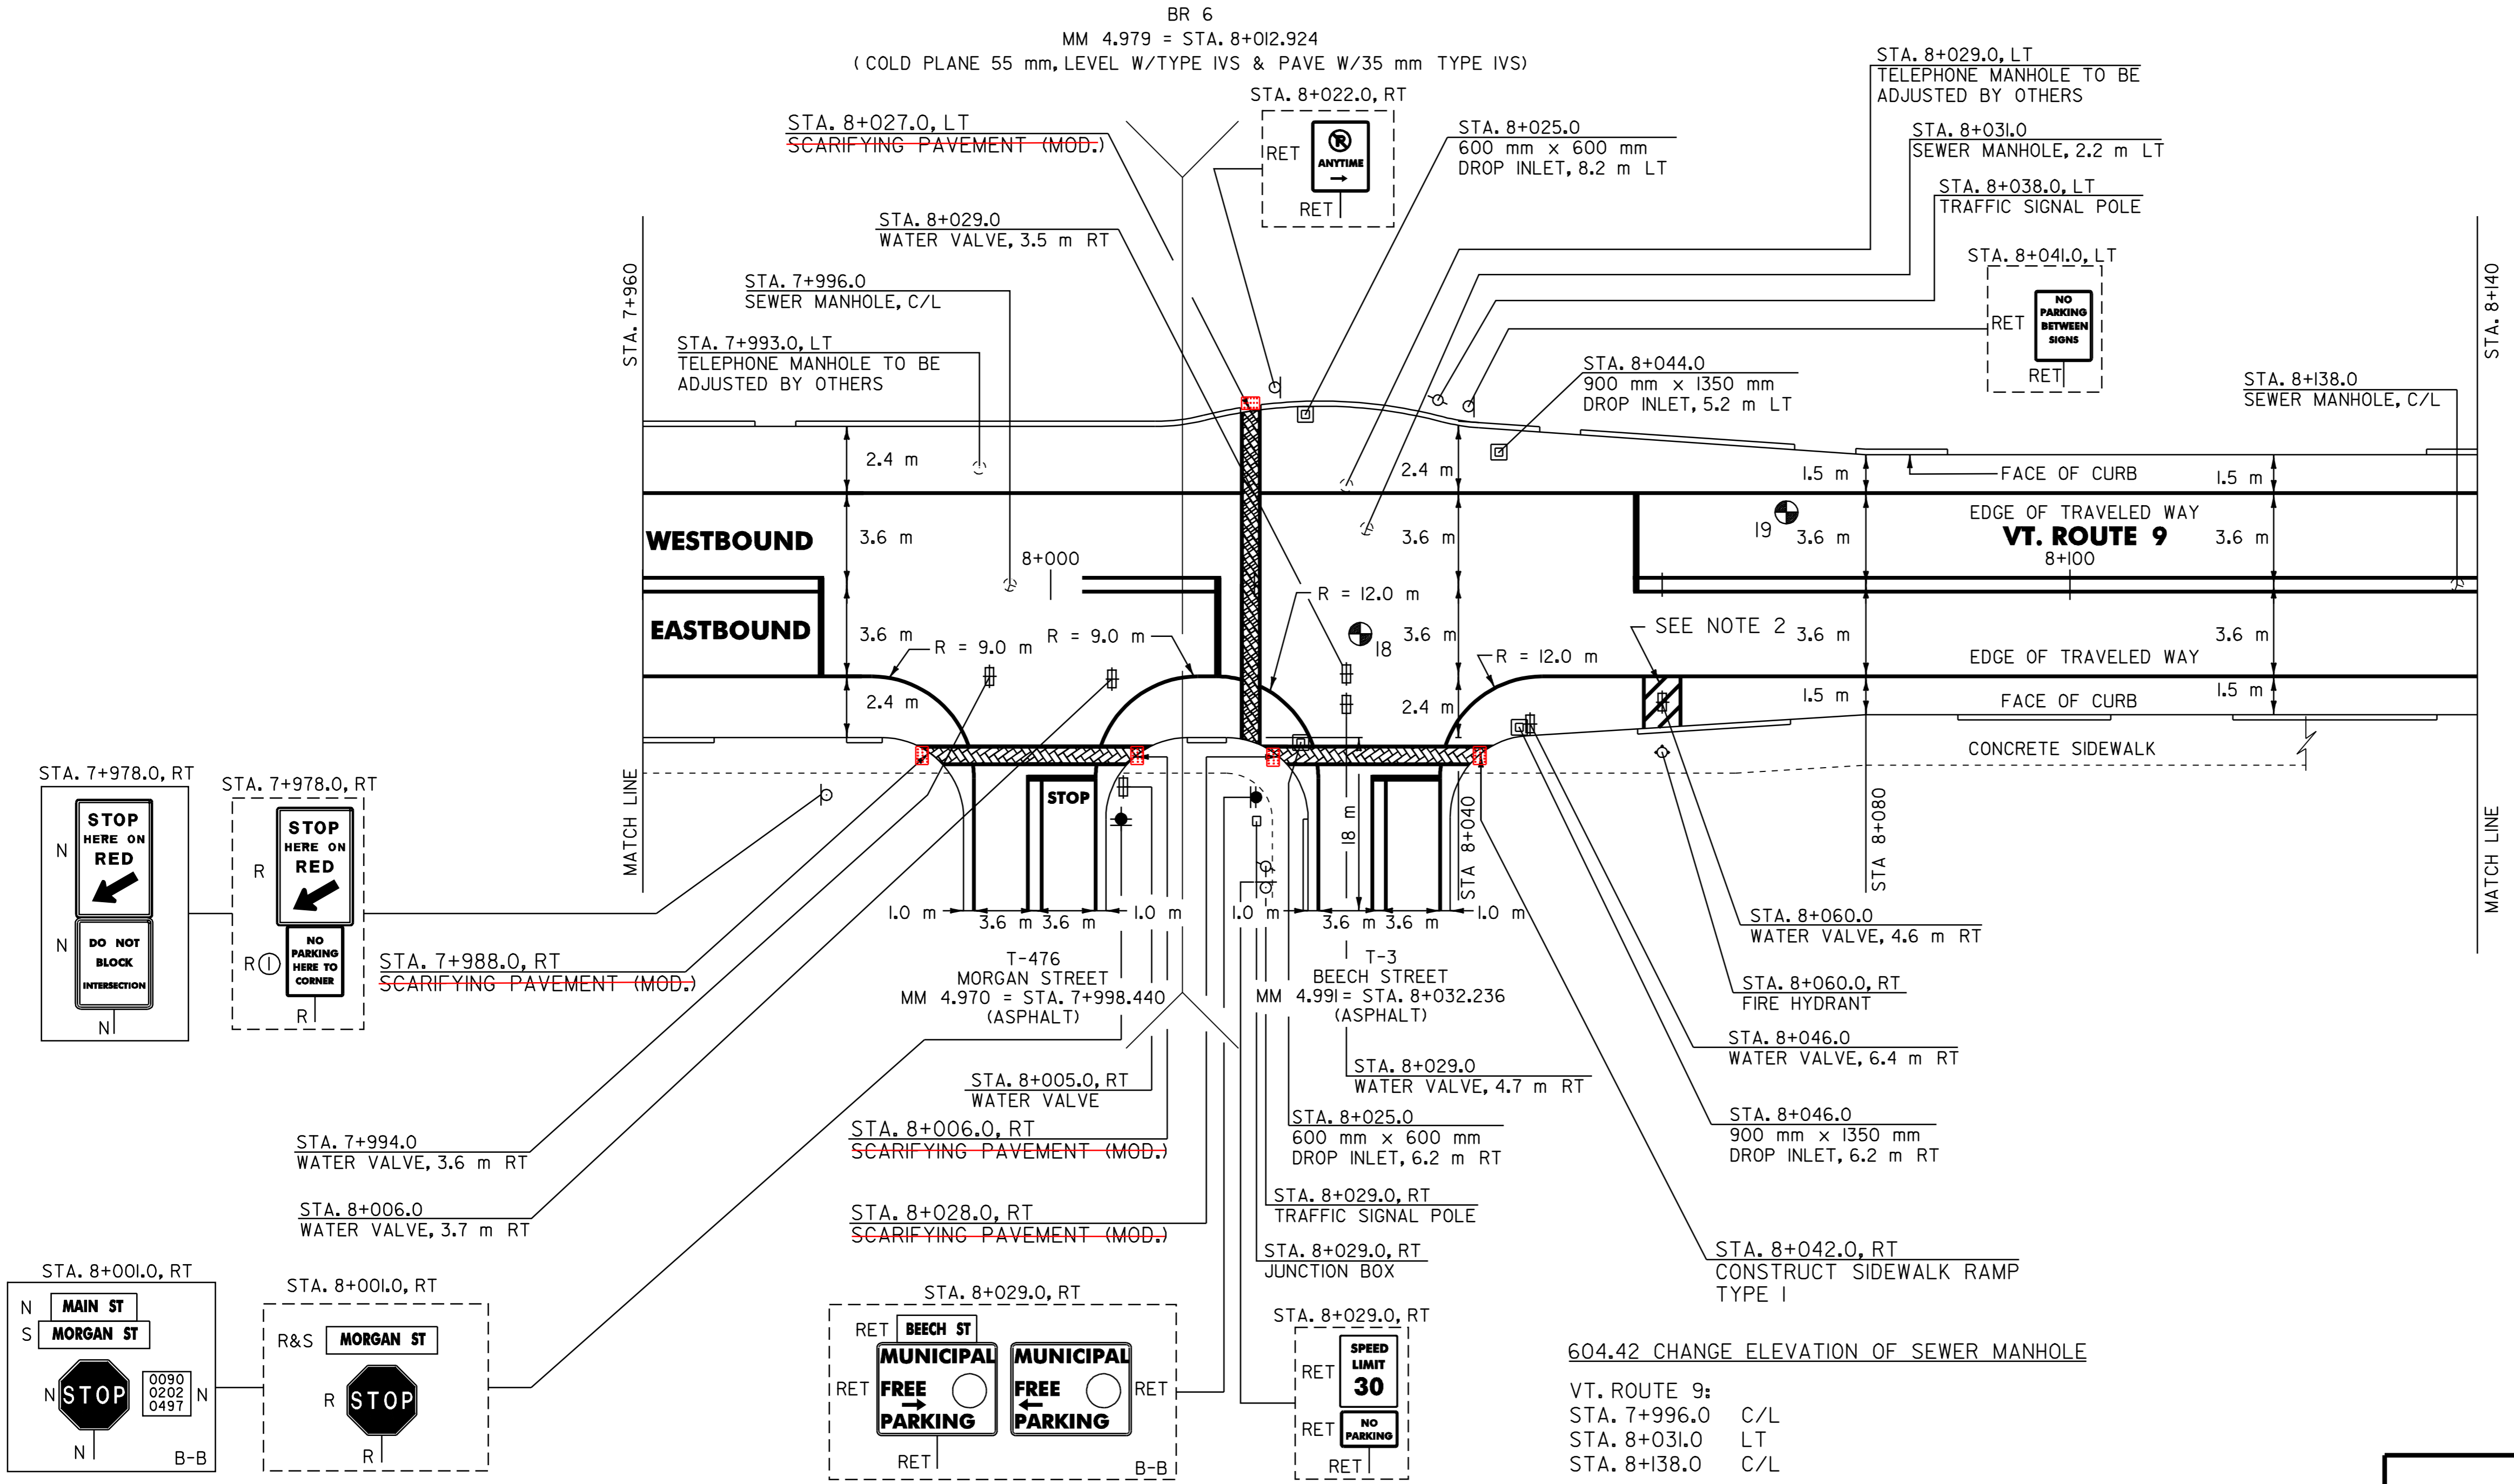

- NOTES:
- PAVING LIMIT ON ALL TOWN HIGHWAYS SHALL BE MEASURED 8 m BACK FROM VT. ROUTE 9 EDGE OF SHOULDER UNLESS DENOTED OTHERWISE ON THE PLANS OR AS DIRECTED BY THE RESIDENT ENGINEER.
 - SEE SHEET 70 OF 108 FOR FIRE HYDRANT PAVEMENT MARKING DETAIL.

PAVEMENT CORES =

#	TOTAL DEPTH (mm)	PCC	COMMENTS
18	114	Y	
19	127	Y	

604.42 CHANGE ELEVATION OF SEWER MANHOLE
VT. ROUTE 9:
STA. 7+996.0 C/L
STA. 8+031.0 LT
STA. 8+138.0 C/L

629.20 ADJUST ELEVATION OF VALVE BOX
VT. ROUTE 9:
STA. 7+994.0 RT
STA. 8+006.0 RT
STA. 8+029.0 RT
STA. 8+029.0 RT
STA. 8+046.0 RT
STA. 8+060.0 RT

SIGN LEGEND
R= REMOVE
S= SALVAGE
N= NEW
RET= RETAIN
B-B= BACK TO BACK
EXISTING= -----
NEW= _____
① SIGN TO BE RETURNED TO THE TOWN OF BENNINGTON

PAVING PROJECT LAYOUT # 17

SURVEYED BY	N/A	DATE	N/A
DRAWN BY	J.A.R.	DATE	4/01
SQUAD LEADER	T.P.K.		
DESIGN FILE NO.	pave/99d156/pd156.dgn		
IPARM FILE	pd156i17.i	DATE PLOTTED	NOV-2005 10
PROJ. NAME	BENNINGTON		
PROJ. NO.	NH 2202(1)S		
SHEET 30 OF 108	SHEETS		

DATUM

VERTICAL	N/A
HORIZONTAL	N/A

ITEM 618.30 DETECTABLE WARNING SURFACE MOD TRUNCATED DOME CAST IN PLACE
~~212.20 SCARIFYING PAVEMENT (MOD.)~~
VT. ROUTE 9: STA 8+042 RT 0.929 m²
STA. 7+988.0 RT (5 m²) 0.929 m²
STA. 8+006.0 RT (5 m²) 0.929 m²
STA. 8+027.0 LT (3 m²) 0.929 m²
STA. 8+028.0 RT (3 m²) 1.858 m²

604.40 CHANGE ELEVATION OF DI, CB OR MH
VT. ROUTE 9:
STA. 8+025.0 RT
STA. 8+025.0 LT
STA. 8+044.0 LT
STA. 8+046.0 RT

646.40 DURABLE 100 mm WHITE LINE
(ALL LINES WILL INCLUDE EDGE LINE BREAKS AND RADIUS FOR TOWN HIGHWAYS)

VT. ROUTE 9:
STA. 8+140.0 - STA. 8+320.0 LT & RT

646.60 TEMPORARY 100 mm WHITE LINE
(ALL LINES WILL INCLUDE EDGE LINE BREAKS AND RADIUS FOR TOWN HIGHWAYS)

VT. ROUTE 9:
STA. 8+140.0 - STA 8+320.0 LT & RT

646.41 DURABLE 100 mm YELLOW LINE
(ALL LINES WILL INCLUDE C/L BREAKS FOR TOWN HIGHWAYS) S=SOLID, D=DASHED

VT. ROUTE 9:
STA. 8+140.0 - STA. 8+320.0 LT S
STA. 8+249.497 DOUBLE SOLID LT, T-374 S

646.61 TEMPORARY 100 mm YELLOW LINE
(ALL LINES WILL INCLUDE C/L BREAKS FOR TOWN HIGHWAYS) S=SOLID, D=DASHED

VT. ROUTE 9:
STA. 8+140.0 - STA. 8+320.0 LT S
STA. 8+249.497 DOUBLE SOLID LT, T-374 S

646.42 DURABLE 200 mm WHITE LINE

VT. ROUTE 9:
STA. 8+230.2 - STA. 8+233.8 RT, SHOULDER HATCHING (12.9 m)

646.46 DURABLE 600 mm STOP BAR (TYPE ITAPE)

VT. ROUTE 9:
STA. 8+249.497 LT, T-374

646.66 TEMPORARY 600 mm STOP BAR

VT. ROUTE 9:
STA. 8+249.497 LT, T-374

646.50 DURABLE LETTER OR SYMBOL (TYPE ITAPE)

VT. ROUTE 9:
STA. 8+249.497 LT, T-374, 'S,T,O,P' (4 EA)

646.70 TEMPORARY LETTER OR SYMBOL

VT. ROUTE 9:
STA. 8+249.497 LT, T-374, 'S,T,O,P' (8 EA)

646.51 DURABLE CROSSWALK MARKINGS WITH DIAGONAL LINES (MOD.)


VT. ROUTE 9:
STA. 8+249.497 LT, T-374

646.71 TEMPORARY CROSSWALK MARKINGS WITH DIAGONAL LINES

VT. ROUTE 9:
STA. 8+249.497 LT, T-374

675.50 REMOVING SIGNS
AS SHOWN - 7

675.60 ERECTING SALVAGED SIGNS
AS SHOWN - 2

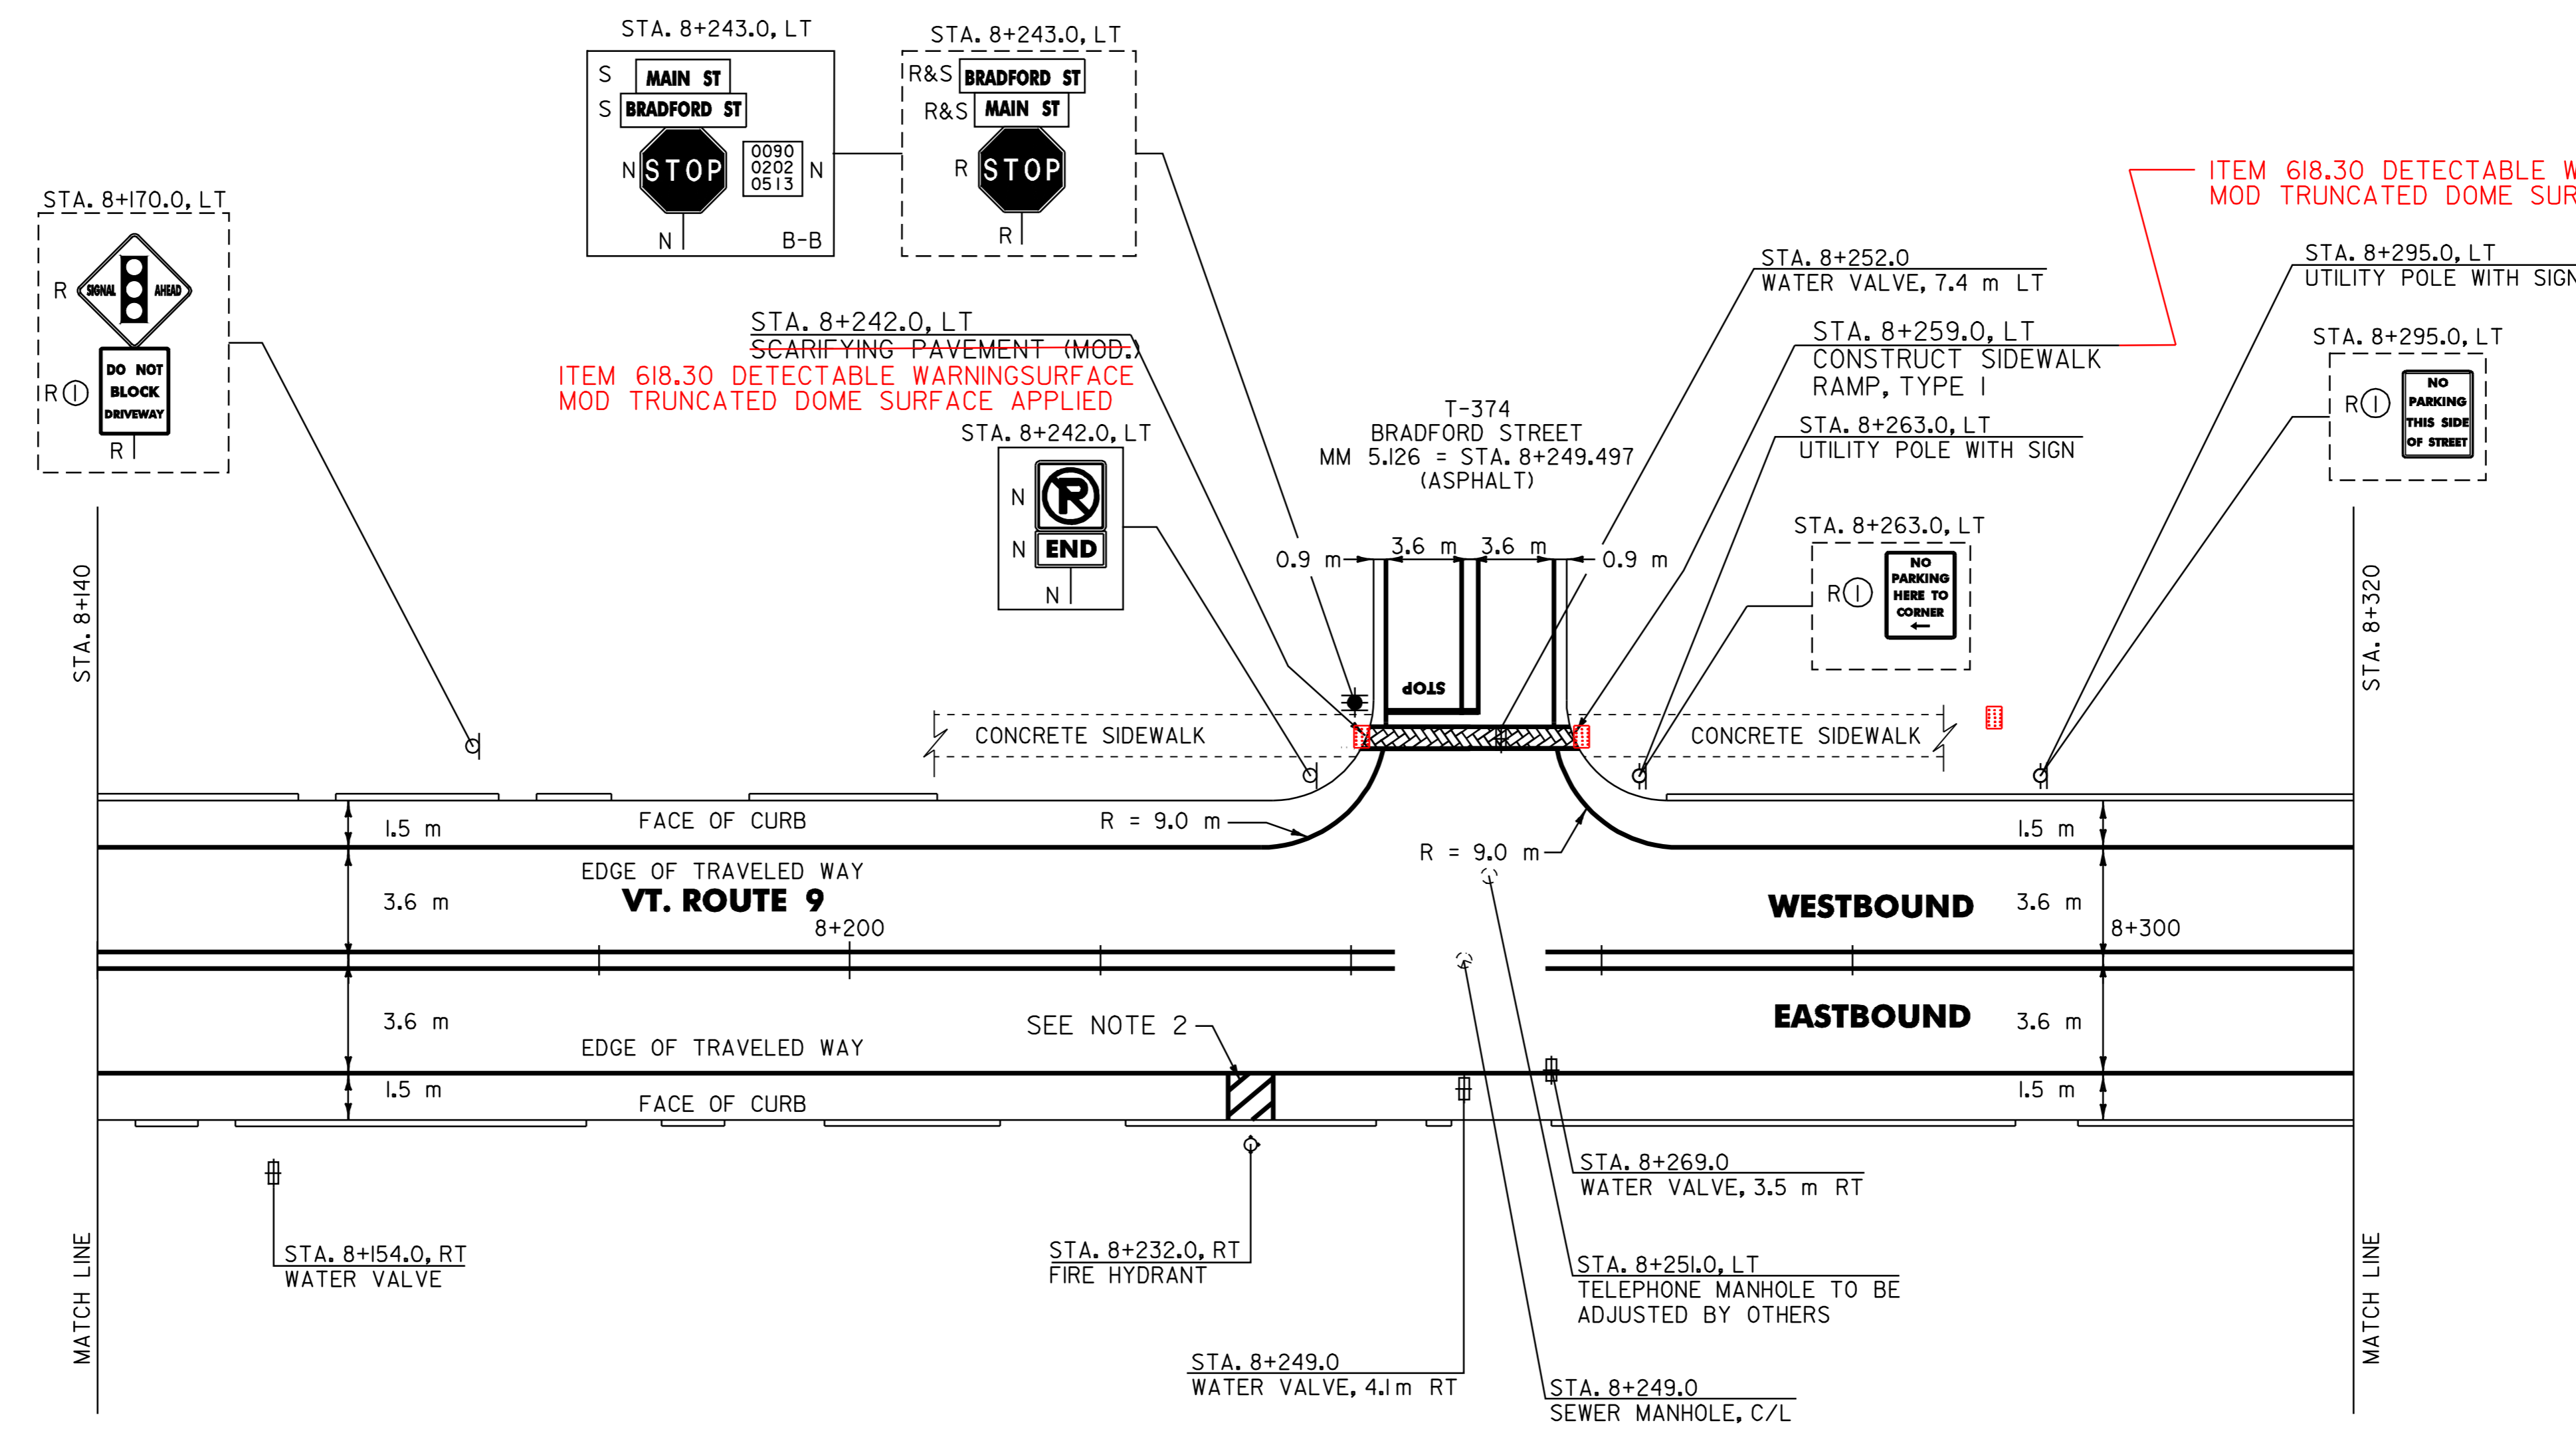

ITEM 618.30 DETECTABLE WARNING SURFACE MOD TRUNCATED DOME SURFACE APPLIED

ITEM 618.30 DETECTABLE WARNING SURFACE MOD TRUNCATED DOME SURFACE APPLIED

NOTES:

- PAVING LIMIT ON ALL TOWN HIGHWAYS SHALL BE MEASURED 8 m BACK FROM VT. ROUTE 9 EDGE OF SHOULDER UNLESS DENOTED OTHERWISE ON THE PLANS OR AS DIRECTED BY THE RESIDENT ENGINEER.
- SEE SHEET 70 OF 108 FOR FIRE HYDRANT PAVEMENT MARKING DETAIL.

ITEM 618.30 DETECTABLE WARNING SURFACE MOD TRUNCATED DOME CAST IN PLACE

~~212.20 SCARIFYING PAVEMENT (MOD.)~~

VT. ROUTE 9:
STA. 8+242.0 LT (5 m²) 0.929 m²
STA 8+259 LT 0.929 m²

604.42 CHANGE ELEVATION OF SEWER MANHOLE

VT. ROUTE 9:
STA. 8+249.0 C/L

629.20 ADJUST ELEVATION OF VALVE BOX

VT. ROUTE 9:
STA. 8+249.0 RT
STA. 8+252.0 LT
STA. 8+269.0 RT

SIGN LEGEND

- R= REMOVE
- S= SALVAGE
- N= NEW
- RET= RETAIN
- B-B= BACK TO BACK
- EXISTING= -----
- NEW= -----
- Ⓢ SIGN TO BE RETURNED TO THE TOWN OF BENNINGTON

PAVING PROJECT LAYOUT # 18

SURVEYED BY	N/A	DATE	N/A
DRAWN BY	J.A.R.	DATE	4/01
SQUAD LEADER	T.P.K.		
DESIGN FILE NO.	pave/99d156/pdl56.dgn		
IPARM FILE	pdl56i18.i	DATE PLOTTED	NOV-2005 10
PROJ. NAME	BENNINGTON		
PROJ. NO.	NH 2202(1)S		
SHEET 31	OF 108	SHEETS	

DATUM	
VERTICAL	N/A
HORIZONTAL	N/A

646.40 DURABLE 100 mm WHITE LINE
 (ALL LINES WILL INCLUDE EDGE LINE BREAKS AND RADIUS FOR TOWN HIGHWAYS)

VT. ROUTE 9:
 STA. 8+320.0 - STA. 8+580.0 LT & RT

646.60 TEMPORARY 100 mm WHITE LINE
 (ALL LINES WILL INCLUDE EDGE LINE BREAKS AND RADIUS FOR TOWN HIGHWAYS)

VT. ROUTE 9:
 STA. 8+320.0 - STA. 8+580.0 LT & RT

646.41 DURABLE 100 mm YELLOW LINE
 (ALL LINES WILL INCLUDE C/L BREAKS FOR TOWN HIGHWAYS) S=SOLID, D=DASHED

VT. ROUTE 9: LT C RT
 STA. 8+320.0 - STA. 8+458.7 S - S
 STA. 8+484.3 - STA. 8+580.0 S - S
 STA. 8+468.368 DOUBLE SOLID RT, T-486
 STA. 8+468.368 DOUBLE SOLID LT, T-384

646.61 TEMPORARY 100 mm YELLOW LINE
 (ALL LINES WILL INCLUDE C/L BREAKS FOR TOWN HIGHWAYS) S=SOLID, D=DASHED

VT. ROUTE 9: LT C RT
 STA. 8+320.0 - STA. 8+458.7 S - S
 STA. 8+484.3 - STA. 8+580.0 S - S
 STA. 8+468.368 DOUBLE SOLID RT, T-486
 STA. 8+468.368 DOUBLE SOLID LT, T-384

646.42 DURABLE 200 mm WHITE LINE

VT. ROUTE 9:
 STA. 8+340.2 - STA. 8+343.8 RT, SHOULDER HATCHING (12.9 m)
 STA. 8+569.2 - STA. 8+572.8 RT, SHOULDER HATCHING (12.9 m)

646.46 DURABLE 600 mm STOP BAR (TYPE ITAPE)

VT. ROUTE 9:
 STA. 8+459.0 RT
 STA. 8+468.368 RT, T-486
 STA. 8+468.368 LT, T-384
 STA. 8+484.0 LT

646.66 TEMPORARY 600 mm STOP BAR

VT. ROUTE 9:
 STA. 8+459.0 RT
 STA. 8+468.368 RT, T-486
 STA. 8+468.368 LT, T-384
 STA. 8+484.0 LT

646.51 DURABLE CROSSWALK MARKINGS WITH DIAGONAL LINES (MOD.2)


VT. ROUTE 9:
 STA. 8+461.0
 STA. 8+468.368 LT, T-384

646.71 TEMPORARY CROSSWALK MARKINGS WITH DIAGONAL LINES

VT. ROUTE 9:
 STA. 8+461.0
 STA. 8+468.368 LT, T-384

675.50 REMOVING SIGNS
 AS SHOWN - 9

675.60 ERECTING SALVAGED SIGNS
 AS SHOWN - 2

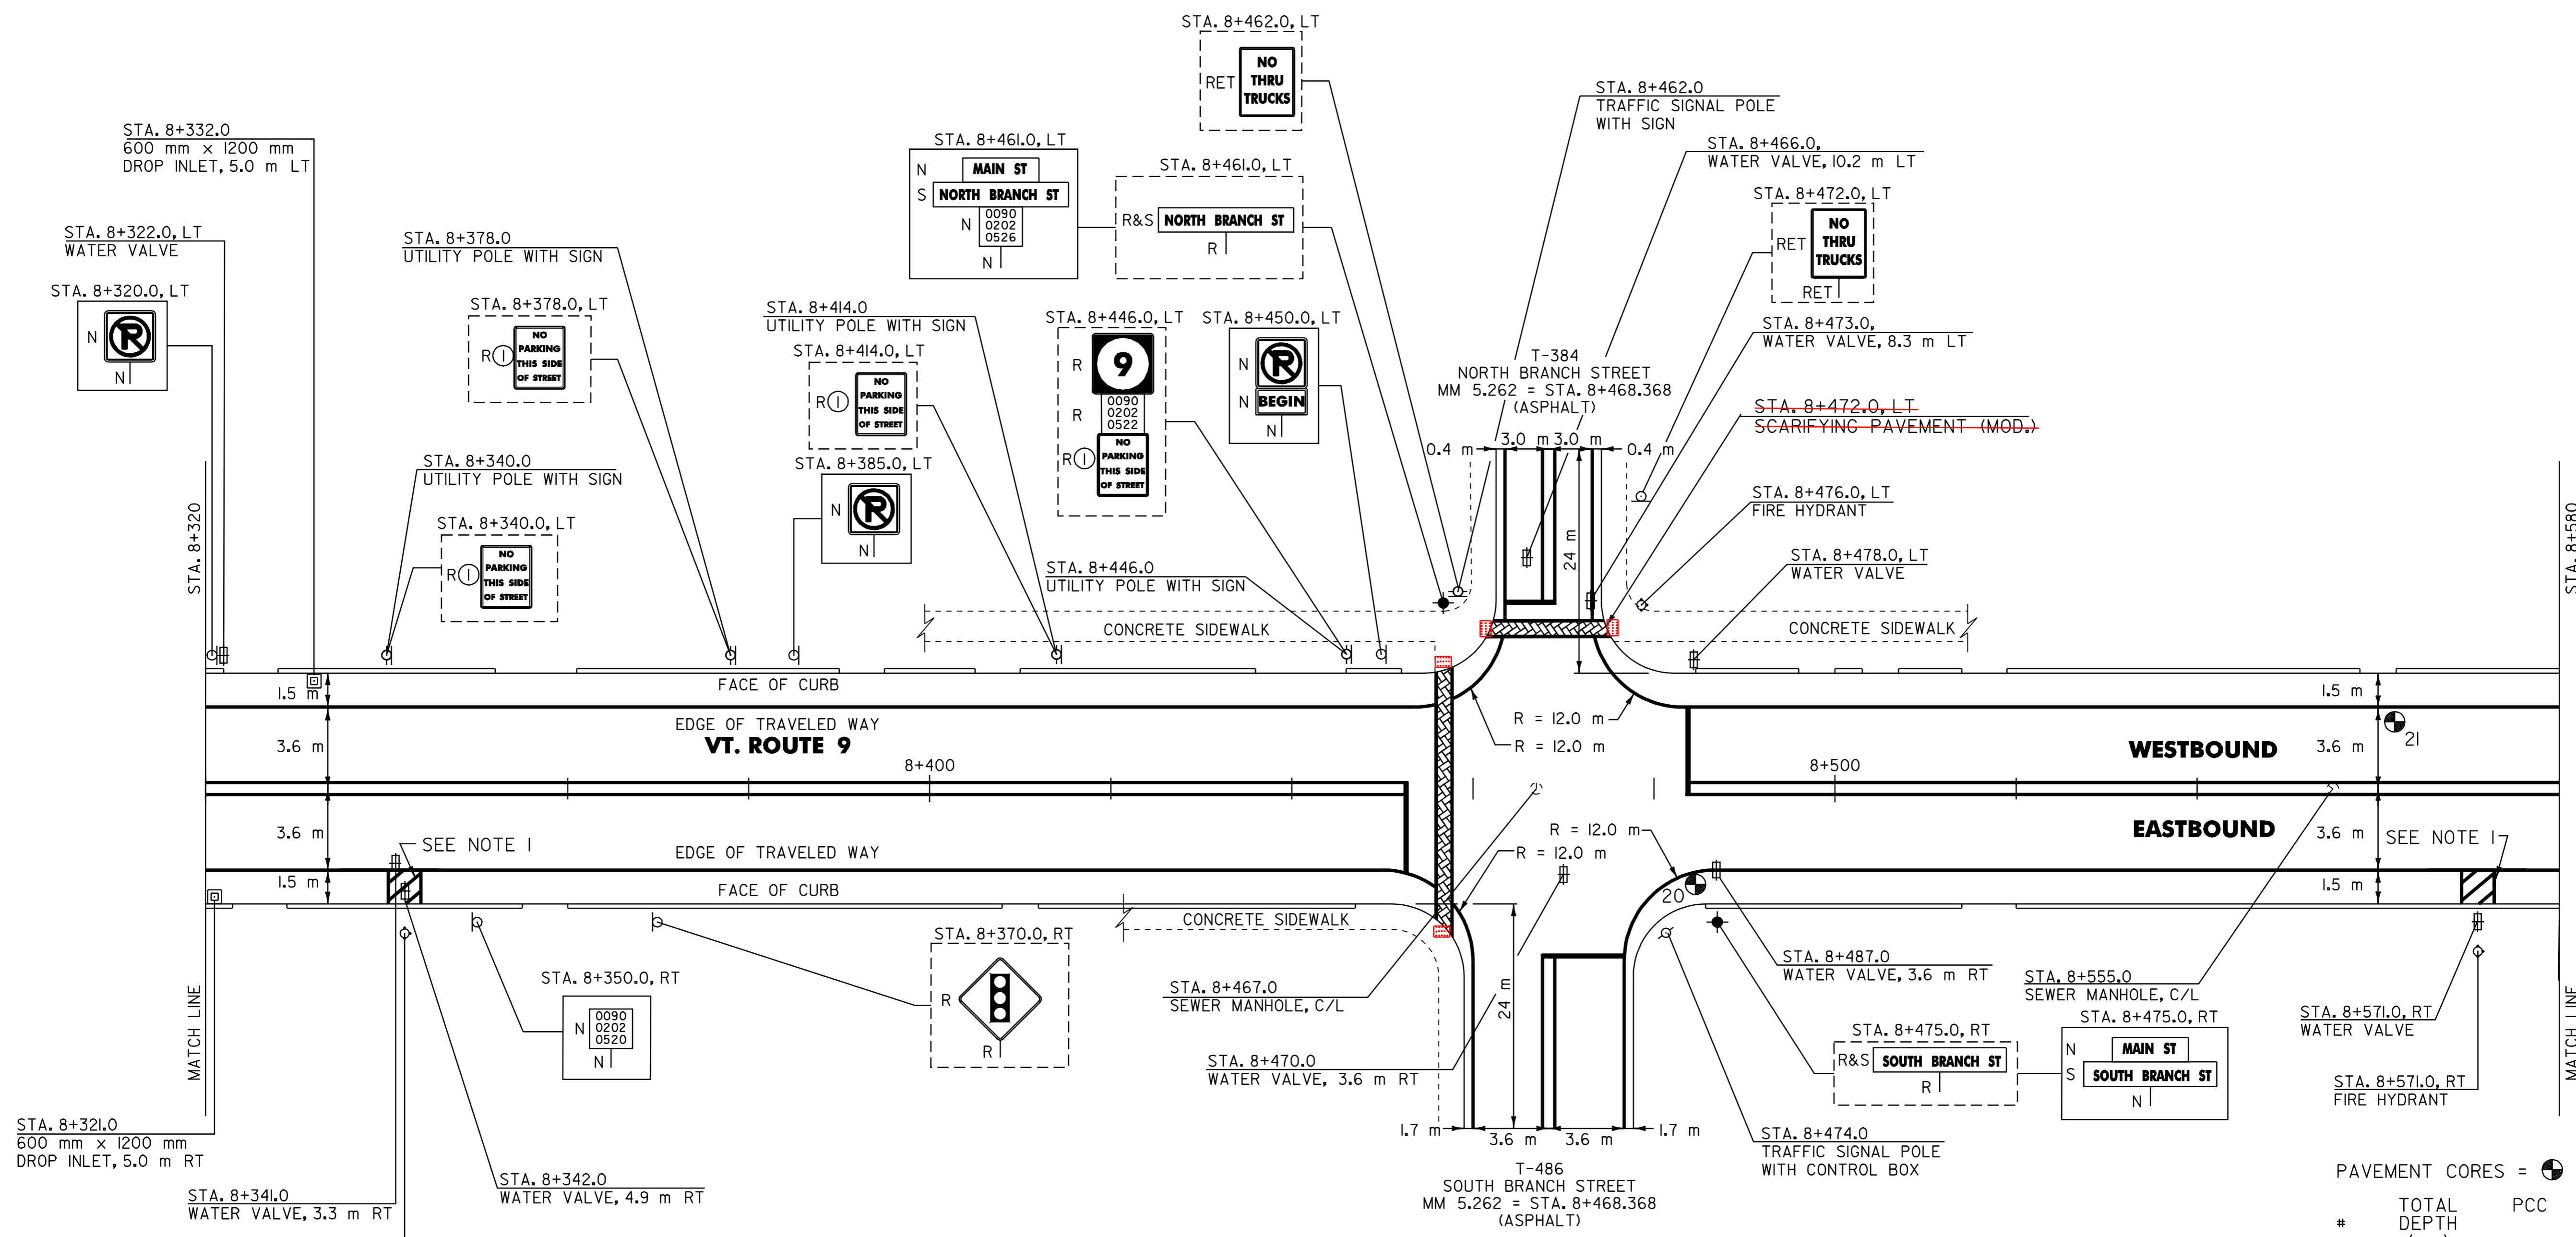

ITEM 618.30 DETECTABLE WARNING SURFACE
 MOD TRUNCATED DOME CAST IN PLACE

~~212.20 SCARIFYING PAVEMENT (MOD.)~~

VT. ROUTE 9:
 STA. 8+472.0 LT (3-m²) & RT 0.929 m²
 STA 8+461 LT 1.858 m²

604.40 CHANGE ELEVATION OF DI, CB OR MH

VT. ROUTE 9:
 STA. 8+321.0 RT
 STA. 8+332.0 LT

604.42 CHANGE ELEVATION OF SEWER MANHOLE

VT. ROUTE 9:
 STA. 8+467.0 C/L
 STA. 8+555.0 C/L

629.20 ADJUST ELEVATION OF VALVE BOX

VT. ROUTE 9:
 STA. 8+341.0 RT
 STA. 8+342.0 RT
 STA. 8+466.0 LT
 STA. 8+470.0 RT
 STA. 8+473.0 LT
 STA. 8+487.0 RT

ITEM 618.30 DETECTABLE WARNING SURFACE
 MOD TRUNCATED DOME SURFACE APPLIED
 STA 8+461 RT

NOTES:

- SEE SHEET 70 OF 108 FOR FIRE HYDRANT PAVEMENT MARKING DETAIL.
- PAVING LIMIT ON ALL TOWN HIGHWAYS SHALL BE MEASURED 8 m BACK FROM VT. ROUTE 9 EDGE OF SHOULDER UNLESS DENOTED OTHERWISE ON THE PLANS OR AS DIRECTED BY THE RESIDENT ENGINEER.

SIGN LEGEND

- R= REMOVE
- S= SALVAGE
- N= NEW
- RET= RETAIN
- B-B= BACK TO BACK
- EXISTING= -----
- NEW= _____

① SIGN TO BE RETURNED TO THE TOWN OF BENNINGTON

#	TOTAL DEPTH (mm)	PCC	COMMENTS
20	127	Y	
21	140	Y	

PAVING PROJECT LAYOUT # 19

SURVEYED BY	N/A	DATE	N/A
DRAWN BY	J.A.R.	DATE	4/01
SQUAD LEADER	T.P.K.		
DESIGN FILE NO.	pave/99dl56/pdl56.dgn		
IPARM FILE	pdl56119.i	DATE PLOTTED	NOV-2005 10
PROJ. NAME	BENNINGTON		
PROJ. NO.	NH 2202(1)S		
SHEET 32 OF 108	SHEETS		

DATUM	
VERTICAL	N/A
HORIZONTAL	N/A

646.40 DURABLE 100 mm WHITE LINE
(ALL LINES WILL INCLUDE EDGE LINE BREAKS AND RADIUS FOR TOWN HIGHWAYS)

VT. ROUTE 9:
STA. 8+580.0 - STA. 8+840.0 LT & RT

646.60 TEMPORARY 100 mm WHITE LINE
(ALL LINES WILL INCLUDE EDGE LINE BREAKS AND RADIUS FOR TOWN HIGHWAYS)

VT. ROUTE 9:
STA. 8+580.0 - STA. 8+840.0 LT & RT

646.41 DURABLE 100 mm YELLOW LINE
(ALL LINES WILL INCLUDE C/L BREAKS FOR TOWN HIGHWAYS) S=SOLID, D=DASHED

VT. ROUTE 9:
STA. 8+580.0 - STA. 8+840.0 LT C RT
STA. 8+624.474 DOUBLE SOLID RT, ROCKWOOD STREET

646.61 TEMPORARY 100 mm YELLOW LINE
(ALL LINES WILL INCLUDE C/L BREAKS FOR TOWN HIGHWAYS) S=SOLID, D=DASHED

VT. ROUTE 9:
STA. 8+580.0 - STA. 8+840.0 LT C RT
STA. 8+624.474 DOUBLE SOLID RT, ROCKWOOD STREET

646.42 DURABLE 200 mm WHITE LINE

VT. ROUTE 9:
STA. 8+763.2 - STA. 8+766.8 RT, SHOULDER HATCHING (12.9 m)

646.46 DURABLE 600 mm STOP BAR (TYPE ITAPE)

VT. ROUTE 9:
STA. 8+624.474 RT, ROCKWOOD STREET

646.66 TEMPORARY 600 mm STOP BAR

VT. ROUTE 9:
STA. 8+624.474 RT, ROCKWOOD STREET

646.50 DURABLE LETTER OR SYMBOL (TYPE ITAPE)


VT. ROUTE 9:
STA. 8+624.474 RT, ROCKWOOD STREET, "S,T,O,P" (4 EA)

646.70 TEMPORARY LETTER OR SYMBOL

VT. ROUTE 9:
STA. 8+624.474 RT, ROCKWOOD STREET, "S,T,O,P" (8 EA)

675.50 REMOVING SIGNS
AS SHOWN - 4

675.60 ERECTING SALVAGED SIGNS
AS SHOWN - 1

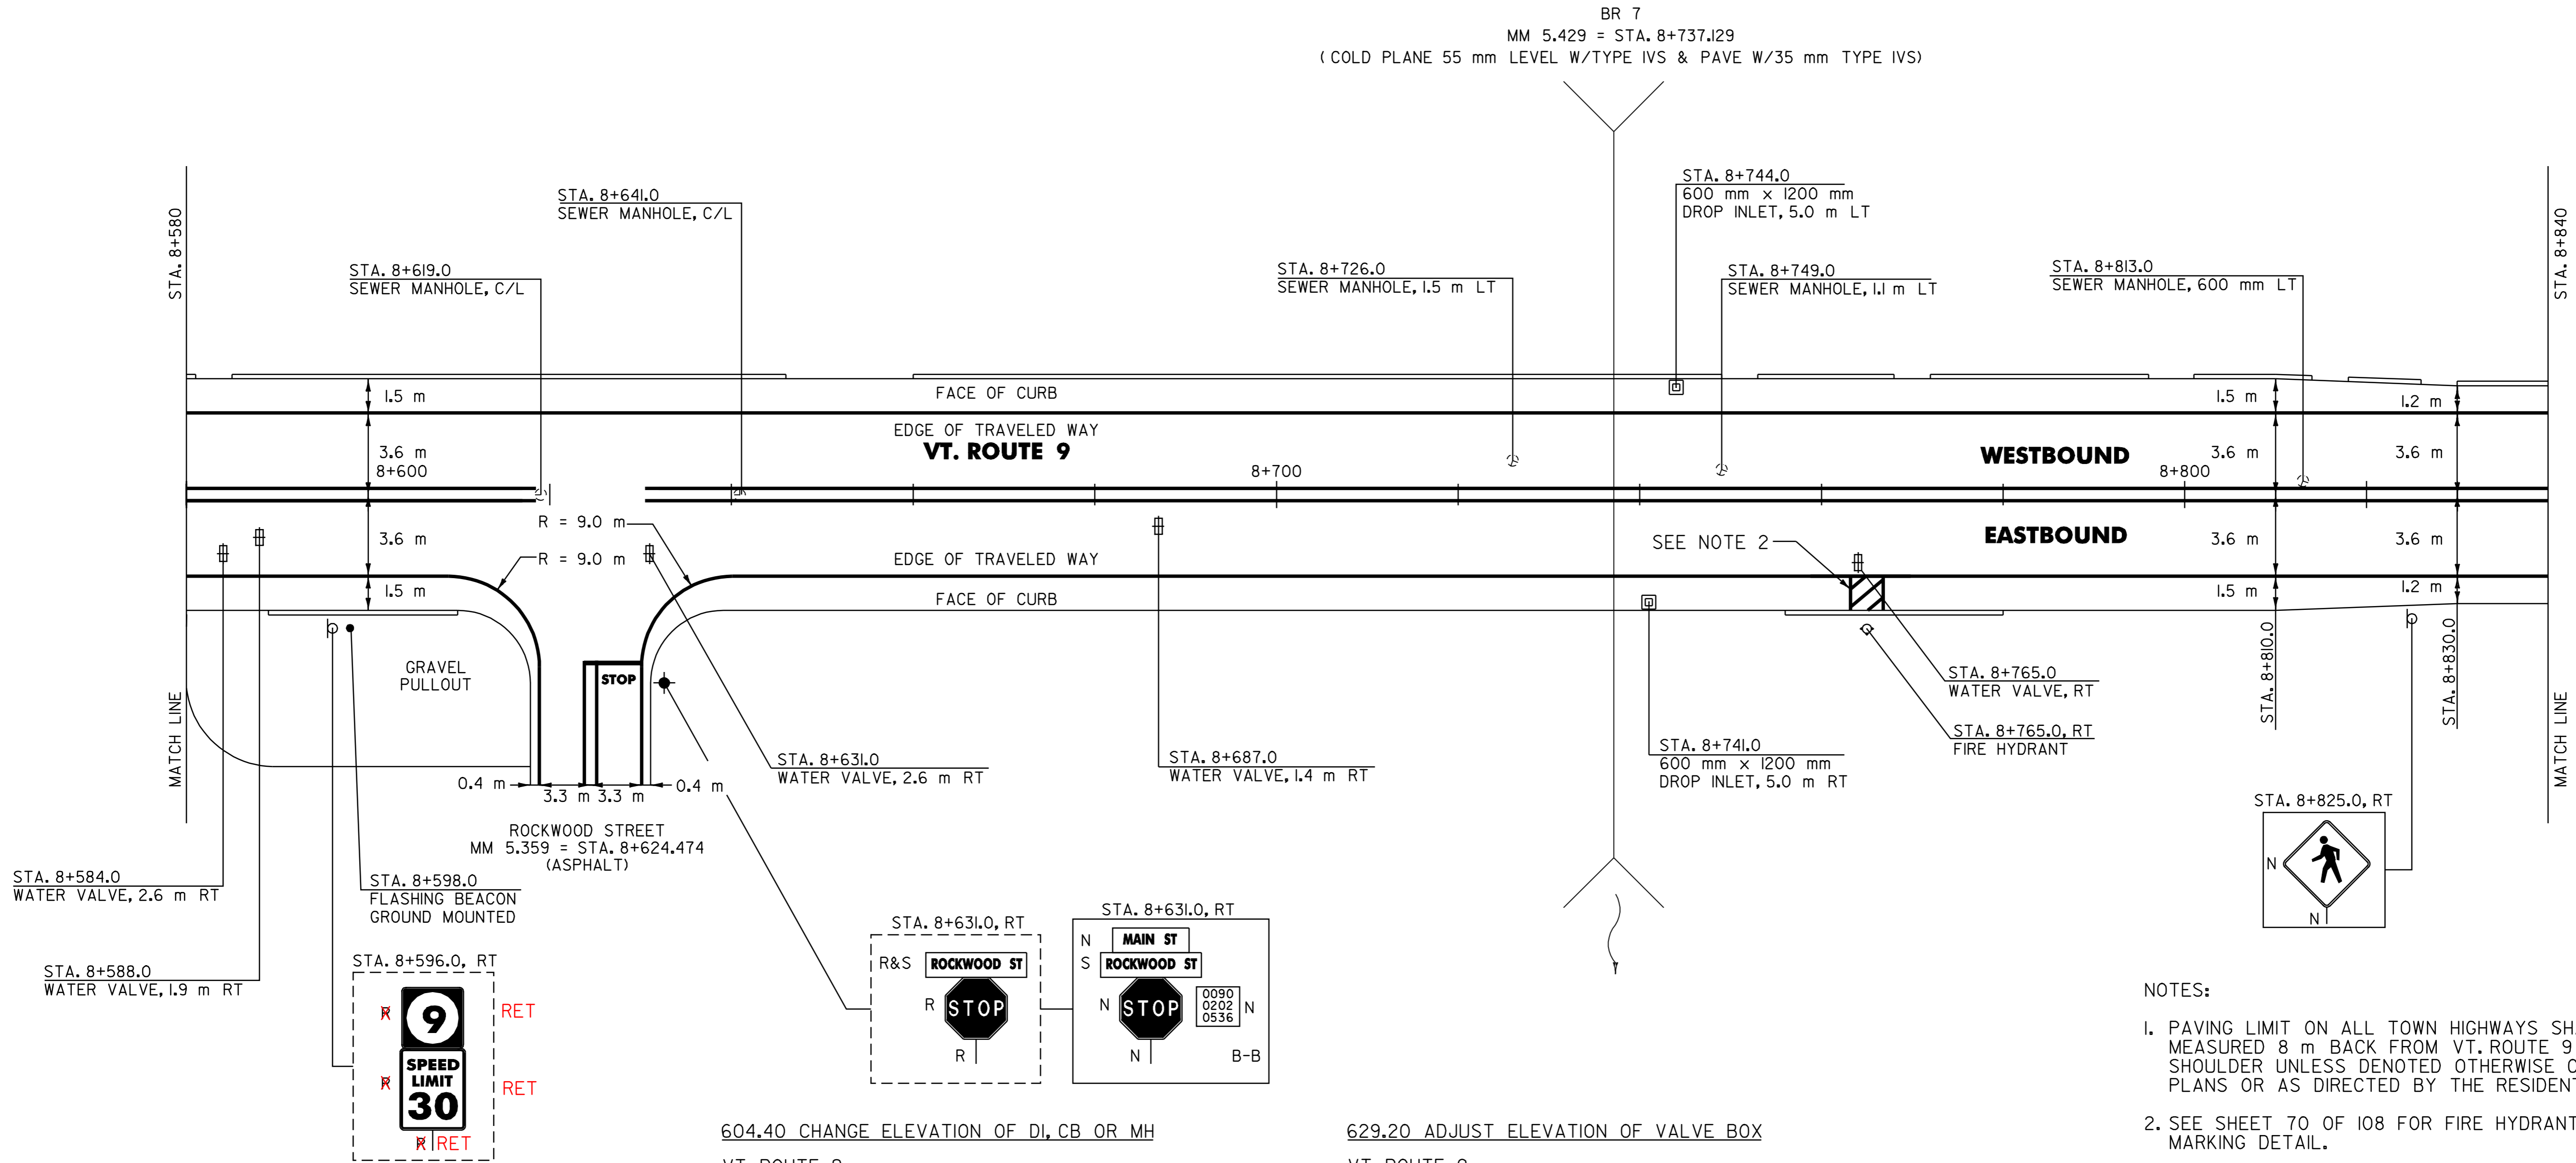

604.40 CHANGE ELEVATION OF DI, CB OR MH

VT. ROUTE 9:
STA. 8+741.0 RT
STA. 8+744.0 LT

629.20 ADJUST ELEVATION OF VALVE BOX

VT. ROUTE 9:
STA. 8+584.0 RT
STA. 8+588.0 RT
STA. 8+631.0 RT
STA. 8+687.0 RT
STA. 8+765.0 RT

604.42 CHANGE ELEVATION OF SEWER MANHOLE

VT. ROUTE 9:
STA. 8+619.0 C/L
STA. 8+641.0 C/L
STA. 8+726.0 LT
STA. 8+749.0 LT
STA. 8+813.0 LT

- NOTES:
- PAVING LIMIT ON ALL TOWN HIGHWAYS SHALL BE MEASURED 8 m BACK FROM VT. ROUTE 9 EDGE OF SHOULDER UNLESS DENOTED OTHERWISE ON THE PLANS OR AS DIRECTED BY THE RESIDENT ENGINEER.
 - SEE SHEET 70 OF 108 FOR FIRE HYDRANT PAVEMENT MARKING DETAIL.

DATUM	
VERTICAL	N/A
HORIZONTAL	N/A

SIGN LEGEND
R= REMOVE
S= SALVAGE
N= NEW
RET= RETAIN
B-B= BACK TO BACK
EXISTING= _____
NEW= _____

<h2>PAVING PROJECT LAYOUT # 20</h2>	SURVEYED BY	N/A	DATE	N/A
	DRAWN BY	J.A.R.	DATE	4/01
	SQUAD LEADER	T.P.K.		
	DESIGN FILE NO.	pave/99d156/pdl56.dgn		
	IPARM FILE	pdl56i20.i	DATE PLOTTED	NOV-2005 10
PROJ. NAME	BENNINGTON			
PROJ. NO.	NH 2202(1)S			
SHEET 33 OF 108	SHEETS			

646.40 DURABLE 100 mm WHITE LINE
 (ALL LINES WILL INCLUDE EDGE LINE BREAKS AND RADIUS FOR TOWN HIGHWAYS)
 VT. ROUTE 9:
 STA. 8+840.0 - STA. 9+100.0 LT & RT

646.41 DURABLE 100 mm YELLOW LINE
 (ALL LINES WILL INCLUDE C/L BREAKS FOR TOWN HIGHWAYS) S=SOLID, D=DASHED
 VT. ROUTE 9:
 STA. 8+840.0 - STA. 9+100.0 S
 STA. 8+912.547 DOUBLE SOLID RT, T-504
 STA. 8+988.186 DOUBLE SOLID LT, T-6

646.46 DURABLE 600 mm STOP BAR (TYPE ITAPE)
 VT. ROUTE 9:
 STA. 8+912.547 RT, T-504
 STA. 8+988.186 LT, T-6

646.51 DURABLE CROSSWALK MARKINGS WITH DIAGONAL LINES (MOD.2)
 VT. ROUTE 9:
 STA. 8+918.0
 STA. 8+988.186 LT, T-6

675.50 REMOVING SIGNS
 AS SHOWN - 1517

675.60 ERECTING SALVAGED SIGNS
 AS SHOWN - 3


646.60 TEMPORARY 100 mm WHITE LINE
 (ALL LINES WILL INCLUDE EDGE LINE BREAKS AND RADIUS FOR TOWN HIGHWAYS)
 VT. ROUTE 9:
 STA. 8+840.0 - STA. 9+100.0 LT & RT

646.61 TEMPORARY 100 mm YELLOW LINE
 (ALL LINES WILL INCLUDE C/L BREAKS FOR TOWN HIGHWAYS) S=SOLID, D=DASHED
 VT. ROUTE 9:
 STA. 8+840.0 - STA. 9+100.0 S
 STA. 8+912.547 DOUBLE SOLID RT, T-504
 STA. 8+988.186 DOUBLE SOLID LT, T-6

646.50 DURABLE LETTER OR SYMBOL (TYPE ITAPE)
 VT. ROUTE 9:
 STA. 8+912.547 RT, T-504, "S,T,O,P" (4 EA)
 STA. 8+988.186 LT, T-6, "S,T,O,P" (4 EA)

646.71 TEMPORARY CROSSWALK MARKINGS WITH DIAGONAL LINES
 VT. ROUTE 9:
 STA. 8+918.0
 STA. 8+988.186 LT, T-6

646.70 TEMPORARY LETTER OR SYMBOL
 VT. ROUTE 9:
 STA. 8+912.547 RT, T-504, "S,T,O,P" (8 EA)
 STA. 8+988.186 LT, T-6, "S,T,O,P" (8 EA)

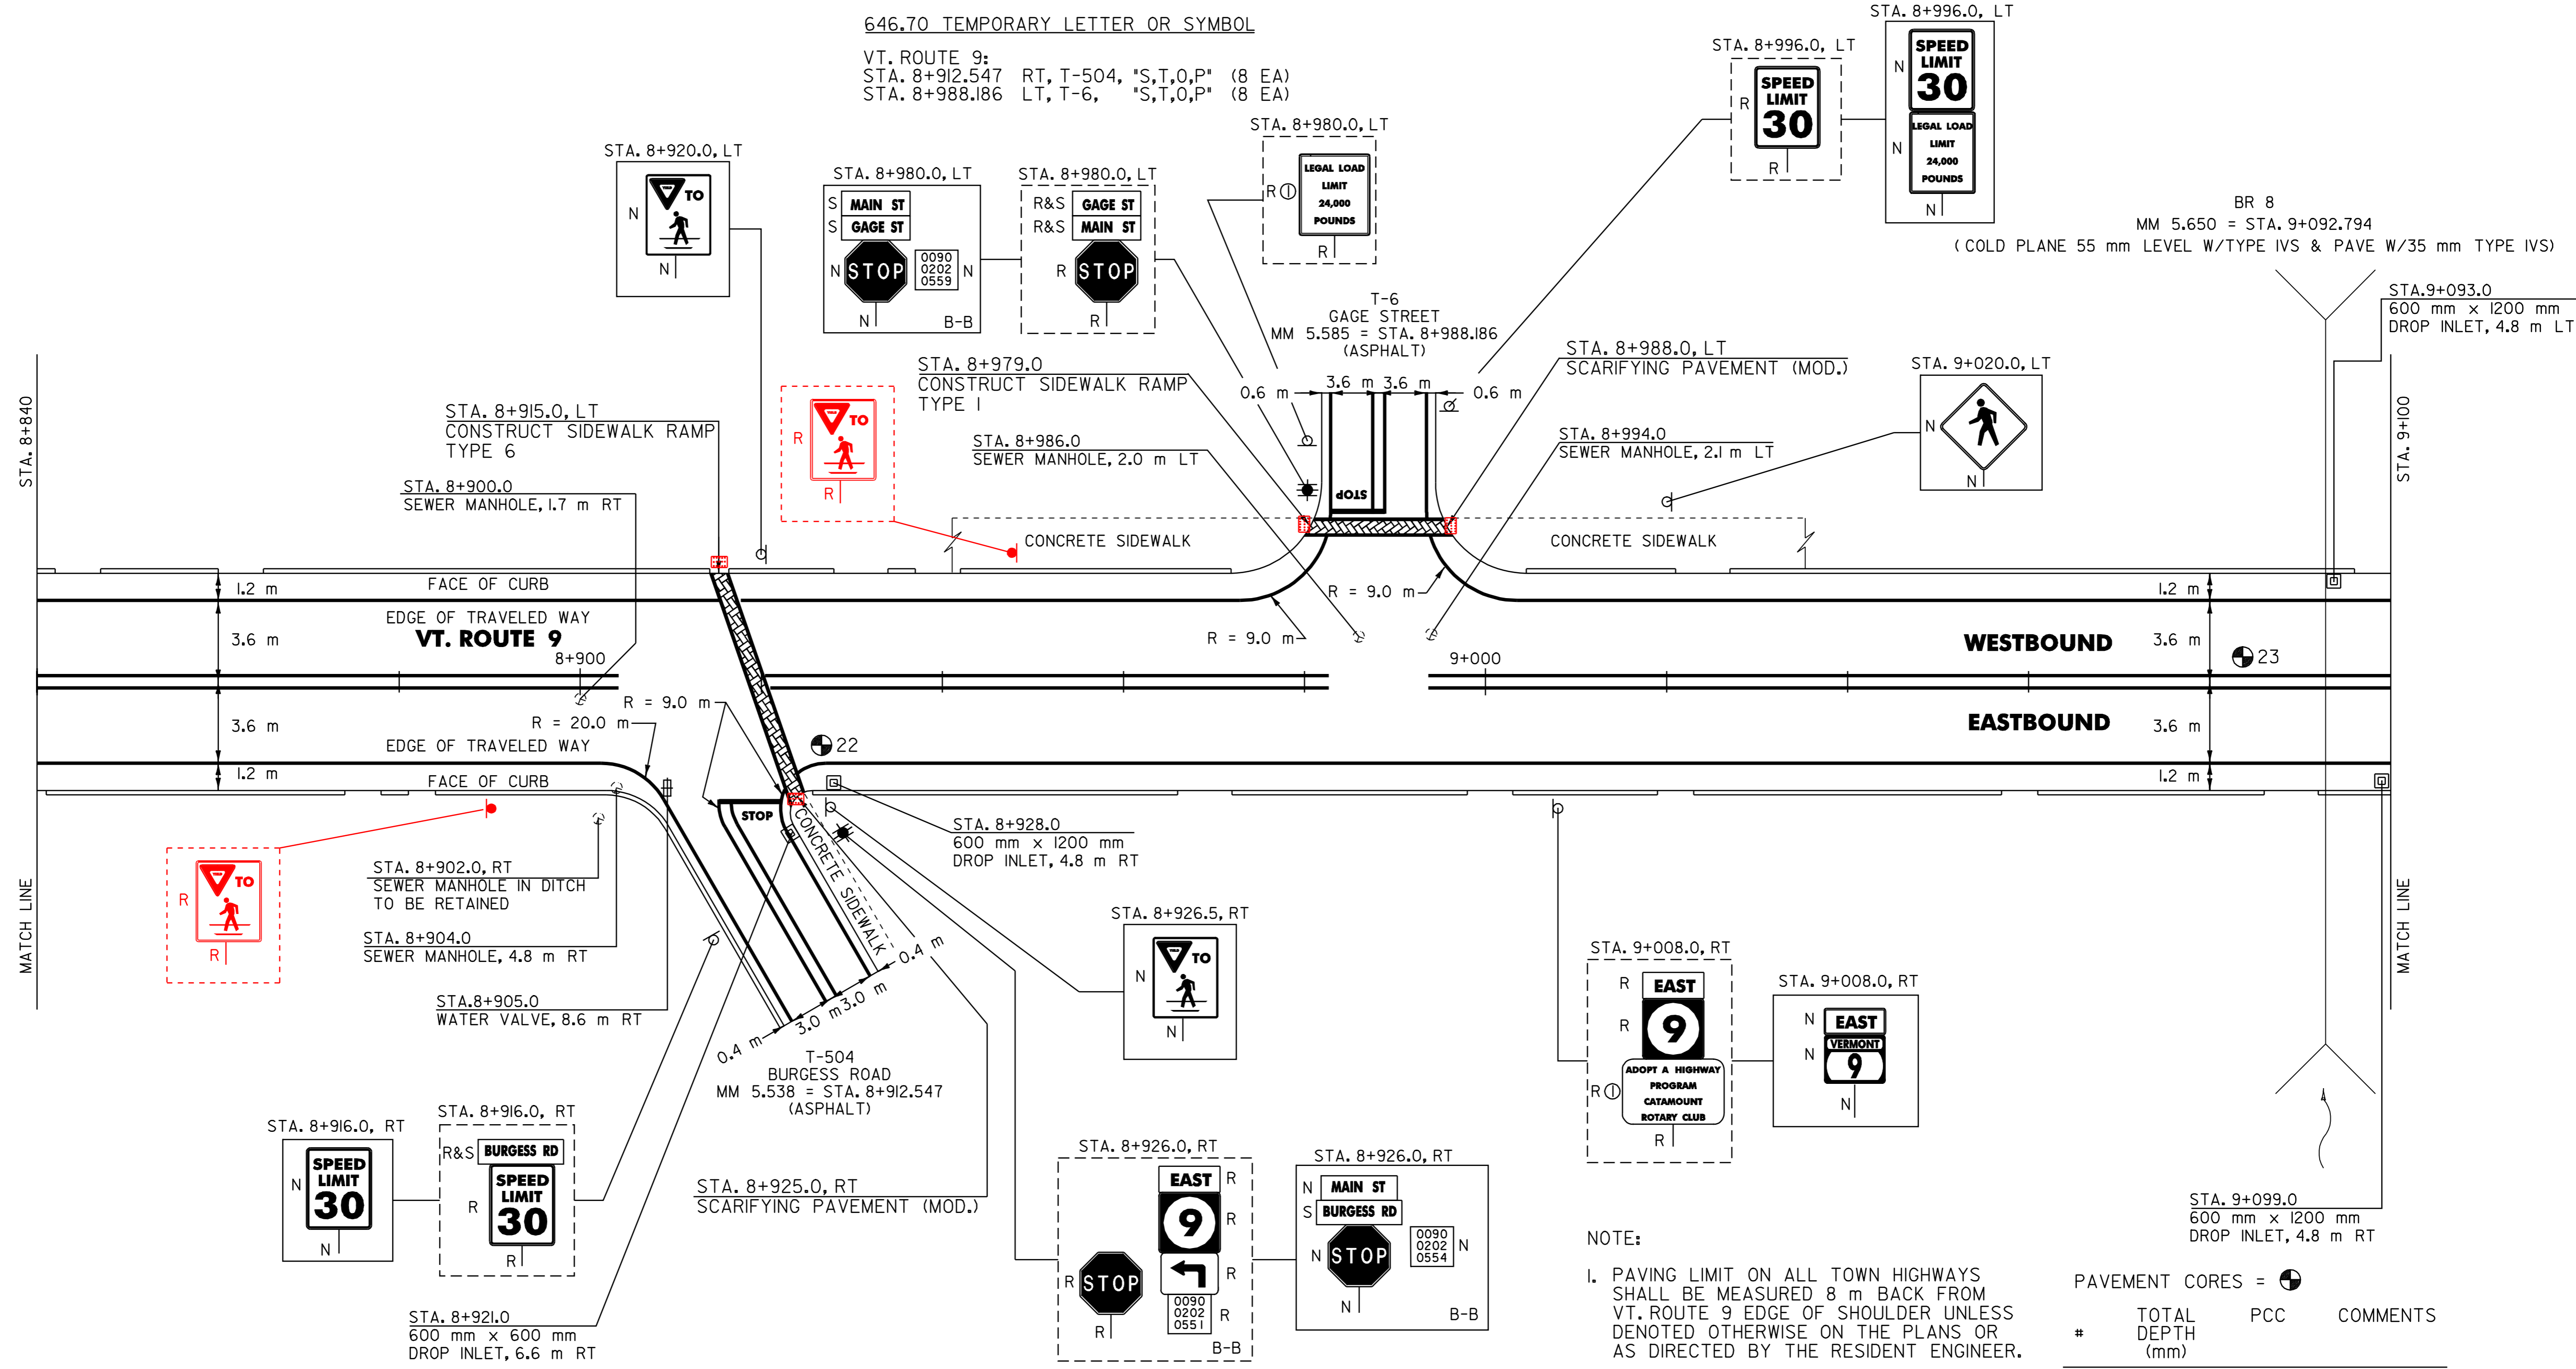

NOTE:
 1. PAVING LIMIT ON ALL TOWN HIGHWAYS SHALL BE MEASURED 8 m BACK FROM VT. ROUTE 9 EDGE OF SHOULDER UNLESS DENOTED OTHERWISE ON THE PLANS OR AS DIRECTED BY THE RESIDENT ENGINEER.

PAVEMENT CORES =

#	TOTAL DEPTH (mm)	PCC	COMMENTS
22	152	Y	
23	133	Y	

ITEM 618.30 DETECTABLE WARNING SURFACE MOD TRUNCATED DOME CAST IN PLACE
212.20 SCARIFYING PAVEMENT (MOD.)

VT. ROUTE 9:
 STA. 8+925.0 RT (5 m²) 0.743 m²
 STA. 8+988.0 LT (5 m²) 0.743 m²
 STA. 8+915 LT 0.929 m²
 STA. 8+97 LT 0.743 m²

604.42 CHANGE ELEVATION OF SEWER MANHOLE

VT. ROUTE 9:
 STA. 8+900.0 RT
 STA. 8+904.0 RT
 STA. 8+986.0 LT
 STA. 8+994.0 LT

629.20 ADJUST ELEVATION OF VALVE BOX

VT. ROUTE 9:
 STA. 8+905.0 RT

DATUM

VERTICAL	N/A
HORIZONTAL	N/A

VT. ROUTE 9:
 STA. 8+921.0 RT
 STA. 8+928.0 RT
 STA. 9+093.0 LT
 STA. 9+099.0 RT

SIGN LEGEND
 R= REMOVE
 S= SALVAGE
 N= NEW
 RET= RETAIN
 B-B= BACK TO BACK
 EXISTING= -----
 NEW= _____

Ⓢ SIGN TO BE RETURNED TO THE TOWN OF BENNINGTON

PAVING PROJECT LAYOUT # 21

SURVEYED BY N/A DATE N/A
 DRAWN BY J.A.R. DATE 4/01
 SQUAD LEADER T.P.K.
 DESIGN FILE NO. pave/99d156/pdl56.dgn
 IPARM FILE pdl56121.i DATE PLOT 4/11/05
 PROJ. NAME BENNINGTON
 PROJ. NO. NH 2202(1)S
 SHEET 34 OF 108 SHEETS

646.40 DURABLE 100 mm WHITE LINE
(ALL LINES WILL INCLUDE EDGE LINE BREAKS AND RADIUS FOR TOWN HIGHWAYS)

VT. ROUTE 9:
STA. 9+100.0 - STA. 9+360.0 LT & RT

646.60 TEMPORARY 100 mm WHITE LINE
(ALL LINES WILL INCLUDE EDGE LINE BREAKS AND RADIUS FOR TOWN HIGHWAYS)

VT. ROUTE 9:
STA. 9+100.0 - STA. 9+360.0 LT & RT

646.41 DURABLE 100 mm YELLOW LINE
(ALL LINES WILL INCLUDE C/L BREAKS FOR TOWN HIGHWAYS) S=SOLID, D=DASHED

VT. ROUTE 9:
STA. 9+100.0 - STA. 9+360.0 LT S - RT S


646.61 TEMPORARY 100 mm YELLOW LINE
(ALL LINES WILL INCLUDE C/L BREAKS FOR TOWN HIGHWAYS) S=SOLID, D=DASHED

VT. ROUTE 9:
STA. 9+100.0 - STA. 9+360.0 LT S - RT S

646.42 DURABLE 200 mm WHITE LINE

VT. ROUTE 9:
STA. 9+192.2 - STA. 9+195.8 LT, SHOULDER HATCHING (11.1 m)
STA. 9+323.2 - STA. 9+326.8 RT, SHOULDER HATCHING (11.1 m)

675.50 REMOVING SIGNS
AS SHOWN - 2

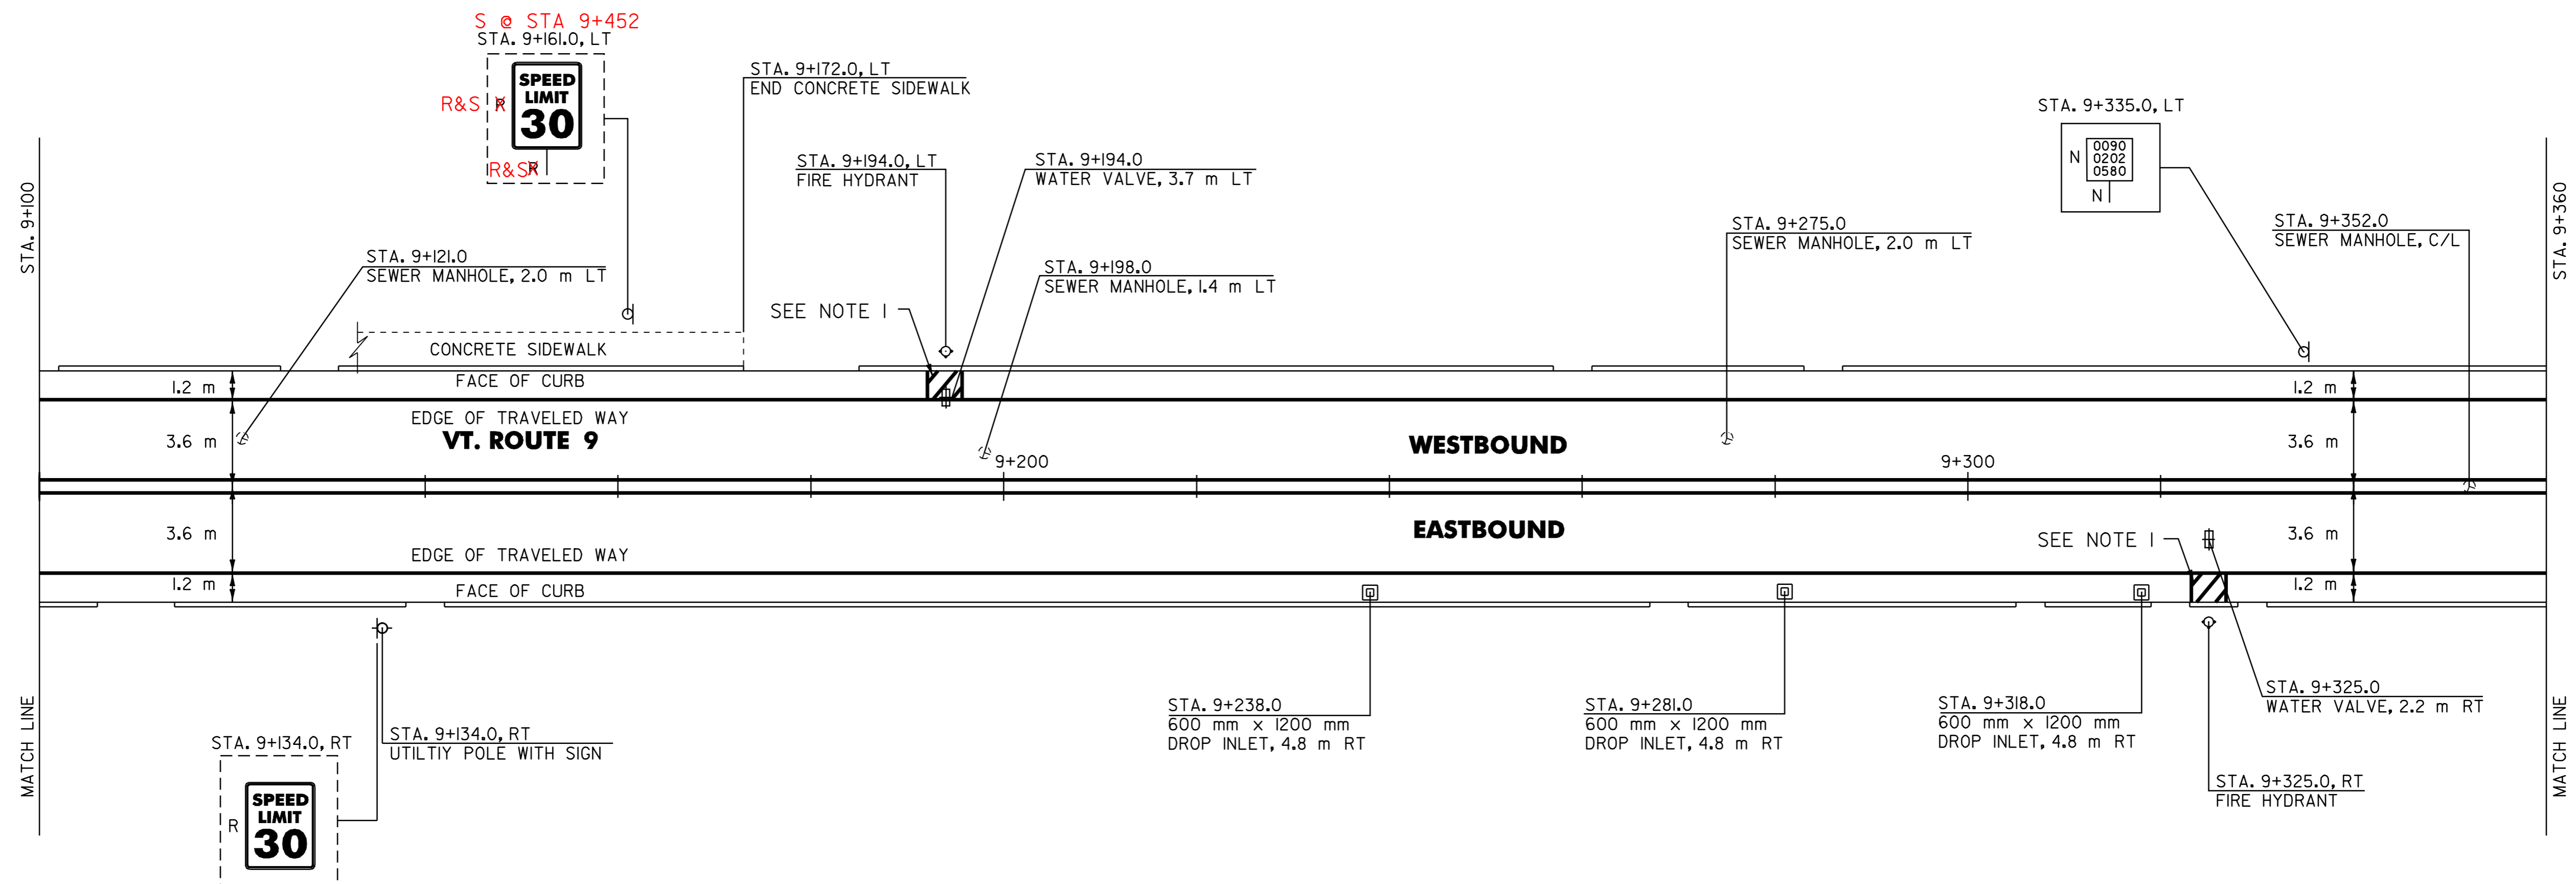

604.40 CHANGE ELEVATION OF DI, CB OR MH

VT. ROUTE 9:
STA. 9+238.0 RT
STA. 9+281.0 RT
STA. 9+318.0 RT

629.20 ADJUST ELEVATION OF VALVE BOX

VT. ROUTE 9:
STA. 9+194.0 LT
STA. 9+325.0 RT

604.42 CHANGE ELEVATION OF SEWER MANHOLE

VT. ROUTE 9:
STA. 9+210.0 LT
STA. 9+198.0 LT
STA. 9+275.0 LT
STA. 9+352.0 C/L

NOTE:
I. SEE SHEET 70 OF 108 FOR FIRE HYDRANT PAVEMENT MARKING DETAIL.

DATUM	
VERTICAL	N/A
HORIZONTAL	N/A

SIGN LEGEND
 R= REMOVE
 S= SALVAGE
 N= NEW
 RET= RETAIN
 B-B= BACK TO BACK
 EXISTING= _____
 NEW= _____

PAVING PROJECT LAYOUT # 22

SURVEYED BY	N/A	DATE	N/A
DRAWN BY	J.A.R.	DATE	4/01
SQUAD LEADER	T.P.K.		
DESIGN FILE NO.	pave/99d156/pdl56.dgn		
IPARM FILE	pdl56122.i	DATE PLOTTED	NOV-2005 10
PROJ. NAME	BENNINGTON		
PROJ. NO.	NH 2202(1)S		
SHEET 35 OF 108	SHEETS		

646.41 DURABLE 100 mm YELLOW LINE
(ALL LINES WILL INCLUDE C/L BREAKS FOR TOWN HIGHWAYS) S=SOLID, D=DASHED

VT. ROUTE 9:
STA. 9+360.0 - STA. 9+496.739 LT ☉ RT S - S

646.40 DURABLE 100 mm WHITE LINE
(ALL LINES WILL INCLUDE EDGE LINE BREAKS AND RADIUS FOR TOWN HIGHWAYS)

VT. ROUTE 9:
STA. 9+360.0 - STA. 9+496.739 LT & RT

675.50 REMOVING SIGNS
AS SHOWN - 6


675.60 ERECTING SALVAGED SIGNS
AS SHOWN - 1

646.61 TEMPORARY 100 mm YELLOW LINE
(ALL LINES WILL INCLUDE C/L BREAKS FOR TOWN HIGHWAYS) S=SOLID, D=DASHED

VT. ROUTE 9:
STA. 9+360.0 - STA. 9+496.739 LT ☉ RT S - S

646.60 TEMPORARY 100 mm WHITE LINE
(ALL LINES WILL INCLUDE EDGE LINE BREAKS AND RADIUS FOR TOWN HIGHWAYS)

VT. ROUTE 9:
STA. 9+360.0 - STA. 9+496.739 LT & RT

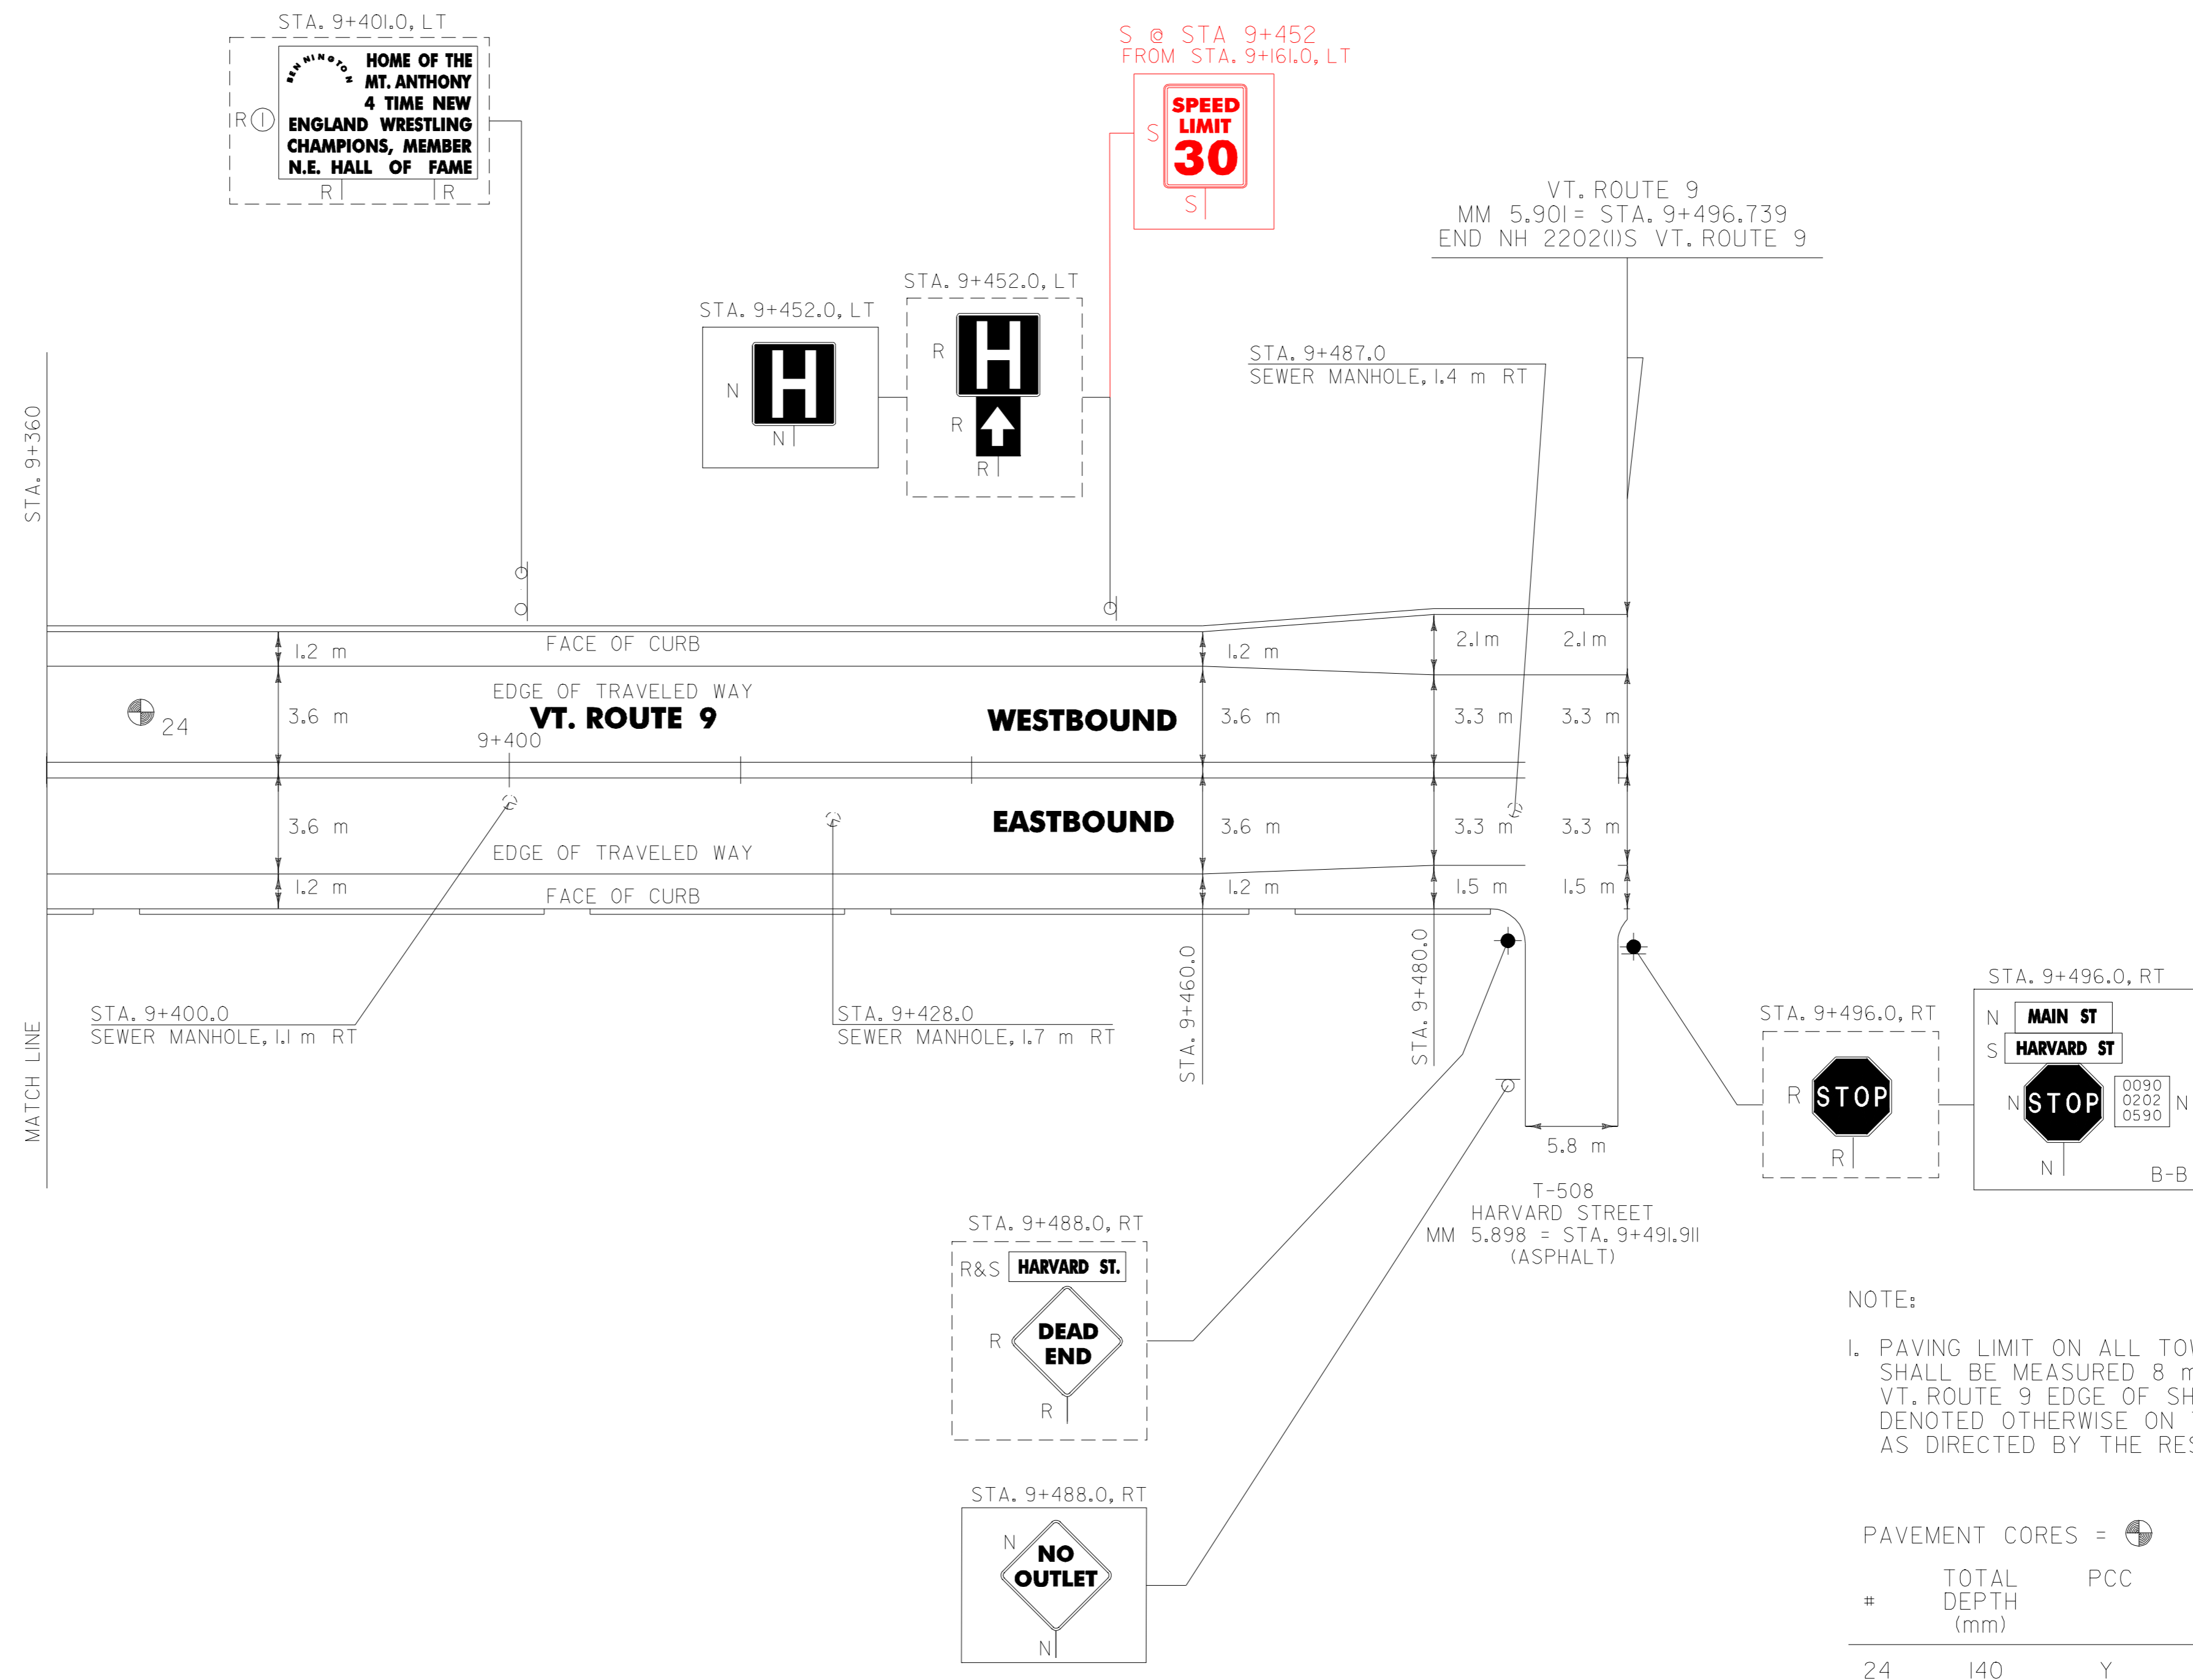

NOTE:
1. PAVING LIMIT ON ALL TOWN HIGHWAYS SHALL BE MEASURED 8 m BACK FROM VT. ROUTE 9 EDGE OF SHOULDER UNLESS DENOTED OTHERWISE ON THE PLANS OR AS DIRECTED BY THE RESIDENT ENGINEER.

PAVEMENT CORES =

#	TOTAL DEPTH (mm)	PCC	COMMENTS
24	140	Y	

604.42 CHANGE ELEVATION OF SEWER MANHOLE

VT. ROUTE 9:
STA. 9+400.0 RT
STA. 9+428.0 RT
STA. 9+487.0 RT

SIGN LEGEND
R= REMOVE
S= SALVAGE
N= NEW
RET= RETAIN
B-B= BACK TO BACK
EXISTING= _____
NEW= _____

PAVING PROJECT LAYOUT # 23

SURVEYED BY N/A DATE N/A
DRAWN BY J.A.R. DATE 4/01
SQUAD LEADER T.P.K.
DESIGN FILE NO. pave/99dl56/pdl56.dgn
IPARM FILE pdl56l23.i DATE PLOT 4/01
PROJ. NAME BENNINGTON
PROJ. NO. NH 2202(1)S
SHEET 36 OF 108 SHEETS

DATUM	
VERTICAL	<u>N/A</u>
HORIZONTAL	<u>N/A</u>

U.S. ROUTE 7:
STA. 4+633.7 LT
STA. 4+633.7 RT
STA. 4+634.3 RT
STA. 4+653.1 LT
STA. 4+653.7 LT
STA. 4+656.7 RT
STA. 4+657.3 RT
STA. 4+657.7 RT
STA. 4+667.7 RT
STA. 4+761.7 RT
STA. 4+855.7 RT
STA. 4+863.7 RT
STA. 4+654 RT

604.42 CHANGE ELEVATION OF SEWER MANHOLE
U.S. ROUTE 7:
STA. 4+633.7 LT
STA. 4+856.7 LT
STA. 4+858.7 LT

629.20 ADJUST ELEVATION OF VALVE BOX
U.S. ROUTE 7:
STA. 4+655.7 RT
STA. 4+666.7 RT
STA. 4+671.7 RT
STA. 4+755.7 RT
STA. 4+861.7 RT
STA. 4+864.7 RT

646.4 DURABLE 100 mm YELLOW LINE
(ALL LINES WILL INCLUDE C/L BREAKS FOR TOWN HIGHWAYS) S=SOLID, D=DASHED
U.S. ROUTE 7:
STA. 4+628.473 - STA. 4+680.0 S
STA. 4+850.0 - STA. 4+880.0 S
STA. 4+663.879 DOUBLE SOLID RT, T-430
STA. 4+680.0 - STA. 4+747.4 DOUBLE SOLID LT
STA. 4+814.0 - STA. 4+850.0 DOUBLE SOLID RT

646.61 TEMPORARY 100 mm YELLOW LINE
(ALL LINES WILL INCLUDE C/L BREAKS FOR TOWN HIGHWAYS) S=SOLID, D=DASHED
U.S. ROUTE 7:
STA. 4+628.473 - STA. 4+680.0 S
STA. 4+850.0 - STA. 4+880.0 S
STA. 4+663.879 DOUBLE SOLID RT, T-430
STA. 4+680.0 - STA. 4+747.4 DOUBLE SOLID LT
STA. 4+814.0 - STA. 4+850.0 DOUBLE SOLID RT

646.4 DURABLE 100 mm WHITE LINE
(ALL LINES WILL INCLUDE EDGE LINE BREAKS AND RADIUS FOR TOWN HIGHWAYS)
U.S. ROUTE 7:
STA. 4+628.473 - STA. 4+730.0 RT
STA. 4+628.473 - STA. 4+634.573 LT, PARKING SPACES
STA. 4+678.9 - STA. 4+697.8 LT, PARKING SPACES
STA. 4+680.0 - STA. 4+730.0 RT, DOTTED LINE
STA. 4+716.0 - STA. 4+741.6 LT, PARKING SPACES
STA. 4+730.0 - STA. 4+752.7 RT, SOLID LINE (LANE LINE)
STA. 4+792.8 - STA. 4+874.9 LT
STA. 4+792.8 - STA. 4+880.0 RT
STA. 4+802.0 - STA. 4+835.0 LT, SOLID LINE (LANE LINE)
STA. 4+835.0 - STA. 4+850.0 LT, DOTTED LINE
STA. 4+871.2 - STA. 4+880.0 LT, PARKING SPACES

646.60 TEMPORARY 100 mm WHITE LINE
(ALL LINES WILL INCLUDE EDGE LINE BREAKS AND RADIUS FOR TOWN HIGHWAYS)
U.S. ROUTE 7:
STA. 4+628.473 - STA. 4+730.0 RT
STA. 4+628.473 - STA. 4+634.573 LT, PARKING SPACES
STA. 4+678.9 - STA. 4+697.8 LT, PARKING SPACES
STA. 4+680.0 - STA. 4+730.0 RT, DOTTED LINE
STA. 4+716.0 - STA. 4+741.6 LT, PARKING SPACES
STA. 4+730.0 - STA. 4+752.7 RT, SOLID LINE (LANE LINE)
STA. 4+792.8 - STA. 4+874.9 LT
STA. 4+792.8 - STA. 4+880.0 RT
STA. 4+802.0 - STA. 4+835.0 LT, SOLID LINE (LANE LINE)
STA. 4+835.0 - STA. 4+850.0 LT, DOTTED LINE
STA. 4+871.2 - STA. 4+880.0 LT, PARKING SPACES

646.46 TEMPORARY 600 mm STOP BAR (TYPE I TAPE)
U.S. ROUTE 7:
STA. 4+663.879 RT, T-430
STA. 4+747.7 RT
STA. 4+753.0 RT
STA. 4+801.7 LT
STA. 4+813.7 LT

646.50 DURABLE LETTER OR SYMBOL (TYPE I TAPE)
U.S. ROUTE 7:
STA. 4+663.879 RT, T-430, *S,T,O,P* (4 EA)
STA. 4+681.9 LT, HANDICAP SYMBOL (1EA)
STA. 4+731.3 RT, *O,N,L,Y* (4 EA)
STA. 4+732.0 RT, ARROW (2 EA)
STA. 4+735.0 RT, ARROW (1EA)
STA. 4+830.0 LT, ARROW (1EA)
STA. 4+833.0 LT, ARROW (2 EA)
STA. 4+833.7 LT, *O,N,L,Y* (4 EA)
STA. 4+810.0 LT, ARROW (2 EA)

646.70 TEMPORARY LETTER OR SYMBOL
U.S. ROUTE 7:
STA. 4+663.879 RT, T-430, *S,T,O,P* (8 EA)
STA. 4+732.0 RT, ARROW (4 EA)
STA. 4+735.0 RT, ARROW (2 EA)
STA. 4+830.0 LT, ARROW (2 EA)
STA. 4+833.0 LT, ARROW (4 EA)


646.51 DURABLE CROSSWALK MARKING WITH DIAGONAL LINES (MOD.)
U.S. ROUTE 7:
STA. 4+663.879 RT, T-430
STA. 4+671.0
STA. 4+764.7
STA. 4+791.6
STA. 4+858.610 RT, T-342

646.71 TEMPORARY CROSSWALK MARKING WITH DIAGONAL LINES
U.S. ROUTE 7:
STA. 4+663.879 RT, T-430
STA. 4+671.0
STA. 4+764.7
STA. 4+791.6
STA. 4+858.610 RT, T-342

675.50 REMOVING SIGNS
AS SHOWN - 18

675.60 ERECTING SALVAGED SIGNS
AS SHOWN - 1
REMOVE & RESET CURB
STA 04+761.7 RT

ITEM 618.30 DETECTABLE WARNING SURFACE
MOD TRUNCATED DOME SURFACE APPLIED
STA 4+656 RT STA 4+850
STA 4+670 RT STA 4+867 RT
STA 4+672 LT & RT

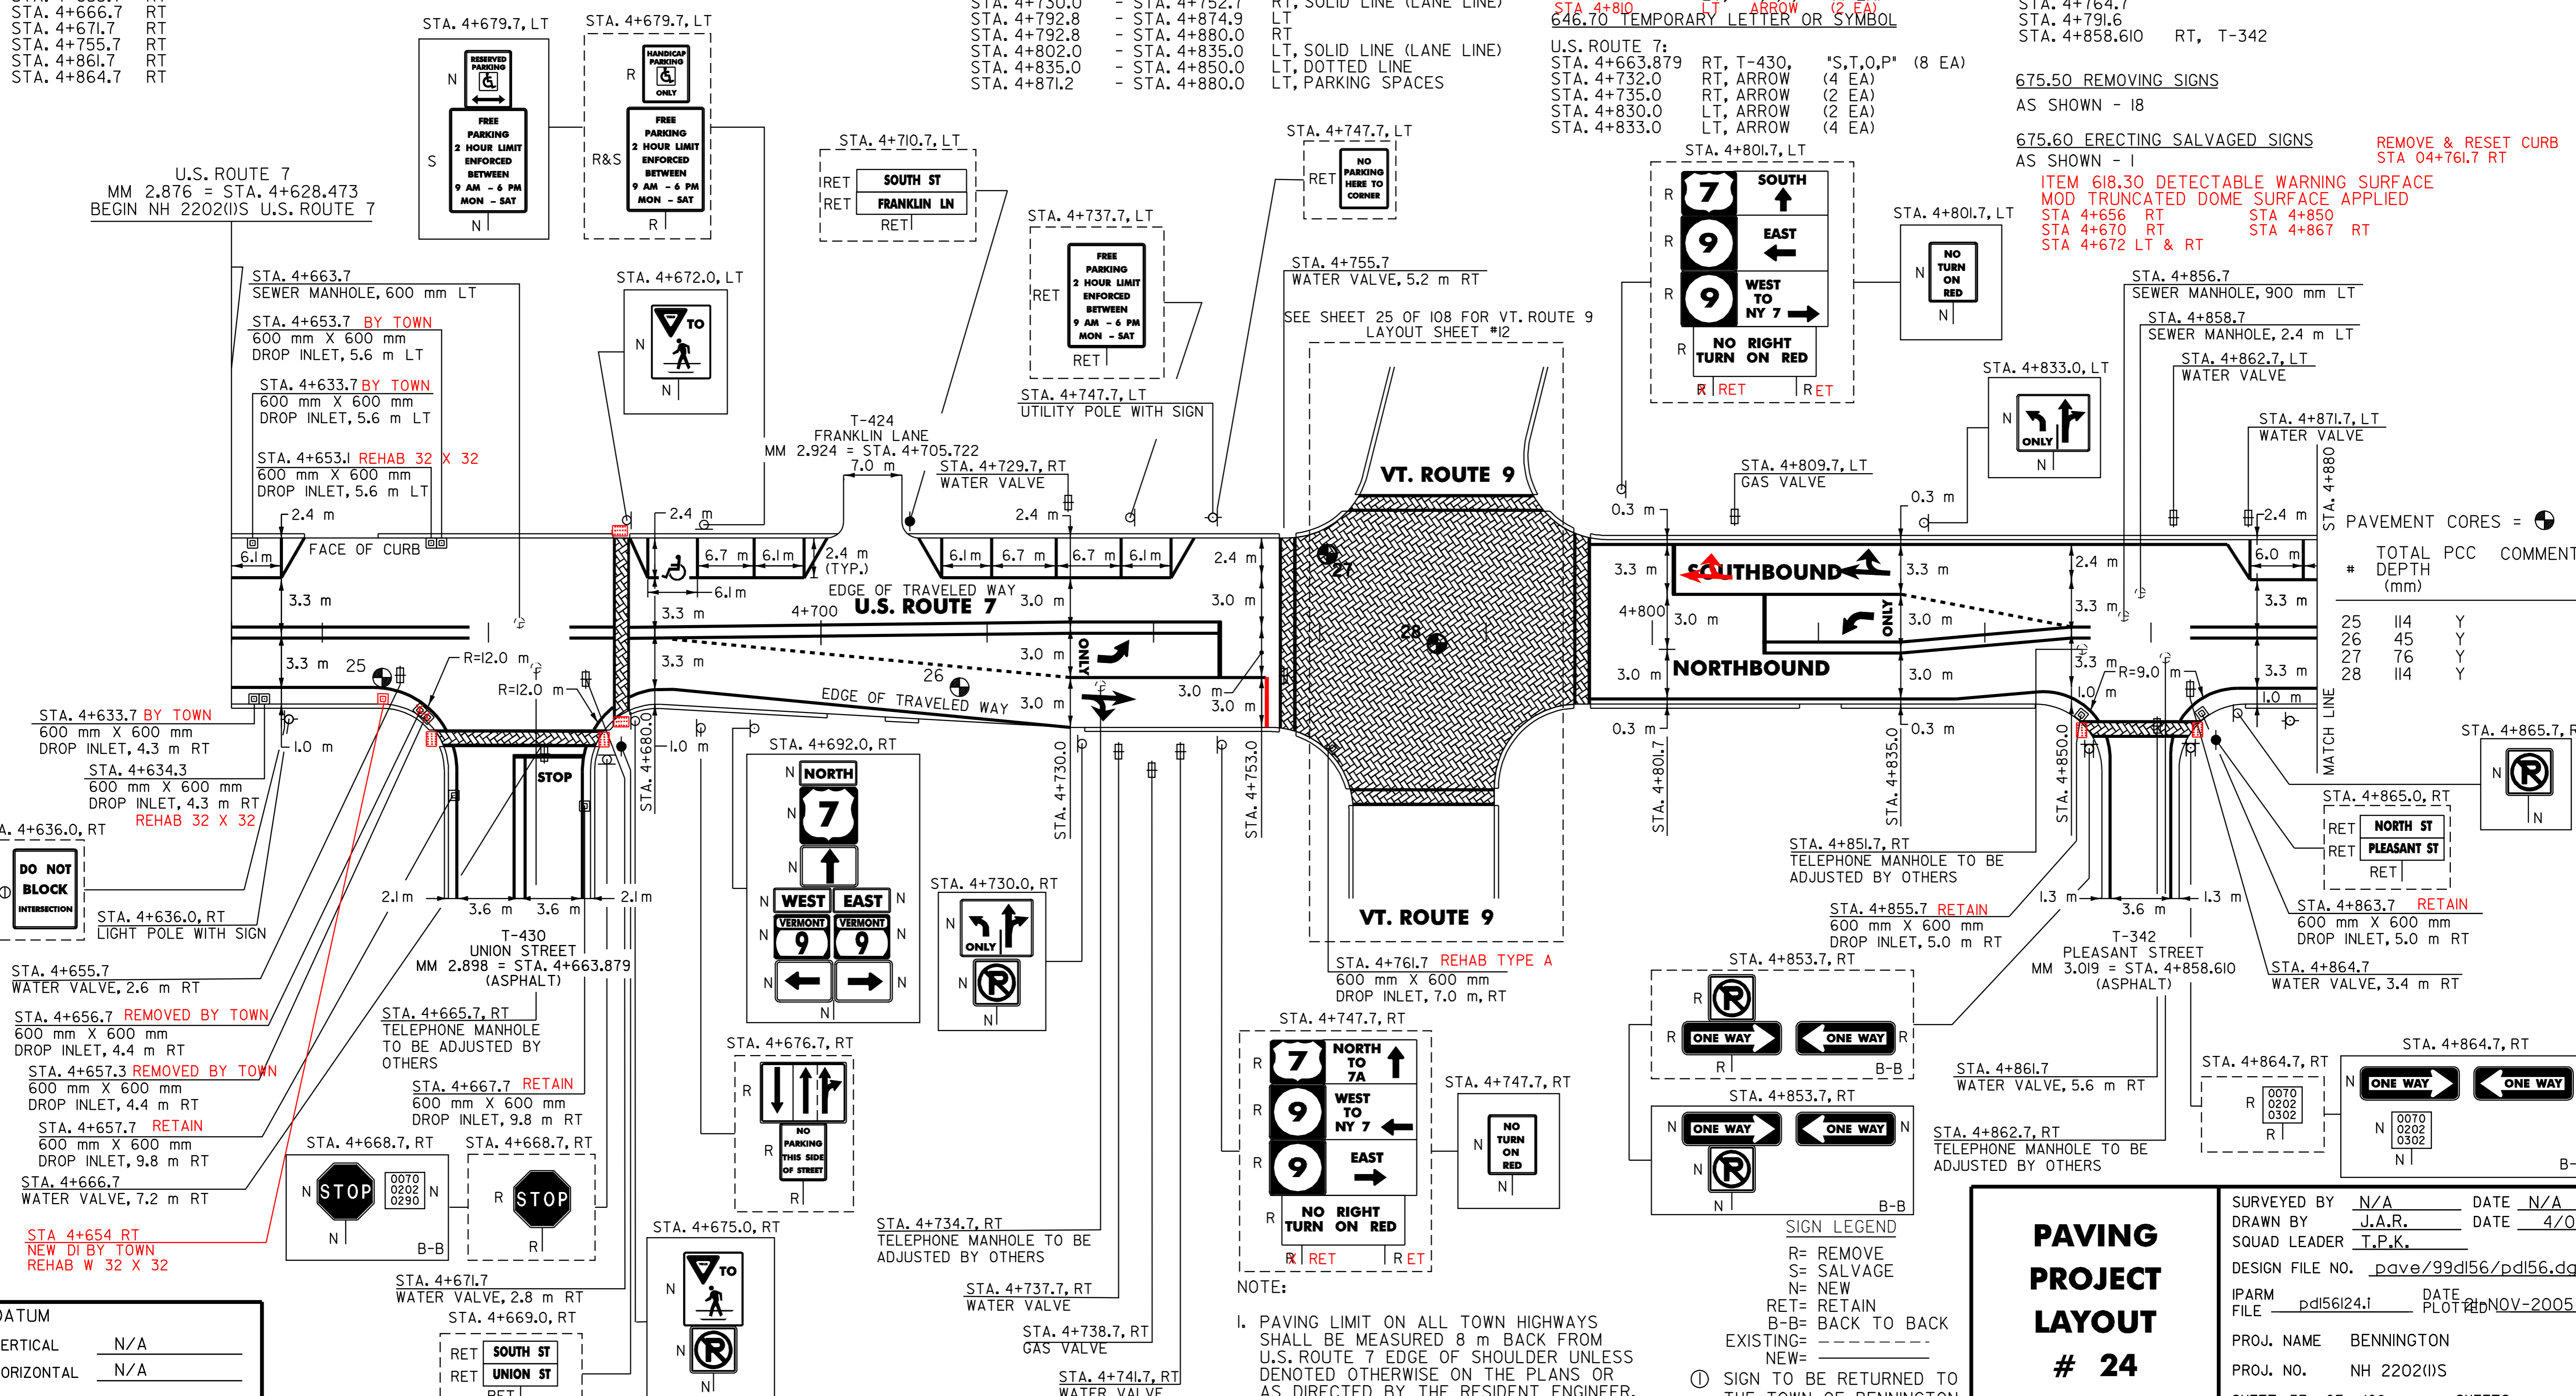

DATUM

VERTICAL	N/A
HORIZONTAL	N/A

PAVING PROJECT LAYOUT # 24

SURVEYED BY N/A DATE N/A
DRAWN BY J.A.R. DATE 4/01
SQUAD LEADER T.P.K.
DESIGN FILE NO. pave/99dl56/pdl56.dgn
IPARM pdl56124.i DATE 4/01
FILE 0202 PLOT 4/01
PROJ. NAME BENNINGTON
PROJ. NO. NH 2202(1)S
SHEET 37 OF 108 SHEETS

NOTE:
1. PAVING LIMIT ON ALL TOWN HIGHWAYS SHALL BE MEASURED 8 m BACK FROM U.S. ROUTE 7 EDGE OF SHOULDER UNLESS DENOTED OTHERWISE ON THE PLANS OR AS DIRECTED BY THE RESIDENT ENGINEER.

Ⓢ SIGN TO BE RETURNED TO THE TOWN OF BENNINGTON

646.4 DURABLE 100 mm YELLOW LINE
 (ALL LINES WILL INCLUDE C/L BREAKS FOR TOWN HIGHWAYS) S=SOLID, D=DASHED

U.S. ROUTE 7:
 STA. 4+880.0 - STA. 5+120.0

646.6 TEMPORARY 100 mm YELLOW LINE
 (ALL LINES WILL INCLUDE C/L BREAKS FOR TOWN HIGHWAYS) S=SOLID, D=DASHED

U.S. ROUTE 7:
 STA. 4+880.0 - STA. 5+120.0

646.40 DURABLE 100 mm WHITE LINE
 (ALL LINES WILL INCLUDE EDGE LINE BREAKS AND RADIUS FOR TOWN HIGHWAYS)

U.S. ROUTE 7:
 STA. 4+880.0 - STA. 5+120.0 RT
 STA. 4+880.0 - STA. 4+896.8 LT, PARKING SPACES
 STA. 4+918.3 - STA. 4+943.9 LT, PARKING SPACES
 STA. 4+951.9 - STA. 4+977.5 LT, PARKING SPACES
 STA. 4+987.6 - STA. 4+999.8 LT, PARKING SPACES
 STA. 5+011.5 - STA. 5+030.4 LT, PARKING SPACES
 STA. 5+030.4 - STA. 5+120.0 LT

646.60 TEMPORARY 100 mm WHITE LINE
 (ALL LINES WILL INCLUDE EDGE LINE BREAKS AND RADIUS FOR TOWN HIGHWAYS)


U.S. ROUTE 7:
 STA. 4+880.0 - STA. 5+120.0 RT
 STA. 4+880.0 - STA. 4+896.8 LT, PARKING SPACES
 STA. 4+918.3 - STA. 4+943.9 LT, PARKING SPACES
 STA. 4+951.9 - STA. 4+977.5 LT, PARKING SPACES
 STA. 4+987.6 - STA. 4+999.8 LT, PARKING SPACES
 STA. 5+011.5 - STA. 5+030.4 LT, PARKING SPACES
 STA. 5+030.4 - STA. 5+120.0 LT

646.5 DURABLE CROSSWALK MARKING WITH DIAGONAL LINES (MOD.)

U.S. ROUTE 7:
 STA. 4+911.5
 STA. 5+046.7

646.7 TEMPORARY CROSSWALK MARKING WITH DIAGONAL LINES


U.S. ROUTE 7:
 STA. 4+911.5
 STA. 5+046.7

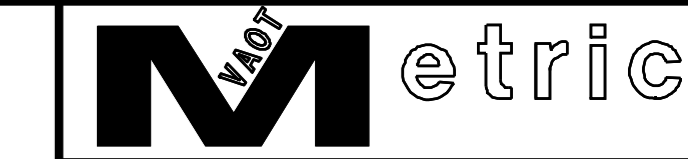

675.50 REMOVING SIGNS
 AS SHOWN - 2

ITEM 618.30 DETECTABLE WARNING SURFACE
 MOD TRUNCATED DOME CAST IN PLACE
 STA 5+047 LT & RT 0.929 m² EA

ITEM 618.30 DETECTABLE WARNING SURFACE
 MOD TRUNCATED DOME SURFACE APPLIED
 STA 4+913 LT & RT 0.743 m² EA

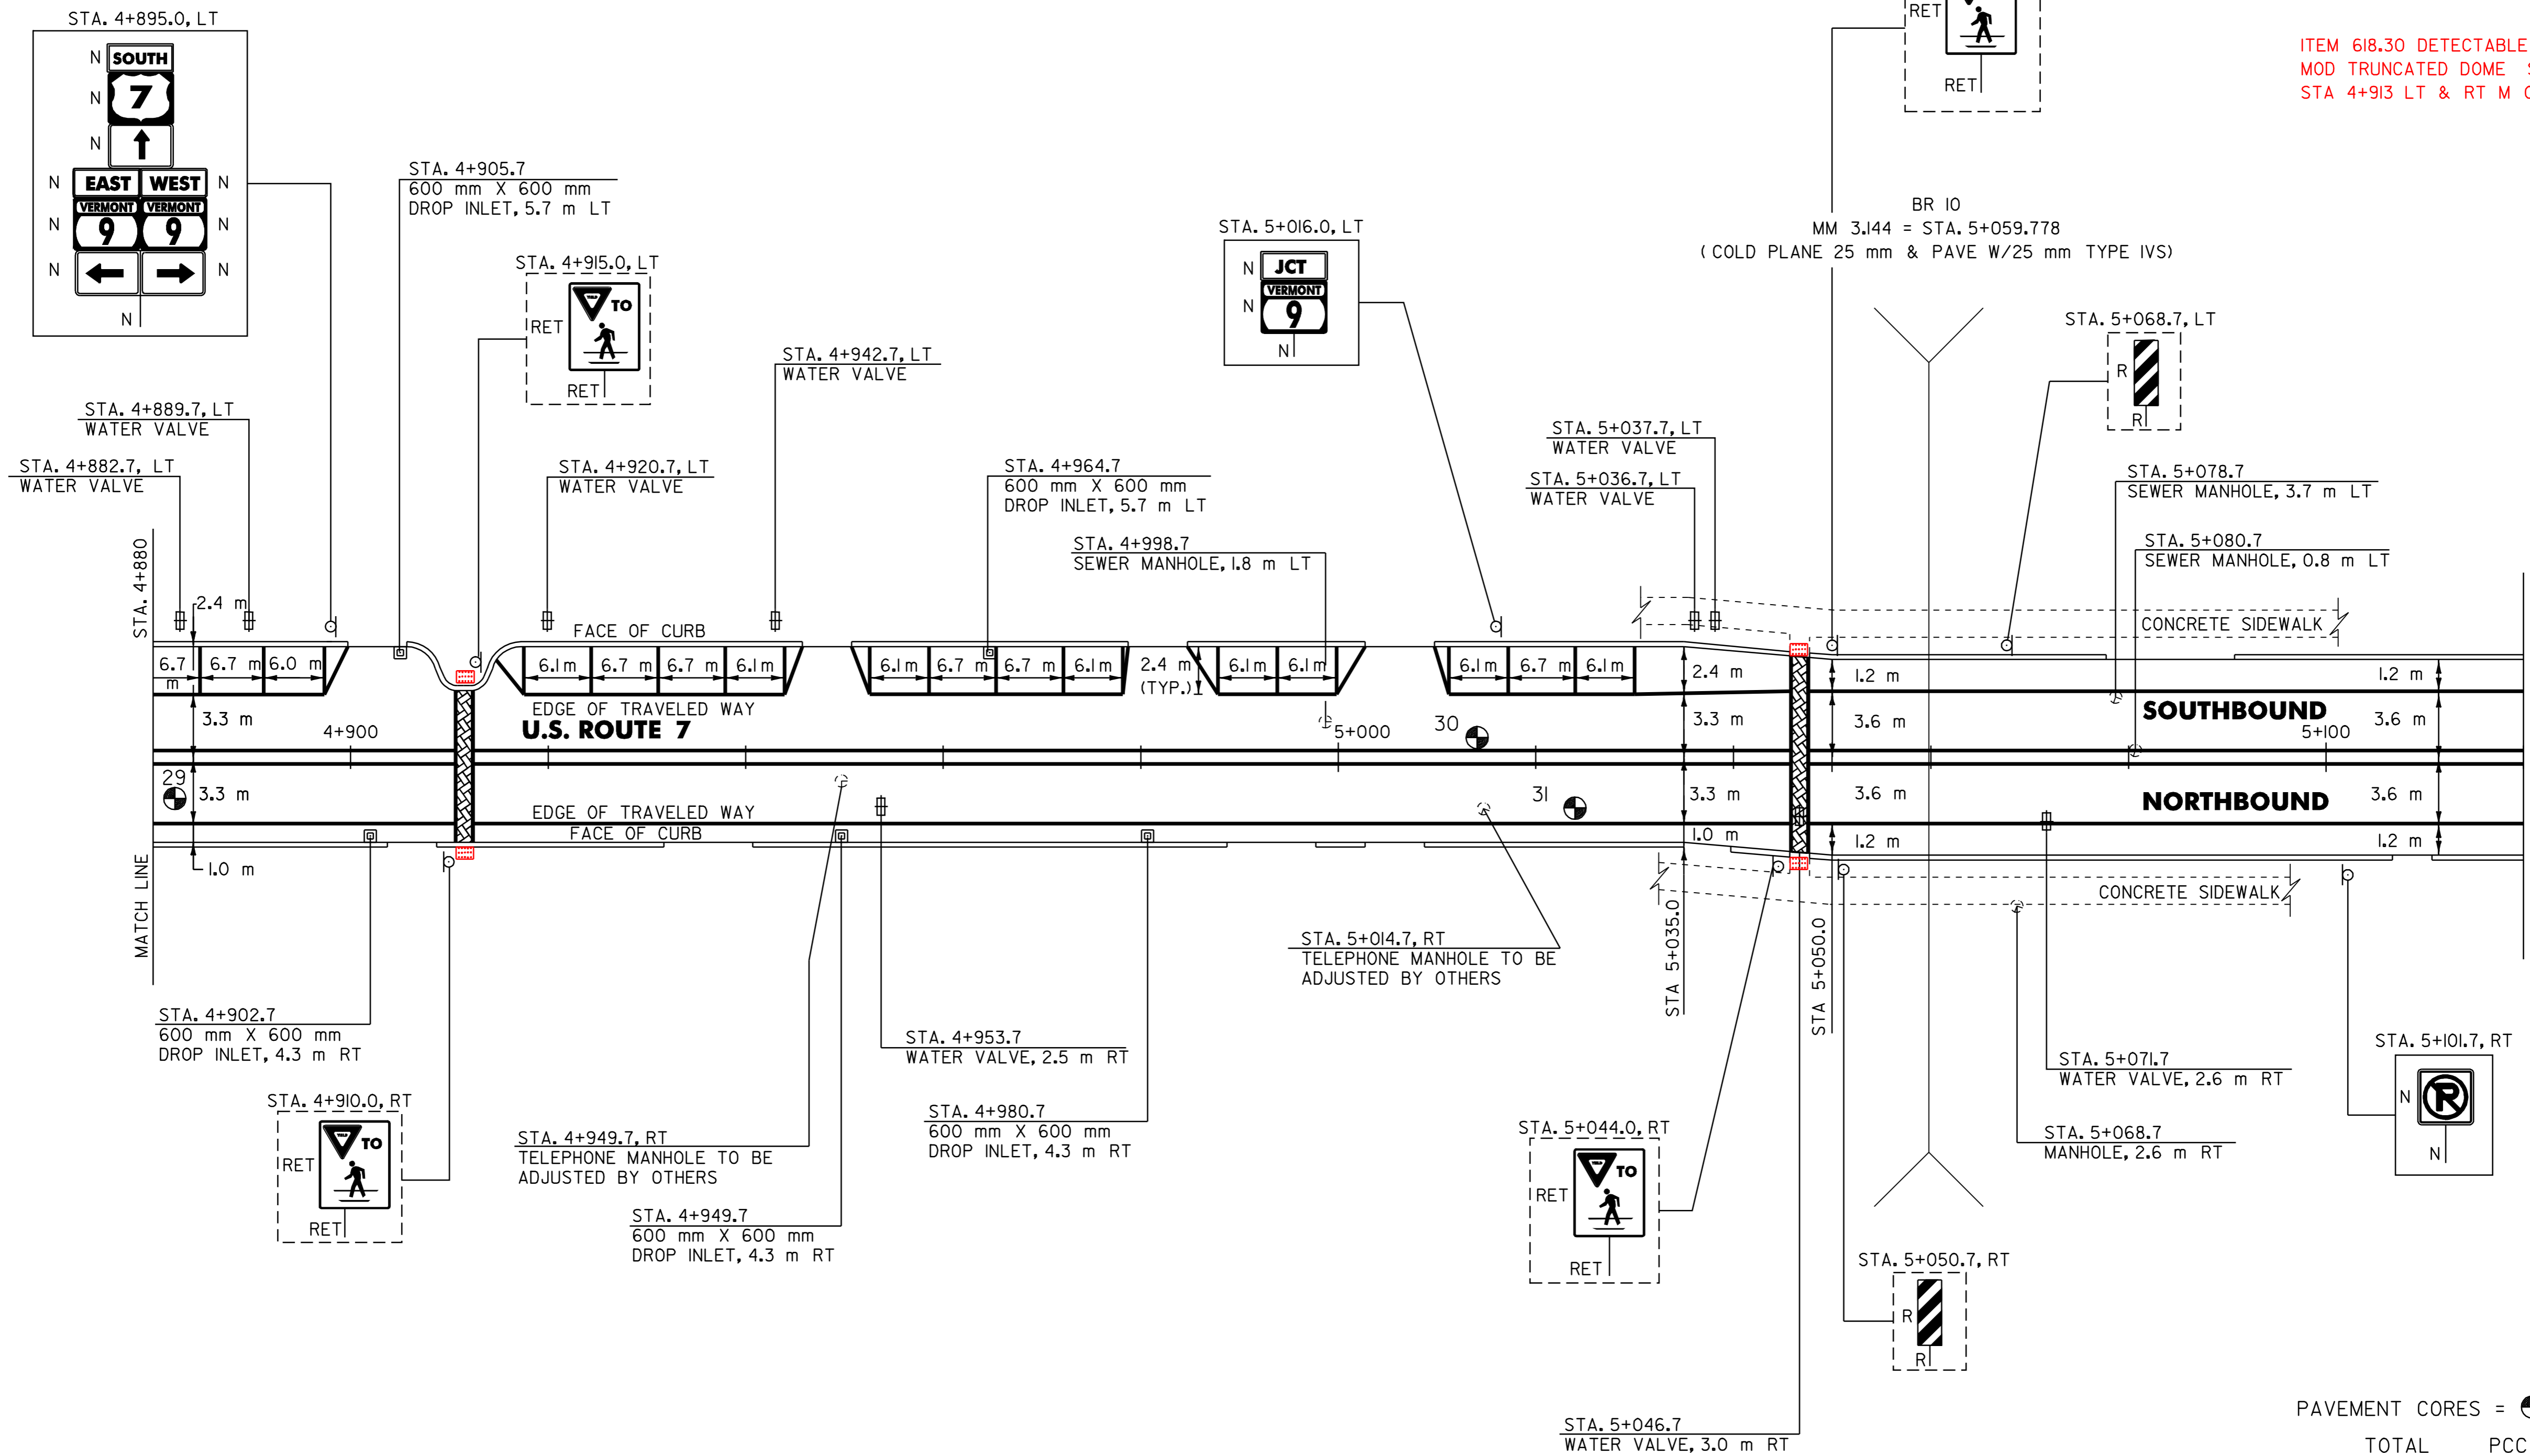

604.40 CHANGE ELEVATION OF DI, CB OR MH

U.S. ROUTE 7:
 STA. 4+902.7 RT
 STA. 4+905.7 LT
 STA. 4+949.7 RT
 STA. 4+964.7 LT
 STA. 4+980.7 RT

604.42 CHANGE ELEVATION OF SEWER MANHOLE

U.S. ROUTE 7:
 STA. 4+998.7 LT
 STA. 5+078.7 LT
 STA. 5+080.7 LT

629.20 ADJUST ELEVATION OF VALVE BOX

U.S. ROUTE 7:
 STA. 4+953.7 RT
 STA. 5+046.7 RT
 STA. 5+071.7 RT

STA 5+ 037 LT & RT

#	TOTAL DEPTH (mm)	PCC	COMMENTS
29	51	Y	
30	133	N	
31	114	-	

SIGN LEGEND
 R= REMOVE
 S= SALVAGE
 N= NEW
 RET= RETAIN
 B-B= BACK TO BACK
 EXISTING= _____
 NEW= _____

PAVING PROJECT LAYOUT # 25

SURVEYED BY N/A DATE N/A
 DRAWN BY J.A.R. DATE 4/01
 SQUAD LEADER T.P.K.
 DESIGN FILE NO. pave/99d156/pdl56.dgn
 IPARM FILE pdl56125.i DATE PLOT 24 NOV-2005 10
 PROJ. NAME BENNINGTON
 PROJ. NO. NH 2202(1)S
 SHEET 38 OF 108 SHEETS

DATUM
 VERTICAL N/A
 HORIZONTAL N/A

646.40 DURABLE 100 mm WHITE LINE
(ALL LINES WILL INCLUDE EDGE LINE BREAKS AND RADIUS FOR TOWN HIGHWAYS)
U.S. ROUTE 7:
STA. 5+120.0 - STA. 5+360.0 LT & RT

646.60 TEMPORARY 100 mm WHITE LINE
(ALL LINES WILL INCLUDE EDGE LINE BREAKS AND RADIUS FOR TOWN HIGHWAYS)
U.S. ROUTE 7:
STA. 5+120.0 - STA. 5+360.0 LT & RT

646.41 DURABLE 100 mm YELLOW LINE
(ALL LINES WILL INCLUDE C/L BREAKS FOR TOWN HIGHWAYS) S=SOLID, D=DASHED
U.S. ROUTE 7:
STA. 5+120.0 - STA. 5+360.0 LT S
STA. 5+183.697 DOUBLE SOLID LT, T-332
STA. 5+289.914 DOUBLE SOLID RT, T-336

646.61 TEMPORARY 100 mm YELLOW LINE
(ALL LINES WILL INCLUDE C/L BREAKS FOR TOWN HIGHWAYS) S=SOLID, D=DASHED
U.S. ROUTE 7:
STA. 5+120.0 - STA. 5+360.0 LT S
STA. 5+183.697 DOUBLE SOLID LT, T-332
STA. 5+289.914 DOUBLE SOLID RT, T-336

646.46 DURABLE 600 mm STOP BAR (TYPE I TAPE)
U.S. ROUTE 7:
STA. 5+183.697 LT, T-332
STA. 5+289.914 RT, T-336

646.66 TEMPORARY 600 mm STOP BAR
U.S. ROUTE 7:
STA. 5+183.697 LT, T-332
STA. 5+289.914 RT, T-336


646.50 DURABLE LETTER OR SYMBOL (TYPE I TAPE)
U.S. ROUTE 7:
STA. 5+183.697 LT, T-332, "S,T,O,P" (4 EA)
STA. 5+289.914 RT, T-336, "S,T,O,P" (4 EA)

646.51 DURABLE CROSSWALK MARKING WITH DIAGONAL LINES (MOD.2)
U.S. ROUTE 7:
STA. 5+141.5
STA. 5+146.682 RT, T-338
STA. 5+183.697 LT, T-332
STA. 5+289.914 RT, T-336

646.71 TEMPORARY CROSSWALK MARKING WITH DIAGONAL LINES
U.S. ROUTE 7:
STA. 5+141.5
STA. 5+146.682 RT, T-338
STA. 5+183.697 LT, T-332
STA. 5+289.914 RT, T-336

675.50 REMOVING SIGNS
AS SHOWN - 12

646.70 TEMPORARY LETTER OR SYMBOL
U.S. ROUTE 7:
STA. 5+183.697 LT, T-332, "S,T,O,P" (8 EA)
STA. 5+289.914 RT, T-336, "S,T,O,P" (8 EA)

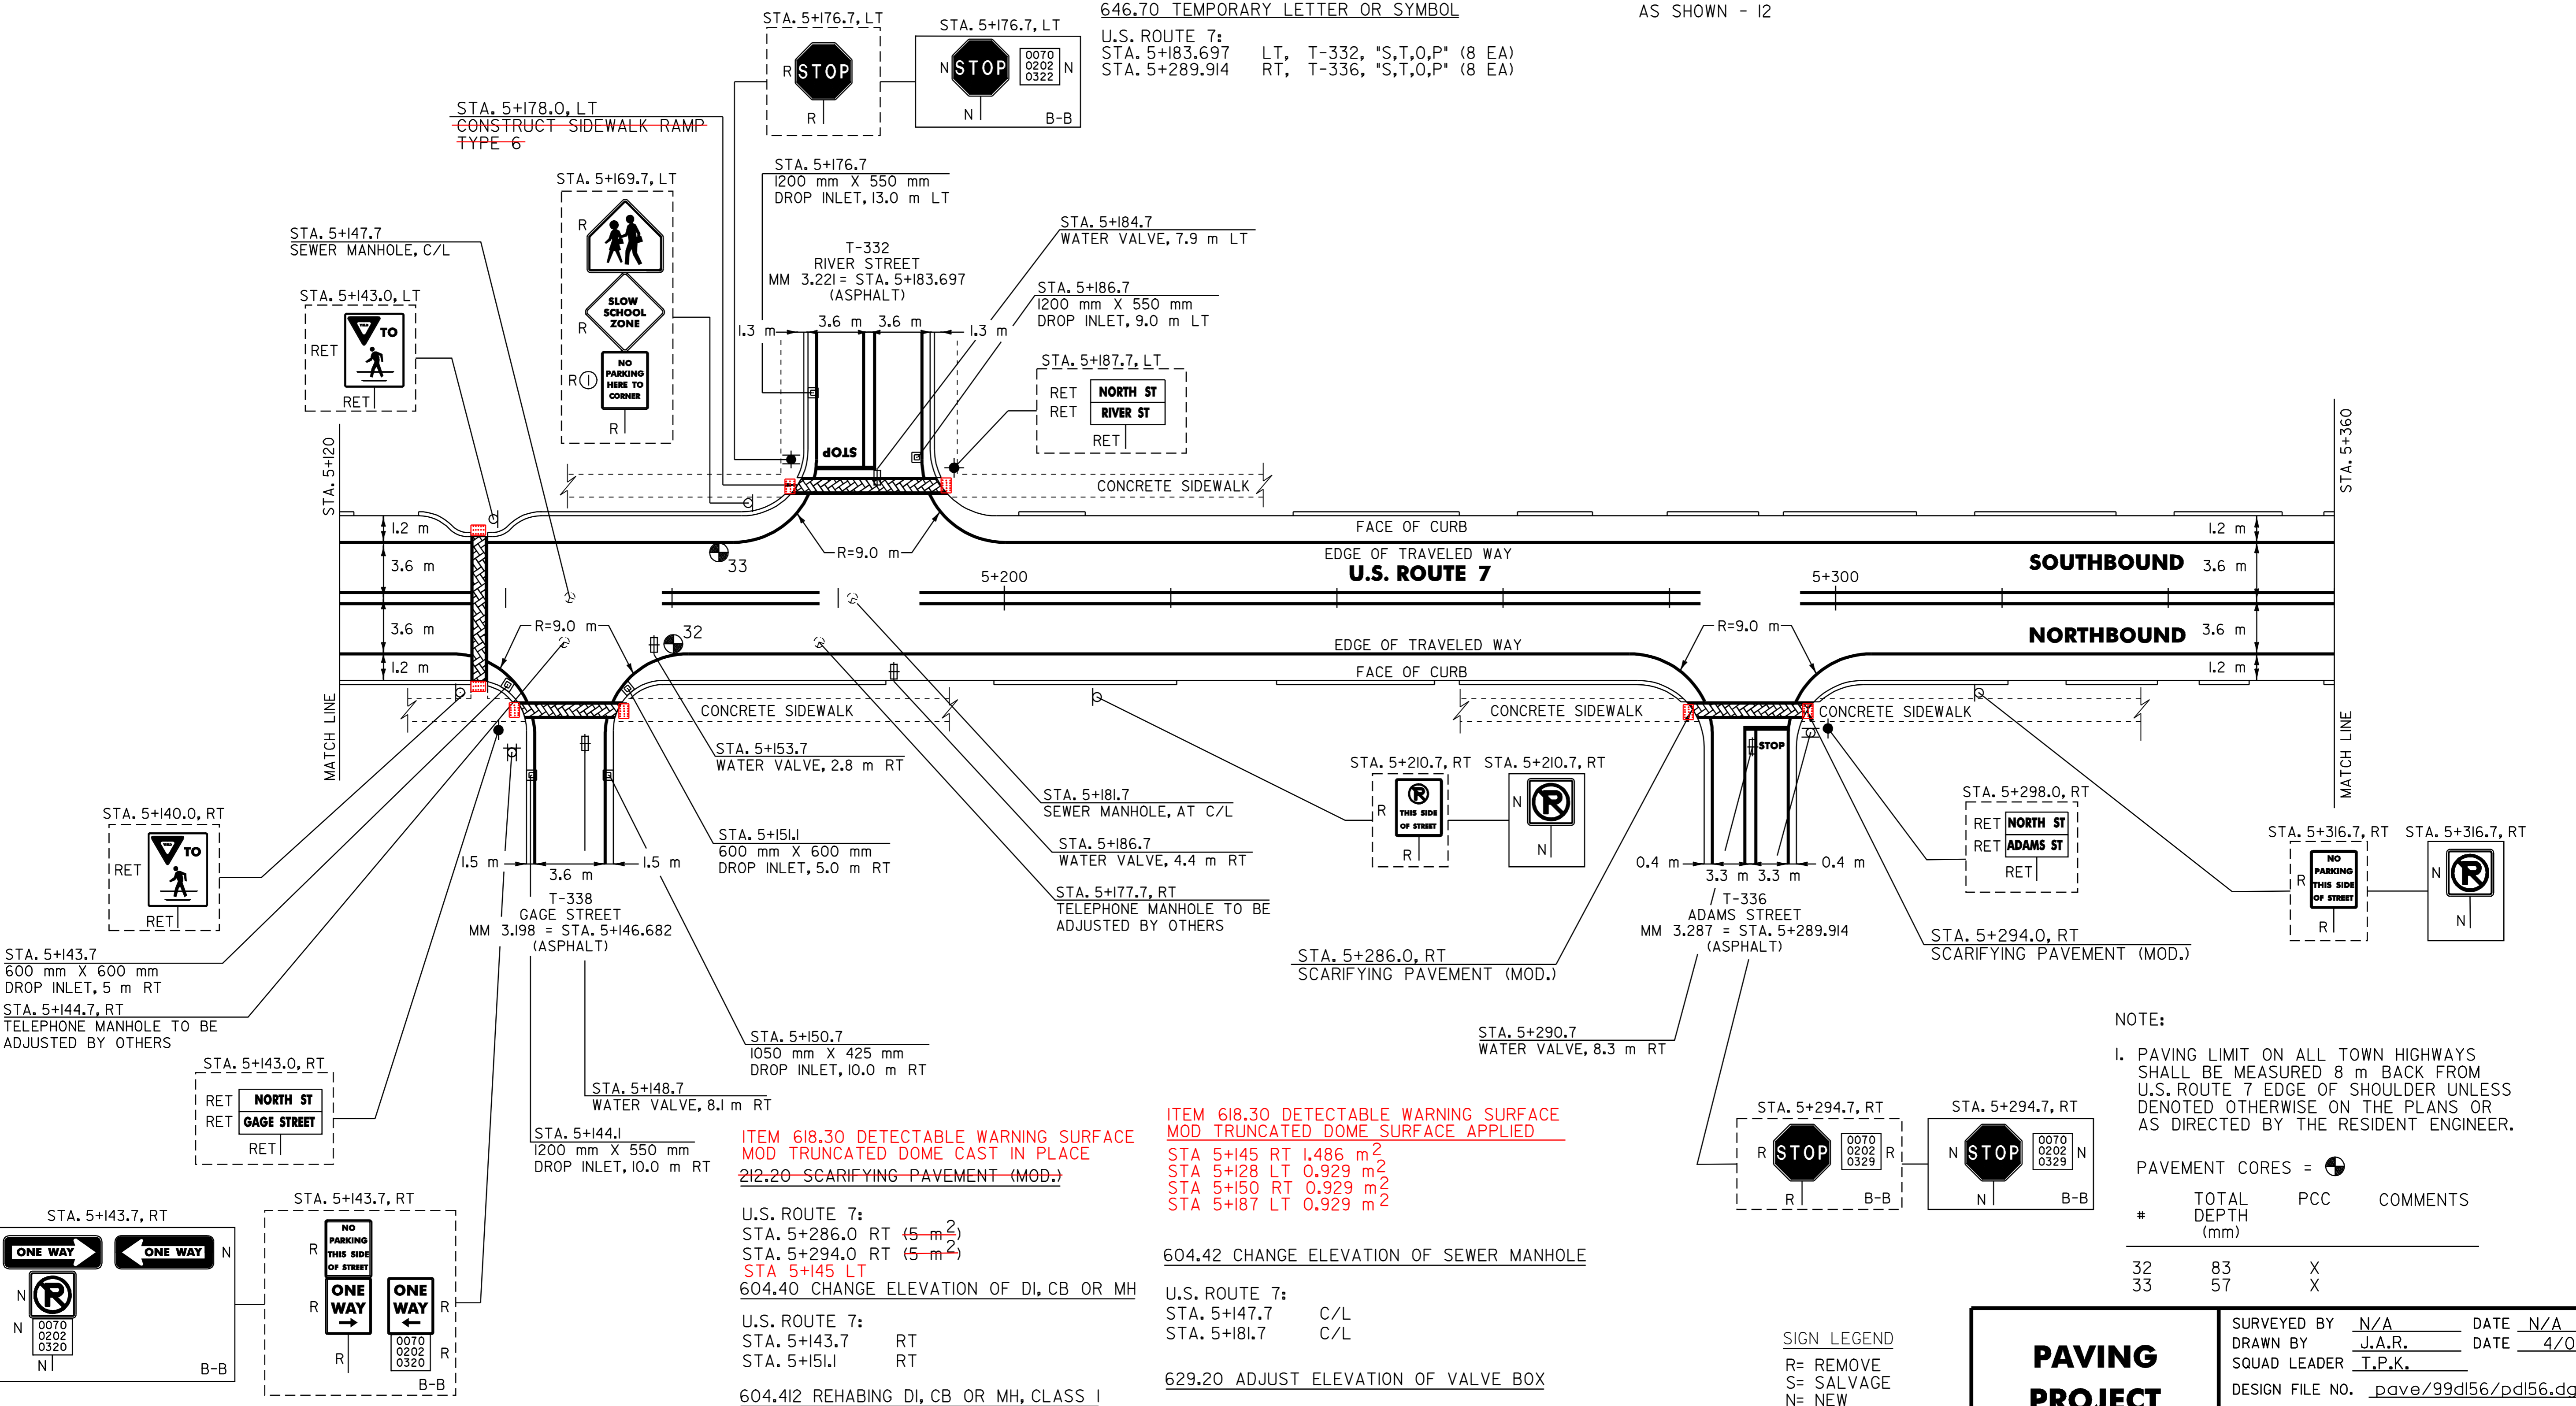

ITEM 618.30 DETECTABLE WARNING SURFACE
MOD TRUNCATED DOME CAST IN PLACE
212.20 SCARIFYING PAVEMENT (MOD.)

ITEM 618.30 DETECTABLE WARNING SURFACE
MOD TRUNCATED DOME SURFACE APPLIED
STA 5+145 RT 1.486 m²
STA 5+128 LT 0.929 m²
STA 5+150 RT 0.929 m²
STA 5+187 LT 0.929 m²

U.S. ROUTE 7:
STA. 5+286.0 RT (5-m²)
STA. 5+294.0 RT (5-m²)
STA 5+145 LT
604.40 CHANGE ELEVATION OF DI, CB OR MH

U.S. ROUTE 7:
STA. 5+143.7 RT
STA. 5+151.1 RT

604.412 REHABING DI, CB OR MH, CLASS I

U.S. ROUTE 7:
STA. 5+144.1 RT
STA. 5+150.7 RT
STA. 5+176.7 LT
STA. 5+186.7 LT

604.42 CHANGE ELEVATION OF SEWER MANHOLE
U.S. ROUTE 7:
STA. 5+147.7 C/L
STA. 5+181.7 C/L

629.20 ADJUST ELEVATION OF VALVE BOX
U.S. ROUTE 7:
STA. 5+148.7 RT
STA. 5+153.7 RT
STA. 5+184.7 LT
STA. 5+186.7 RT
STA. 5+290.7 RT

NOTE:
1. PAVING LIMIT ON ALL TOWN HIGHWAYS SHALL BE MEASURED 8 m BACK FROM U.S. ROUTE 7 EDGE OF SHOULDER UNLESS DENOTED OTHERWISE ON THE PLANS OR AS DIRECTED BY THE RESIDENT ENGINEER.

PAVEMENT CORES =

#	TOTAL DEPTH (mm)	PCC	COMMENTS
32	83	X	
33	57	X	

SIGN LEGEND
R= REMOVE
S= SALVAGE
N= NEW
RET= RETAIN
B-B= BACK TO BACK
EXISTING= -----
NEW= _____
Ⓢ SIGN TO BE RETURNED TO THE TOWN OF BENNINGTON

PAVING PROJECT LAYOUT # 26

SURVEYED BY N/A DATE N/A
DRAWN BY J.A.R. DATE 4/01
SQUAD LEADER T.P.K.
DESIGN FILE NO. pave/99dl56/pdl56.dgn
IPARM FILE pdl56l26.l DATE PLOT 24 NOV-2005 10
PROJ. NAME BENNINGTON
PROJ. NO. NH 2202(1)S
SHEET 39 OF 108 SHEETS

DATUM
VERTICAL N/A
HORIZONTAL N/A

646.40 DURABLE 100 mm WHITE LINE
 (ALL LINES WILL INCLUDE EDGE LINE BREAKS AND RADIUS FOR TOWN HIGHWAYS)
 U.S. ROUTE 7:
 STA. 5+360.0 - STA. 5+492.691 LT & RT

646.60 TEMPORARY 100 mm WHITE LINE
 (ALL LINES WILL INCLUDE EDGE LINE BREAKS AND RADIUS FOR TOWN HIGHWAYS)
 U.S. ROUTE 7:
 STA. 5+360.0 - STA. 5+492.691 LT & RT

646.41 DURABLE 100 mm YELLOW LINE
 (ALL LINES WILL INCLUDE C/L BREAKS FOR TOWN HIGHWAYS) S=SOLID, D=DASHED
 U.S. ROUTE 7:
 STA. 5+360.0 - STA. 5+436.4 S - S
 STA. 5+464.0 - STA. 5+492.691 S - S
 STA. 5+450.848 DOUBLE SOLID RT, T-5
 STA. 5+450.848 DOUBLE SOLID LT, T-326

646.61 TEMPORARY 100 mm YELLOW LINE
 (ALL LINES WILL INCLUDE C/L BREAKS FOR TOWN HIGHWAYS) S=SOLID, D=DASHED
 U.S. ROUTE 7:
 STA. 5+360.0 - STA. 5+436.4 S - S
 STA. 5+464.0 - STA. 5+492.691 S - S
 STA. 5+450.848 DOUBLE SOLID RT, T-5
 STA. 5+450.848 DOUBLE SOLID LT, T-326

646.46 DURABLE 600 mm STOP BAR (TYPE I TAPE)
 U.S. ROUTE 7:
 STA. 5+436.7 RT
 STA. 5+450.848 LT, T-326
 STA. 5+450.848 RT, T-5
 STA. 5+463.7 LT

646.66 TEMPORARY 600 mm STOP BAR
 U.S. ROUTE 7:
 STA. 5+436.7 RT
 STA. 5+450.848 LT, T-326
 STA. 5+450.848 RT, T-5
 STA. 5+463.7 LT


646.51 DURABLE CROSSWALK MARKING WITH DIAGONAL LINES (MOD.)
 U.S. ROUTE 7:
 STA. 5+443.7
 STA. 5+450.848 LT, T-326
 STA. 5+450.848 RT, T-5

646.71 TEMPORARY CROSSWALK MARKING WITH DIAGONAL LINES
 U.S. ROUTE 7:
 STA. 5+443.7
 STA. 5+450.848 LT, T-326
 STA. 5+450.848 RT, T-5

675.50 REMOVING SIGNS
 AS SHOWN - 2

ITEM 618.30 DETECTABLE WARNING SURFACE
 MOD TRUNCATED DOME SURFACE MOUNT
 STA 5+442 LT 1.672 m²
 STA 5+447 LT 0.743 m²
 STA 5+455 RT 0.743 m²

ITEM 618.30 DETECTABLE WARNING SURFACE
 MOD TRUNCATED DOME CAST IN PLACE
 STA 5+442 RT 1.858 m²

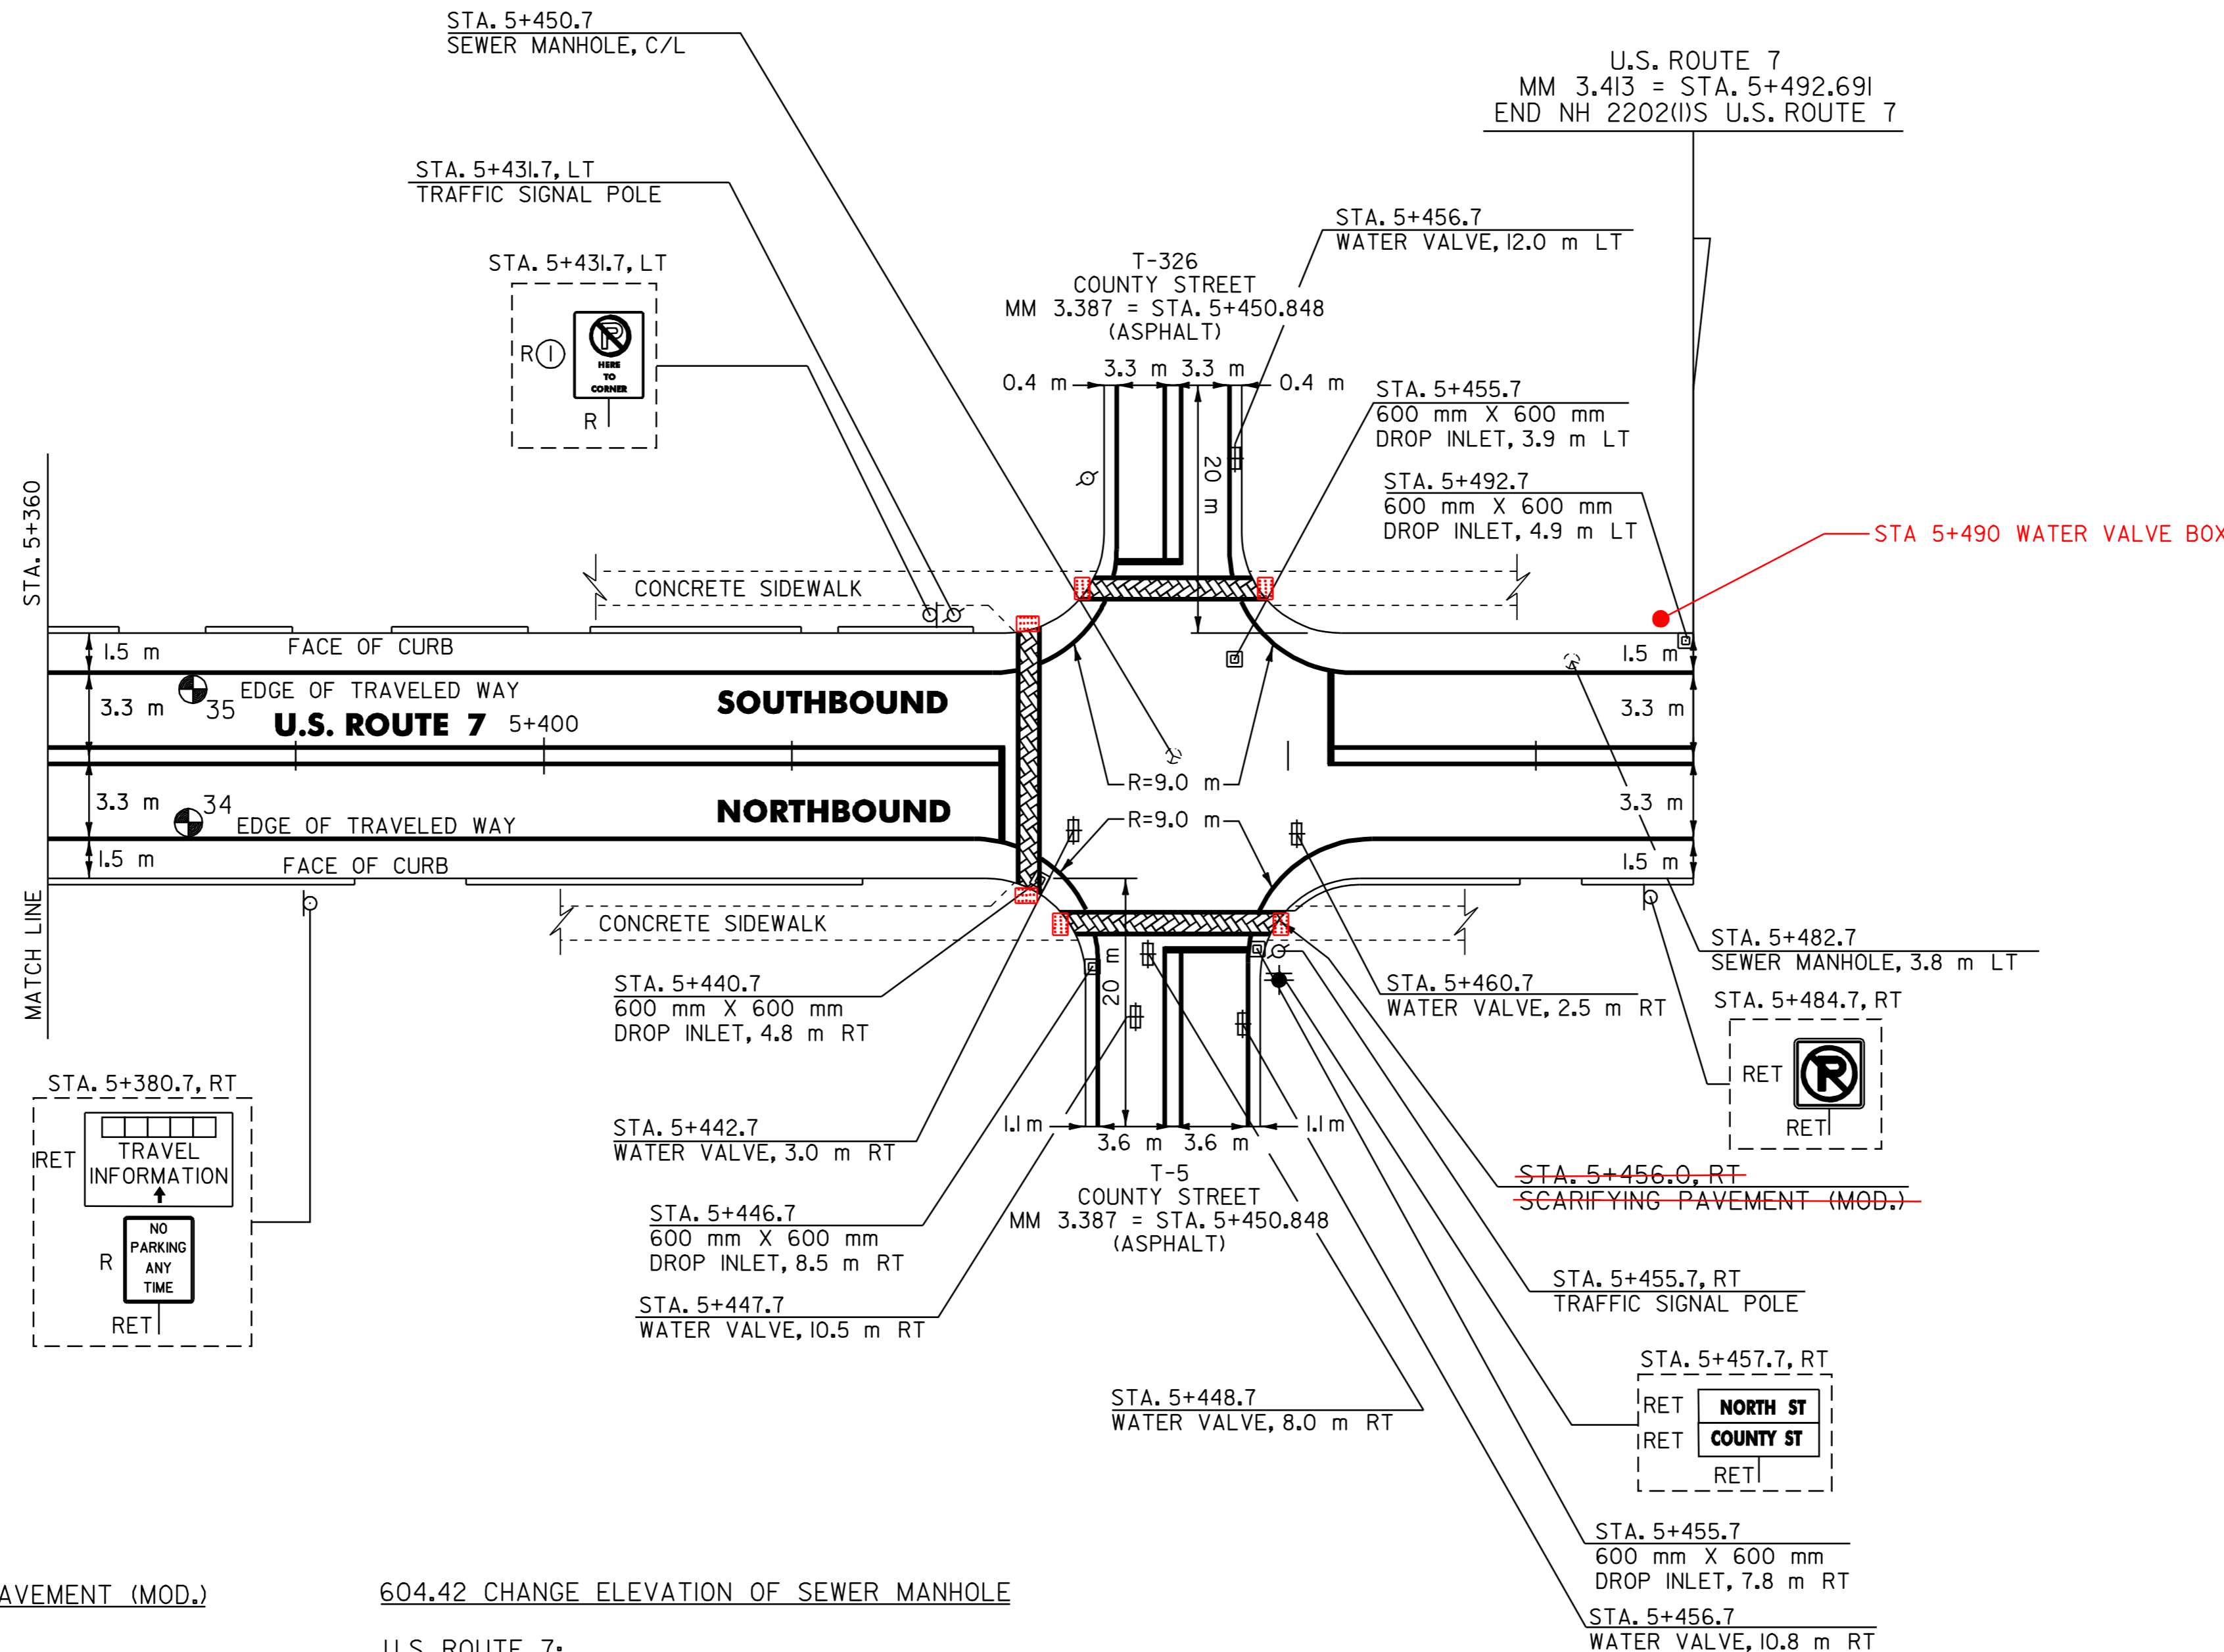

212.20 SCARIFYING PAVEMENT (MOD.)
 U.S. ROUTE 7:
 STA. 5+456.0 RT (R m²)

604.40 CHANGE ELEVATION OF DI, CB OR MH
 U.S. ROUTE 7:
 STA. 5+440.7 RT
 STA. 5+446.7 RT
 STA. 5+455.7 LT
 STA. 5+455.7 RT
 STA. 5+492.7 LT

604.42 CHANGE ELEVATION OF SEWER MANHOLE
 U.S. ROUTE 7:
 STA. 5+450.7 C/L
 STA. 5+482.7 LT

629.20 ADJUST ELEVATION OF VALVE BOX
 U.S. ROUTE 7:
 STA. 5+442.7 RT
 STA. 5+447.7 RT
 STA. 5+448.7 RT
 STA. 5+456.7 RT
 STA. 5+456.7 LT
 STA. 5+460.7 RT

STA. 5+490 LT

NOTE:
 1. PAVING LIMIT ON ALL TOWN HIGHWAYS SHALL BE MEASURED 8 m BACK FROM U.S. ROUTE 7 EDGE OF SHOULDER UNLESS DENOTED OTHERWISE ON THE PLANS OR AS DIRECTED BY THE RESIDENT ENGINEER.

PAVEMENT CORES =

#	TOTAL DEPTH (mm)	PCC	COMMENTS
34	89	Y	
35	57	Y	

SIGN LEGEND
 R= REMOVE
 S= SALVAGE
 N= NEW
 RET= RETAIN
 B-B= BACK TO BACK
 EXISTING= _____
 NEW= _____

Ⓢ SIGN TO BE RETURNED TO THE TOWN OF BENNINGTON

PAVING PROJECT LAYOUT # 27

SURVEYED BY N/A DATE N/A
 DRAWN BY J.A.R. DATE 4/01
 SQUAD LEADER T.P.K.

DESIGN FILE NO. pave/99dl56/pdl56.dgn
 IPARM pdl56i27.i DATE 27 NOV-2005 10:47
 FILE PLT27.dwg

PROJ. NAME BENNINGTON
 PROJ. NO. NH 2202(1)S
 SHEET 40 OF 108 SHEETS

DATUM	
VERTICAL	<u>N/A</u>
HORIZONTAL	<u>N/A</u>

678.22 VEHICLE LOOP DETECTOR

LOOP 2 - 42 m
 LOOP 4 - 41m
 LOOP 6 - 42 m
 LOOP 8 - 42 m

678.23 WIRED CONDUIT (DN4I)

LOOP 4 TO JBI - 1m
 LOOP 6 TO JB2 - 1m
 LOOP 8 TO JB3 - 1m
 LOOP 2 TO JB4 - 1m

678.26 JUNCTION BOX

JBI-STA. 6+622.0 LT
 JB2-STA. 6+656.0 LT
 JB3-STA. 6+641.0 RT
 JB4-STA. 6+596.0 RT
 USED EXISTING JUNCTION BOXES


VEHICLE LOOP DETECTORS							TEST RESULTS AT JUNCTION BOX				TEST RESULTS AT CONTROLLER (FUTURE USE) **					
LANE	LOOP NO.	SIZE	TYPE	NO TURNS	MODE	AMP	INDUCTANCE (uH)		RESISTANCE Ω @ 25°C		(MΩ)	INDUCTANCE (uH)		RESISTANCE Ω @ 25°C		(MΩ)
							CALCULATED	MEASURED	CALCULATED	MEASURED	LEAKAGE TO GROUND	CALCULATED	MEASURED	CALCULATED	MEASURED	LEAKAGE TO GROUND
EB THRU	△	1.8m x 12.0m	QUAD.	2	PRESENCE	NON-DELAY	336		0.59			396		1.36		
SB THRU	△	1.8m x 12.0m	QUAD.	2	PRESENCE	NON-DELAY	335		0.58			355		0.83		
WB THRU	△	1.8m x 12.0m	QUAD.	2	PRESENCE	NON-DELAY	336		0.59			349		0.75		
NB THRU	△	1.8m x 12.0m	QUAD.	2	PRESENCE	NON-DELAY	335		0.58			390		1.27		

* MEASURED VALUES MUST BE FILLED IN PRIOR TO TEST PERIOD.

** CALCULATED VALUES AT CONTROLLER ARE BASED ON DIRECT CONDUIT ROUTING TO THE NEAREST SIGNAL POLE AND CROSSING THE SPAN WIRE AS NECESSARY TO THE EXISTING CONTROLLER LOCATION. ANY SIGNAL MODIFICATION AND/OR CONTROLLER RELOCATION PRIOR TO LOOP CONNECTION WILL REQUIRE RECALCULATION OF THESE VALUES.

NOTES:

1. THIS PLAN SHEET IS NOT TO SCALE AND SHALL ONLY BE USED AS A GUIDE FOR LOOP AND JUNCTION BOX PLACEMENT. THE CONTRACTOR SHALL CONFIRM ALL LOCATIONS IN THE FIELD WITH THE RESIDENT ENGINEER PRIOR TO INSTALLATION.
2. LOOPS ARE TO BE TERMINATED AT THE JUNCTION BOX WITH 1m SLACK PER LOOP WIRE COILED NEATLY WITHIN THE BOX. LOOPS WILL NOT BE CONNECTED TO THE CONTROLLER AT THIS TIME.
3. ALL LOOPS WILL EXTEND 1m PAST THE CENTER OF THE STOP BAR ON EACH APPROACH.
4. LOOPS SHALL BE INSTALLED IN THE PAVEMENT PRIOR TO THE PLACEMENT OF THE WEARING COURSE.
5. IF WATER VALVES, DROP INLETS OR OTHER OBSTRUCTIONS ARE ENCOUNTERED WITHIN THE AREA OF A PROPOSED LOOP, THE CONTRACTOR SHALL TAKE SPECIAL CARE TO AVOID THE OBSTRUCTION DURING LOOP INSTALLATION. IF LOOP SIZES OR SHAPES ARE TO BE MODIFIED DUE TO OBSTRUCTIONS THE RESIDENT ENGINEER MUST APPROVE LAYOUT PRIOR TO INSTALLATION.
6. SEE SHEET 11 OF 108 FOR ITEM DETAIL SUMMARY SHEET #1.

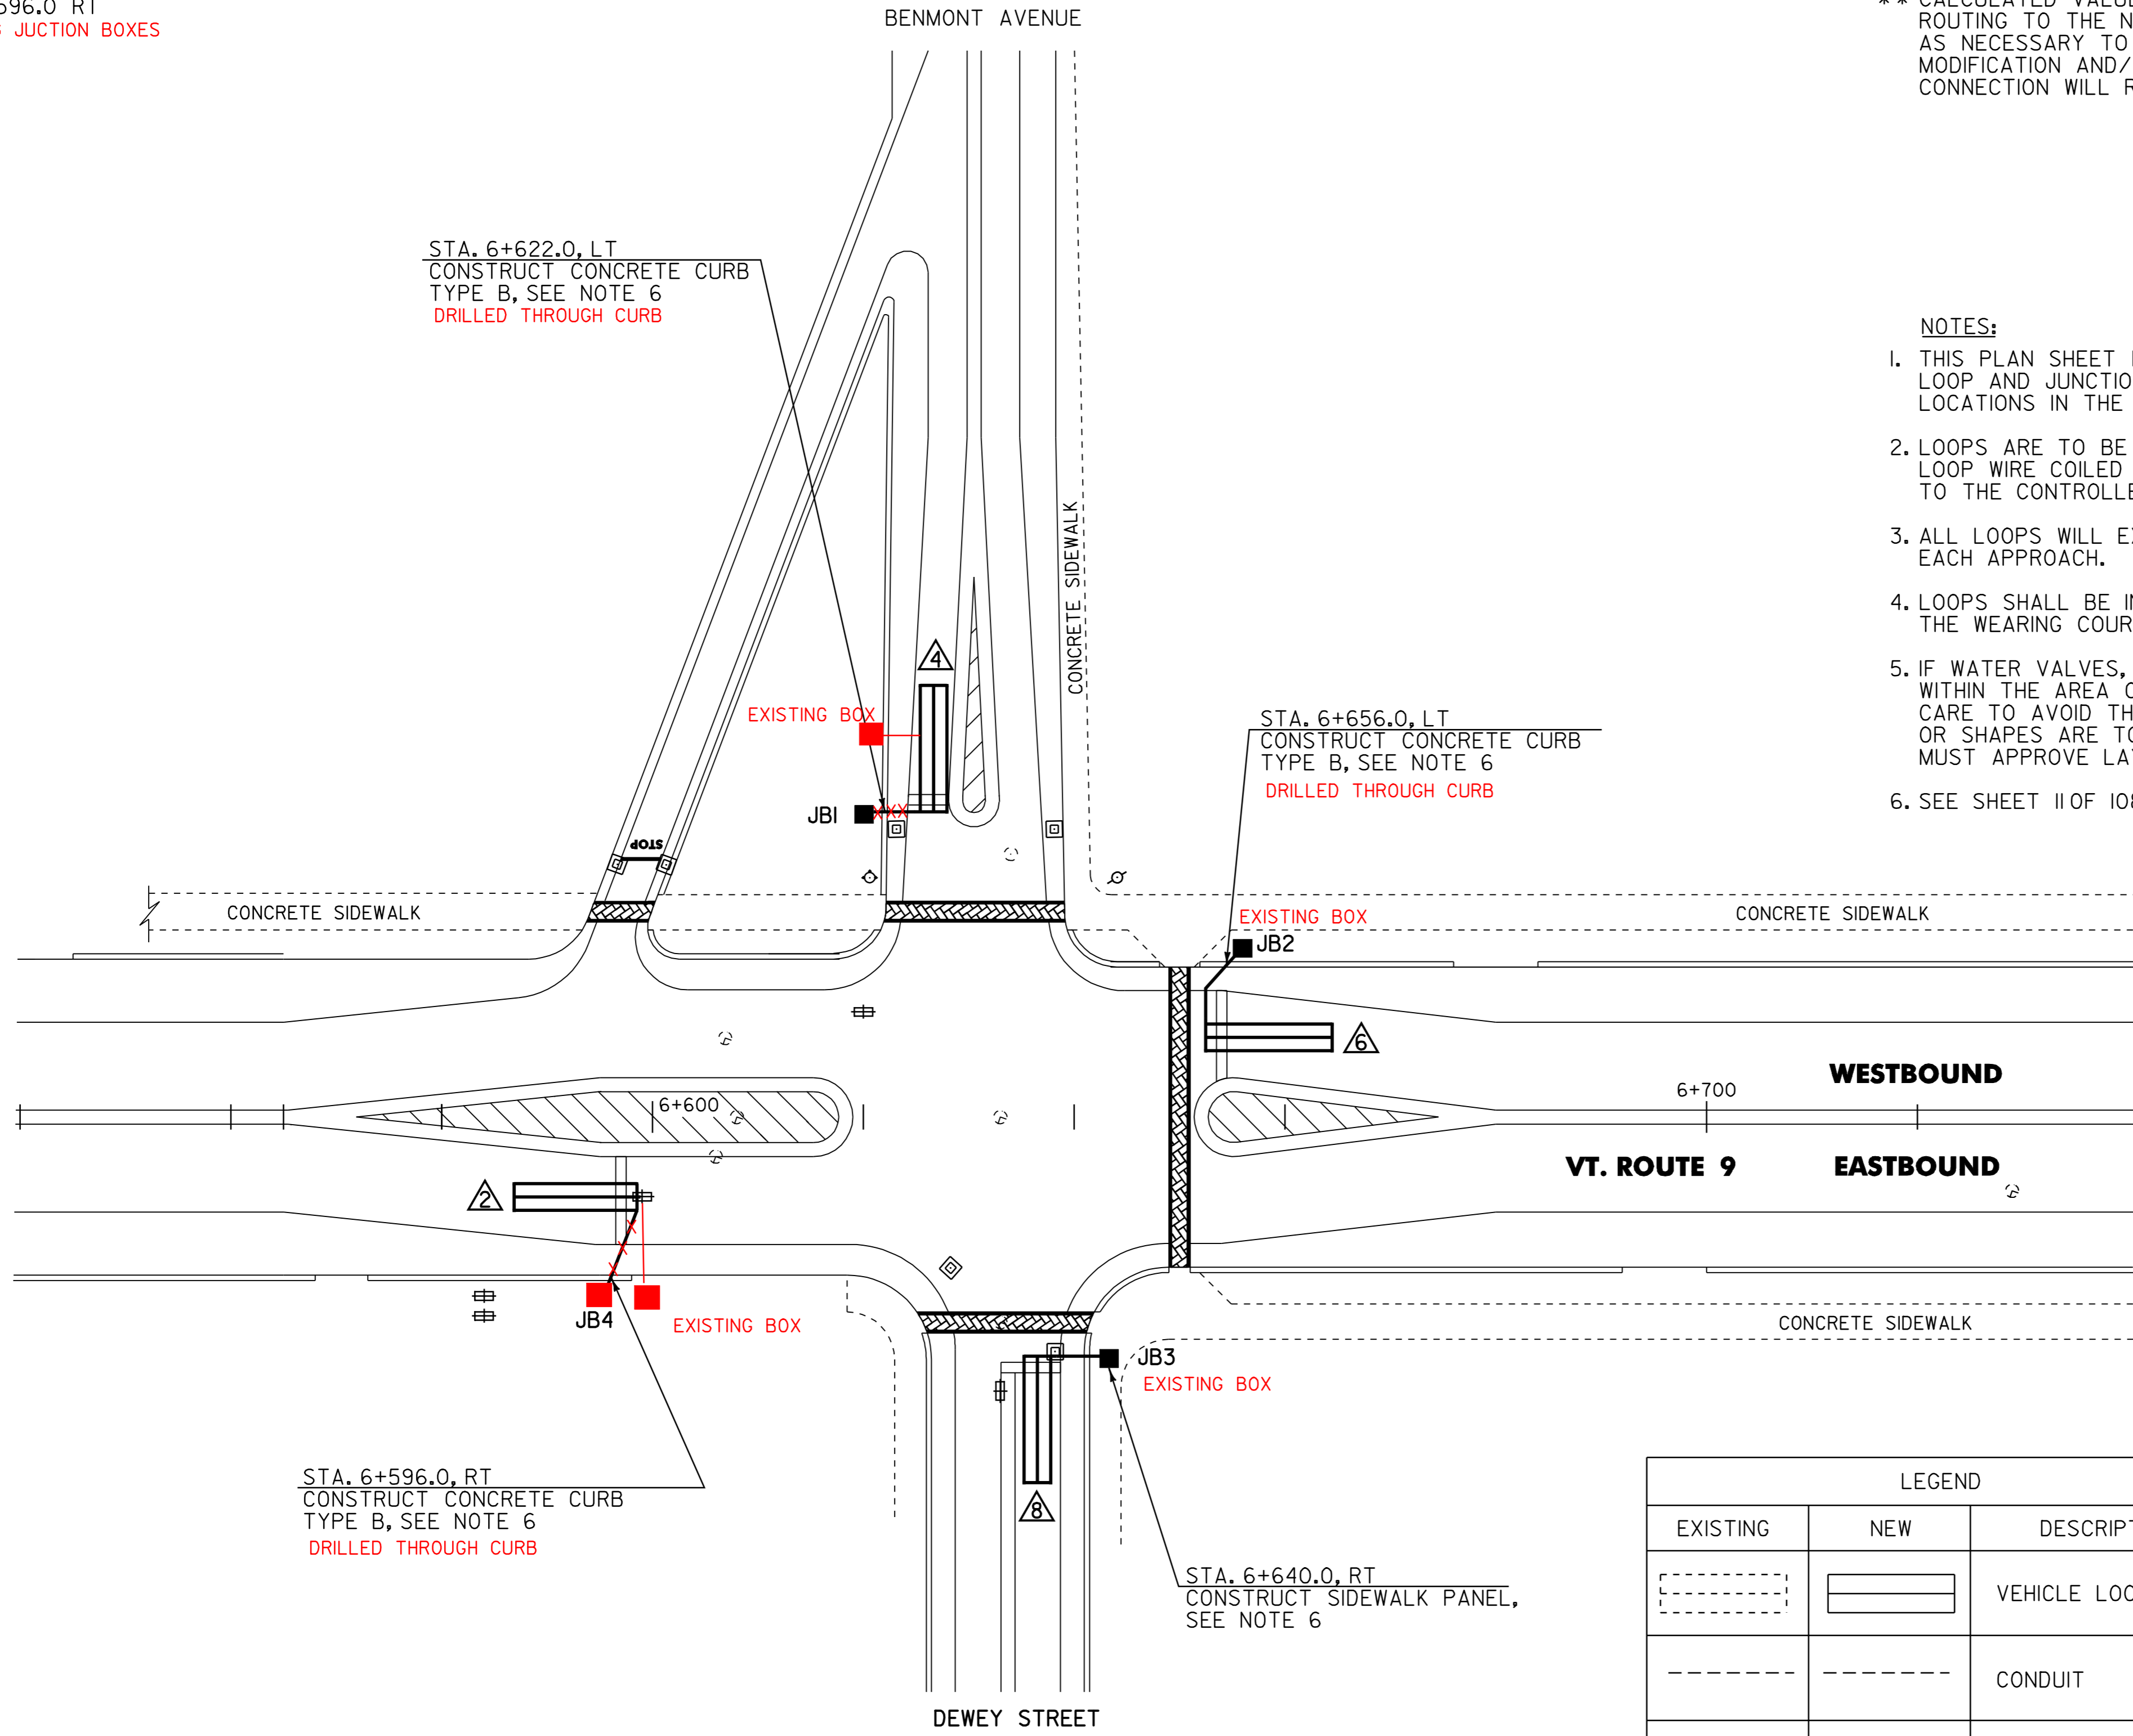

STA. 6+622.0, LT
 CONSTRUCT CONCRETE CURB
 TYPE B, SEE NOTE 6
 DRILLED THROUGH CURB

STA. 6+656.0, LT
 CONSTRUCT CONCRETE CURB
 TYPE B, SEE NOTE 6
 DRILLED THROUGH CURB

STA. 6+596.0, RT
 CONSTRUCT CONCRETE CURB
 TYPE B, SEE NOTE 6
 DRILLED THROUGH CURB

STA. 6+640.0, RT
 CONSTRUCT SIDEWALK PANEL,
 SEE NOTE 6

LEGEND		
EXISTING	NEW	DESCRIPTION
		VEHICLE LOOP
		CONDUIT
		JUNCTION BOX
		CONTROLLER CABINET

TRAFFIC LOOP LAYOUT # 1

SURVEYED BY	N/A	DATE	N/A
DRAWN BY	K.H.D.	DATE	4/01
SQUAD LEADER	T.P.K.		
DESIGN FILE NO.	/pave/99d156/pd156.dgn		
IPARM FILE	pd156+11.i	DATE PLOTTED	20 NOV-2005 10:20
PROJ. NAME	BENNINGTON		
PROJ. NO.	NH 2202(1)S		
SHEET	41	OF	108 SHEETS

DATUM	
VERTICAL	N/A
HORIZONTAL	N/A

678.22 VEHICLE LOOP DETECTOR

LOOP 2 - 43 m
 LOOP 4A - 41m
 LOOP 4B - 44 m
 LOOP 6 - 43 m
 LOOP 8 - 43 m

678.23 WIRED CONDUIT (DN41)

LOOP 4A TO JBI - 1m
 LOOP 4B TO JBI - 1m
 LOOP 6 TO JB2 - 1m
 LOOP 8 TO JB3 - 1m
 LOOP 2 TO JB4 - 1m

678.26 JUNCTION BOX


JBI-STA. 6+910.0 LT
 JB2-STA. 6+949.0 LT
 JB3-STA. 6+936.0 RT
 JB4-STA. 6+902.0 RT

CONSTRUCTION BOXES NOT INSTALLED

VEHICLE LOOP DETECTORS							TEST RESULTS AT JUNCTION BOX				TEST RESULTS AT CONTROLLER (FUTURE USE)**					
							INDUCTANCE (uH)		RESISTANCE Ω @ 25°C		(MΩ)	INDUCTANCE (uH)		RESISTANCE Ω @ 25°C		(MΩ)
LANE	LOOP NO.	SIZE	TYPE	NO TURNS	MODE	AMP	CALCULATED	MEASURED	CALCULATED	MEASURED	LEAKAGE TO GROUND	CALCULATED	MEASURED	CALCULATED	MEASURED	LEAKAGE TO GROUND
EB THRU	△	1.8m x 12.0m	QUAD.	2	PRESENCE	NON-DELAY	337		0.60			396		1.36		
SB RT	△	1.8m x 12.0m	QUAD.	2	PRESENCE	DELAY - 5 SEC.	335		0.58			338		0.61		
SB TH/LT	△	1.8m x 12.0m	QUAD.	2	PRESENCE	NON-DELAY	337		0.60			340		0.63		
WB THRU	△	1.8m x 12.0m	QUAD.	2	PRESENCE	NON-DELAY	337		0.60			370		1.03		
NB THRU	△	1.8m x 12.0m	QUAD.	2	PRESENCE	NON-DELAY	340		0.63			381		1.16		

*MEASURED VALUES MUST BE FILLED IN PRIOR TO TEST PERIOD.

**CALCULATED VALUES AT CONTROLLER ARE BASED ON DIRECT CONDUIT ROUTING TO THE NEAREST SIGNAL POLE AND CROSSING THE SPAN RAIL AS NECESSARY TO THE EXISTING CONTROLLER LOCATION. ANY SIGNAL MODIFICATION AND/OR CONTROLLER RELOCATION PRIOR TO LOOP CONNECTION WILL REQUIRE RECALCULATION OF THESE VALUES.

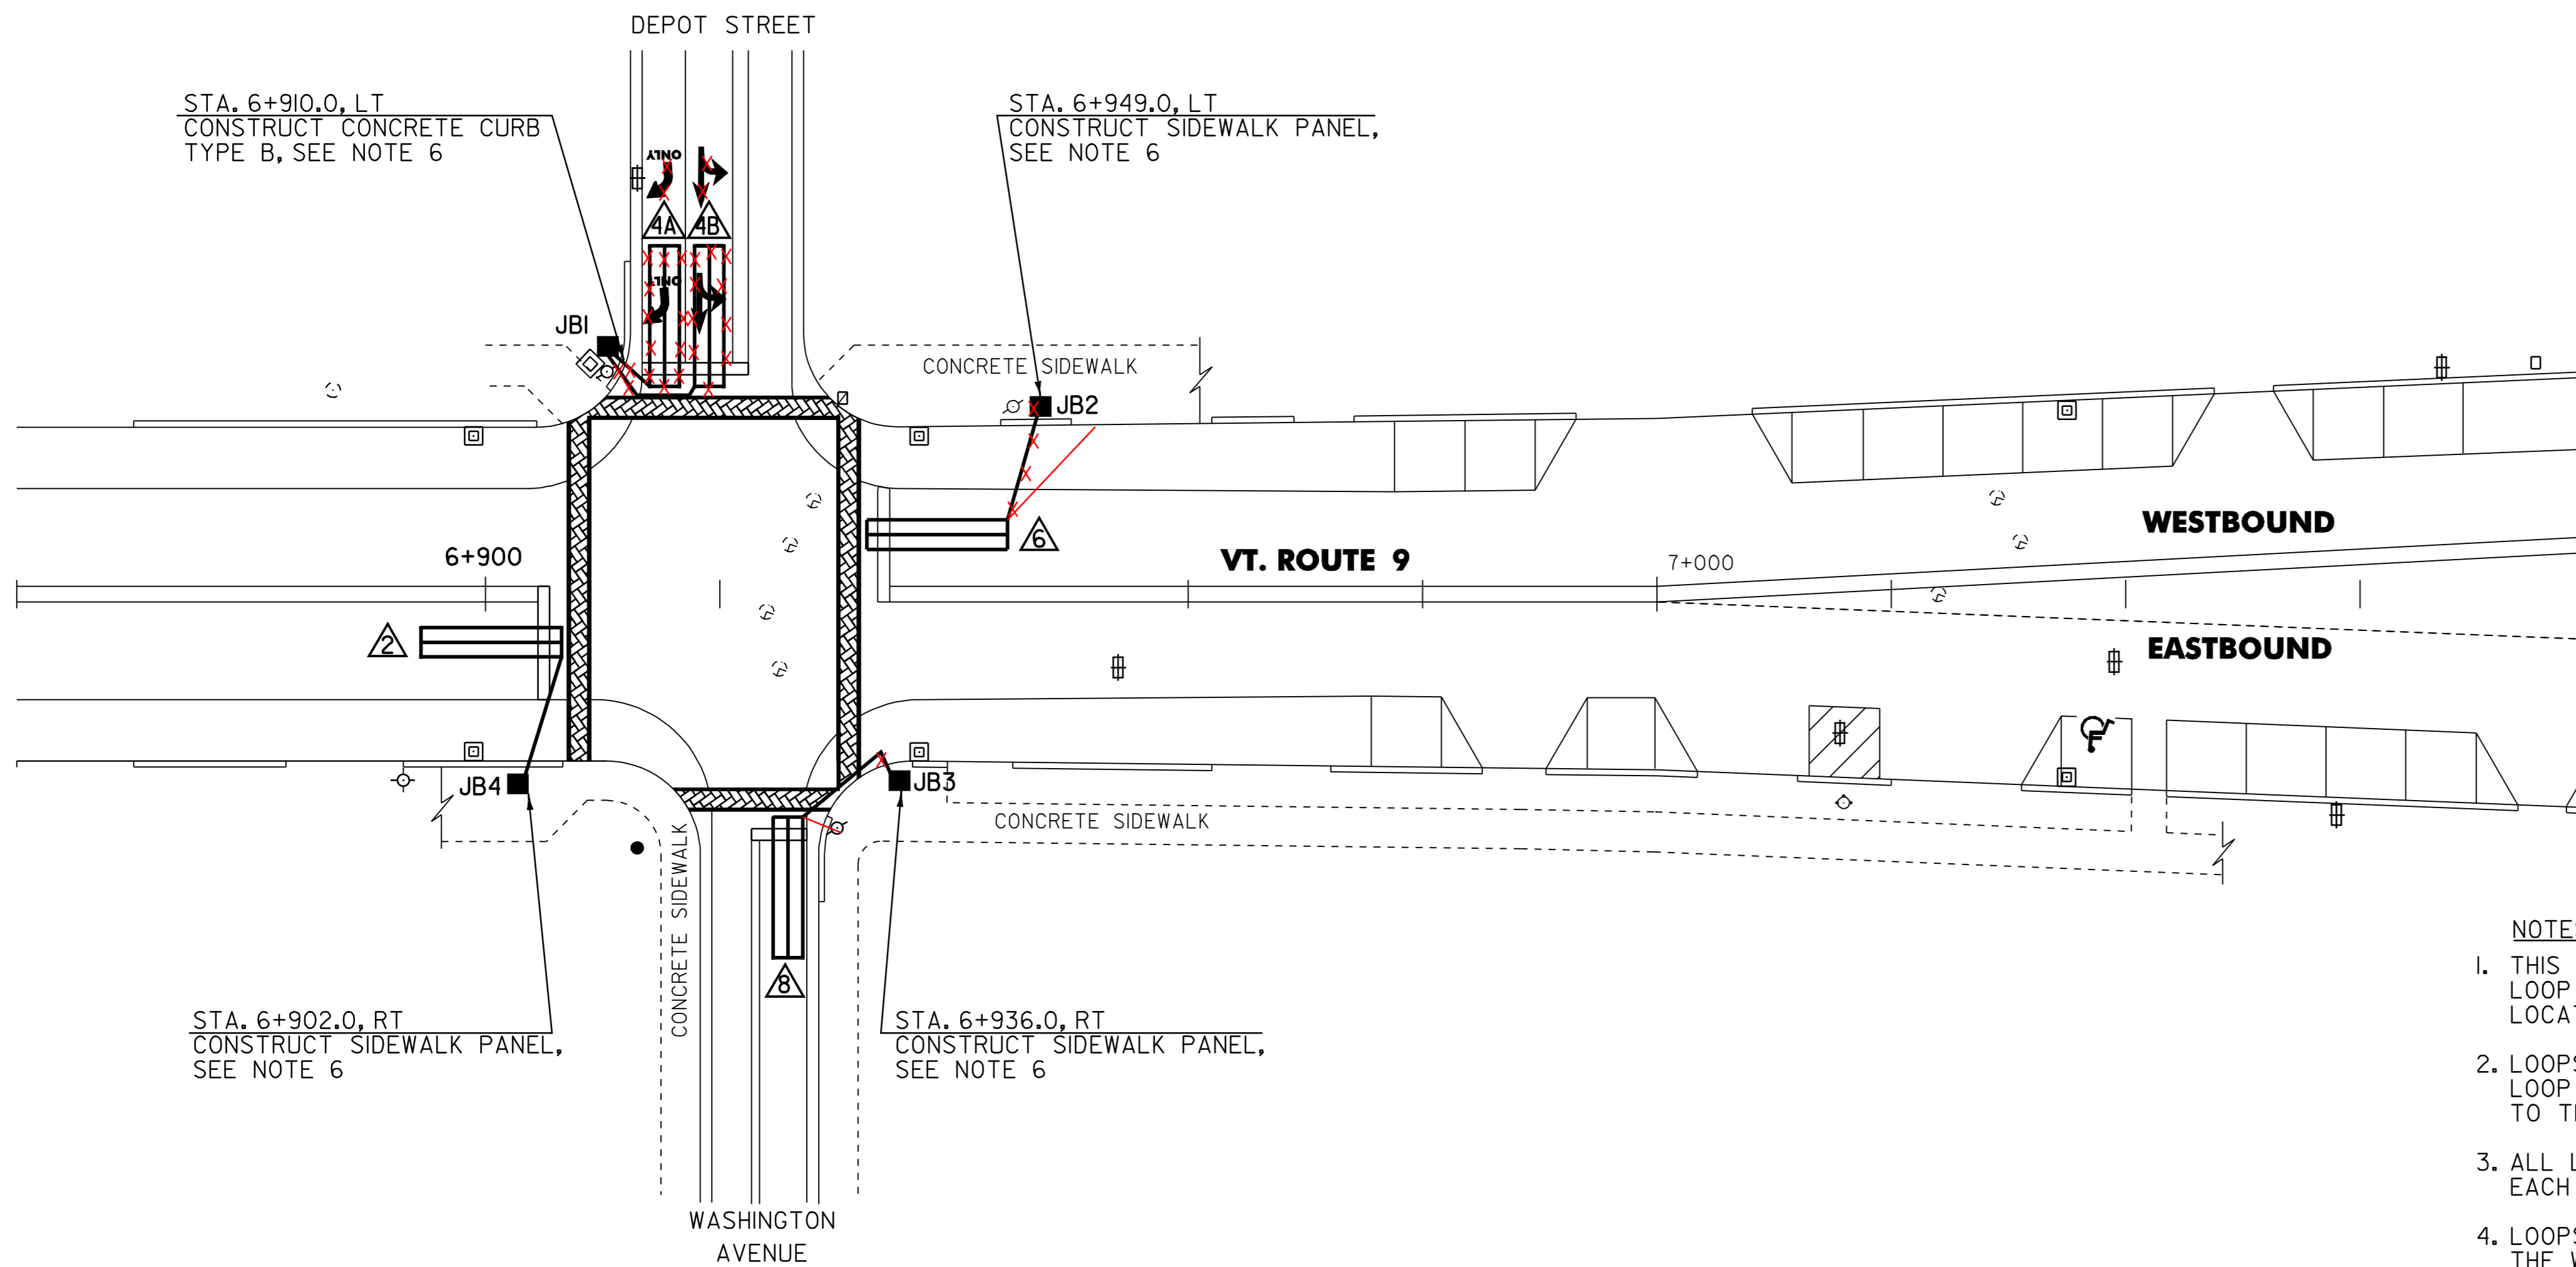

LEGEND		
EXISTING	NEW	DESCRIPTION
		VEHICLE LOOP
		CONDUIT
		JUNCTION BOX
		CONTROLLER CABINET

NOTES:

1. THIS PLAN SHEET IS NOT TO SCALE AND SHALL ONLY BE USED AS A GUIDE FOR LOOP AND JUNCTION BOX PLACEMENT. THE CONTRACTOR SHALL CONFIRM ALL LOCATIONS IN THE FIELD WITH THE RESIDENT ENGINEER PRIOR TO INSTALLATION.
2. LOOPS ARE TO BE TERMINATED AT THE JUNCTION BOX WITH 1m SLACK PER LOOP WIRE COILED NEATLY WITHIN THE BOX. LOOPS WILL NOT BE CONNECTED TO THE CONTROLLER AT THIS TIME.
3. ALL LOOPS WILL EXTEND 1m PAST THE CENTER OF THE STOP BAR ON EACH APPROACH.
4. LOOPS SHALL BE INSTALLED IN THE PAVEMENT PRIOR TO THE PLACEMENT OF THE WEARING COURSE.
5. IF WATER VALVES, DROP INLETS OR OTHER OBSTRUCTIONS ARE ENCOUNTERED WITHIN THE AREA OF A PROPOSED LOOP, THE CONTRACTOR SHALL TAKE SPECIAL CARE TO AVOID THE OBSTRUCTION DURING LOOP INSTALLATION. IF LOOP SIZES OR SHAPES ARE TO BE MODIFIED DUE TO OBSTRUCTIONS THE RESIDENT ENGINEER MUST APPROVE LAYOUT PRIOR TO INSTALLATION.
6. SEE SHEET #1 OF I08 FOR ITEM DETAIL SUMMARY SHEET #1.

DATUM	
VERTICAL	N/A
HORIZONTAL	N/A

<p>TRAFFIC LOOP LAYOUT # 2</p>	SURVEYED BY	N/A	DATE	N/A
	DRAWN BY	K.H.D.	DATE	4/01
	SQUAD LEADER	T.P.K.		
	DESIGN FILE NO.	/pave/99d156/pd156.dgn		
	IPARM FILE	pbl56+12.i	DATE PLOTTED	20 NOV-2005 10:20
PROJ. NAME	BENNINGTON			
PROJ. NO.	NH 2202(I)S			
SHEET	42 OF	108	SHEETS	

616.40 REMOVING AND RESETTING CURB

(SEE NOTE 6)

VT. ROUTE 9:
 STA. 7+103.0 RT (2.5 m)
 STA. 7+128.0 LT (2.5 m)

VT. ROUTE 7:
 STA. 4+752.0 LT (2.5 m)
 STA. 4+795.0 RT (2.5 m)

678.22 VEHICLE LOOP DETECTOR

- LOOP 1 - 46 m
- LOOP 2 - 41m
- LOOP 3 - 48 m
- LOOP 4 - 41m
- LOOP 5 - 44 m
- LOOP 6 - 43 m
- LOOP 7 - 53 m
- LOOP 8 - 41m

678.23 WIRED CONDUIT (DN41)

- LOOP 4 TO JBI - 1m
- LOOP 7 TO JBI - 1m
- LOOP 1 TO JB2 - 1m
- LOOP 6 TO JB2 - 1m
- LOOP 3 TO JB3 - 1m
- LOOP 8 TO JB3 - 1m
- LOOP 2 TO JB4 - 1m
- LOOP 5 TO JB4 - 1m


678.26 JUNCTION BOX

VT. ROUTE 9:
 JB4-STA. 7+103.0 RT
 JB2-STA. 7+128.0 LT

VT. ROUTE 7:
 JB3-STA. 4+752.0 LT
 JBI-STA. 4+795.0 RT

VEHICLE LOOP DETECTORS							TEST RESULTS AT JUNCTION BOX				TEST RESULTS AT CONTROLLER (FUTURE USE)**				
							INDUCTANCE (uH)		RESISTANCE Ω @ 25°C (MΩ)		INDUCTANCE (uH)		RESISTANCE Ω @ 25°C (MΩ)		LEAKAGE TO GROUND
LANE	LOOP NO.	SIZE	TYPE	NO TURNS	MODE	AMP	CALCULATED	MEASURED	CALCULATED	MEASURED	CALCULATED	MEASURED	CALCULATED	MEASURED	LEAKAGE TO GROUND
WB LT	1	1.8m x 12.0m	QUAD.	2	PRESENCE	NON-DELAY	340		0.63			380		1.14	
EB TH/RT	2	1.8m x 12.0m	QUAD.	2	PRESENCE	NON-DELAY	337		0.60			341		0.65	
NB LT	3	1.8m x 12.0m	QUAD.	2	PRESENCE	NON-DELAY	338		0.61			353		0.80	
SB TH/RT	4	1.8m x 12.0m	QUAD.	2	PRESENCE	NON-DELAY	335		0.58			350		0.77	
EB LT	5	1.8m x 12.0m	QUAD.	2	PRESENCE	NON-DELAY	340		0.63			344		0.69	
WB TH/RT	6	1.8m x 12.0m	QUAD.	2	PRESENCE	NON-DELAY	337		0.60			377		1.11	
SB LT	7	1.8m x 12.0m	QUAD.	2	PRESENCE	NON-DELAY	338		0.61			353		0.80	
NB TH/RT	8	1.8m x 12.0m	QUAD.	2	PRESENCE	NON-DELAY	335		0.58			350		0.77	

* MEASURED VALUES MUST BE FILLED IN PRIOR TO TEST PERIOD.
 **CALCULATED VALUES AT CONTROLLER ARE BASED ON DIRECT CONDUIT ROUTING TO THE NEAREST SIGNAL POLE AND CROSSING THE SPAN WIRE AS NECESSARY TO THE EXISTING CONTROLLER LOCATION. ANY SIGNAL MODIFICATION AND/OR CONTROLLER RELOCATION PRIOR TO LOOP CONNECTION WILL REQUIRE RECALCULATION OF THESE VALUES.

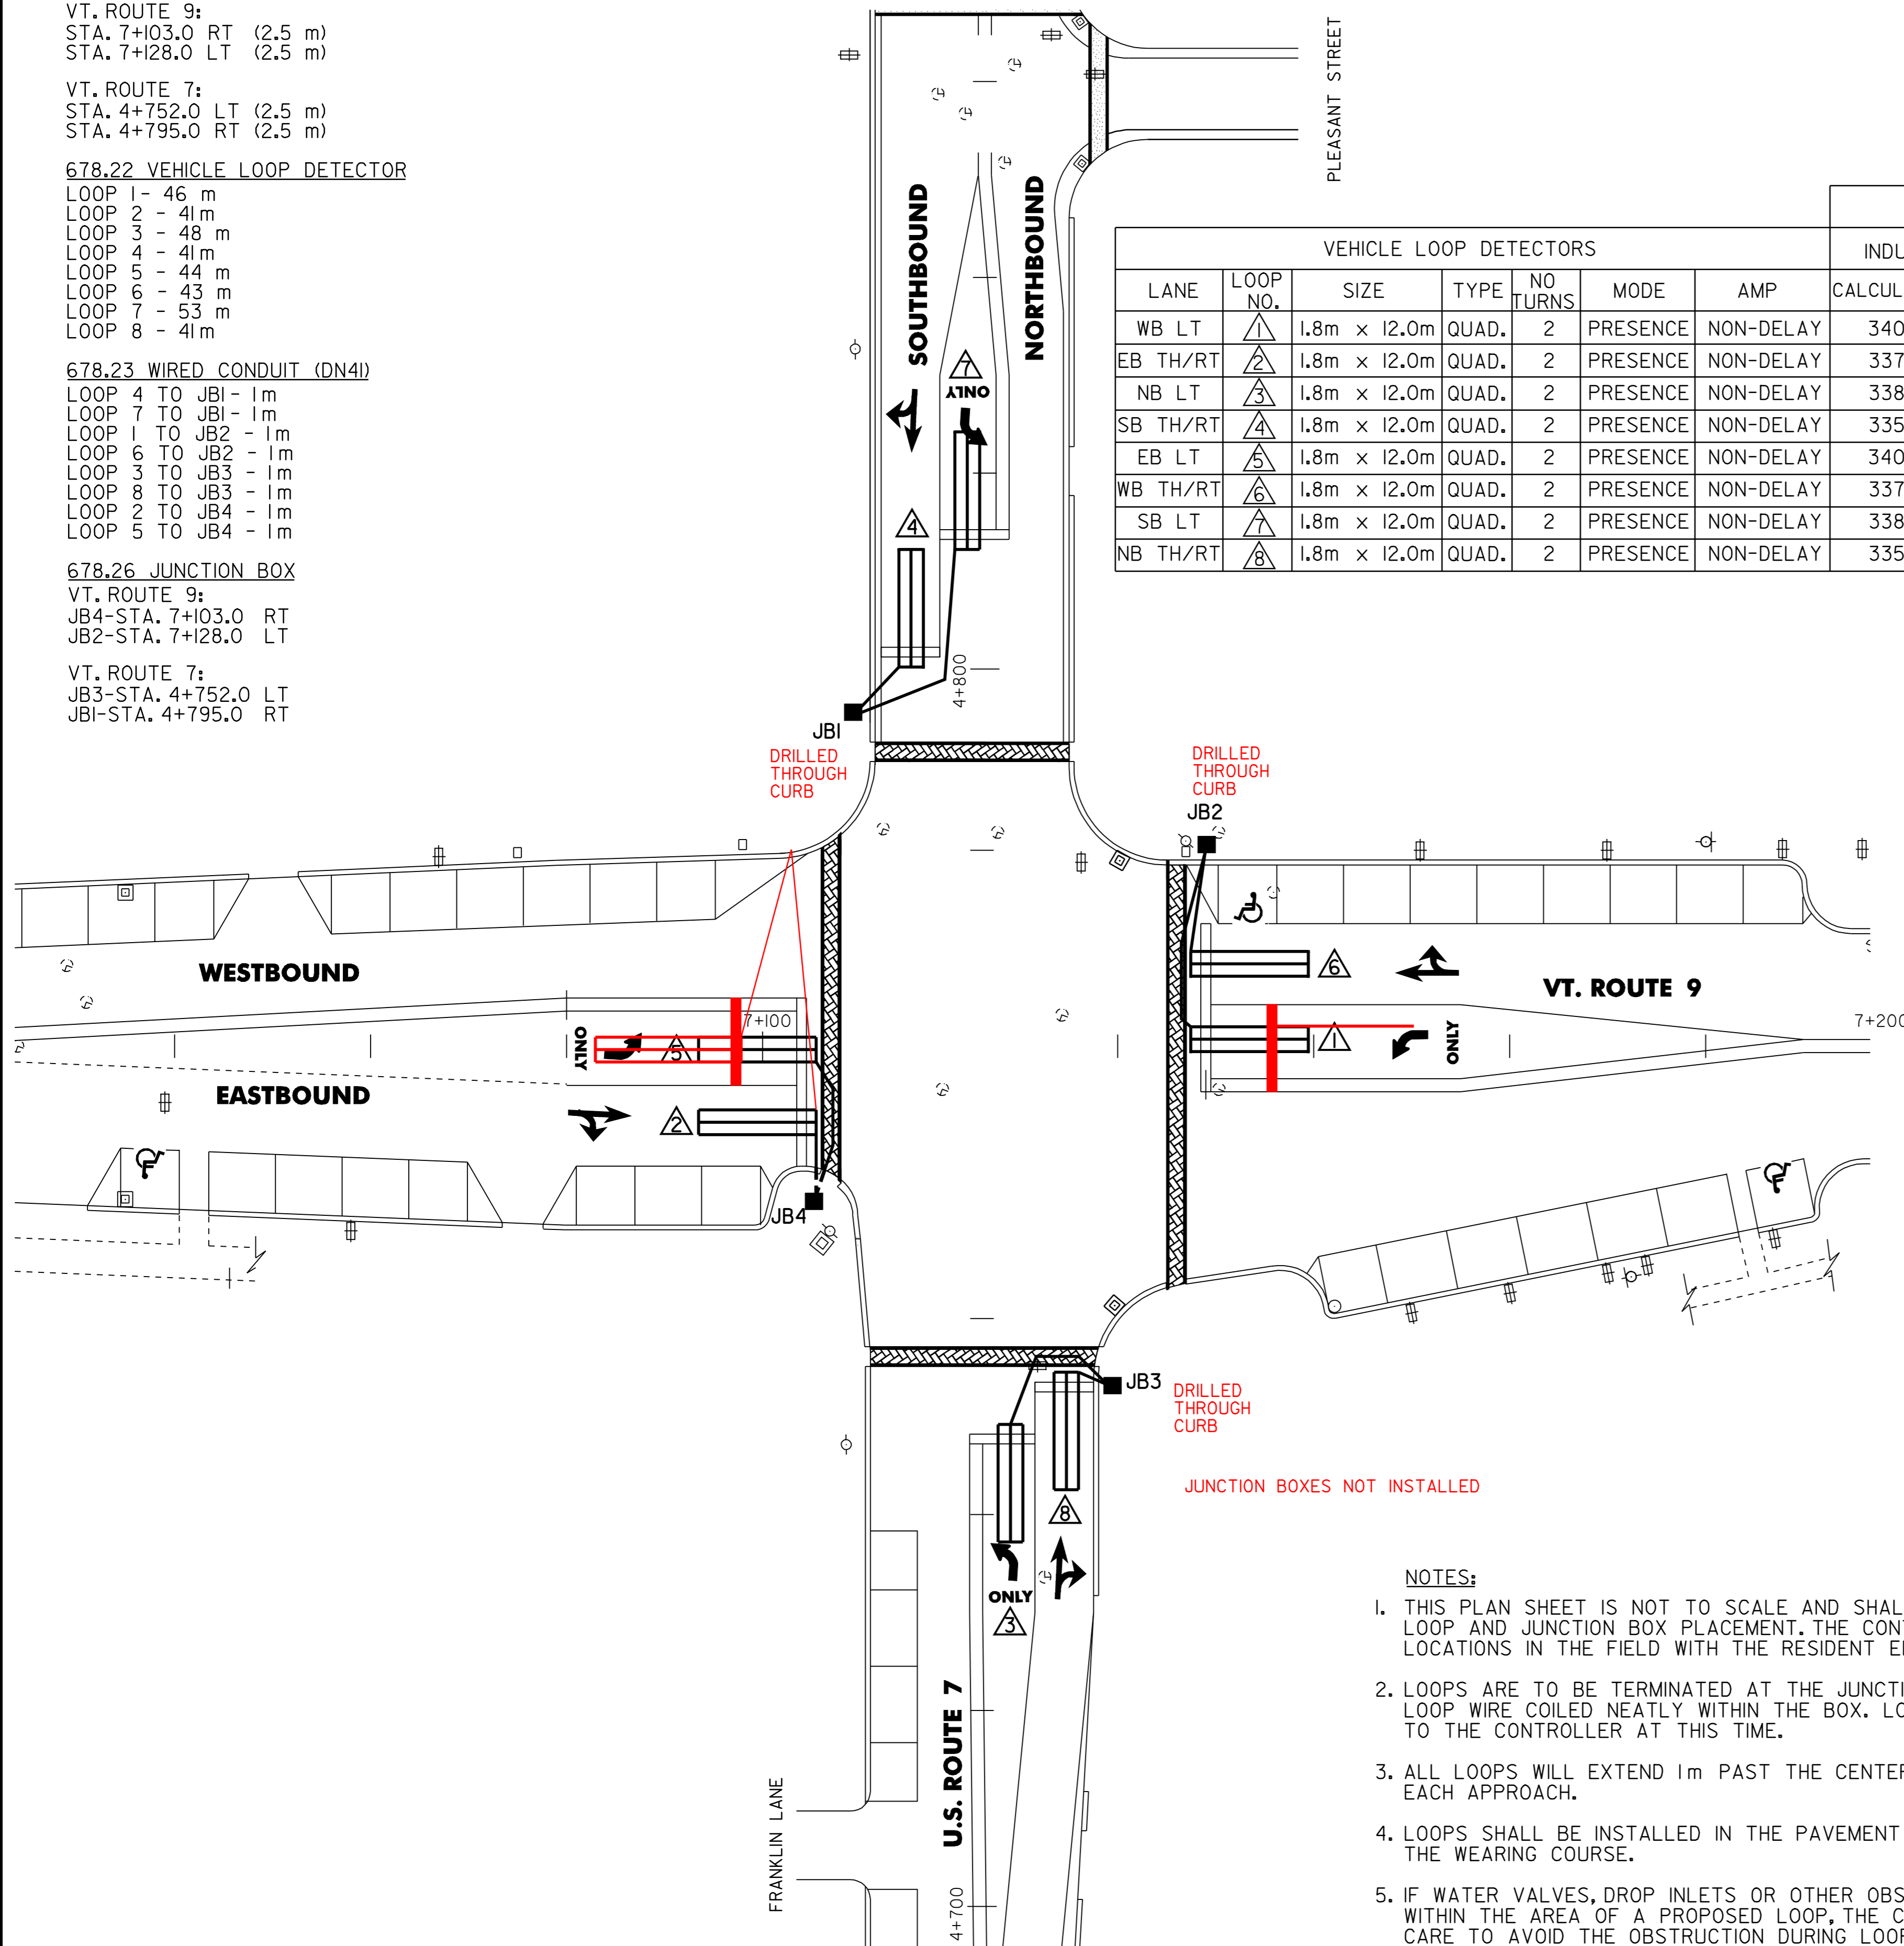

LEGEND		
EXISTING	NEW	DESCRIPTION
		VEHICLE LOOP
		CONDUIT
		JUNCTION BOX
		CONTROLLER CABINET

NOTES:

1. THIS PLAN SHEET IS NOT TO SCALE AND SHALL ONLY BE USED AS A GUIDE FOR LOOP AND JUNCTION BOX PLACEMENT. THE CONTRACTOR SHALL CONFIRM ALL LOCATIONS IN THE FIELD WITH THE RESIDENT ENGINEER PRIOR TO INSTALLATION.
2. LOOPS ARE TO BE TERMINATED AT THE JUNCTION BOX WITH 1m SLACK PER LOOP WIRE COILED NEATLY WITHIN THE BOX. LOOPS WILL NOT BE CONNECTED TO THE CONTROLLER AT THIS TIME.
3. ALL LOOPS WILL EXTEND 1m PAST THE CENTER OF THE STOP BAR ON EACH APPROACH.
4. LOOPS SHALL BE INSTALLED IN THE PAVEMENT PRIOR TO THE PLACEMENT OF THE WEARING COURSE.
5. IF WATER VALVES, DROP INLETS OR OTHER OBSTRUCTIONS ARE ENCOUNTERED WITHIN THE AREA OF A PROPOSED LOOP, THE CONTRACTOR SHALL TAKE SPECIAL CARE TO AVOID THE OBSTRUCTION DURING LOOP INSTALLATION. IF LOOP SIZES OR SHAPES ARE TO BE MODIFIED DUE TO OBSTRUCTIONS THE RESIDENT ENGINEER MUST APPROVE LAYOUT PRIOR TO INSTALLATION.
6. SEE SHEET 11 OF 108 AND 13 OF 108 FOR ITEM DETAIL SUMMARY SHEETS #1 AND #3.

DATUM	
VERTICAL	N/A
HORIZONTAL	N/A

TRAFFIC LOOP LAYOUT # 3

SURVEYED BY	N/A	DATE	N/A
DRAWN BY	K.H.D.	DATE	4/01
SQUAD LEADER	T.P.K.		
DESIGN FILE NO.	/pave/99d156/pd156.dgn		
IPARM FILE	pd156+13.i	DATE PLOTTED	20 NOV-2005 10:20
PROJ. NAME	BENNINGTON		
PROJ. NO.	NH 2202(1)S		
SHEET 43 OF	108	SHEETS	

678.22 VEHICLE LOOP DETECTOR

 LOOP 2 - 43 m
 LOOP 4 - 41m
 LOOP 6 - 43 m
 LOOP 8 - 12 m

678.23 WIRED CONDUIT (DN41)

 LOOP 4 TO JBI - 2 m
 LOOP 6 TO JB2 - 1m
 LOOP 8 TO JB3 - 1m
 LOOP 2 TO JB4 - 2 m

678.26 JUNCTION BOX


 JBI-STA. 7+880.0 LT
 JBI-STA. 7+905.0 LT
 JBI-STA. 7+894.0 RT
 JBI-STA. 7+880.0 RT

VEHICLE LOOP DETECTORS							TEST RESULTS AT JUNCTION BOX				TEST RESULTS AT CONTROLLER (FUTURE USE)**					
							INDUCTANCE (μH)		RESISTANCE Ω @ 25°C		(MΩ)	INDUCTANCE (μH)		RESISTANCE Ω @ 25°C		(MΩ)
LANE	LOOP NO.	SIZE	TYPE	NO TURNS	MODE	AMP	CALCULATED	MEASURED	CALCULATED	MEASURED	LEAKAGE TO GROUND	CALCULATED	MEASURED	CALCULATED	MEASURED	LEAKAGE TO GROUND
EB THRU	2	1.8m x 12.0m	QUAD.	2	PRESENCE	NON-DELAY	337		0.60			350		0.76		
SB THRU	4	1.8m x 12.0m	QUAD.	2	PRESENCE	NON-DELAY	335		0.58			375		1.08		
WB THRU	6	1.8m x 12.0m	QUAD.	2	PRESENCE	NON-DELAY	336		0.59			395		1.33		
NB THRU	8	3.0m x 1.8m	RECT.	5	PRESENCE	DELAY-10 SEC.	264		0.28			267		0.32		

* MEASURED VALUES MUST BE FILLED IN PRIOR TO TEST PERIOD.

** CALCULATED VALUES AT CONTROLLER ARE BASED ON DIRECT CONDUIT ROUTING TO THE NEAREST SIGNAL POLE AND CROSSING THE SPAN WIRE AS NECESSARY TO THE EXISTING CONTROLLER LOCATION. ANY SIGNAL MODIFICATION AND/OR CONTROLLER RELOCATION PRIOR TO LOOP CONNECTION WILL REQUIRE RECALCULATION OF THESE VALUES.

LEGEND		
EXISTING	NEW	DESCRIPTION
		VEHICLE LOOP
		CONDUIT
		JUNCTION BOX
		CONTROLLER CABINET

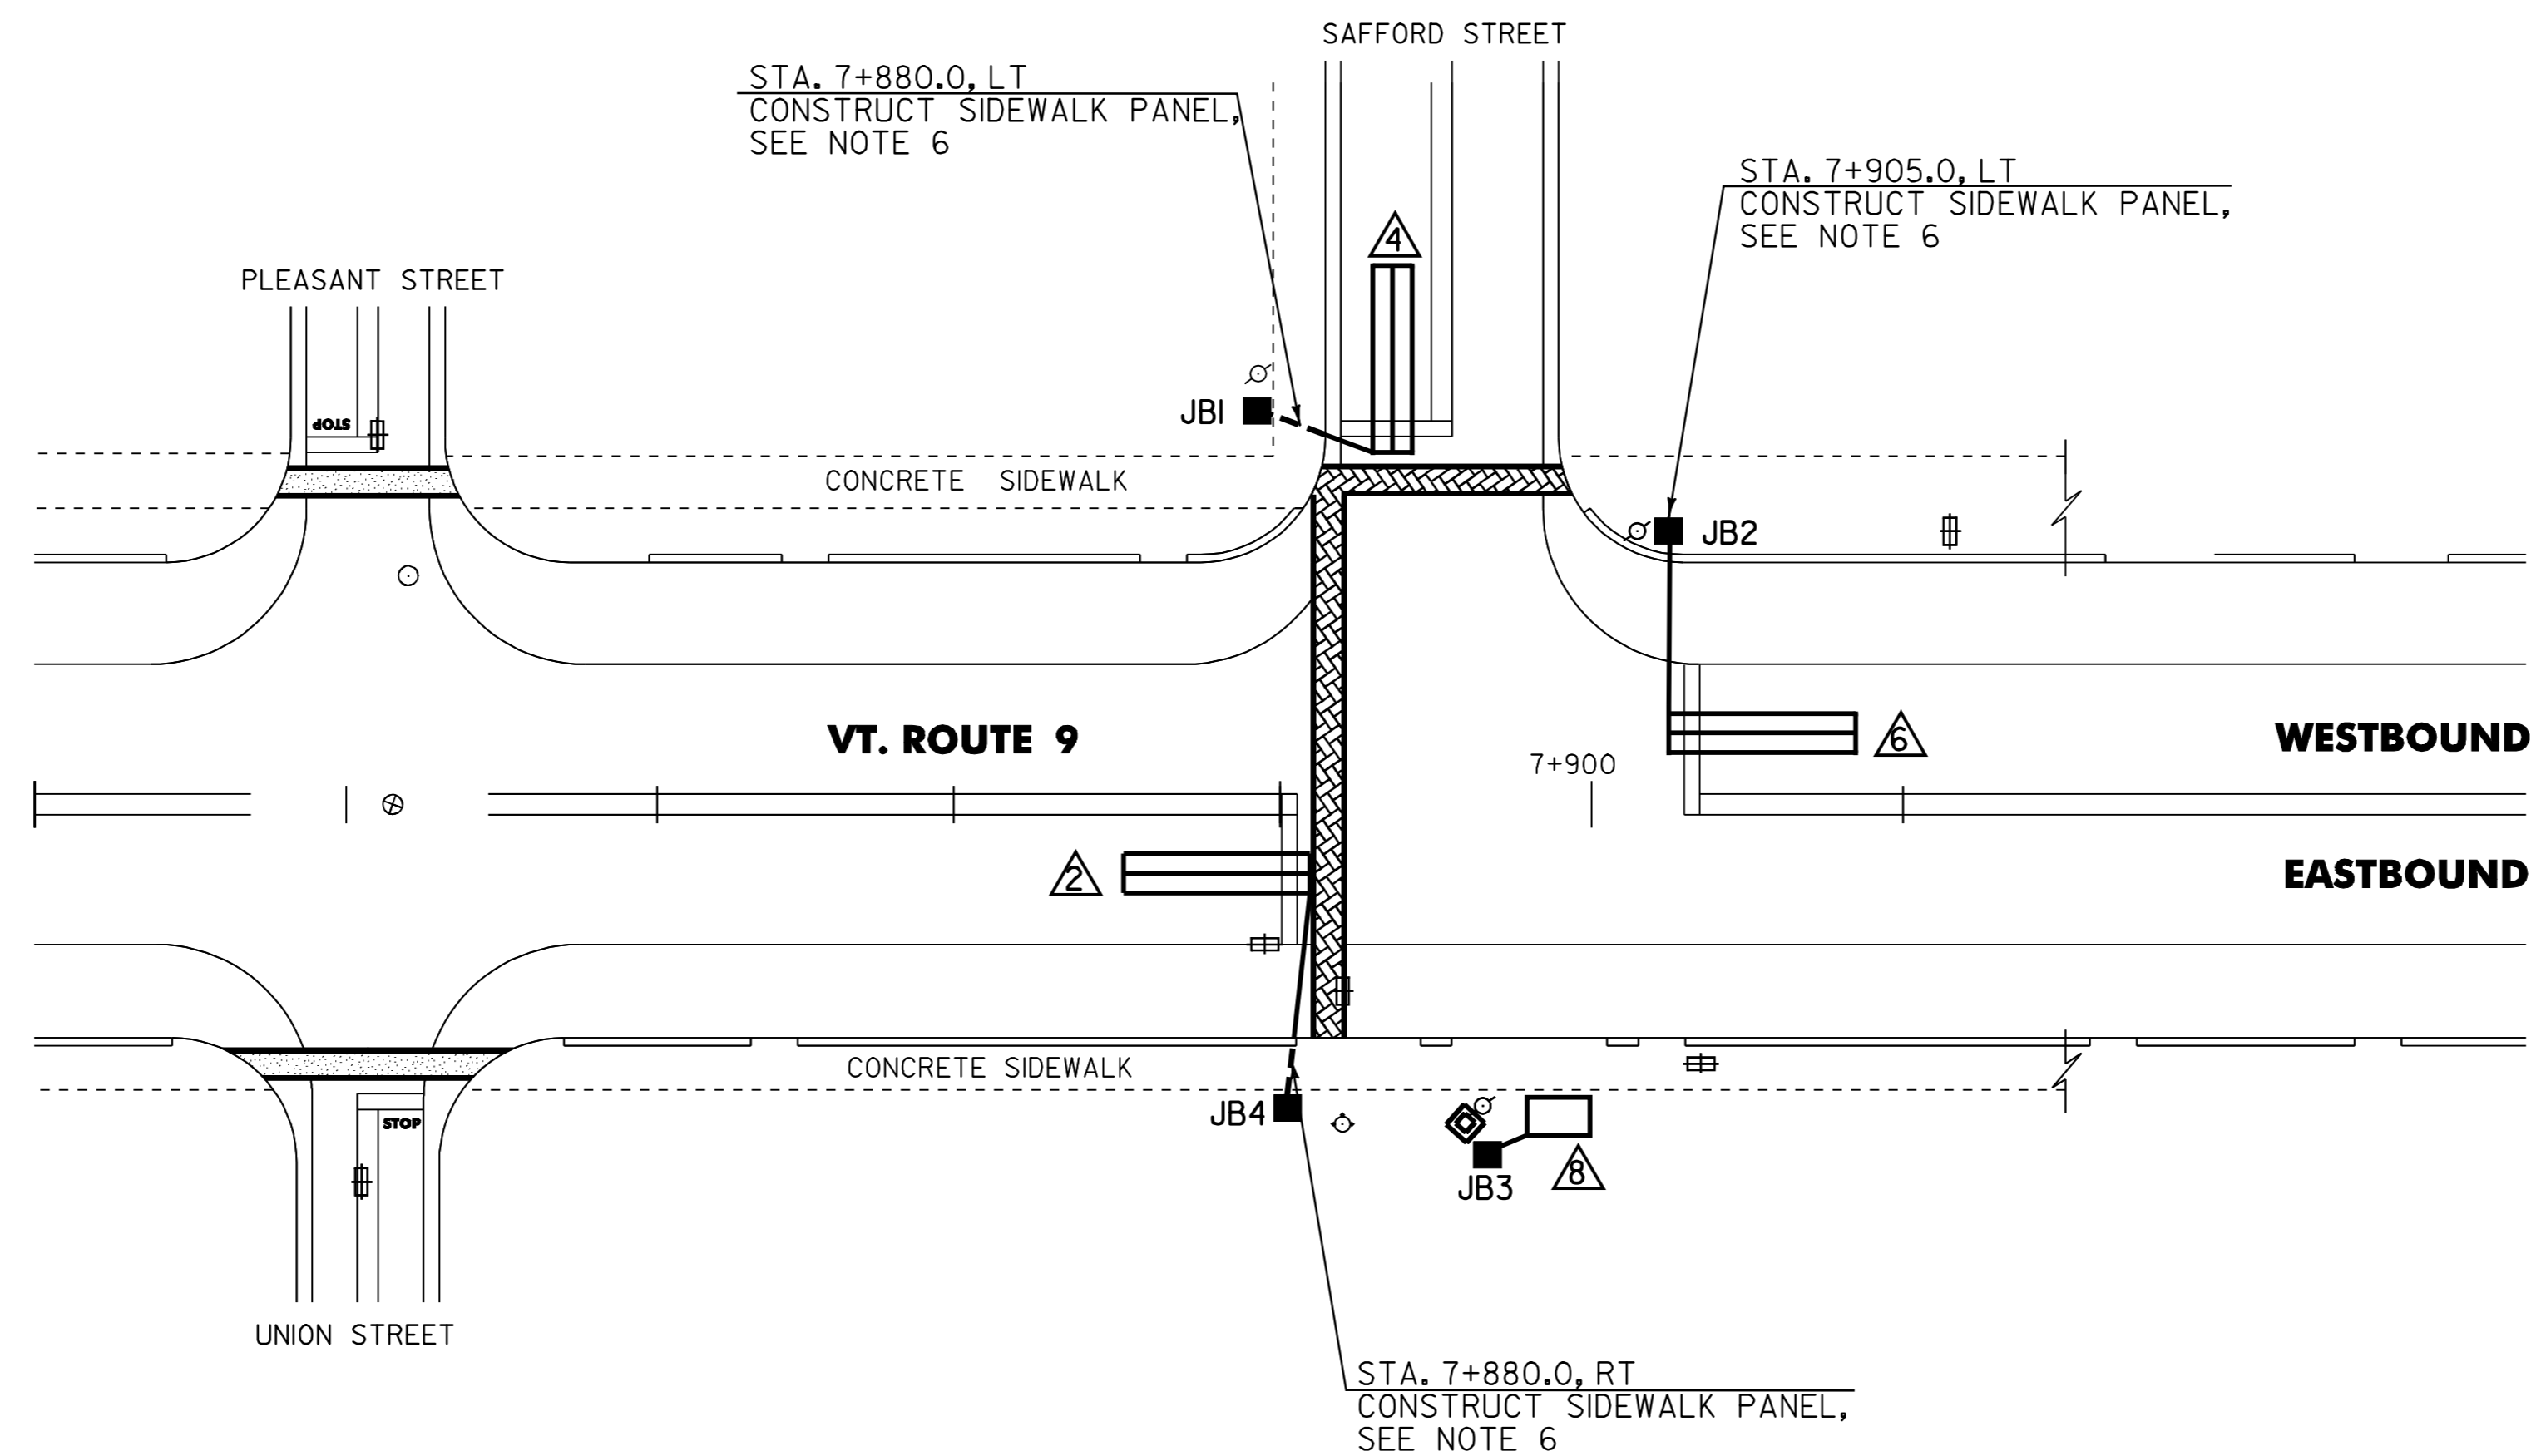
NOTES:

- THIS PLAN SHEET IS NOT TO SCALE AND SHALL ONLY BE USED AS A GUIDE FOR LOOP AND JUNCTION BOX PLACEMENT. THE CONTRACTOR SHALL CONFIRM ALL LOCATIONS IN THE FIELD WITH THE RESIDENT ENGINEER PRIOR TO INSTALLATION.
- LOOPS ARE TO BE TERMINATED AT THE JUNCTION BOX WITH 1m SLACK PER LOOP WIRE COILED NEATLY WITHIN THE BOX. LOOPS WILL NOT BE CONNECTED TO THE CONTROLLER AT THIS TIME.
- ALL LOOPS WILL EXTEND 1m PAST THE CENTER OF THE STOP BAR ON EACH APPROACH.
- LOOPS SHALL BE INSTALLED IN THE PAVEMENT PRIOR TO THE PLACEMENT OF THE WEARING COURSE.
- IF WATER VALVES, DROP INLETS OR OTHER OBSTRUCTIONS ARE ENCOUNTERED WITHIN THE AREA OF A PROPOSED LOOP, THE CONTRACTOR SHALL TAKE SPECIAL CARE TO AVOID THE OBSTRUCTION DURING LOOP INSTALLATION. IF LOOP SIZES OR SHAPES ARE TO BE MODIFIED DUE TO OBSTRUCTIONS THE RESIDENT ENGINEER MUST APPROVE LAYOUT PRIOR TO INSTALLATION.
- SEE SHEET 12 OF 108 FOR ITEM DETAIL SUMMARY SHEET #2.

DATUM	
VERTICAL	N/A
HORIZONTAL	N/A

TRAFFIC LOOP LAYOUT # 4	SURVEYED BY	N/A	DATE	N/A
	DRAWN BY	K.H.D.	DATE	4/01
	SQUAD LEADER	T.P.K.		
	DESIGN FILE NO.	/pave/99d156/pd156.dgn		
	IPARM FILE	pd156+14.1	DATE	20 NOV-2005 10:20
PROJ. NAME	BENNINGTON			
PROJ. NO.	NH 2202(1)S			
SHEET	44	OF	108	SHEETS

678.22 VEHICLE LOOP DETECTOR

LOOP 2A - 43 m
 LOOP 2B - 43 m
 LOOP 4 - 41m
 LOOP 6 - 43 m

678.23 WIRED CONDUIT (DN41)

LOOP 2A TO JBI - 2 m
 LOOP 2B TO JB2 - 2 m
 LOOP 4 TO JB3 - 2 m
 LOOP 6 TO JB4 - 1m


678.26 JUNCTION BOX

JB1-STA. 7+982.0 RT
 JB2-STA. 8+016.0 RT
 JB3-STA. 8+042.0 RT
 JB4-STA. 8+055.0 LT

VEHICLE LOOP DETECTORS							TEST RESULTS AT JUNCTION BOX				TEST RESULTS AT CONTROLLER (FUTURE USE)**					
							INDUCTANCE (μH)		RESISTANCE Ω @ 25°C		(MΩ)	INDUCTANCE (μH)		RESISTANCE Ω @ 25°C		(MΩ)
LANE	LOOP NO.	SIZE	TYPE	NO TURNS	MODE	AMP	CALCULATED	MEASURED	CALCULATED	MEASURED	LEAKAGE TO GROUND	CALCULATED	MEASURED	CALCULATED	MEASURED	LEAKAGE TO GROUND
EB THRU	2A	1.8m x 12.0m	QUAD.	2	PRESENCE	NON-DELAY	338		0.61			371		1.04		
EB THRU	2B	1.8m x 12.0m	QUAD.	2	PRESENCE	NON-DELAY	337		0.60			341		0.65		
NB THRU	4	1.8m x 12.0m	QUAD.	2	PRESENCE	NON-DELAY	336		0.59			357		0.86		
WB THRU	6	1.8m x 12.0m	QUAD.	2	PRESENCE	NON-DELAY	337		0.60			387		1.24		

* MEASURED VALUES MUST BE FILLED IN PRIOR TO TEST PERIOD.

** CALCULATED VALUES AT CONTROLLER ARE BASED ON DIRECT CONDUIT ROUTING TO THE NEAREST SIGNAL POLE AND CROSSING THE SPAN WIRE AS NECESSARY TO THE EXISTING CONTROLLER LOCATION. ANY SIGNAL MODIFICATION AND/OR CONTROLLER RELOCATION PRIOR TO LOOP CONNECTION WILL REQUIRE RECALCULATION OF THESE VALUES.

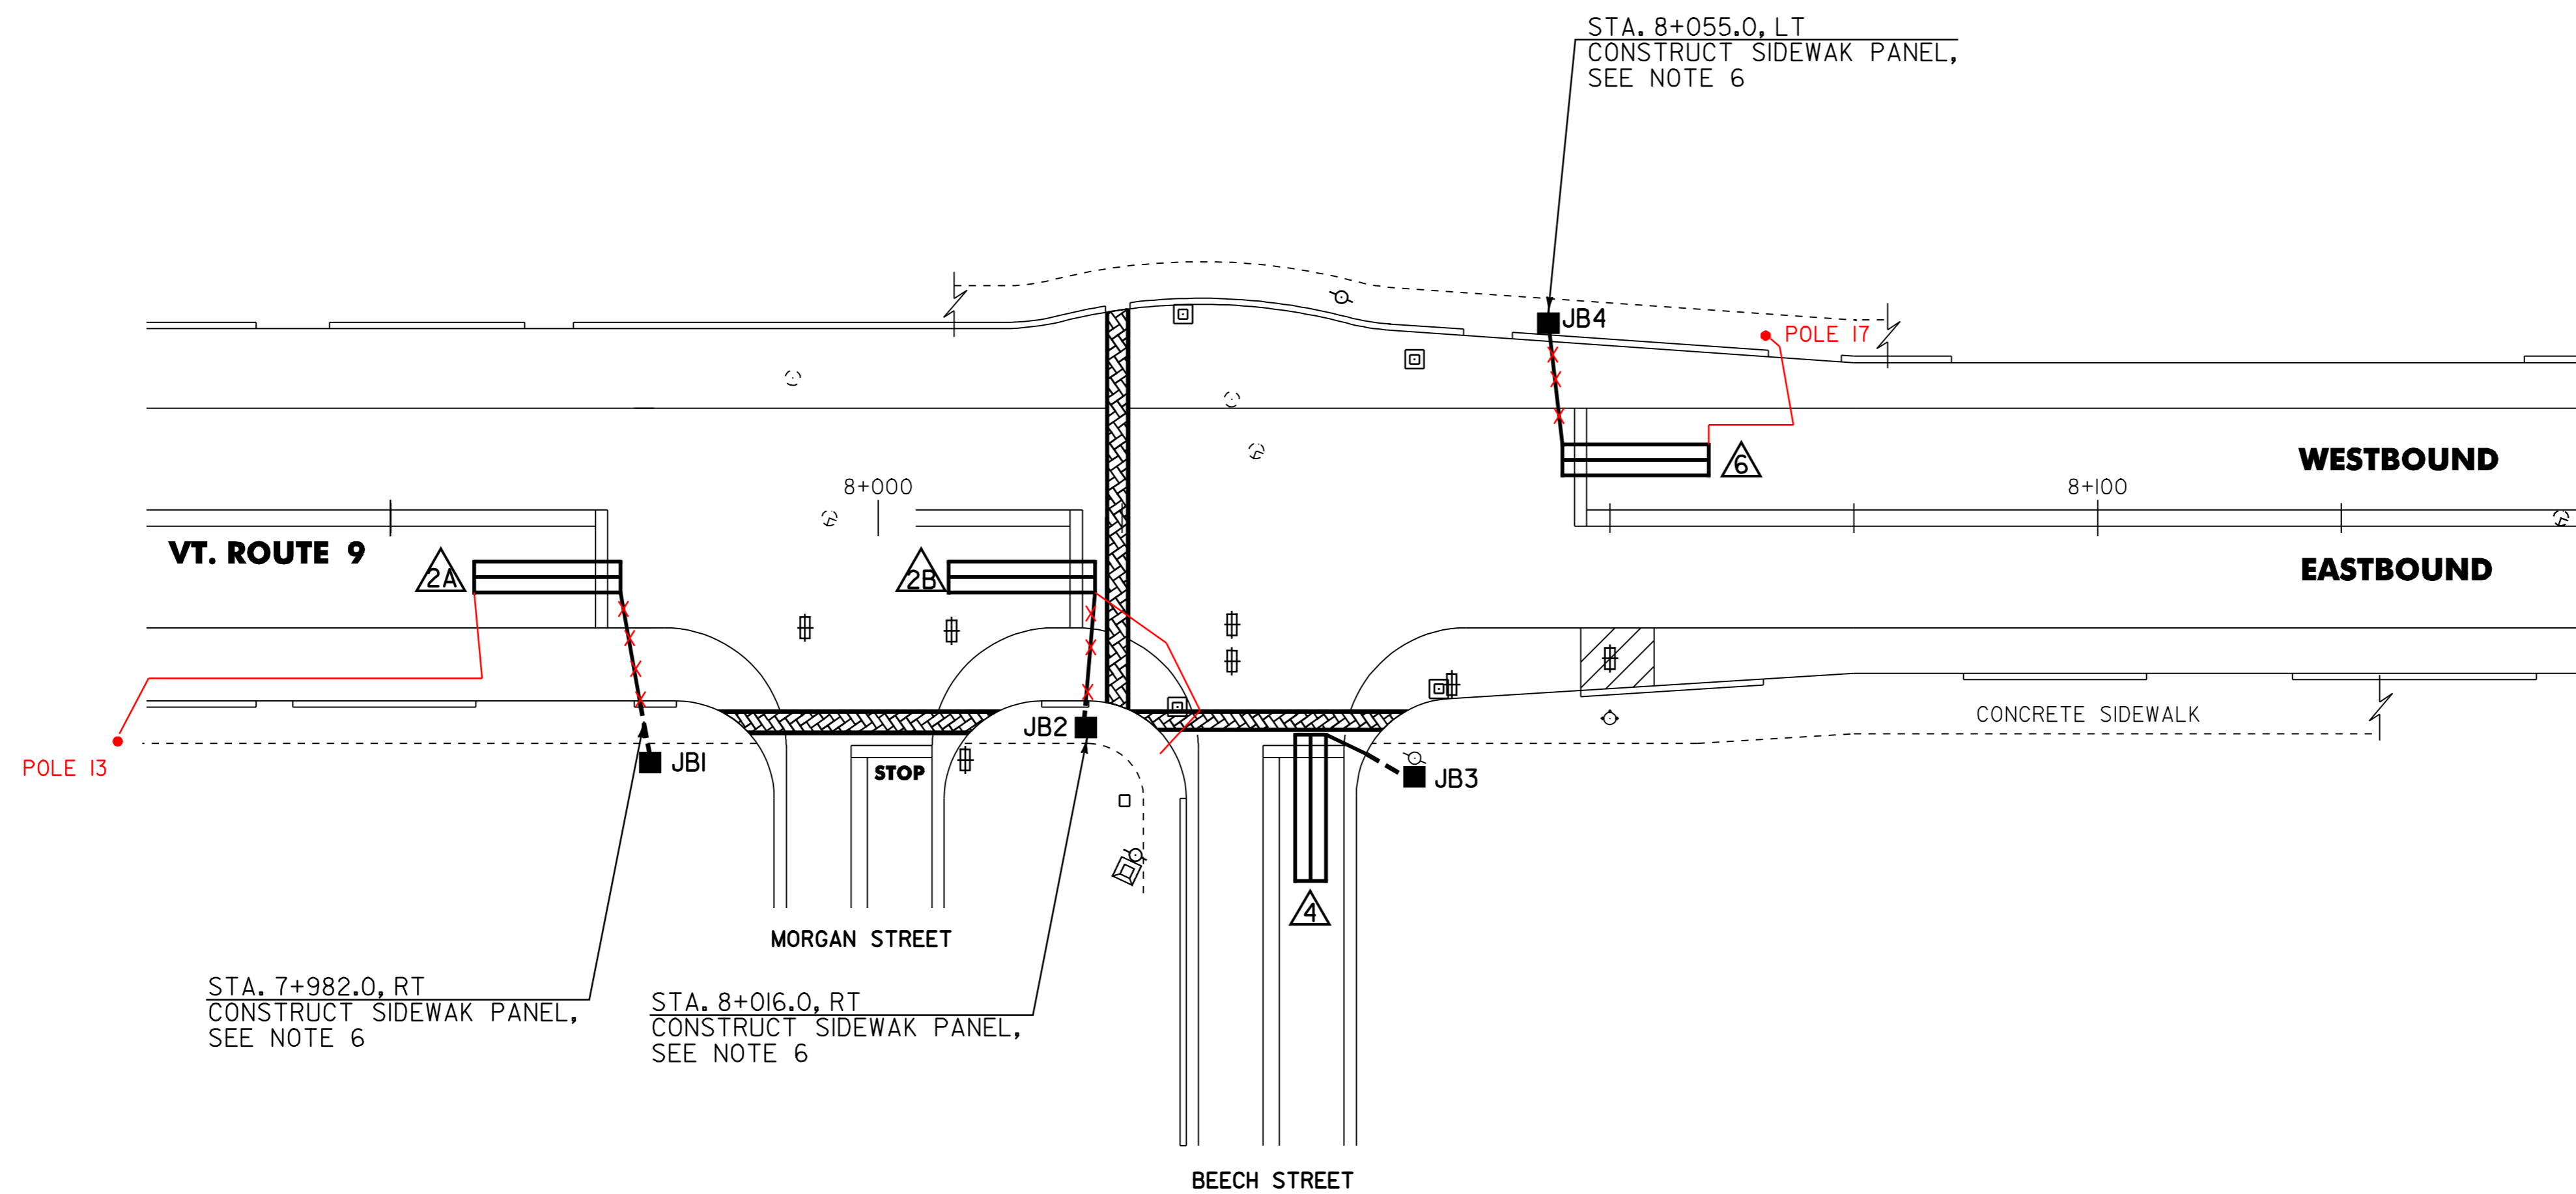

LEGEND		
EXISTING	NEW	DESCRIPTION
		VEHICLE LOOP
		CONDUIT
		JUNCTION BOX
		CONTROLLER CABINET

NOTES:

- THIS PLAN SHEET IS NOT TO SCALE AND SHALL ONLY BE USED AS A GUIDE FOR LOOP AND JUNCTION BOX PLACEMENT. THE CONTRACTOR SHALL CONFIRM ALL LOCATIONS IN THE FIELD WITH THE RESIDENT ENGINEER PRIOR TO INSTALLATION.
- LOOPS ARE TO BE TERMINATED AT THE JUNCTION BOX WITH 1m SLACK PER LOOP WIRE COILED NEATLY WITHIN THE BOX. LOOPS WILL NOT BE CONNECTED TO THE CONTROLLER AT THIS TIME.
- ALL LOOPS WILL EXTEND 1m PAST THE CENTER OF THE STOP BAR ON EACH APPROACH.
- LOOPS SHALL BE INSTALLED IN THE PAVEMENT PRIOR TO THE PLACEMENT OF THE WEARING COURSE.
- IF WATER VALVES, DROP INLETS OR OTHER OBSTRUCTIONS ARE ENCOUNTERED WITHIN THE AREA OF A PROPOSED LOOP, THE CONTRACTOR SHALL TAKE SPECIAL CARE TO AVOID THE OBSTRUCTION DURING LOOP INSTALLATION. IF LOOP SIZES OR SHAPES ARE TO BE MODIFIED DUE TO OBSTRUCTIONS THE RESIDENT ENGINEER MUST APPROVE LAYOUT PRIOR TO INSTALLATION.
- SEE SHEET I2 OF I08 FOR ITEM DETAIL SUMMARY SHEET #2.

TRAFFIC LOOP LAYOUT # 5	SURVEYED BY <u>N/A</u> DATE <u>N/A</u>
	DRAWN BY <u>K.H.D.</u> DATE <u>4/01</u>
	SQUAD LEADER <u>T.P.K.</u>
	DESIGN FILE NO. <u>/pave/99d156/pd156.dgn</u>
	IPARM FILE <u>pbl56t15.i</u> DATE <u>20 NOV-2005 10:20</u>
PROJ. NAME <u>BENNINGTON</u>	
PROJ. NO. <u>NH 2202(I)S</u>	
SHEET <u>45</u> OF <u>108</u> SHEETS	

DATUM	
VERTICAL	<u>N/A</u>
HORIZONTAL	<u>N/A</u>

678.22 VEHICLE LOOP DETECTOR

LOOP 2 - 43 m
 LOOP 4 - 41m
 LOOP 6 - 42 m
 LOOP 8 - 41m

678.23 WIRED CONDUIT (DN4I)

LOOP 4 TO JBI - 2 m
 LOOP 6 TO JB2 - 1m
 LOOP 8 TO JB3 - 2 m
 LOOP 2 TO JB4 - 2 m


678.26 JUNCTION BOX

JBI-STA. 8+458.0 LT
 JB2-STA. 8+483.0 LT
 JB3-STA. 8+480.0 RT
 JB4-STA. 8+438.0 RT

VEHICLE LOOP DETECTORS							TEST RESULTS AT JUNCTION BOX					TEST RESULTS AT CONTROLLER (FUTURE USE)**				
LANE	LOOP NO.	SIZE	TYPE	NO TURNS	MODE	AMP	INDUCTANCE (uH)		RESISTANCE Ω @ 25° C		(MΩ)	INDUCTANCE (uH)		RESISTANCE Ω @ 25° C		(MΩ)
							CALCULATED	MEASURED	CALCULATED	MEASURED	LEAKAGE TO GROUND	CALCULATED	MEASURED	CALCULATED	MEASURED	LEAKAGE TO GROUND
EB THRU	△2	1.8m x 12.0m	QUAD.	2	PRESENCE	NON-DELAY	337		0.60			374		1.07		
SB THRU	△4	1.8m x 12.0m	QUAD.	2	PRESENCE	NON-DELAY	336		0.59			374		1.07		
WB THRU	△6	1.8m x 12.0m	QUAD.	2	PRESENCE	NON-DELAY	337		0.60			395		1.34		
NB THRU	△8	1.8m x 12.0m	QUAD.	2	PRESENCE	NON-DELAY	335		0.58			340		0.63		

* MEASURED VALUES MUST BE FILLED IN PRIOR TO TEST PERIOD.

** CALCULATED VALUES AT CONTROLLER ARE BASED ON DIRECT CONDUIT ROUTING TO THE NEAREST SIGNAL POLE AND CROSSING THE SPAN WIRE AS NECESSARY TO THE EXISTING CONTROLLER LOCATION. ANY SIGNAL MODIFICATION AND/OR CONTROLLER RELOCATION PRIOR TO LOOP CONNECTION WILL REQUIRE RECALCULATION OF THESE VALUES.

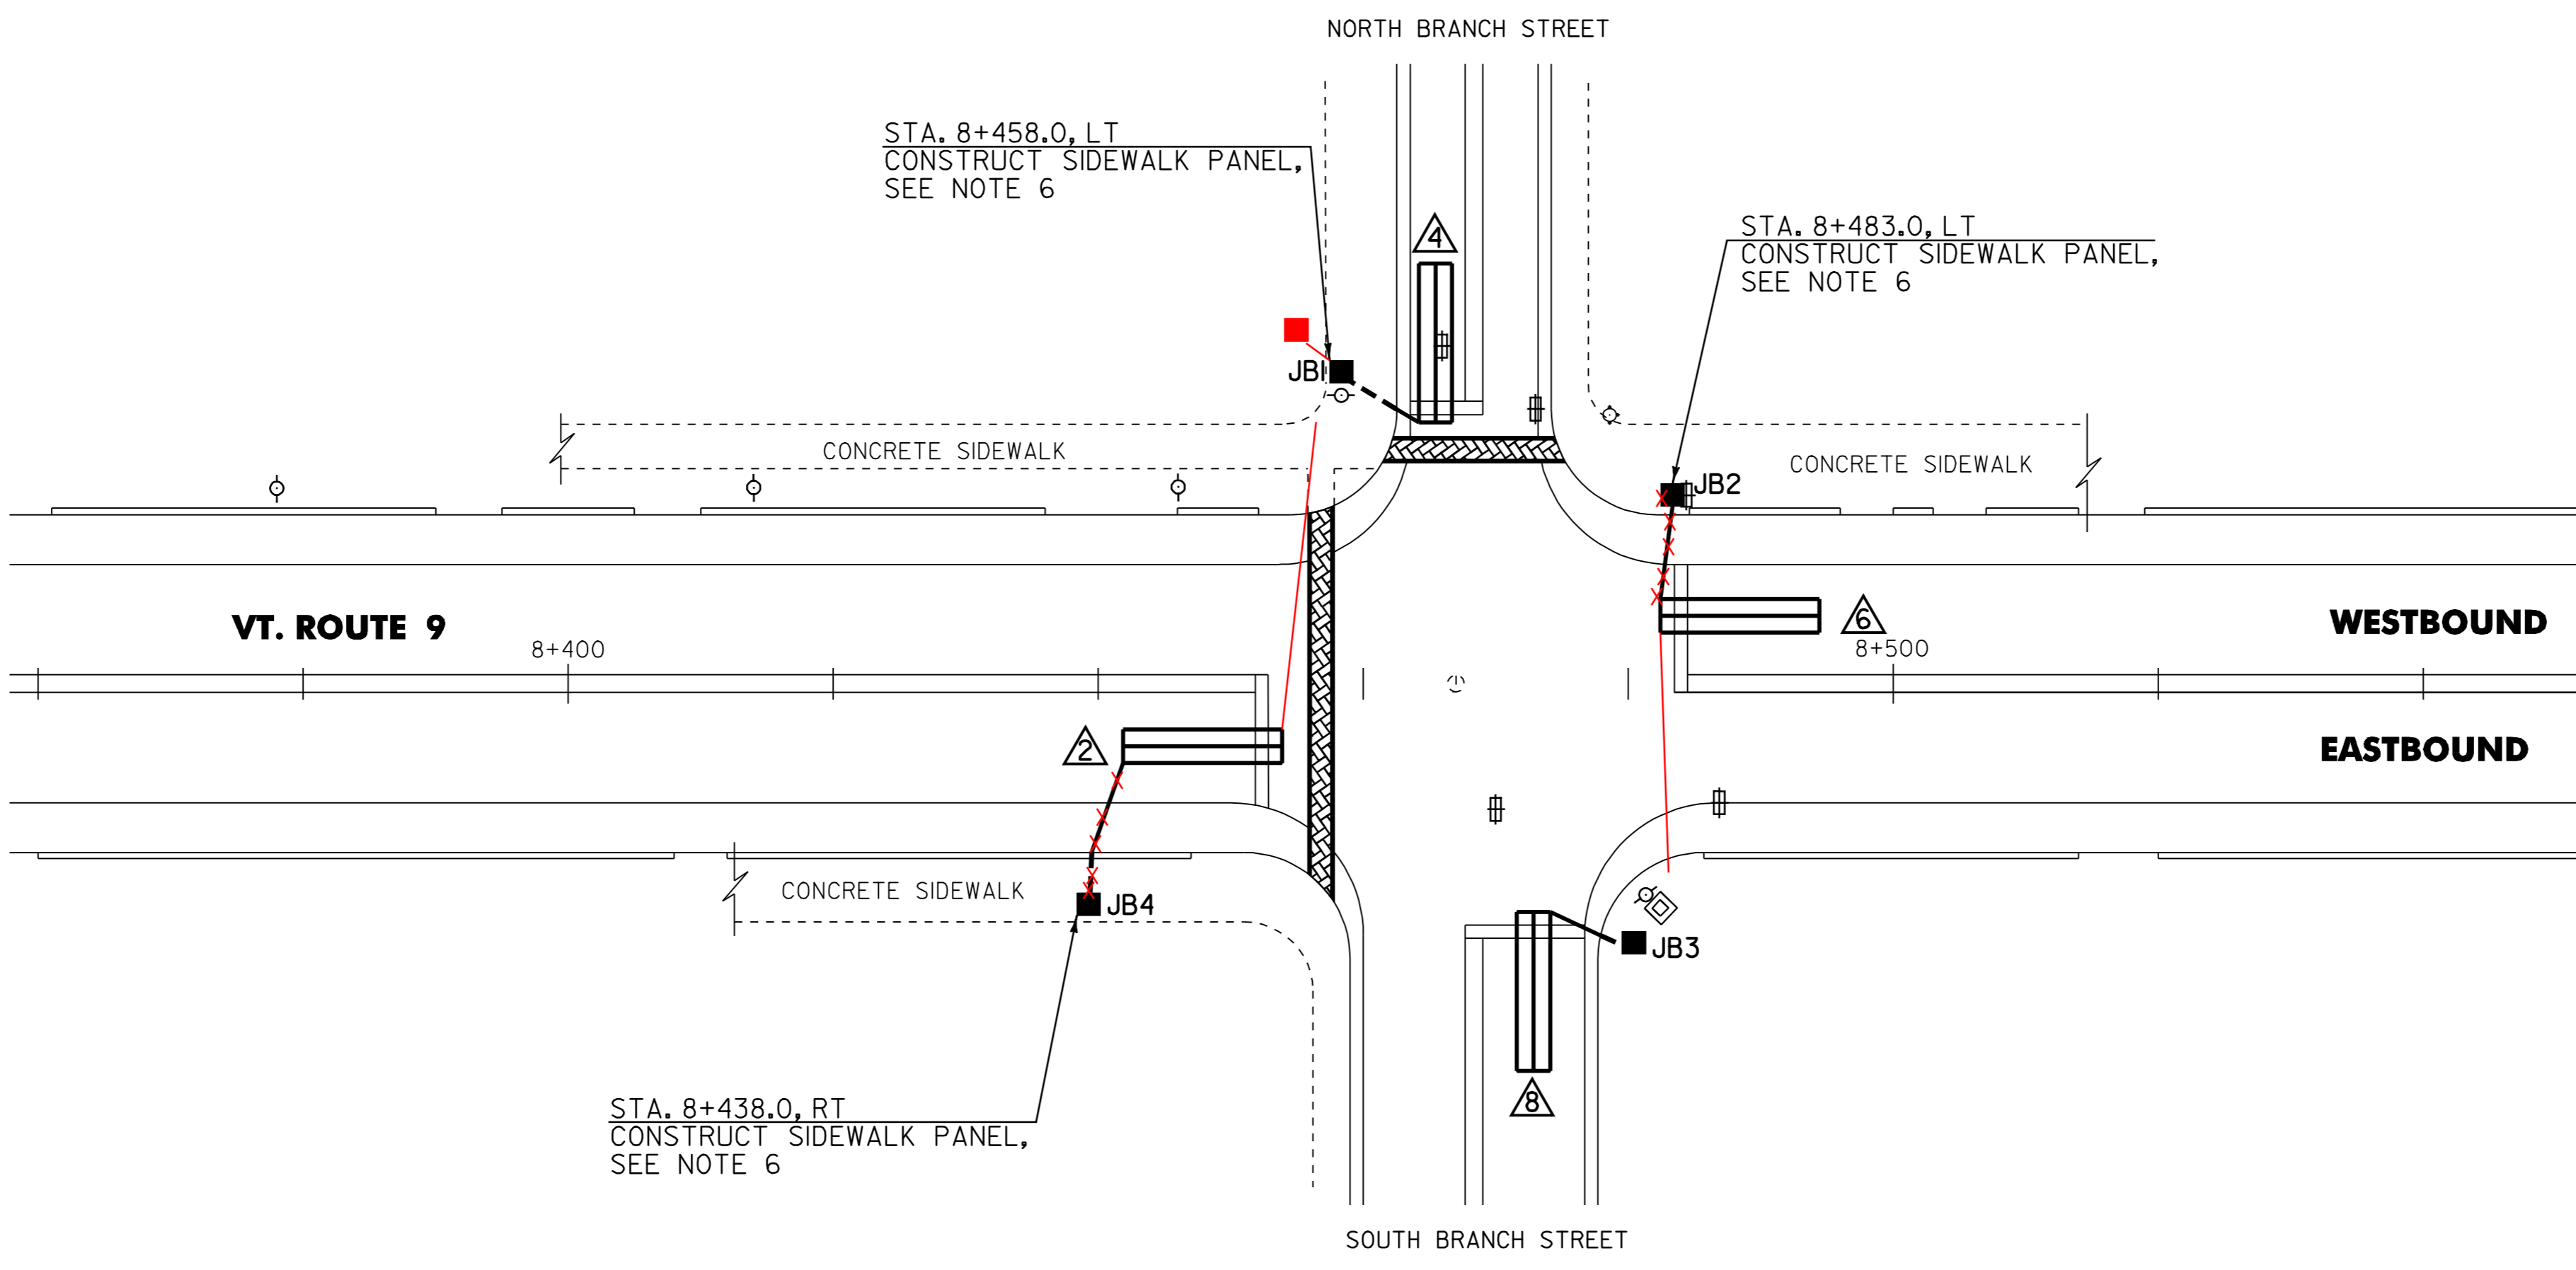

STA. 8+458.0, LT
 CONSTRUCT SIDEWALK PANEL,
 SEE NOTE 6

STA. 8+483.0, LT
 CONSTRUCT SIDEWALK PANEL,
 SEE NOTE 6

STA. 8+438.0, RT
 CONSTRUCT SIDEWALK PANEL,
 SEE NOTE 6

LEGEND		
EXISTING	NEW	DESCRIPTION
		VEHICLE LOOP
		CONDUIT
		JUNCTION BOX
		CONTROLLER CABINET

NOTES:

- THIS PLAN SHEET IS NOT TO SCALE AND SHALL ONLY BE USED AS A GUIDE FOR LOOP AND JUNCTION BOX PLACEMENT. THE CONTRACTOR SHALL CONFIRM ALL LOCATIONS IN THE FIELD WITH THE RESIDENT ENGINEER PRIOR TO INSTALLATION.
- LOOPS ARE TO BE TERMINATED AT THE JUNCTION BOX WITH 1m SLACK PER LOOP WIRE COILED NEATLY WITHIN THE BOX. LOOPS WILL NOT BE CONNECTED TO THE CONTROLLER AT THIS TIME.
- ALL LOOPS WILL EXTEND 1m PAST THE CENTER OF THE STOP BAR ON EACH APPROACH.
- LOOPS SHALL BE INSTALLED IN THE PAVEMENT PRIOR TO THE PLACEMENT OF THE WEARING COURSE.
- IF WATER VALVES, DROP INLETS OR OTHER OBSTRUCTIONS ARE ENCOUNTERED WITHIN THE AREA OF A PROPOSED LOOP, THE CONTRACTOR SHALL TAKE SPECIAL CARE TO AVOID THE OBSTRUCTION DURING LOOP INSTALLATION. IF LOOP SIZES OR SHAPES ARE TO BE MODIFIED DUE TO OBSTRUCTIONS THE RESIDENT ENGINEER MUST APPROVE LAYOUT PRIOR TO INSTALLATION.
- SEE SHEET 12 OF 108 FOR ITEM DETAIL SUMMARY SHEET #2.

DATUM	
VERTICAL	N/A
HORIZONTAL	N/A

TRAFFIC LOOP LAYOUT # 6

SURVEYED BY	N/A	DATE	N/A
DRAWN BY	K.H.D.	DATE	4/01
SQUAD LEADER	T.P.K.		
DESIGN FILE NO.	/pave/99d156/pd156.dgn		
IPARM FILE	pbl56+16.1	DATE PLOTTED	20 NOV-2005 10:20
PROJ. NAME	BENNINGTON		
PROJ. NO.	NH 2202(I)S		
SHEET 46 OF 108 SHEETS			

678.22 VEHICLE LOOP DETECTOR

 LOOP 2 - 42 m
 LOOP 4 - 41m
 LOOP 6 - 42 m
 LOOP 8 - 41m

678.23 WIRED CONDUIT (DN4I)

 LOOP 4 TO JBI - 2 m
 LOOP 6 TO JB2 - 2 m
 LOOP 8 TO JB3 - 1m
 LOOP 2 TO JB4 - 1m


678.26 JUNCTION BOX

 JBI-STA. 5+440.0 LT
 JB2-STA. 5+462.0 LT
 JB3-STA. 5+460.0 RT
 JB4-STA. 5+435.0 RT

VEHICLE LOOP DETECTORS							TEST RESULTS AT JUNCTION BOX					TEST RESULTS AT CONTROLLER (FUTURE USE) **				
							INDUCTANCE (uH)		RESISTANCE Ω @ 25°C		(M Ω)	INDUCTANCE (uH)		RESISTANCE Ω @ 25°C		(M Ω)
LANE	LOOP NO.	SIZE	TYPE	NO TURNS	MODE	AMP	CALCULATED	MEASURED	CALCULATED	MEASURED	LEAKAGE TO GROUND	CALCULATED	MEASURED	CALCULATED	MEASURED	LEAKAGE TO GROUND
NB THRU	△	1.8m x 12.0m	QUAD.	2	PRESENCE	NON-DELAY	336		0.59			359		0.88		
EB THRU	△	1.8m x 12.0m	QUAD.	2	PRESENCE	NON-DELAY	336		0.59			378		1.12		
SB THRU	△	1.8m x 12.0m	QUAD.	2	PRESENCE	NON-DELAY	338		0.61			392		1.30		
WB THRU	△	1.8m x 12.0m	QUAD.	2	PRESENCE	NON-DELAY	335		0.58			340		0.63		

*MEASURED VALUES MUST BE FILLED IN PRIOR TO TEST PERIOD.

**CALCULATED VALUES AT CONTROLLER ARE BASED ON DIRECT CONDUIT ROUTING TO THE NEAREST SIGNAL POLE AND CROSSING THE SPAN WIRE AS NECESSARY TO THE EXISTING CONTROLLER LOCATION. ANY SIGNAL MODIFICATION AND/OR CONTROLLER RELOCATION PRIOR TO LOOP CONNECTION WILL REQUIRE RECALCULATION OF THESE VALUES.

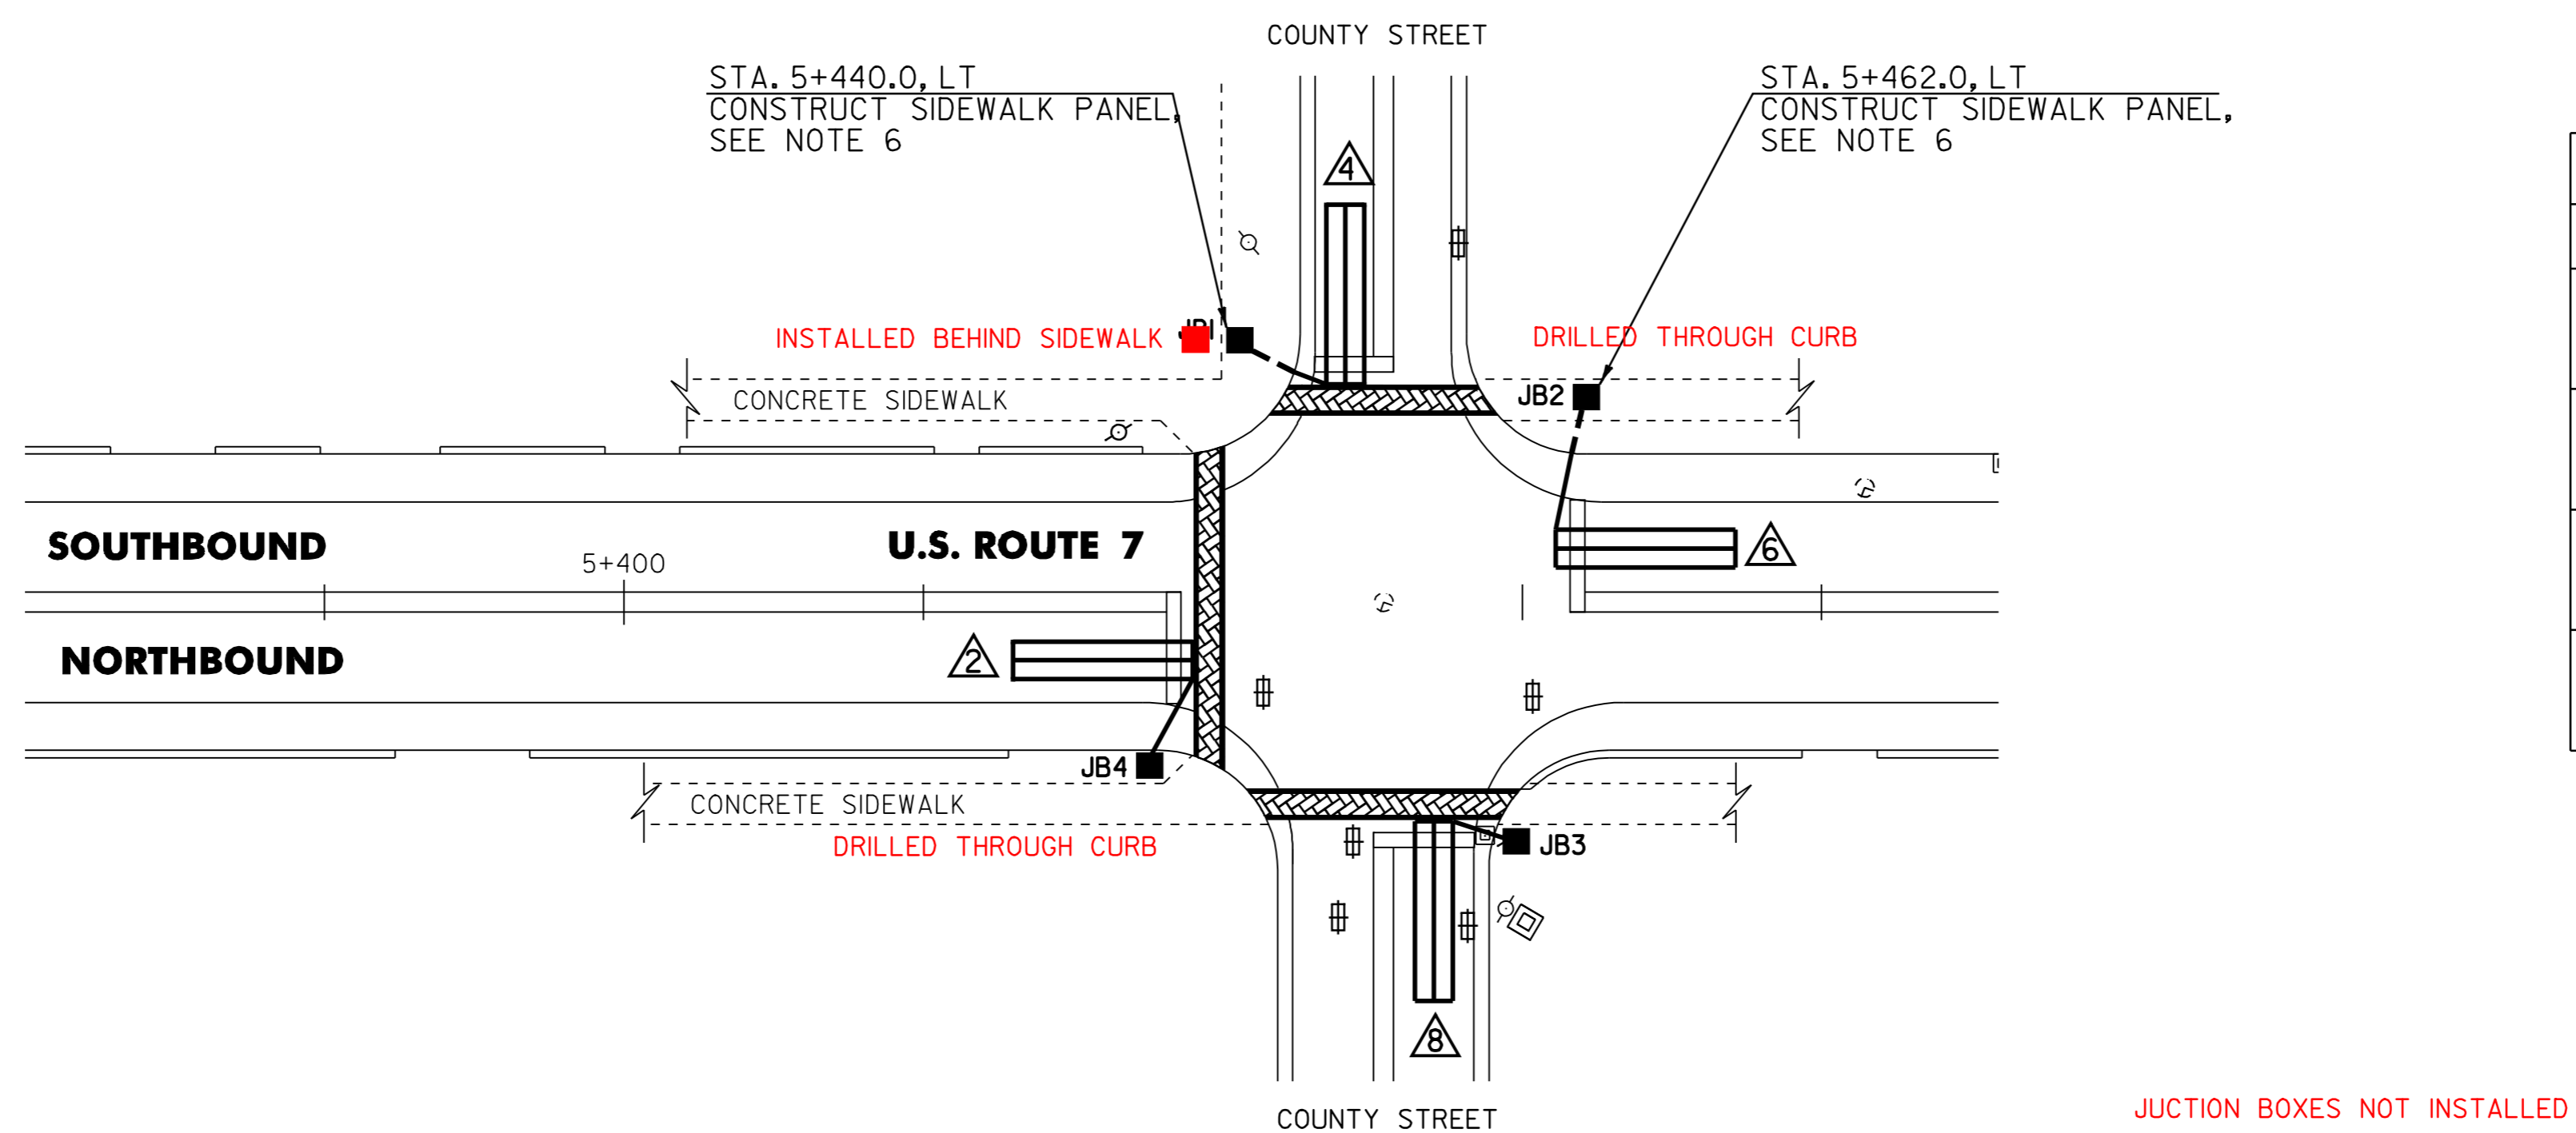

LEGEND		
EXISTING	NEW	DESCRIPTION
		VEHICLE LOOP
		CONDUIT
		JUNCTION BOX
		CONTROLLER CABINET

NOTES:

- THIS PLAN SHEET IS NOT TO SCALE AND SHALL ONLY BE USED AS A GUIDE FOR LOOP AND JUNCTION BOX PLACEMENT. THE CONTRACTOR SHALL CONFIRM ALL LOCATIONS IN THE FIELD WITH THE RESIDENT ENGINEER PRIOR TO INSTALLATION.
- LOOPS ARE TO BE TERMINATED AT THE JUNCTION BOX WITH 1m SLACK PER LOOP WIRE COILED NEATLY WITHIN THE BOX. LOOPS WILL NOT BE CONNECTED TO THE CONTROLLER AT THIS TIME.
- ALL LOOPS WILL EXTEND 1m PAST THE CENTER OF THE STOP BAR ON EACH APPROACH.
- LOOPS SHALL BE INSTALLED IN THE PAVEMENT PRIOR TO THE PLACEMENT OF THE WEARING COURSE.
- IF WATER VALVES, DROP INLETS OR OTHER OBSTRUCTIONS ARE ENCOUNTERED WITHIN THE AREA OF A PROPOSED LOOP, THE CONTRACTOR SHALL TAKE SPECIAL CARE TO AVOID THE OBSTRUCTION DURING LOOP INSTALLATION. IF LOOP SIZES OR SHAPES ARE TO BE MODIFIED DUE TO OBSTRUCTIONS THE RESIDENT ENGINEER MUST APPROVE LAYOUT PRIOR TO INSTALLATION.
- SEE SHEET 13 OF 108 FOR ITEM DETAIL SUMMARY SHEET #3.

TRAFFIC LOOP LAYOUT # 7

 SURVEYED BY N/A DATE N/A
 DRAWN BY K.H.D. DATE 4/01
 SQUAD LEADER T.P.K.
 DESIGN FILE NO. /pave/99d156/pd156.dgn
 IPARM FILE pd156+17.1 DATE 20 NOV-2005 10:20
 PROJ. NAME BENNINGTON
 PROJ. NO. NH 2202(1)S
 SHEET 47 OF 108 SHEETS

DATUM	
VERTICAL	<u>N/A</u>
HORIZONTAL	<u>N/A</u>

KILOMETER MARKER, STATION, OR SIGN NUMBER	SIGN LEGEND	SIGN DIMENSIONS		NEW & SALVAGED SIGNS				EXIST POST RETAIN	SALVAGE	NO. OF POSTS	NEW SIGN POSTS																REMARKS	SIGN DETAIL						
		EA	WIDTH (mm)	HEIGHT (mm)	"A"	"B"	SALV SIGN				SALV TIS	FLANGED CHANNEL			SQUARE STEEL (mm)			TUBULAR ALUMINUM Ø (mm)			TUBULAR STEEL Ø (mm)				W-SHAPE STEEL			FRAMING SIGN	REQUIRED	DETAIL ON SHEET NUMBER	STD. SHEET NUMBER			
												1.7	3.0	4.5	44	50	63	75	100	100 MOD	FOUND-ATION	75	89	100	125	FTG. SIZE						WEIGHT	POST SIZE	
																										kg/m								kg/m
OPTION ITEMS																																		
BENNINGTON: VT. ROUTE 9 5+356.0, RT		1	600	600	0.36					1			4.27 X			X																E-132M		
		1	600	150	0.09																										E-132M			
5+380.0, LT		1	600	750	0.45					1			4.27 X			X															E-142M			
5+451.5, RT		1	1200	600	0.72					2			3.66 X 3.66			X															E-152M			
5+452.0, RT		1	750	750	0.56					1			4.27 X			X																E-143M		
		1	750	750	0.56																													
		1	900	300	0.27																												E-142M	
		1	900	300	0.27																													E-142M
5+454.0, RT		1	750	750	0.56					1			4.27 X			X																	E-143M	
		1	750	750	0.56																													
		1	900	300	0.27																												E-142M	
		1	900	300	0.27																													
		1	150	200	0.03																											E-138M		
5+456.0, RT		1	1200	600	0.72					2			3.66 X 3.66			X																	E-152M	
		1	750	750	0.56																													
5+487.0, RT		1	750	750	0.56					1			4.27 X			X																E-152M		

FINAL POST LENGTHS ARE TO BE DETERMINED IN THE FIELD. POST SIZES ARE COMPUTED BASED ON INFORMATION FURNISHED ON THE STANDARD SHEETS AND THE TRAFFIC & SAFETY DIVISION'S "SIGN POST DESIGN GUIDELINE."

TOTALS	6.81	m ²	m ²	EA	m ²		m	41.4	m	41.4	EA	kg	kg	kg	EA	kg	EA	EA	kg
---------------	------	----------------	----------------	----	----------------	--	---	------	---	------	----	----	----	----	----	----	----	----	----

PROJECT: BENNINGTON	PROJECT NO.: NH 2202(I)S
DESIGN FILE NAME: pave/99dl56/pdl56.dgn	PLOT DATE: 21-NOV-2005 10:
IPARM FILE NAME: pdl56ss02.i	SURVEY DATE: N/A
SURVEYED BY: N/A	DRAWN BY: C.A.K.
SQUAD LEADER: T.P.K.	SHEET: 49 OF 108

KILOMETER MARKER, STATION, OR SIGN NUMBER	SIGN LEGEND	SIGN DIMENSIONS			NEW & SALVAGED SIGNS				EXIST POST RETAIN SALVAGE	NO. OF POSTS	NEW SIGN POSTS												REMARKS	SIGN DETAIL									
		EA	WIDTH (mm)	HEIGHT (mm)	"A"	"B"	SALV SIGN	SALV TIS			FLANGED CHANNEL			SQUARE STEEL (mm)			TUBULAR ALUMINUM Ø (mm)			TUBULAR STEEL Ø (mm)				W-SHAPE STEEL		FRAMING SIGN	REQUIRED	DETAIL ON SHEET NUMBER	STD. SHEET NUMBER				
											1.7	3.0	4.5	44	50	63	75	100	100 MOD	FOUND-ATION	75	89		100	125					FTG. SIZE		WEIGHT	POST SIZE
														kg/m			kg/m				kg/m			600 mm	750 mm								
OPTION ITEMS																																	
BENNINGTON: VT. ROUTE 9 5+533.0, LT		1	900	300	0.27					1			3.66																BACK - TO - BACK	E-142M			
		1	900	300	0.27								X																E-142M				
5+539.0, LT		1	900	300	0.27					1			3.66																BACK - TO - BACK	E-142M			
		1	900	300	0.27								X																E-142M				
5+564.0, LT		1	750	750	0.56					1			4.27																BACK - TO - BACK	E-143M			
		1	150	200	0.03								X																E-138M				
5+565.0, RT		1	900	300	0.27					1			3.66																BACK - TO - BACK	E-142M			
		1	900	300	0.27								X																E-142M				
5+576.0, RT		1	900	300	0.27					1			3.66																BACK - TO - BACK	E-142M			
		1	900	300	0.27								X																E-142M				

FINAL POST LENGTHS ARE TO BE DETERMINED IN THE FIELD. POST SIZES ARE COMPUTED BASED ON INFORMATION FURNISHED ON THE STANDARD SHEETS AND THE TRAFFIC & SAFETY DIVISION'S "SIGN POST DESIGN GUIDELINE."

TOTALS	m ²	m ²	EA	m ²		m	m	EA	kg	kg	kg	kg	kg	kg	EA	EA	kg
	2.75					23.0	23.0										

PROJECT: BENNINGTON

DESIGN FILE NAME: pave/99dl56/pdl56.dgn

IPARM FILE NAME: pdl56ss03.l

SURVEYED BY: N/A

SQUAD LEADER: T.P.K.

PROJECT NO.: NH 2202(I)S

PLOT DATE: 21-NOV-2005 10:

SURVEY DATE: N/A

DRAWN BY: C.A.K.

SHEET: 50 OF 108

KILOMETER MARKER, STATION, OR SIGN NUMBER	SIGN LEGEND	SIGN DIMENSIONS			NEW & SALVAGED SIGNS				EXIST POST	NO. OF POSTS	NEW SIGN POSTS														REMARKS	SIGN DETAIL									
		EA	WIDTH (mm)	HEIGHT (mm)	"A"	"B"	SALV SIGN	SALV TIS			RETAIN	SALVAGE	FLANGED CHANNEL			SQUARE STEEL (mm)			TUBULAR ALUMINUM Ø (mm)			TUBULAR STEEL Ø (mm)				W-SHAPE STEEL				FRAMING	REQUIRED	DETAIL ON SHEET NUMBER	STD. SHEET NUMBER		
													1.7	3.0	4.5	44	50	63	75	100	100 MOD	FOUND-ATION	75	89		100	125	FTG. SIZE						WEIGHT	POST SIZE
																kg/m	kg/m	kg/m	kg/m	kg/m	kg/m		kg/m	kg/m		600 mm	750 mm								
BENNINGTON: VT. ROUTE 9 5+585.0, RT		1	600	750	0.45					1			4.27 X		X																E-146M				
5+589.0, LT		1	600	750	0.45					1			4.27 X		X															E-146M					
5+660.0, LT		1	750	750	0.56					1			4.27 X		X													69	-						
5+690.0, LT		1	750	750	0.56					1			4.27 X		X															E-152M					
5+702.0, LT	 	1 1	600 750	150 150	0.09 0.11					1			4.27 X		X																TOP MOUNTING BRACKET REQUIRED TO INSTALL NEW SIGN ON FLANGED CHANNEL POST.				
	 	1 1	750 150	750 200	0.56 0.03																										BACK - TO - BACK				
5+720.0, RT		1	750	750	0.56					1			4.27 X		X																E-153M				

<p>FINAL POST LENGTHS ARE TO BE DETERMINED IN THE FIELD. POST SIZES ARE COMPUTED BASED ON INFORMATION FURNISHED ON THE STANDARD SHEETS AND THE TRAFFIC & SAFETY DIVISION'S "SIGN POST DESIGN GUIDELINE."</p>											m			m			EA			kg			kg			kg			kg			EA			EA			kg		
											27.6			27.6																										
											m			m			kg			EA			kg			EA			EA			kg								
TOTALS											3.37																													

PROJECT: BENNINGTON	PROJECT NO.: NH 2202(1)S
DESIGN FILE NAME: pave/99dl56/pdl56.dgn	PLOT DATE: 21-NOV-2005 10:
IPARM FILE NAME: pdl56ss04.i	SURVEY DATE: N/A
SURVEYED BY: N/A	DRAWN BY: C.A.K.
SQUAD LEADER: T.P.K.	SHEET: 51 OF 108

KILOMETER MARKER, STATION, OR SIGN NUMBER	SIGN LEGEND	SIGN DIMENSIONS		NEW & SALVAGED SIGNS				EXIST POST	NO. OF POSTS	NEW SIGN POSTS													REMARKS	SIGN DETAIL									
		EA	WIDTH (mm)	HEIGHT (mm)	"A"	"B"	SALV SIGN			SALV TIS	FLANGED CHANNEL		SQUARE STEEL (mm)			TUBULAR ALUMINUM Ø (mm)			TUBULAR STEEL Ø (mm)					W-SHAPE STEEL		FRAMING SIGN	REQUIRED	DETAIL ON SHEET NUMBER	STD. SHEET NUMBER				
											1.7	3.0	4.5	44	50	63	75	100	100 MOD	FOUND-ATION	75	89		100	125					FTG. SIZE		WEIGHT	POST SIZE
																														kg/m	kg/m		
BENNINGTON: VT. ROUTE 9 5+985.0, LT		1	750	750	0.56				1		4.27 X																				E-153M		
6+015.0, RT		1	600	750	0.45				1		4.27 X																			E-142M			
6+076.0, LT		1	600	750	0.45				1		4.27 X																						
6+086.0, LT			750	400	0.34				1		4.27 X																				E-128BM		
6+180.0, LT		1	600	150	0.09				1		4.27 X															SALVAGED SIGN TO BE MOUNTED ON NEW POST. TOP MOUNTING BRACKET REQUIRED TO INSTALL SALVAGED SIGN ON FLANGED CHANNEL POST.	-	-		E-123M			
		1	750	750	0.56																										E-143M		
		1	150	200	0.03																										E-138M		
6+226.0, RT		1	750	750	0.56				1		4.27 X																				69	-	
6+234.0, RT		1	600	150	0.09				1		4.27 X															SALVAGED SIGN TO BE MOUNTED ON NEW POST. TOP MOUNTING BRACKET REQUIRED TO INSTALL SALVAGED SIGN ON FLANGED CHANNEL POST.	-	-		E-123M			
		1	750	750	0.56																										E-143M		
		1	150	200	0.03																										E-138M		
6+322.0, RT		1	750	750	0.56				1		4.27 X																				69	-	

OPTION ITEMS

m m m m m m EA kg kg kg kg kg kg kg kg

32.2 32.2

FINAL POST LENGTHS ARE TO BE DETERMINED IN THE FIELD. POST SIZES ARE COMPUTED BASED ON INFORMATION FURNISHED ON THE STANDARD SHEETS AND THE TRAFFIC & SAFETY DIVISION'S "SIGN POST DESIGN GUIDELINE."

TOTALS

m² 3.83 m² EA 2 m² m 32.2 m 32.2 kg EA kg EA EA kg

PROJECT: BENNINGTON	PROJECT NO.: NH 2202(I)S
DESIGN FILE NAME: pave/99dl56/pdl56.dgn	PLOT DATE: 21-NOV-2005 10:00
IPARM FILE NAME: pdl56ss05.i	SURVEY DATE: N/A
SURVEYED BY: N/A	DRAWN BY: C.A.K.
SQUAD LEADER: T.P.K.	SHEET: 52 OF 108

KILOMETER MARKER, STATION, OR SIGN NUMBER	SIGN LEGEND	SIGN DIMENSIONS			NEW & SALVAGED SIGNS				EXIST POST RETAIN	NO. OF POSTS	NEW SIGN POSTS													REMARKS	SIGN DETAIL						
		EA	WIDTH (mm)	HEIGHT (mm)	"A"	"B"	SALV SIGN	SALV TIS			FLANGED CHANNEL			SQUARE STEEL (mm)			TUBULAR ALUMINUM (mm)			TUBULAR STEEL (mm)					W-SHAPE STEEL			DETAIL ON SHEET NUMBER	STD. SHEET NUMBER		
											1.7	3.0	4.5	44	50	63	75	100	100 MOD	FOUND-ATION	75	89	100		125	FTG. SIZE				WEIGHT	POST SIZE
																										kg/m	kg/m				
BENNINGTON: VT. ROUTE 9 6+330.0, RT	MAIN ST McCALL ST	1	600	150	0.09					1			4.27														SALVAGED SIGN TO BE MOUNTED ON NEW POST. TOP MOUNTING BRACKET REQUIRED TO INSTALL SALVAGED SIGN ON FLANGED CHANNEL POST.	-	E-123M		
		1	750	750	0.56																					BACK - TO - BACK		E-143M E-138M			
6+368.0, LT	MAIN ST McKINLEY ST						1			1			4.27														SALVAGED SIGNS TO BE MOUNTED ON NEW POST. TOP MOUNTING BRACKET REQUIRED TO INSTALL SALVAGED SIGNS ON FLANGED CHANNEL POST.	-	-		
		1	750	750	0.56																					BACK - TO - BACK		E-143M E-138M			
6+505.0, LT		1	600	750	0.45					1			4.27																E-142M		
6+528.0, RT	MAIN ST HARRISON AVE	1	600	150	0.09					1			4.27														SALVAGED SIGN TO BE MOUNTED ON NEW POST. TOP MOUNTING BRACKET REQUIRED TO INSTALL SALVAGED SIGN ON FLANGED CHANNEL POST.	-	E-123M		
		1	750	750	0.56																					BACK - TO - BACK		E-143M E-138M			
6+585.0, LT		1	600	300	0.18					1							8.8										USE 70 mm DIAMETER TUBULAR ALUMINUM SIGN POST PAINTED BLACK. PAYMENT UNDER ITEM 675.32 TUBULAR ALUMINUM SIGN POST (MOD.).		E-136BM		
		1	600	600	0.36																								E-136BM		
6+597.0, RT		1	600	900	0.54					1							8.8										USE 70 mm DIAMETER TUBULAR ALUMINUM SIGN POST PAINTED BLACK. PAYMENT UNDER ITEM 675.32 TUBULAR ALUMINUM SIGN POST (MOD.).		E-140M		

FINAL POST LENGTHS ARE TO BE DETERMINED IN THE FIELD. POST SIZES ARE COMPUTED BASED ON INFORMATION FURNISHED ON THE STANDARD SHEETS AND THE TRAFFIC & SAFETY DIVISION'S "SIGN POST DESIGN GUIDELINE."											m			m			EA			kg			kg			kg			kg			EA			EA			kg		
											18.4			18.4			17.6																							
TOTALS											m			m			kg			EA			EA			kg														
											3.48			4			18.4			17.6																				

PROJECT: BENNINGTON	PROJECT NO.: NH 2202(I)S
DESIGN FILE NAME: pave/99d156/pdl56.dgn	PLOT DATE: 21-NOV-2005 10:
IPARM FILE NAME: pdl56ss06.1	SURVEY DATE: N/A
SURVEYED BY: N/A	DRAWN BY: C.A.K.
SQUAD LEADER: T.P.K.	SHEET: 53 OF 108

KILOMETER MARKER, STATION, OR SIGN NUMBER	SIGN LEGEND	SIGN DIMENSIONS		NEW & SALVAGED SIGNS				EXIST POST		NEW SIGN POSTS													REMARKS	SIGN DETAIL									
		EA	WIDTH (mm)	HEIGHT (mm)	"A"	"B"	SALV SIGN	SALV TIS	RETA IN	SALV AGE	NO. OF POSTS	FLANGED CHANNEL			SQUARE STEEL (mm)			TUBULAR ALUMINUM Ø (mm)			TUBULAR STEEL Ø (mm)				W-SHAPE STEEL			FRAM E	SIG NE	REQUI RED	DETAIL ON SHEET NUMBER	STD. SHEET NUMBER	
												1.7	3.0	4.5	44	50	63	75	100	100 MOD	FOUND- ATION	75		89	100	125	FTG. SIZE						WEIGHT

OPTION ITEMS																														
BENNINGTON VT. ROUTE 9: 7+134.0, LT		1	300	450	0.14						1																	USE 70 mm DIAMETER TUBULAR ALUMINUM SIGN POST PAINTED BLACK. PAYMENT UNDER ITEM 675.32 TUBULAR ALUMINUM SIGN POST (MOD.).	69	-
7+155.0, LT		1	900	750	0.68						1																USE 70 mm DIAMETER TUBULAR ALUMINUM SIGN POST PAINTED BLACK. PAYMENT UNDER ITEM 675.32 TUBULAR ALUMINUM SIGN POST (MOD.).		E-145AM	
7+168.0, RT 7+213		1	300	450	0.14						1																USE 70 mm DIAMETER TUBULAR ALUMINUM SIGN POST PAINTED BLACK. PAYMENT UNDER ITEM 675.32 TUBULAR ALUMINUM SIGN POST (MOD.).	69	-	
7+230.0, LT		1	450	225	0.10						1																USE 70 mm DIAMETER TUBULAR ALUMINUM SIGN POST PAINTED BLACK. PAYMENT UNDER ITEM 675.32 TUBULAR ALUMINUM SIGN POST (MOD.).REDUCE MINIMUM STANDARD SIZE SIGN DIMENSIONS BY 25%.		E-136BM	
		1	450	450	0.20																						REDUCE MINIMUM STANDARD SIZE SIGN DIMENSIONS BY 25%.		E-136BM	
		1	395	280	0.11																						REDUCE MINIMUM STANDARD SIZE SIGN DIMENSIONS BY 25%.		E-136BM	
		1	450	225	0.10																						REDUCE MINIMUM STANDARD SIZE SIGN DIMENSIONS BY 25%.		E-136AM	
		1	450	225	0.10																						REDUCE MINIMUM STANDARD SIZE SIGN DIMENSIONS BY 25%.		E-136AM	
		1	450	450	0.20																						REDUCE MINIMUM STANDARD SIZE SIGN DIMENSIONS BY 25%.		E-136AM	
		1	450	450	0.20																						REDUCE MINIMUM STANDARD SIZE SIGN DIMENSIONS BY 25%.		E-136AM	
		1	395	280	0.11																						REDUCE MINIMUM STANDARD SIZE SIGN DIMENSIONS BY 25%.		E-136AM	
		1	395	280	0.11																						REDUCE MINIMUM STANDARD SIZE SIGN DIMENSIONS BY 25%.		E-136AM	

FINAL POST LENGTHS ARE TO BE DETERMINED IN THE FIELD. POST SIZES ARE COMPUTED BASED ON INFORMATION FURNISHED ON THE STANDARD SHEETS AND THE TRAFFIC & SAFETY DIVISION'S "SIGN POST DESIGN GUIDELINE."																																															
TOTALS																																															

PROJECT: BENNINGTON	PROJECT NO.: NH 2202(1)S
DESIGN FILE NAME: pave/99dl56/pdl56.dgn	PLOT DATE: 21-NOV-2005 10:
IPARM FILE NAME: pdl56ssi0.1	SURVEY DATE: N/A
SURVEYED BY: N/A	DRAWN BY: C.A.K.
SQUAD LEADER: T.P.K.	SHEET: 57 OF 108

KILOMETER MARKER, STATION, OR SIGN NUMBER	SIGN LEGEND	SIGN DIMENSIONS		NEW & SALVAGED SIGNS				EXIST POST	NO. OF POSTS	NEW SIGN POSTS												REMARKS	SIGN DETAIL							
		EA	WIDTH (mm)	HEIGHT (mm)	"A"	"B"	SALV SIGN			SALV TIS	FLANGED CHANNEL			SQUARE STEEL (mm)			TUBULAR ALUMINUM Ø (mm)			TUBULAR STEEL Ø (mm)				W-SHAPE STEEL		DETAIL ON SHEET NUMBER	STD. SHEET NUMBER			
											1.7	3.0	4.5	44	50	63	75	100	100 MOD	75	89		100	125	FTG. SIZE			WEIGHT	POST SIZE	
																									kg/m					kg/m
OPTION ITEMS																														
BENNINGTON VT. ROUTE 9: 7+285.0, LT		1	750	750	0.56				1																USE 70 mm DIAMETER TUBULAR ALUMINUM SIGN POST PAINTED BLACK. PAYMENT UNDER ITEM 675.32 TUBULAR ALUMINUM SIGN POST (MOD.). BACK - TO - BACK		E-143M E-138M			
7+308.0, LT		1	300	450	0.14				1																USE 70 mm DIAMETER TUBULAR ALUMINUM SIGN POST PAINTED BLACK. PAYMENT UNDER ITEM 675.32 TUBULAR ALUMINUM SIGN POST (MOD.).	69	-			
7+393.0, RT		1	900	300	0.27				1																USE 70 mm DIAMETER TUBULAR ALUMINUM SIGN POST PAINTED BLACK. PAYMENT UNDER ITEM 675.32 TUBULAR ALUMINUM SIGN POST (MOD.).		E-142M E-142M			
7+409.0, RT		1	300	450	0.14				1																USE 70 mm DIAMETER TUBULAR ALUMINUM SIGN POST PAINTED BLACK. PAYMENT UNDER ITEM 675.32 TUBULAR ALUMINUM SIGN POST (MOD.).	69	-			
7+491.0, RT		1	750	750	0.56				1																USE 70 mm DIAMETER TUBULAR ALUMINUM SIGN POST PAINTED BLACK. PAYMENT UNDER ITEM 675.32 TUBULAR ALUMINUM SIGN POST (MOD.).		E-143M			
		1	900	300	0.27																				BACK - TO - BACK		E-142M E-142M			
7+492.0, LT		1	900	300	0.27				1																USE 70 mm DIAMETER TUBULAR ALUMINUM SIGN POST PAINTED BLACK. PAYMENT UNDER ITEM 675.32 TUBULAR ALUMINUM SIGN POST (MOD.). BACK - TO - BACK		E-142M E-142M			
7+500.0, RT		1	750	750	0.56				1																USE 70 mm DIAMETER TUBULAR ALUMINUM SIGN POST PAINTED BLACK. PAYMENT UNDER ITEM 675.32 TUBULAR ALUMINUM SIGN POST (MOD.). BACK - TO - BACK		E-143M E-143M			
		1	900	300	0.27																				BACK - TO - BACK		E-142M E-142M			
		1	150	200	0.03																						E-138M			
7+500.0, LT		1	900	300	0.27				1																USE 70 mm DIAMETER TUBULAR ALUMINUM SIGN POST PAINTED BLACK. PAYMENT UNDER ITEM 675.32 TUBULAR ALUMINUM SIGN POST (MOD.). BACK - TO - BACK		E-142M E-142M			
		1	150	200	0.03																						E-138M			

FINAL POST LENGTHS ARE TO BE DETERMINED IN THE FIELD. POST SIZES ARE COMPUTED BASED ON INFORMATION FURNISHED ON THE STANDARD SHEETS AND THE TRAFFIC & SAFETY DIVISION'S "SIGN POST DESIGN GUIDELINE."

TOTALS	5.31	m ²	m ²	EA	m ²		m	m	m	m	m	m	EA	kg	kg	kg	kg	kg	kg	kg	EA	EA	kg
														70.4									
														70.4									

PROJECT: BENNINGTON	PROJECT NO.: NH 2202(I)S
DESIGN FILE NAME: pave/99dl56/pdl56.dgn	PLOT DATE: 21-NOV-2005 10:
IPARM FILE NAME: pdl56ssl.l	SURVEY DATE: N/A
SURVEYED BY: N/A	DRAWN BY: C.A.K.
SQUAD LEADER: T.P.K.	SHEET: 58 OF 108

KILOMETER MARKER, STATION, OR SIGN NUMBER	SIGN LEGEND	SIGN DIMENSIONS			NEW & SALVAGED SIGNS				EXIST POST RE TAIN SAL VAGE	NO. OF POSTS	NEW SIGN POSTS											REQUIRE D SIGN E	REMARKS	SIGN DETAIL								
		EA	WIDTH (mm)	HEIGHT (mm)	"A"	"B"	SALV SIGN	SALV TIS			FLANGED CHANNEL		SQUARE STEEL (mm)			TUBULAR ALUMINUM Ø (mm)			TUBULAR STEEL Ø (mm)					W-SHAPE STEEL		DETAIL ON SHEET NUMBER	STD. SHEET NUMBER					
											1.7	3.0	4.5	44	50	63	75	100	100 MOD	FOUND-ACTION	75			89	100			125	FTG. SIZE		WEIGHT	POST SIZE
														kg/m			kg/m				kg/m			600 mm	750 mm							
BENNINGTON VT. ROUTE 9; 7+508.0, LT		1	600	750	0.45					1						6.1 8.8											USE 70 mm DIAMETER TUBULAR ALUMINUM SIGN POST PAINTED BLACK. PAYMENT UNDER ITEM 675.32 TUBULAR ALUMINUM SIGN POST (MOD.).		E-142M			
7+520.0, RT		1	600	750	0.45					1		4.27 X																E-142M				
7+560.0, RT		1	600	300	0.18					1		4.27 X																E-136BM				
		1	600	600	0.36																							E-136BM				
7+705.0, RT										1		4.27 X														SALVAGED SIGN TO BE MOUNTED ON NEW POST.	-	-				
7+705.0, LT										1		4.27 X														SALVAGED SIGN TO BE MOUNTED ON NEW POST.	-	-				
7+723.0, RT		1	600	750	0.45					1		4.27 X																E-146M				
7+728.0, LT		1	600	750	0.45					1		4.27 X																E-146M				
		1	150	200	0.03																							E-138M				
7+745.0, RT										1		4.27 X														SALVAGED SIGN TO BE MOUNTED ON NEW POST.	-	-				

OPTION ITEMS

FINAL POST LENGTHS ARE TO BE DETERMINED IN THE FIELD. POST SIZES ARE COMPUTED BASED ON INFORMATION FURNISHED ON THE STANDARD SHEETS AND THE TRAFFIC & SAFETY DIVISION'S "SIGN POST DESIGN GUIDELINE."


TOTALS

EA	kg	kg	kg	kg	kg	kg	EA	EA	kg
3	8.8	8.8	8.8	8.8	8.8	8.8	EA	EA	kg
3	32.2	32.2	32.2	32.2	32.2	32.2	EA	EA	kg

PROJECT: BENNINGTON	PROJECT NO.: NH 2202(1)S
DESIGN FILE NAME: pave/99d156/pd156.dgn	PLOT DATE: 21-NOV-2005 10:
IPARM FILE NAME: pbi56ssl2.1	SURVEY DATE: N/A
SURVEYED BY: N/A	DRAWN BY: C.A.K.
SQUAD LEADER: T.P.K.	SHEET: 59 OF 108

KILOMETER MARKER, STATION, OR SIGN NUMBER	SIGN LEGEND	SIGN DIMENSIONS		NEW & SALVAGED SIGNS				EXIST POST RETAIN SALVAGE	NO. OF POSTS	NEW SIGN POSTS														REMARKS	SIGN DETAIL										
		EA	WIDTH (mm)	HEIGHT (mm)	"A"	"B"	SALV SIGN			SALV TIS	FLANGED CHANNEL				SQUARE STEEL (mm)			TUBULAR ALUMINUM Ø (mm)			TUBULAR STEEL Ø (mm)				W-SHAPE STEEL				DETAIL ON SHEET NUMBER	STD. SHEET NUMBER					
											kg/m		44	50	63	75	100	100 MOD	FOUND-ATION	75	89	100	125		FTG. SIZE		WEIGHT	POST SIZE							
											1.7	3.0	4.5	3.4	3.9	5.0	kg/m	kg/m		kg/m	kg/m	kg/m	kg/m		kg/m	600 mm					750 mm				
BENNINGTON VT. ROUTE 9: 7+745.0, LT							1		1			4.3 X			X												SALVAGED SIGN TO BE MOUNTED ON NEW POST.	-	-						
7+819.0, LT	MAIN ST PLEASANT ST						1 1		1			4.3 X			X												SALVAGED SIGNS TO BE MOUTED ON NEW POST. TOP MOUNTING BRACKET REQUIRED TO INSTALL SALVAGED SIGNS ON FLANGED CHANNEL POST.	-	-						
		1 1	750 150	750 200	0.56 0.03																						BACK - TO - BACK		E-143M E-138M						
7+825.0, RT	MAIN ST UNION ST	1	600	150	0.09				1			4.3 X			X												SALVAGED SIGN TO BE MOUTED ON NEW POST. TOP MOUNTING BRACKET REQUIRED TO INSTALL SALVAGED SIGN ON FLANGED CHANNEL POST. SLEEVE REQUIRED TO INSTALL NEW POST.	-	-						
		1 1	750 150	750 200	0.56 0.03																						BACK - TO - BACK		E-143M E-138M						
7+885.0, LT	MAIN ST SAFFORD ST	1 1	600 600	150 150	0.09 0.09				1		X			X	SIGN PLACED ON TRAFFIC SIGNAL POLE																				E-123M E-123M
7+978.0, RT		1	600	900	0.54				1			4.9 X			X														E-140M						
		1	600	750	0.45																								E-140M						
8+001.0, RT	MAIN ST MORGAN ST	1	600	150	0.09				1			4.3 X			X													SALVAGED SIGN TO BE MOUTED ON NEW POST. TOP MOUNTING BRACKET REQUIRED TO INSTALL SALVAGED SIGN ON FLANGED CHANNEL POST.	-	-					
		1 1	750 150	750 200	0.56 0.03																						BACK - TO - BACK		E-143M E-138M						
8+242.0, LT		1	600	600	0.36				1			4.3 X			X														E-143M						
		1	600	300	0.18																								E-140M						
8+243.0, LT	MAIN ST BRADFORD ST						1 1		1			4.3 X			X													SALVAGED SIGN TO BE MOUTED ON NEW POST. TOP MOUNTING BRACKET REQUIRED TO INSTALL SALVAGED SIGNS ON FLANGED CHANNEL POST. SLEEVE REQUIRED TO INSTALL NEW POST.	-	-					
		1 1	750 150	750 200	0.56 0.03																						BACK - TO - BACK		E-143M E-138M						

OPTION ITEMS

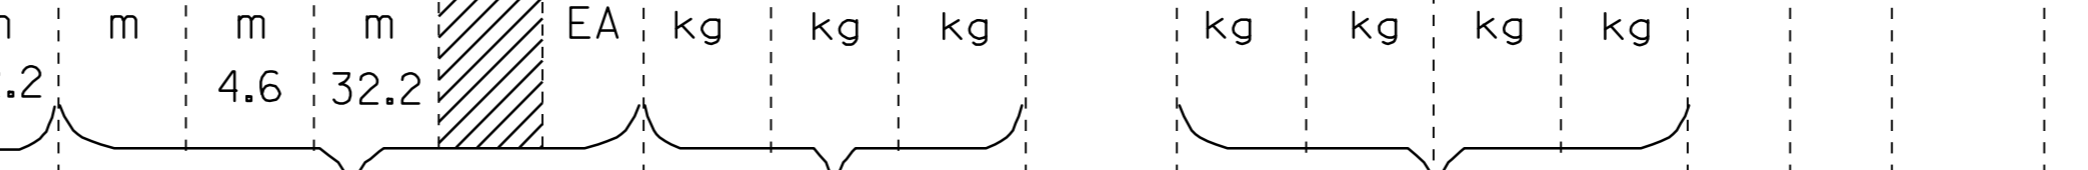

FINAL POST LENGTHS ARE TO BE DETERMINED IN THE FIELD. POST SIZES ARE COMPUTED BASED ON INFORMATION FURNISHED ON THE STANDARD SHEETS AND THE TRAFFIC & SAFETY DIVISION'S "SIGN POST DESIGN GUIDELINE."

TOTALS

m ²	m ²	EA	m ²						m	m	EA	kg	kg	kg	kg	kg	kg	kg	EA	EA	kg
4.25		7							36.8	36.8											

PROJECT: BENNINGTON	PROJECT NO.: NH 2202(I)S
DESIGN FILE NAME: pave/99dl56/pdl56.dgn	PLOT DATE: 21-NOV-2005 10:
IPARM FILE NAME: pdl56ssi3.1	SURVEY DATE: N/A
SURVEYED BY: N/A	DRAWN BY: C.A.K.
SQUAD LEADER: T.P.K.	SHEET: 60 OF 108

KILOMETER MARKER, STATION, OR SIGN NUMBER	SIGN LEGEND	SIGN DIMENSIONS			NEW & SALVAGED SIGNS				EXIST POST RETAIN	NO. OF POSTS	NEW SIGN POSTS																REMARKS	SIGN DETAIL					
		EA	WIDTH (mm)	HEIGHT (mm)	"A"	"B"	SALV SIGN	SALV TIS			FLANGED CHANNEL			SQUARE STEEL (mm)			TUBULAR ALUMINUM Ø (mm)			TUBULAR STEEL Ø (mm)				W-SHAPE STEEL		FRAMING SIGN		REQUIRED	DETAIL ON SHEET NUMBER	STD. SHEET NUMBER			
											1.7	3.0	4.5	44	50	63	75	100	100 MOD	FOUND-ATION	75	89	100	125	FTG. SIZE						WEIGHT	POST SIZE	
														kg/m			kg/m				kg/m			600 mm	750 mm								
BENNINGTON VT. ROUTE 9; 8+320.0, LT		1	600	600	0.36					1			4.5 X			X																E-143M	
8+350.0, RT		1	150	200	0.03					1	X			X																	E-138M		
8+385.0, LT		1	600	600	0.36					1			4.3 X			X															E-143M		
8+450.0, LT		1	600	600	0.36					1			4.3 X			X															E-143M		
		1	600	300	0.18																										E-140M		
8+461.0, LT		1	600	150	0.09					1			3.7 X			X													SALVAGED SIGN TO BE MOUNTED ON NEW POST. TOP MOUNTING BRACKET REQUIRED TO INSTALL SALVAGED SIGN ON FLANGED CHANNEL POST.	-	E-123M		
		1	150	200	0.03																										E-138M		
8+475.0, RT		1	600	150	0.09					1			3.7 X			X													SALVAGED SIGN TO BE MOUNTED ON NEW POST. TOP MOUNTING BRACKET REQUIRED TO INSTALL SALVAGED SIGN ON FLANGED CHANNEL POST.	-	E-123M		

OPTION ITEMS

FINAL POST LENGTHS ARE TO BE DETERMINED IN THE FIELD. POST SIZES ARE COMPUTED BASED ON INFORMATION FURNISHED ON THE STANDARD SHEETS AND THE TRAFFIC & SAFETY DIVISION'S "SIGN POST DESIGN GUIDELINE."

TOTALS	1,50	m ²	m ²	EA	2	m ²		m	27.6	m	27.6	EA	kg	kg	kg	kg	EA	kg	EA	EA	kg
---------------	------	----------------	----------------	----	---	----------------	--	---	------	---	------	----	----	----	----	----	----	----	----	----	----

PROJECT: BENNINGTON

DESIGN FILE NAME: pave/99dl56/pdl56.dgn

IPARM FILE NAME: pdl56ssl4.1

SURVEYED BY: N/A

SQUAD LEADER: T.P.K.

PROJECT NO.: NH 2202(I)S

PLOT DATE: 21-NOV-2005 10:50

SURVEY DATE: N/A

DRAWN BY: C.A.K.

SHEET: 61 OF 108

KILOMETER MARKER, STATION, OR SIGN NUMBER	SIGN LEGEND	SIGN DIMENSIONS			NEW & SALVAGED SIGNS				EXIST POST RETAIN SALVAGE	NO. OF POSTS	NEW SIGN POSTS														REMARKS	SIGN DETAIL					
		EA	WIDTH (mm)	HEIGHT (mm)	"A"	"B"	SALV SIGN	SALV TIS			FLANGED CHANNEL				SQUARE STEEL (mm)			TUBULAR ALUMINUM Ø (mm)			TUBULAR STEEL Ø (mm)					W-SHAPE STEEL			DETAIL ON SHEET NUMBER	STD. SHEET NUMBER	
											1.7	3.0	4.5	3.4	3.9	5.0	75	100	100 MOD	FOUND-ATION	75	89	100	125		FTG. SIZE		WEIGHT			POST SIZE
																										kg/m	kg/m				
BENNINGTON VT. ROUTE 9; 8+631.0, RT	MAIN ST ROCKWOOD ST	1	600	150	0.09		1			1			4.3 X			X												SALVAGED SIGN TO BE MOUNTED ON NEW POST. TOP MOUNTING REQUIRED TO INSTALL SALVAGED SIGN ON FLANGED CHANNEL POST.	-	E-123M	
		1	750	750	0.56																						BACK - TO - BACK		E-143M E-138M		
8+825.0, RT		1	750	750	0.56					1			4.3 X			X														E-152M	
8+916.0, RT		1	600	750	0.45					1			4.3 X			X														E-142M	
8+920.0, LT		1	600	750	0.45					1			4.3 X			X														E-146M	
8+926.0, RT	MAIN ST BURGESS RD	1	600	150	0.09		1			1			4.3 X			X											SALVAGED SIGN TO BE MOUNTED ON NEW POST. TOP MOUNTING BRACKET REQUIRED TO INSTALL SALVAGED SIGN ON FLANGED CHANNEL POST.	-	E-123M		
		1	750	750	0.56																						BACK - TO - BACK		E-143M E-138M		
8+926.5, RT		1	600	750	0.45					1			4.3 X			X														E-146M	
8+980.0, LT	MAIN ST GAGE ST						1			1			4.3 X			X											SALVAGED SIGN TO BE MOUNTED ON NEW POST. TOP MOUNTING BRACKET REQUIRED TO INSTALL SALVAGED SIGNS ON FLANGED CHANNEL POST.	-	-		
		1	750	750	0.56																						BACK - TO - BACK		E-143M E-138M		
8+996.0, LT		1	600	750	0.45					1			4.9 X			X														E-142M	
		1	600	750	0.45																									E-141M	

FINAL POST LENGTHS ARE TO BE DETERMINED IN THE FIELD. POST SIZES ARE COMPUTED BASED ON INFORMATION FURNISHED ON THE STANDARD SHEETS AND THE TRAFFIC & SAFETY DIVISION'S "SIGN POST DESIGN GUIDELINE."											m	m	m	m	m	m	EA	kg	kg	kg	kg	kg	kg	kg	EA	EA	kg
											36.8			36.8													
TOTALS											m ²	m ²	EA	m ²				kg	EA	kg	EA	EA	kg				
											4.76		4				36.8		36.8								

PROJECT: BENNINGTON
 DESIGN FILE NAME: pave/99dl56/pdl56.dgn
 IPARM FILE NAME: pdl56ssi5.1
 SURVEYED BY: N/A
 SQUAD LEADER: T.P.K.

PROJECT NO.: NH 2202(I)S
 PLOT DATE: 21-NOV-2005 10:54
 SURVEY DATE: N/A
 DRAWN BY: C.A.K.
 SHEET: 62 OF 108

KILOMETER MARKER, STATION, OR SIGN NUMBER	SIGN LEGEND	SIGN DIMENSIONS		NEW & SALVAGED SIGNS				EXIST POST RETAIN	NO. OF POSTS	NEW SIGN POSTS												REMARKS	SIGN DETAIL										
		EA	WIDTH (mm)	HEIGHT (mm)	"A"	"B"	SALV SIGN			SALV TIS	FLANGED CHANNEL			SQUARE STEEL (mm)			TUBULAR ALUMINUM Ø (mm)			TUBULAR STEEL Ø (mm)				W-SHAPE STEEL		DETAIL ON SHEET NUMBER	STD. SHEET NUMBER						
											1.7	3.0	4.5	44	50	63	75	100	100 MOD	FOUND-ATION	75		89	100	125			FTG. SIZE		WEIGHT	POST SIZE		
																												kg/m	kg/m			kg/m	600 mm
BENNINGTON: VT. ROUTE 9 9+008.0, RT		1	600	300	0.18				1			4.27 X			X																	E-136BM	
		1	600	600	0.36																										E-136BM		
9+020.0, LT		1	750	750	0.56				1			4.27 X			X																E-152M		
9+134, RT												4.27																					
9+161, LT												4.27																					
9+335.0, LT		1	150	200	0.03				1	X			X																			E-138M	
9+452.0, LT		1	600	600	0.36				1			4.27 X			X																	E-132M	
9+488.0, RT		1	750	750	0.56				1			4.27 X			X																	69	-
9+496.0, RT	MAIN ST HARVARD ST	1	600	150	0.09				1			4.27 X			X																	SALVAGED SIGN TO BE MOUNTED ON NEW POST. TOP MOUNTING BRACKET REQUIRED TO INSTALL SALVAGED SIGNS ON FLANGED CHANNEL POST.	E-123M
		1	750	750	0.56																											E-143M	
		1	150	200	0.03																											E-138M	

m	m	m	m	m	m	EA	kg	kg	kg	kg	kg	kg	kg	kg	kg	EA	EA	kg
4.6		23.0	4.6		23.0													
TOTALS		m ²	m ²	EA	m ²		m	m	kg	EA	kg	EA	EA	kg				
		2.73		1			27.6	27.6										

PROJECT: BENNINGTON PROJECT NO.: NH 2202(I)S

DESIGN FILE NAME: pave/99dl56/pdl56.dgn PLOT DATE: 21-NOV-2005 10:50

IPARM FILE NAME: pdl56ssl6.l SURVEY DATE: N/A

SURVEYED BY: N/A DRAWN BY: C.A.K.

SQUAD LEADER: T.P.K. SHEET: 63 OF 108

FINAL POST LENGTHS ARE TO BE DETERMINED IN THE FIELD. POST SIZES ARE COMPUTED BASED ON INFORMATION FURNISHED ON THE STANDARD SHEETS AND THE TRAFFIC & SAFETY DIVISION'S "SIGN POST DESIGN GUIDELINE."

KILOMETER MARKER, STATION, OR SIGN NUMBER	SIGN LEGEND	SIGN DIMENSIONS		NEW & SALVAGED SIGNS								NEW SIGN POSTS														REMARKS	SIGN DETAIL							
		EA	WIDTH (mm)	HEIGHT (mm)	"A"	"B"	SALV SIGN	SALV TIS	RETAIN	SALVAGE	NO. OF POSTS	FLANGED CHANNEL			SQUARE STEEL (mm)			TUBULAR ALUMINUM Ø (mm)			TUBULAR STEEL Ø (mm)				W-SHAPE STEEL				FRAME	REQUIRED	DETAIL ON SHEET NUMBER	STD. SHEET NUMBER		
												1.7	3.0	4.5	44	50	63	75	100	100 MOD	FOUND-ATION	75	89	100	125		FTG. SIZE						WEIGHT	POST SIZE
															kg/m			kg/m				kg/m			600 mm		750 mm							
OPTION ITEMS																																		
BENNINGTON U.S. ROUTE 7; 4+668.7, RT		1	750	750	0.56						1																		USE 70 mm DIAMETER TUBULAR ALUMINUM SIGN POST PAINTED BLACK. PAYMENT UNDER ITEM 675.32 TUBULAR ALUMINUM SIGN POST (MOD.). BACK - TO - BACK		E-143M E-138M			
4+672.0, LT		1	600	750	0.45						1																	USE 70 mm DIAMETER TUBULAR ALUMINUM SIGN POST PAINTED BLACK. PAYMENT UNDER ITEM 675.32 TUBULAR ALUMINUM SIGN POST (MOD.).		E-146M				
4+675.0, RT		1	600	750	0.45						1																	USE 70 mm DIAMETER TUBULAR ALUMINUM SIGN POST PAINTED BLACK. PAYMENT UNDER ITEM 675.32 TUBULAR ALUMINUM SIGN POST (MOD.).		E-146M				
		1	600	600	0.36																									E-143M				
4+692.0, RT		1	450	225	0.10						1																X	USE 70 mm DIAMETER TUBULAR ALUMINUM SIGN POST PAINTED BLACK. PAYMENT UNDER ITEM 675.32 TUBULAR ALUMINUM SIGN POST (MOD.). REDUCE MINIMUM STANDARD SIZE SIGN DIMENSIONS BY 25%.		E-136AM				
		1	450	450	0.20																									E-136AM				
		1	395	280	0.11																									E-136AM				
		1	450	225	0.10																									E-136BM E-136BM				
		1	450	450	0.20																									E-136BM E-136BM				
		1	395	280	0.11																									E-136BM E-136BM				
4+679.7, LT		1	300	450	0.14						1																	USE 70 mm DIAMETER TUBULAR ALUMINUM SIGN POST PAINTED BLACK. PAYMENT UNDER ITEM 675.32 TUBULAR ALUMINUM SIGN POST (MOD.).	69	-				
																														-	-			

FINAL POST LENGTHS ARE TO BE DETERMINED IN THE FIELD. POST SIZES ARE COMPUTED BASED ON INFORMATION FURNISHED ON THE STANDARD SHEETS AND THE TRAFFIC & SAFETY DIVISION'S "SIGN POST DESIGN GUIDELINE."

TOTALS	3.22	m ²	m ²	EA	m ²		m	m	m	m	m	m	EA	kg	kg	kg	kg	kg	kg	kg	EA	EA	kg							
														47.0																
														47.0																


PROJECT: BENNINGTON	PROJECT NO.: NH 2202(I)S
DESIGN FILE NAME: pave/99d156/pdl56.dgn	PLOT DATE: 21-NOV-2005 10:
IPARM FILE NAME: pd156ssl7.1	SURVEY DATE: N/A
SURVEYED BY: N/A	DRAWN BY: C.A.K.
SQUAD LEADER: T.P.K.	SHEET: 64 OF 108

KILOMETER MARKER, STATION, OR SIGN NUMBER	SIGN LEGEND	SIGN DIMENSIONS		NEW & SALVAGED SIGNS								NEW SIGN POSTS												REMARKS	SIGN DETAIL									
		EA	WIDTH (mm)	HEIGHT (mm)	"A"	"B"	SALV SIGN	SALV TIS	RETAIN	SALVAGE	NO. OF POSTS	FLANGED CHANNEL			SQUARE STEEL (mm)			TUBULAR ALUMINUM Ø (mm)			TUBULAR STEEL Ø (mm)				W-SHAPE STEEL		FRAMING SIGN	REQUIRED	DETAIL ON SHEET NUMBER	STD. SHEET NUMBER				
												1.7	3.0	4.5	44	50	63	75	100	100 MOD	FOUND-ATION	75	89		100	125					600 mm	750 mm	WEIGHT	POST SIZE
															kg/m			kg/m				kg/m			kg/m									
OPTION ITEMS																																		
BENNINGTON U.S. ROUTE 7: 4+730.0, RT		1	900	750	0.68						1																		USE 70 mm DIAMETER TUBULAR ALUMINUM SIGN POST PAINTED BLACK. PAYMENT UNDER ITEM 675.32 TUBULAR ALUMINUM SIGN POST (MOD.).		E-145AM			
		1	600	600	0.36																									E-143M				
4+747.7, RT		1	600	750	0.45																									USE 70 mm DIAMETER TUBULAR ALUMINUM SIGN POST PAINTED BLACK. PAYMENT UNDER ITEM 675.32 TUBULAR ALUMINUM SIGN POST (MOD.).		E-140M		
4+801.7, LT		1	600	750	0.45																									USE 70 mm DIAMETER TUBULAR ALUMINUM SIGN POST PAINTED BLACK. PAYMENT UNDER ITEM 675.32 TUBULAR ALUMINUM SIGN POST (MOD.).		E-140M		
4+833.0, LT		1	900	750	0.68																									USE 70 mm DIAMETER TUBULAR ALUMINUM SIGN POST PAINTED BLACK. PAYMENT UNDER ITEM 675.32 TUBULAR ALUMINUM SIGN POST (MOD.).		E-145AM		
4+853.7, RT		1	900	300	0.27																										USE 70 mm DIAMETER TUBULAR ALUMINUM SIGN POST PAINTED BLACK. PAYMENT UNDER ITEM 675.32 TUBULAR ALUMINUM SIGN POST (MOD.). BACK - TO - BACK		E-142M	
		1	900	300	0.27																											E-142M		
		1	600	600	0.36																											E-143M		
4+864.7, RT		1	900	300	0.27																										USE 70mm DIAMETER TUBULAR ALUMINUM SIGN POST PAINTED BLACK. PAYMENT UNDER ITEM 675.32 TUBULAR ALUMINUM SIGN POST (MOD.). BACK - TO - BACK		E-142M	
		1	900	300	0.27																											E-142M		
		1	150	200	0.03																											E-138M		
4+865.7, RT		1	600	600	0.36																										USE 70 mm DIAMETER TUBULAR ALUMINUM SIGN POST PAINTED BLACK. PAYMENT UNDER ITEM 675.32 TUBULAR ALUMINUM SIGN POST (MOD.).		E-143M	

FINAL POST LENGTHS ARE TO BE DETERMINED IN THE FIELD. POST SIZES ARE COMPUTED BASED ON INFORMATION FURNISHED ON THE STANDARD SHEETS AND THE TRAFFIC & SAFETY DIVISION'S "SIGN POST DESIGN GUIDELINE."


TOTALS	m ²	m ²	EA	m ²		m	m	m	m	m	m	EA	kg	kg	kg	kg	kg	kg	kg	EA	EA	kg
	4.45												61.6									61.6

PROJECT: BENNINGTON	PROJECT NO.: NH 2202(I)S
DESIGN FILE NAME: pave/99d156/pdbl56.dgn	PLOT DATE: 21-NOV-2005 10:
IPARM FILE NAME: pd156ssi8.1	SURVEY DATE: N/A
SURVEYED BY: N/A	SQUAD LEADER: T.P.K.
SHEET: 65 OF 108	

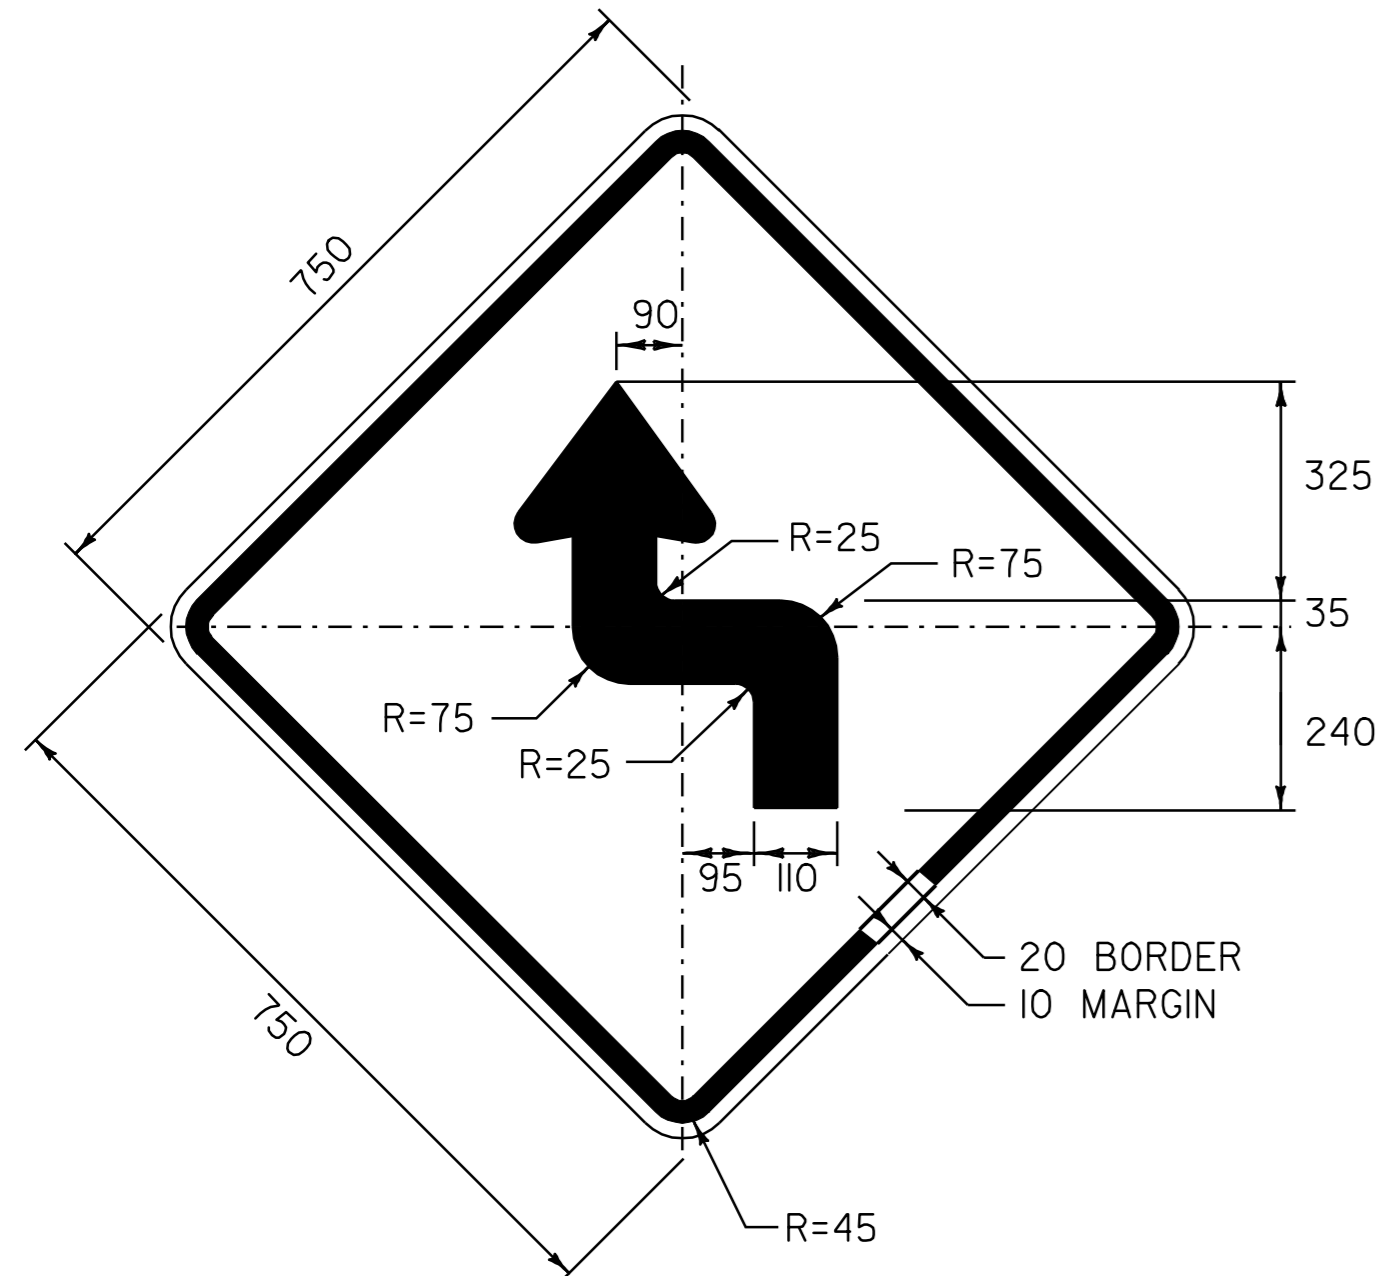

COLOR: BLACK BORDER & TEXT
YELLOW BACKGROUND (REFLECTIVE)

MATERIAL: PER VAOT STANDARD E-153M
SIGN - VT. ROUTE 9
STA. 5+329.0 RT
STA. 5+660.0 LT

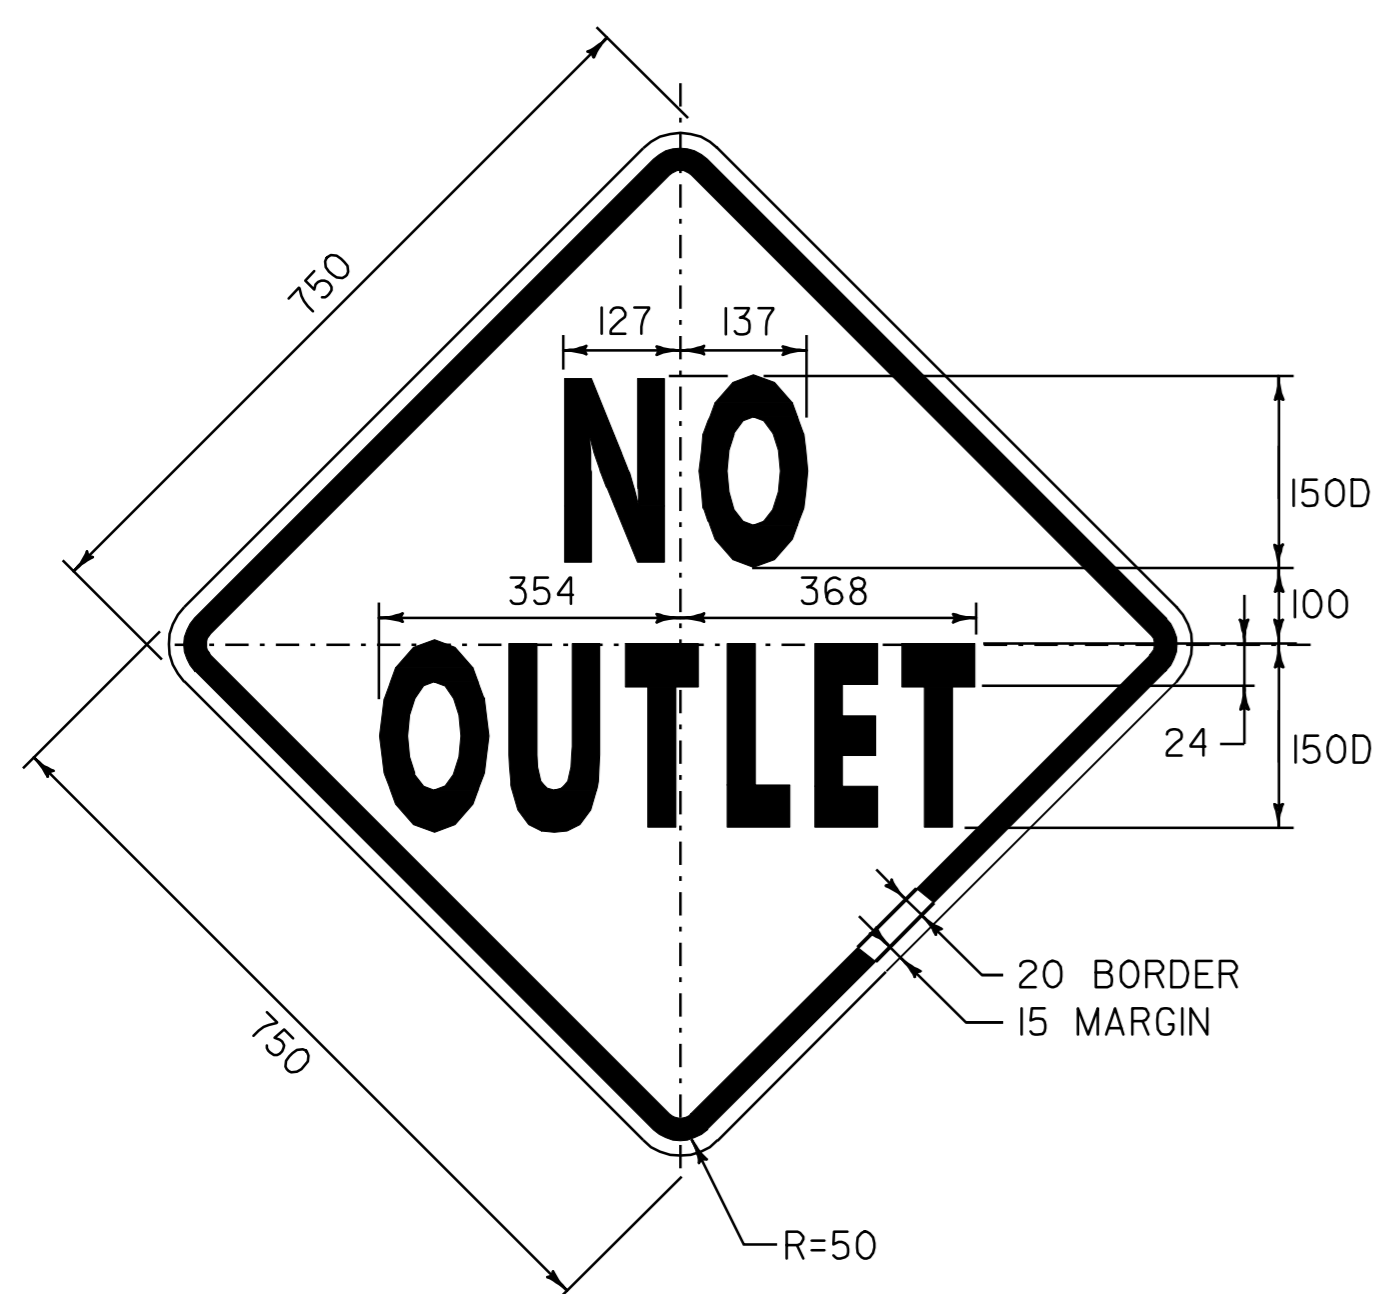

COLOR: BLACK BORDER & TEXT
YELLOW BACKGROUND (REFLECTIVE)

MATERIAL: PER VAOT STANDARD E-153M
SIGN - VT. ROUTE 9
STA. 5+172.0 RT
STA. 6+226.0 RT
STA. 6+322.0 RT
STA. 9+488.0 RT


NOTE:

TEXT LAYOUT DIMENSIONS ARE BASED ON THE "LETTER & NUMERAL WIDTHS & SPACE" TABLES FOUND IN THE "STANDARD HIGHWAY SIGNS" BOOKLET. MINOR VARIATIONS IN TEXT DIMENSIONS ARE ACCEPTABLE BASED ON INDIVIDUAL MANUFACTURER'S LETTER FABRICATION. SIGNIFICANT CHANGES THAT AFFECT SIGN APPEARANCE SHALL BE BROUGHT TO THE ATTENTION OF THE VAOT'S TRAFFIC AND SAFETY DIVISION BEFORE FABRICATION.



COLOR: GREEN BORDER & TEXT
WHITE BACKGROUND
WHITE SYMBOL ON BLUE BACKGROUND

MATERIAL: PER VAOT STANDARD E-143M
* 50% REDUCTION IN SPACING
SIGN - VT. ROUTE 9
STA. 7+040.1 RT
STA. 7+134.0 LT
STA. 7+188.0 RT
STA. 7+308.0 LT
STA. 7+409.0 RT
SIGN - U.S. ROUTE 7
STA. 4+679.7 LT

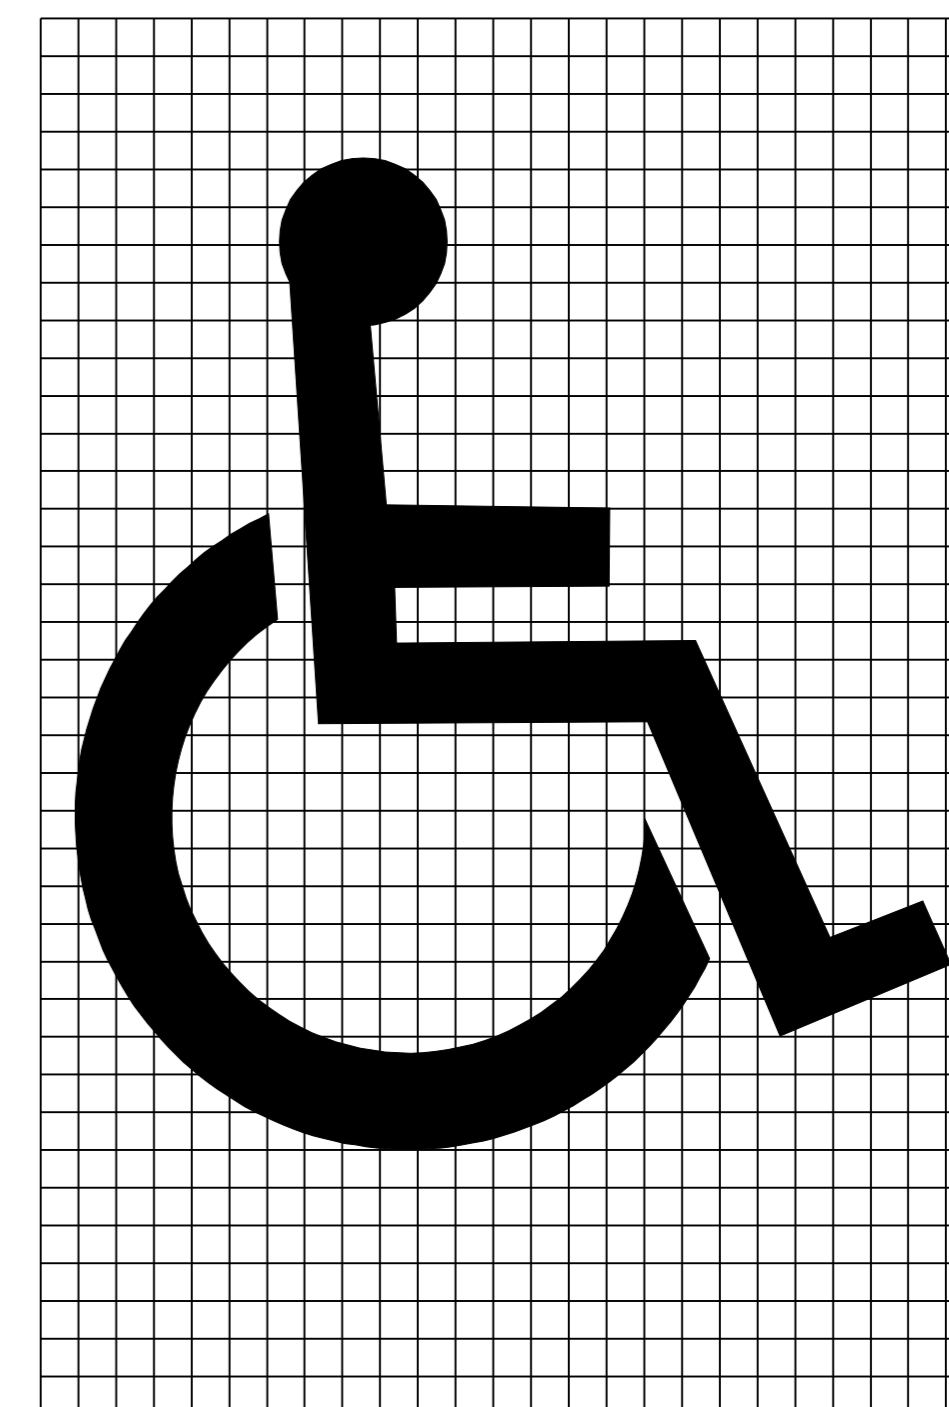


ALL DIMENSIONS IN MILLIMETERS EXCEPT WHERE OTHERWISE INDICATED.

**TRAFFIC SIGN
DETAIL
SHEET**

SURVEYED BY	N/A	DATE	N/A
DRAWN BY	J.A.R.	DATE	4/01
SQUAD LEADER	T.P.K.		
DESIGN FILE NO.	pave/99d156/pd156.dgn		
IPARM FILE	pd156sd.i	DATE PLOTTED	27 NOV-2005 10:47
PROJ. NAME	BENNINGTON		
PROJ. NO.	NH 2202(1)S		
SHEET	69 OF 108	SHEETS	

DATUM	
VERTICAL	N/A
HORIZONTAL	N/A

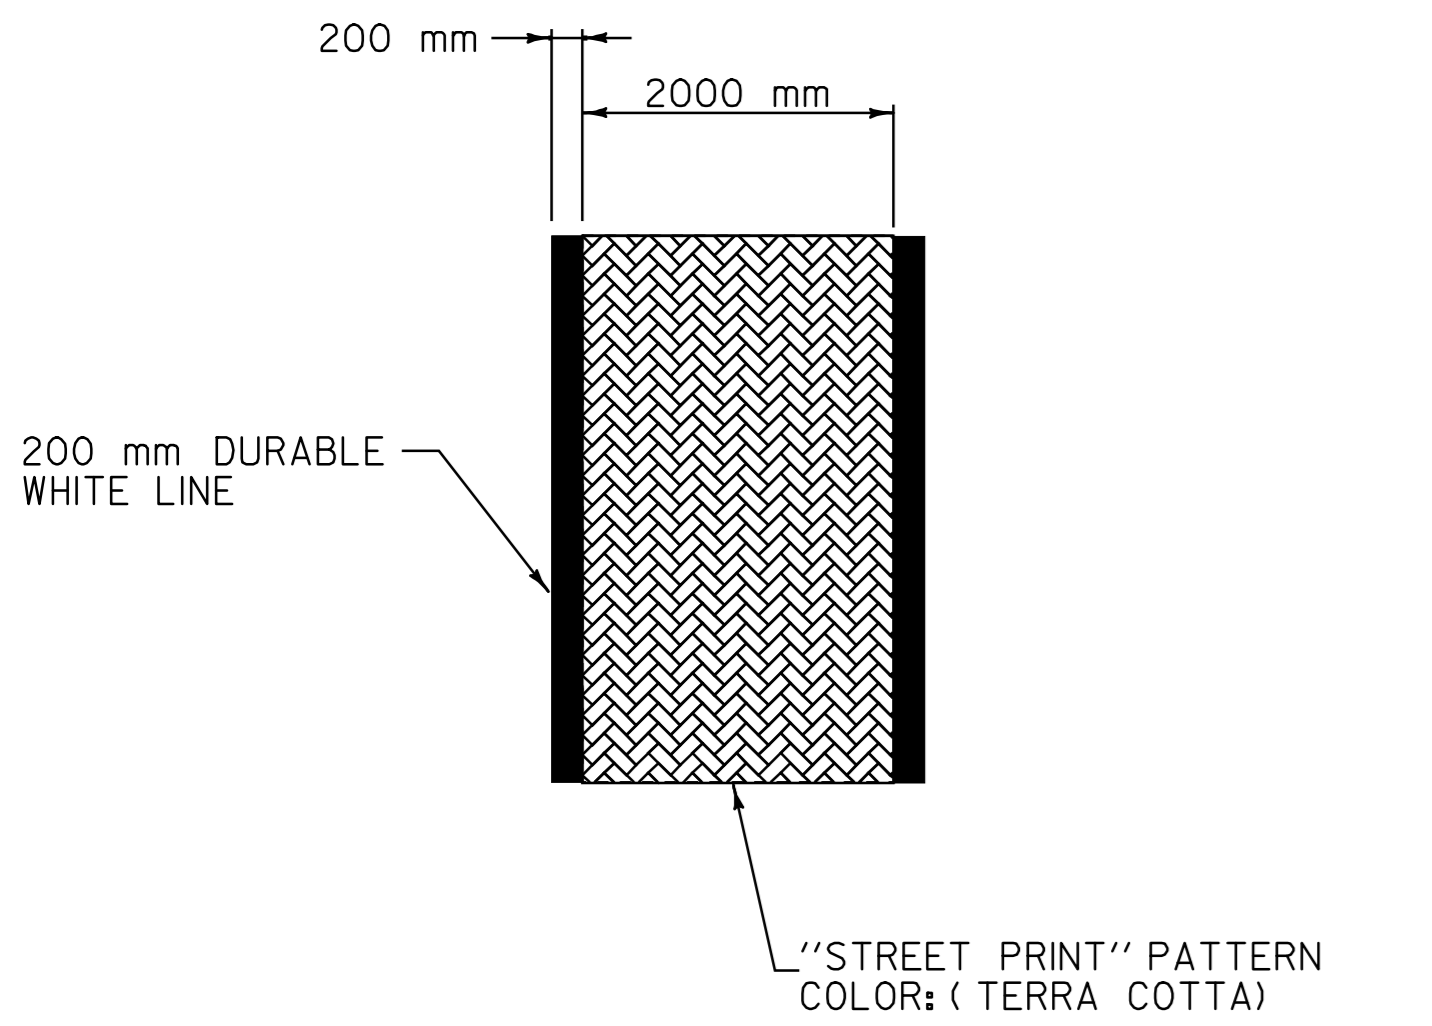


DETAIL OF DURABLE CROSSWALK MARKINGS WITH BRICK TEXTURING

NOT TO SCALE


NOTES

1. THE "STREET PRINT" PATTERN SHALL BE IMPRINTED AS SPECIFIED IN THE SPECIAL PROVISIONS.
2. THE PER METER COST OF INSTALLED CROSSWALK, INCLUDING THE 200 mm DURABLE WHITE LINES, SHALL BE PAID AS ITEM 646.51 DURABLE CROSSWALK MARKINGS WITH DIAGONAL LINES (MOD.).

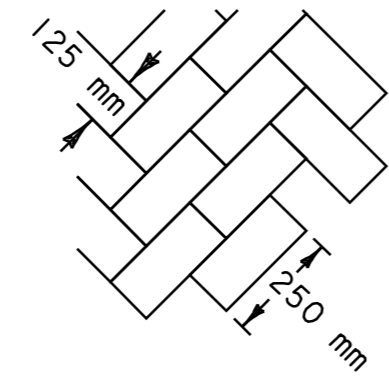


HERRINGBONE STREET PRINT

INTERSECTION OF U.S. 7 & VT. 9
 "STREET PRINT" PATTERN
 COLOR: NO COLOR
 TO BE PAID AS ITEM 618.20 (MOD.)

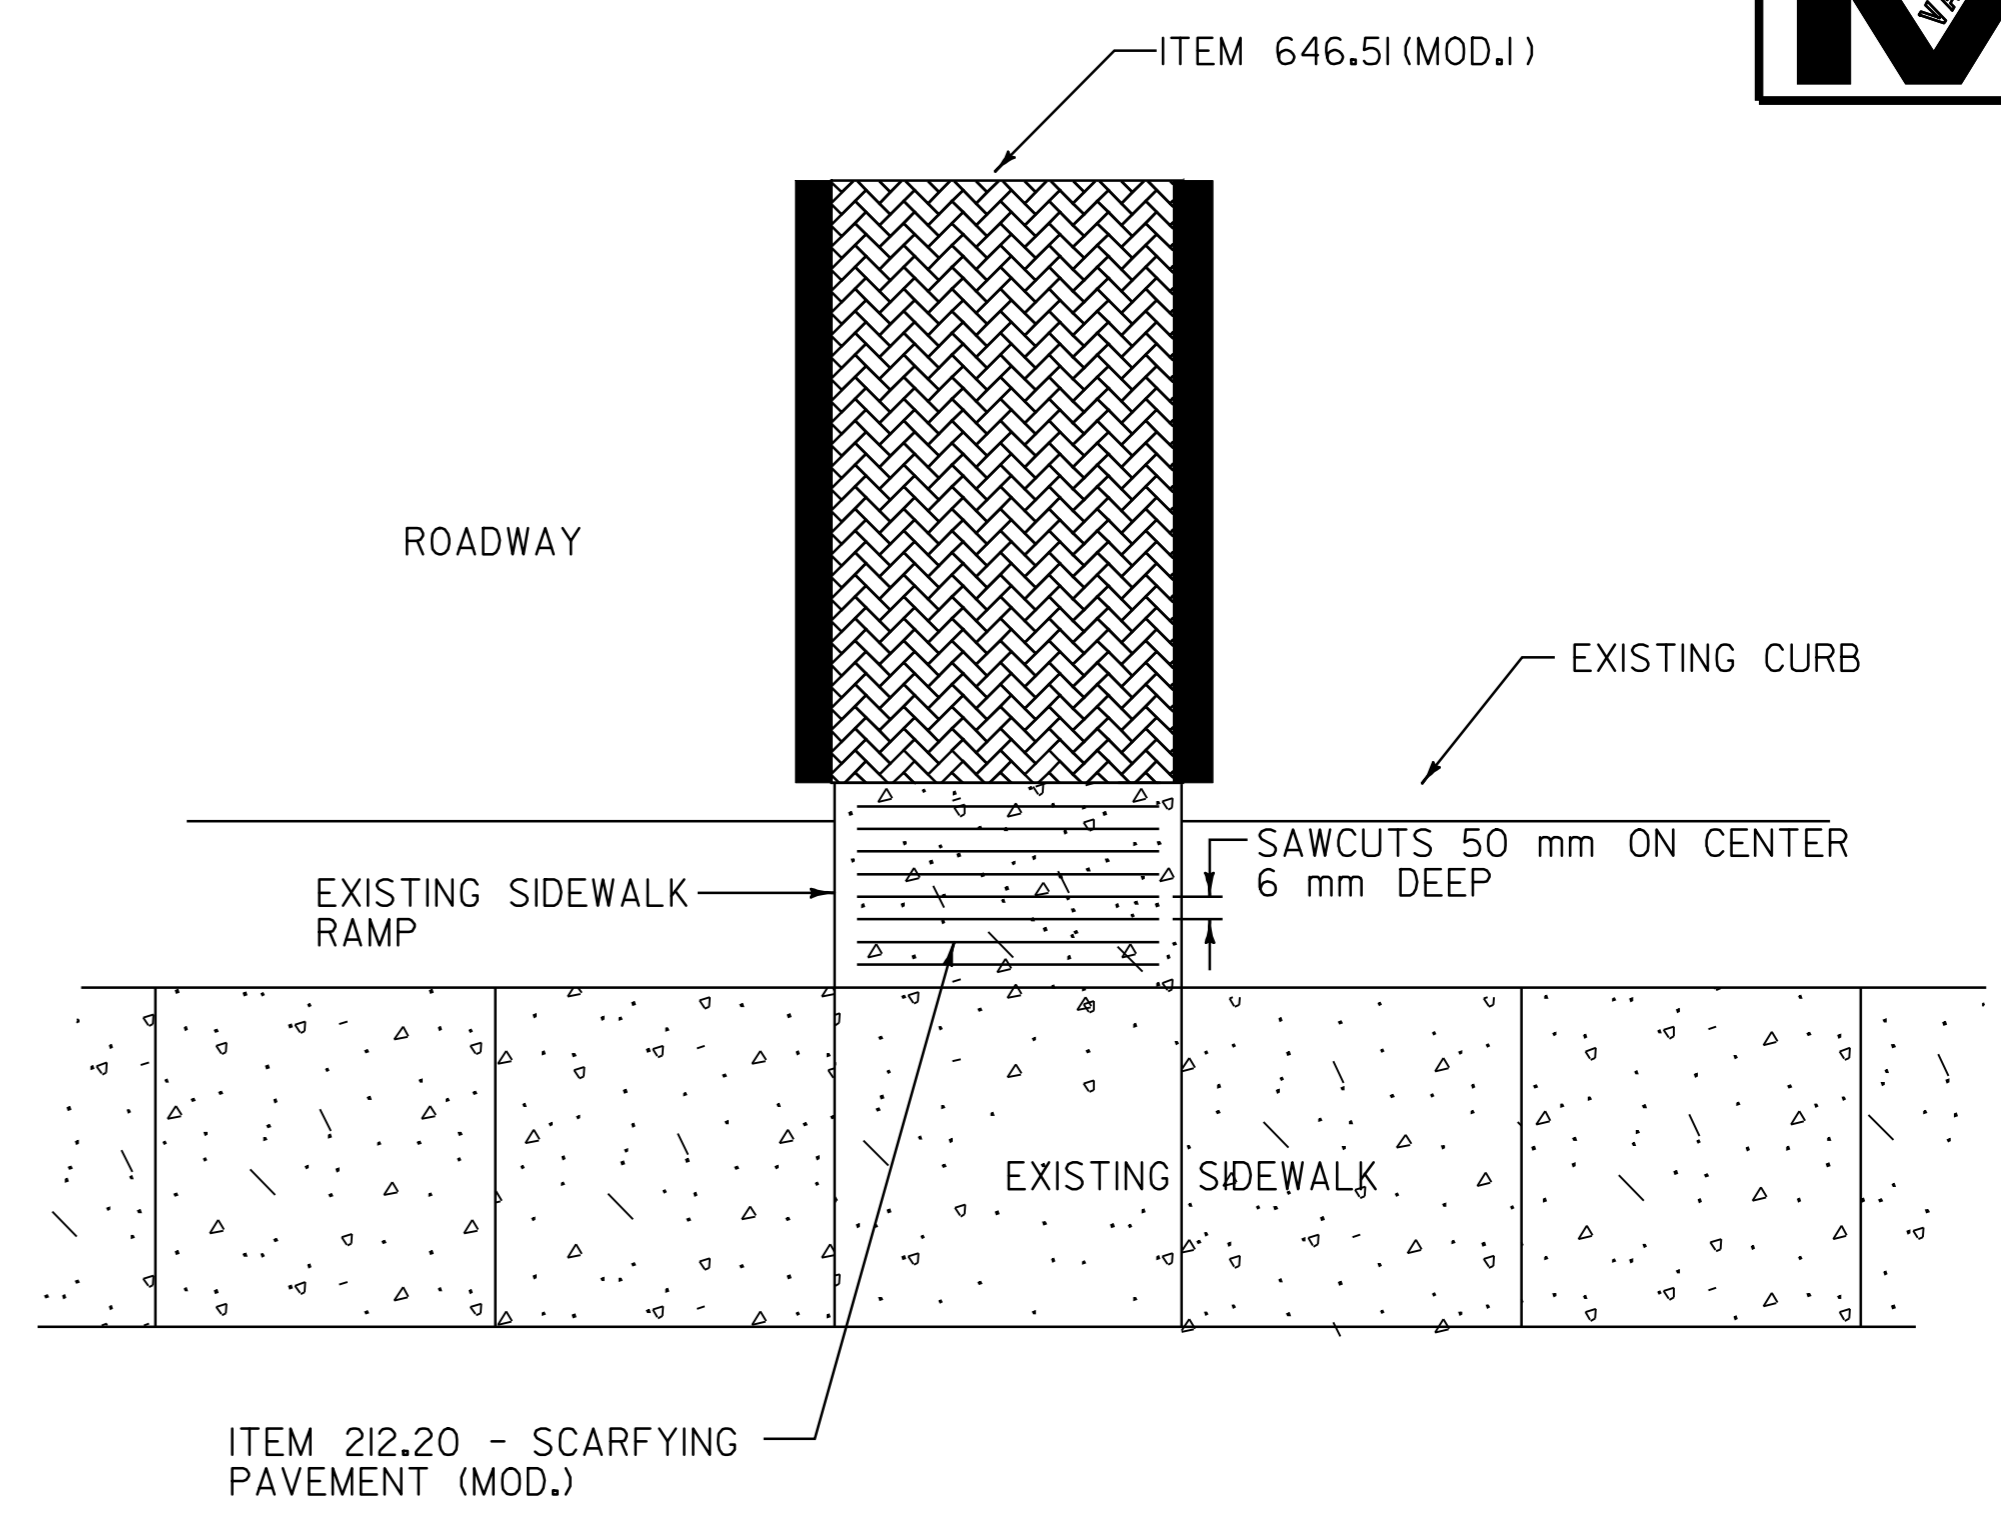

**PLAN VIEW
 SIDEWALK RAMP TEXTURING DETAIL**

NOT TO SCALE

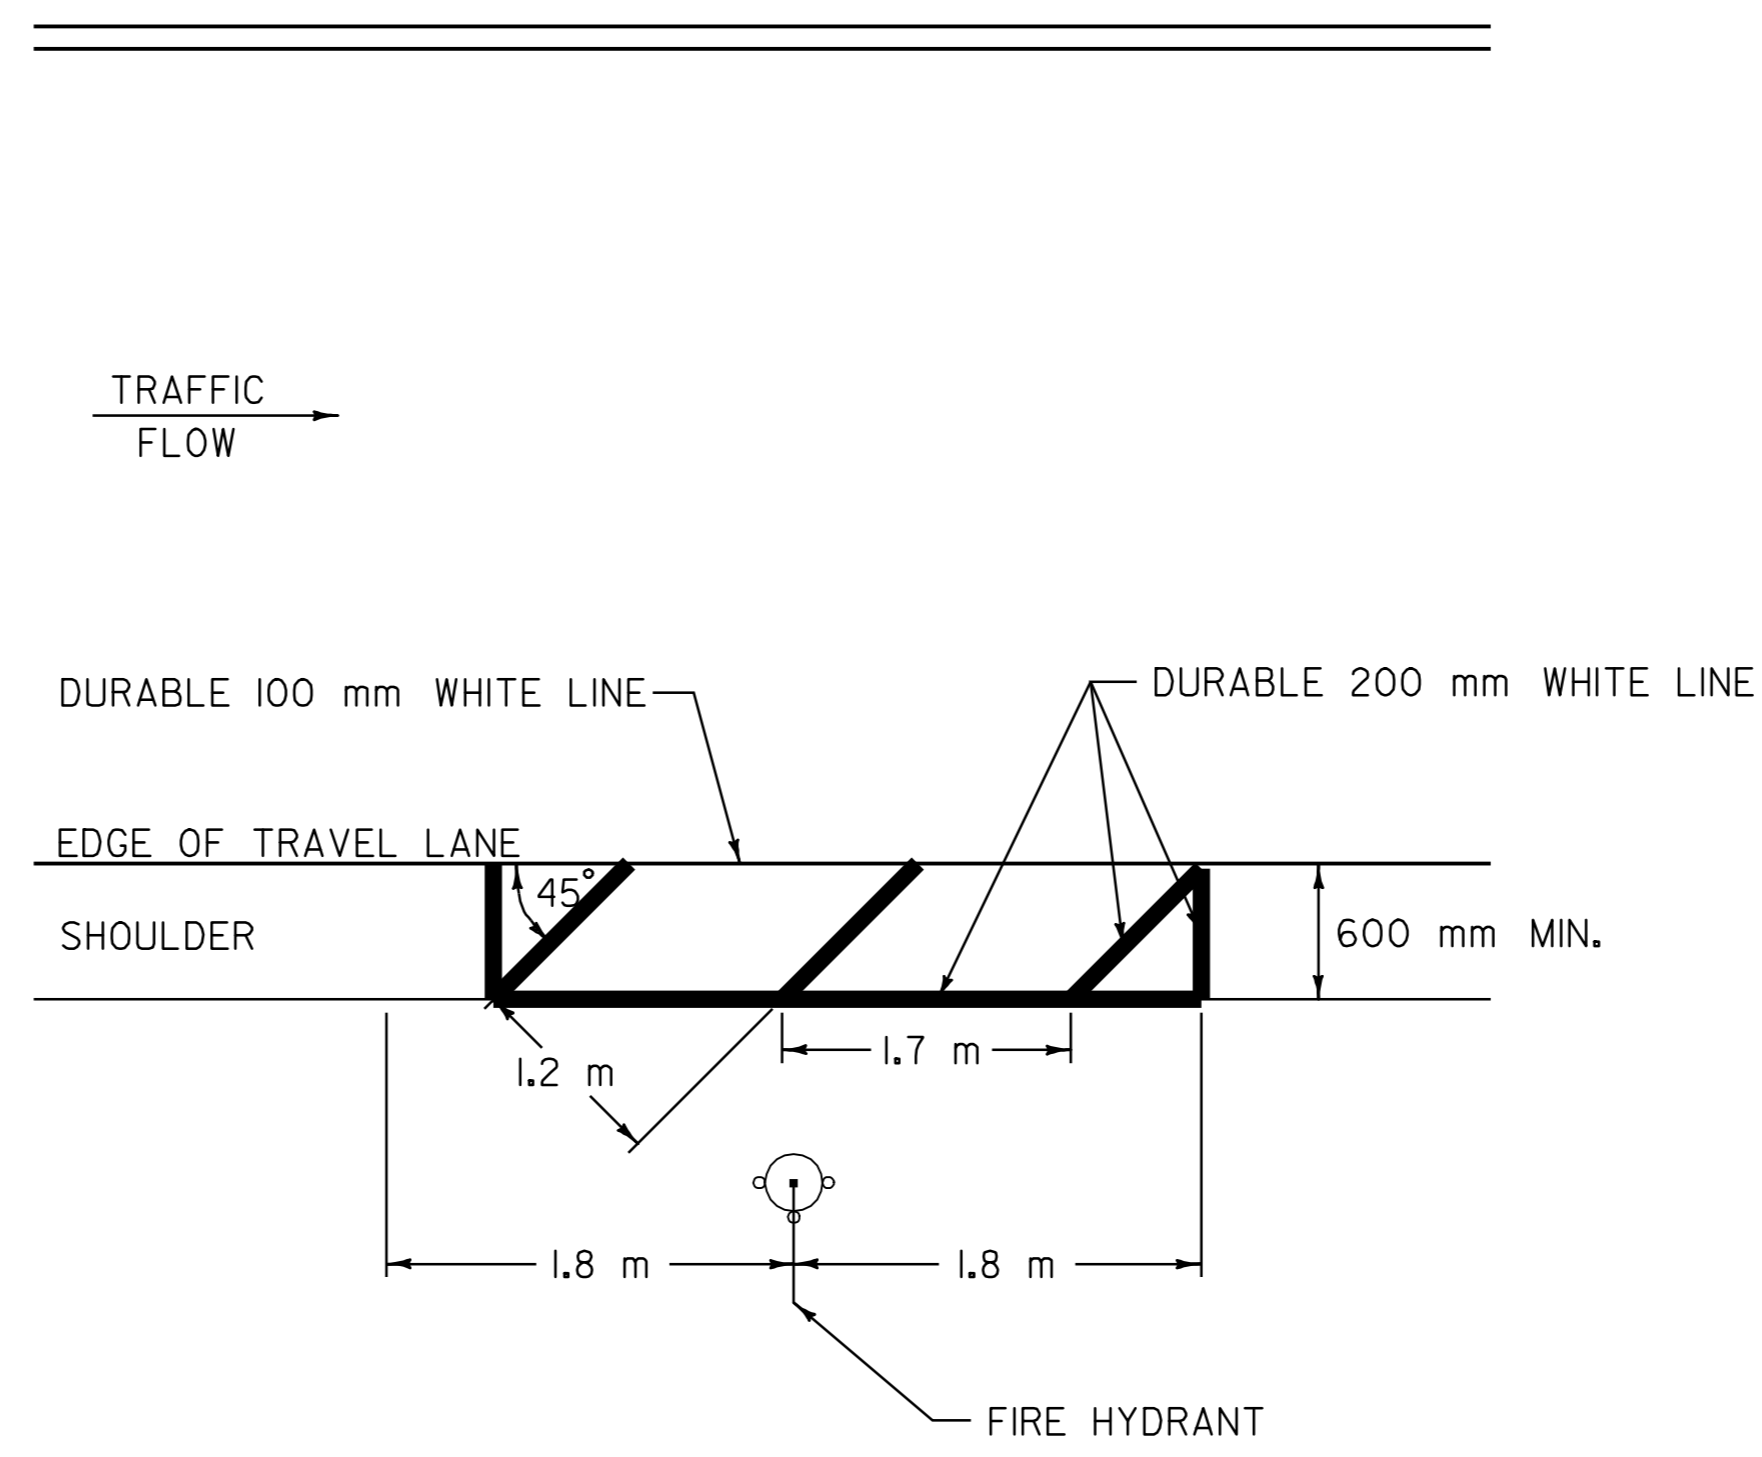


FIRE HYDRANT PAVEMENT MARKING DETAIL

NOT TO SCALE

DATUM	
VERTICAL	N/A
HORIZONTAL	N/A

PAVEMENT MARKINGS & SIDEWALK RAMP TEXTURING DETAIL SHEET	SURVEYED BY	N/A	DATE	N/A
	DRAWN BY	J.A.R.	DATE	4/01
	SQUAD LEADER	T.P.K.		
	DESIGN FILE NO.	pave/99d156/pdl56.dgn		
	IPARM FILE	pdl56det.i	DATE PLOTTED	NOV-2005 10:47
	PROJ. NAME	BENNINGTON		
	PROJ. NO.	NH 2202(1)S		
	SHEET	70 OF 108	SHEETS	

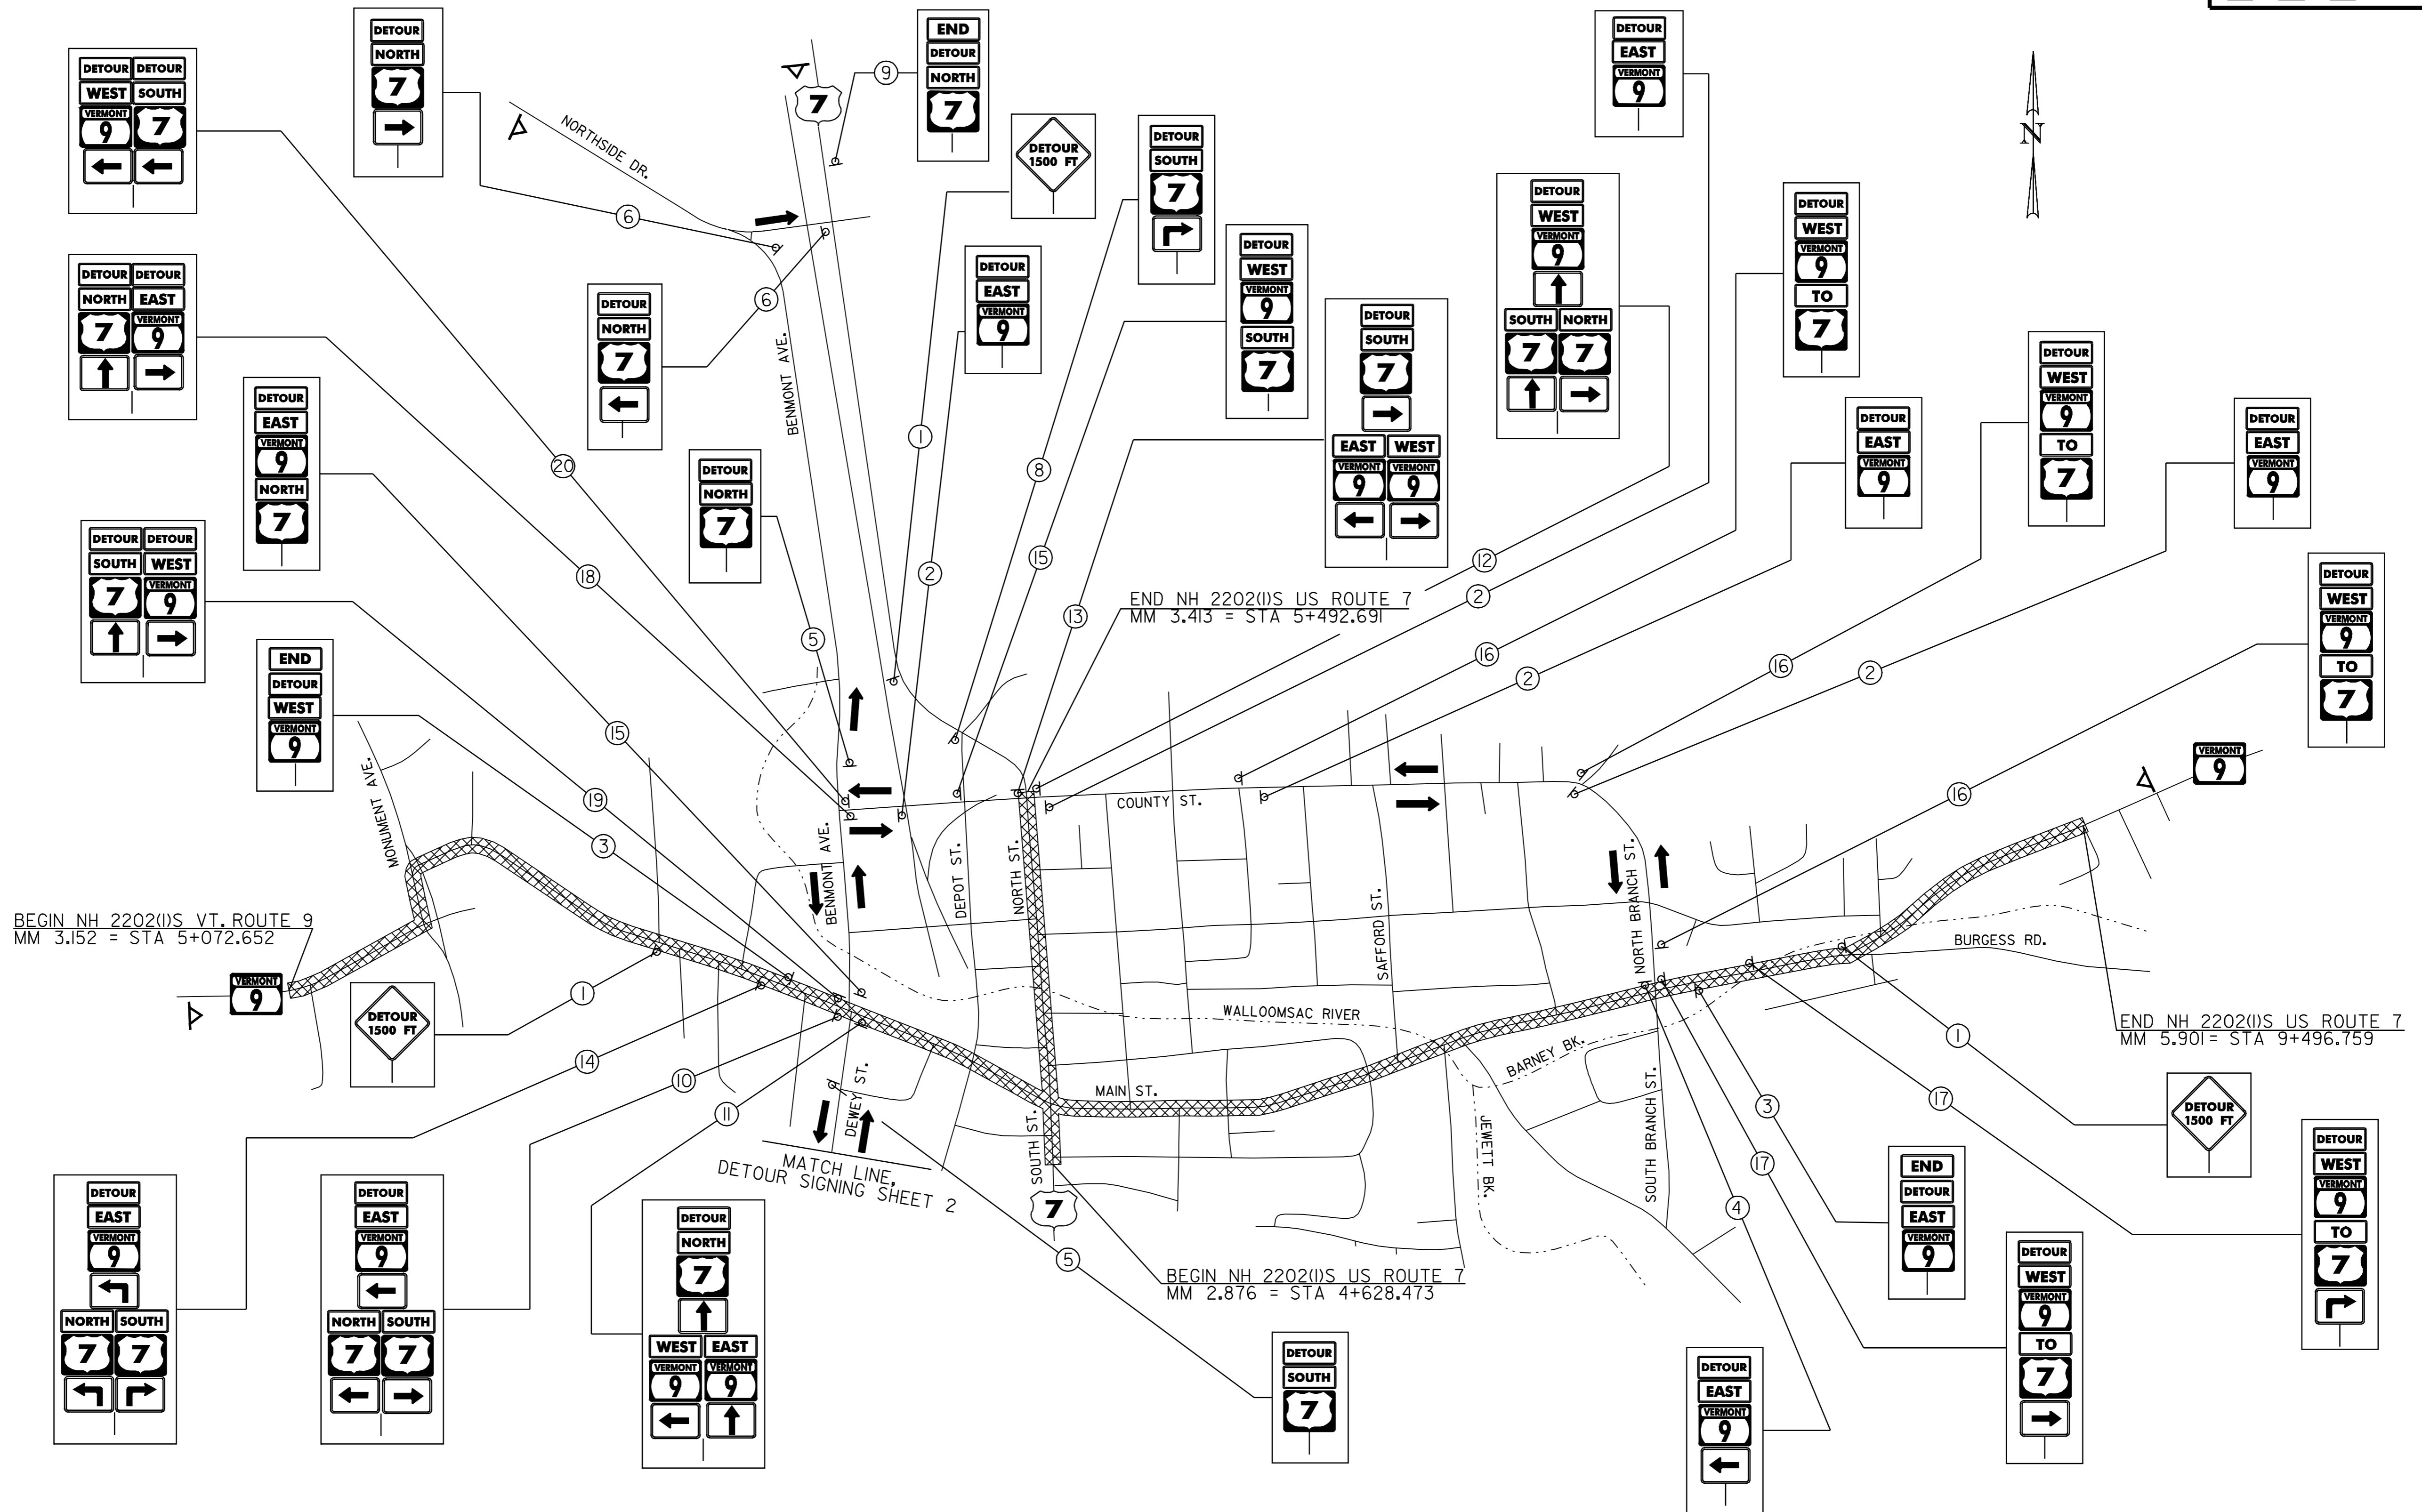

BEGIN NH 2202(I)S VT. ROUTE 9
MM 3.152 = STA 5+072.652

END NH 2202(I)S US ROUTE 7
MM 3.413 = STA 5+492.691

END NH 2202(I)S US ROUTE 7
MM 5.901 = STA 9+496.759

BEGIN NH 2202(I)S US ROUTE 7
MM 2.876 = STA 4+628.473

MATCH LINE,
DETOUR SIGNING SHEET 2

NOTES:

1. SIGNS WILL BE INSTALLED AS SHOWN ON THE PLANS AND COVERED FROM THE MOTORISTS VIEW WITH A DURABLE BAG OR OTHER ACCEPTABLE MATERIAL AS DIRECTED BY THE RESIDENT ENGINEER WHEN SIGN FACES ARE NOT IN USE.
2. PORTABLE CHANGEABLE MESSAGE SIGNS ARE SHOWN ABOVE IN THEIR APPROXIMATE LOCATIONS. THE EXACT LOCATION OF EACH PORTABLE CHANGEABLE MESSAGE SIGN MAY VARY DUE TO THE WORK BEING PERFORMED OR AS DIRECTED BY THE RESIDENT ENGINEER.
3. ALL SIGNS AND SIGN POSTS ASSOCIATED WITH THE DETOUR WILL BE REMOVED UPON COMPLETION OF THIS PROJECT AND GIVEN TO VAOT DISTRICT 1.


LEGEND

- ▲ PORTABLE CHANGEABLE MESSAGE SIGN
- ➔ ALTERNATE ROUTE TRAFFIC FLOW
- ▨ PROJECT AREA


**DETOUR
SIGNING
SHEET 1**

SURVEYED BY N/A DATE N/A
 DRAWN BY J.A.R. DATE 4/01
 SQUAD LEADER T.P.K.
 DESIGN FILE NO. pave/99dl56/pdl56.dgn
 IPARM pdl56dsl.i DATE NOV-2005
 FILE 4/01 PLOT# 4/01
 PROJ. NAME BENNINGTON
 PROJ. NO. NH 2202(I)S
 SHEET 71 OF 108 SHEETS

DATUM	
VERTICAL	N/A
HORIZONTAL	N/A

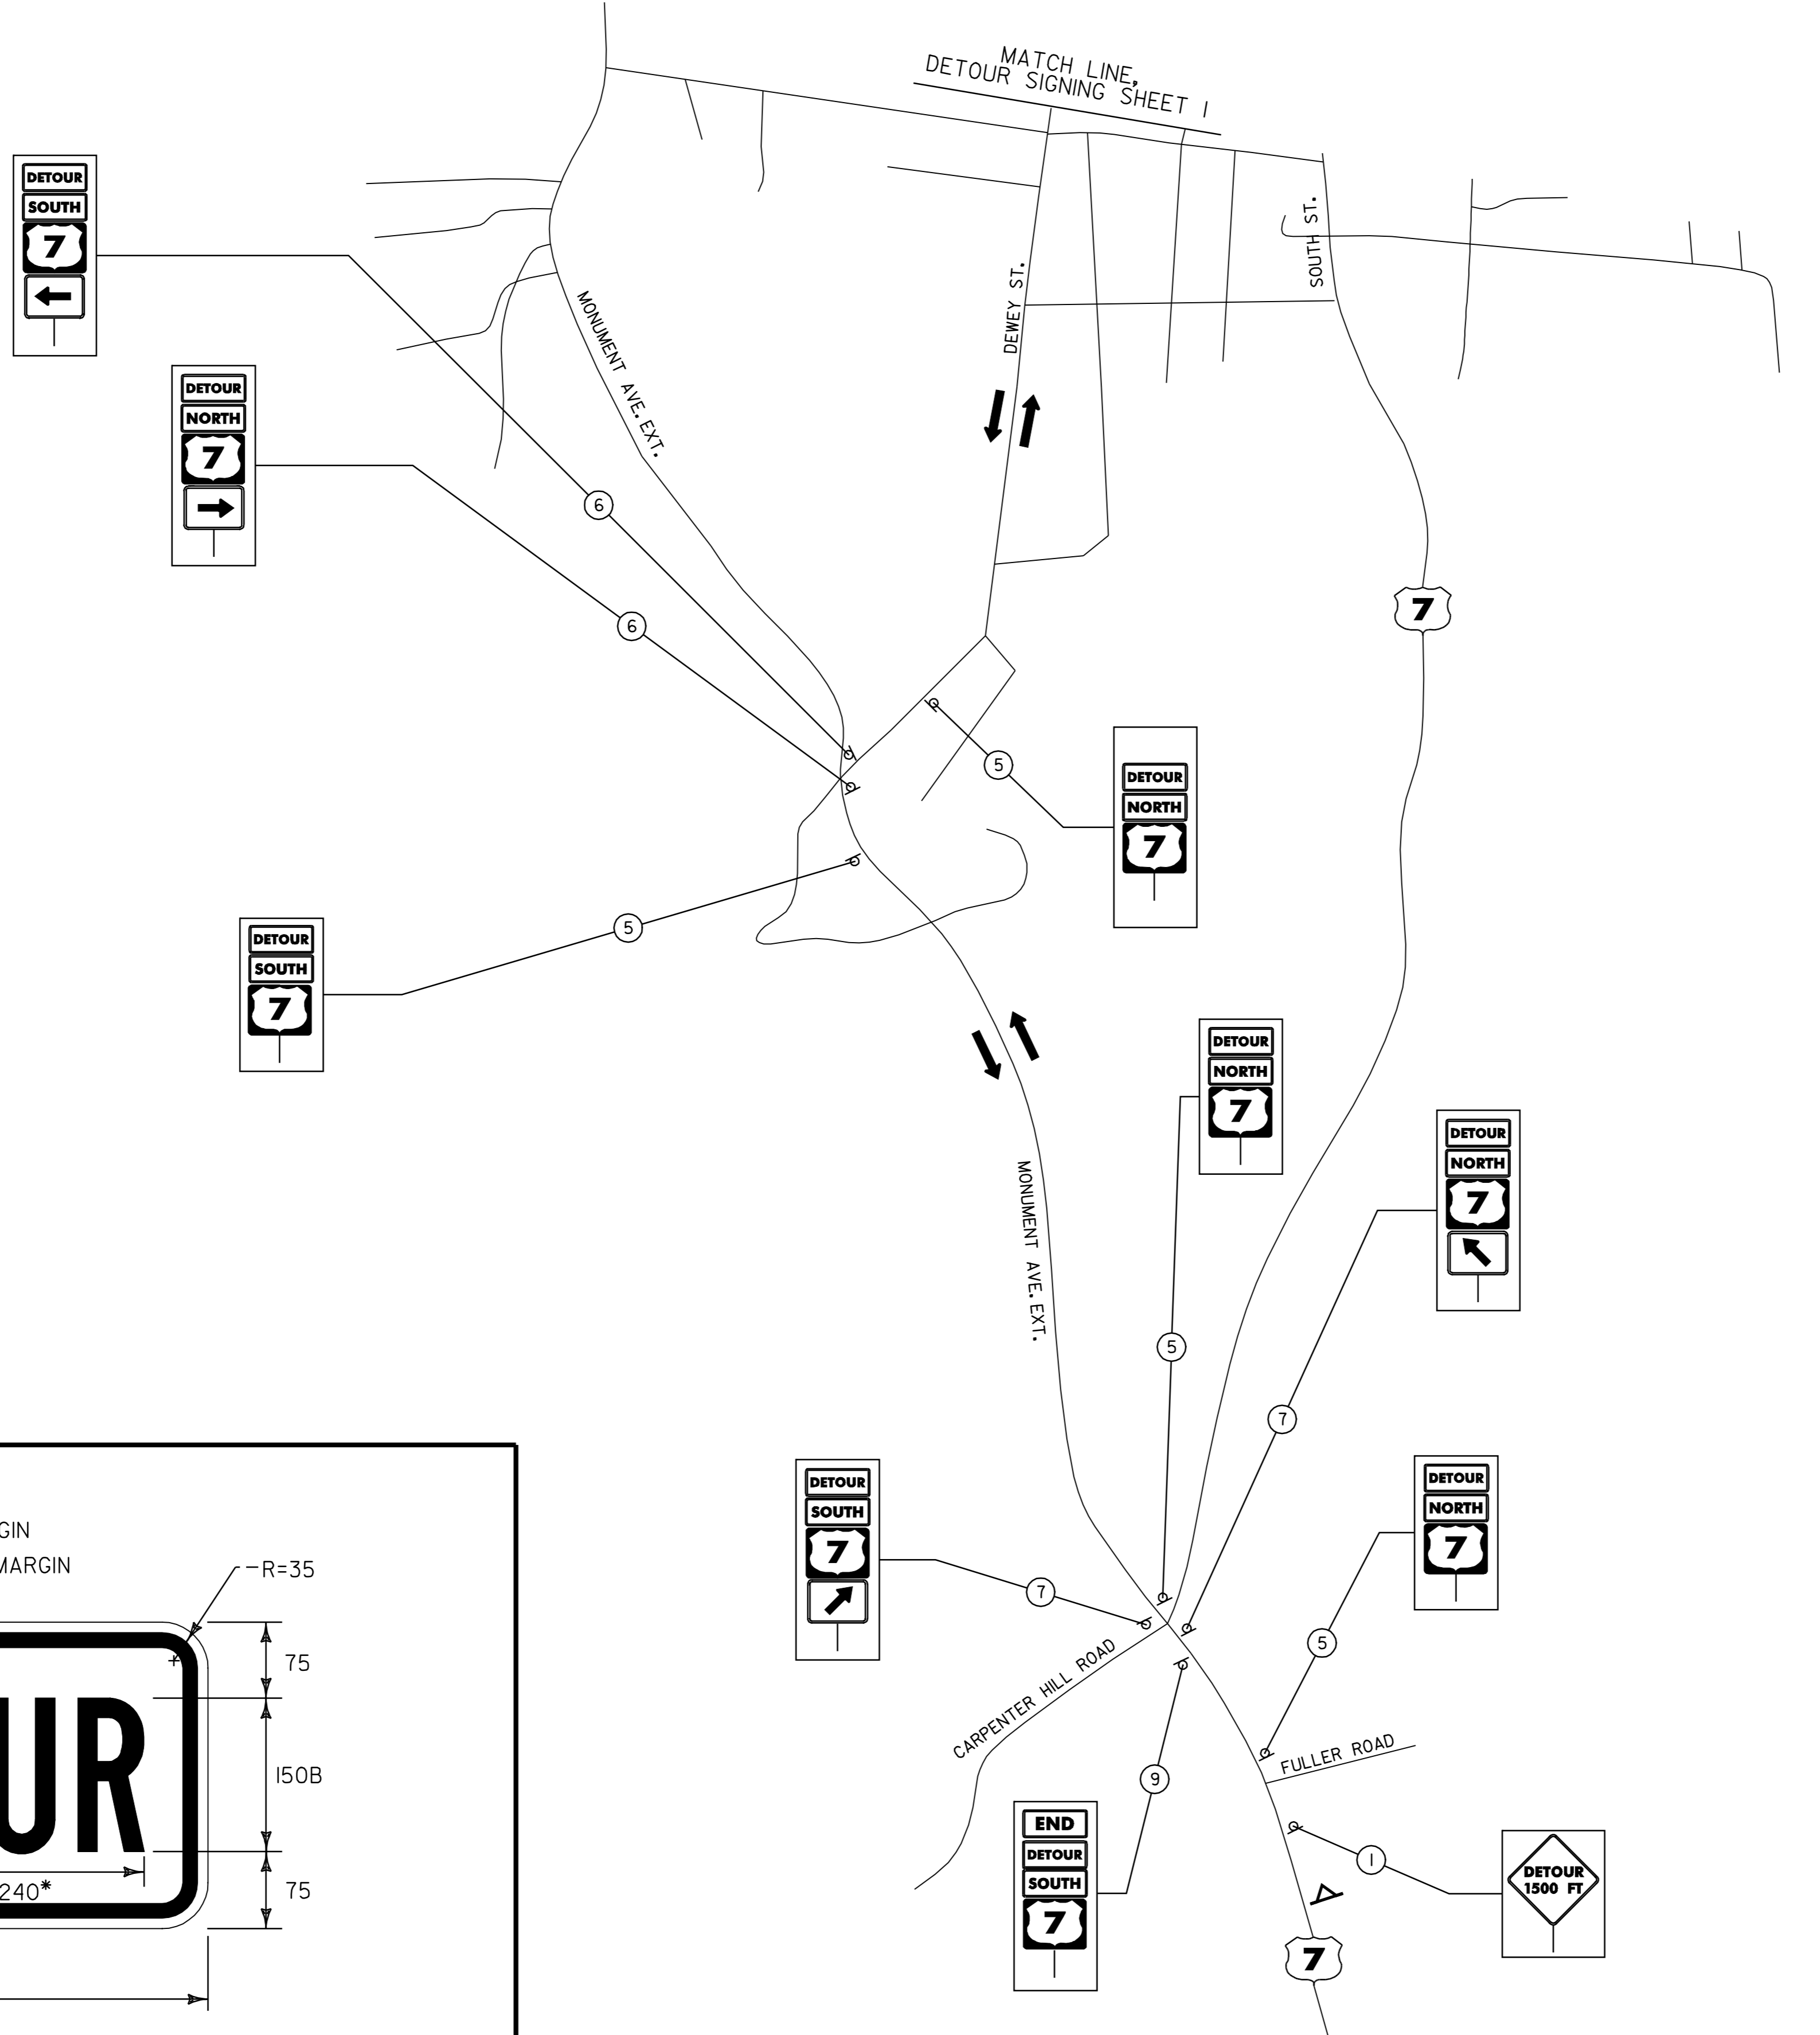

ALL DIMENSIONS IN MILLIMETERS EXCEPT WHERE OTHERWISE INDICATED.

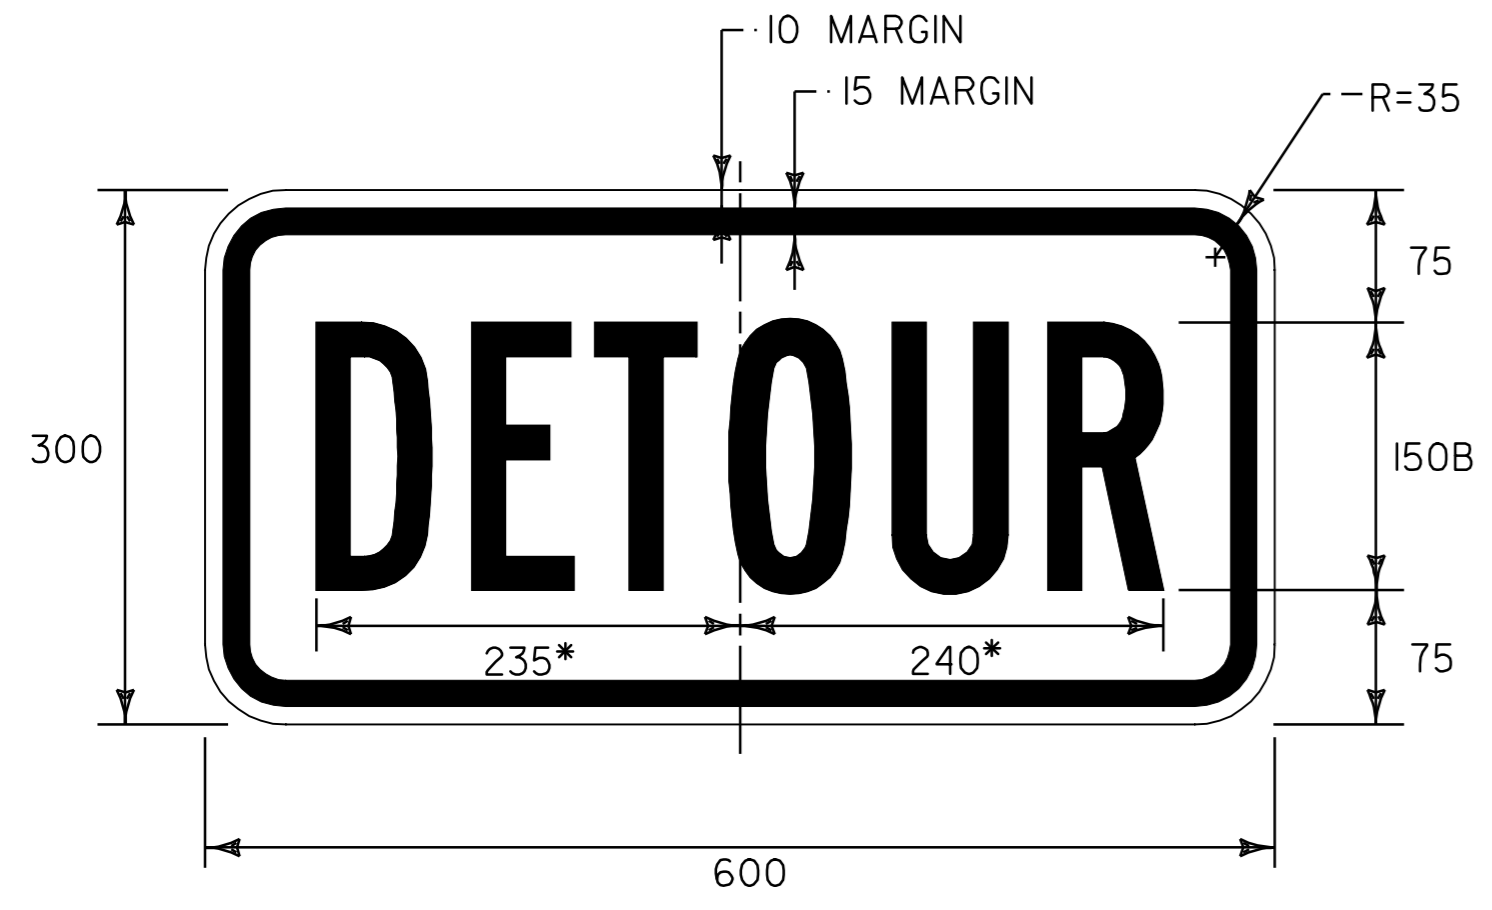

* REDUCE SPACING BY 20%
 COLOR: BLACK BORDER & TEXT
 ORANGE BACKGROUND (REFLECTORIZED)
 MATERIAL: PER VAOT STANDARD E-100M

TEXT LAYOUT DIMENSIONS ARE BASED ON THE "LETTER & NUMERAL WIDTHS & SPACE" TABLES FOUND IN THE "STANDARD HIGHWAY SIGNS" BOOKLET. MINOR VARIATIONS IN TEXT DIMENSIONS ARE ACCEPTABLE BASED ON INDIVIDUAL MANUFACTURER'S LETTER FABRICATION. SIGNIFICANT CHANGES THAT AFFECT SIGN APPEARANCE SHALL BE BROUGHT TO THE ATTENTION OF THE VAOT'S TRAFFIC AND SAFETY DIVISION BEFORE FABRICATION.

DATUM	
VERTICAL	N/A
HORIZONTAL	N/A

NOTES:

- SIGNS WILL BE INSTALLED AS SHOWN ON THE PLANS AND COVERED FROM THE MOTORISTS' VIEW WITH A DURABLE BAG OR OTHER ACCEPTABLE MATERIAL AS DIRECTED BY THE RESIDENT ENGINEER WHEN SIGN FACES ARE NOT IN USE.
- PORTABLE CHANGEABLE MESSAGE SIGNS ARE SHOWN ABOVE IN THEIR APPROXIMATE LOCATIONS. THE EXACT LOCATION OF EACH PORTABLE CHANGEABLE MESSAGE SIGN MAY VARY DUE TO THE WORK BEING PERFORMED OR AS DIRECTED BY THE RESIDENT ENGINEER.
- ALL SIGNS AND SIGN POSTS ASSOCIATED WITH THE DETOUR WILL BE REMOVED UPON COMPLETION OF THIS PROJECT AND GIVEN TO VAOT DISTRICT I.

- LEGEND**
- PORTABLE CHANGEABLE MESSAGE SIGN
 - ALTERNATE ROUTE TRAFFIC FLOW

DETOUR SIGNING SHEET 2	SURVEYED BY <u>N/A</u> DATE <u>N/A</u>
	DRAWN BY <u>J.A.R.</u> DATE <u>4/01</u>
	SQUAD LEADER <u>T.P.K.</u>
	DESIGN FILE NO. <u>pave/99dl56/pdl56.dgn</u>
	IPARM <u>pdl56ds.1</u> DATE <u>NOV-2005</u> FILE <u>PL074</u>
PROJ. NAME <u>BENNINGTON</u>	
PROJ. NO. <u>NH 2202(1)S</u>	
SHEET <u>72</u> OF <u>108</u> SHEETS	

KILOMETER MARKER, STATION, OR SIGN NUMBER	SIGN LEGEND	SIGN DIMENSIONS			NEW & SALVAGED SIGNS				EXIST POST RETAIN	SALVAGE	NO. OF POSTS	NEW SIGN POSTS																REMARKS	SIGN DETAIL					
		EA	WIDTH (mm)	HEIGHT (mm)	"A"	"B"	SALV SIGN	SALV TIS				FLANGED CHANNEL			SQUARE STEEL (mm)			TUBULAR ALUMINUM Ø (mm)			TUBULAR STEEL Ø (mm)				W-SHAPE STEEL		FRAGILE SIGN		REQUIRED	DETAIL ON SHEET NUMBER	STD. SHEET NUMBER			
												1.7	3.0	4.5	44	50	63	75	100	100 MOD	FOUND-ATION	75	89	100	125	FTG. SIZE						WEIGHT	POST SIZE	
																										kg/m								kg/m
OPTION ITEMS																																		
5		6	600	300	1.08						6																		SIX DIFFERENT LOCATIONS, ONE POST PER EACH LOCATION.	72	-			
		6	600	300	1.08																										E-136AM			
		6	600	600	2.16																										E-136AM			
6		4	600	300	0.72						4																			FOUR DIFFERENT LOCATIONS, ONE POST PER EACH LOCATION.	72	-		
		4	600	300	0.72																											E-136AM		
		4	600	600	1.44																											E-136AM		
		4	525	375	0.80																											E-136AM		
7		2	600	300	0.36						2																				TWO DIFFERENT LOCATIONS, ONE POST PER EACH LOCATION.	72	-	
		2	600	300	0.36																												E-136AM	
		2	600	600	0.72																												E-136AM	
		2	525	375	0.40																												E-136AM	

FINAL POST LENGTHS ARE TO BE DETERMINED IN THE FIELD. POST SIZES ARE COMPUTED BASED ON INFORMATION FURNISHED ON THE STANDARD SHEETS AND THE TRAFFIC & SAFETY DIVISION'S "SIGN POST DESIGN GUIDELINE."

TOTALS	m ²	m ²	EA	m ²		m	m	kg	EA	kg	EA	kg
	9.84					27.6	27.6	52.8				

PROJECT: BENNINGTON	PROJECT NO.: NH 2202(I)S
DESIGN FILE NAME: /pave/99dl56/pdl56.dgn	PLOT DATE: 21-NOV-2005 10:00
IPARM FILE NAME: pdl56dss2.l	SURVEY DATE: N/A
SURVEYED BY: N/A	DRAWN BY: C.A.K.
SQUAD LEADER: T.P.K.	SHEET: 74 OF 108


KILOMETER MARKER, STATION, OR SIGN NUMBER	SIGN LEGEND	SIGN DIMENSIONS		NEW & SALVAGED SIGNS				EXIST POST		NEW SIGN POSTS														REMARKS REDUCE MINIMUM STANDARD SIZE SIGN DIMENSIONS BY 25%.	SIGN DETAIL									
		EA	WIDTH (mm)	HEIGHT (mm)	"A"	"B"	SALV SIGN	SALV TIS	RETAI N	SALV AGE	NO. OF POSTS	FLANGED CHANNEL			SQUARE STEEL (mm)			TUBULAR ALUMINUM Ø (mm)			TUBULAR STEEL Ø (mm)				W-SHAPE STEEL			FR AIG ME	REQUI RED	DETAIL ON SHEET NUMBER	STD. SHEET NUMBER			
												1.7	3.0	4.5	44	50	63	75	100	100 MOD	FOUND- ATION	75	89		100	125	FTG. SIZE					WEIGHT	POST SIZE	
															kg/m			kg/m				kg/m			600 mm	750 mm								
OPTION ITEMS																																		
13		1	450	225	0.10					1								12.5										X	REDUCE MINIMUM STANDARD SIZE SIGN DIMENSIONS BY 25%.	72	-			
		1	450	225	0.10																										E-136AM			
		1	450	450	0.20																										E-136AM			
		1	395	375	0.11																										E-136AM			
		1	450	225	0.10																										E-136BM			
		1	450	225	0.10																										E-136BM			
		1	450	450	0.20																										E-136BM			
		1	450	450	0.20																										E-136BM			
		1	395	375	0.11																										E-136BM			
		1	395	375	0.11																										E-136BM			
14		1	450	225	0.10					1								12.5										X	REDUCE MINIMUM STANDARD SIZE SIGN DIMENSIONS BY 25%.	72	-			
		1	450	225	0.10																										E-136BM			
		1	450	450	0.20																										E-136BM			
		1	395	280	0.11																										E-136BM			
		1	450	225	0.10																										E-136AM			
		1	450	225	0.10																										E-136AM			
		1	450	450	0.20																										E-136AM			
		1	450	450	0.20																										E-136AM			
		1	395	280	0.11																										E-136AM			
		1	395	280	0.11																										E-136AM			

VT. ROUTE 9
MM 3.152 = STA. 5+072.652
END PROJECT NH 2225(I)S
BEGIN PROJECT NH 2202(I)S

VT. ROUTE 9
MM 5.901 = STA. 9+496.739
END PROJECT NH 2202(I)S

U.S. ROUTE 7
MM 3.413 = STA. 5+492.691
END PROJECT NH 2202(I)S

U.S. ROUTE 7
MM 2.876 = STA. 4+628.473
BEGIN PROJECT NH 2202(I)S

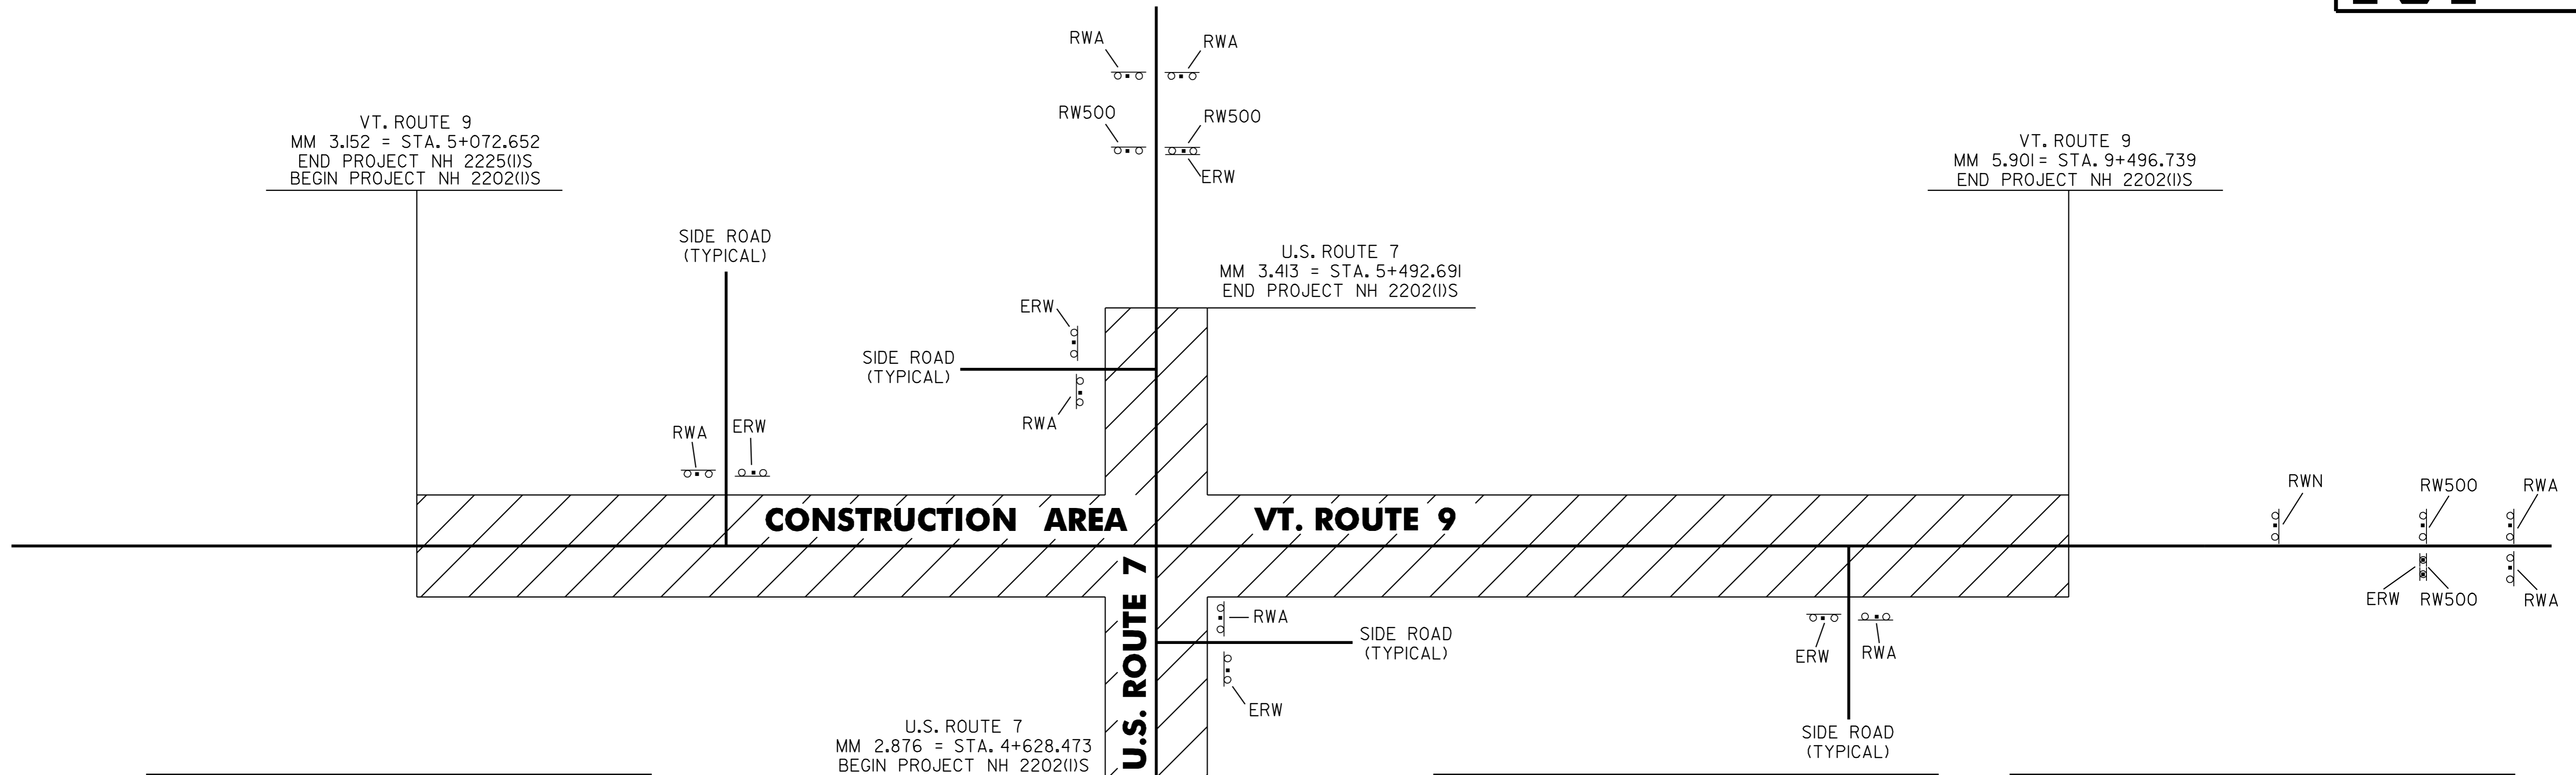

U.S. ROUTE 7 LIST OF TOWN HIGHWAYS FOR CONSTRUCTION SIGNS			
TOWN HIGHWAY NUMBER	ROAD WORK AHEAD	END ROAD WORK	OTHER
BEGIN PROJECT	2	1	2 - RW500 1 - RWN
T-430	1	1	
T-342	-	1	
T-338	-	1	
T-332	1	1	
T-336	1	1	
T-5	1	1	
T-326	1	1	
END PROJECT	2	1	2 - RW500 1 - RWN
TOTAL	9	9	6

VERMONT ROUTE 9 LIST OF TOWN HIGHWAYS FOR CONSTRUCTION SIGNS			
TOWN HIGHWAY NUMBER	ROAD WORK AHEAD	END ROAD WORK	OTHER
T-912	1	1	
T-2 NORTH	1	1	
T-2 SOUTH	1	1	
T-2	1	1	
T-910	1	1	
T-320	1	1	
T-394	1	1	
T-396	1	1	
T-324	1	1	
T-398	1	1	
T-7	1	1	
T-404	1	1	
T-406	1	1	
T-416	1	1	
T-330	1	1	
T-340	1	1	
T-438	-	1	

VERMONT ROUTE 9 LIST OF TOWN HIGHWAYS FOR CONSTRUCTION SIGNS			
TOWN HIGHWAY NUMBER	ROAD WORK AHEAD	END ROAD WORK	OTHER
T-442 NORTH	-	1	
T-442 SOUTH	1	-	
T-430	1	1	
T-342	1	1	
T-360	1	1	
T-476	1	1	
T-3	1	1	
T-374	1	1	
T-486	1	1	
T-384	1	1	
ROCKWOOD ST.	1	1	
T-504	1	1	
T-6	1	1	
T-508	1	1	
END PROJECT	2	1	2 - RW500 1 - RWN
TOTAL	31	31	3

SIGN LEGEND

RWA = ROAD WORK AHEAD
RW500 = ROAD WORK 500 FEET
ERW = END ROAD WORK
RWN = ROAD WORK NEXT 3 MILES

CONSTRUCTION APPROACH SIGNING

SEE STD. E-100M FOR ADDITIONAL SIGN PLACEMENT

NOTE:

THE RESIDENT ENGINEER AT HIS OR HER DISCRETION SHALL ELIMINATE CONSTRUCTION APPROACH SIGNS FOR DEAD END/NO OUTLET TOWN HIGHWAYS OR TOWN HIGHWAYS THAT CONNECT ON BOTH SIDES OF THE PROJECT.

CONSTRUCTION APPROACH SIGNING DETAIL SHEET

SURVEYED BY N/A DATE N/A
DRAWN BY J.A.R. DATE 4/01
SQUAD LEADER T.P.K.
DESIGN FILE NO. pave/99d156/pdl56.dgn
IPARM FILE pdl56cas.i DATE 27 NOV-2005 10:47:27
PROJ. NAME BENNINGTON
PROJ. NO. NH 2202(I)S
SHEET 80 OF 108 SHEETS

DATUM
VERTICAL N/A
HORIZONTAL N/A

INDEX OF SHEETS

- 81 TITLE SHEET
- 82 PROJECT TYPICAL SHEET
- 83 PAVING DETAILS AND PAVEMENT JOINT DETAIL SHEET
- 84-85 QUANTITY SHEETS
- 86 ITEM DETAIL SUMMARY SHEET
- 87-96 LAYOUT SHEETS
- 97-106 TRAFFIC SIGN SUMMARY SHEETS
- 107 TRAFFIC SIGN DETAIL SHEET
- 108 CONSTRUCTION APPROACH SIGNING SHEET

STATE OF VERMONT AGENCY OF TRANSPORTATION




PROPOSED IMPROVEMENT TOWN OF BENNINGTON COUNTY OF BENNINGTON VT. ROUTE 9

THE PROJECT BEGINS IN BENNINGTON AT THE NEW YORK / VERMONT STATE LINE AT MILE MARKER 0.000 = STA. 0+000.000 AND EXTENDS EASTERLY ALONG VT. ROUTE 9 FOR A DISTANCE OF 5072.652 m (3.152 MILES) TO A POINT AT MILE MARKER 3.152 = STA. 5+072.652.

LENGTH OF ROADWAY 5072.652 m (3.152 MILES)
LENGTH OF PROJECT 5072.652 m (3.152 MILES)

WORK TO BE PERFORMED UNDER THIS PROJECT INCLUDES RESURFACING WITH A WEARING COURSE, NEW PAVEMENT MARKINGS, NEW SIGNS, DRAINAGE IMPROVEMENTS, GUARDRAIL IMPROVEMENTS AND INCIDENTAL ITEMS.

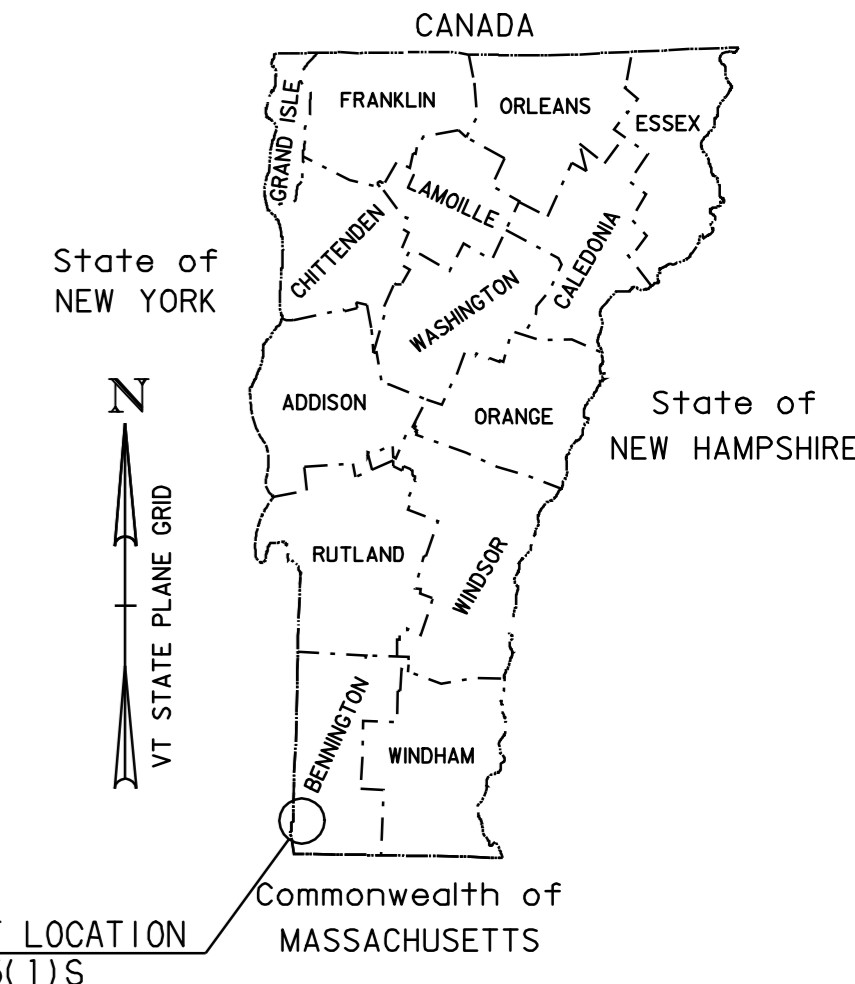


TRAFFIC DATA

VT. ROUTE 9 (MM 0.000 TO MM 2.610)
2002 ADT = 10,800
2002 DHV = 1,300
2012 ADT = 12,900
2012 DHV = 1,600
2002 ~ 2012 CUM. ESALS = 6,121,000
2002 ~ 2022 CUM. ESALS = 16,140,000

VT. ROUTE 9 (MM 2.610 TO END PROJECT)
2002 ADT = 11,000
2002 DHV = 1,400
2012 ADT = 13,200
2012 DHV = 1,600
2002 ~ 2012 CUM. ESALS = 5,508,000
2002 ~ 2022 CUM. ESALS = 13,924,000


VAOT STANDARDS

E-100M	CONSTRUCTION APPROACH SIGNS	06-13-97
E-101M	CONSTRUCTION SIGN DETAILS	06-13-97
E-102M	CONSTRUCTION SIGN DETAILS	06-13-97
E-102AM	CONSTRUCTION SIGN DETAILS	06-13-97
E-103M	MAINLINE TRAFFIC CONTROL DIVIDED HIGHWAY ONE LANE CLOSED	09-24-98
E-106M	TRAFFIC CONTROL MISCELLANEOUS DETAILS	06-13-97
E-107M	DELINEATION, BARRICADES AND DETOURS FOR CONSTRUCTION AREAS	06-13-97
E-107AM	BREAKAWAY BARRICADE DETAILS	06-13-97
E-108M	CONSTRUCTION ZONE LONGITUDINAL DROP OFFS	06-13-97
E-110M	MAJOR MAINTENANCE OPERATION LANE CLOSURE	06-13-97
E-111M	MAINTENANCE OPERATION APPROACH SIGNS	02-17-98
E-121M	STANDARD SIGN PLACEMENT CONVENTIONAL ROAD	06-13-97
E-123M	GUIDE SIGN PLACEMENT MISCELLANEOUS DETAILS	06-13-97
E-128AM	VILLAGE SIGNS A-M	06-13-97
E-128BM	VILLAGE SIGNS N-W	06-13-97
E-131M	GUIDE SIGN DETAILS	06-13-97
E-134M	BRIDGE NUMBER PLAQUE	06-13-97
E-136BM	STATE ROUTE MARKER SIGN DETAILS	06-13-97
E-138M	REFERENCE PLAQUE DETAILS STATE AND TOWN HIGHWAYS	06-13-97
E-141M	REGULATORY SIGN DETAILS	06-13-97
E-142M	REGULATORY SIGN DETAILS	06-13-97
E-143M	REGULATORY SIGN DETAILS	06-13-97
E-144M	REGULATORY SIGN DETAILS	06-13-97
E-151M	WARNING SIGN DETAILS	06-13-97
E-152M	WARNING SIGN DETAILS	06-13-97
E-153M	WARNING SIGN DETAILS	06-13-97
E-154M	WARNING SIGN DETAILS	06-13-97
E-155M	WARNING SIGN DETAILS	06-13-97
E-160M	FLANGED CHANNEL STEEL SIGN POST	06-13-97
E-162M	TUBULAR ALUMINUM SIGN POST	06-13-97
E-191M	PAVEMENT MARKING DETAILS	06-13-97
E-193M	PAVEMENT MARKING DETAILS	06-13-97
G-1M	STEEL BEAM GUARDRAIL WITH STEEL POSTS	01-03-00
G-4M	YIELDING MARKER POSTS	06-13-97
G-19M	GENERIC GRADING PLAN FOR GUARDRAIL TERMINALS	10-21-98

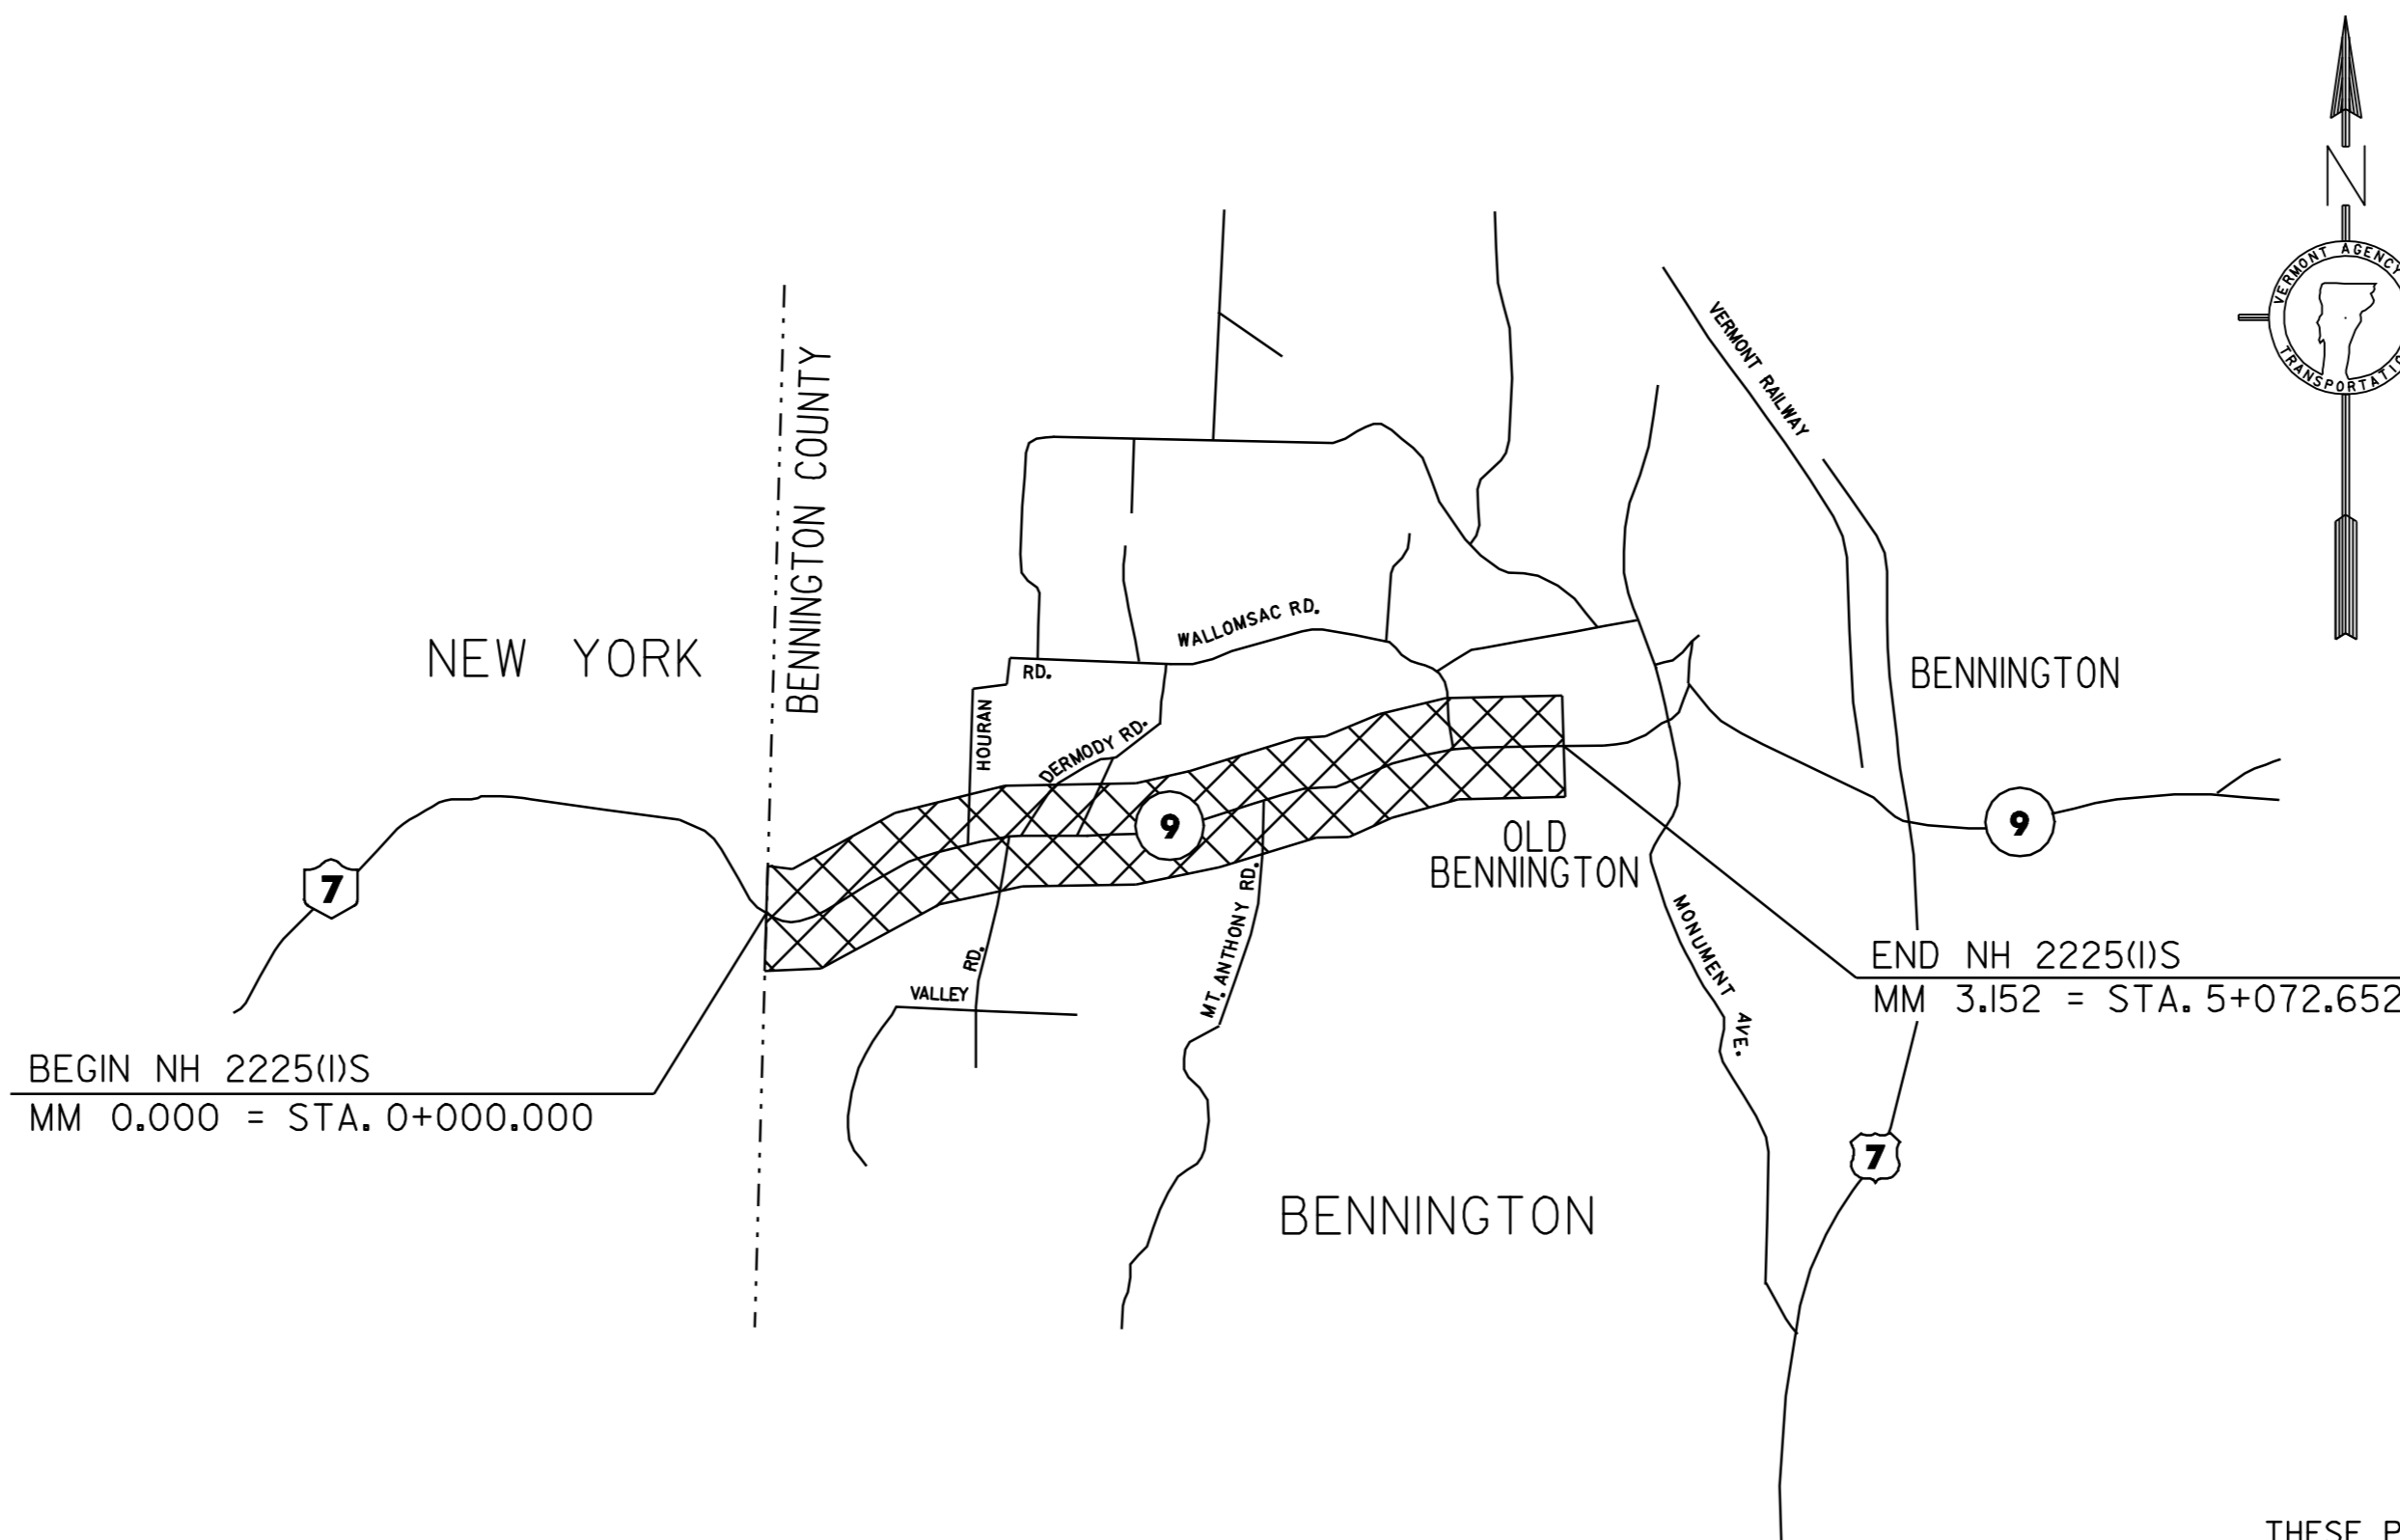

UNLESS OTHERWISE NOTED, ALL DRAWINGS AND DETAILS OF THE PROJECT PLANS ARE NOT TO SCALE

RIGHT OF WAY LIMITS, IF APPLICABLE, ARE PROVIDED SOLELY FOR THE CONVENIENCE OF THE STATE AND ITS CONTRACTOR DURING THE COURSE OF THIS PAVING PROJECT. ANY REFERENCES TO OFFSETS ON THESE PLANS ARE APPROXIMATE AND SHOULD NOT BE RELIED UPON FOR ANY OTHER PURPOSES

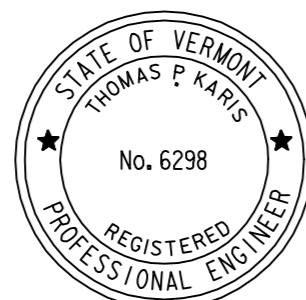

PLANS PREPARED BY

CH A CLOUGH, HARBOUR & ASSOCIATES LLP
ENGINEERS, SURVEYORS, PLANNERS & LANDSCAPE ARCHITECTS
111 WINNERS CIRCLE ALBANY, NEW YORK, 12205

BY _____

DATUM
VERTICAL N/A
HORIZONTAL N/A

CONVENTIONAL SIGNS

COUNTY LINE	---
TOWN LINE	- - - -
LIMITS OF ACCESS	○-○-○-○
POINT OF ACCESS	X
FENCE LINE	-x-x-
STONE WALL	○-○-○-○
TRAVELED WAY	====
GUARD RAIL	○-○-○-○
RAILROAD	
SURVEY LINE	++
CULVERT	—+—+—+—+—
POWER POLE	⊕
TELEPHONE POLE	⊙
TREES	⊗ * *
CONTROL OF ACCESS	///
PROPERTY LINE	---
R.O.W. TAKING LINE	—SR—
SLOPE RIGHTS	△
TOP OF CUT	▲
TOE OF SLOPE	○

THESE PLANS ARE SUBJECT TO SUCH ENGINEERING CHANGES AS MAY BE REQUIRED BY THE FEDERAL HIGHWAY ADMINISTRATION OR THE DIRECTOR OF PROJECT DEVELOPMENT.
CONSTRUCTION IS TO BE CARRIED ON IN ACCORDANCE WITH THESE PLANS AND THE STANDARD SPECIFICATIONS FOR CONSTRUCTION DATED 2001, AS APPROVED BY THE FEDERAL HIGHWAY ADMINISTRATION ON JANUARY 4, 2001 FOR USE ON THIS PROJECT, INCLUDING ALL SUBSEQUENT REVISIONS AND SUCH REVISED SPECIFICATIONS AND SPECIAL PROVISIONS AS ARE INCORPORATED IN THESE PLANS.

Metric

APPROVED _____ DATE _____
DIRECTOR OF PROGRAM DEVELOPMENT

DEPARTMENT OF TRANSPORTATION
FEDERAL HIGHWAY ADMINISTRATION


APPROVED _____ DATE _____
DIVISION ADMINISTRATOR

PROJECT BENNINGTON
NH 2225(1)S

SHEET 81 OF 108 SHEETS

NOTES

1. THE WEARING COURSE SHALL BE TYPE IVS SUPERPAVE BITUMINOUS CONCRETE PAVEMENT. THE LEVELING COURSE SHALL BE TYPE IV UNLESS OTHERWISE DIRECTED BY THE RESIDENT ENGINEER. ALL ASPHALT CEMENT USED IN THE SUPERPAVE BITUMINOUS CONCRETE PAVEMENT SHALL BE PG 64-28.
2. EXISTING SHOULDER MATERIAL DEEMED UNSUITABLE BY THE RESIDENT ENGINEER SHALL BE EXCAVATED TO A DEPTH OF 75 mm OR AS DIRECTED BY THE RESIDENT ENGINEER. EXCAVATED MATERIAL SHALL BE SPREAD ON THE ADJACENT SLOPES OR REMOVED FROM THE PROJECT, AS DIRECTED BY THE RESIDENT ENGINEER. EXCAVATION WILL BE PAID FOR AS ALL-PURPOSE EXCAVATOR OR GRADER RENTAL. MATERIAL REMOVED SHALL BE REPLACED WITH SUBBASE OF CRUSHED GRAVEL (FINE GRADED).
3. EMULSIFIED ASPHALT SHALL BE APPLIED ON ALL EXISTING PAVEMENT SURFACES, ON ALL COLD PLANED SURFACES AND BETWEEN ALL COURSES OF PAVEMENT AT THE RATE OF 0.12 L/m² OR AS DIRECTED BY THE RESIDENT ENGINEER.
4. BITUMINOUS CONCRETE PAVEMENT TOLERANCE = ±5 mm (TOTAL PAVEMENT THICKNESS EXCLUDING LEVELING).
5. ALL DRIVEWAYS AND MAILBOX TURNOUTS SHALL RECEIVE A PAVED APRON AS DIRECTED BY THE RESIDENT ENGINEER. ALL MAILBOX TURNOUTS SHALL HAVE THE EXISTING EDGE OF PAVEMENT BACKED-UP WITH COLD PLANE GRINDINGS PRIOR TO THE PLACEMENT OF THE PAVED APRON. COMPENSATION FOR THIS WORK SHALL BE MADE UNDER THE APPROPRIATE EQUIPMENT RENTAL ITEM(S).
6. AN ESTIMATED QUANTITY OF EARTH BORROW HAS BEEN INCLUDED FOR THE PROVISION OF CONSTRUCTING MANUFACTURED TERMINAL SECTION FLARES WHICH SHALL BE CAPPED WITH AN ESTIMATED 75 mm DEPTH OF AGGREGATE SHOULDER MATERIAL UNLESS OTHERWISE DIRECTED BY THE RESIDENT ENGINEER. THE QUANTITIES INCLUDED REFLECT 20 m³ OF EARTH BORROW AND 5 TONS OF AGGREGATE SHOULDER MATERIAL FOR EACH GUARDRAIL TERMINAL.
7. ITEM 616.47 BITUMINOUS CONCRETE GUTTERS AND TRAFFIC ISLANDS WILL BE PAID FOR ONLY WHERE SPECIFIED IN THE PLANS. ALL OTHER BITUMINOUS CONCRETE PAVEMENT WORK, WHICH COULD INVOLVE SOME HAND-WORK (SUCH AS DRIVE AND SIDE ROAD APPROACHES AND AROUND DRAINAGE/UTILITY STRUCTURES), SHALL BE PAID FOR AT THE CONTRACT UNIT PRICE FOR ITEM 490.30 SUPERPAVE BITUMINOUS CONCRETE PAVEMENT (PG 64-28).
8. GRASS GROWING ADJACENT TO PAVEMENT OR THROUGH CRACKS IN THE PAVEMENT WHICH MAY HAMPER THE PLACEMENT OF NEW BITUMINOUS CONCRETE SHALL BE REMOVED BY THE CONTRACTOR AS DIRECTED BY THE RESIDENT ENGINEER. PAYMENT FOR THIS WORK WILL NOT BE MADE DIRECTLY, BUT WILL BE CONSIDERED SUBSIDIARY TO ITEM 490.30.
9. 1.0 m OF BACKING IS REQUIRED BEHIND THE FACE OF GUARDRAIL WITH 1.8 m POSTS. IF THIS CANNOT BE OBTAINED, THEN 2.4 m POSTS SHALL BE USED.
10. SPOT LEVELING HAS BEEN ESTIMATED AT 25% OF THE ENTIRE AREA OF PAVEMENT AND SHALL BE PERFORMED AS DIRECTED BY THE RESIDENT ENGINEER.
11. AN ESTIMATED QUANTITY OF ITEM 613.10 STONE FILL, TYPE I HAS BEEN INCLUDED TO REPAIR THE EXISTING SIDE SLOPE AS DIRECTED BY THE RESIDENT ENGINEER.

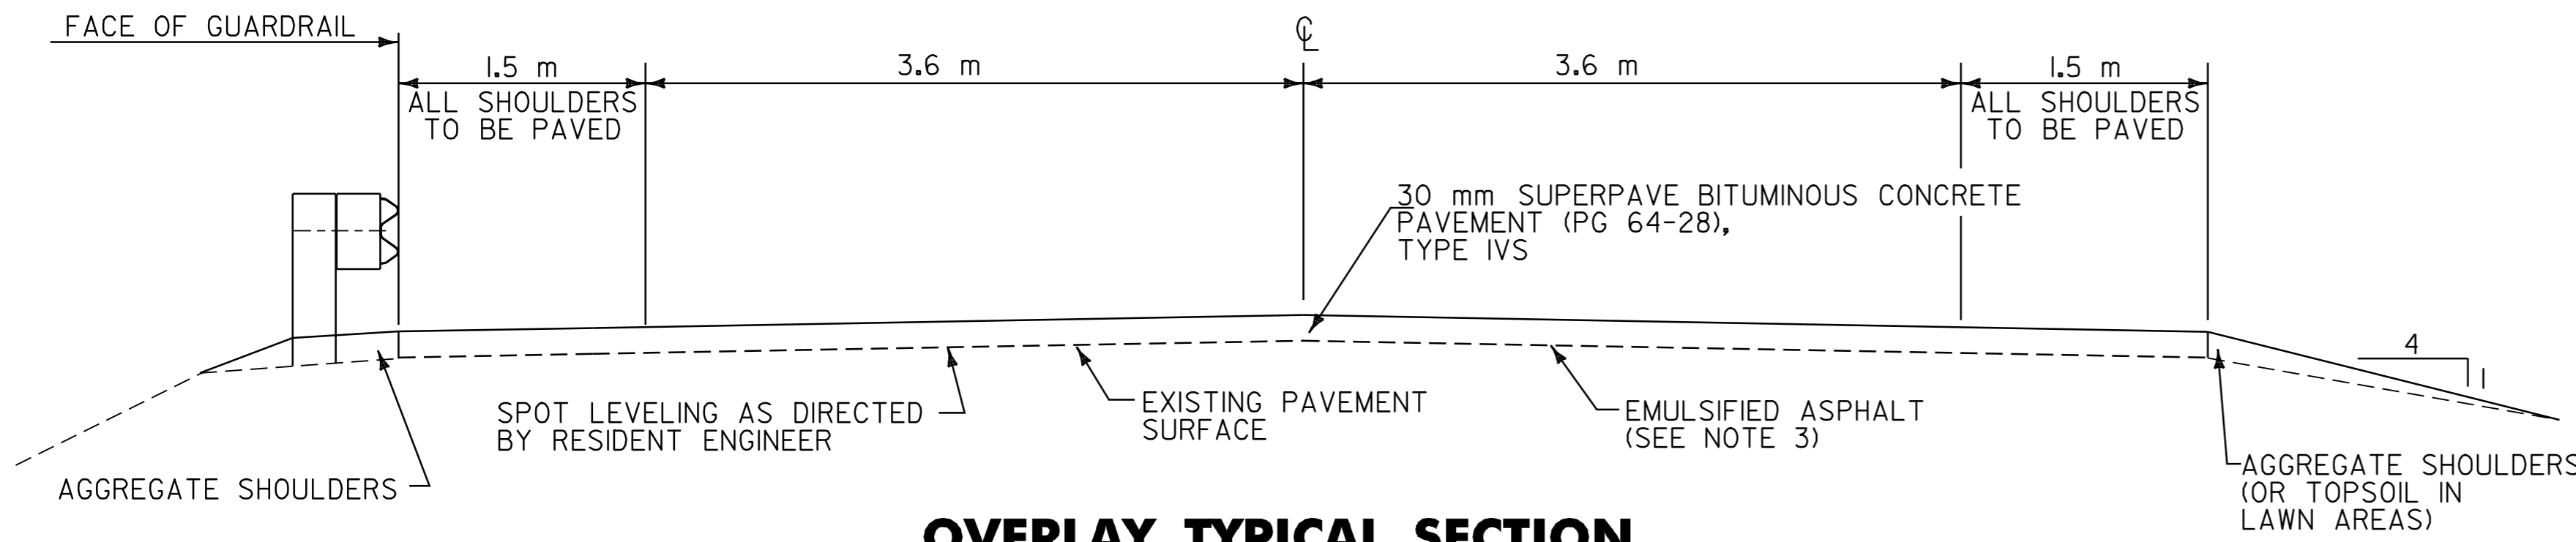

OVERLAY TYPICAL SECTION

VT. ROUTE 9 BENNINGTON STA. 0+000.000 TO BENNINGTON STA. 5+072.652

CONSERVATION SEED MIX

RURAL AREA - SEED MIXTURE				
% WT.	kg/ha.	NAME	PUR. %	GERM. %
37.14	26.0	CREEPING RED FESCUE	98	85
37.14	26.0	TALL FESCUE	95	90
5.71	4.0	RED TOP	95	90
14.30	10.0	BIRDSFOOT TREFOIL	98	85
5.71	4.0	ANNUAL RYEGRASS	95	85
100.0	70.0			

SEED MIXTURE:
SHALL NOT HAVE A WEED CONTENT EXCEEDING 0.40% BY WEIGHT AND SHALL BE FREE OF ALL NOXIOUS WEED SEED.

SEED:
TO BE APPLIED PER SEEDING FORMULA DIRECTED BY THE RESIDENT ENGINEER

FERTILIZER:
FORMULA 10-20-10 TO BE USED WITH SEED, APPLIED AT THE RATE OF 560 kg/ha (HYDRO SEEDERS MAY USE 19-19-19 FORMULA)

AGRICULTURAL LIMESTONE:
TO BE APPLIED AT THE RATE OF 4500 kg/ha OR AS DIRECTED BY THE RESIDENT ENGINEER.

HAY MULCH:
TO BE APPLIED ON EARTH SLOPES AT THE RATE OF 4500 kg/ha, OR AS DIRECTED BY THE RESIDENT ENGINEER.

TOPSOIL:
TO BE USED WITH SEED AS INDICATED ON THE PLANS, OR AS DIRECTED BY THE RESIDENT ENGINEER.


PROJECT PAVING LIMITS

TOWN & ROUTE	BEGIN STATION	END STATION	LANE TYPICAL	WEARING DEPTH	LEVELING †	NOTES
BENNINGTON VT. ROUTE 9	0+000.000	5+072.652	1.5 m - 3.6 m - 3.6 m - 1.5 m	30 mm	466	SPOT LEVEL & PAVE WITH 30 mm TYPE IVS

PROJECT TYPICAL SHEET


SURVEYED BY	N/A	DATE	N/A
DRAWN BY	C.A.K.	DATE	12/00
SQUAD LEADER	T.P.K.		
DESIGN FILE NO.	/pave/99d156/pd156.dgn		
IPARM FILE	pb054pt.i	DATE PLOTTED	\$DATE\$
PROJ. NAME	BENNINGTON		
PROJ. NO.	NH 2225(I)S		
SHEET	82 OF 108	SHEETS	

DATUM	
VERTICAL	N/A
HORIZONTAL	N/A

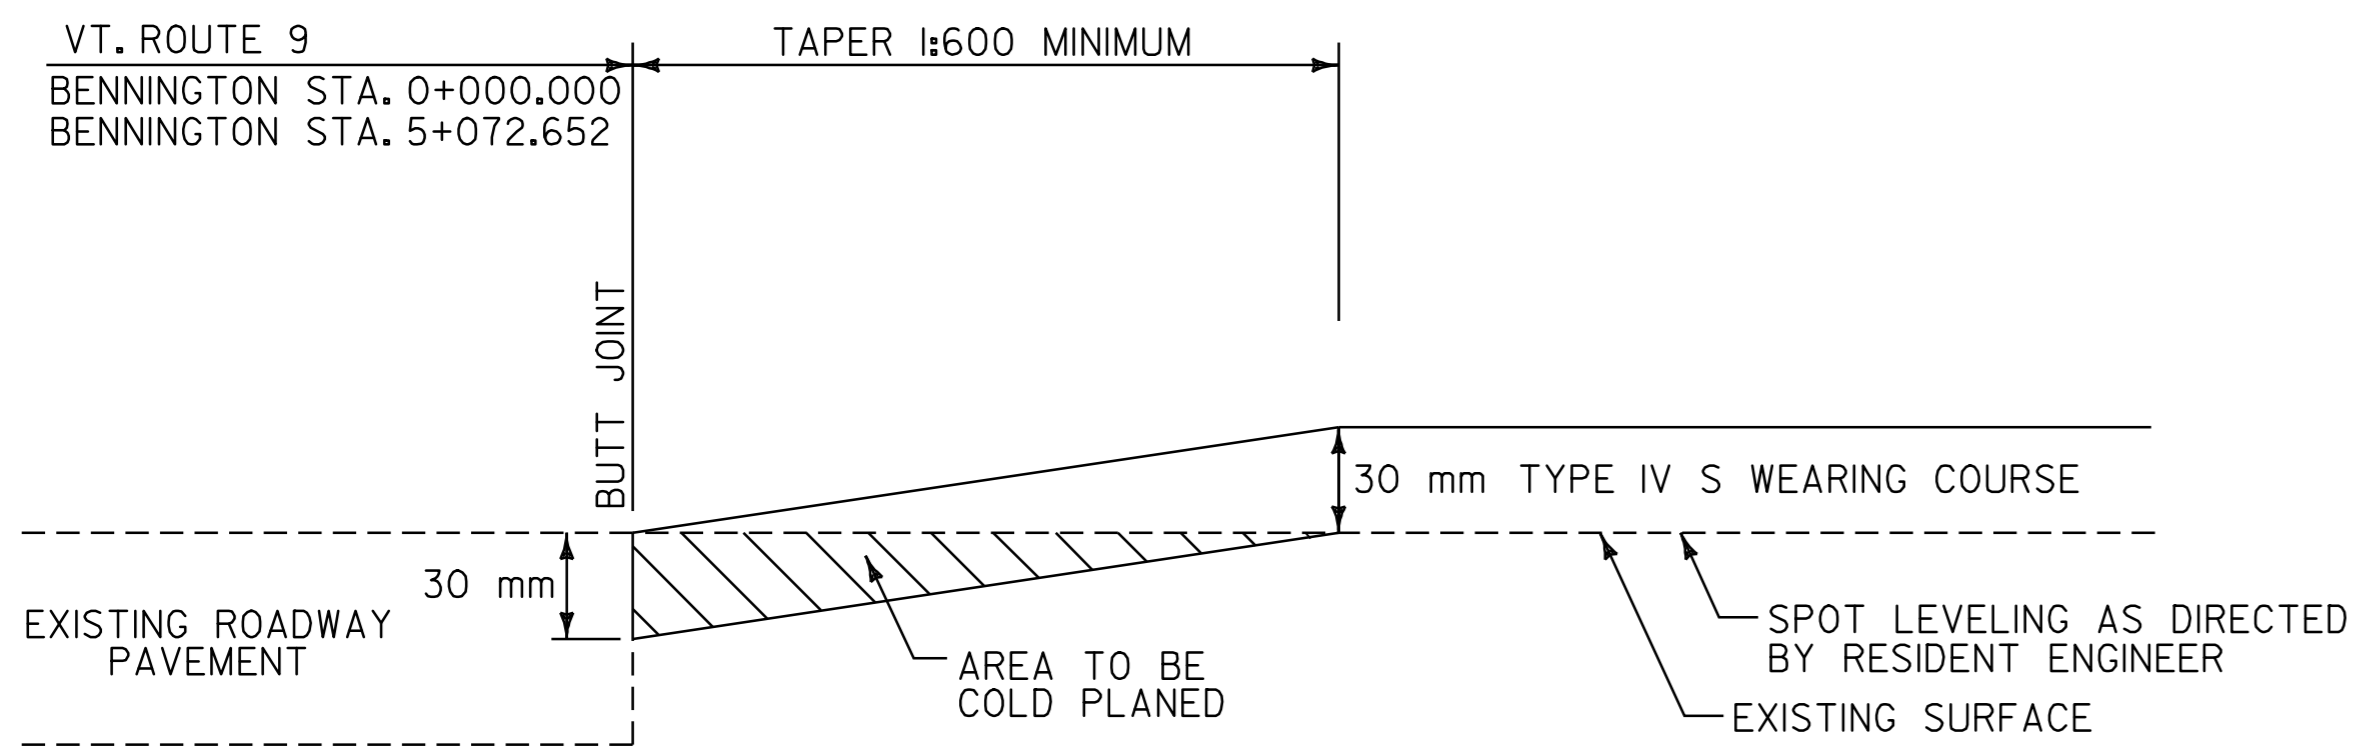


APPROACH AREA DETAIL

VT. ROUTE 9 BENNINGTON STA. 0+000.000 - BEGIN OVERLAY
 VT. ROUTE 9 BENNINGTON STA. 5+072.652 - END OVERLAY

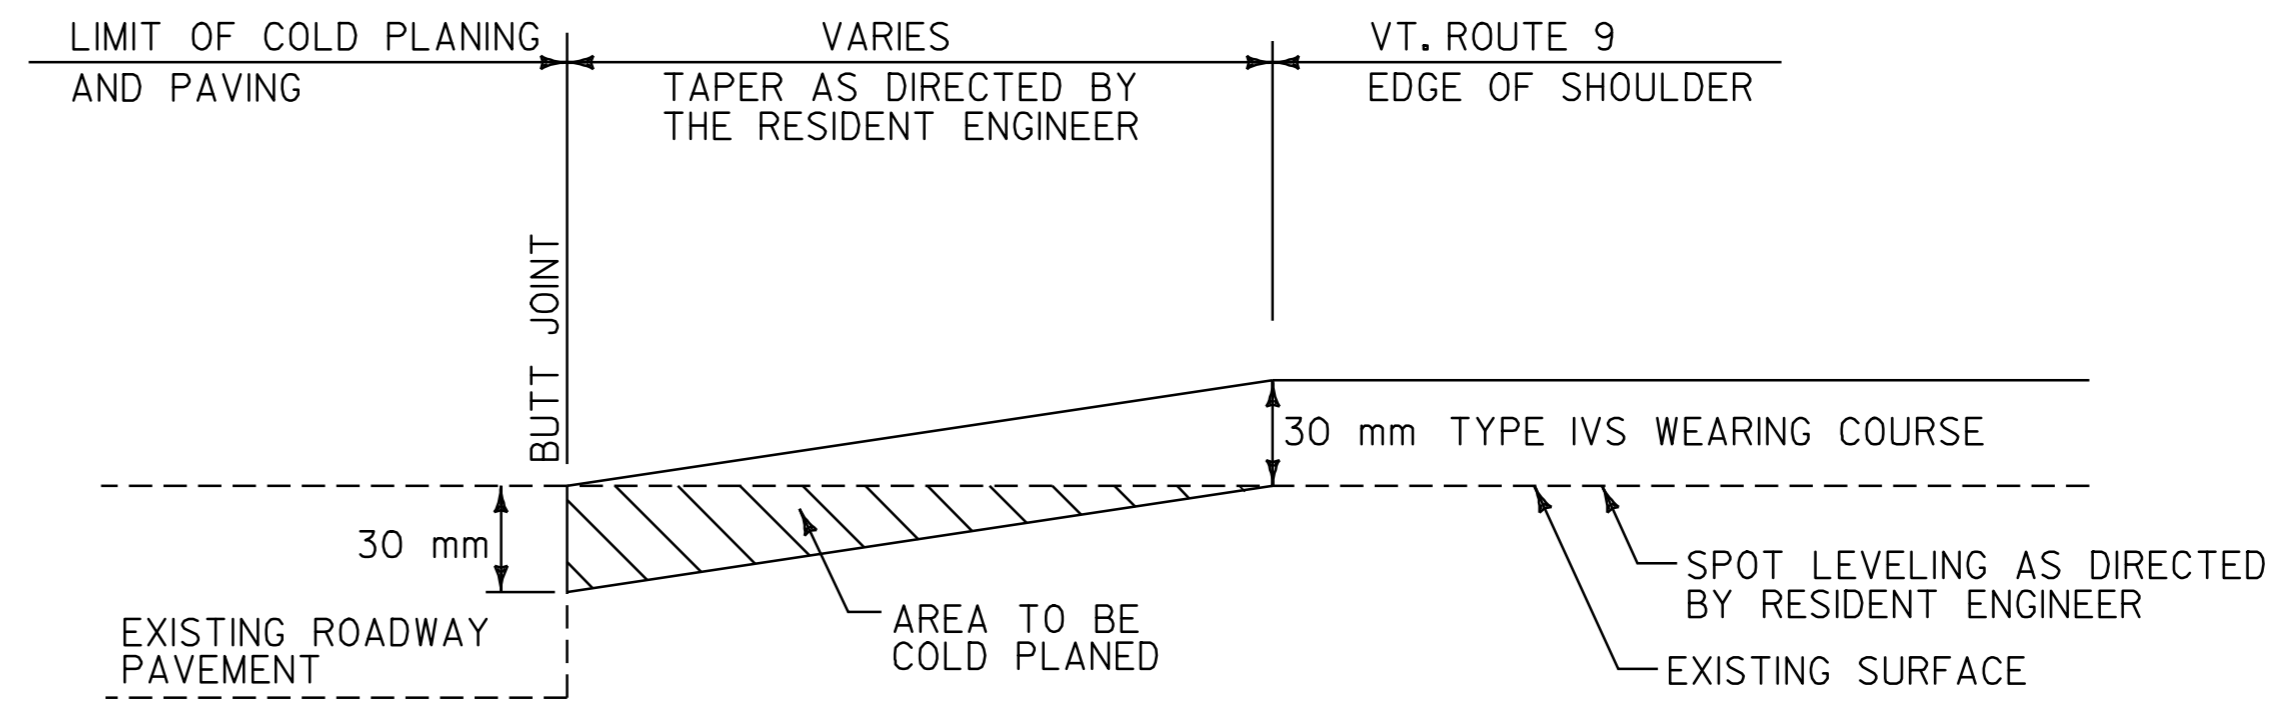

APPROACH AREA DETAIL

T-72 T-46
 T-40 T-39
 T-42 T-12
 T-83 T-12
 T-74

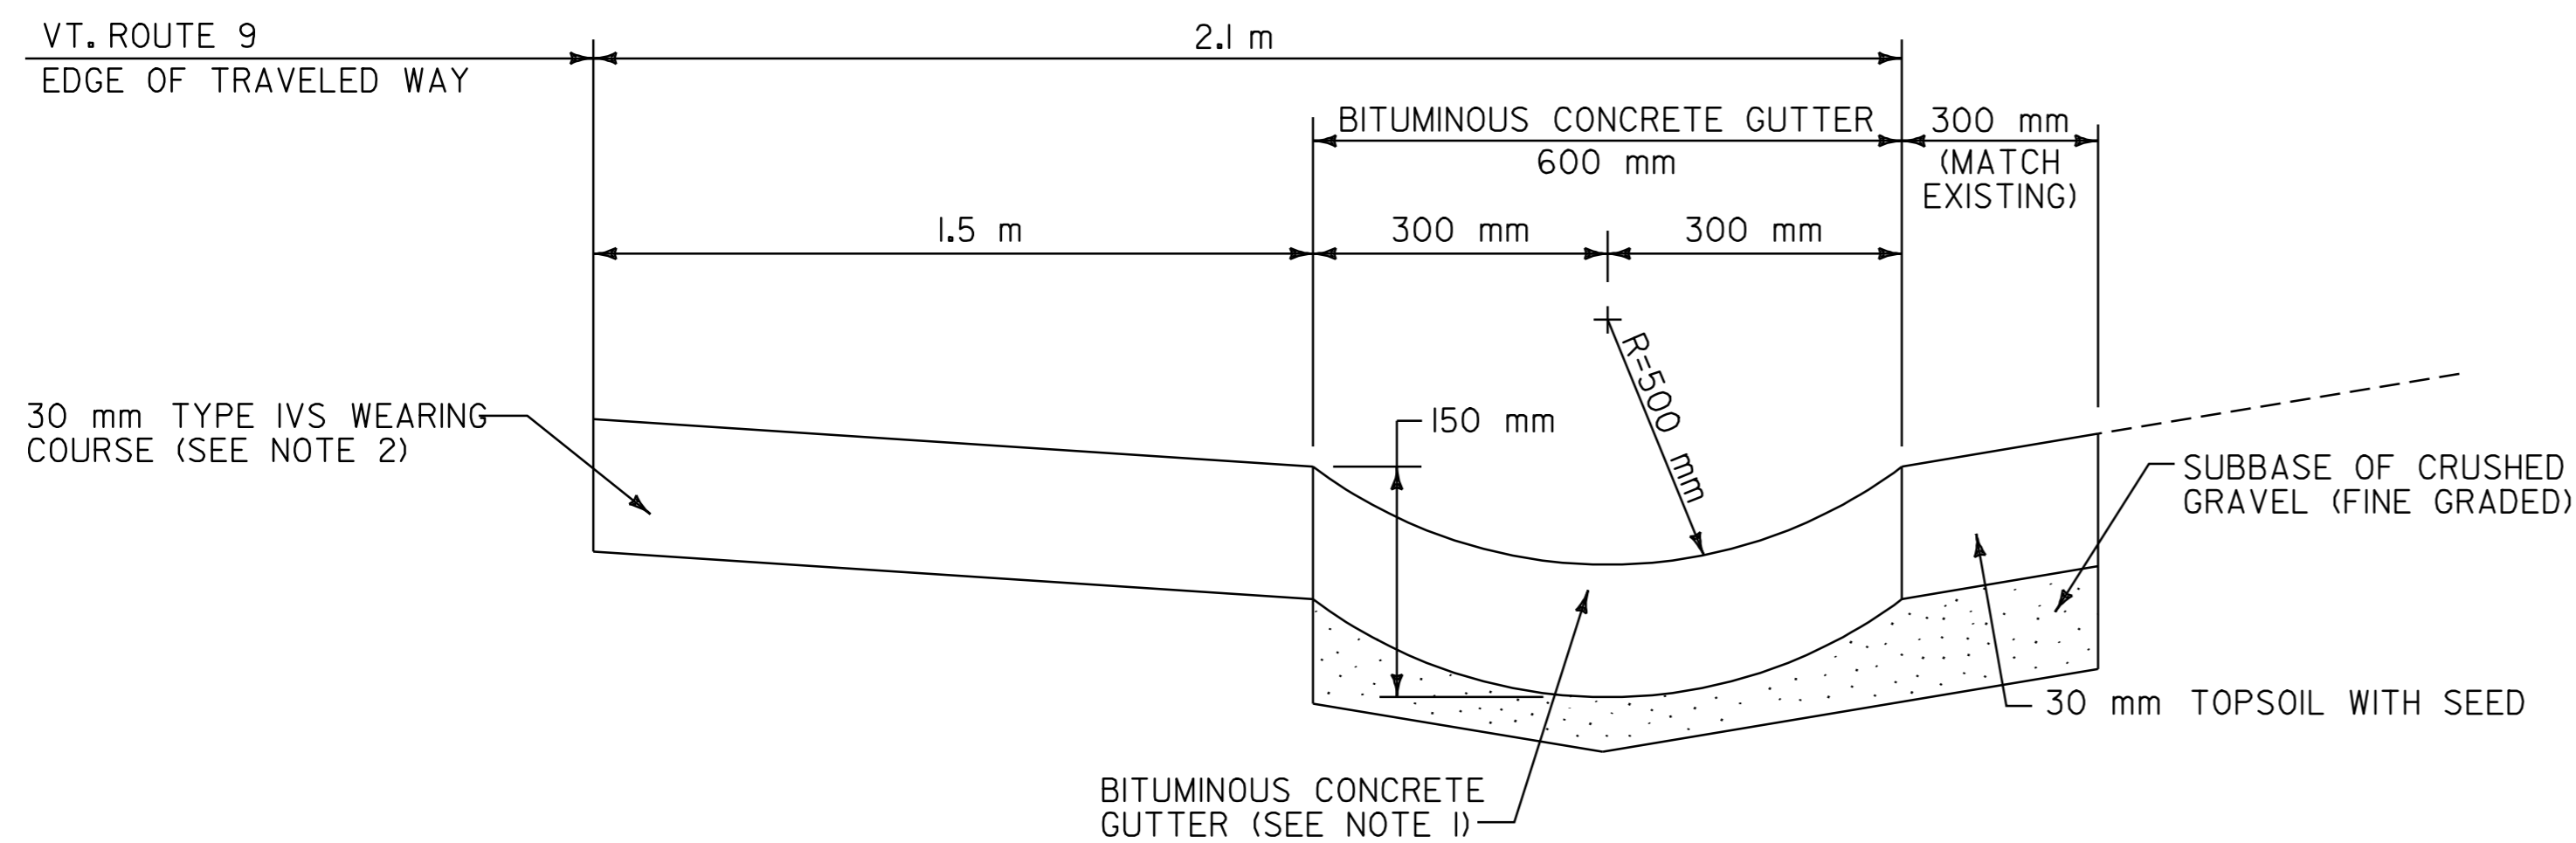

BITUMINOUS CONCRETE GUTTER DETAIL

VT. ROUTE 9 BENNINGTON STA. 0+965.0 - STA. 1+015.0, LT

- NOTES:
1. BITUMINOUS CONCRETE GUTTER TO BE CONSTRUCTED BY PLACING 1-30 mm TYPE IVS BITUMINOUS CONCRETE PAVEMENT LIFT. PAYMENT UNDER ITEM 616.47 BITUMINOUS CONCRETE GUTTERS AND TRAFFIC ISLANDS.
 2. THE 30 mm TYPE IVS WEARING COURSE ADJACENT TO THE TRAVELED WAY SHALL BE PLACED AT THE SAME CROSS SLOPE AS THE TRAVELED WAY. PAYMENT UNDER ITEM 490.30 SUPERPAVE BITUMINOUS CONCRETE PAVEMENT (PG 64-28).

PAVING DETAILS AND PAVEMENT JOINT DETAIL SHEET	SURVEYED BY	N/A	DATE	N/A
	DRAWN BY	C.A.K.	DATE	12/00
	SQUAD LEADER	T.P.K.		
	DESIGN FILE NO.	/pave/99dl56/pd0156.dgn		
	IPARM FILE	pb054pd.i	DATE PLOTTED	\$DATE\$
PROJ. NAME	BENNINGTON			
PROJ. NO.	NH 2225(I)S			
SHEET	83 OF 108	SHEETS		

DATUM	
VERTICAL	N/A
HORIZONTAL	N/A

646.40 DURABLE 100 mm WHITE LINE
(ALL LINES WILL INCLUDE EDGE LINE BREAKS AND RADIUS FOR TOWN HIGHWAYS)


646.41 DURABLE 100 mm YELLOW LINE
(ALL LINES WILL INCLUDE C/L BREAKS FOR TOWN HIGHWAYS) S=SOLID, D=DASHED

675.50 REMOVING SIGNS
AS SHOWN - 17

BENNINGTON:
STA. 0+000.000 - 0+540.000 LT & RT

BENNINGTON:
STA. 0+000.000 - STA. 0+434.5 LT S S
STA. 0+434.5 - STA. 0+540.0 S D

675.60 ERECTING SALVAGED SIGNS
AS SHOWN - 2

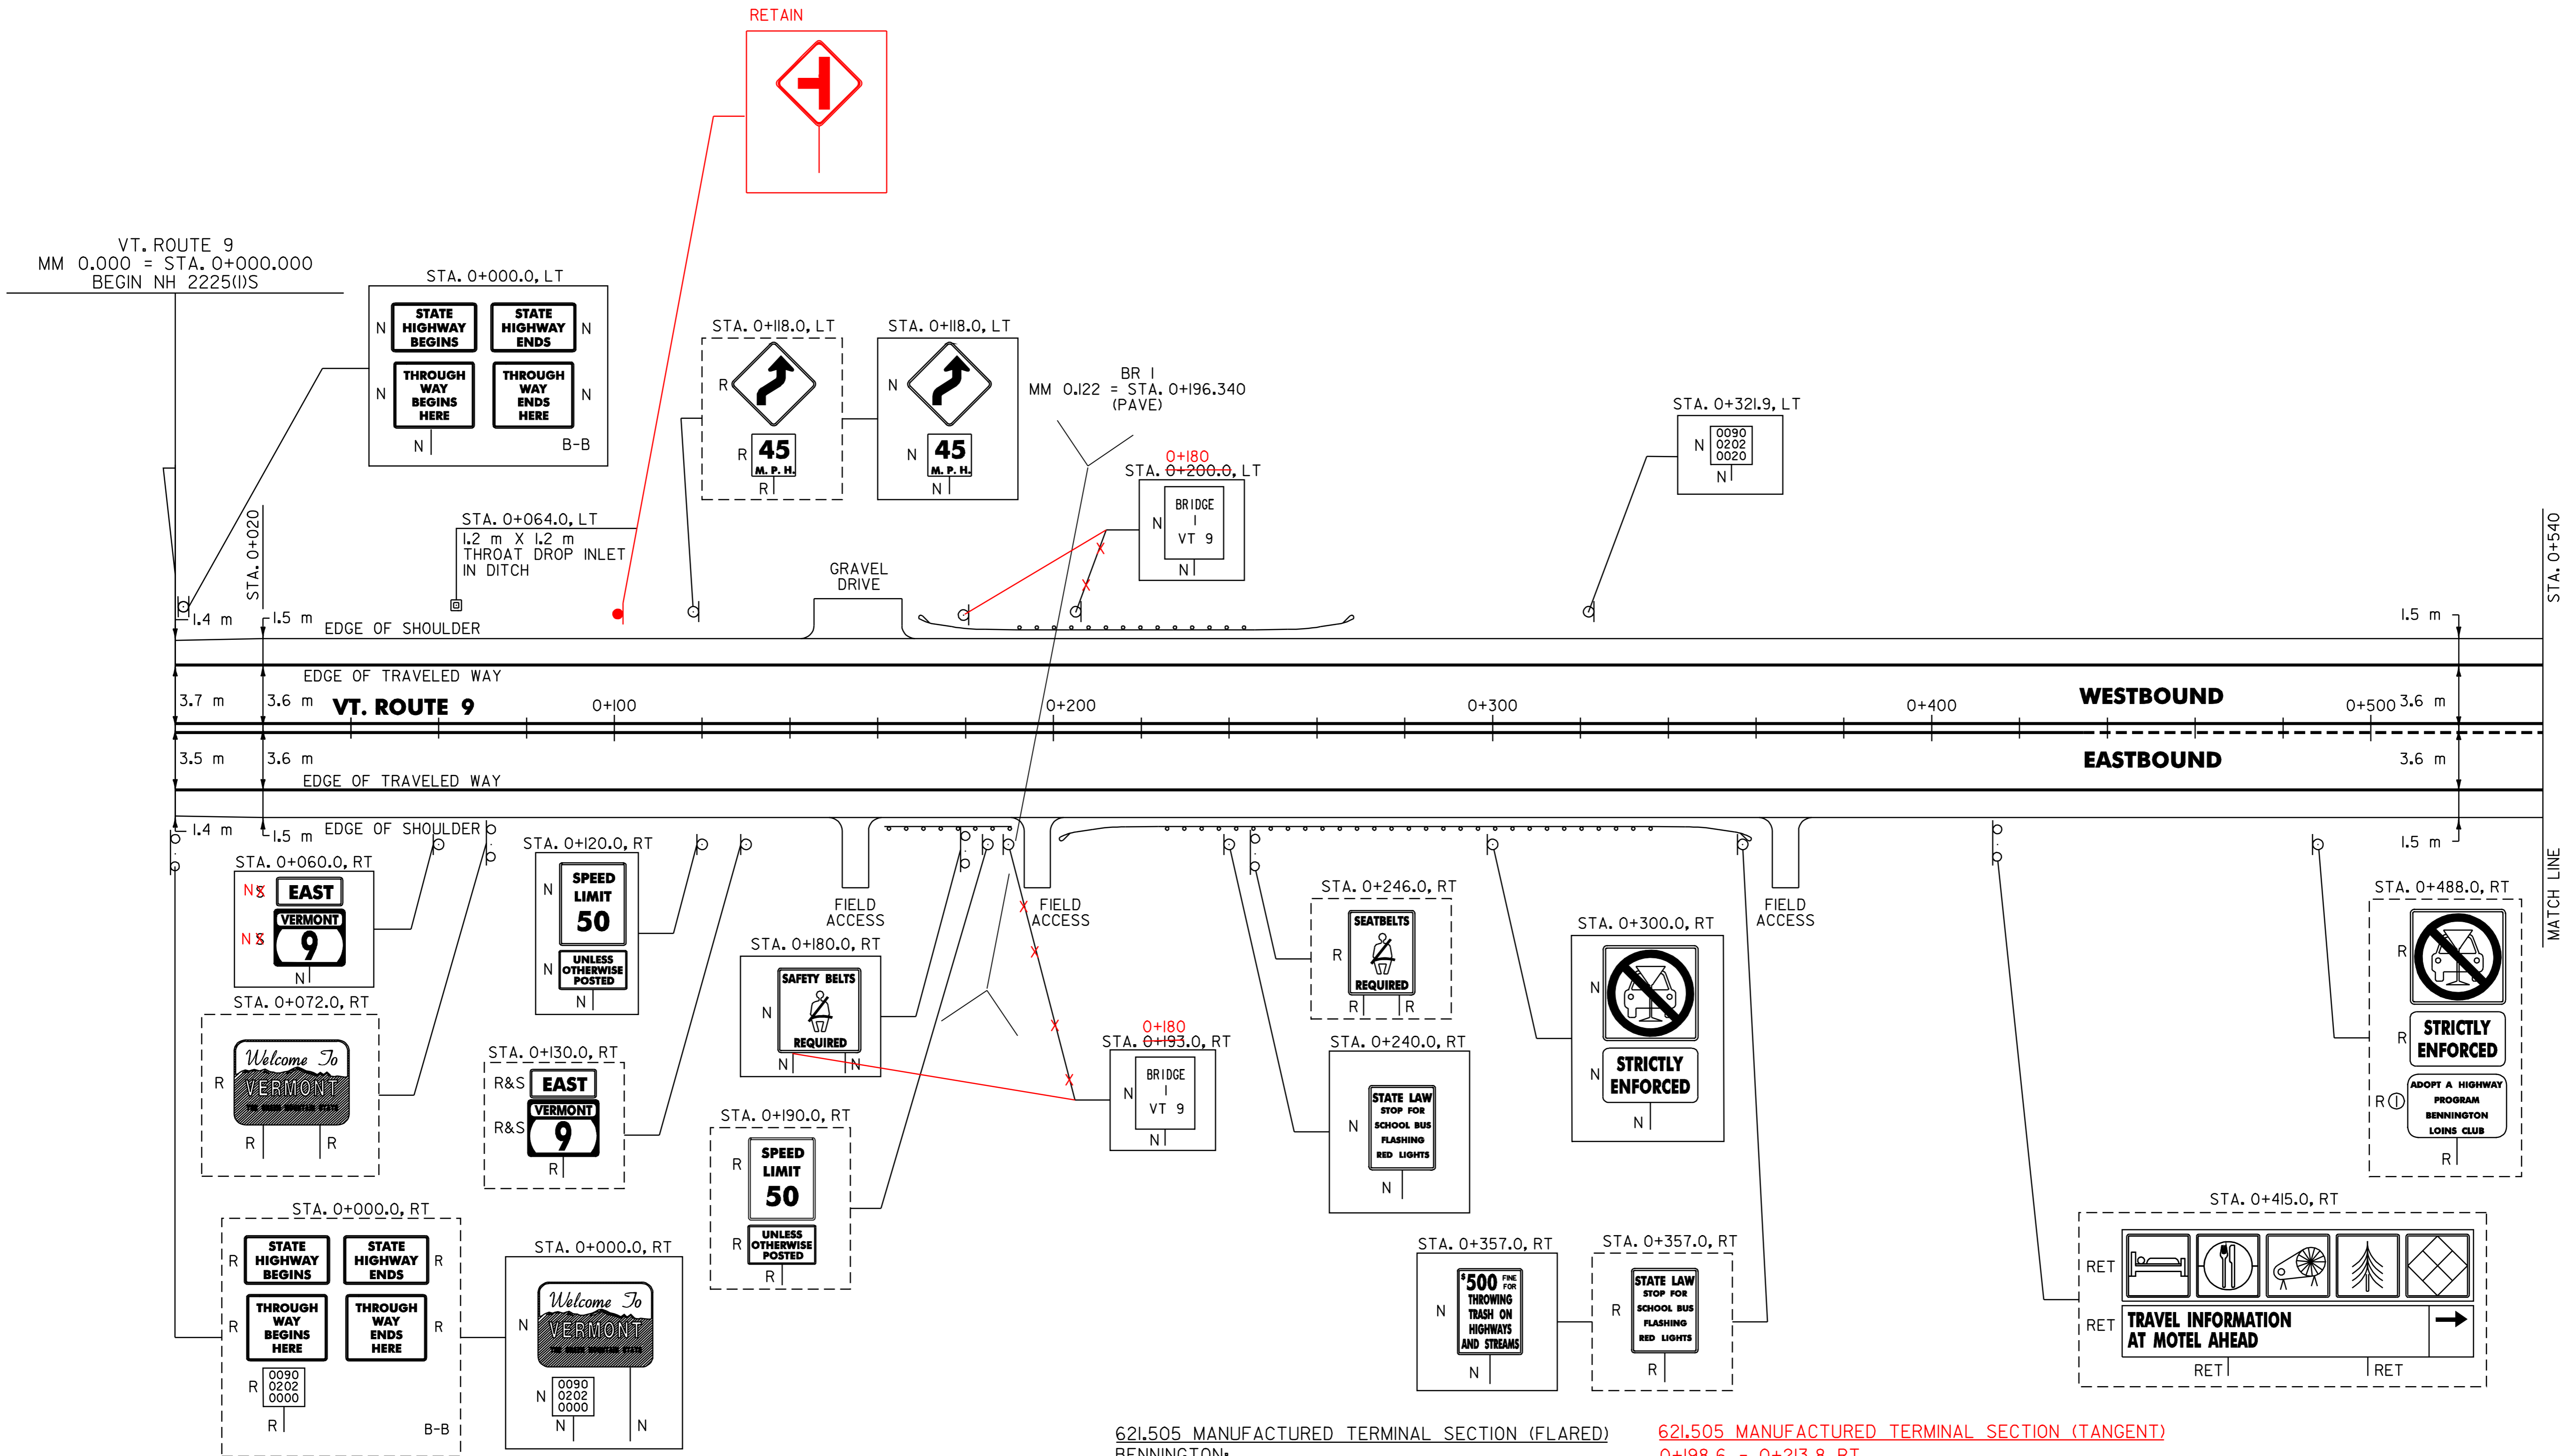

604.412 REHABING DI, CB OR MH, CLASS I
BENNINGTON:
STA. 0+064.0 LT

621.20 STEEL BEAM GUARDRAIL W/2.4 m POSTS (MOD.)
BENNINGTON:
168.9 STA. 0+164.9 - STA. 0+180.1 RT (15.2 m) 0+186.3
177.6 STA. 0+178.4 - STA. 0+258.2 LT (79.8 m) 0+257.6
213.8 STA. 0+209.1 - STA. 0+345.9 RT (136.8 m) 0+351

621.505 MANUFACTURED TERMINAL SECTION (FLARED)
BENNINGTON:
STA. 0+164.9 RT 0+166.2 - 0+177.6 LT
STA. 0+178.4 LT 0+180.3 - 0+191.7 RT
STA. 0+180.1 RT 0+257.6 - 0+269.0 LT
STA. 0+209.1 RT 0+351 - 0+362.4 RT
STA. 0+258.2 LT
STA. 0+345.9 RT

621.505 MANUFACTURED TERMINAL SECTION (TANGENT)
0+198.6 - 0+213.8 RT
0+153.7 - 0+168.9 RT

SIGN LEGEND
R= REMOVE
S= SALVAGE
N= NEW
RET= RETAIN
B-B= BACK TO BACK
EXISTING= -----
NEW= _____
⊙ SIGN TO BE RETURNED TO THE TOWN OF BENNINGTON

PAVING PROJECT LAYOUT # 1

SURVEYED BY	N/A	DATE	N/A
DRAWN BY	C.A.K.	DATE	12/00
SQUAD LEADER	T.P.K.		
DESIGN FILE NO.	/pave/99dl56/pdl56.dgn		
IPARM FILE	pb054101.i	DATE PLOTTED	\$DATE\$
PROJ. NAME	BENNINGTON		
PROJ. NO.	NH 2225(I)S		
SHEET	87 OF 108	SHEETS	

DATUM	
VERTICAL	N/A
HORIZONTAL	N/A


646.40 DURABLE 100 mm WHITE LINE
(ALL LINES WILL INCLUDE EDGE LINE BREAKS AND RADIUS FOR TOWN HIGHWAYS)

BENNINGTON:
STA. 0+540.0 - STA. 1+080.0 LT & RT

646.41 DURABLE 100 mm YELLOW LINE
(ALL LINES WILL INCLUDE C/L BREAKS FOR TOWN HIGHWAYS) S=SOLID, D=DASHED

BENNINGTON:
STA. 0+540.0 - STA. 0+675.9 LT S - D
STA. 0+675.9 - STA. 0+724.2 - D -
STA. 0+724.2 - STA. 0+949.5 D - S
STA. 0+949.5 - STA. 1+080.0 S - S

675.50 REMOVING SIGNS
AS SHOWN - 8

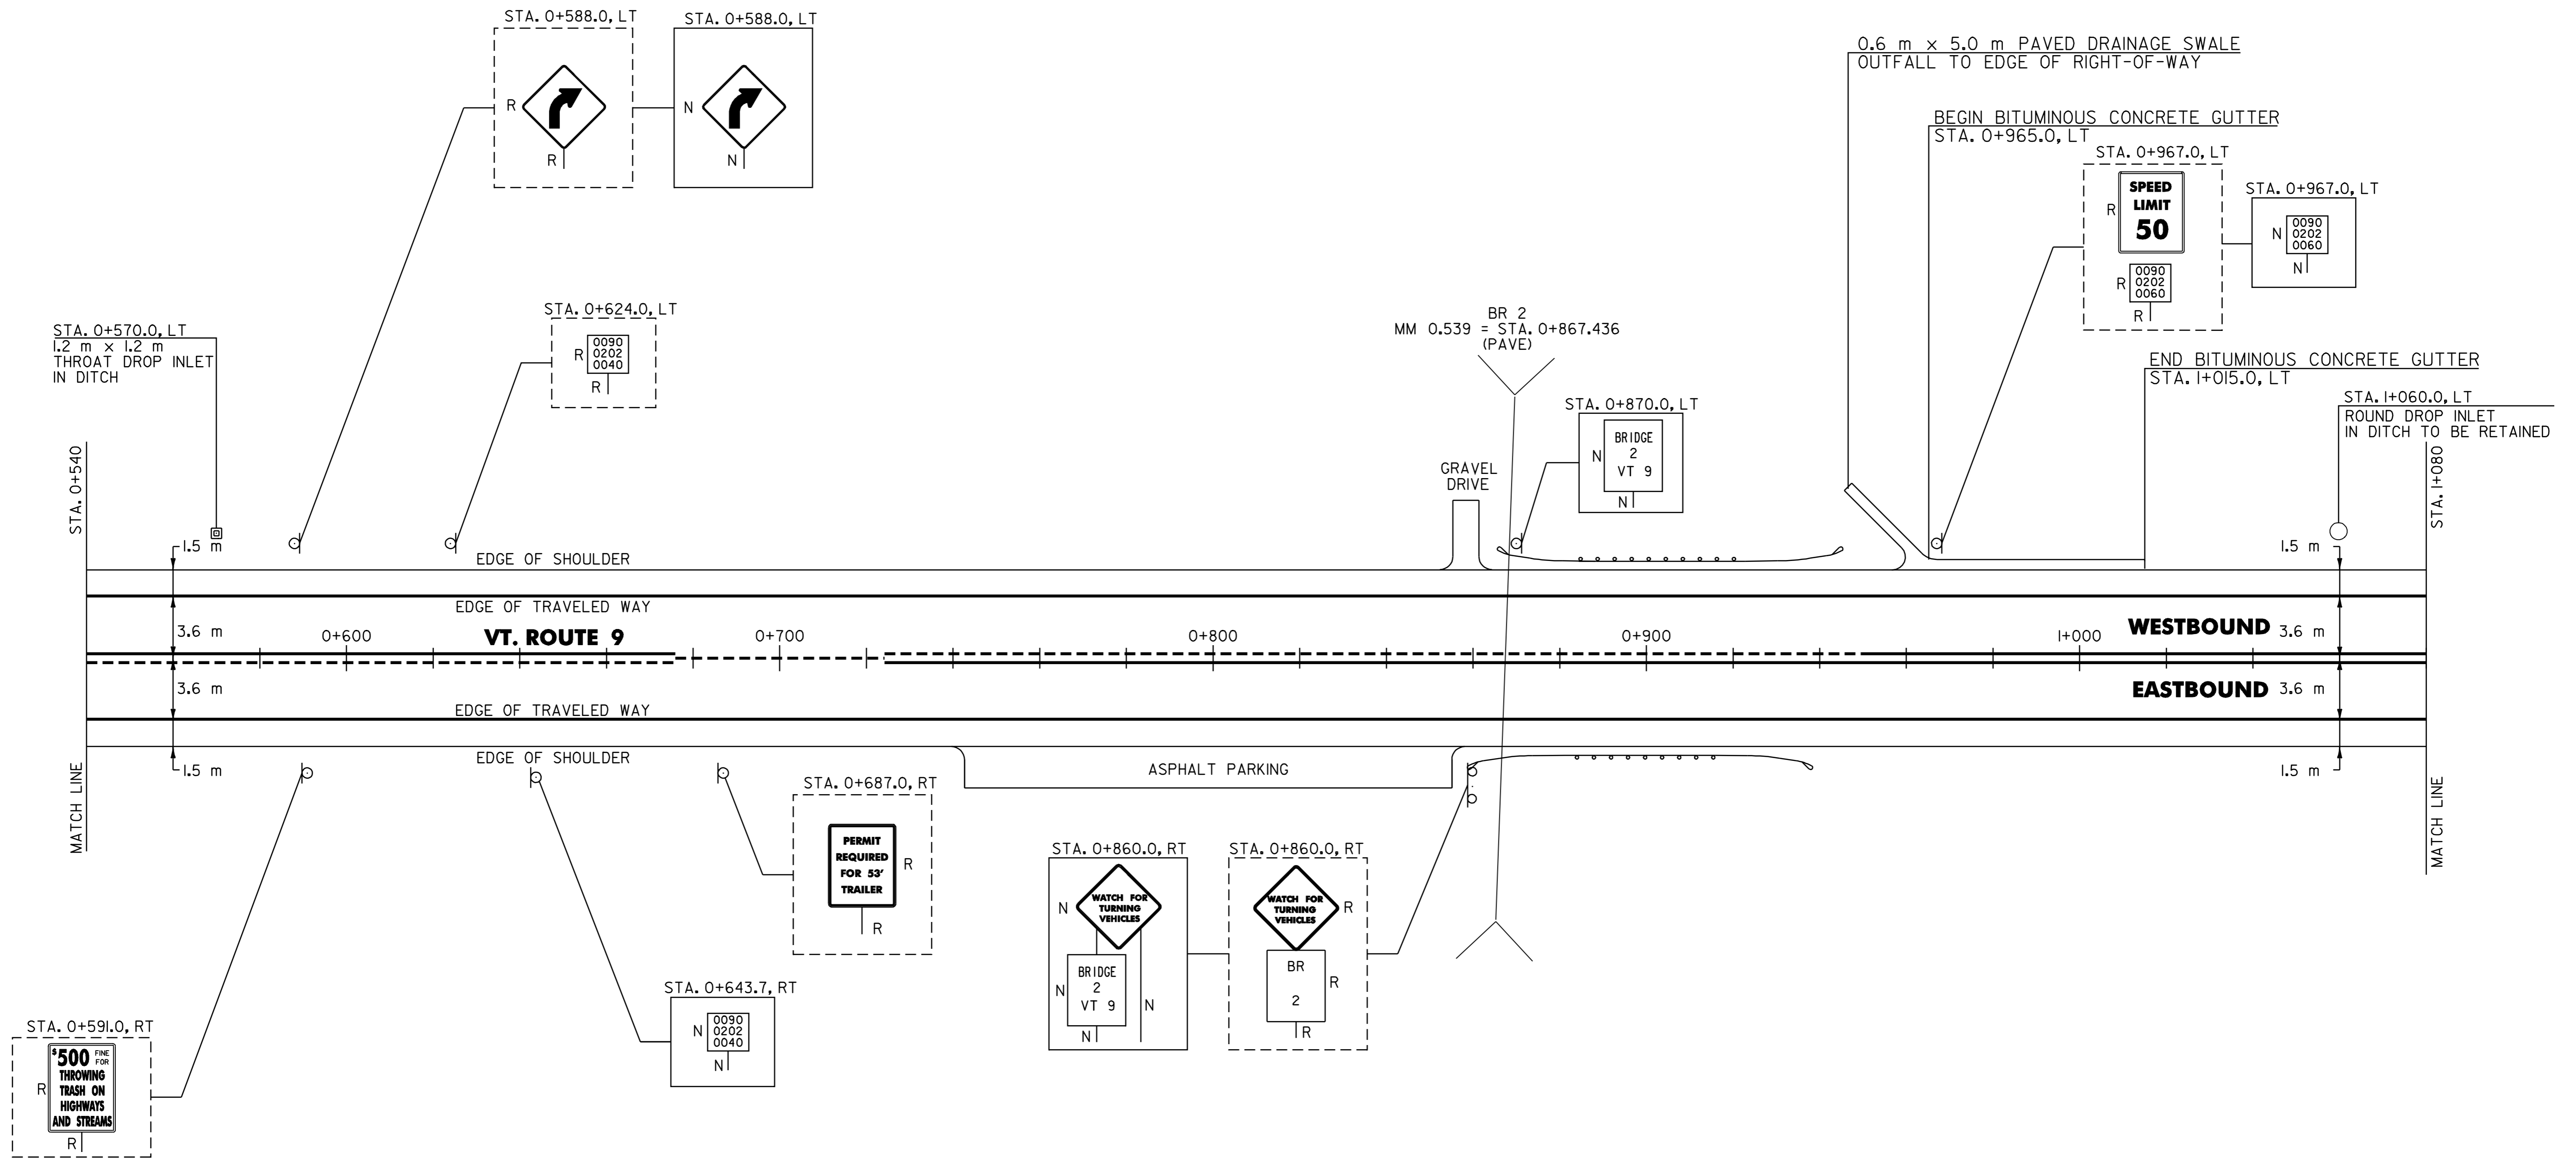

ANCHOR FOR STEEL BEAM GUARD RAIL
STA 0+866.2 LT

604.412 REHABING DI, CB OR MH, CLASS I
BENNINGTON:
STA. 0+570.0 LT

616.47 BITUMINOUS CONCRETE GUTTERS AND TRAFFIC ISLANDS
BENNINGTON:
STA. 0+965.0 - STA. 1+015.0 (5 ±)

621.20 STEEL BEAM GUARDRAIL W/2.4 m POSTS (MOD.)
BENNINGTON:

0+874.8 STA. 0+868.8 - STA. 0+925.8 RT (57.0 m) 0+970.1
0+862.4 STA. 0+878.6 - STA. 0+935.6 LT (57.0 m) 0+912.5

621.505 MANUFACTURED TERMINAL SECTION (FLARED)

BENNINGTON:
STA. 0+868.8 RT 0+863.4 - 0+879.9 RT
STA. 0+878.6 LT
STA. 0+925.8 RT 0+970.1 - 0+982.5 RT
STA. 0+935.6 LT 0+912.5 - 0+923.9 LT

621.80 REMOVAL AND DISPOSAL OF GUARDRAIL

BENNINGTON:
STA. 0+858.0 - STA. 0+912.0 RT (54.0 m)
STA. 0+867.0 - STA. 0+917.0 LT (50.0 m)

SIGN LEGEND
R= REMOVE
S= SALVAGE
N= NEW
RET= RETAIN
B-B= BACK TO BACK
EXISTING= - - - - -
NEW= _____

<h2>PAVING PROJECT LAYOUT # 2</h2>	SURVEYED BY	N/A	DATE	N/A
	DRAWN BY	C.A.K.	DATE	12/00
	SQUAD LEADER	T.P.K.		
	DESIGN FILE NO.	/pave/99dl56/pdl56.dgn		
	IPARM FILE	pb054102.i	DATE PLOTTED	\$DATE\$
PROJ. NAME	BENNINGTON			
PROJ. NO.	NH 2225(I)S			
SHEET	88 OF 108	SHEETS		

DATUM	
VERTICAL	N/A
HORIZONTAL	N/A

646.40 DURABLE 100 mm WHITE LINE
(ALL LINES WILL INCLUDE EDGE LINE BREAKS AND RADIUS FOR TOWN HIGHWAYS)

BENNINGTON:
STA. I+080.0 - STA. I+620.0 LT & RT

646.41 DURABLE 100 mm YELLOW LINE
(ALL LINES WILL INCLUDE C/L BREAKS FOR TOWN HIGHWAYS) S=SOLID, D=DASHED

BENNINGTON:
STA. I+080.0 - STA. I+620.0 LT S
STA. I+393.692 DOUBLE SOLID LT, T-72
STA. I+599.688 DOUBLE SOLID RT, T-42

646.61 TEMPORARY 100 mm YELLOW LINE

BENNINGTON:
STA. I+393.692 DOUBLE SOLID LT, T-72
STA. I+599.688 DOUBLE SOLID RT, T-42

646.46 DURABLE 600 mm STOP BAR

BENNINGTON:
STA. I+393.692 LT, T-72
STA. I+599.688 RT, T-42

646.66 TEMPORARY 600 mm STOP BAR

BENNINGTON:
STA. I+393.692 LT, T-72
STA. I+599.688 RT, T-42

646.50 DURABLE LETTER OR SYMBOL

BENNINGTON:
STA. I+393.692 LT, T-72, 'S,T,O,P' (4 EA)
STA. I+599.688 RT, T-42, 'S,T,O,P' (4 EA)

646.70 TEMPORARY LETTER OR SYMBOL


BENNINGTON:
STA. I+393.692 LT, T-72, 'S,T,O,P' (4 EA)
STA. I+599.688 RT, T-42, 'S,T,O,P' (4 EA)

675.50 REMOVING SIGNS

AS SHOWN - 16

675.60 ERECTING SALVAGED SIGNS

AS SHOWN - 3

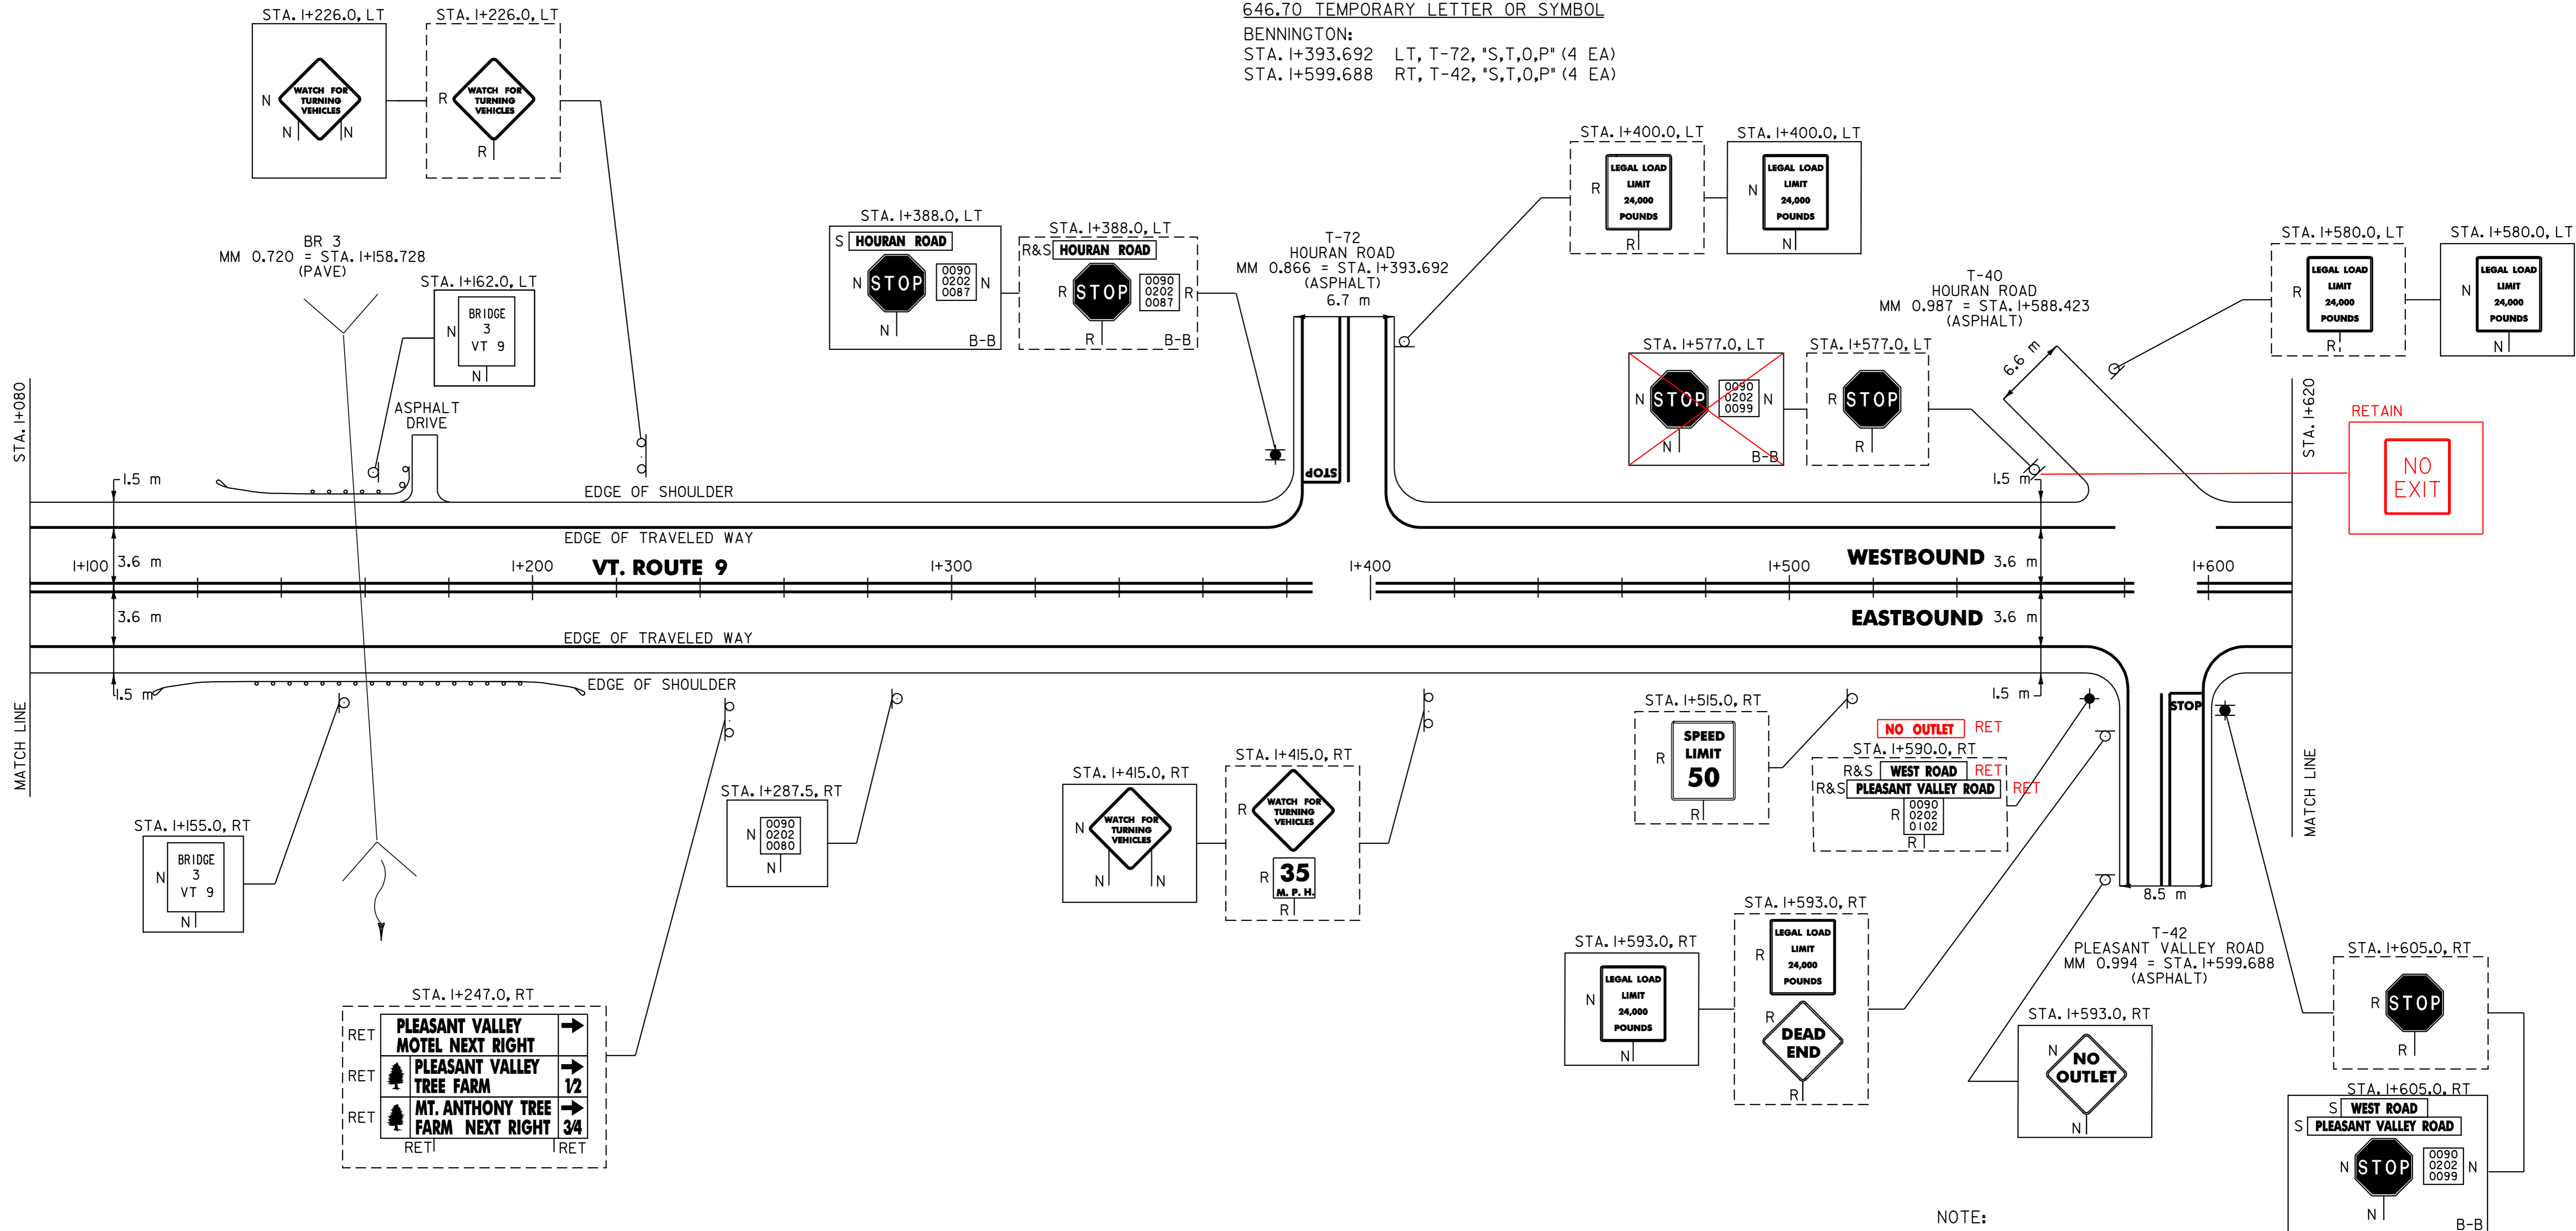

NOTE:
I. PAVING LIMIT ON ALL TOWN HIGHWAYS SHALL BE MEASURED 8 m BACK FROM VT. ROUTE 9 EDGE OF SHOULDER UNLESS DENOTED OTHERWISE ON THE PLANS OR AS DIRECTED BY THE RESIDENT ENGINEER.

621.20 STEEL BEAM GUARDRAIL W/2.4 m POSTS (MOD.)

BENNINGTON:
0+108.5 STA. I+09.6 - STA. I+212.2 RT (102.6 m)
STA. I+124.8 - STA. I+155.2 LT (30.4 m)
0+122.9 I+161LT

621.505 MANUFACTURED TERMINAL SECTION (FLARED)

BENNINGTON:
STA. I+09.6 RT I+097.1 - I+168.5 RT
STA. I+124.8 LT I+111.5 - I+122.9 LT
STA. I+155.2 LT
STA. I+212.2 RT I+211.4 - I+222.8 RT

621.80 REMOVAL AND DISPOSAL OF GUARDRAIL

BENNINGTON:
STA. I+101.0 - STA. I+201.0 RT (100.0 m)
STA. I+115.0 - STA. I+166.0 LT (51.0 m)

DATUM	
VERTICAL	N/A
HORIZONTAL	N/A

SIGN LEGEND

R=	REMOVE
S=	SALVAGE
N=	NEW
RET=	RETAIN
B-B=	BACK TO BACK
EXISTING=	-----
NEW=	_____

PAVING PROJECT LAYOUT # 3

SURVEYED BY	N/A	DATE	N/A
DRAWN BY	C.A.K.	DATE	12/00
SQUAD LEADER	T.P.K.		
DESIGN FILE NO.	/pave/99d156/pd156.dgn		
IPARM FILE	pb054103.1	DATE PLOTTED	\$DATE\$
PROJ. NAME	BENNINGTON		
PROJ. NO.	NH 2225(I)S		
SHEET	89 OF 108	SHEETS	

646.40 DURABLE 100 mm WHITE LINE
 (ALL LINES WILL INCLUDE EDGE LINE BREAKS AND RADIUS FOR TOWN HIGHWAYS)

BENNINGTON:
 STA. I+620.0 - STA. 2+160.0 LT & RT

646.41 DURABLE 100 mm YELLOW LINE
 (ALL LINES WILL INCLUDE C/L BREAKS FOR TOWN HIGHWAYS) S=SOLID, D=DASHED

BENNINGTON: LT C RT
 STA. I+620.0 - STA. 2+160.0 S - S
 STA. I+654.406 DOUBLE SOLID LT, T-83
 STA. I+995.587 DOUBLE SOLID LT, T-74

646.61 TEMPORARY 100 mm YELLOW LINE

BENNINGTON:
 STA. I+654.406 DOUBLE SOLID LT, T-83
 STA. I+995.587 DOUBLE SOLID LT, T-74

646.46 DURABLE 600 mm STOP BAR

BENNINGTON:
 STA. I+654.406 LT, T-83
 STA. I+995.587 LT, T-74

646.66 TEMPORARY 600 mm STOP BAR

BENNINGTON:
 STA. I+654.406 LT, T-83
 STA. I+995.587 LT, T-74

646.50 DURABLE LETTER OR SYMBOL

BENNINGTON:
 STA. I+654.406 LT, T-83, 'S,T,O,P' (4 EA)
 STA. I+995.587 LT, T-74, 'S,T,O,P' (4 EA)

646.70 TEMPORARY LETTER OR SYMBOL


BENNINGTON:
 STA. I+654.406 LT, T-83, 'S,T,O,P' (4 EA)
 STA. I+995.587 LT, T-74, 'S,T,O,P' (4 EA)

675.50 REMOVING SIGNS

AS SHOWN - 12

675.60 ERECTING SALVAGED SIGNS

AS SHOWN - 3

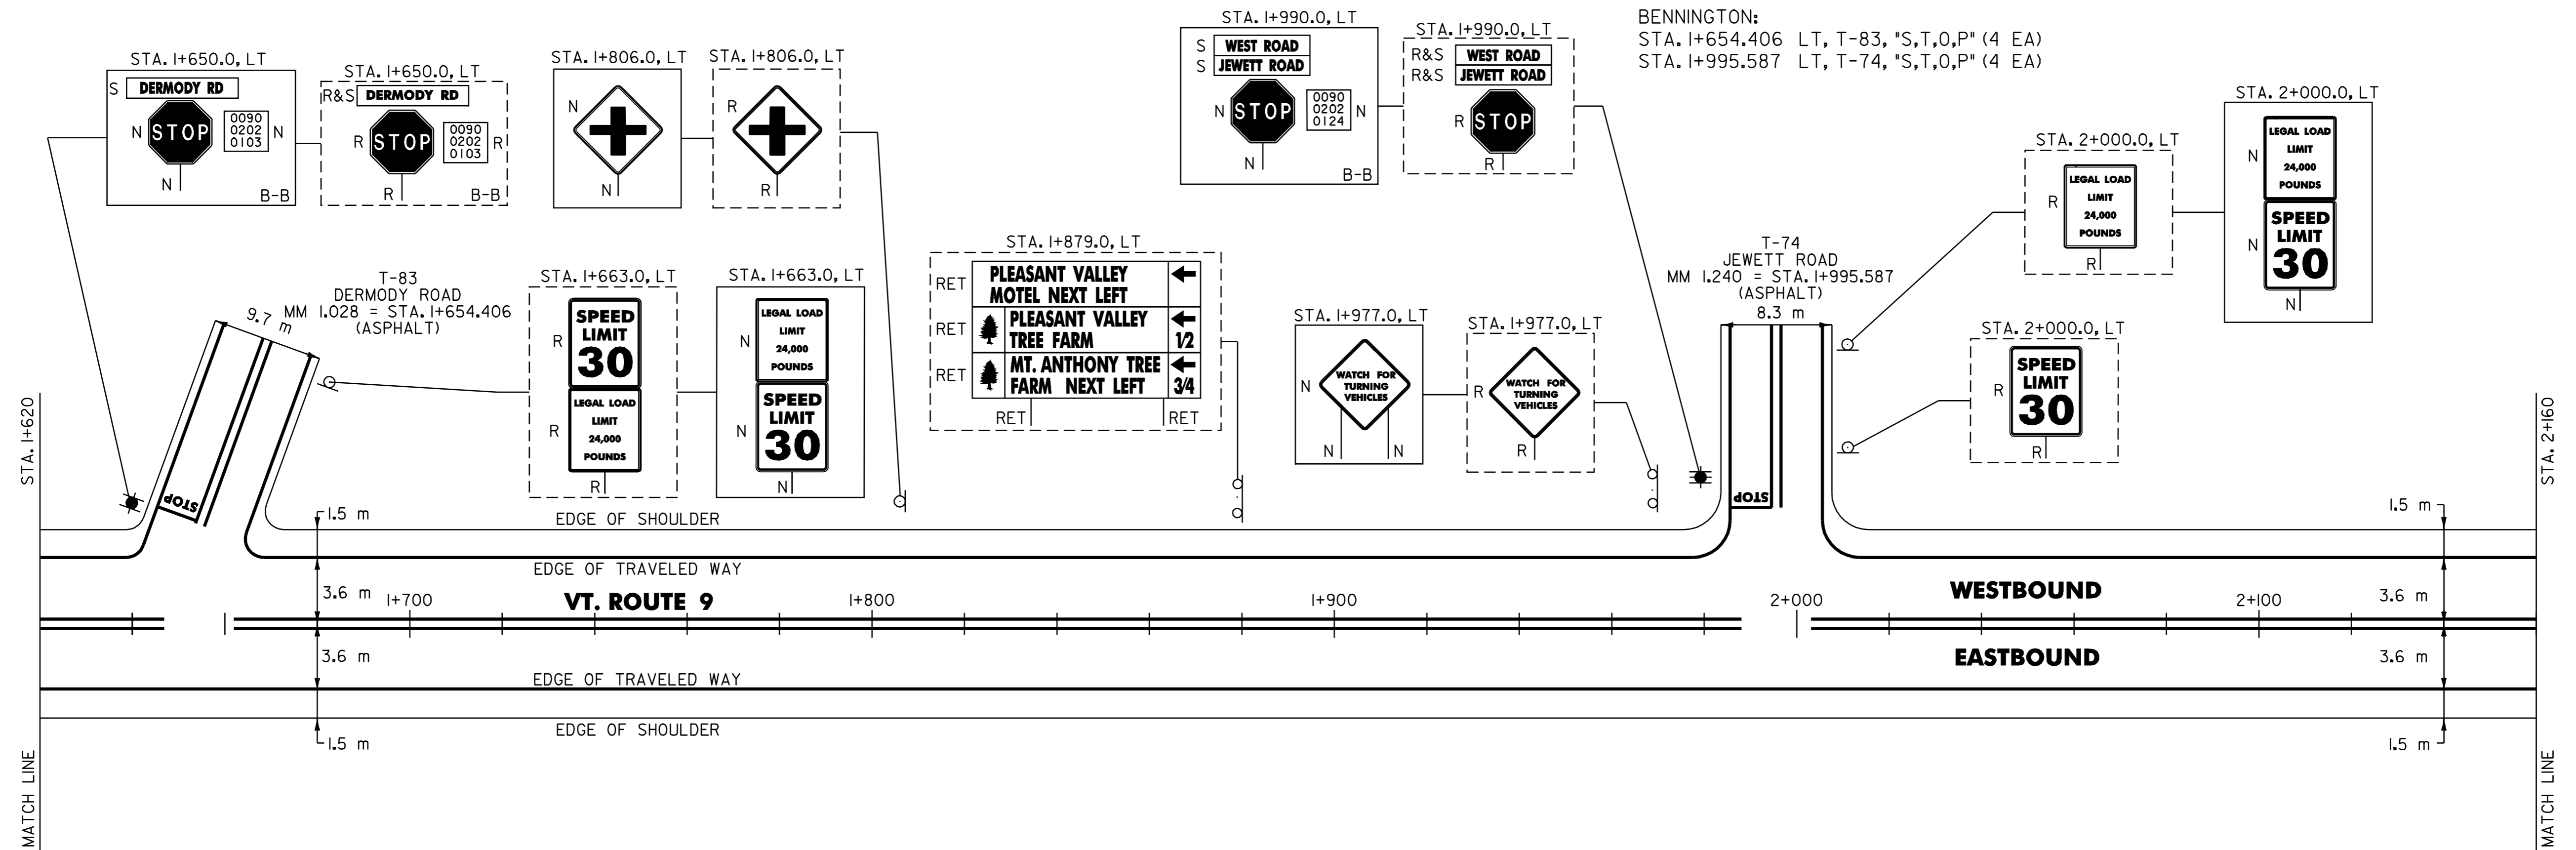

NOTE:

- PAVING LIMIT ON ALL TOWN HIGHWAYS SHALL BE MEASURED 8 m BACK FROM VT. ROUTE 9 EDGE OF SHOULDER UNLESS DENOTED OTHERWISE ON THE PLANS OR AS DIRECTED BY THE RESIDENT ENGINEER.

DATUM	
VERTICAL	N/A
HORIZONTAL	N/A

SIGN LEGEND
 R= REMOVE
 S= SALVAGE
 N= NEW
 RET= RETAIN
 B-B= BACK TO BACK
 EXISTING= _____
 NEW= _____

PAVING PROJECT LAYOUT # 4

SURVEYED BY	N/A	DATE	N/A
DRAWN BY	C.A.K.	DATE	12/00
SQUAD LEADER	T.P.K.		
DESIGN FILE NO.	/pave/99dl56/pdl56.dgn		
IPARM FILE	pb054104.i	DATE PLOTTED	\$DATE\$
PROJ. NAME	BENNINGTON		
PROJ. NO.	NH 2225(I)S		
SHEET	90 OF 108	SHEETS	


646.40 DURABLE 100 mm WHITE LINE
 (ALL LINES WILL INCLUDE EDGE LINE BREAKS AND RADIUS FOR TOWN HIGHWAYS)

BENNINGTON:
 STA. 2+160.0 - STA. 2+700.0 LT & RT

646.41 DURABLE 100 mm YELLOW LINE
 (ALL LINES WILL INCLUDE C/L BREAKS FOR TOWN HIGHWAYS) S=SOLID, D=DASHED

BENNINGTON: LT C RT
 STA. 2+160.0 - STA. 2+700.0 S - S

675.50 REMOVING SIGNS
 AS SHOWN - 8

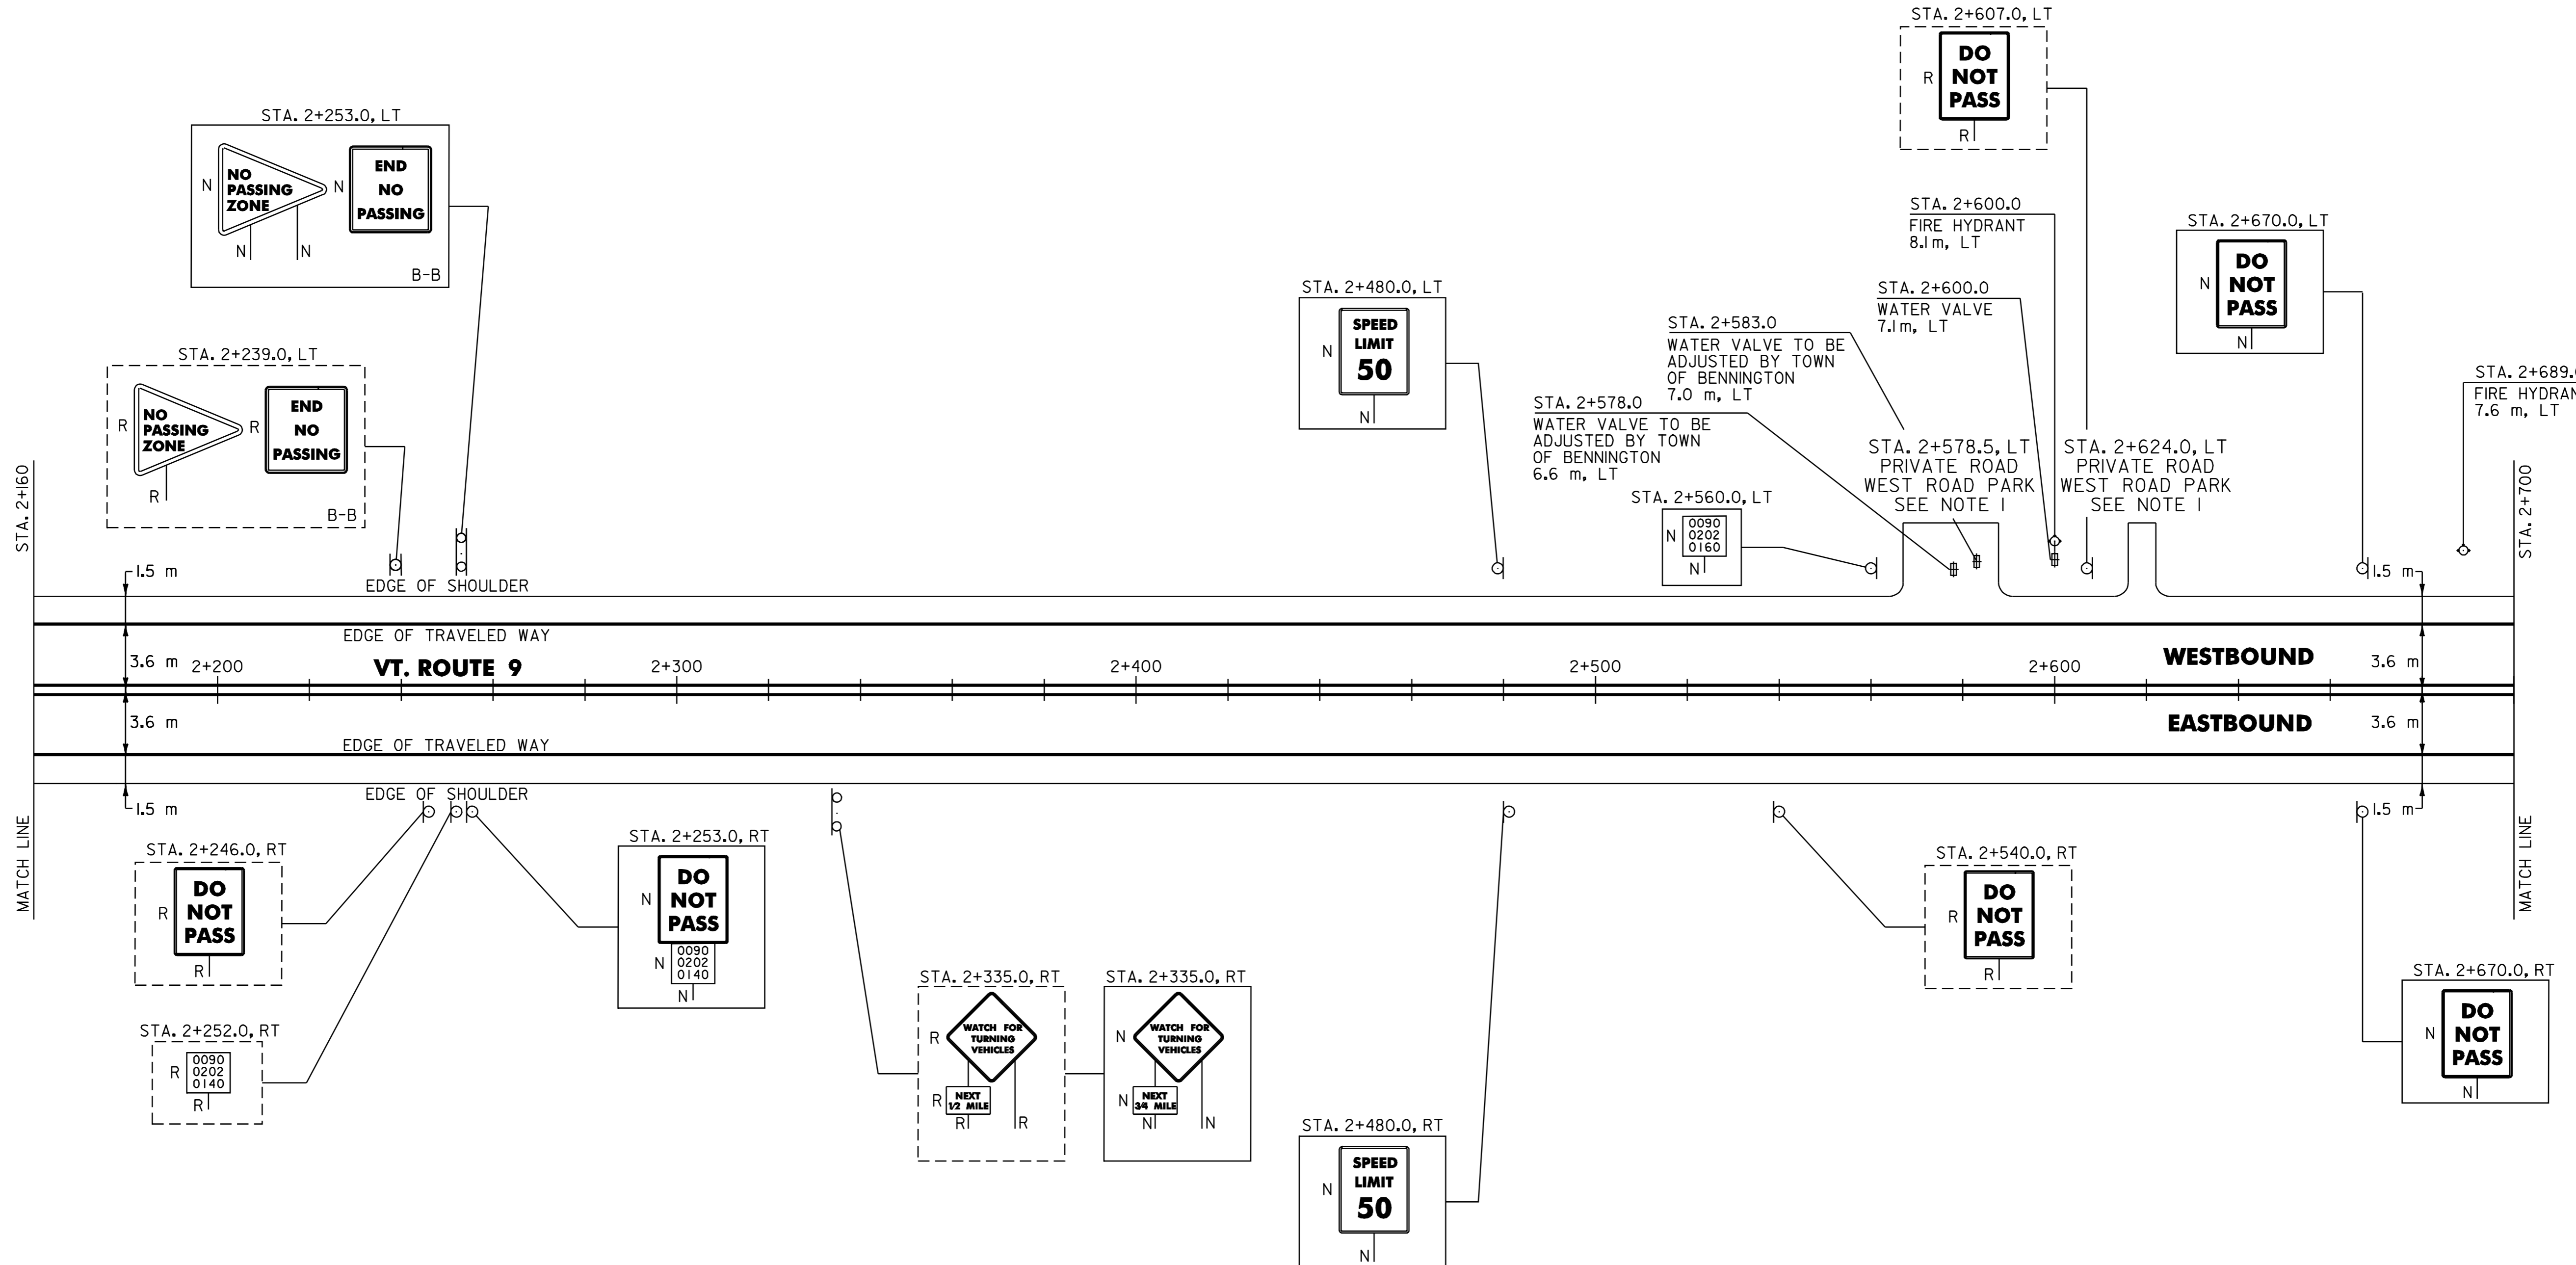

NOTE:
 I. PROVIDE A 30 mm TYPE IVS 5 m WIDE APRON FOR THE EXISTING PRIVATE ROAD. ANY REQUIRED EXCAVATION SHALL BE PERFORMED AS DIRECTED BY THE RESIDENT ENGINEER AND PAID FOR UNDER ITEM 210.10 OR 608.25.

DATUM	
VERTICAL	N/A
HORIZONTAL	N/A

SIGN LEGEND
 R= REMOVE
 S= SALVAGE
 N= NEW
 RET= RETAIN
 B-B= BACK TO BACK
 EXISTING= - - - - -
 NEW= _____

<h2>PAVING PROJECT LAYOUT</h2> <h3># 5</h3>	SURVEYED BY	N/A	DATE	N/A
	DRAWN BY	C.A.K.	DATE	12/00
	SQUAD LEADER	T.P.K.		
	DESIGN FILE NO.	/pave/99dl56/pdl56.dgn		
	IPARM FILE	pb054105.i	DATE PLOTTED	\$DATE\$
PROJ. NAME	BENNINGTON			
PROJ. NO.	NH 2225(I)S			
SHEET	91	OF	108	SHEETS

646.40 DURABLE 100 mm WHITE LINE
 (ALL LINES WILL INCLUDE EDGE LINE BREAKS AND RADIUS FOR TOWN HIGHWAYS)

BENNINGTON:
 STA. 2+700.0 - STA. 3+240.0 LT & RT

646.41 DURABLE 100 mm YELLOW LINE
 (ALL LINES WILL INCLUDE C/L BREAKS FOR TOWN HIGHWAYS) S=SOLID, D=DASHED

BENNINGTON: LT ☉ RT S - S
 STA. 2+700.0 - STA. 3+240.0
 STA. 3+078.675 DOUBLE SOLID RT, T-46

646.46 DURABLE 600 mm STOP BAR
 BENNINGTON:
 STA. 3+078.675 RT, T-46

675.50 REMOVING SIGNS
 AS SHOWN - 14


646.66 TEMPORARY 600 mm STOP BAR
 BENNINGTON:
 STA. 3+078.675 RT, T-46

675.60 ERECTING SALVAGED SIGNS
 AS SHOWN - 2

646.61 TEMPORARY 100 mm YELLOW LINE
 BENNINGTON:
 STA. 3+078.675 DOUBLE SOLID RT, T-46

646.50 DURABLE LETTER OR SYMBOL
 BENNINGTON:
 STA. 3+078.675 RT, T-46, "S,T,O,P" (4 EA)

646.70 TEMPORARY LETTER OR SYMBOL
 BENNINGTON:
 STA. 3+078.675 RT, T-46, "S,T,O,P" (4 EA)

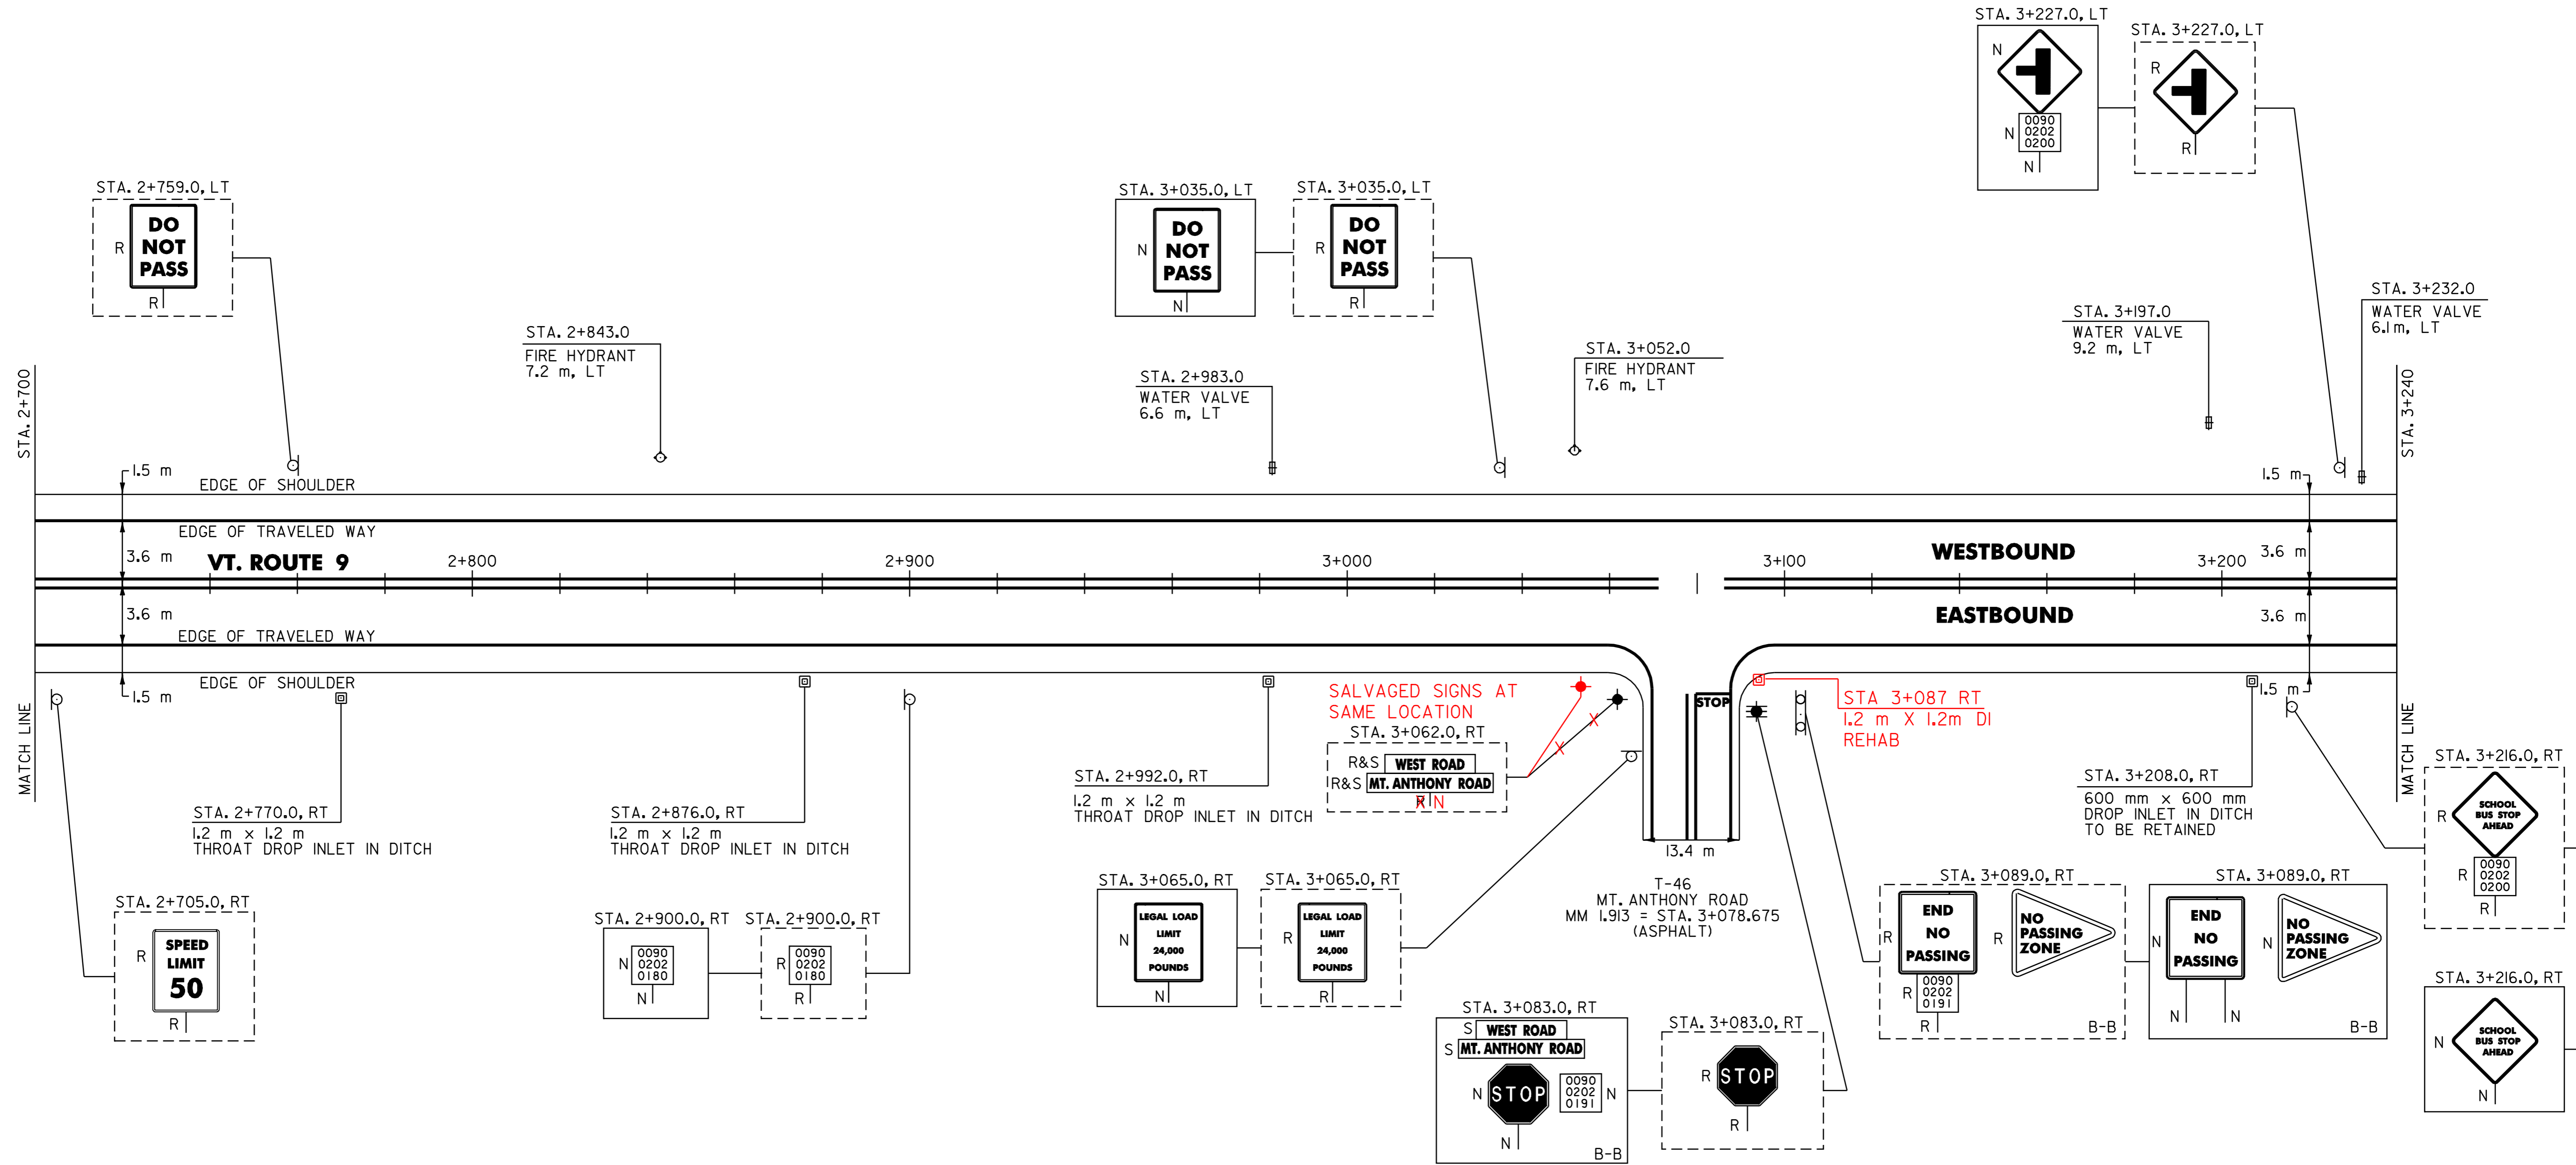

NOTE:
 1. PAVING LIMIT ON ALL TOWN HIGHWAYS SHALL BE MEASURED 8 m BACK FROM VT. ROUTE 9 EDGE OF SHOULDER UNLESS DENOTED OTHERWISE ON THE PLANS OR AS DIRECTED BY THE RESIDENT ENGINEER.

604.412 REHABING DI, CB OR MH, CLASS I
 BENNINGTON:
 STA. 2+770.0 RT
 STA. 2+876.0 RT
 STA. 2+992.0 RT
 STA. 3+087 RT

SIGN LEGEND
 R= REMOVE
 S= SALVAGE
 N= NEW
 RET= RETAIN
 B-B= BACK TO BACK
 EXISTING= - - - - -
 NEW= _____


<h2>PAVING PROJECT LAYOUT</h2> <h3># 6</h3>	SURVEYED BY	N/A	DATE	N/A
	DRAWN BY	C.A.K.	DATE	12/00
	SQUAD LEADER	T.P.K.		
	DESIGN FILE NO.	/pave/99dl56/pdl56.dgn		
	IPARM FILE	pb054106.i	DATE PLOTTED	#DATE#
PROJ. NAME	BENNINGTON			
PROJ. NO.	NH 2225(I)S			
SHEET	92 OF 108	SHEETS		

DATUM
 VERTICAL N/A
 HORIZONTAL N/A

646.40 DURABLE 100 mm WHITE LINE
 (ALL LINES WILL INCLUDE EDGE LINE BREAKS AND RADIUS FOR TOWN HIGHWAYS)
 BENNINGTON:
 STA. 3+240.0 - STA. 3+780.0 LT & RT

646.41 DURABLE 100 mm YELLOW LINE
 (ALL LINES WILL INCLUDE C/L BREAKS FOR TOWN HIGHWAYS) S=SOLID, D=DASHED
 BENNINGTON:
 STA. 3+240.0 - STA. 3+780.0 S Q RT
 S - S

675.50 REMOVING SIGNS
 AS SHOWN - 4

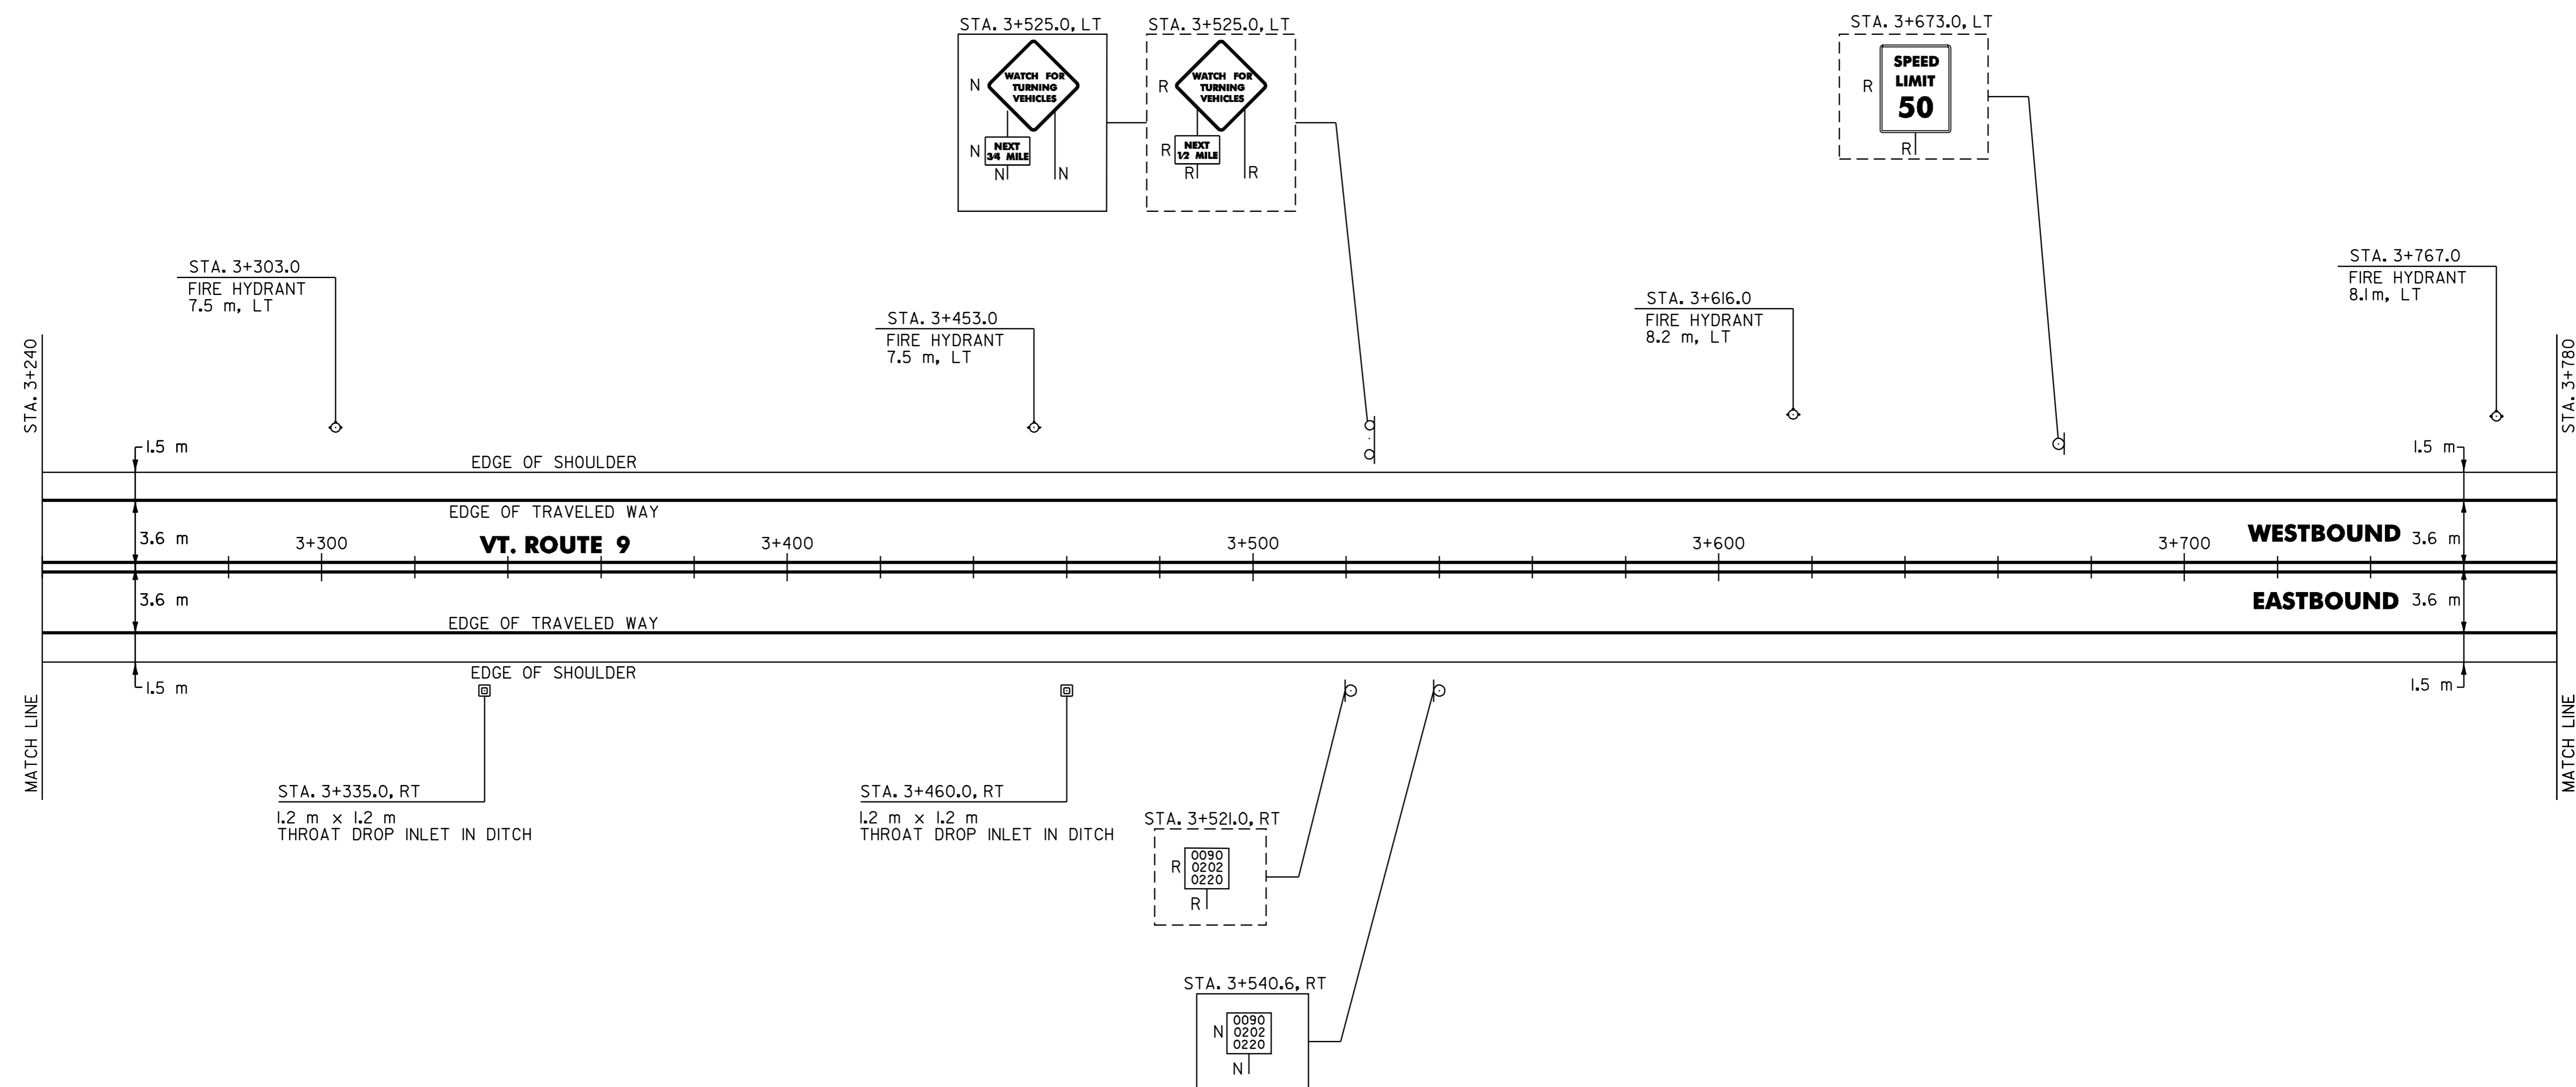

DATUM	
VERTICAL	N/A
HORIZONTAL	N/A

604.412 REHABING DI, CB OR MH, CLASS I
 BENNINGTON:
 STA. 3+335.0 RT
 STA. 3+460.0 RT

SIGN LEGEND
 R= REMOVE
 S= SALVAGE
 N= NEW
 RET= RETAIN
 B-B= BACK TO BACK
 EXISTING= - - - - -
 NEW= _____

PAVING PROJECT LAYOUT # 7

SURVEYED BY	N/A	DATE	N/A
DRAWN BY	C.A.K.	DATE	12/00
SQUAD LEADER	T.P.K.		
DESIGN FILE NO.	/pave/99dl56/pdl56.dgn		
IPARM FILE	pb054107.i	DATE PLOTTED	\$DATE\$
PROJ. NAME	BENNINGTON		
PROJ. NO.	NH 2225(I)S		
SHEET	93 OF 108	SHEETS	

646.40 DURABLE 100 mm WHITE LINE
(ALL LINES WILL INCLUDE EDGE LINE BREAKS AND RADIUS FOR TOWN HIGHWAYS)

BENNINGTON:
STA. 3+780.0 - STA. 4+320.0 LT & RT

646.60 TEMPORARY 100 mm WHITE LINE
(ALL LINES WILL INCLUDE EDGE LINE BREAKS AND RADIUS FOR TOWN HIGHWAYS)

BENNINGTON:
STA. 3+780.0 - STA. 4+320.0 LT & RT

646.41 DURABLE 100 mm YELLOW LINE
(ALL LINES WILL INCLUDE C/L BREAKS FOR TOWN HIGHWAYS) S=SOLID, D=DASHED

BENNINGTON: LT CL RT
STA. 3+780.0 - STA. 4+320.0 S - S
STA. 4+211.653 DOUBLE SOLID T-39

646.61 TEMPORARY 100 mm YELLOW LINE
(ALL LINES WILL INCLUDE C/L BREAKS FOR TOWN HIGHWAYS) S=SOLID, D=DASHED

BENNINGTON: LT CL RT
STA. 3+780.0 - STA. 4+320.0 S - S
STA. 4+211.653 DOUBLE SOLID T-39

646.46 DURABLE 600 mm STOP BAR

BENNINGTON:
STA. 4+211.653, LT, T-39

646.50 DURABLE LETTER OR SYMBOL

BENNINGTON:
STA. 4+211.653 LT, T-39, 'S,T,O,P' (4 EA)

675.50 REMOVING SIGNS


AS SHOWN - 9

675.60 ERECTING SALVAGED SIGNS

AS SHOWN - 1

678.16 FLASHING BEACON-GROUND MOUNTED (MOD.)

BENNINGTON:
STA. 3+959.0 RT

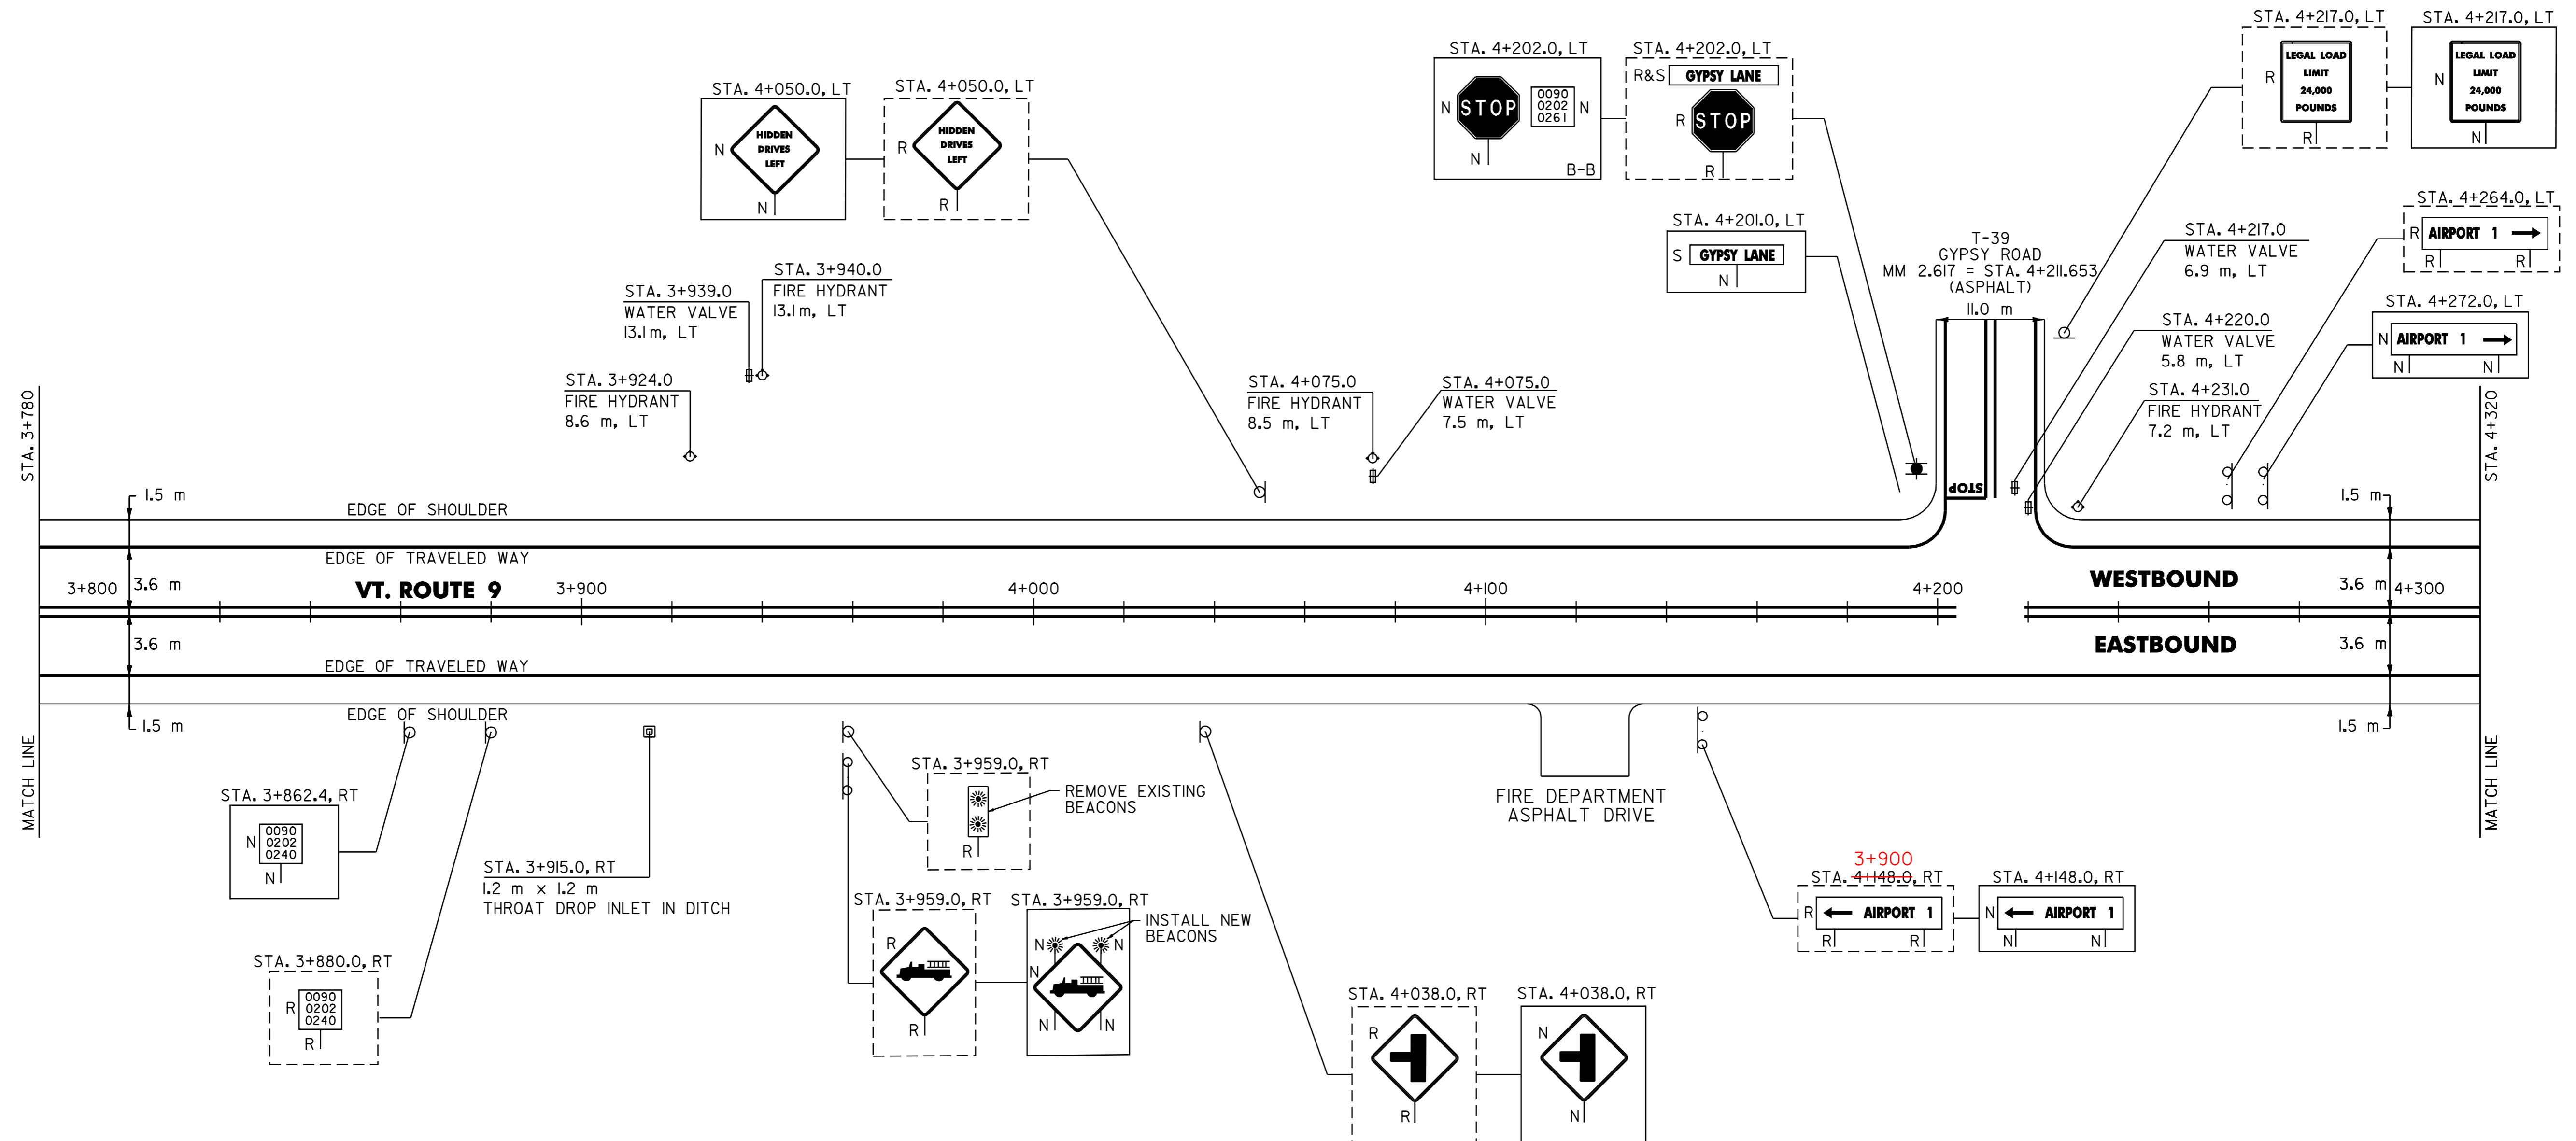

604.412 REHABING DI'S, CB'S OR MH'S, CLASS I
BENNINGTON:
STA. 3+915.0 LT

NOTE:

I. PAVING LIMIT ON ALL TOWN HIGHWAYS SHALL BE MEASURED 8 m BACK FROM VT. ROUTE 9 EDGE OF SHOULDER UNLESS DENOTED OTHERWISE ON THE PLANS OR AS DIRECTED BY THE RESIDENT ENGINEER.

DATUM	
VERTICAL	N/A
HORIZONTAL	N/A

SIGN LEGEND
R= REMOVE
S= SALVAGE
N= NEW
RET= RETAIN
B-B= BACK TO BACK
EXISTING= - - - - -
NEW= _____

PAVING PROJECT LAYOUT #8

SURVEYED BY	N/A	DATE	N/A
DRAWN BY	C.A.K.	DATE	12/00
SQUAD LEADER	T.P.K.		
DESIGN FILE NO.	/pave/99d156/pd156.dgn		
IPARM FILE	pb054108.1	DATE PLOTTED	\$DATE\$
PROJ. NAME	BENNINGTON		
PROJ. NO.	NH 2225(I)S		
SHEET	94 OF 108	SHEETS	

646.40 DURABLE 100 mm WHITE LINE
(ALL LINES WILL INCLUDE EDGE LINE BREAKS AND RADIUS FOR TOWN HIGHWAYS)

BENNINGTON:
STA. 4+320.0 - STA. 4+860.0 LT & RT

646.41 DURABLE 100 mm YELLOW LINE
(ALL LINES WILL INCLUDE C/L BREAKS FOR TOWN HIGHWAYS) S=SOLID, D=DASHED

BENNINGTON:
STA. 4+320.0 - STA. 4+860.0 S S
STA. 4+636.520 DOUBLE SOLID LT, T-12

646.46 DURABLE 600 mm STOP BAR

BENNINGTON:
STA. 4+636.520 LT, T-12

675.50 REMOVING SIGNS

AS SHOWN - 19

646.66 TEMPORARY 600 mm STOP BAR

BENNINGTON:
STA. 4+636.520 LT, T-12

675.60 ERECTING SALVAGED SIGNS

AS SHOWN - 5

646.61 TEMPORARY 100 mm YELLOW LINE


BENNINGTON:
STA. 4+636.520 DOUBLE SOLID LT, T-12

646.50 DURABLE LETTER OR SYMBOL

BENNINGTON:
STA. 4+636.520 LT, T-12, 'S,T,O,P' (4 EA)

646.70 TEMPORARY LETTER OR SYMBOL

BENNINGTON:
STA. 4+636.520 LT, T-12, 'S,T,O,P' (4 EA)

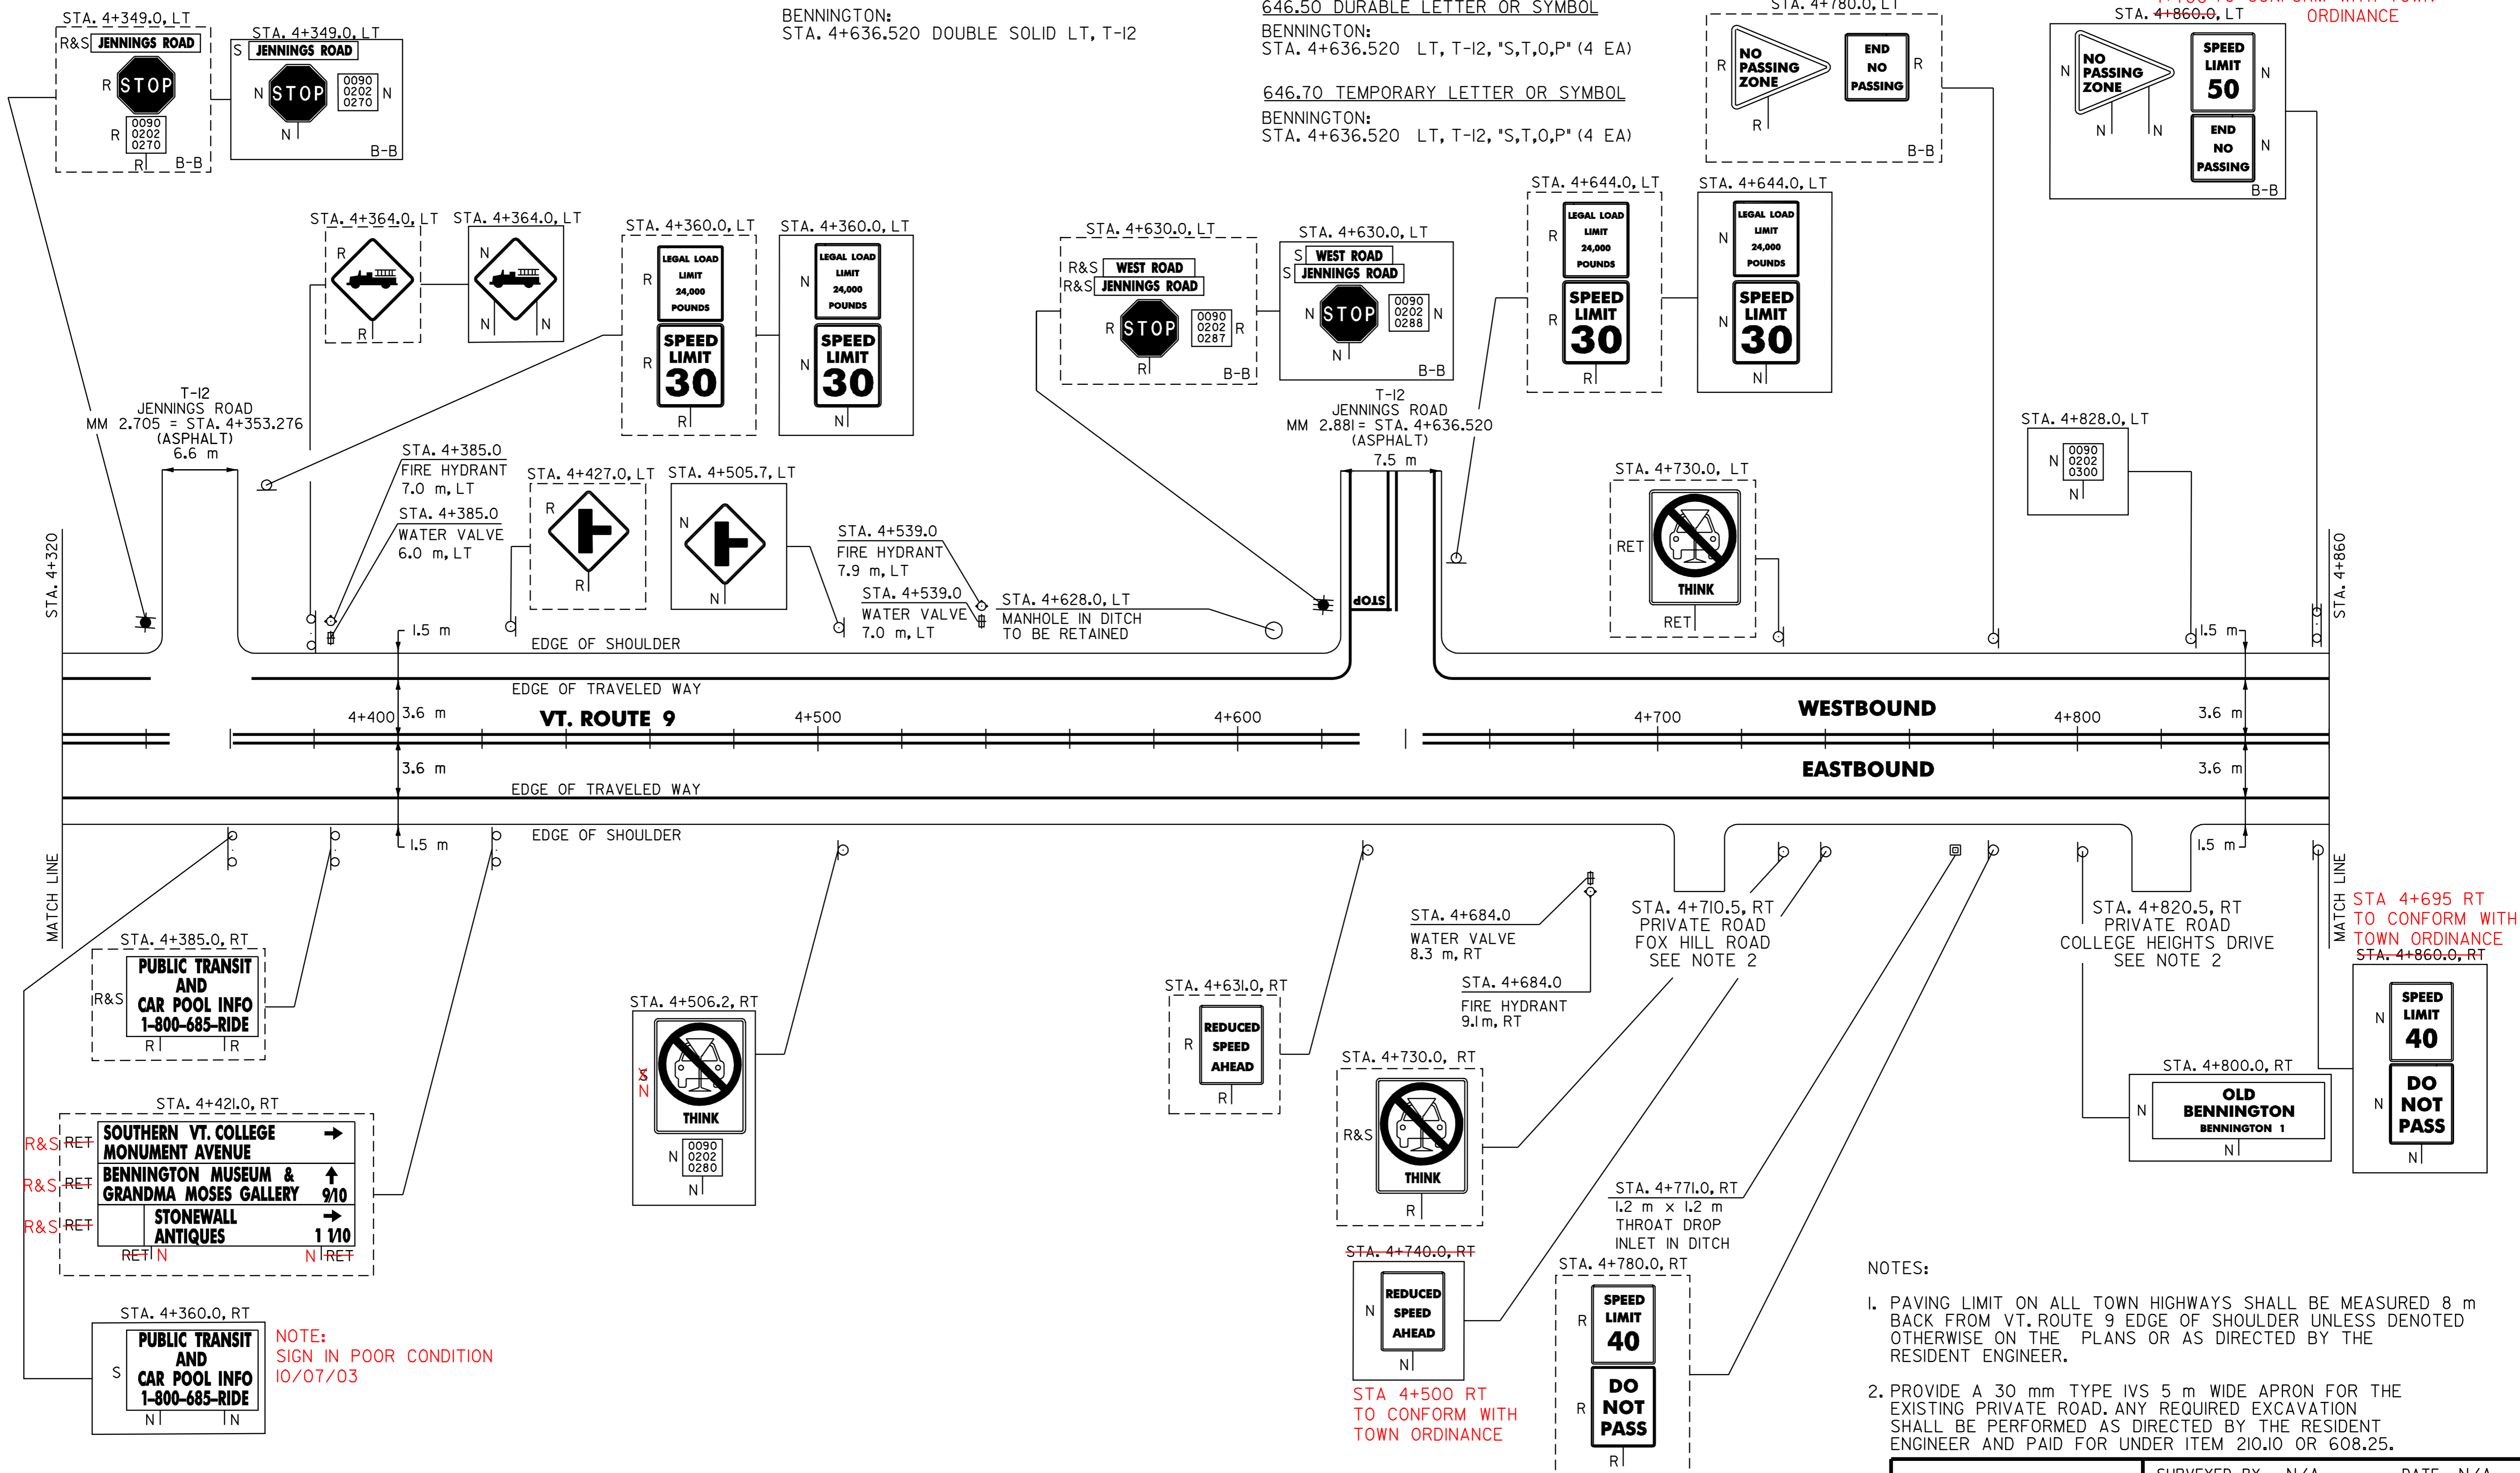

4+700 TO CONFORM WITH TOWN ORDINANCE

STA 4+695 RT TO CONFORM WITH TOWN ORDINANCE STA. 4+860.0, RT

NOTE:
SIGN IN POOR CONDITION
10/07/03

- NOTES:
- PAVING LIMIT ON ALL TOWN HIGHWAYS SHALL BE MEASURED 8 m BACK FROM VT. ROUTE 9 EDGE OF SHOULDER UNLESS DENOTED OTHERWISE ON THE PLANS OR AS DIRECTED BY THE RESIDENT ENGINEER.
 - PROVIDE A 30 mm TYPE IVS 5 m WIDE APRON FOR THE EXISTING PRIVATE ROAD. ANY REQUIRED EXCAVATION SHALL BE PERFORMED AS DIRECTED BY THE RESIDENT ENGINEER AND PAID FOR UNDER ITEM 210.10 OR 608.25.

DATUM	
VERTICAL	N/A
HORIZONTAL	N/A

604.412 REHABING DI, CB OR MH, CLASS 1
BENNINGTON:
STA. 4+771.0 RT

SIGN LEGEND

R=	REMOVE
S=	SALVAGE
N=	NEW
RET=	RETAIN
B-B=	BACK TO BACK
EXISTING=	-----
NEW=	-----

PAVING PROJECT LAYOUT # 9


SURVEYED BY	N/A	DATE	N/A
DRAWN BY	C.A.K.	DATE	12/00
SQUAD LEADER	T.P.K.		
DESIGN FILE NO.	/pave/99dl56/pdl56.dgn		
IPARM FILE	pb054109.1	DATE PLOTTED	\$DATE\$
PROJ. NAME	BENNINGTON		
PROJ. NO.	NH 2225(I)S		
SHEET:	95 OF 108	SHEETS	

646.40 DURABLE 100 mm WHITE LINE
 (ALL LINES WILL INCLUDE EDGE LINE BREAKS AND
 RADIUS FOR TOWN HIGHWAYS)
 BENNINGTON:
 STA. 4+860.0 - STA. 5+072.652 LT & RT

646.41 DURABLE 100 mm YELLOW LINE
 (ALL LINES WILL INCLUDE C/L BREAKS FOR
 TOWN HIGHWAYS) S=SOLID, D=DASHED
 BENNINGTON: LT C RT
 STA. 4+860.0 - STA. 5+072.652 S - S

675.50 REMOVING SIGNS
 AS SHOWN - 13

ADJUST ELEVATION OF VALVE BOX
 STA 4+964 RT
 STA 5+003 RT

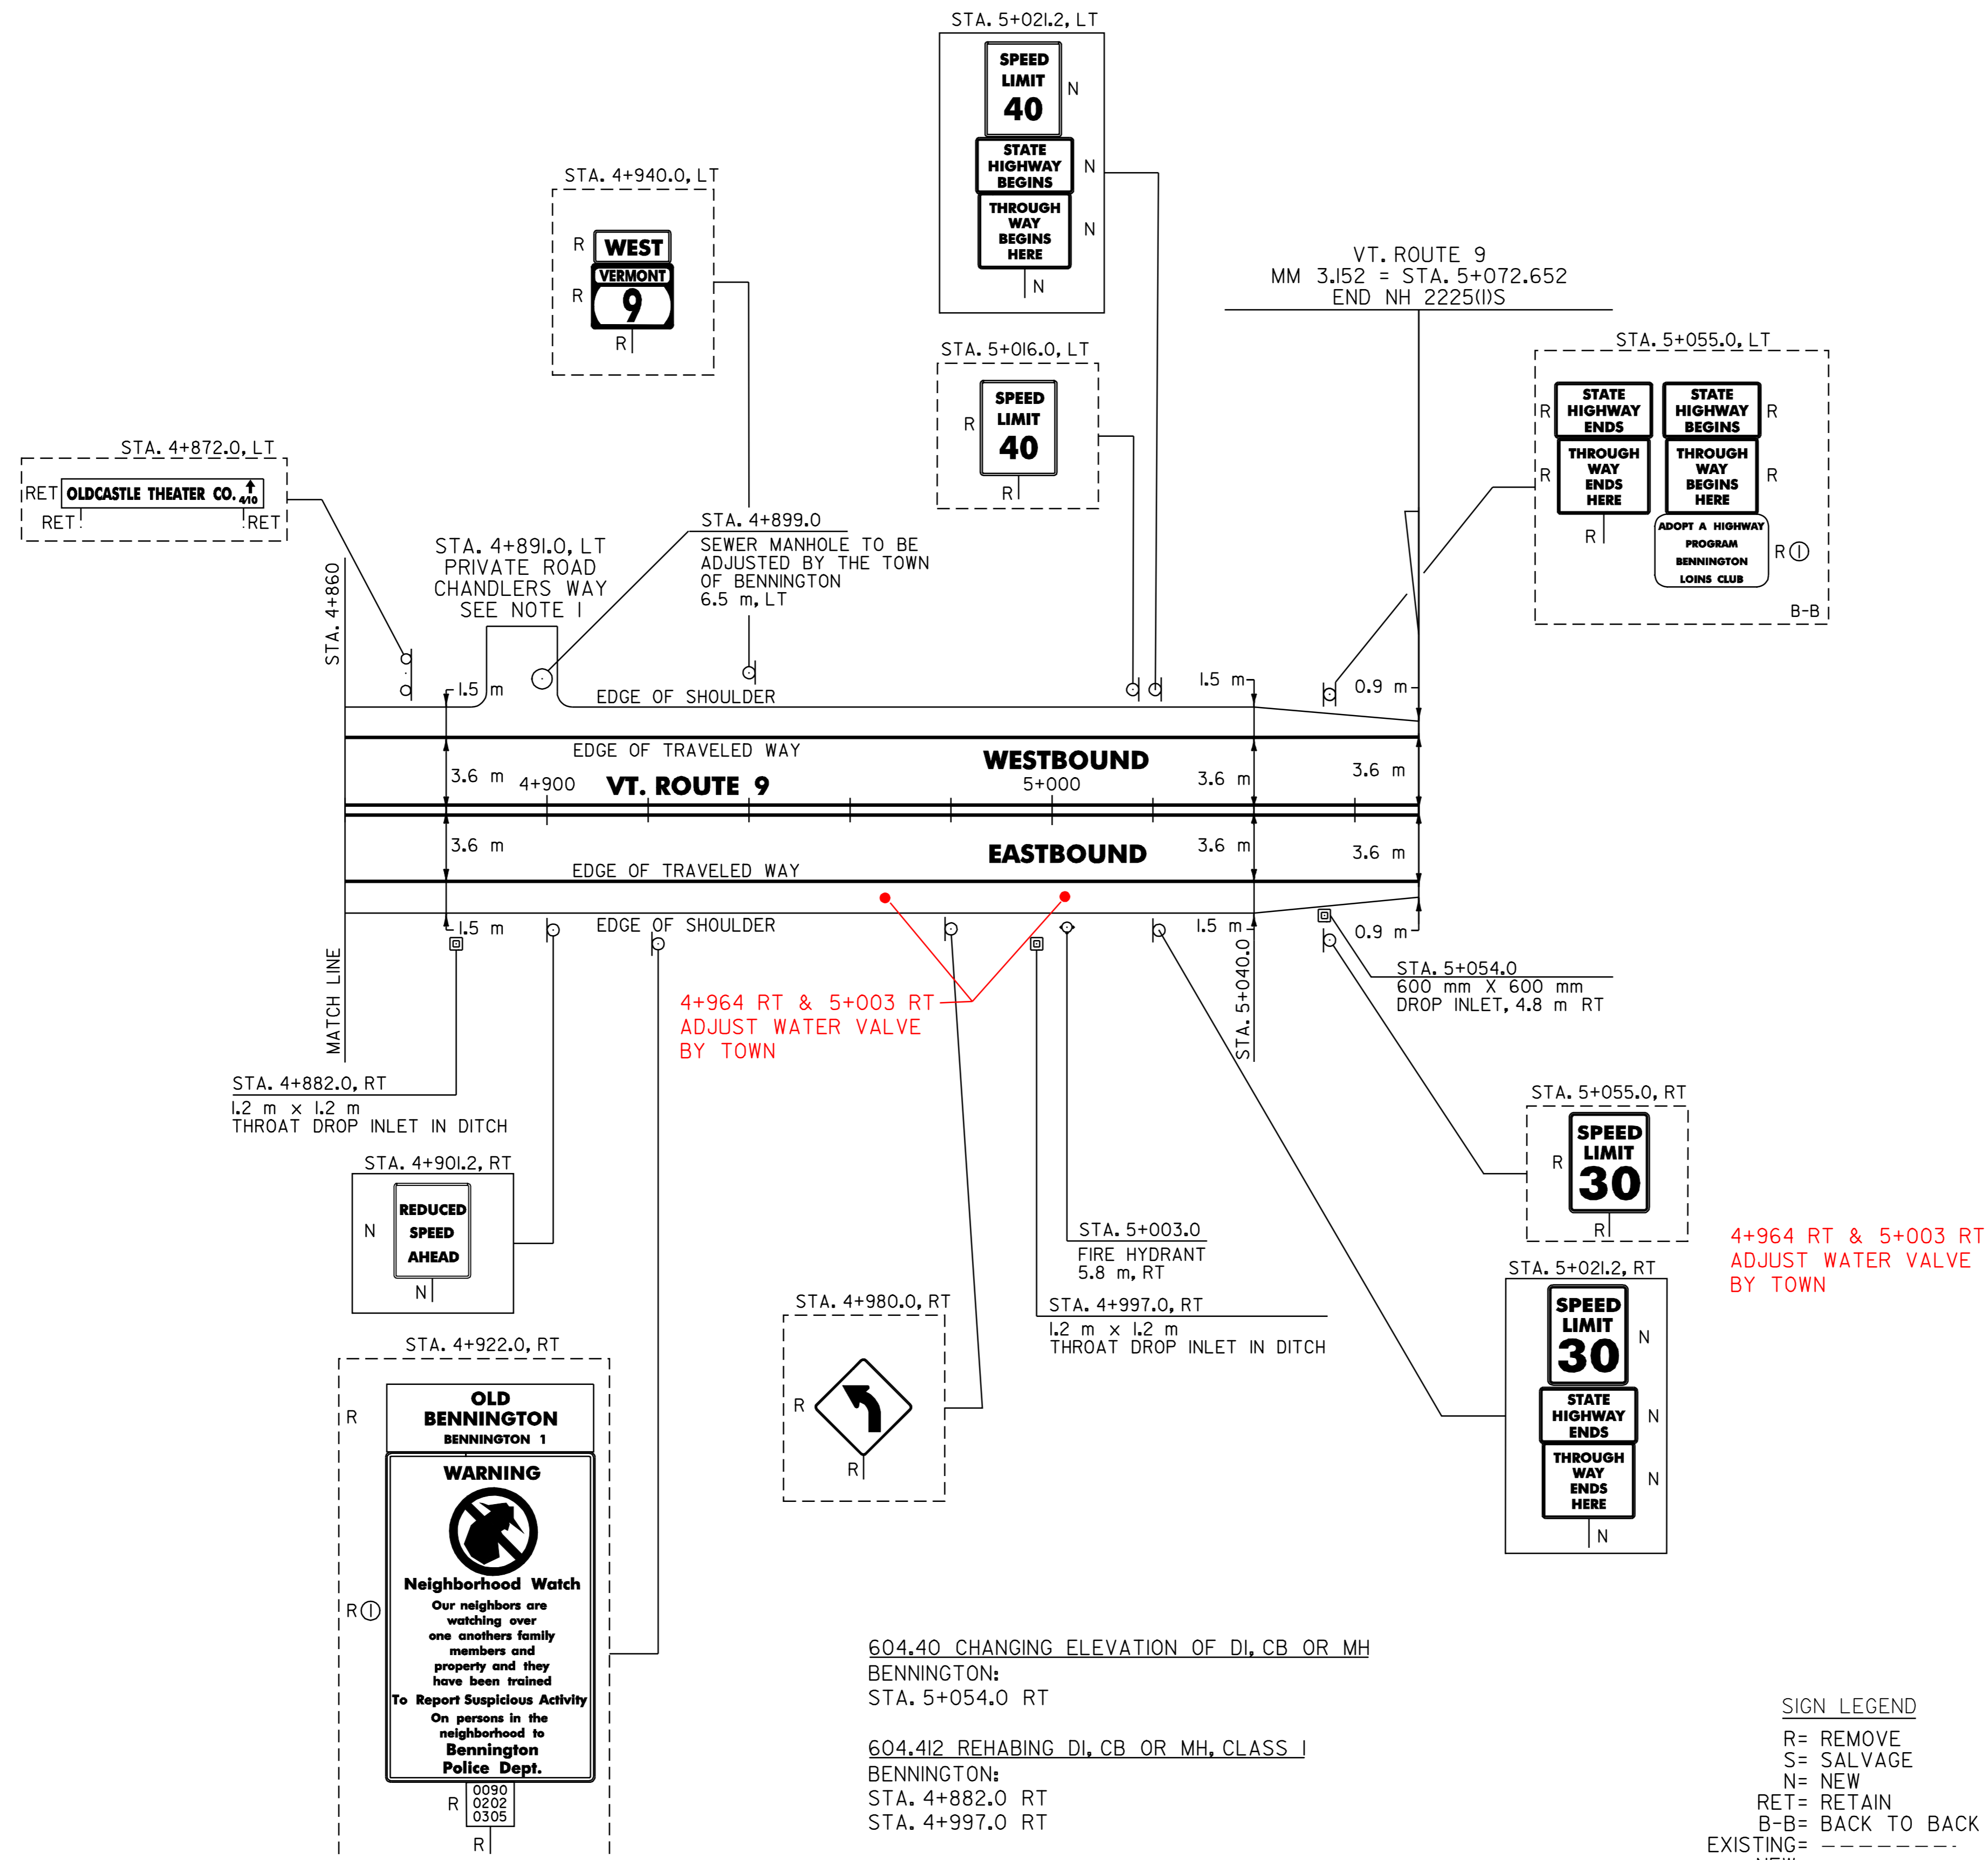

- NOTES:
- PROVIDE A 30 mm TYPE IVS 5 m WIDE APRON FOR THE EXISTING PRIVATE ROAD. ANY REQUIRED EXCAVATION SHALL BE PERFORMED AS DIRECTED BY THE RESIDENT ENGINEER AND PAID UNDER ITEM 608.25 OR 210.10.
 - THE CONTRACTOR SHOULD BE AWARE THAT THERE IS AN EXISTING UNDERGROUND TELEPHONE CABLE BETWEEN STA. 4+904.0 AND 5+072.652 LT.

604.40 CHANGING ELEVATION OF DI, CB OR MH
 BENNINGTON:
 STA. 5+054.0 RT

604.412 REHABING DI, CB OR MH, CLASS I
 BENNINGTON:
 STA. 4+882.0 RT
 STA. 4+997.0 RT


SIGN LEGEND
 R= REMOVE
 S= SALVAGE
 N= NEW
 RET= RETAIN
 B-B= BACK TO BACK
 EXISTING= -----
 NEW= _____
 Ⓢ SIGN TO BE RETURNED TO THE TOWN OF BENNINGTON

<h2>PAVING PROJECT LAYOUT</h2> <h3># 10</h3>	SURVEYED BY <u>N/A</u> DATE <u>N/A</u>
	DRAWN BY <u>C.A.K.</u> DATE <u>12/00</u>
	SQUAD LEADER <u>T.P.K.</u>
	DESIGN FILE NO. <u>/pave/99dl56/pdl56.dgn</u>
	IPARM FILE <u>pb054110.i</u> DATE PLOTTED <u>\$DATE\$</u>
PROJ. NAME <u>BENNINGTON</u>	
PROJ. NO. <u>NH 2225(I)S</u>	
SHEET <u>96 OF 108</u> SHEETS	

DATUM	
VERTICAL	<u>N/A</u>
HORIZONTAL	<u>N/A</u>

KILOMETER MARKER, STATION, OR SIGN NUMBER	SIGN LEGEND	SIGN DIMENSIONS			NEW & SALVAGED SIGNS				EXIST POST RETAIN	SALVAGE	NO. OF POSTS	NEW SIGN POSTS														REMARKS	SIGN DETAIL							
		EA	WIDTH (mm)	HEIGHT (mm)	"A"	"B"	SALV SIGN	SALV TIS				FLANGED CHANNEL			SQUARE STEEL (mm)			TUBULAR ALUMINUM Ø (mm)			TUBULAR STEEL Ø (mm)				W-SHAPE STEEL				DETAIL ON SHEET NUMBER	STD. SHEET NUMBER				
												1.7	3.0	4.5	44	50	63	75	100	100 MOD	FOUND-ACTION	75	89	100	125		FTG. SIZE				WEIGHT	POST SIZE		
																											kg/m	kg/m					kg/m	600 mm
BENNINGTON: 0+240.0, RT		1	600	750	0.45						1			4.9 X			X																	E-144M
0+300.0, RT		1	600	600	0.36						1			4.9 X			X																E-143M	
		1	600	450	0.27																								107	-				
0+321.9, LT		1	150	200	0.03						1		3.0 X			X																	E-138M	
0+357.0, RT		1	600	750	0.45						1			4.3 X			X																E-144M	
0+588.0, LT		1	750	750	0.56						1			4.3 X			X																E-151M	
0+643.7, RT		1	150	200	0.03						1		X			X																	E-138M	
0+860.0, RT		1	900	900	0.81						2			4.9 X 4.9			X																E-154M	
0+870.0, LT		1	150	200	0.03						1		3.0 X			X																		E-134M
0+967.0, LT		1	150	200	0.03						1		2.4 X			X																		E-138M
1+155.0, RT		1	150	200	0.03						1		3.0 X			X																		E-134M
1+162.0, LT		1	150	200	0.03						1		3.0 X			X																		E-134M

OPTION ITEMS

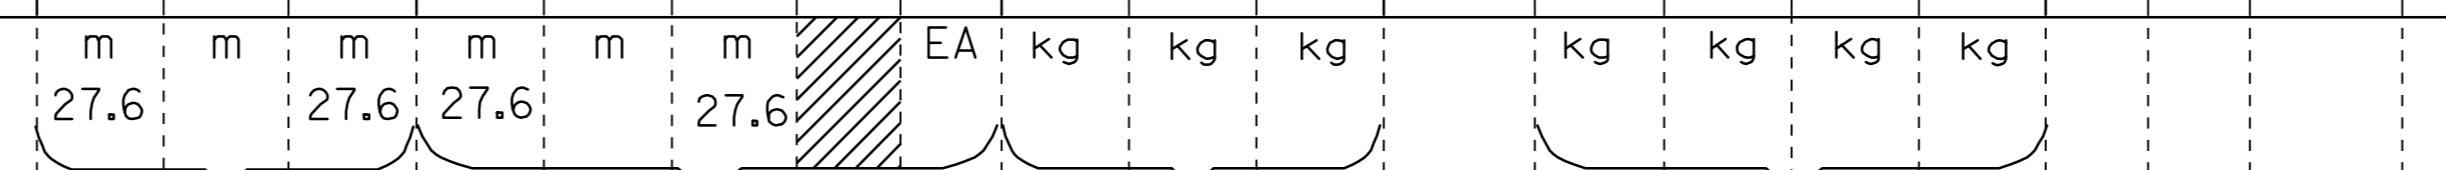

FINAL POST LENGTHS ARE TO BE DETERMINED IN THE FIELD. POST SIZES ARE COMPUTED BASED ON INFORMATION FURNISHED ON THE STANDARD SHEETS AND THE TRAFFIC & SAFETY DIVISION'S "SIGN POST DESIGN GUIDELINE."

TOTALS

EA	m ²	m ²	EA	m ²	EA	m	m	kg	EA	kg	EA	EA	kg
1	3.11		1		1	55.2	55.2		1		1	1	

PROJECT: BENNINGTON	PROJECT NO.: NH 2225(I)S
DESIGN FILE NAME: /pave/99d156/pdl56.dgn	PLOT DATE: 12/00
IPARM FILE NAME: pb054ss02.1	SURVEY DATE: N/A
SURVEYED BY: N/A	DRAWN BY: C.A.K.
SQUAD LEADER: T.P.K.	SHEET: 98 OF 108

KILOMETER MARKER, STATION, OR SIGN NUMBER	SIGN LEGEND	SIGN DIMENSIONS		NEW & SALVAGED SIGNS				EXIST POST	NO. OF POSTS	NEW SIGN POSTS												REMARKS	SIGN DETAIL											
		EA	WIDTH (mm)	HEIGHT (mm)	"A"	"B"	SALV SIGN			SALV TIS	FLANGED CHANNEL			SQUARE STEEL (mm)			TUBULAR ALUMINUM Ø (mm)			TUBULAR STEEL Ø (mm)				W-SHAPE STEEL		DETAIL ON SHEET NUMBER	STD. SHEET NUMBER							
											kg/m			44	50	63	75	100	100 MOD	FOUND-ATION			FTG. SIZE		WEIGHT			POST SIZE						
											1.7	3.0	4.5	3.4	3.9	5.0	1.9	2.5	2.5	75	89		100	125					600 mm	750 mm				
OPTION ITEMS																																		
1+266.0, LT		1	900	900	0.81				2			4.9 X 4.9			X															E-154M				
1+287.5, RT		1	150	200	0.03				1	X		X																		E-138M				
1+388.0, LT									1			4.3 X			X															SALVAGED SIGN TO BE MOUNTED ON NEW POST. TOP MOUNTING BRACKET REQUIRED TO INSTALL SALVAGED SIGN ON FLANGED CHANNEL POST.	-	-		
		1	750	750	0.56																										E-143M			
		1	150	200	0.03																										E-138M			
1+400.0, LT		1	600	750	0.45				1			4.3 X			X																E-141M			
1+415.0, RT		1	900	900	0.81				2			4.9 X 4.9			X																E-154M			
1+577.0, LT		1	750	750	0.56				1			X			X																E-143M			
		1	150	200	0.03																										E-138M			
1+580.0, LT		1	600	750	0.45				1			4.3 X			X																E-141M			
1+593.0, RT		1	600	750	0.45				1			4.3 X			X																E-141M			
1+593.0, RT		1	750	750	0.56				1			X			X																107	-		
1+605.0, RT									1			4.3 X			X																	SALVAGED SIGNS TO BE MOUNTED ON NEW POST. TOP MOUNTING BRACKET REQUIRED TO INSTALL SALVAGED SIGNS ON FLANGED CHANNEL POST.	-	-
		1	750	750	0.56																											E-143M		
		1	150	200	0.03																											E-138M		

FINAL POST LENGTHS ARE TO BE DETERMINED IN THE FIELD. POST SIZES ARE COMPUTED BASED ON INFORMATION FURNISHED ON THE STANDARD SHEETS AND THE TRAFFIC & SAFETY DIVISION'S "SIGN POST DESIGN GUIDELINE."

TOTALS	5.33	m ²		m ²	EA	3	m ²		EA		kg	55.2		kg	55.2		EA		kg		EA	EA	kg								
---------------	------	----------------	--	----------------	----	---	----------------	--	----	--	----	------	--	----	------	--	----	--	----	--	----	----	----	--	--	--	--	--	--	--	--

PROJECT: BENNINGTON	PROJECT NO.: NH 2225(I)S
DESIGN FILE NAME: /pave/99d156/pdl156.dgn	PLOT DATE: 12/00
IPARM FILE NAME: pb054ss03.1	SURVEY DATE: N/A
SURVEYED BY: N/A	DRAWN BY: C.A.K.
SQUAD LEADER: T.P.K.	SHEET: 99 OF 108

KILOMETER MARKER, STATION, OR SIGN NUMBER	SIGN LEGEND	SIGN DIMENSIONS		NEW & SALVAGED SIGNS				EXIST POST RETAIN SALVAGE	NO. OF POSTS	NEW SIGN POSTS												REMARKS	SIGN DETAIL										
		EA	WIDTH (mm)	HEIGHT (mm)	"A"	"B"	SALV SIGN			SALV TIS	FLANGED CHANNEL			SQUARE STEEL (mm)			TUBULAR ALUMINUM Ø (mm)			TUBULAR STEEL Ø (mm)				W-SHAPE STEEL		FRAMING SIGN	REQUIRED	DETAIL ON SHEET NUMBER	STD. SHEET NUMBER				
											1.7	3.0	4.5	44	50	63	75	100	100 MOD	FOUND-ATION	75		89	100	125					FTG. SIZE		WEIGHT	POST SIZE
																														kg/m	kg/m		
OPTION ITEMS																																	
BENNINGTON: 1+650.0, LT							1		1			4.3 X																SALVAGED SIGN TO BE MOUNTED ON NEW POST. TOP MOUNTING BRACKET REQUIRED TO INSTALL SALVAGED SIGN ON FLANGED CHANNEL POST.	-	-			
		1	750	750	0.56																							BACK - TO - BACK		E-143M E-138M			
1+663.0, LT		1	600	750	0.45				1			4.9 X																		E-141M			
		1	600	750	0.45																									E-142M			
1+806.0, LT		1	750	750	0.56				1			4.3 X																USE "STATE ROUTE/TOWN HIGHWAY INTERSECTION" SIGN.		E-155M			
1+977.0, LT		1	900	900	0.81				2			4.3 X 4.3																		E-154M			
1+990.0, LT	 						1 1		1			4.3 X																SALVAGED SIGNS TO BE MOUNTED ON NEW POST. TOP MOUNTING BRACKET REQUIRED TO INSTALL SALVAGED SIGNS ON FLANGED CHANNEL POST.	-	-			
		1	750	750	0.56																							BACK - TO - BACK		E-143M E-138M			
2+000.0, LT		1	600	750	0.45				1			4.9 X																		E-141M			
		1	600	750	0.45																									E-142M			
2+253.0, LT	 	1 1	1200 750	900 750	1.08 0.56				2			4.3 X 4.3																BACK - TO - BACK		E-152M E-141M			

FINAL POST LENGTHS ARE TO BE DETERMINED IN THE FIELD. POST SIZES ARE COMPUTED BASED ON INFORMATION FURNISHED ON THE STANDARD SHEETS AND THE TRAFFIC & SAFETY DIVISION'S "SIGN POST DESIGN GUIDELINE."

TOTALS	5.99	m ²		m ²	EA	3	m ²		m	41.4	m	41.4	EA	kg	kg	kg	kg	EA	kg	EA	EA	kg
---------------	------	----------------	--	----------------	----	---	----------------	--	---	------	---	------	----	----	----	----	----	----	----	----	----	----

PROJECT: BENNINGTON	PROJECT NO.: NH 2225(I)S
DESIGN FILE NAME: /pave/99dl56/pdl56.dgn	PLOT DATE: 12/00
IPARM FILE NAME: pb054ss04.l	SURVEY DATE: N/A
SURVEYED BY: N/A	DRAWN BY: C.A.K.
SQUAD LEADER: T.P.K.	SHEET: 100 OF 108

KILOMETER MARKER, STATION, OR SIGN NUMBER	SIGN LEGEND	SIGN DIMENSIONS		NEW & SALVAGED SIGNS				EXIST POST RETAIN	SALVAGE	NO. OF POSTS	NEW SIGN POSTS																REMARKS	SIGN DETAIL						
		EA	WIDTH (mm)	HEIGHT (mm)	"A"	"B"	SALV SIGN				SALV TIS	FLANGED CHANNEL			SQUARE STEEL (mm)			TUBULAR ALUMINUM Ø (mm)			TUBULAR STEEL Ø (mm)				W-SHAPE STEEL			FRAMING SIGN	REQUIRED	DETAIL ON SHEET NUMBER	STD. SHEET NUMBER			
												1.7	3.0	4.5	44	50	63	75	100	100 MOD	FOUND-ATION	75	89	100	125	FTG. SIZE						WEIGHT	POST SIZE	
																										kg/m								kg/m
OPTION ITEMS																																		
BENNINGTON: 2+253.0, RT		1	600	750	0.45					1			4.3 X			X																E-141M		
		1	150	200	0.03																											E-138M		
2+335.0, RT		1	900	900	0.81					2			4.9 X 4.9			X																E-154M		
		1	600	450	0.27																						MOUNT ON POST CLOSEST TO ROAD.				E-152M			
2+480.0, LT		1	600	750	0.45					1			4.3 X			X																E-142M		
2+480.0, RT		1	600	750	0.45					1			4.9 X			X																E-142M		
2+560.0, LT		1	150	200	0.03					1	X			X																		E-138M		
2+670.0, RT		1	600	750	0.45					1			4.3 X			X																E-141M		
2+670.0, LT		1	600	750	0.45					1			4.3 X			X																E-141M		
2+900.0, RT		1	150	200	0.03					1	2.4 X			X																		E-138M		
3+035.0, LT		1	600	750	0.45					1			4.3 X			X																E-141M		

FINAL POST LENGTHS ARE TO BE DETERMINED IN THE FIELD. POST SIZES ARE COMPUTED BASED ON INFORMATION FURNISHED ON THE STANDARD SHEETS AND THE TRAFFIC & SAFETY DIVISION'S "SIGN POST DESIGN GUIDELINE."

TOTALS	m ²	m ²	EA	m ²		9.2	m	36.8	m	9.2	m	36.8	EA	kg	kg	kg	kg	kg	kg	kg	EA	EA	kg
	3.87					46.0		46.0															

PROJECT: BENNINGTON	PROJECT NO.: NH 2225(I)S
DESIGN FILE NAME: /pave/99d156/pdl156.dgn	PLOT DATE: 12/00
IPARM FILE NAME: pb054ss05.1	SURVEY DATE: N/A
SURVEYED BY: N/A	DRAWN BY: C.A.K.
SQUAD LEADER: T.P.K.	SHEET: 101 OF 108

KILOMETER MARKER, STATION, OR SIGN NUMBER	SIGN LEGEND	SIGN DIMENSIONS		NEW & SALVAGED SIGNS				EXIST POST RETAIN SALVAGE	NO. OF POSTS	NEW SIGN POSTS																REMARKS	SIGN DETAIL					
		EA	WIDTH (mm)	HEIGHT (mm)	"A"	"B"	SALV SIGN			SALV TIS	FLANGED CHANNEL			SQUARE STEEL (mm)			TUBULAR ALUMINUM Ø (mm)			TUBULAR STEEL Ø (mm)				W-SHAPE STEEL			FRAMING SIGN	REQUIRED	DETAIL ON SHEET NUMBER	STD. SHEET NUMBER		
											1.7	3.0	4.5	44	50	63	75	100	100 MOD	75	89	100	125	FTG. SIZE							WEIGHT	POST SIZE
																								kg/m	kg/m							
OPTION ITEMS																																
3+065.0, RT		1	600	750	0.45				1			4.3 X			X															E-141M		
3+083.0, RT	 								1			3.7 X			X															SALVAGED SIGNS TO BE MOUNTED ON NEW POST. TOP MOUNTING BRACKET REQUIRED TO INSTALL SALVAGED SIGNS ON FLANGED CHANNEL POST.	-	-
	 	1	750	750	0.56							4.3	NEW POST																	E-143M E-138M		
3+089.0, RT	 	1	750	750	0.56				2			4.3 X 4.3			X															E-141M E-152M		
3+216.0, RT		1	750	750	0.56				1			4.3 X			X															E-153M		
3+227.0, LT	 	1	750	750	0.56				1			4.9 X			X															USE "STATE ROUTE/TOWN HIGHWAY INTERSECTION" SIGN.	E-155M E-138M	
3+525.0, LT	 	1	900	900	0.81				2			4.9 X 4.9			X															E-154M E-152M		

FINAL POST LENGTHS ARE TO BE DETERMINED IN THE FIELD. POST SIZES ARE COMPUTED BASED ON INFORMATION FURNISHED ON THE STANDARD SHEETS AND THE TRAFFIC & SAFETY DIVISION'S "SIGN POST DESIGN GUIDELINE."

TOTALS	EA	m ²	m ²	EA	m ²	EA	m	m	kg	EA	kg	kg	kg	EA	EA	kg
	2	4.91		2			36.8	36.8								

PROJECT: BENNINGTON	PROJECT NO.: NH 2225(I)S
DESIGN FILE NAME: /pave/99d156/pdl56.dgn	PLOT DATE: 12/00
IPARM FILE NAME: pb054ss06.1	SURVEY DATE: N/A
SURVEYED BY: N/A	DRAWN BY: C.A.K.
SQUAD LEADER: T.P.K.	SHEET: 102 OF 108

KILOMETER MARKER, STATION, OR SIGN NUMBER	SIGN LEGEND	SIGN DIMENSIONS		NEW & SALVAGED SIGNS				EXIST POST RETAIN	SALVAGE	NO. OF POSTS	NEW SIGN POSTS																REMARKS	SIGN DETAIL						
		EA	WIDTH (mm)	HEIGHT (mm)	"A"	"B"	SALV SIGN				SALV TIS	FLANGED CHANNEL			SQUARE STEEL (mm)			TUBULAR ALUMINUM Ø (mm)			TUBULAR STEEL Ø (mm)				W-SHAPE STEEL			FRAMING SIGN	REQUIRED	DETAIL ON SHEET NUMBER	STD. SHEET NUMBER			
												1.7	3.0	4.5	44	50	63	75	100	100 MOD	FOUNDATION	75	89	100	125	FTG. SIZE						WEIGHT	POST SIZE	
																										kg/m								kg/m
OPTION ITEMS																																		
BENNINGTON: 3+540. 6, RT		1	150	200	0.03					1	3.0 X		X																		E-138M			
3+862. 4, RT		1	150	200	0.03					1	3.0 X		X																		E-138M			
3+959. 0, RT		1	900	900	0.81					2		4.3 X 4.3		X																	107	-		
4+038. 0, RT		1	750	750	0.56					1		4.3 X		X																		USE "STATE ROUTE/TOWN HIGHWAY INTERSECTION" SIGN.	E-155M	
4+050. 0, LT		1	750	750	0.56					1		4.3 X		X																		E-154M		
4+148. 0, RT		1	1800	250	0.45					2		4.3 X		X																		E-123M		
4+202. 0, LT										1		3.7 X		X																		SALVAGED SIGN TO BE MOUNTED ON NEW POST. TOP MOUNTING BRACKET REQUIRED TO INSTALL SALVAGED SIGN ON FLANGED CHANNEL POST.	-	-
		1	750	750	0.56							4.3																				E-143M		
		1	150	200	0.03																												E-138M	

FINAL POST LENGTHS ARE TO BE DETERMINED IN THE FIELD. POST SIZES ARE COMPUTED BASED ON INFORMATION FURNISHED ON THE STANDARD SHEETS AND THE TRAFFIC & SAFETY DIVISION'S "SIGN POST DESIGN GUIDELINE."

TOTALS	m ²	m ²	EA	m ²		m	m	m	m	EA	kg	kg	kg	kg	kg	kg	kg	EA	EA	kg
	3.03		1			41.8	41.8													


PROJECT: BENNINGTON	PROJECT NO.: NH 2225(I)S
DESIGN FILE NAME: /pave/99dl56/pdl56.dgn	PLOT DATE: 12/00
IPARM FILE NAME: pb054ss07.1	SURVEY DATE: N/A
SURVEYED BY: N/A	DRAWN BY: C.A.K.
SQUAD LEADER: T.P.K.	SHEET: 103 OF 108

KILOMETER MARKER, STATION, OR SIGN NUMBER	SIGN LEGEND	SIGN DIMENSIONS			NEW & SALVAGED SIGNS				EXIST POST RETAIN SALVAGE	NO. OF POSTS	NEW SIGN POSTS												REMARKS	SIGN DETAIL									
		EA	WIDTH (mm)	HEIGHT (mm)	"A"	"B"	SALV SIGN	SALV TIS			FLANGED CHANNEL			SQUARE STEEL (mm)			TUBULAR ALUMINUM Ø (mm)			TUBULAR STEEL Ø (mm)				W-SHAPE STEEL		FRAGILE SIGN	REQUIRED	DETAIL ON SHEET NUMBER	STD. SHEET NUMBER				
											kg/m			44	50	63	75	100	100 MOD	FOUND-ATION	75	89		100	125					FTG. SIZE		WEIGHT	POST SIZE
											1.7	3.0	4.5	kg/m			kg/m				kg/m				600 mm					750 mm			
BENNINGTON: 4+217.0, LT		1	600	750	0.45					1			4.3 X			X															E-141M		
4+272.0, LT		1	1800	250	0.45					2			3.7 X 4.3			X														E-123M			
4+349.0, LT										1			4.3 X			X											SALVAGED SIGN TO BE MOUNTED ON NEW POST. TOP MOUNTING BRACKET REQUIRED TO INSTALL SALVAGED SIGN ON FLANGED CHANNEL POST.	-	-				
		1	750	750	0.56																									E-143M			
		1	150	200	0.03																									E-138M			
4+360.0, LT		1	600	750	0.45					1			4.3 X			X															E-141M		
		1	600	750	0.45																										E-142M		
4+360.0, LT										2			4.9 X 4.9			X												SALVAGED SIGN TO BE MOUNTED ON NEW POST.	-	-			
4+364.0, LT		1	900	900	0.81					2			4.3 X 4.3			X													107	-			
4+421.0 RT	TRAFFIC INFORMATION SIGN									2			4.9 4.9															EXISTING POST BENT SALVAGE SIGNS ON NEW POST					
4+505.7, LT		1	750	750	0.56					1			4.3 X			X												USE "STATE ROUTE/TOWN HIGHWAY INTERSECTION" SIGN.			E-155M		
4+506.2, RT										1			4.3 X			X											SIGN MISSING SALVAGED SIGN TO BE MOUNTED ON NEW POST. INSTALL A NEW SIGN	-	-				
		1	150	200	0.03																										E-138M		

FINAL POST LENGTHS ARE TO BE DETERMINED IN THE FIELD. POST SIZES ARE COMPUTED BASED ON INFORMATION FURNISHED ON THE STANDARD SHEETS AND THE TRAFFIC & SAFETY DIVISION'S "SIGN POST DESIGN GUIDELINE."


TOTALS	m ²	m ²	EA	m ²		m	m	kg	EA	kg	EA	kg
	3.79		3		50.6	50.6						

PROJECT: BENNINGTON	PROJECT NO.: NH 2225(I)S
DESIGN FILE NAME: /pave/99dl56/pdl56.dgn	PLOT DATE: 12/00
IPARM FILE NAME: pb054ss08.l	SURVEY DATE: N/A
SURVEYED BY: N/A	DRAWN BY: C.A.K.
SQUAD LEADER: T.P.K.	SHEET: 104 OF 108

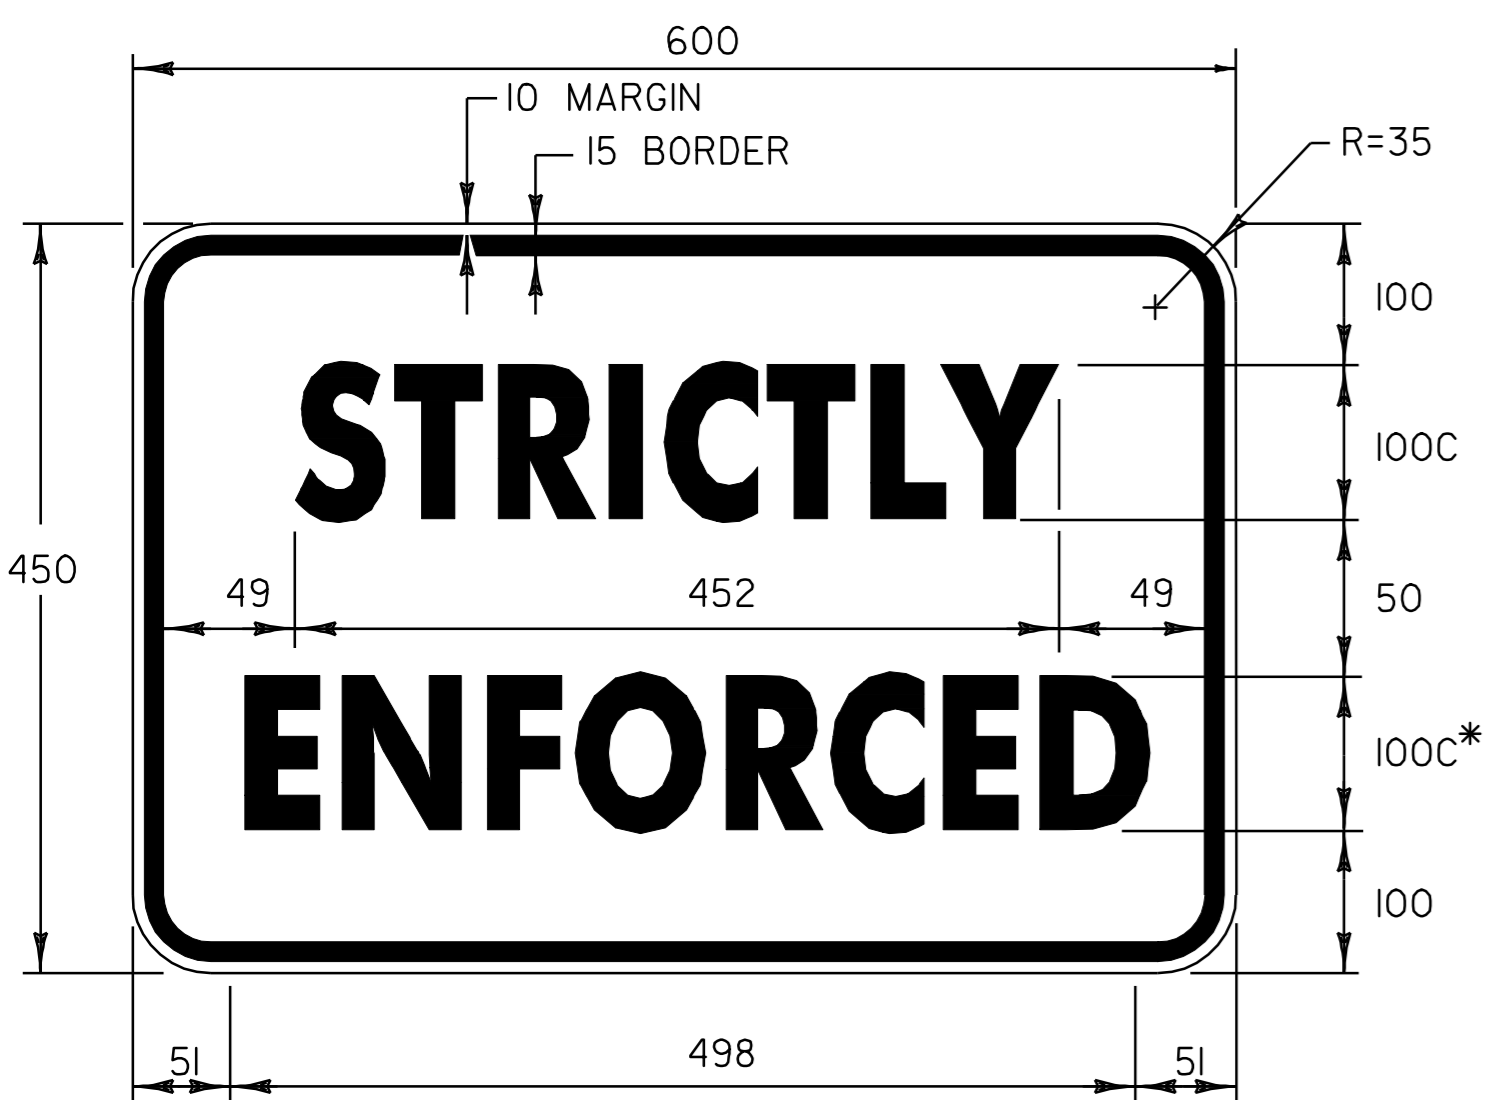


COLOR: BLACK BORDER & TEXT (REFLECTIVE)
WHITE BACKGROUND (REFLECTIVE)

MATERIAL: PER VAOT STANDARD E-144M
*50% REDUCTION IN SPACING
SIGN - VT. ROUTE 9
STA. 0+300.0, RT

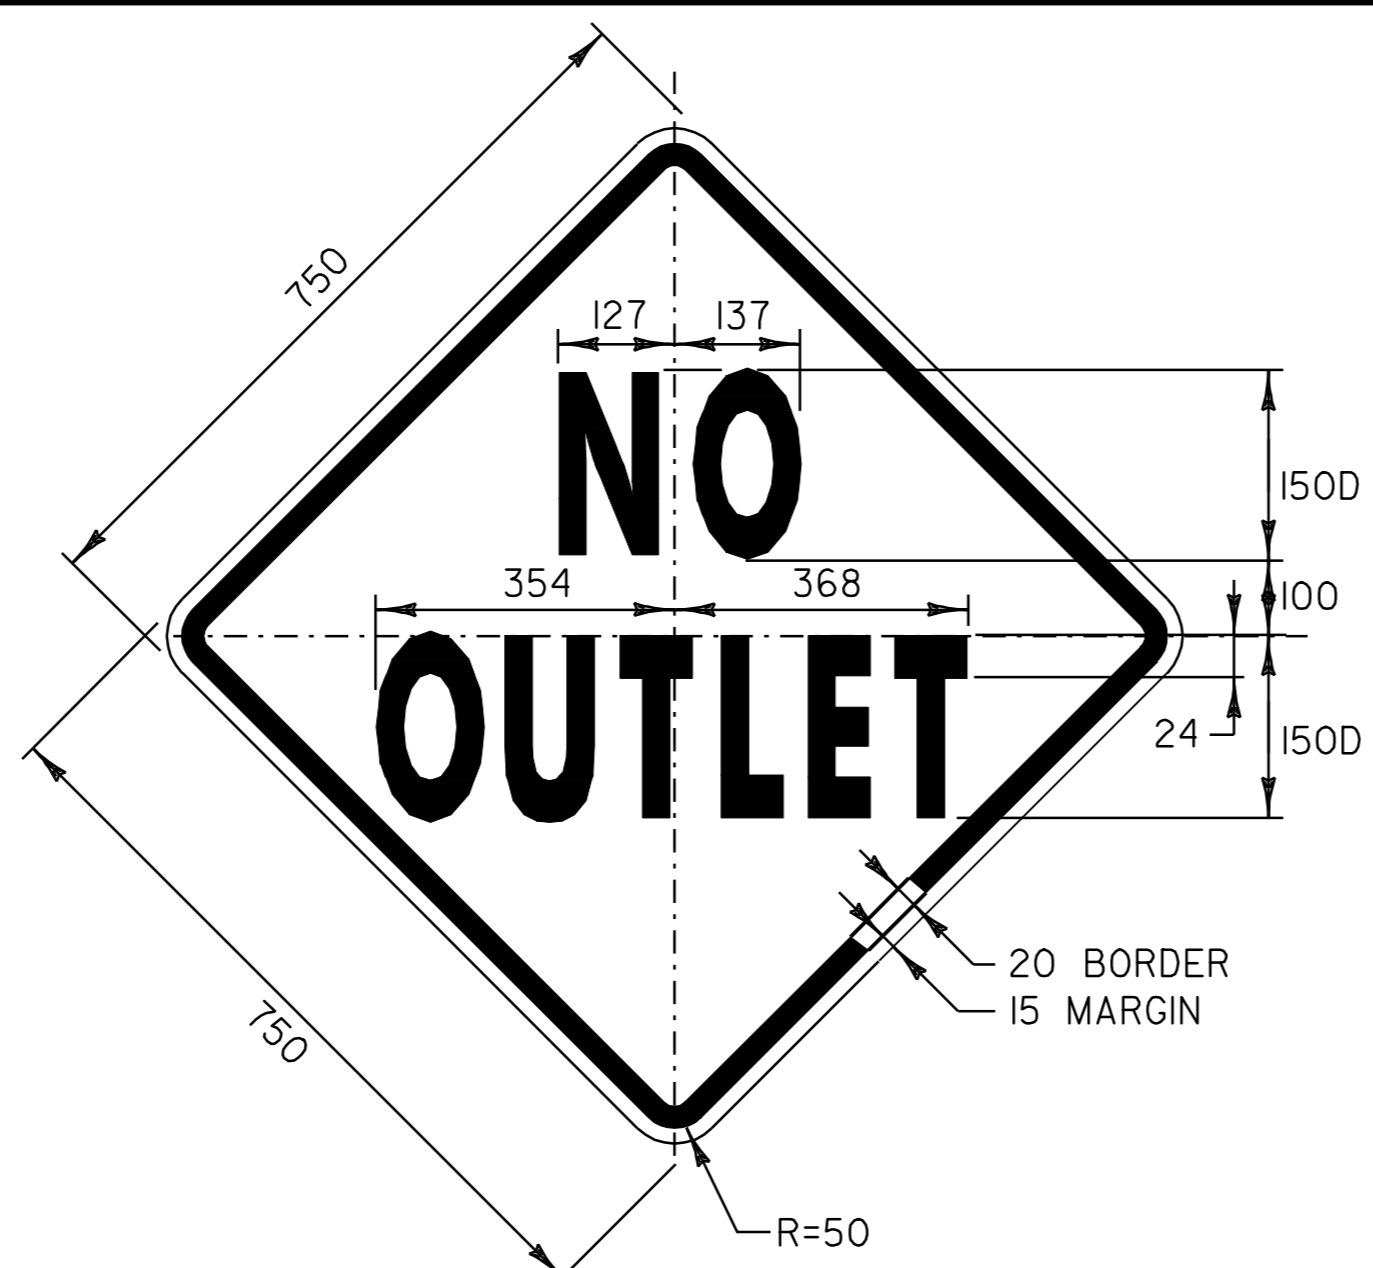


COLOR: BLACK BORDER & TEXT
YELLOW BACKGROUND (REFLECTIVE)

MATERIAL: PER VAOT STANDARD E-153M
SIGN - VT. ROUTE 9
STA. 1+593.0, RT

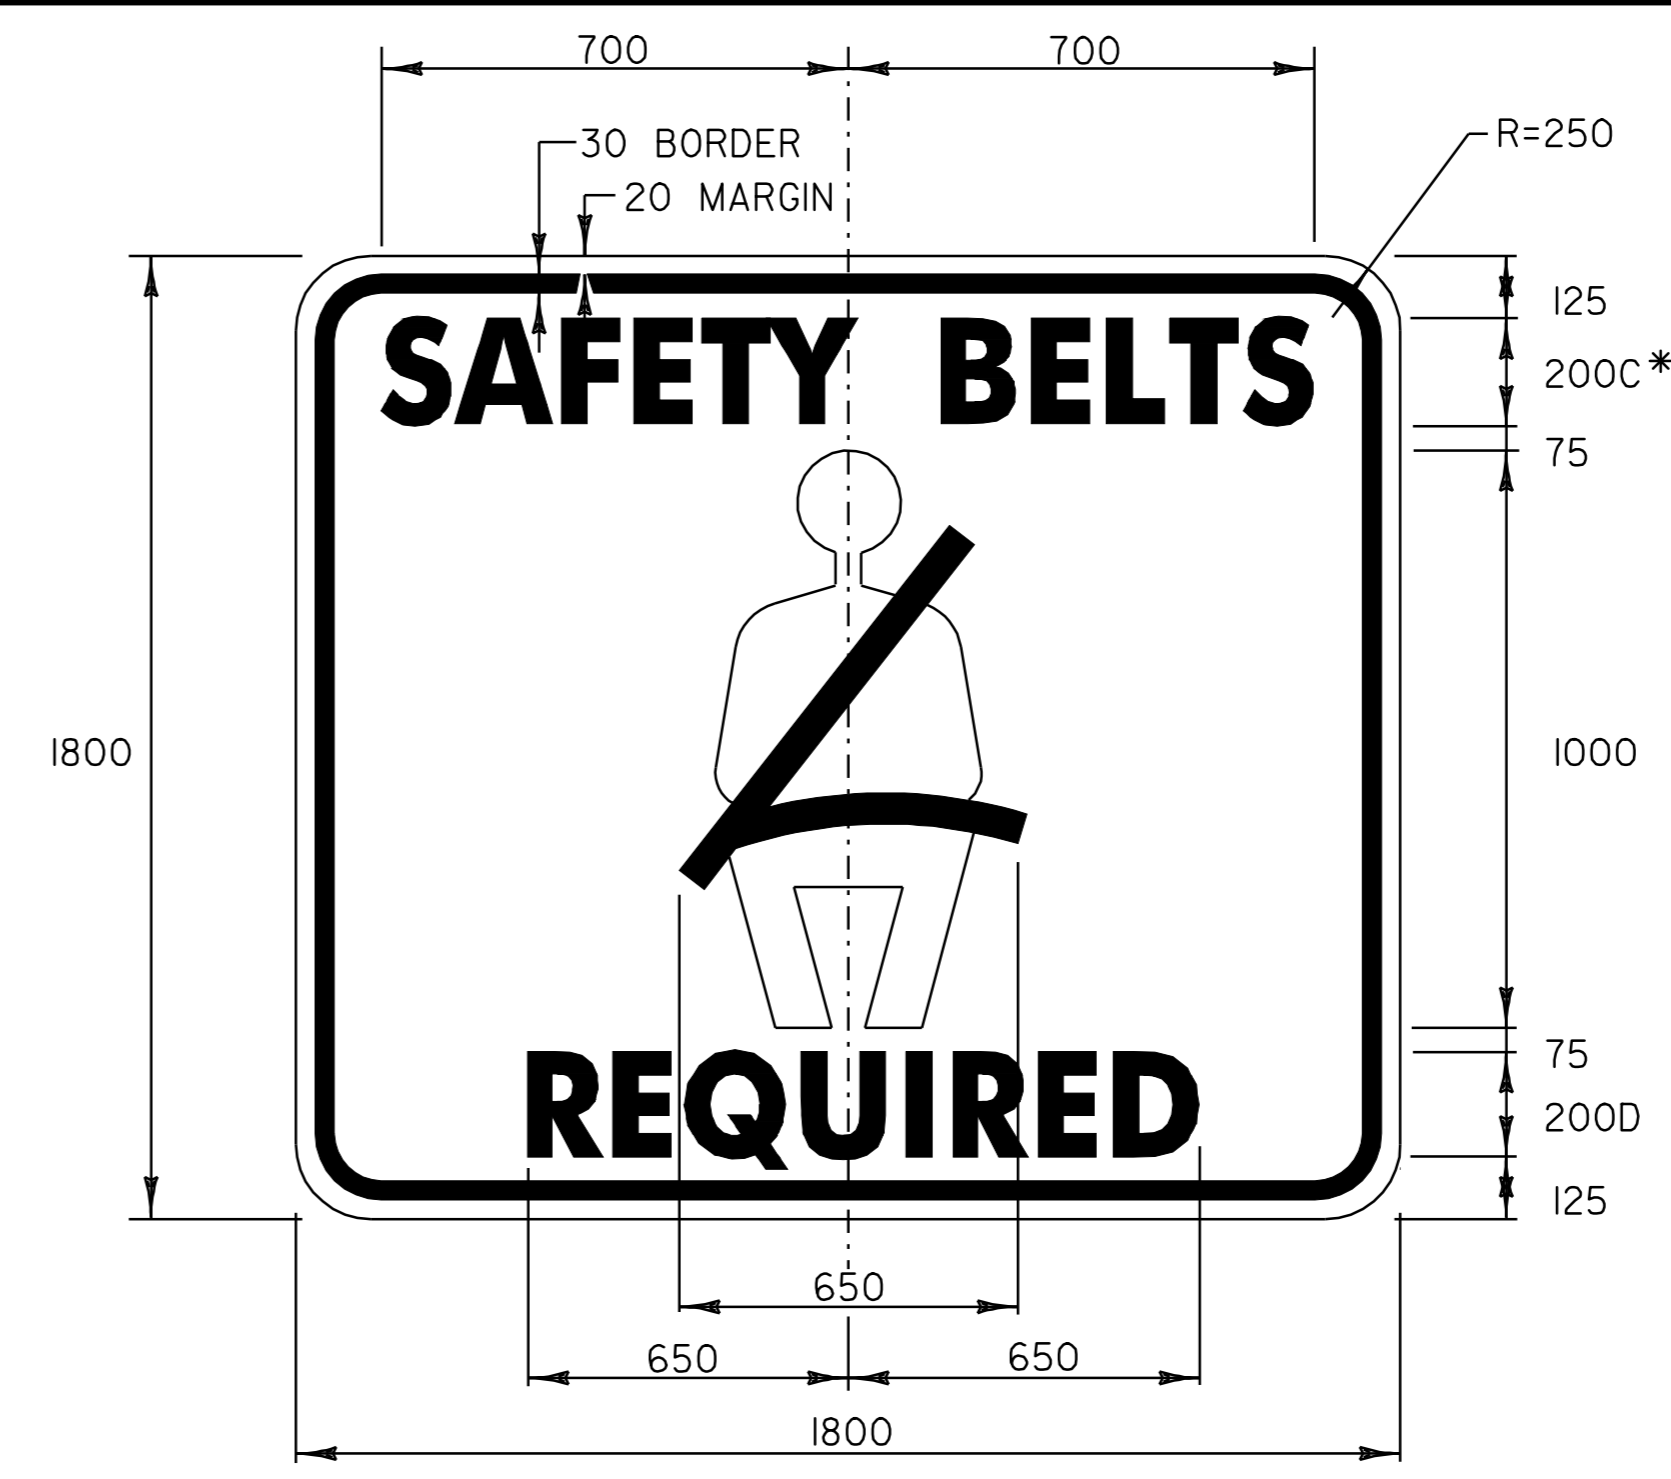

COLOR: BLACK BORDER & TEXT (REFLECTIVE)
WHITE BACKGROUND (REFLECTIVE)

MATERIAL: PER VAOT STANDARD E-144M
*50% REDUCTION IN SPACING
SIGN - VT. ROUTE 9
STA. 0+180.0, RT

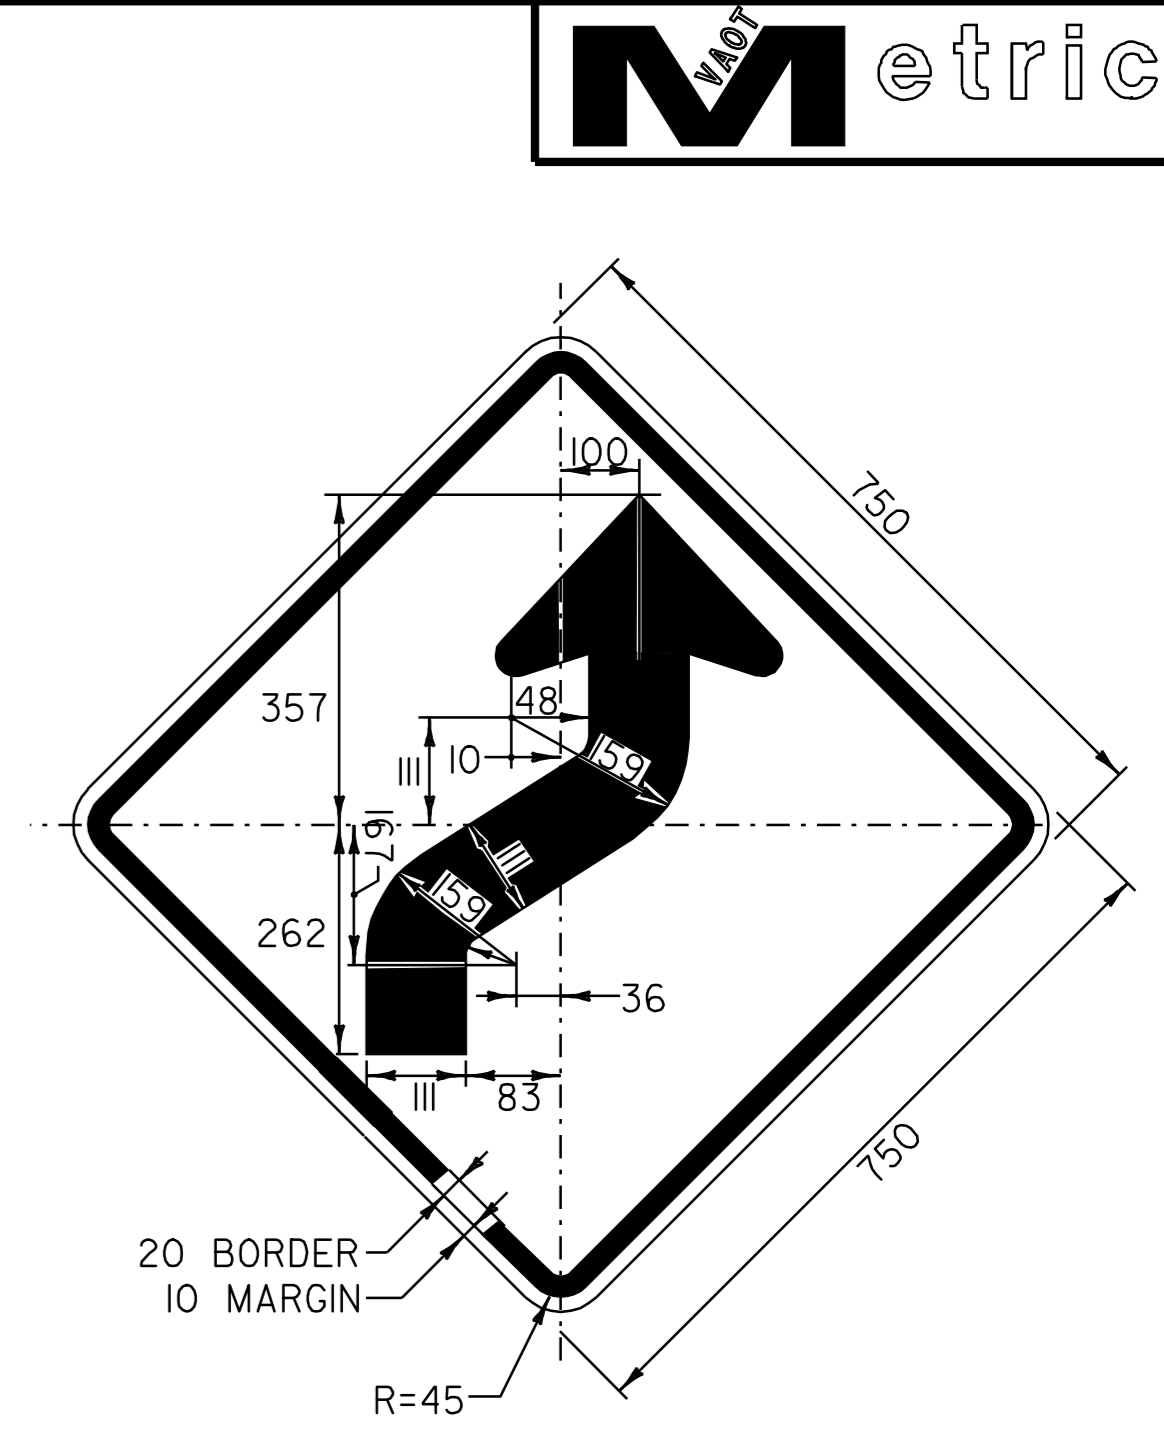


COLOR: BLACK BORDER & SYMBOL
YELLOW BACKGROUND (REFLECTIVE)

MATERIAL: PER VAOT STANDARD E-155M
SIGN - VT. ROUTE 9
STA. 0+118.0, LT





FOR THE WORDS "WELCOME TO" USE GERBER FONT MURRAY HILL BOLD OR EQUIVALENT. TEXT COLOR IS GREEN. ALL OTHER TEXT USE GERBER FONT SOUVENIR DEMI-BOLD OR EQUIVALENT. TEXT COLOR IS WHITE. REFER TO VAOT STANDARD E-131M FOR COLORS.

MATERIALS:
THE SIGN BASE MATERIALS USED FOR THIS SIGN MAY BE ANY OF THE FOLLOWING OF THE MINIMUM THICKNESS NOTED.
FLAT SHEET ALUMINUM 1.02 mm
HIGH DENSITY OVERLAID PLYWOOD 19 mm
SIGN - VT. ROUTE 9
STA. 0+000.0, RT

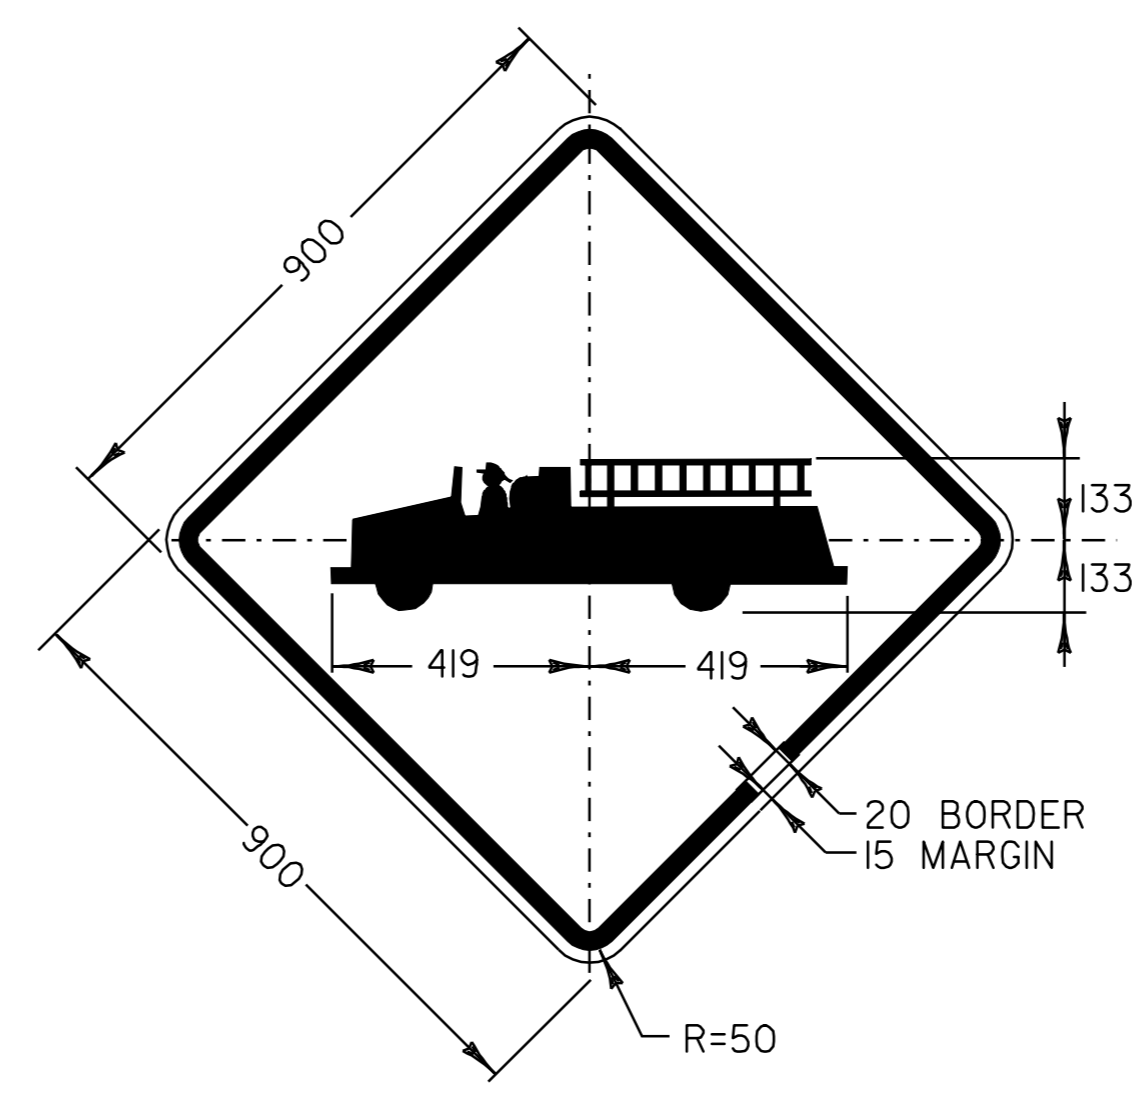

COLOR: BLACK BORDER & TEXT
YELLOW BACKGROUND (REFLECTIVE)

MATERIAL: PER VAOT STANDARD E-153M
SIGN - VT. ROUTE 9
STA. 3+959.0, RT
STA. 4+364.0, LT

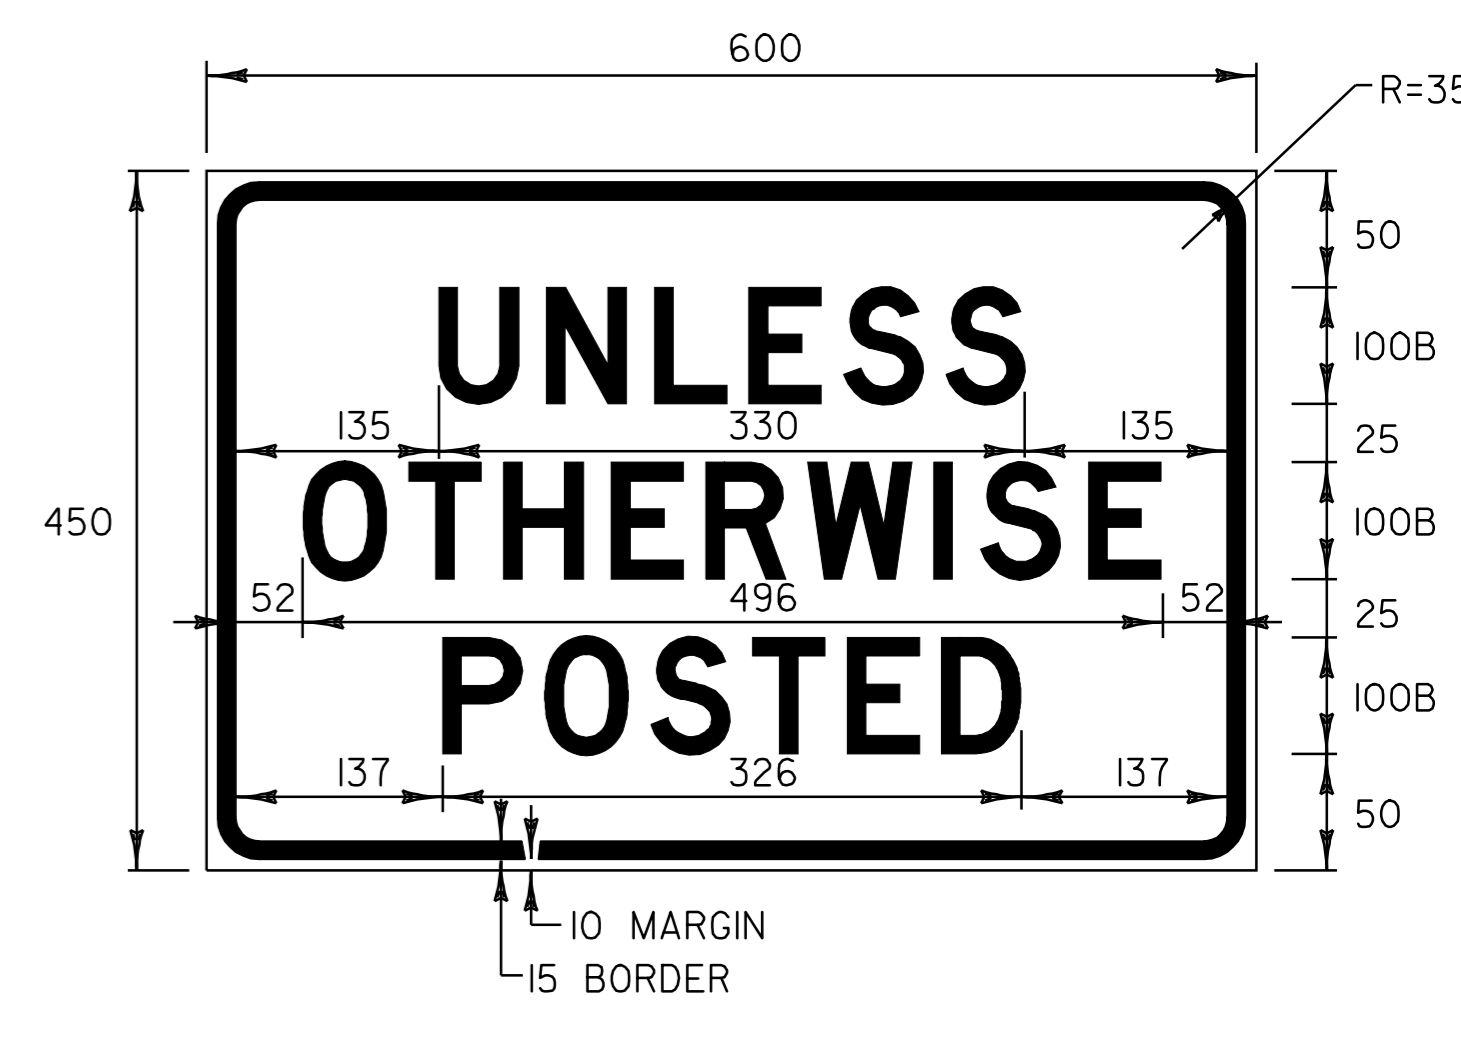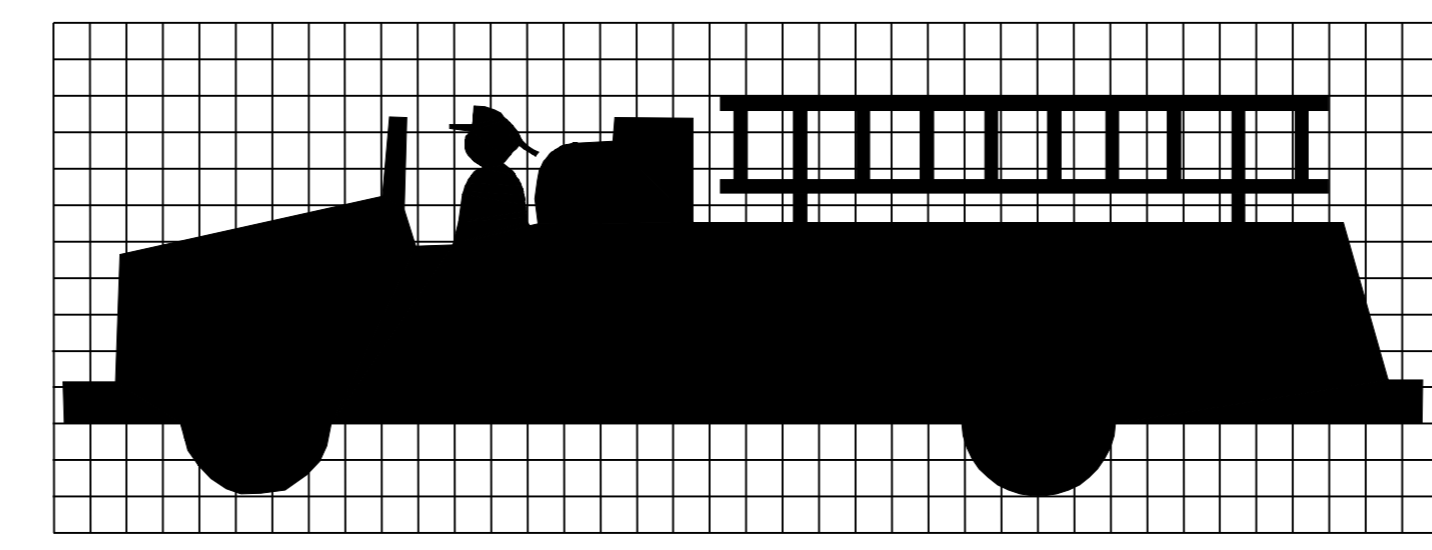

COLOR: BLACK BORDER & TEXT (REFLECTIVE)
WHITE BACKGROUND (REFLECTIVE)

MATERIAL: PER VAOT STANDARD E-144M
SIGN - VT. ROUTE 9
STA. 0+120.0, RT

NOTE:
TEXT LAYOUT DIMENSIONS ARE BASED ON THE "LETTER & NUMERAL WIDTHS & SPACE" TABLES FOUND IN THE "STANDARD HIGHWAY SIGNS" BOOKLET. MINOR VARIATIONS IN TEXT DIMENSIONS ARE ACCEPTABLE BASED ON INDIVIDUAL MANUFACTURER'S LETTER FABRICATION. SIGNIFICANT CHANGES THAT AFFECT SIGN APPEARANCE SHALL BE BROUGHT TO THE ATTENTION OF THE VAOT'S TRAFFIC AND SAFETY DIVISION BEFORE FABRICATION.


TRAFFIC SIGN DETAIL SHEET	SURVEYED BY	N/A	DATE	N/A
	DRAWN BY	C.A.K.	DATE	12/00
	SQUAD LEADER	T.P.K.		
	DESIGN FILE NO.	/pave/99dl56/pdl56.dgn		
	IPARM FILE	pb054ts.i	DATE PLOTTED	\$DATE\$
PROJ. NAME	BENNINGTON			
PROJ. NO.	NH 2225(I)S			
SHEET	107 OF 108	SHEETS		

ALL DIMENSIONS IN MILLIMETERS EXCEPT WHERE OTHERWISE INDICATED.

DATUM	
VERTICAL	N/A
HORIZONTAL	N/A

VT. ROUTE 9
MM 3.152 = STA. 5+072.652
END PROJECT NH 2225(I)S
BEGIN PROJECT NH 2202(I)S

VT. ROUTE 9
MM 0.000 = STA. 0+000.000
BEGIN PROJECT NH 2225(I)S

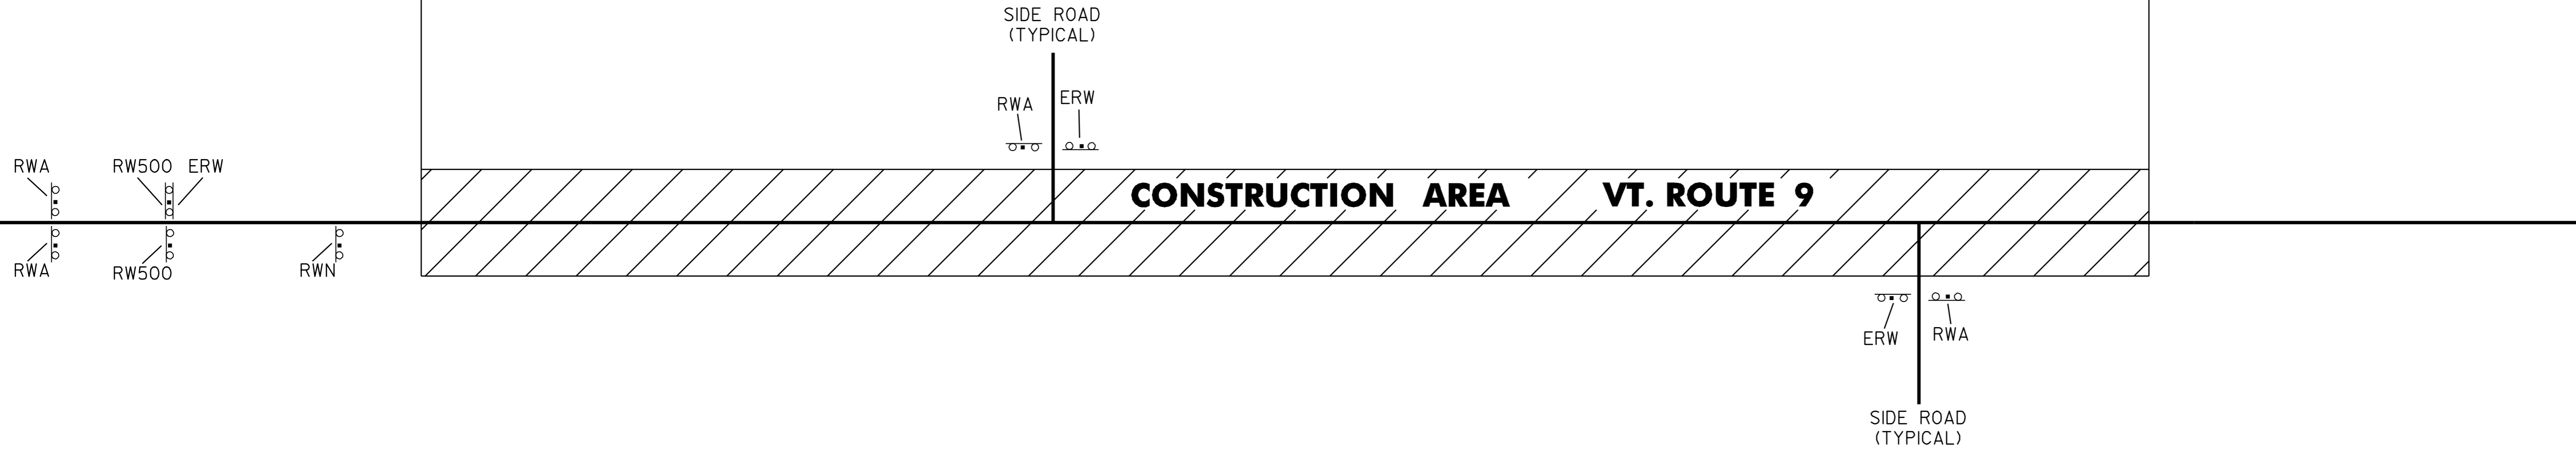

CONSTRUCTION APPROACH SIGNING

SEE STD. E-100M FOR ADDITIONAL SIGN PLACEMENT

SIGN LEGEND

- RWA = ROAD WORK AHEAD
- RW500 = ROAD WORK 500 FEET
- ERW = END ROAD WORK
- SRWA = SIDE ROAD WORK AHEAD
- SRW500 = SIDE ROAD WORK 500 FEET
- RWN = ROAD WORK NEXT 3 1/4 MILES

LIST OF TOWN HIGHWAYS FOR CONSTRUCTION SIGNS

TOWN HIGHWAY NUMBER	ROAD WORK AHEAD	END ROAD WORK	OTHER
BEGIN PROJECT	2	1	2 - RW500 1 - RWN
T-72	1	1	
T-40	1	1	
T-42	1	1	
T-83	1	1	
T-74	1	1	
T-46	1	1	
T-39	1	1	
T-12	1	1	
T-12	1	1	
TOTAL	11	10	3

NOTES:

1. THE RESIDENT ENGINEER AT HIS OR HER DISCRETION SHALL ELIMINATE CONSTRUCTION APPROACH SIGNING ON DEAD END/NO OUTLET TOWN HIGHWAYS.
2. THE CONTRACTOR SHALL CONTACT JAN MEILHEDE OF THE NEW YORK STATE DEPARTMENT OF TRANSPORTATION AT (518) 286-2301 PRIOR TO INSTALLING CONSTRUCTION APPROACH SIGNS IN NEW YORK

CONSTRUCTION APPROACH SIGNING SHEET

SURVEYED BY N/A DATE N/A
 DRAWN BY C.A.K. DATE 12/00
 SQUAD LEADER T.P.K.
 DESIGN FILE NO. /pave/99d156/pd156.dgn
 IPARM FILE pb054cas.1 DATE PLOTTED \$DATE\$
 PROJ. NAME BENNINGTON
 PROJ. NO. NH 2225(I)S
 SHEET 108 OF 108 SHEETS

DATUM
 VERTICAL N/A
 HORIZONTAL N/A