
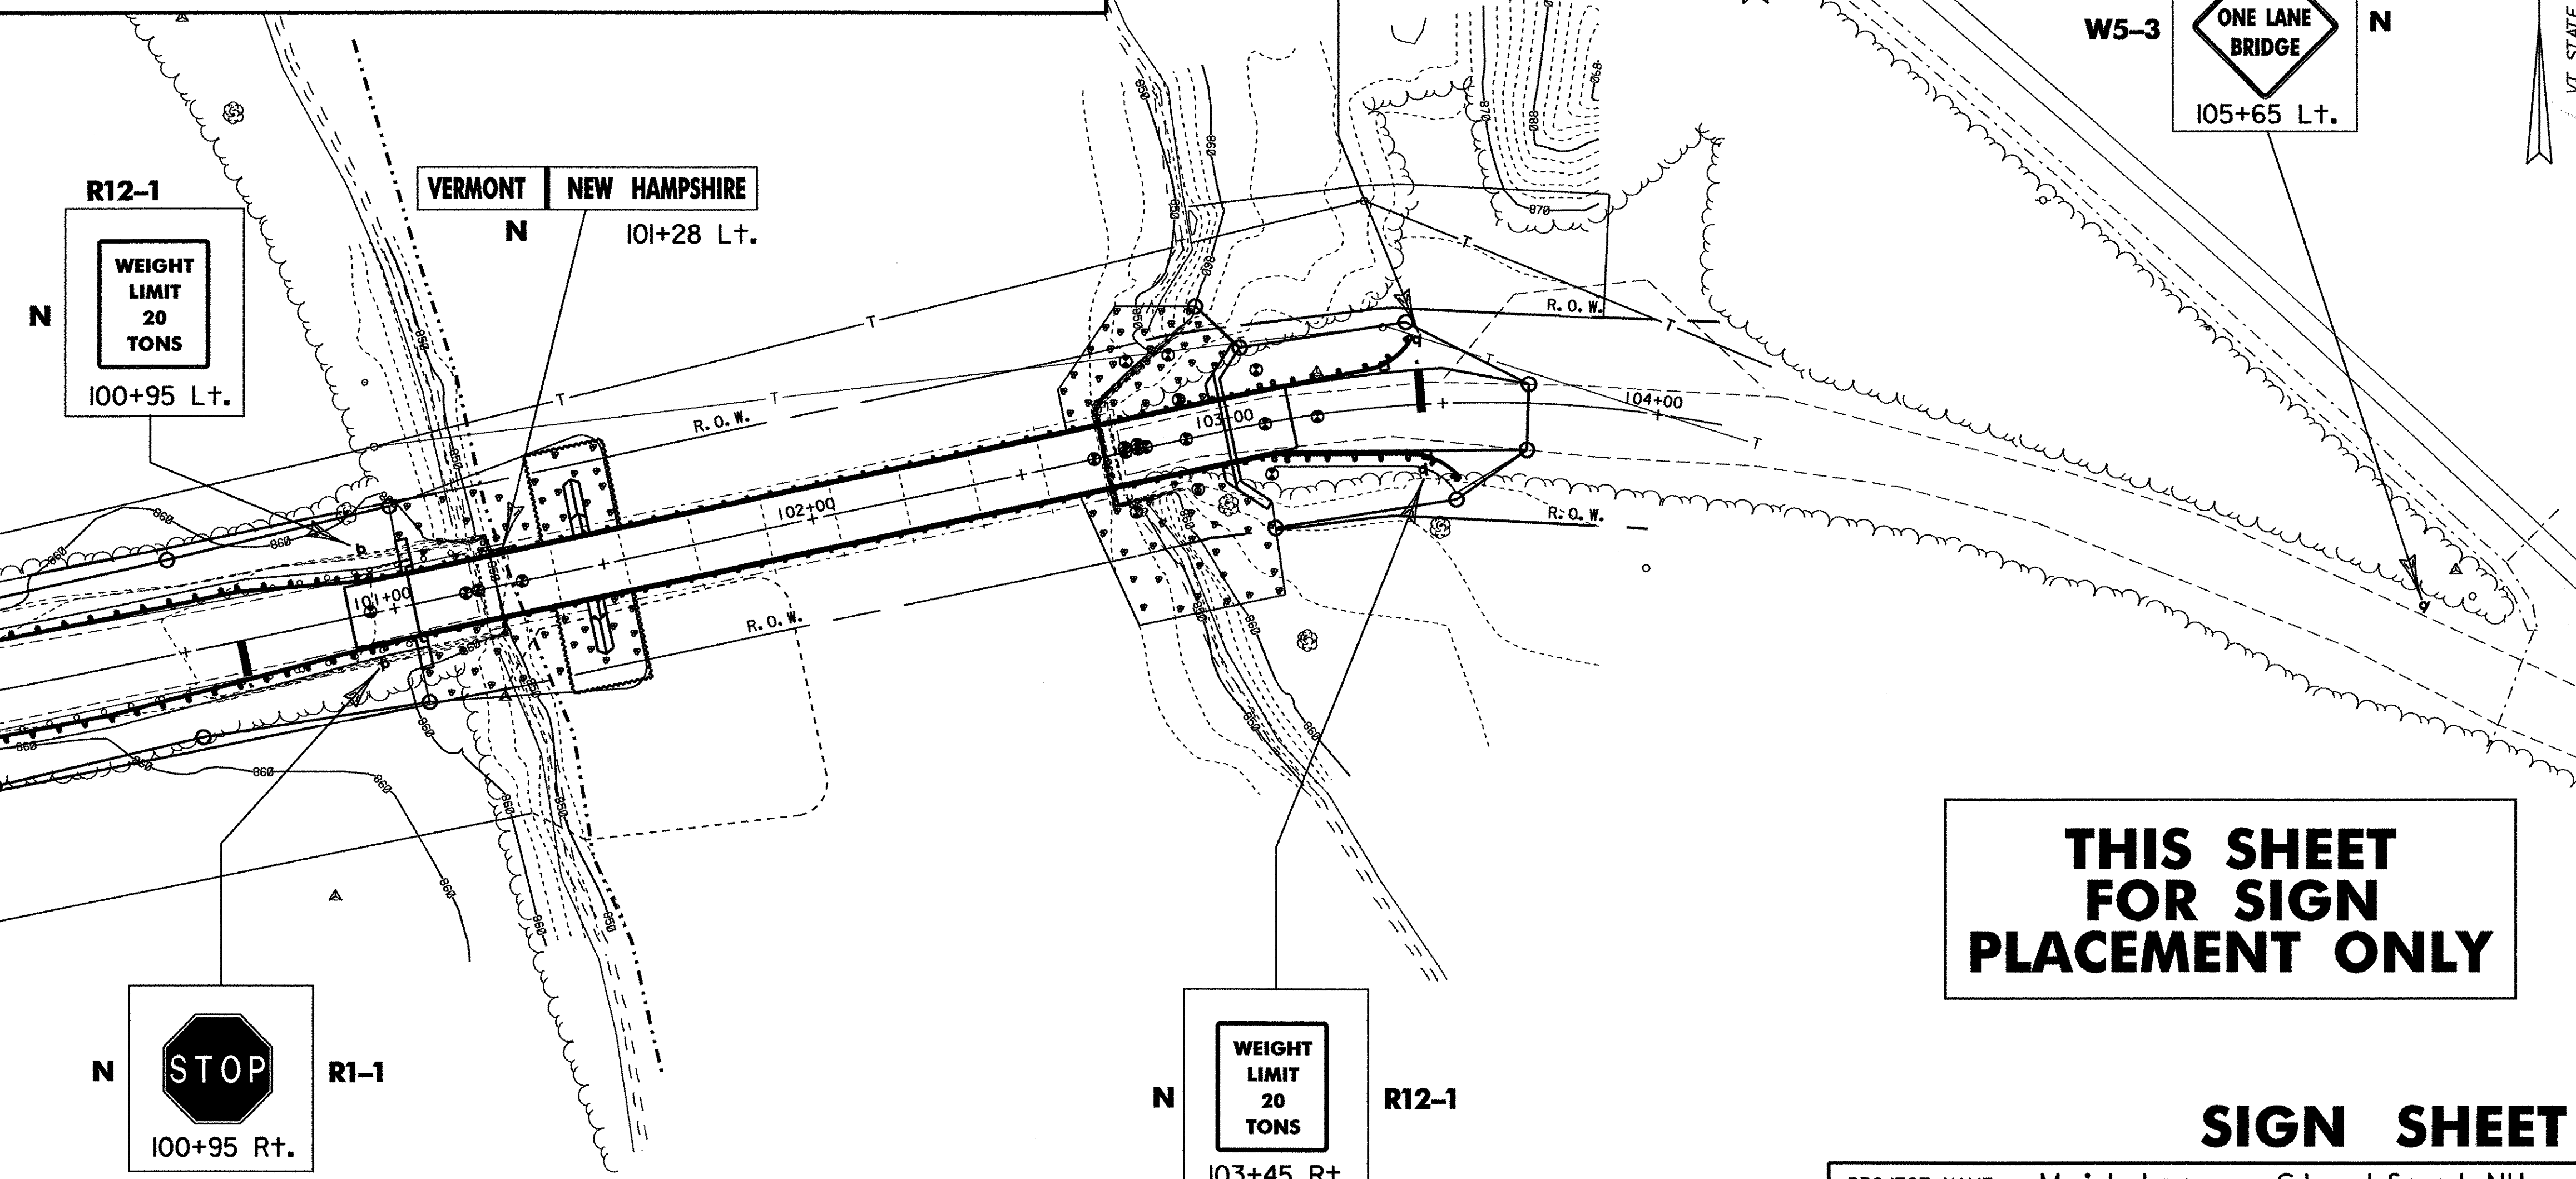
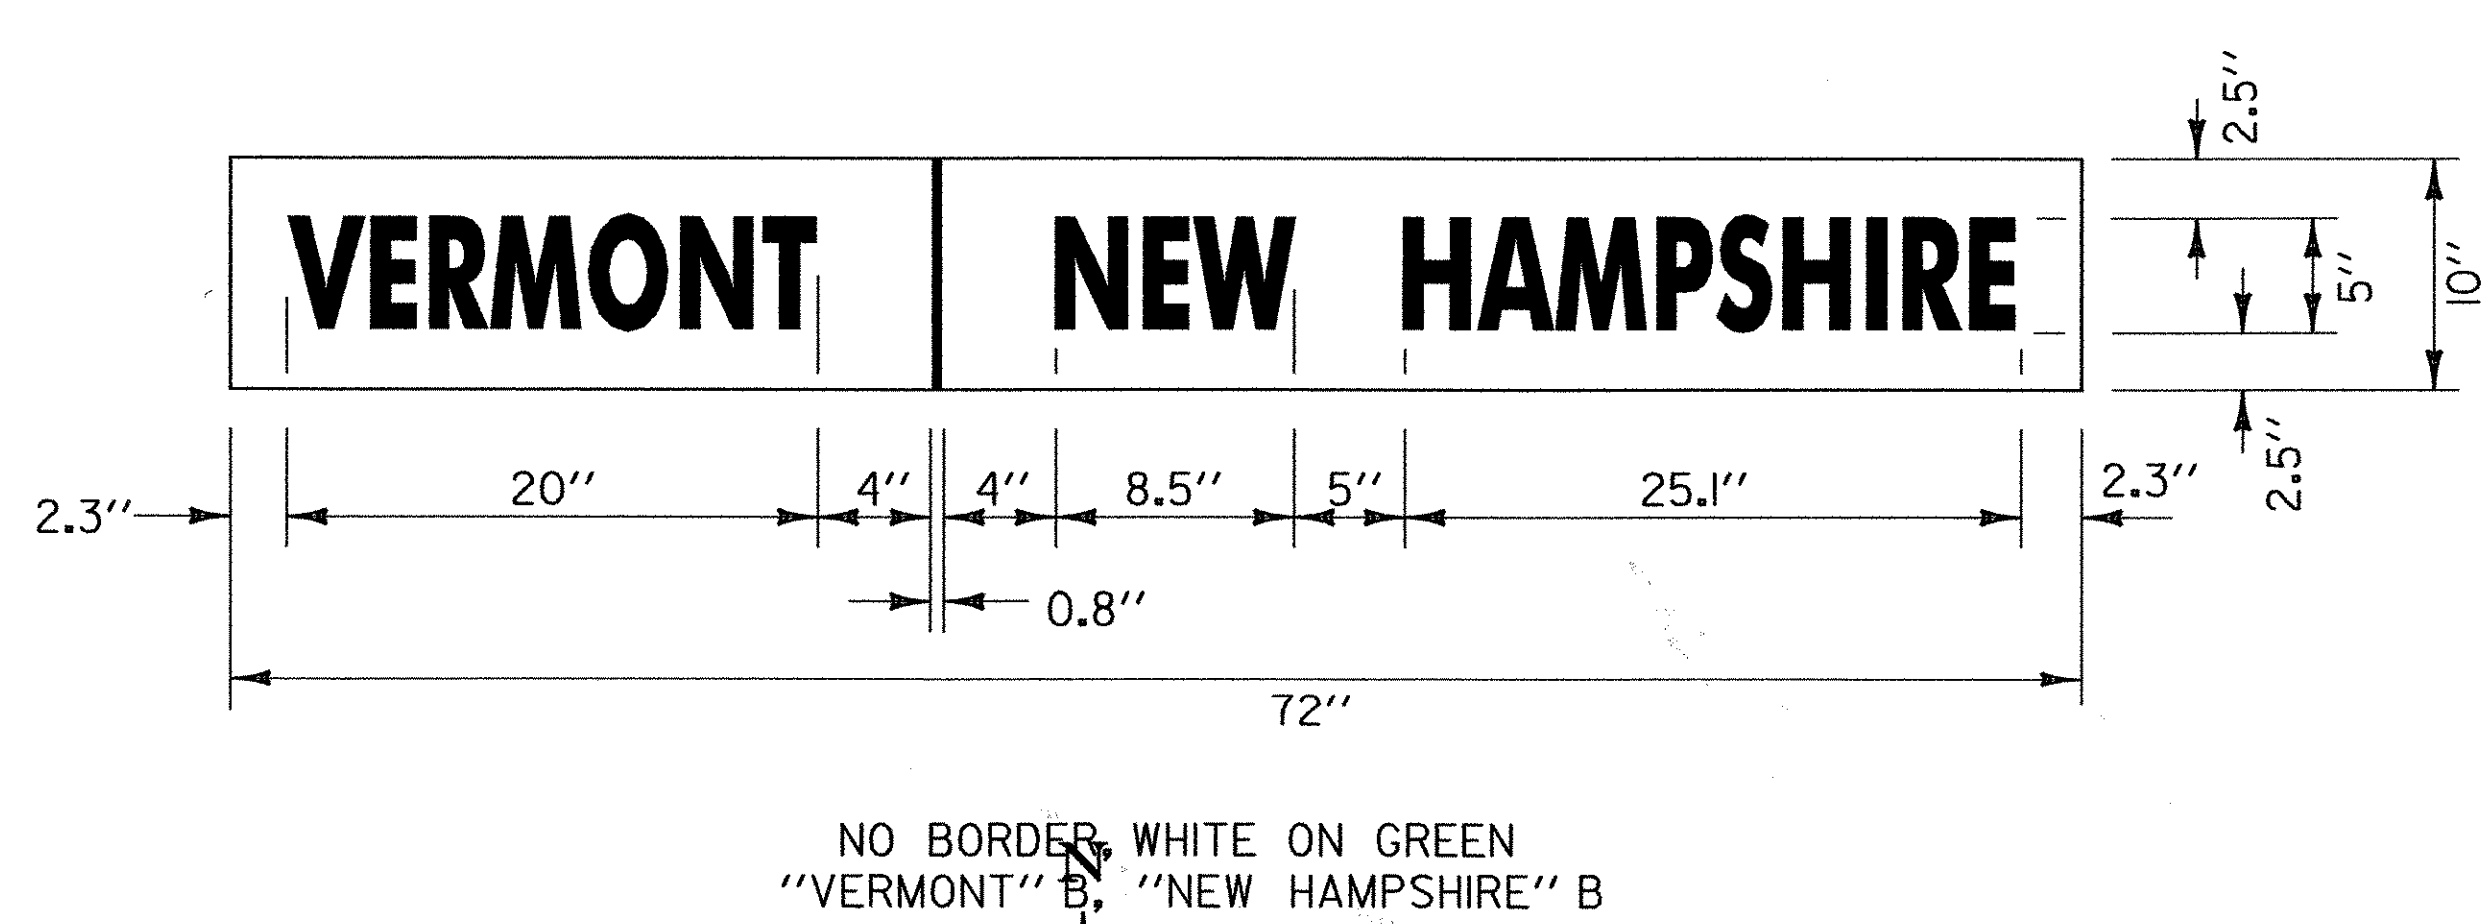


SIGN	DIMENSIONS (INCHES)									
	A	B	C	D	E	F	G	H	J	
MIN.	30	1/2	3/4	5C	3/4	13 3/16	12 1/16	9/8	1 1/8	
STD.	36	5/8	7/8	6C	4	16	15 1/4	1 1/2	2 1/4	
SPECIAL	48	3/4	1 1/4	8C	5	21 1/4	20 1/4	15 3/8	3	



COLORS
 LEGEND-BLACK (NON - REFL)
 BACKGROUND - YELLOW (REFL)

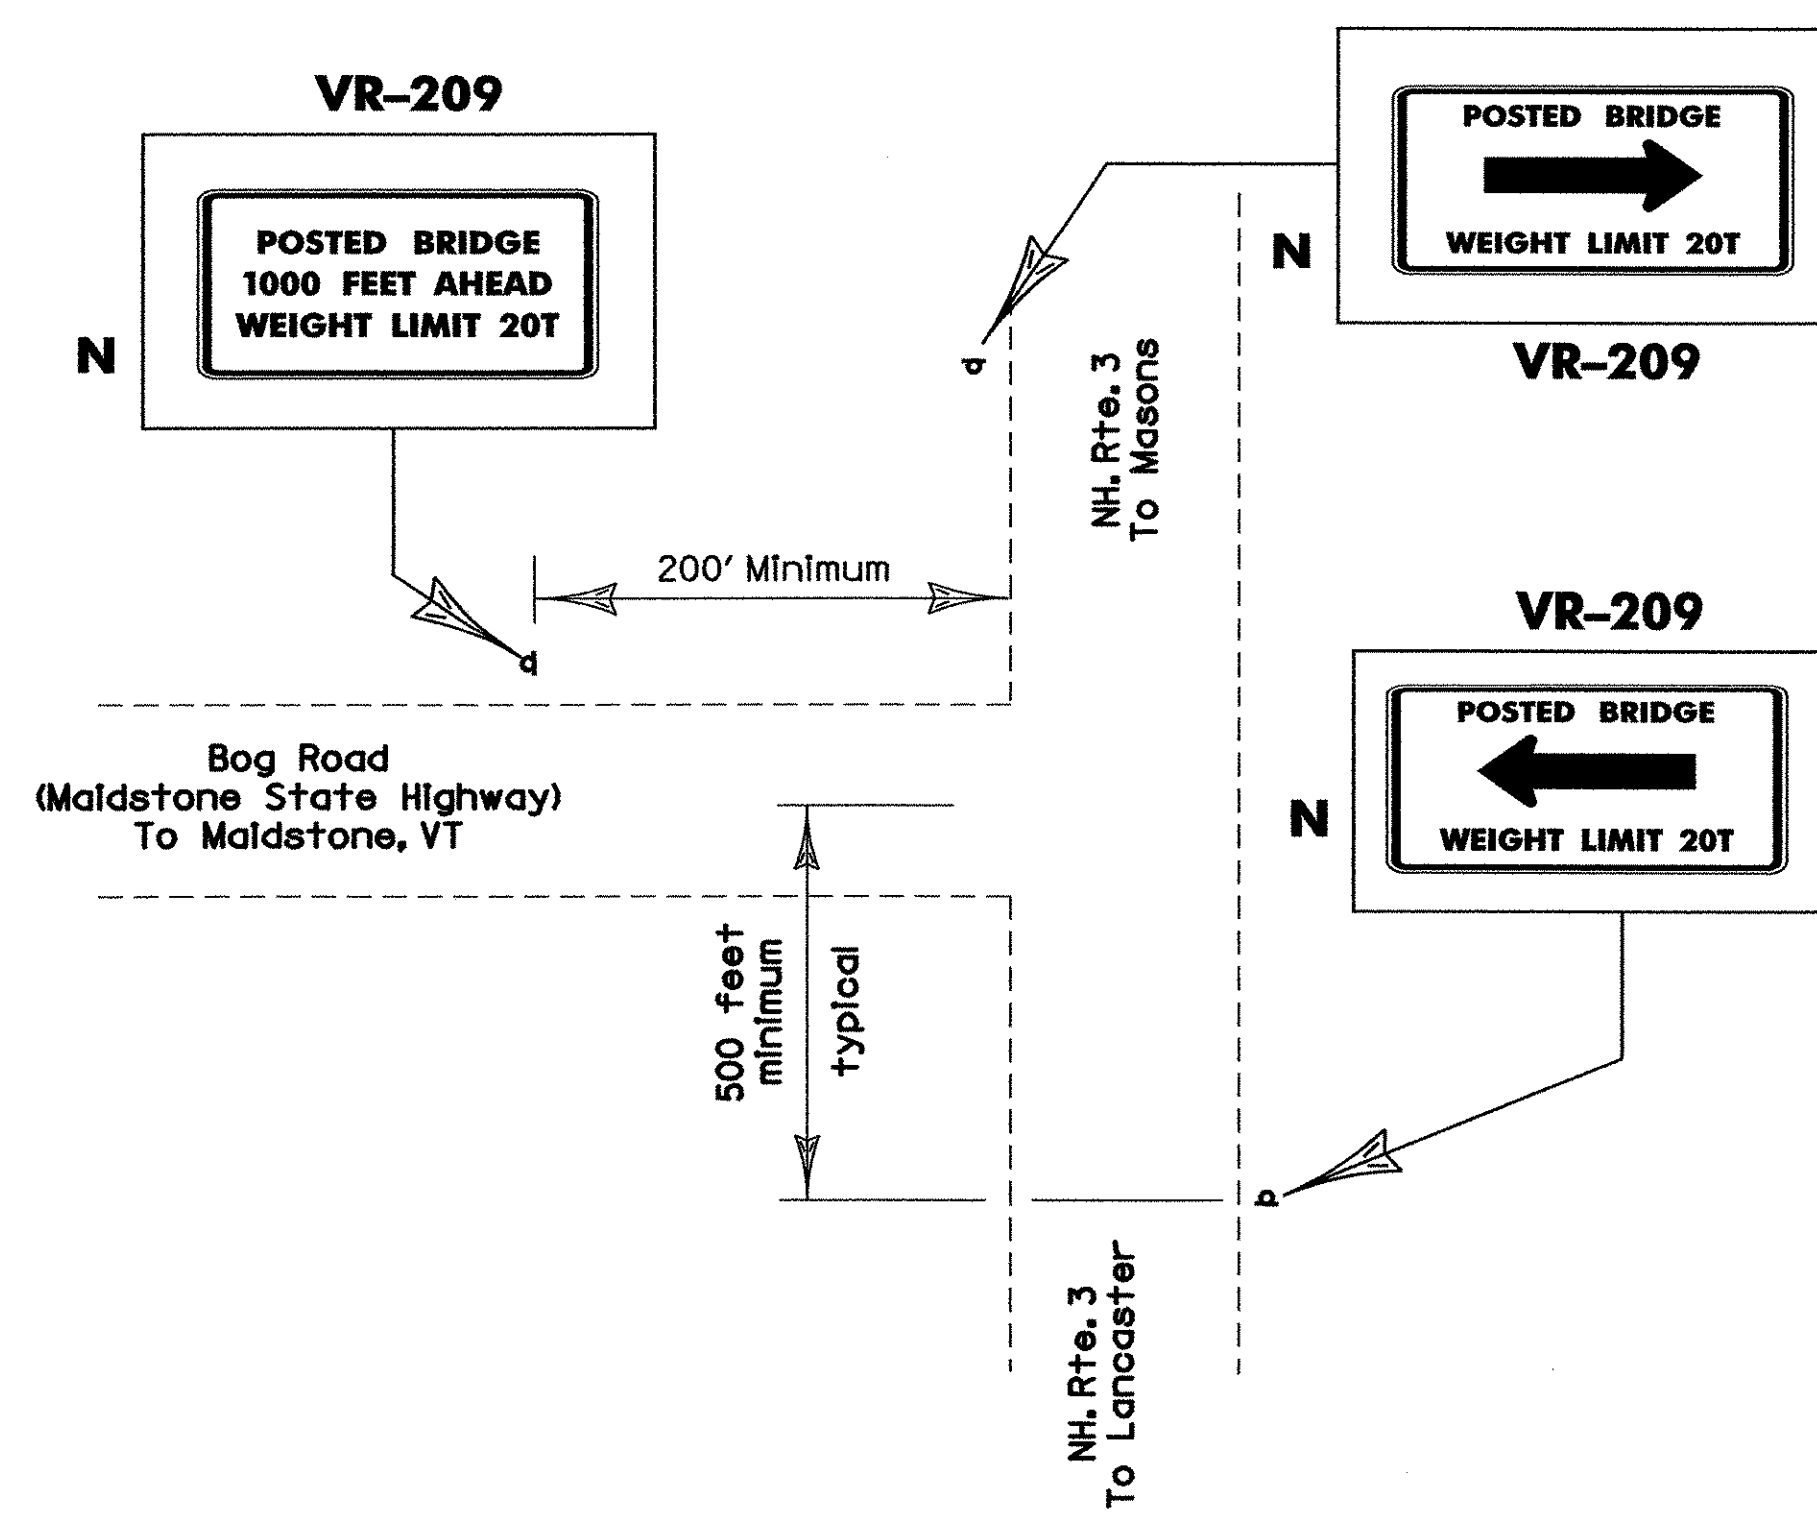

THIS SHEET FOR SIGN PLACEMENT ONLY

SIGN SHEET

PROJECT NAME: Maidstone - Stratford, NH
 PROJECT NUMBER: BHO 1447(24)
 FILE NAME: str5/99e054/se054bdr.dgn
 PROJECT LEADER: Craig Keller
 DESIGNED BY: se054sgn.l
 PLOT DATE: 18-AUG-2003
 DRAWN BY:
 CHECKED BY:
 SHEET 65a OF 65

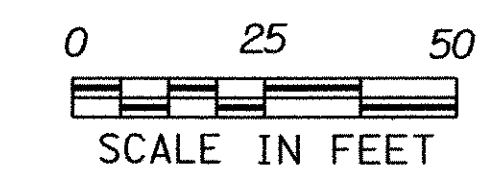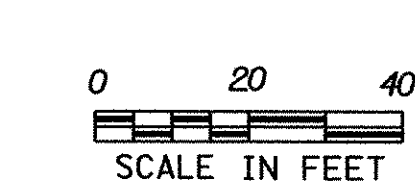

N=New Sign & Post