


DATE _____
 BY _____
 SURVEY _____
 PROJECT _____
 SHEET NO. _____
 TOTAL SHEETS _____
 DRAWN BY _____
 CHECKED BY _____
 APPROVED BY _____

ORIGINAL SURVEY _____
 REVISION _____
 DATE OF REVISION _____
 REVISION NO. _____
 REVISION BY _____
 REVISION CHECKED BY _____
 REVISION APPROVED BY _____

870

860

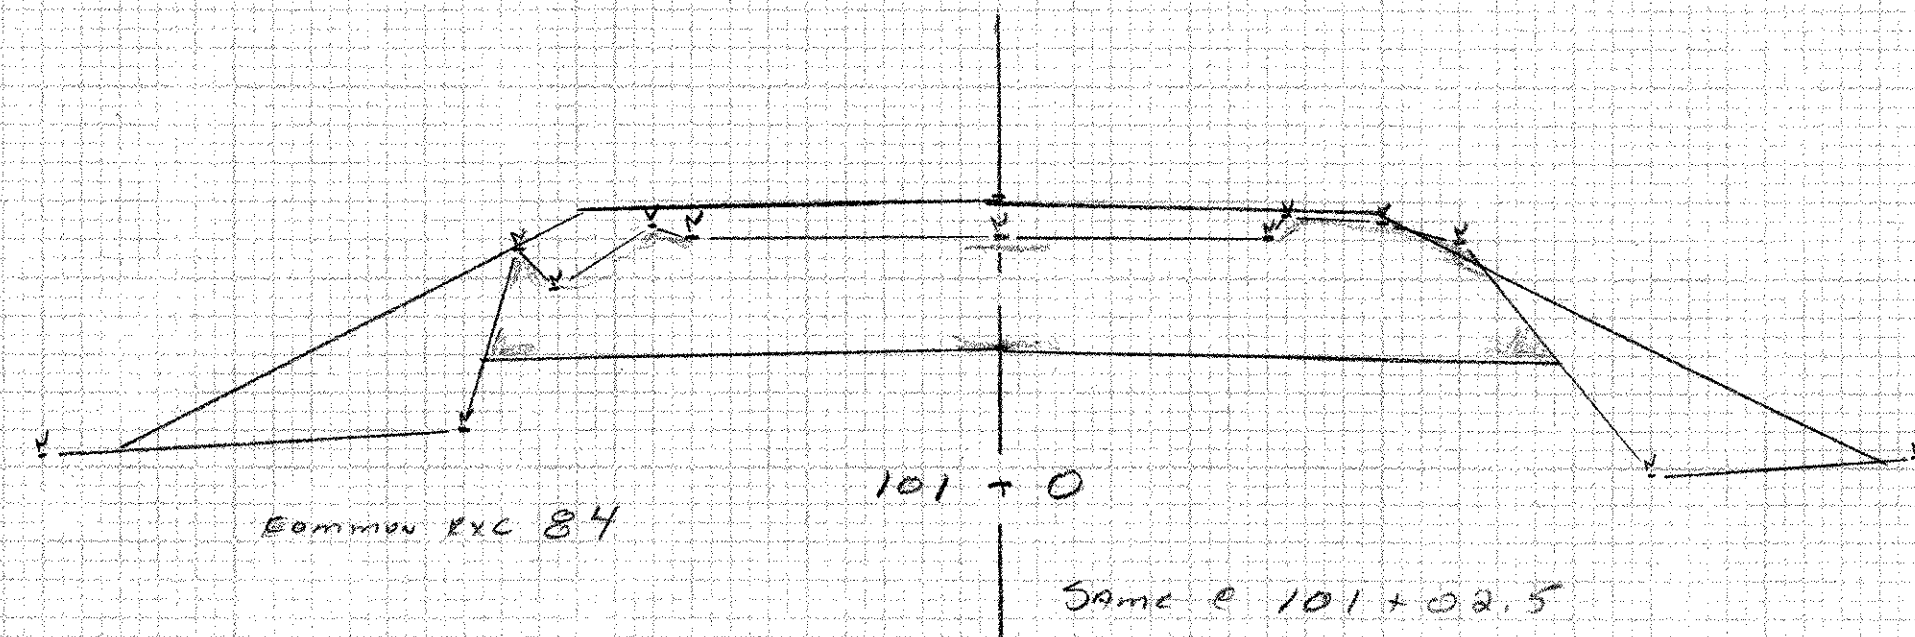

103 + 75
 Common Exc 44
 $2.0 \times 22 = 44$


103 + 50
 Common Exc 46

870

860


870

860

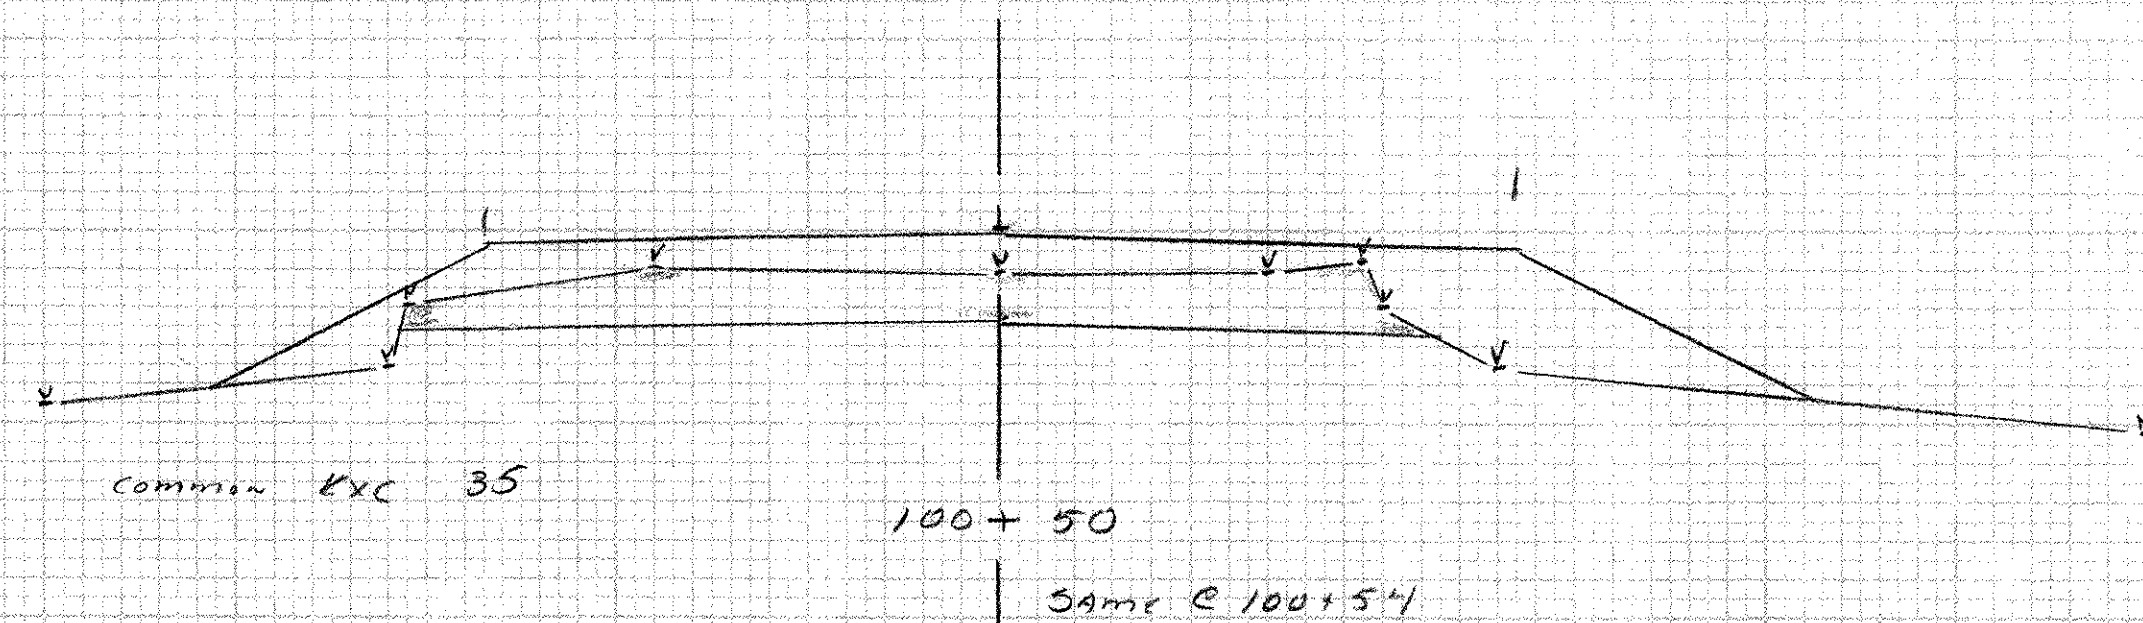

870

860

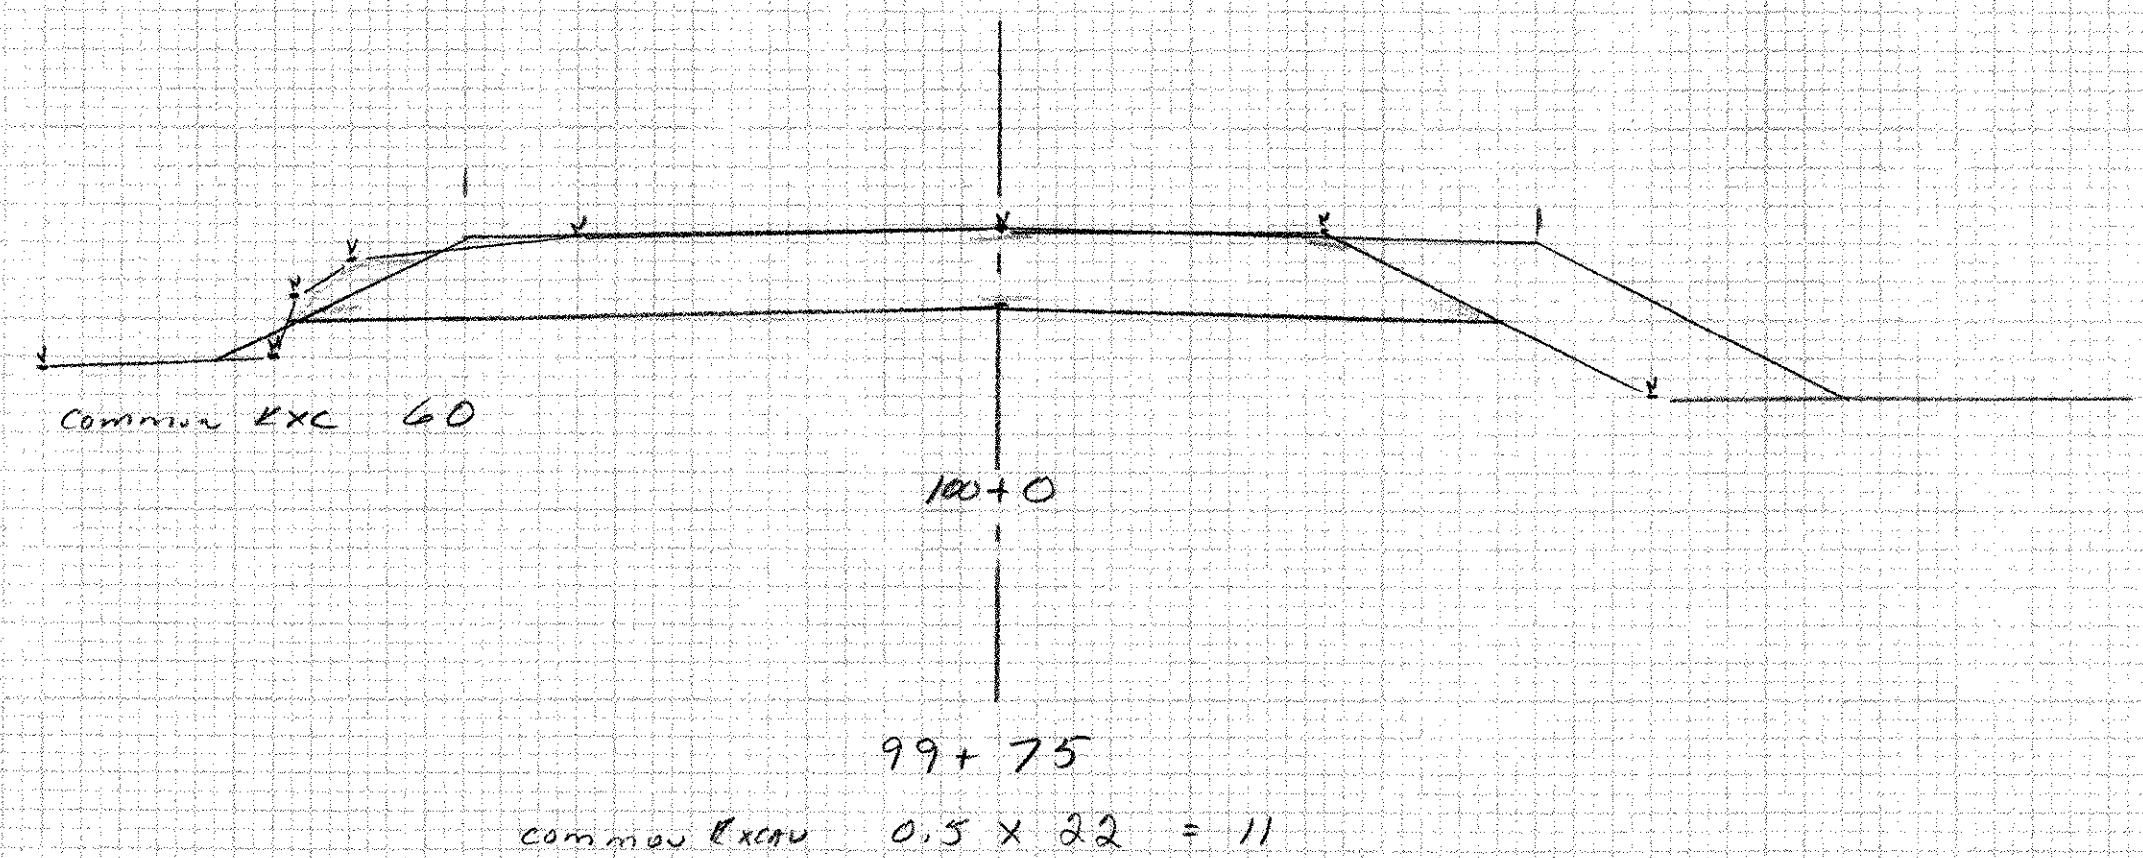

103 + 0
 Same @ 103 + 07 But Common Exc 79
 Common Exc 79

870

860

MAIDSTONE - STRATFORD
 BHO 1447 (24)
 ROADWAY X-SECTIONS
 Common Excavation

Scale 1" = 5' Horiz & Vert