




F:\R\Share\Engineering\STATE\VT\1032196\22-1032196-D002.dwg 11:44:27 3/24/04

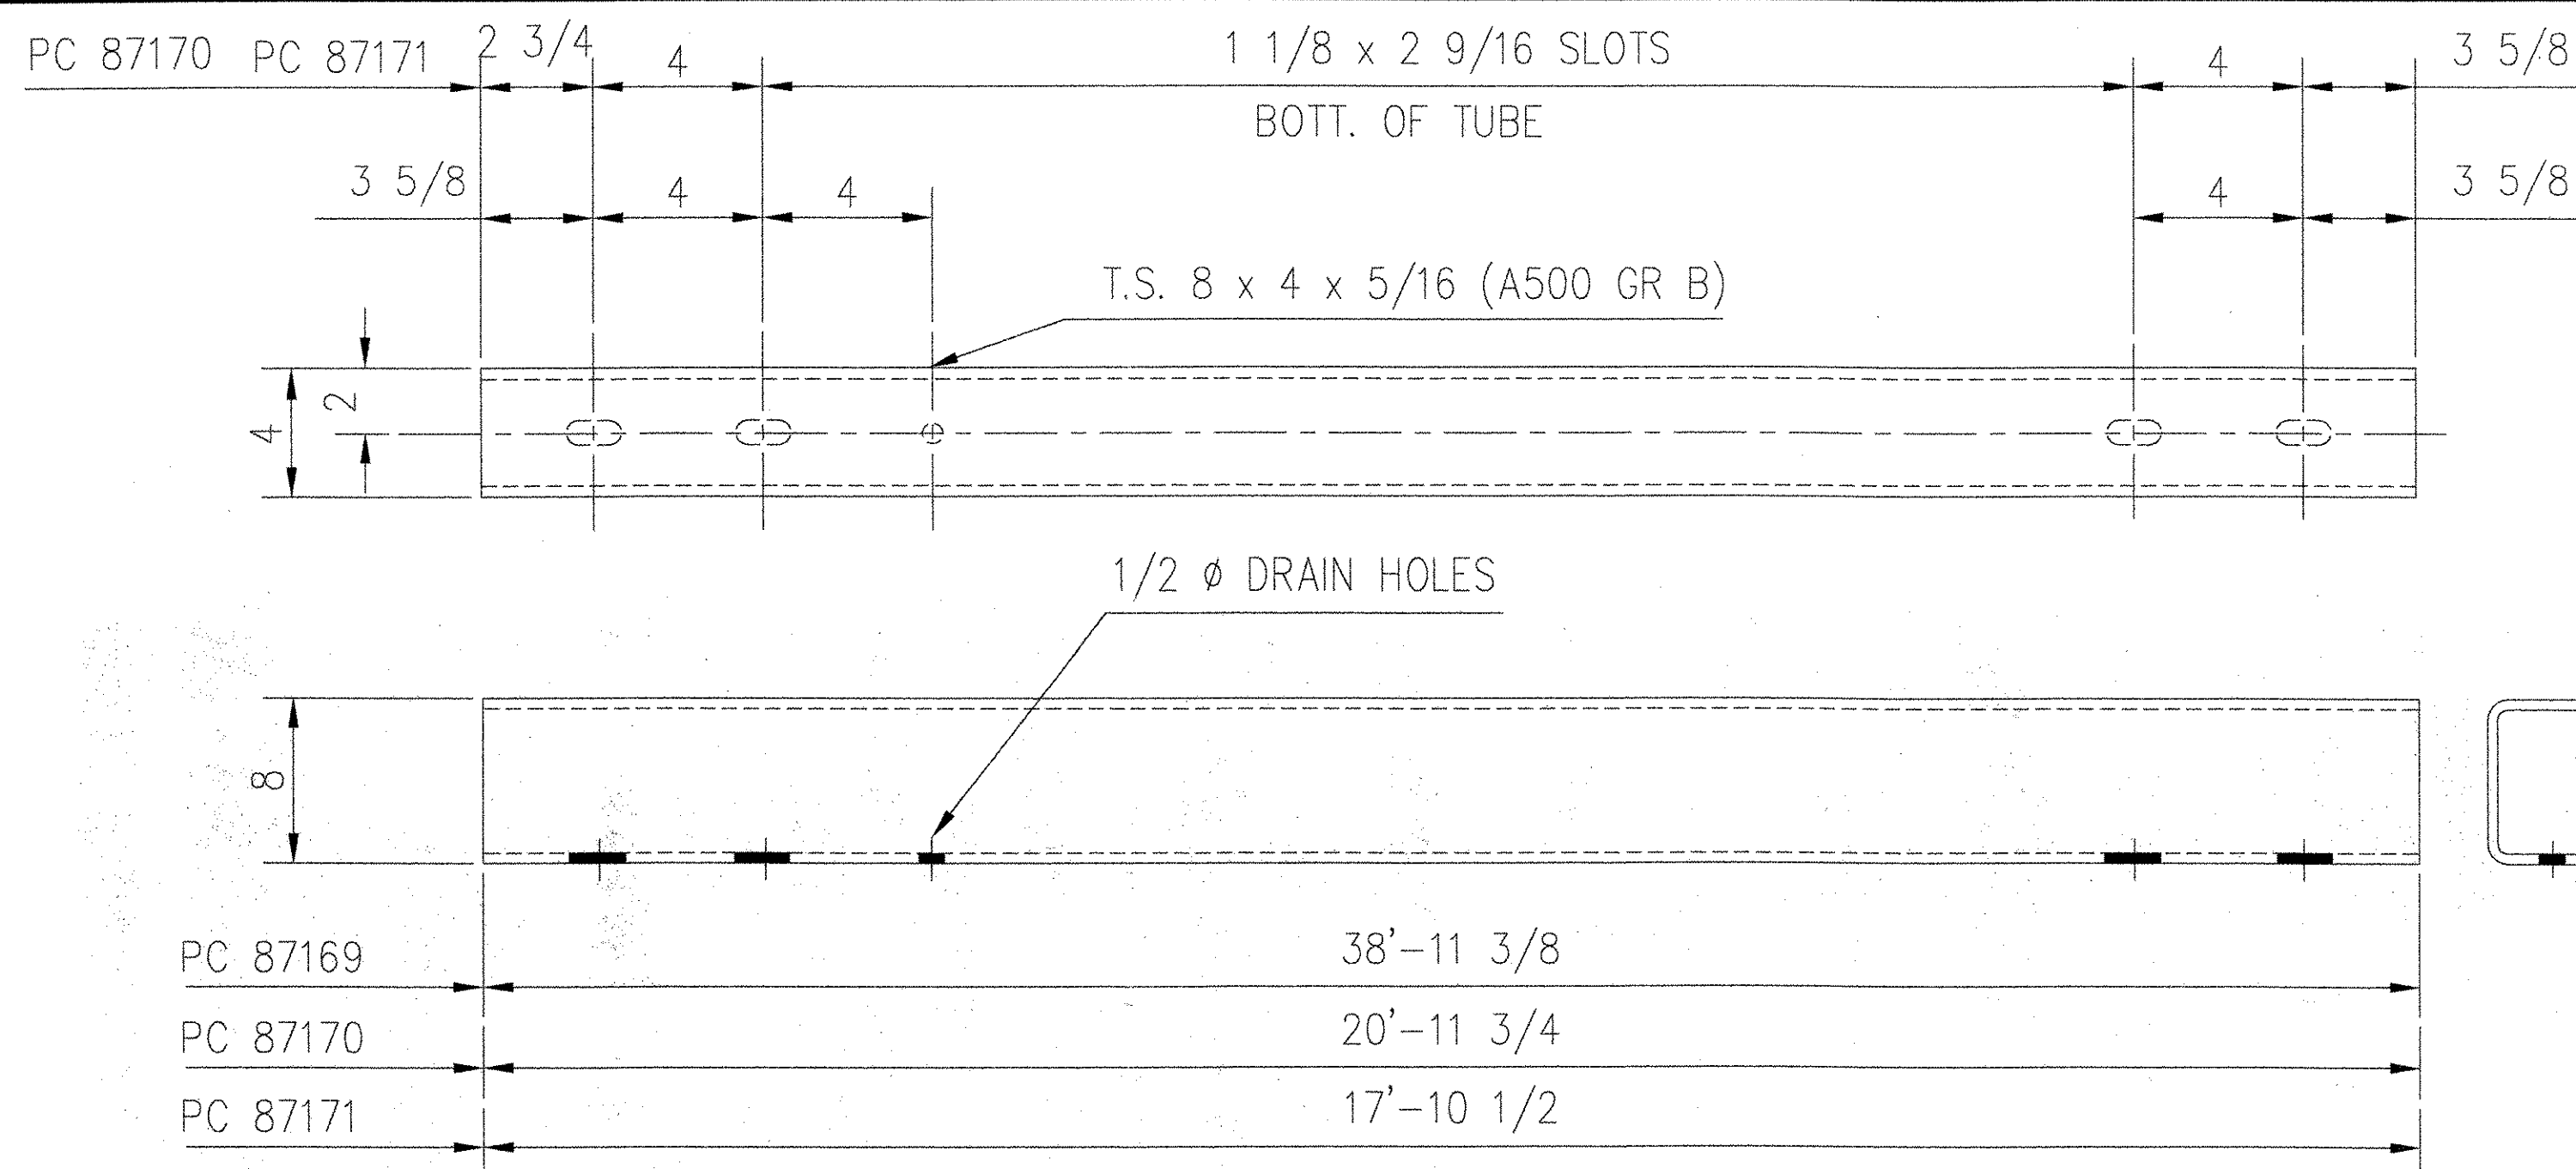

PC 87169	38'-11 3/8"
PC 87170	20'-11 3/4"
PC 87171	17'-10 1/2"


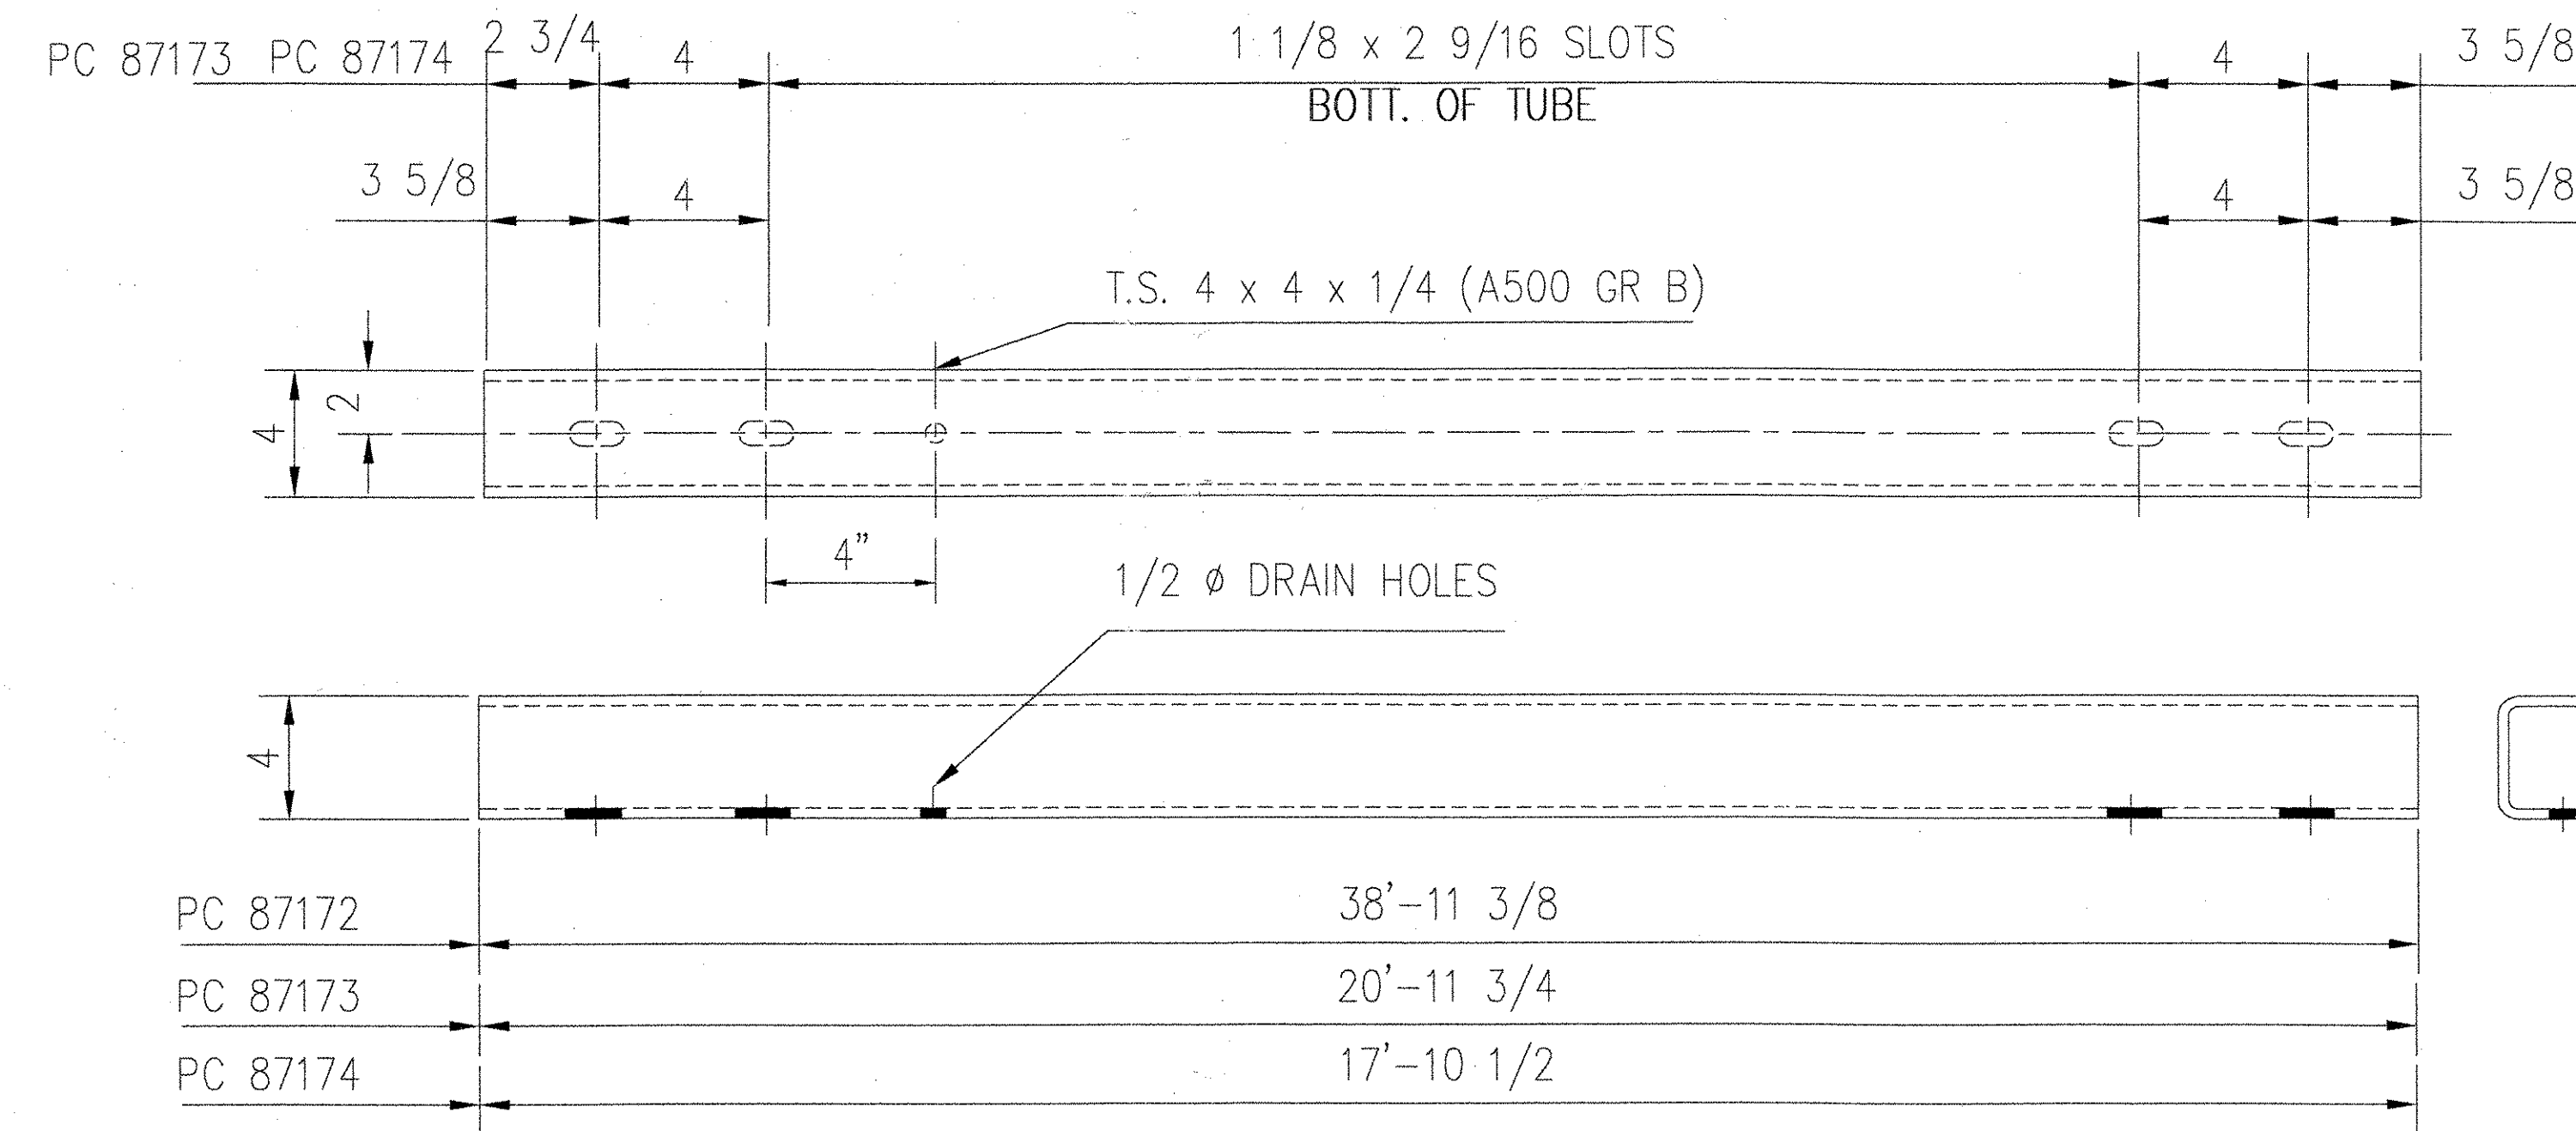


PC 87172	38'-11 3/8"
PC 87173	20'-11 3/4"
PC 87174	17'-10 1/2"

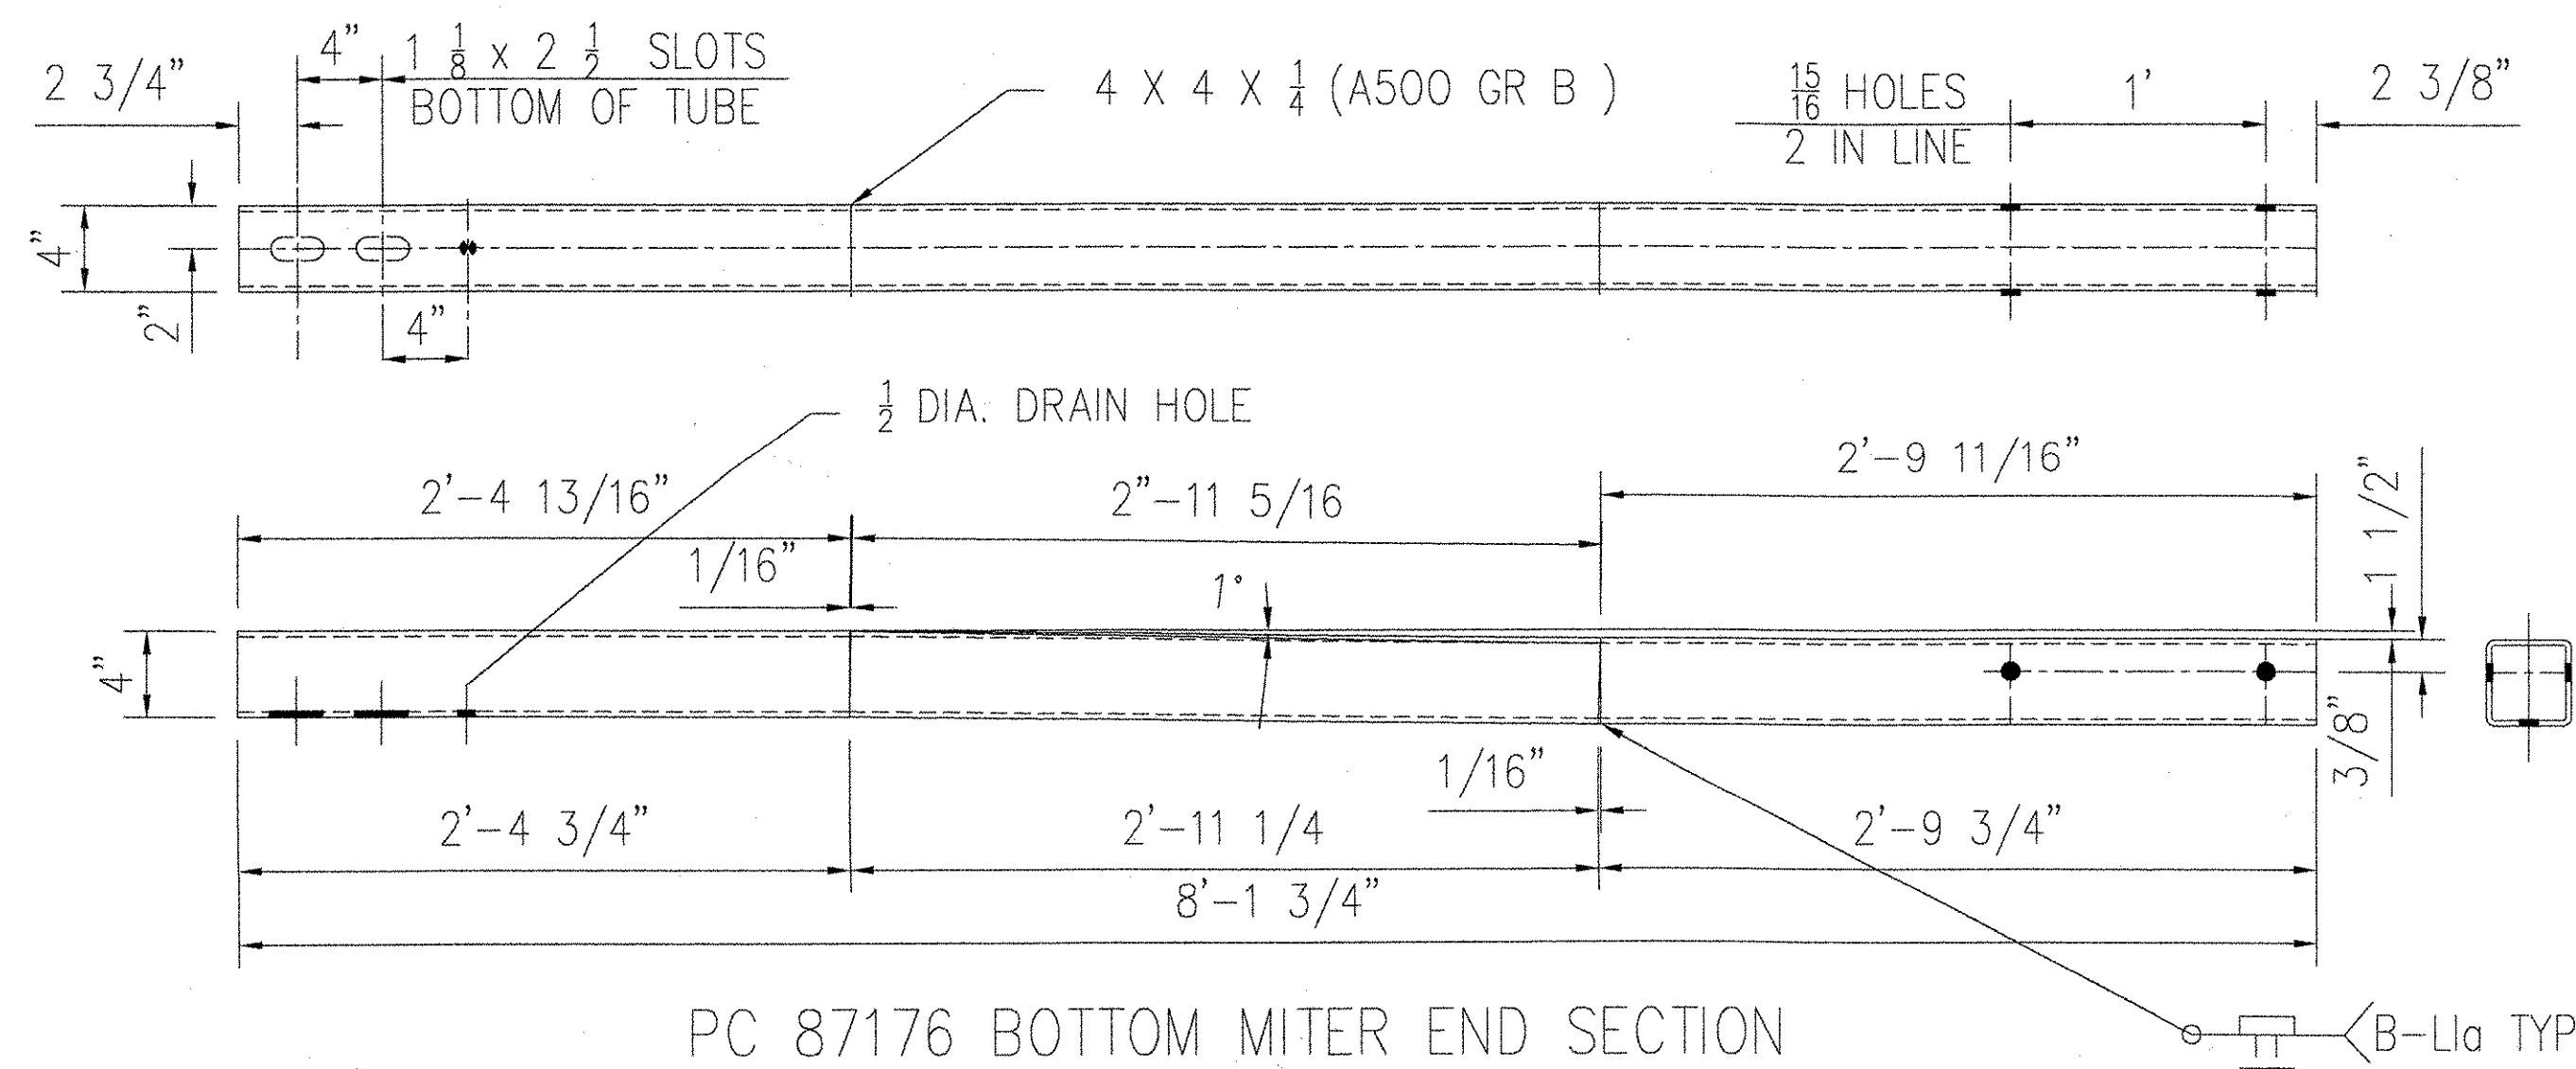

PC 87176 BOTTOM MITER END SECTION


BILL OF MATERIAL				
PRODUCT CODE	QTY.	DESCRIPTION	WT./EA.	REMARKS
87169G	8	TS 8 x 4 x 5/16 x 38' 11 3/8	931.9#	
87170G	2	TS 8 x 4 x 5/16 x 20' 11 3/4	514.5#	
87171G	2	TS 8 x 4 x 5/16 x 17' 10 1/2	442.8#	
87172G	8	TS 4 x 4 x 1/4 x 38' 11 3/8	503.5#	
87173G	2	TS 4 x 4 x 1/4 x 20' 11 3/4	260#	
87174G	2	TS 4 x 4 x 1/4 x 17' 10 1/2	231.3#	
87175G	4	TS 8 x 4 x 5/16 x 8'-2 5/16"	198.2#	MITERED
87176G	4	TS 4 x 4 x 1/4 x 8' 1 13/16"	106.2#	MITERED

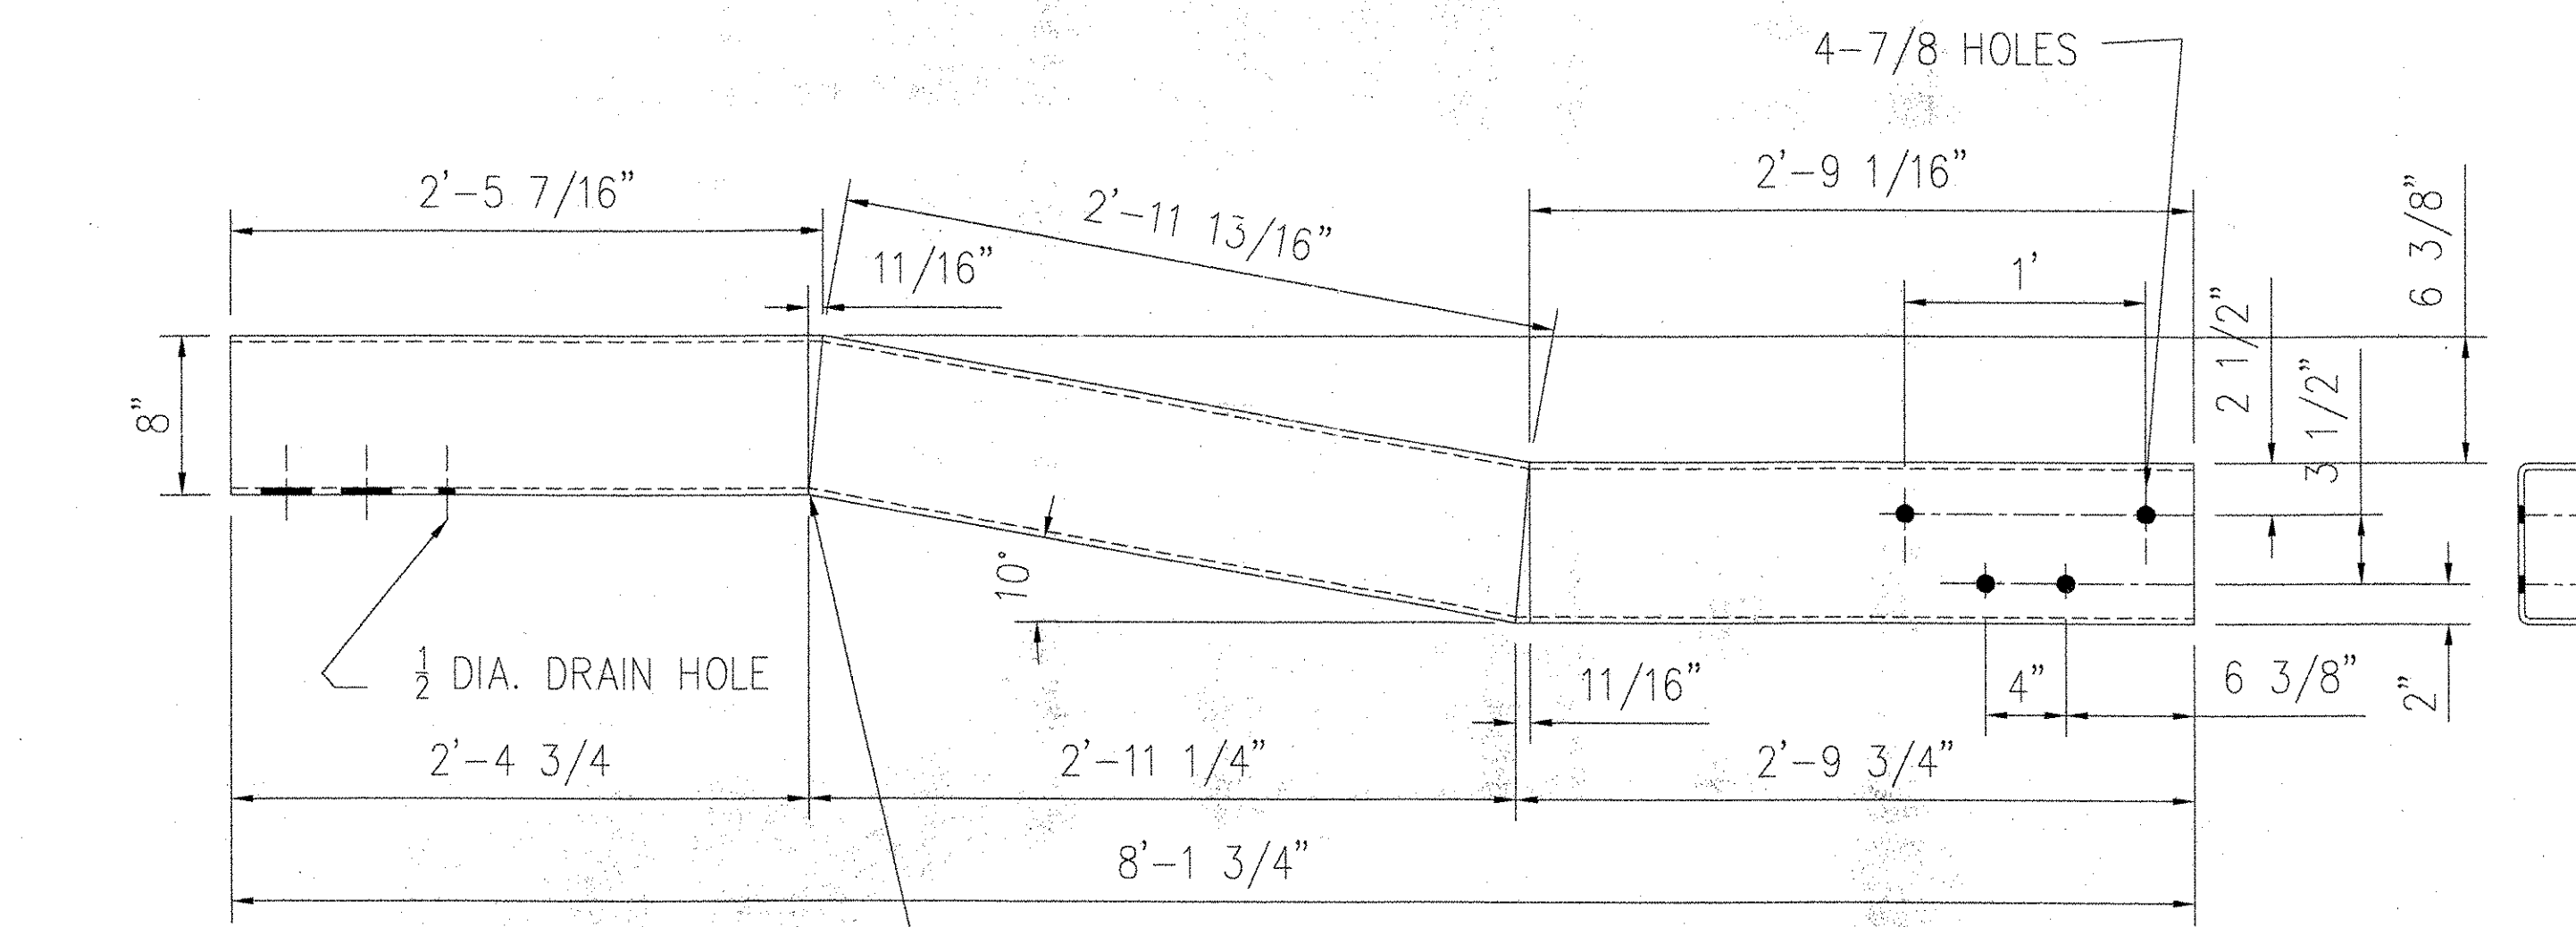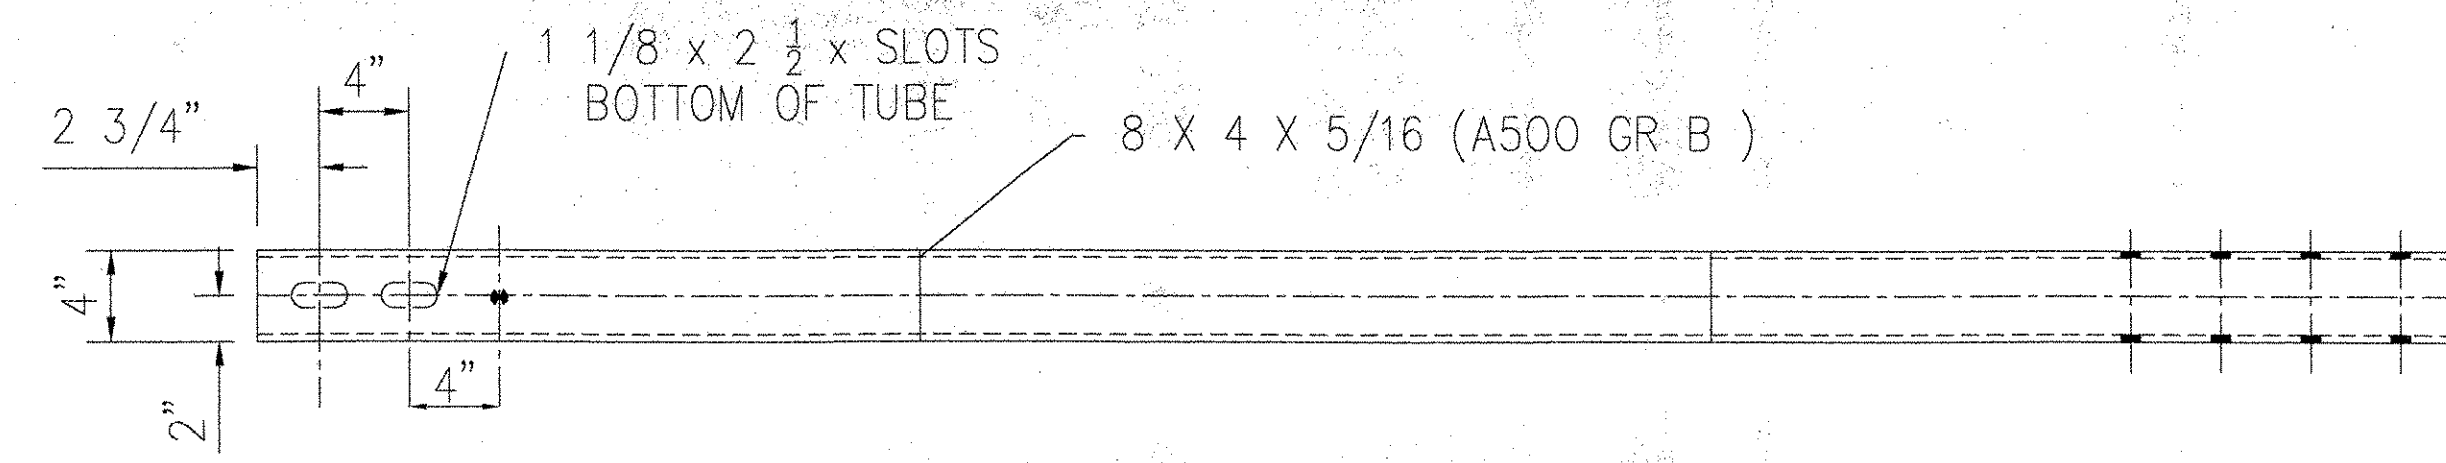

PC 87175 TOP MITER END SECTION

APPROVED EXCEPT AS NOTED

LICHTENSTEIN CONSULTING ENGINEERS, INC.
 This drawing has only been checked for conformance with the design concept of the Project and compliance with the information given in the Contract Documents. Contractor is responsible for dimensions to be confirmed and corrected at the job site; for information that pertains solely to the fabrication processes or to techniques of construction; and for coordination of the work of all trades.
 By: *[Signature]* Date: 04/08/04

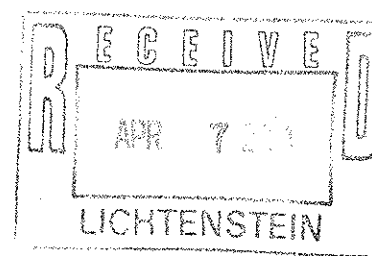

APPROVAL DRAWING

GIRARD ENGINEERING DEPT. ISSUED
 Wednesday, March 24, 2004
TRINITY INDUSTRIES, INC.
 1170 N. STATE STREET
 GIRARD, OHIO 44420

This drawing and the information shown thereon is the sole property of TRINITY INDUSTRIES, INC. Neither the drawing nor such information is to be used for any purpose other than that for which it was specifically furnished by TRINITY INDUSTRIES, INC., nor is any reproduction authorized without written permission.

VA NOT RECEIVED
 OK'D BY: *[Signature]* OK'D BY: *[Signature]*
 APR 8 1 2004
 RESUBMIT APPROVED *[Signature]*
 BY: DATE 04-28-04

ERECTION DETAILS ARE ON E1 AND E2 AND E3 OF 3

REV.	CHK'D	BY	DATE	REMARKS
PAY ITEM 525.33 NETC 2-RAIL				
STATE OF VERMONT AGENCY OF TRANSPORTATION TOWN OF MADISON, VT STRATFORD, NH PROJECT NO. NH BHO-1447-(24)				DRAWN: MARLEY CHECKED: SAR APPROVED:
CUSTOMER: WINTERSET INC		P.O. No. C-1308		DATE: 3/4/04
TRINITY INDUSTRIES, INC. HIGHWAY SAFETY PRODUCTS 2525 STEMMONS FREEWAY, DALLAS, TX 75207				ENG. FILE #: 22-1032196 SHT. No.: D2 OF 3 TRINITY SALES ORDER NO.: (22)1032196
				REV: 0