


**INTERIOR GLU-LAM DECK
PANEL 3 THUS**

(1)-INTERIOR GLU-LAM DECK PANEL THUS
 (1)-INTERIOR GLU-LAM DECK PANEL THUS REVERSE (BEVEL REVERSE ONLY)
 (SEE SHT. 1 FOR 1/4\"/>

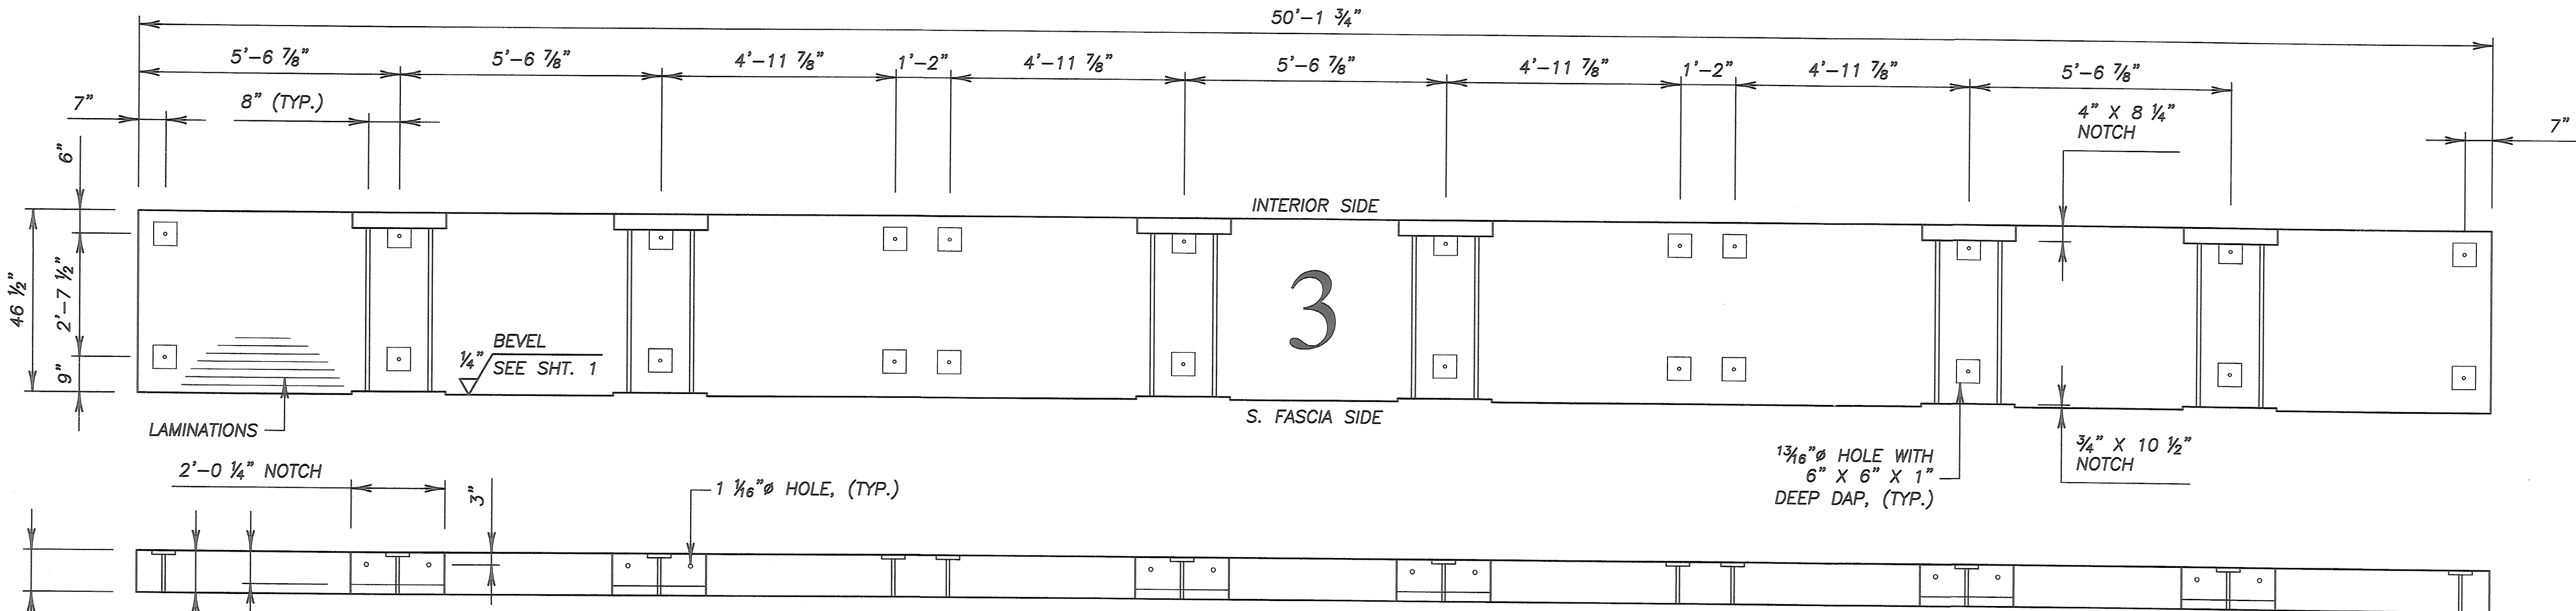

**SOUTH FASCIA GLU-LAM DECK
PANEL 3 THUS**

(1)-SOUTH FASCIA GLU-LAM DECK PANEL THUS
 10 1/2\"/>

SPECIFICATIONS:
 GLU-LAM BEAMS TO BE SOUTHERN YELLOW PINE, COMB. SYMB. 2, SP/SP.
 GLU-LAMS TO BE INDUSTRIAL IN APPEARANCE, FILL ALL VOIDS.
 GLU-LAMS ARE NOT TO BE END SEALED, SURFACE SEALED, OR WRAPPED.
 GLU-LAMS TO BE PENTA TREATED AFTER FABRICATION IN ACCORDANCE WITH THE REQUIREMENTS OF AASHTO M133.
 ENDS OF GLU-LAMS TO BE PLUMB.
 GLU-LAMS SHALL BE INCISED FOR TREATING.

GLU-LAMS SHALL BE MANUFACTURED USING WET-USE ADHESIVES.
 GLU-LAMS SHALL BE MARKED WITH A QUALIFIED INSPECTION & TESTING AGENCY MARK PRIOR TO TREATMENT & A CERTIFICATE & TEST RESULTS INDICATING CONFORMANCE TO ANSI/AITC A190.1 SHALL BE PROVIDED.
 ALL HOLES SHALL BE DRILLED PERPENDICULAR TO SURFACE SHOWN TO ASSURE FIELD PLACEMENT OF BEAMS, DIAPHRAGMS, ATTACHING STEEL, ETC...

APPROVED

RECEIVED
 OK'D BY _____ OK'D BY _____
 MAY 19 2004
 RESUBMIT _____ APPROVED _____
 BY _____ DATE _____

DISCLAIMER:
 PLANS ARE FOR FABRICATION PURPOSED ONLY. SIZE OF DECKS GIVEN. WHEELER NOT RESPONSIBLE FOR DESIGN LOADS.

DO NOT SCALE DRAWINGS

STATE OF VERMONT
 AGENCY OF TRANSPORTATION
 PROPOSED IMPROVEMENT BRIDGE PROJECT

PANEL 3 PREFRAMING

SHOPS PREPARED BY:
WHEELER CONSOLIDATED
 12127 WHITEWOOD SERVICE ROAD
 WHITEWOOD, SD 57793 (605) 269-2372

| | |
|----------------------|------------------|
| TRACKING NO.: T11547 | ORDER NO.: 11245 |
| DATE: 1/20/04 | DWN: LAF |
| CHKD. MAC | SHEET 5 OF 10 |