


CURB & SCUPPER LAYOUT

NOTE:
SEE CURB & SCUPPER PREFRAMING DETAILS SHEETS 9 & 10.



RECEIVED
OK'D BY _____
MAY 19 2004
RESUBMIT _____ APPROVED _____
BY _____ DATE _____

DO NOT SCALE DRAWINGS

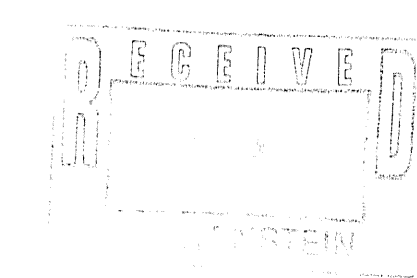

STATE OF VERMONT
AGENCY OF TRANSPORTATION
PROPOSED IMPROVEMENT BRIDGE PROJECT

CURB & SCUPPER LAYOUT

SHOPS PREPARED BY:
WHEELER CONSOLIDATED
12127 WHITEWOOD SERVICE ROAD
WHITEWOOD, SD 57793 (605) 269-2372

TRACKING NO.: T11547	ORDER NO.: 11245
DATE: 1/20/04	DWN: LAF
CHKD. MAC	SHEET 8 OF 10