


- NOTES: (1) FOR DESCRIPTIONS OF LAYOUT POINTS AND CURVE DATA, SEE LAYOUT POINTS & CONSTRUCTION NOTES SHEET.  
 (2) FOR CONSTRUCTION NOTES, SEE LAYOUT POINTS & CONSTRUCTION NOTES SHEET.  
 (3) ALL SIDEWALKS ENTERING A CROSSWALK SHALL HAVE THE APPROPRIATE RAMP CONSTRUCTED PER VTRANS STANDARDS C-3A & C-3B.  
 (4) IF CURB RADIUS IS NOT DEFINED ASSUME R=5.0'

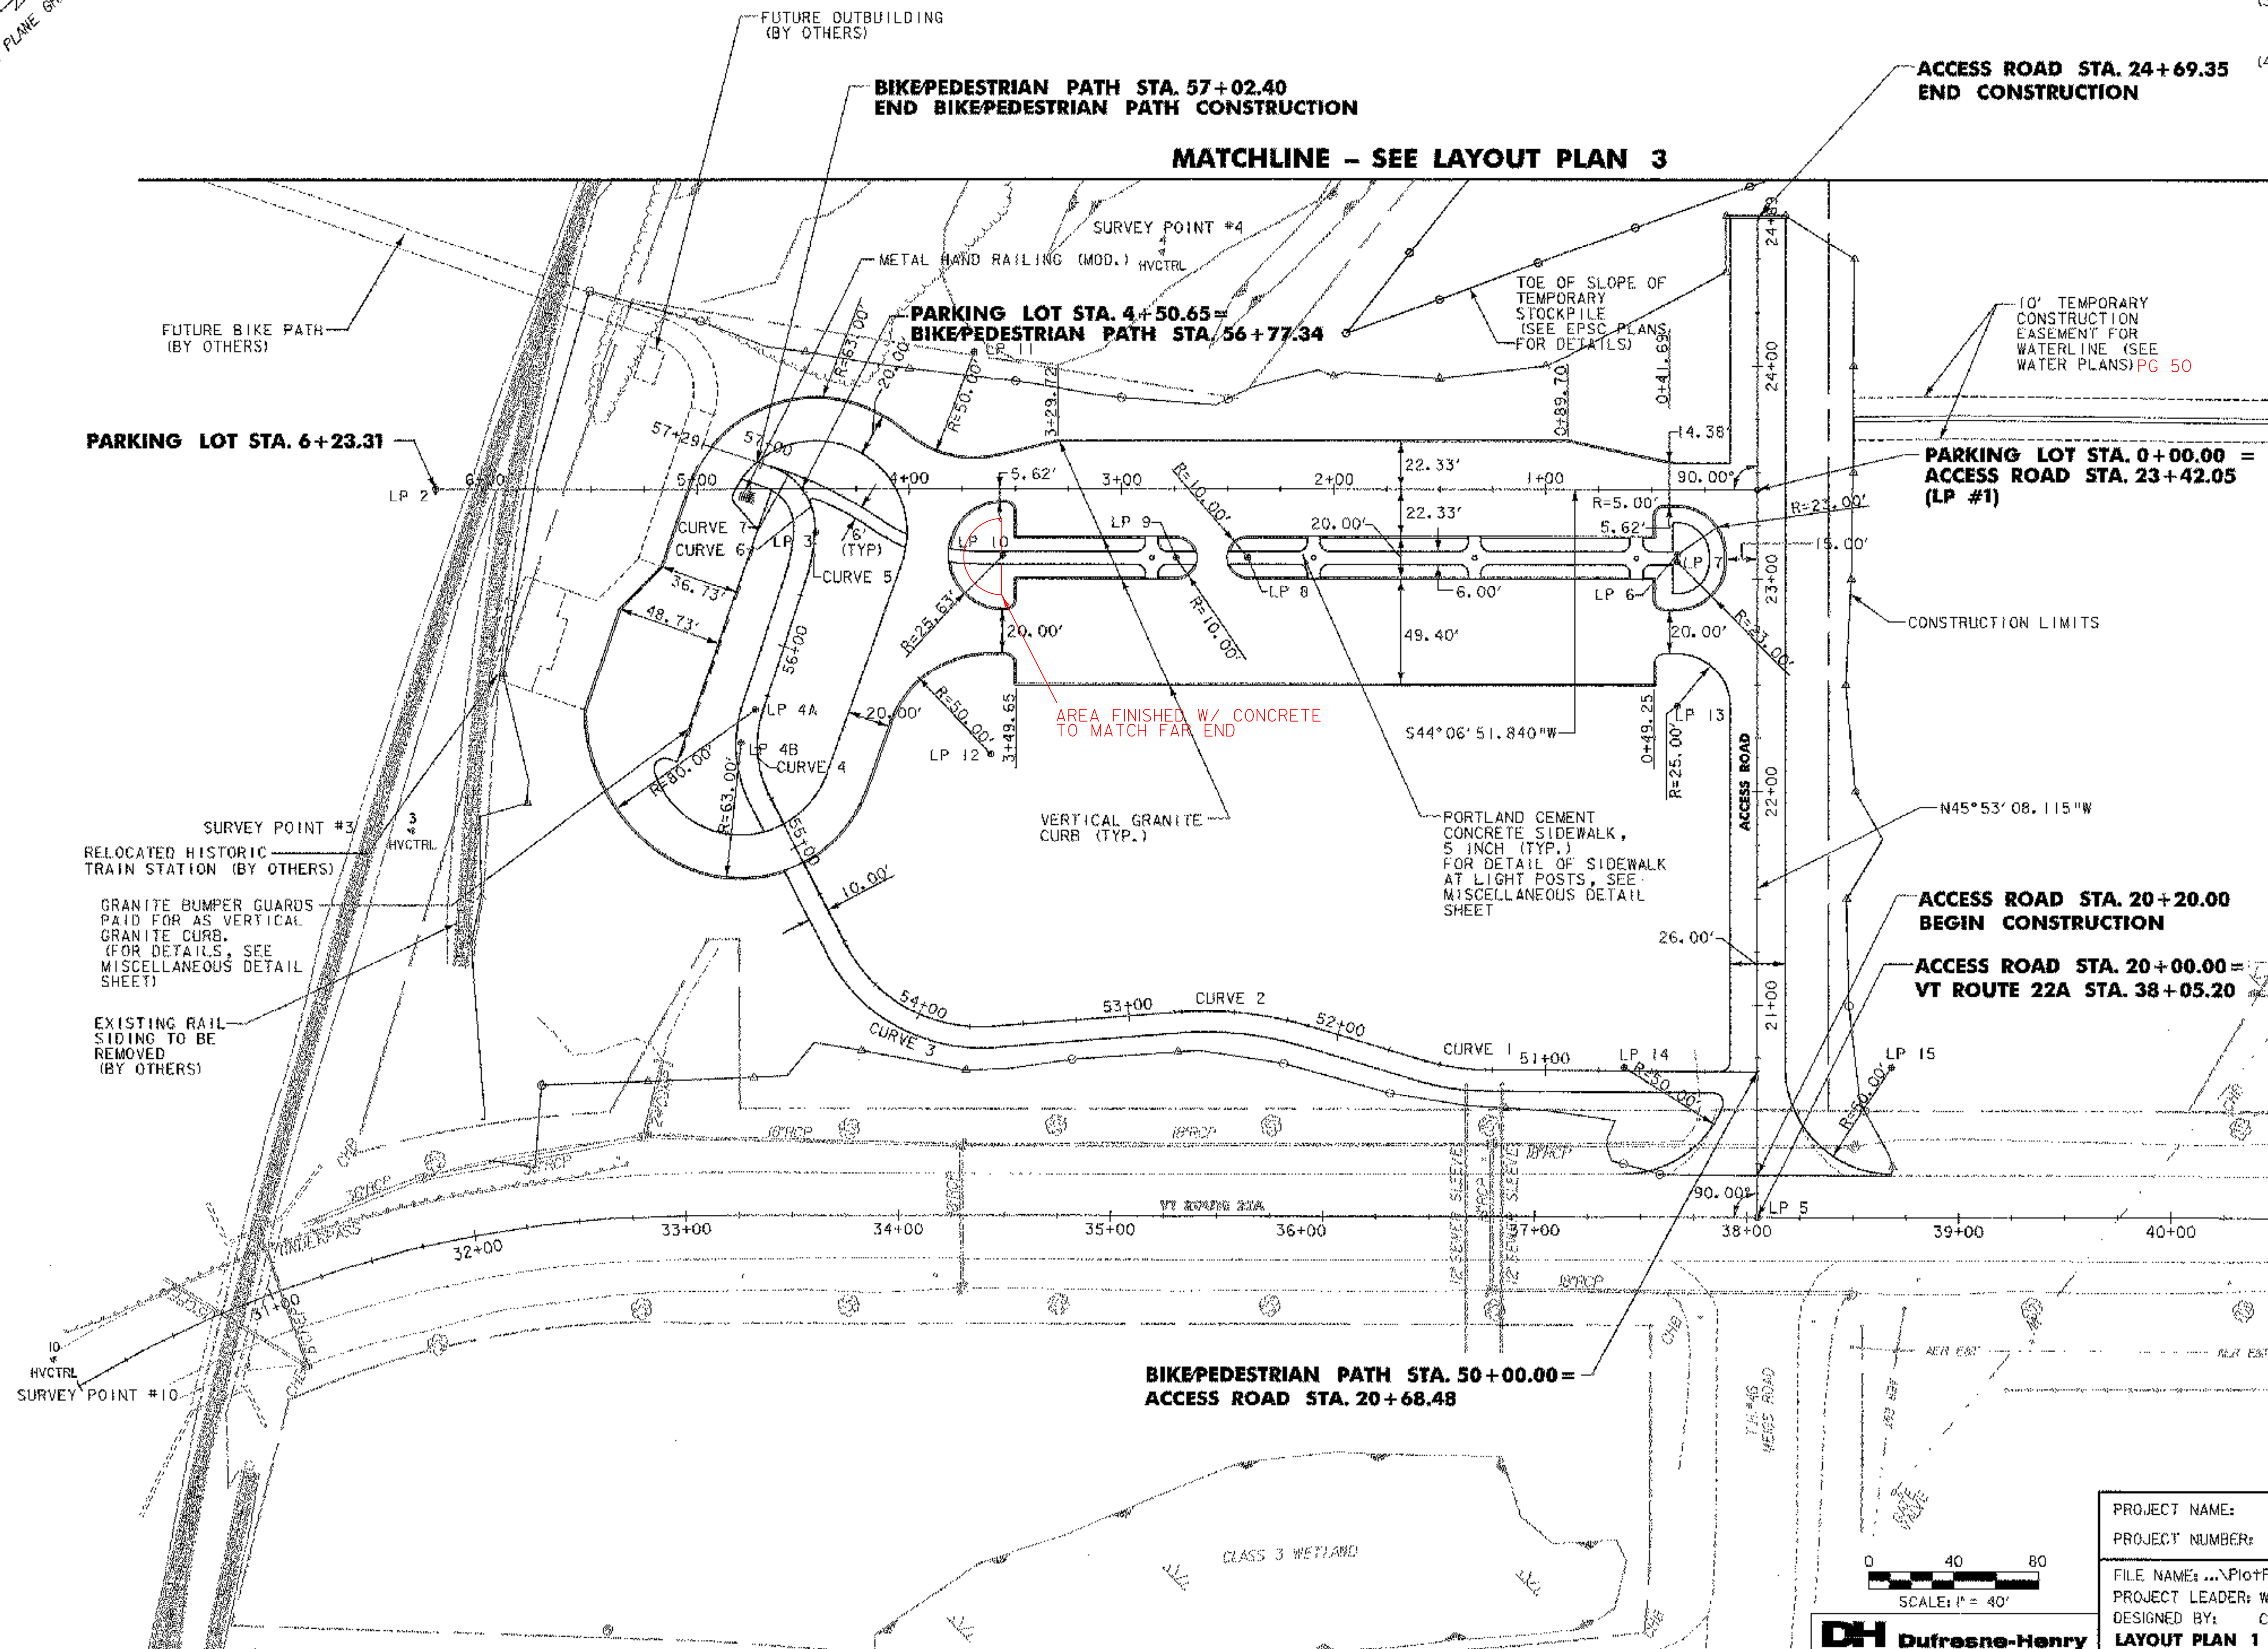

MATCHLINE STA. 40+50 - SEE LAYOUT PLAN 2

MATCHLINE - SEE LAYOUT PLAN 3

PROJECT NAME: FERRISBURGH/VERGS-FERRISBURGH	
PROJECT NUMBER: CMG PARK (15)S/STP EHO(21)	
FILE NAME: ...PlotFiles\N2\layout01.ppt	PLOT DATE: 4/19/2006
PROJECT LEADER: WLD	DRAWN BY: MBL
DESIGNED BY: CSP/GGG	CHECKED BY: GAS
LAYOUT PLAN 1	SHEET 12 OF 65

