



MATCHLINE - SEE LAYOUT PLAN 1

MATCHLINE - SEE LAYOUT PLAN 2

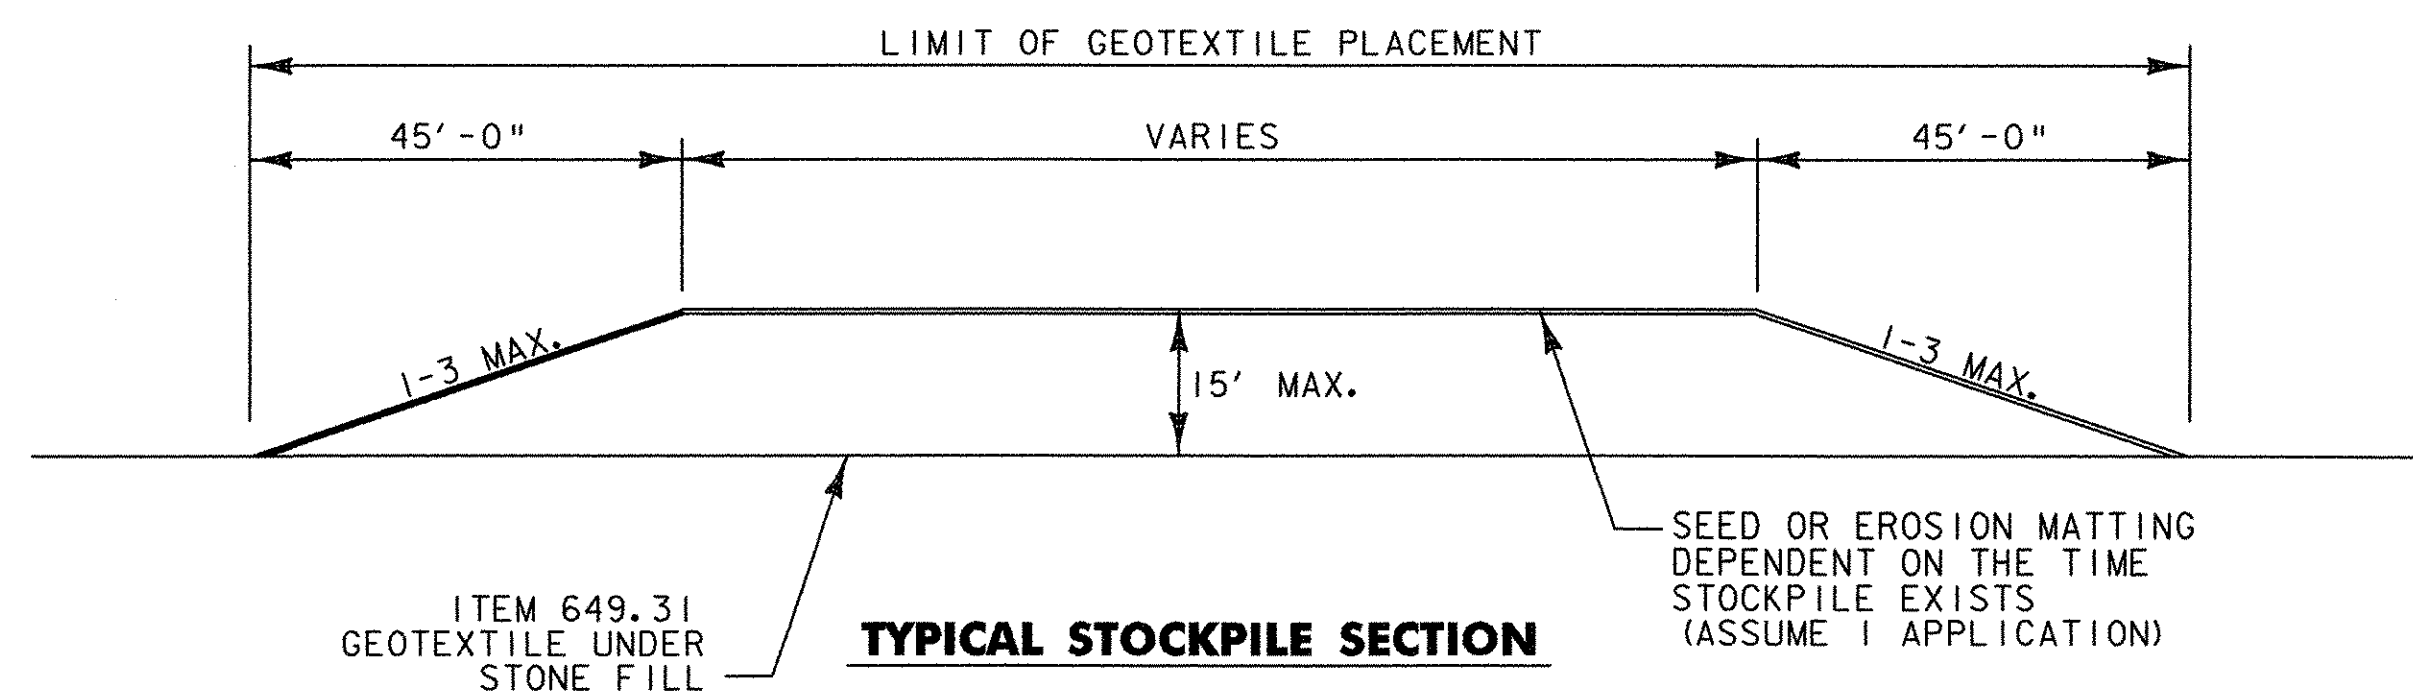

**TYPICAL STOCKPILE SECTION**

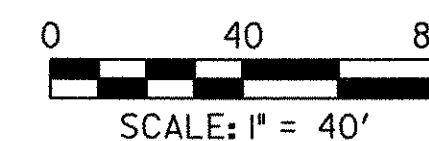

PROJECT NAME:	FERRISBURGH/VERGS-FERRISBURGH	PLOT DATE:	4/19/2006
PROJECT NUMBER:	CMG PARK (15)S/STP EH01(21)	DRAWN BY:	MBL/SRZ
FILE NAME:	...PlotFiles\14layout03.ptf	CHECKED BY:	GAS
PROJECT LEADER:	WLD	SHEET 14	OF 65
DESIGNED BY:	CSP/GGG	<b>LAYOUT PLAN 3</b>	