



BIKE/PEDESTRIAN PATH PROFILE

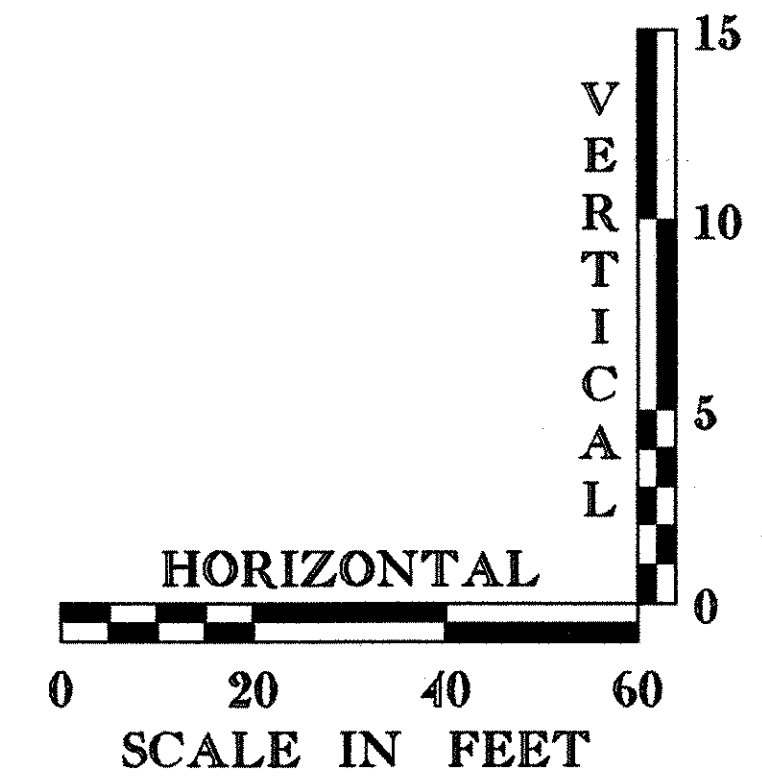

PROJECT NAME:	FERRISBURGH/VERGS-FERRISBURGH
PROJECT NUMBER:	CMG PARK (15)/S/STP EH01(21)
FILE NAME:	...\\PlotFiles\16-17profile.ptf
PROJECT LEADER:	WLD
DESIGNED BY:	CSP/GGG
PROFILE SHEET 2	
PLOT DATE:	4/19/2006
DRAWN BY:	MBL
CHECKED BY:	GAS
SHEET 17	OF 65

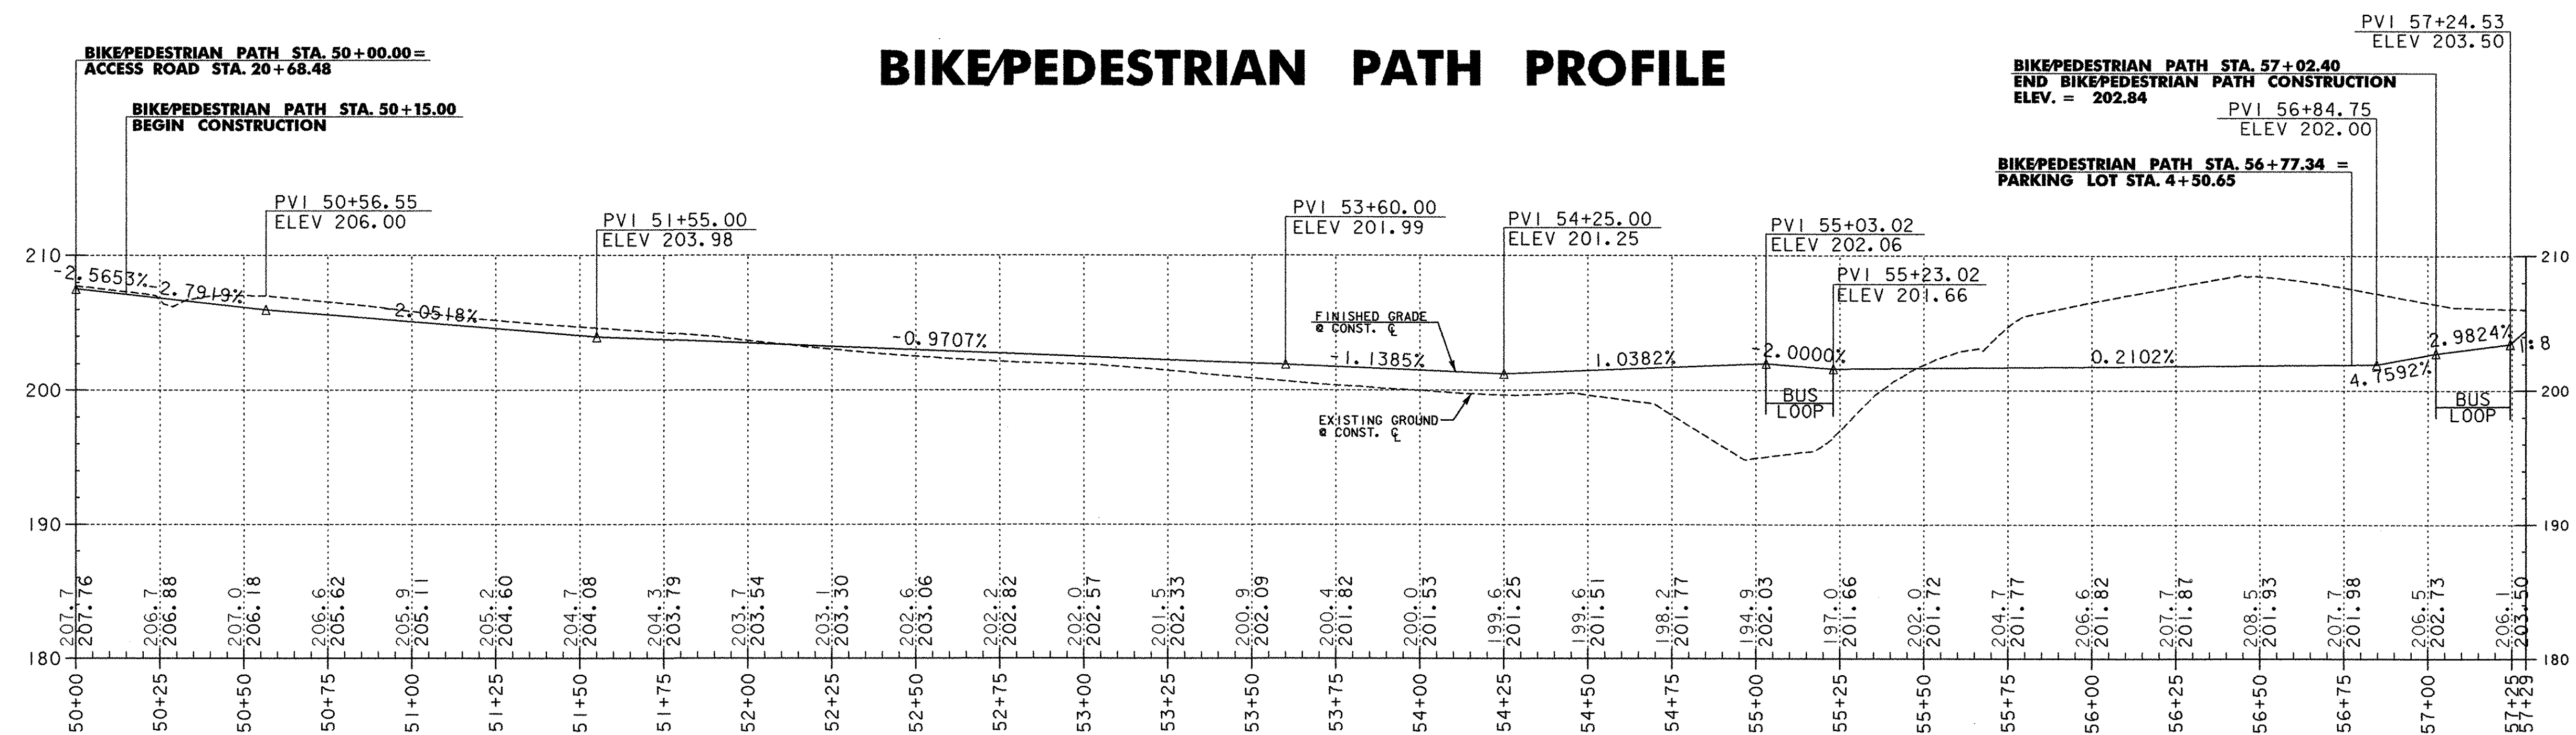